
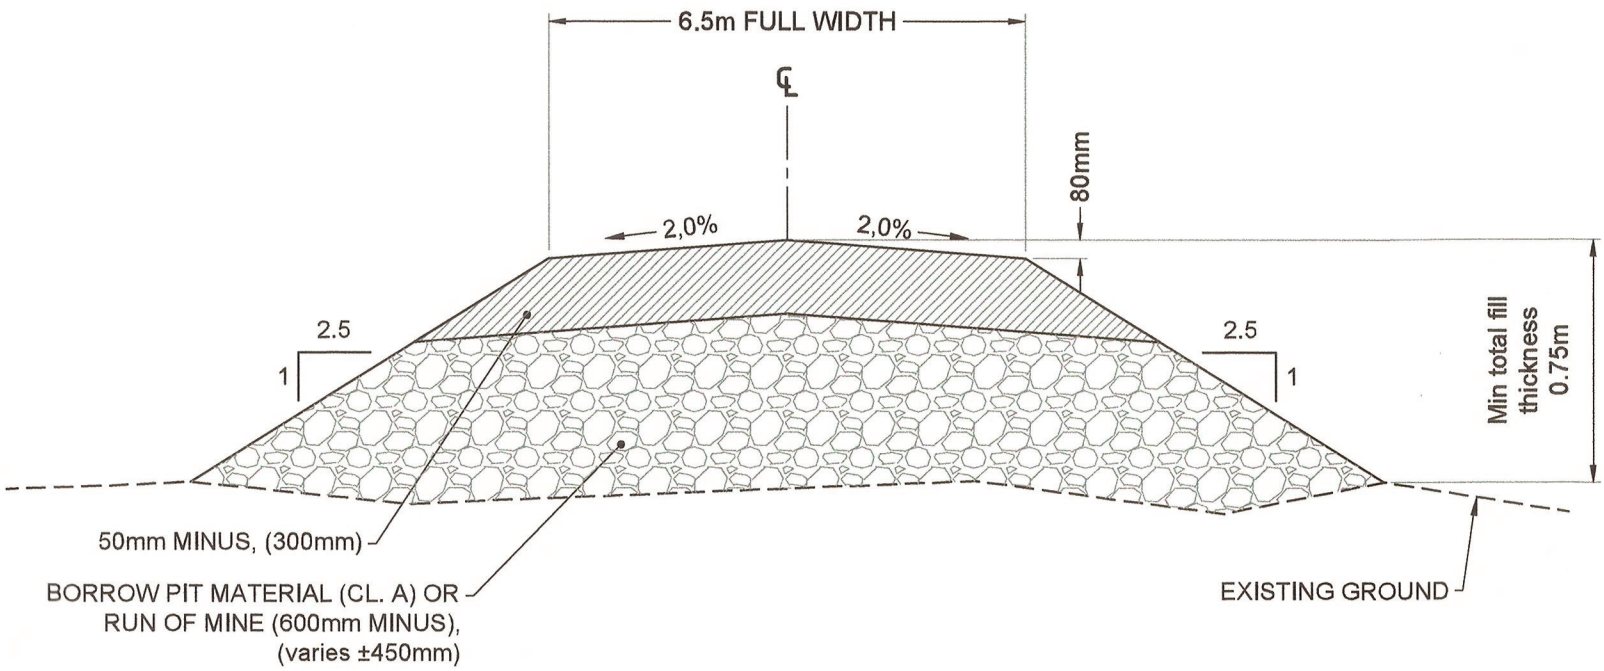


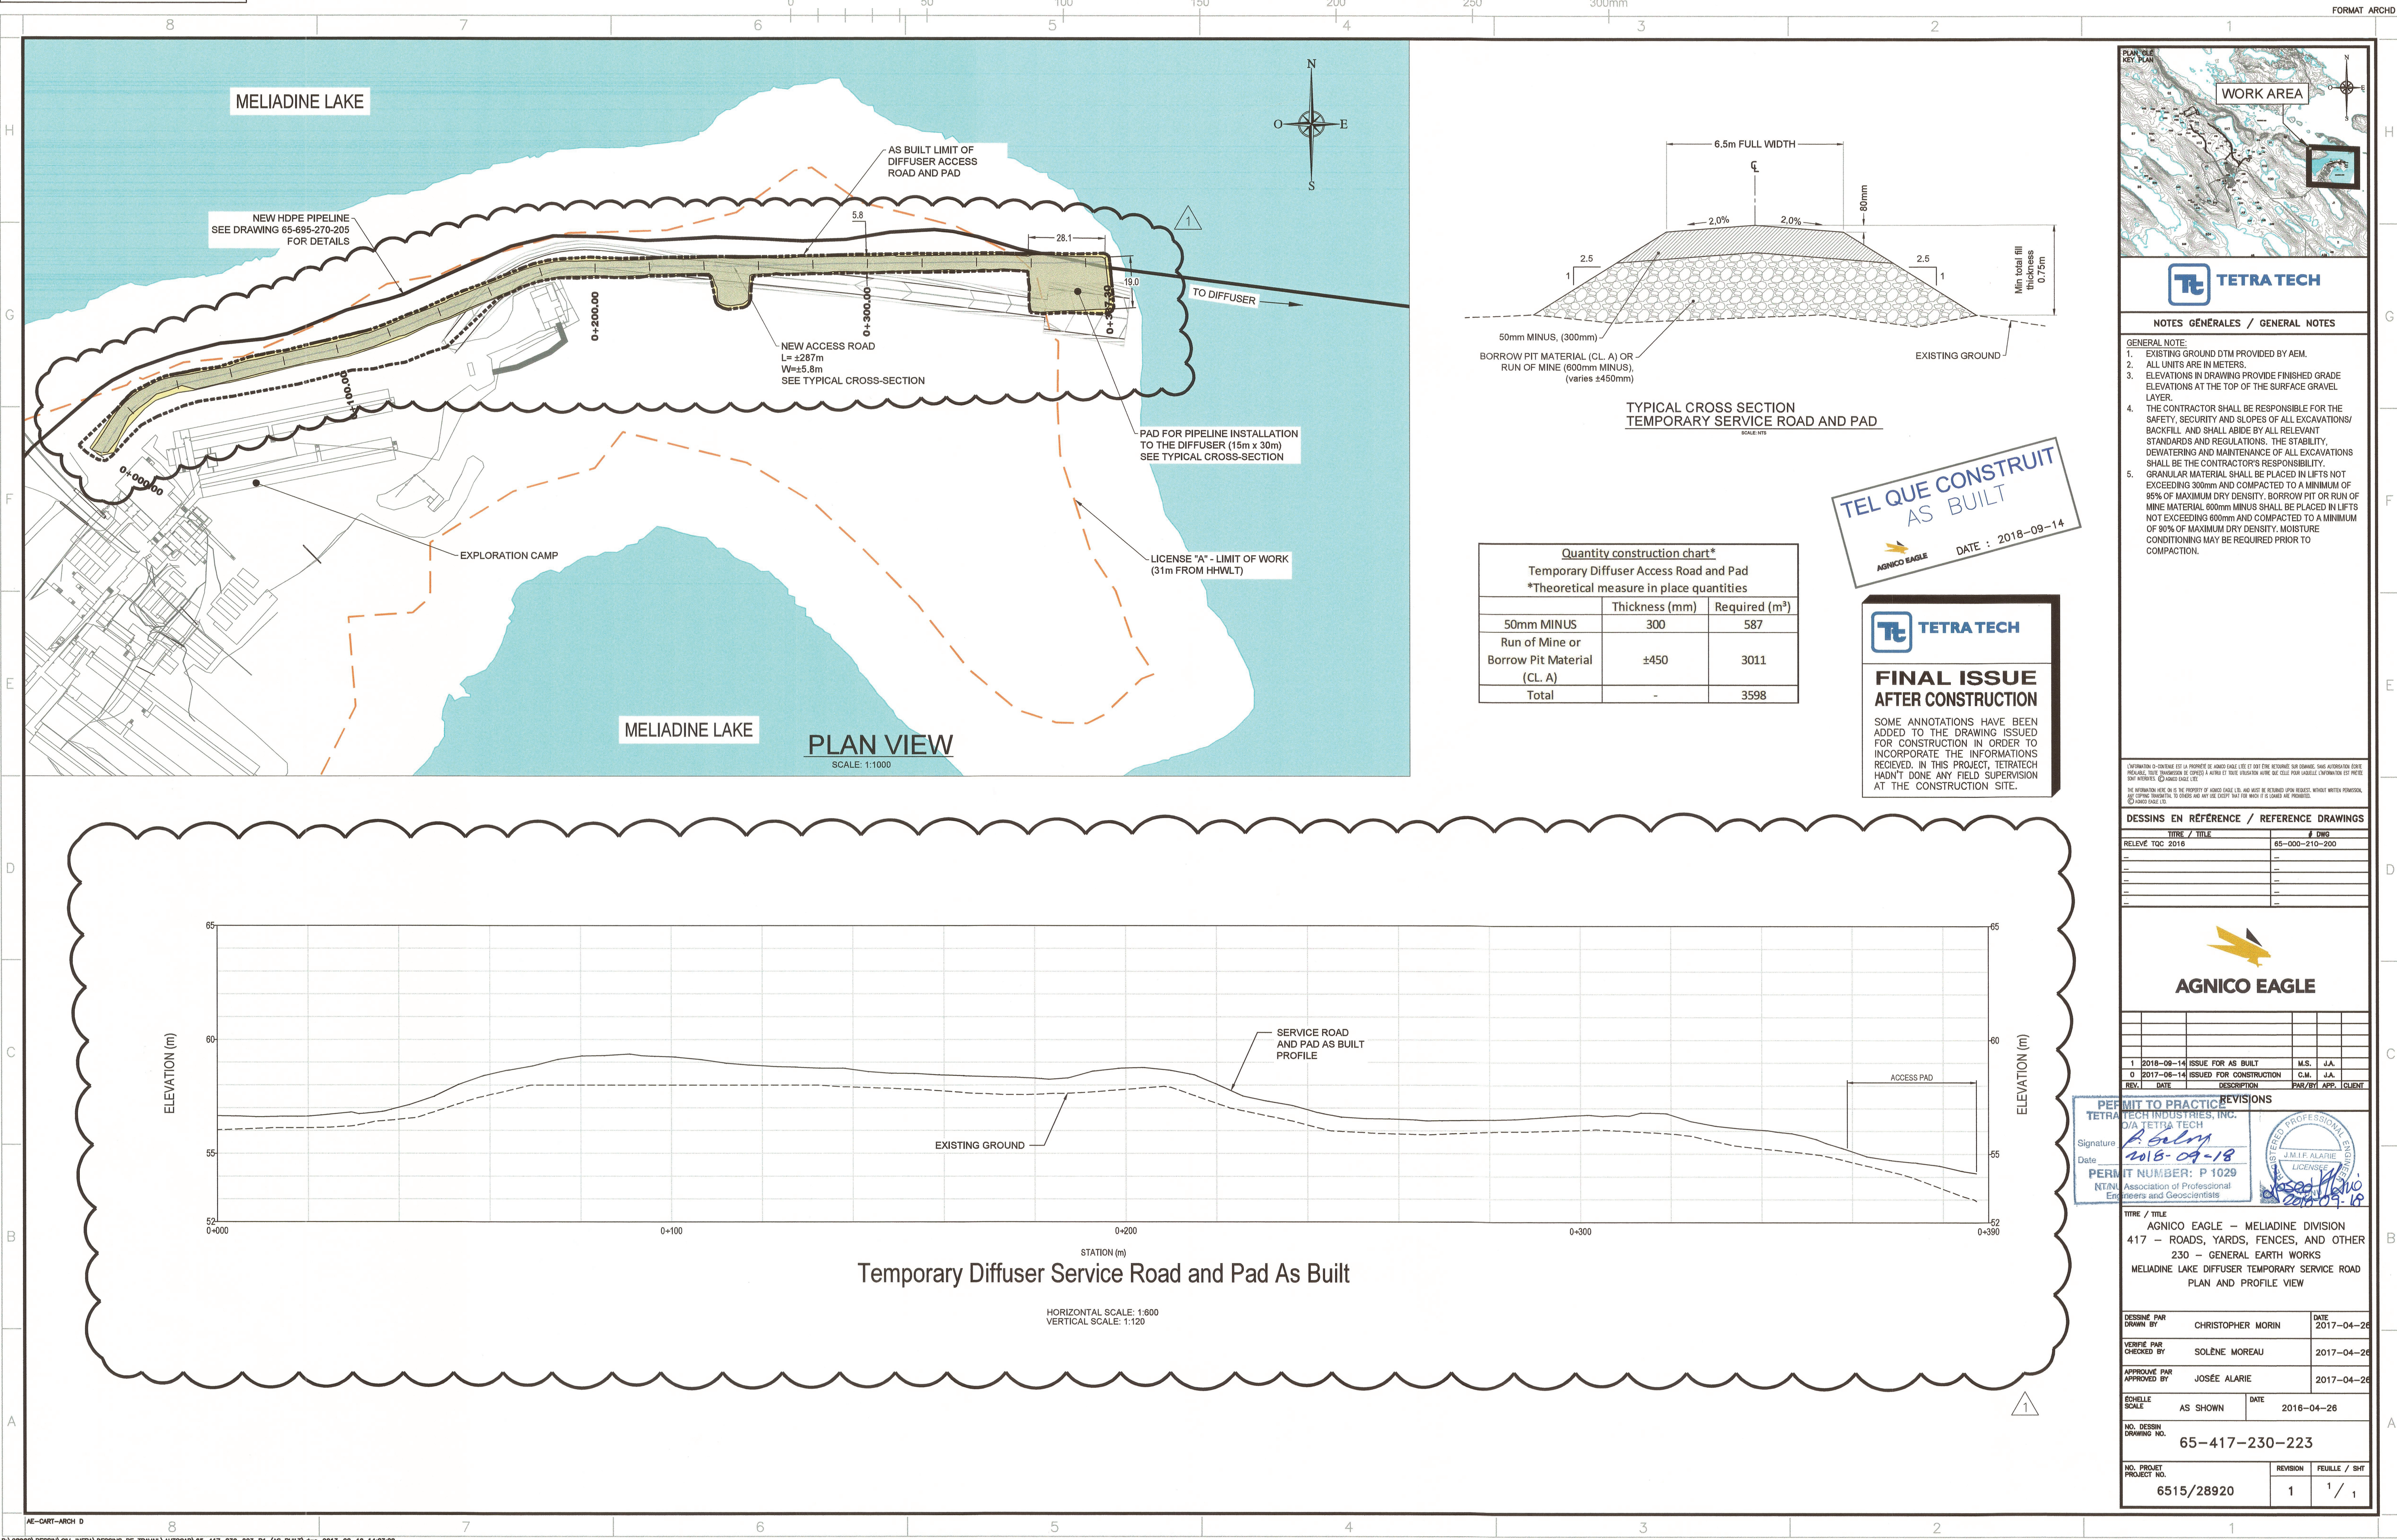


Quantity construction chart\*  
Temporary Diffuser Access Road and Pad  
\*Theoretical measure in place quantities

|                                            | Thickness (mm) | Required (m³) |
|--------------------------------------------|----------------|---------------|
| 50mm MINUS                                 | 300            | 587           |
| Run of Mine or Borrow Pit Material (CL. A) | ±450           | 3011          |
| Total                                      | -              | 3598          |

**TEL QUE CONSTRUIT  
AS BUILT**  
AGNICO EAGLE  
DATE : 2018-09-14

**TETRA TECH**  
**FINAL ISSUE  
AFTER CONSTRUCTION**  
SOME ANNOTATIONS HAVE BEEN  
ADDED TO THE DRAWING ISSUED  
FOR CONSTRUCTION IN ORDER TO  
INCORPORATE THE INFORMATIONS  
RECEIVED. IN THIS PROJECT, TETRA TECH  
HADN'T DONE ANY FIELD SUPERVISION  
AT THE CONSTRUCTION SITE.

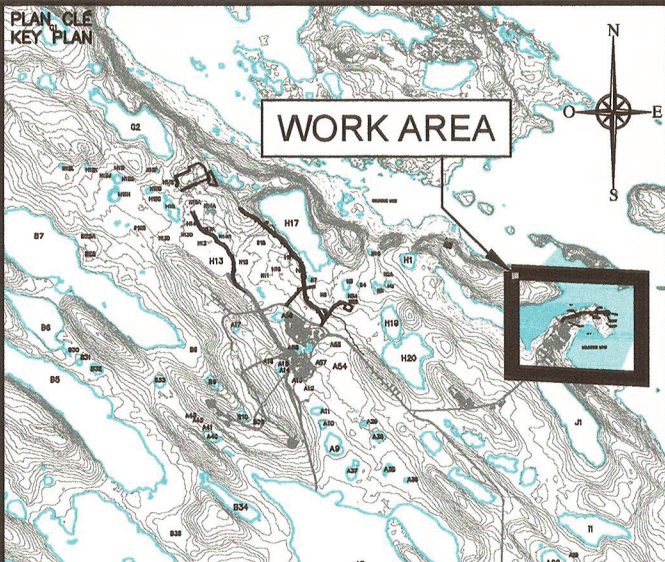

**TETRA TECH**

**NOTES GÉNÉRALES / GENERAL NOTES**

- GENERAL NOTE:
1. EXISTING GROUND DTM PROVIDED BY AEM.
  2. ALL UNITS ARE IN METERS.
  3. ELEVATIONS IN DRAWING PROVIDE FINISHED GRADE ELEVATIONS AT THE TOP OF THE SURFACE GRAVEL LAYER.
  4. THE CONTRACTOR SHALL BE RESPONSIBLE FOR THE SAFETY, SECURITY AND SLOPES OF ALL EXCAVATIONS/ BACKFILL AND SHALL ABIDE BY ALL RELEVANT STANDARDS AND REGULATIONS. THE STABILITY, DEWATERING AND MAINTENANCE OF ALL EXCAVATIONS SHALL BE THE CONTRACTOR'S RESPONSIBILITY.
  5. GRANULAR MATERIAL SHALL BE PLACED IN LIFTS NOT EXCEEDING 300mm AND COMPACTED TO A MINIMUM OF 95% OF MAXIMUM DRY DENSITY. BORROW PIT OR RUN OF MINE MATERIAL 600mm MINUS SHALL BE PLACED IN LIFTS NOT EXCEEDING 600mm AND COMPACTED TO A MINIMUM OF 90% OF MAXIMUM DRY DENSITY. MOISTURE CONDITIONING MAY BE REQUIRED PRIOR TO COMPACTION.

L'INFORMATION D'ENSEMBLE EST LA PROPRIÉTÉ DE AGNICO EAGLE LTD ET DOIT ÊTRE RÉSERVÉE À SON DOMAINE. TOUTE AUTRES INFORMATION DOIT ÊTRE RÉSERVÉE À SON DOMAINE. TOUTES LES INFORMATIONS SONT SOUS RÉSERVE. © AGNICO EAGLE LTD.

ALL INFORMATION HEREIN IS THE PROPERTY OF AGNICO EAGLE LTD. AND MUST BE RESERVED TO ITS DOMAIN. WITHOUT WRITTEN PERMISSION, ALL COPIES TRANSMITTED TO OTHERS AND ANY USE EXCEPT THAT FOR WHICH IT IS ISSUED ARE PROHIBITED. © AGNICO EAGLE LTD.

**DESSINS EN RÉFÉRENCE / REFERENCE DRAWINGS**

| TITRE / TITLE   | # DWG          |
|-----------------|----------------|
| RELEVÉ TQC 2016 | 65-000-210-200 |
|                 |                |
|                 |                |
|                 |                |
|                 |                |

**AGNICO EAGLE**

|  |  |  |  |  |  |
|--|--|--|--|--|--|
|  |  |  |  |  |  |
|  |  |  |  |  |  |
**PERMIT TO PRACTICE REVISIONS**  
TETRA TECH INDUSTRIES, INC.  
O/A TETRA TECH  
Signature: *[Signature]*  
Date: 2018-09-18  
PERMIT NUMBER: P 1029  
NTNL Association of Professional Engineers and Geoscientists

**TITRE / TITLE**  
AGNICO EAGLE - MELIADINE DIVISION  
417 - ROADS, YARDS, FENCES, AND OTHER  
230 - GENERAL EARTH WORKS  
MELIADINE LAKE DIFFUSER TEMPORARY SERVICE ROAD  
PLAN AND PROFILE VIEW

|                             |                   |                    |
|-----------------------------|-------------------|--------------------|
| DESSINÉ PAR<br>DRAWN BY     | CHRISTOPHER MORIN | DATE<br>2017-04-26 |
| VÉRIFIÉ PAR<br>CHECKED BY   | SOLÈNE MOREAU     | 2017-04-26         |
| APPROUVÉ PAR<br>APPROVED BY | JOSÉE ALARIE      | 2017-04-26         |

ÉCHELLE  
SCALE AS SHOWN  
DATE 2016-04-26

NO. DESSIN  
DRAWING NO. 65-417-230-223

|                                      |               |                          |
|--------------------------------------|---------------|--------------------------|
| NO. PROJET<br>PROJECT NO. 6515/28920 | REVISION<br>1 | FEUILLE / SHEET<br>1 / 1 |
|--------------------------------------|---------------|--------------------------|