


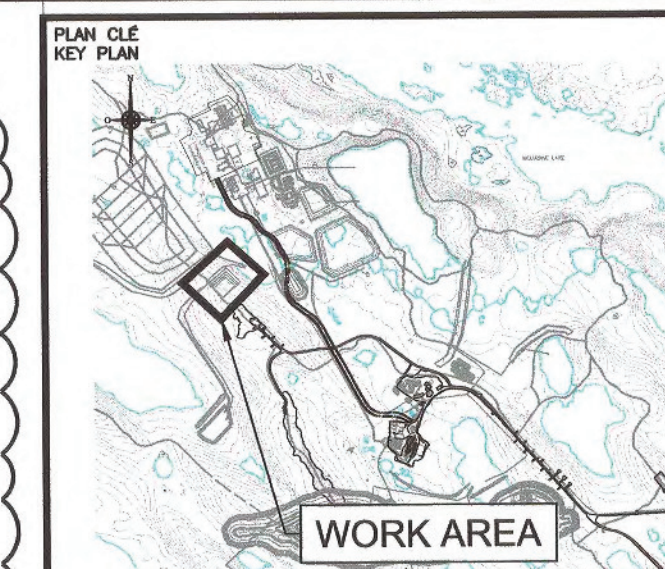

TETRA TECH

NOTES GÉNÉRALES / GENERAL NOTES

LEGEND

- (A) ESKER GRANULAR FILL (CL. A) (600mm MINUS)
- (B) GRANULAR FILL (50mm MINUS)

TEL QUE CONSTRUIT
AS BUILT

AGNICO EAGLE DATE : 2017

THE INFORMATION HERE ON IS THE PROPERTY OF AGARD EAGLE LTD. AND MUST BE RETURNED UPON REQUEST. WITHOUT WRITTEN PERMISSION, NO REPRODUCTION, EITHER WHOLE OR IN PART, FOR ANY PURPOSE, SHALL BE MADE. IT IS ASSURED, AND REPRODUCED.

DESSINS EN RÉFÉRENCE / REFERENCE DRAWINGS

TITRE / TITLE	# DWG
---	---
---	---
AGNICO EAGLE

1	2017-12-01	ISSUED AS-BUILT	CM	JA	
0	2017-02-08	ISSUED FOR CONSTRUCTION	GZ	KJ	
A	2017-01-23	ISSUED FOR REVIEW	GZ	KJ	
REV	DATE	DESCRIPTION	PAR/BY	APP.	

REVISIONS

PERMIT TO PRACTICE
TETRA TECH INDUSTRIES, INC.
 O/A TETRA TECH
 Signature *P. Galy*
 Date *2017-12-01*
PERMIT NUMBER: P 1029
 NT/NU Association of Professional
 Engineers and Geoscientists

REGISTERED PROFESSIONAL
 J.M.I.F. ALABAMA
 LICENSED
P. Galy
 2017

ENGINEERS AND GEOSCIENTISTS

TITLE / TITLE
AGNICO EAGLE - MELIADINE DIVISION 697 - LANDFILL 230 - GENERAL EARTH WORKS OPERATION LANDFILL (STAGE 1) CROSS SECTIONS A-A AND B-B

DESSINÉ PAR DRAWN BY	EL	DATE 2017-
VERIFIÉ PAR CHECKED BY	GZ	2017-
APPROUVÉ PAR APPROVED BY	KJ	2017-

ÉCHELLE SCALE	AS SHOWN	DATE	2017-01-23
------------------	----------	------	------------

NO. DESSIN
DRAWING NO. 65-697-230-205

NO. PROJ.	REVISION	FEUILLE
PROJECT NO.		

