
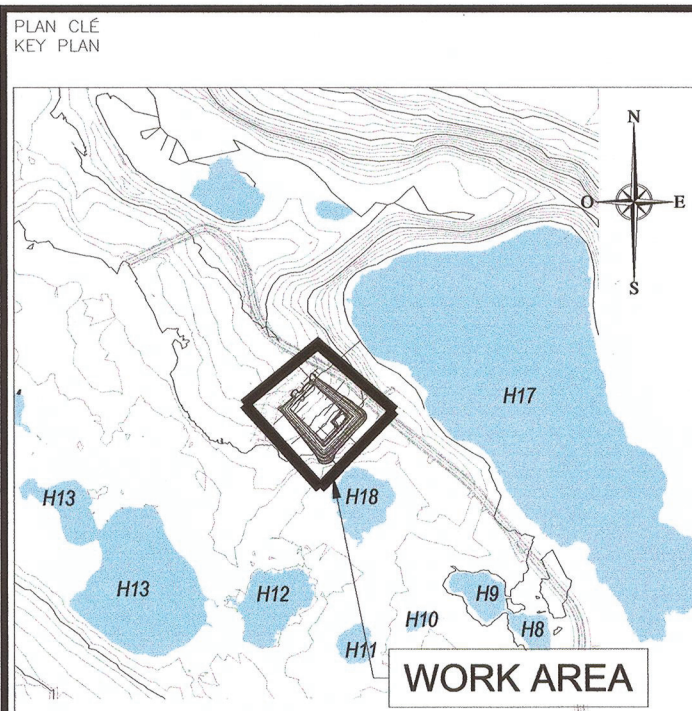


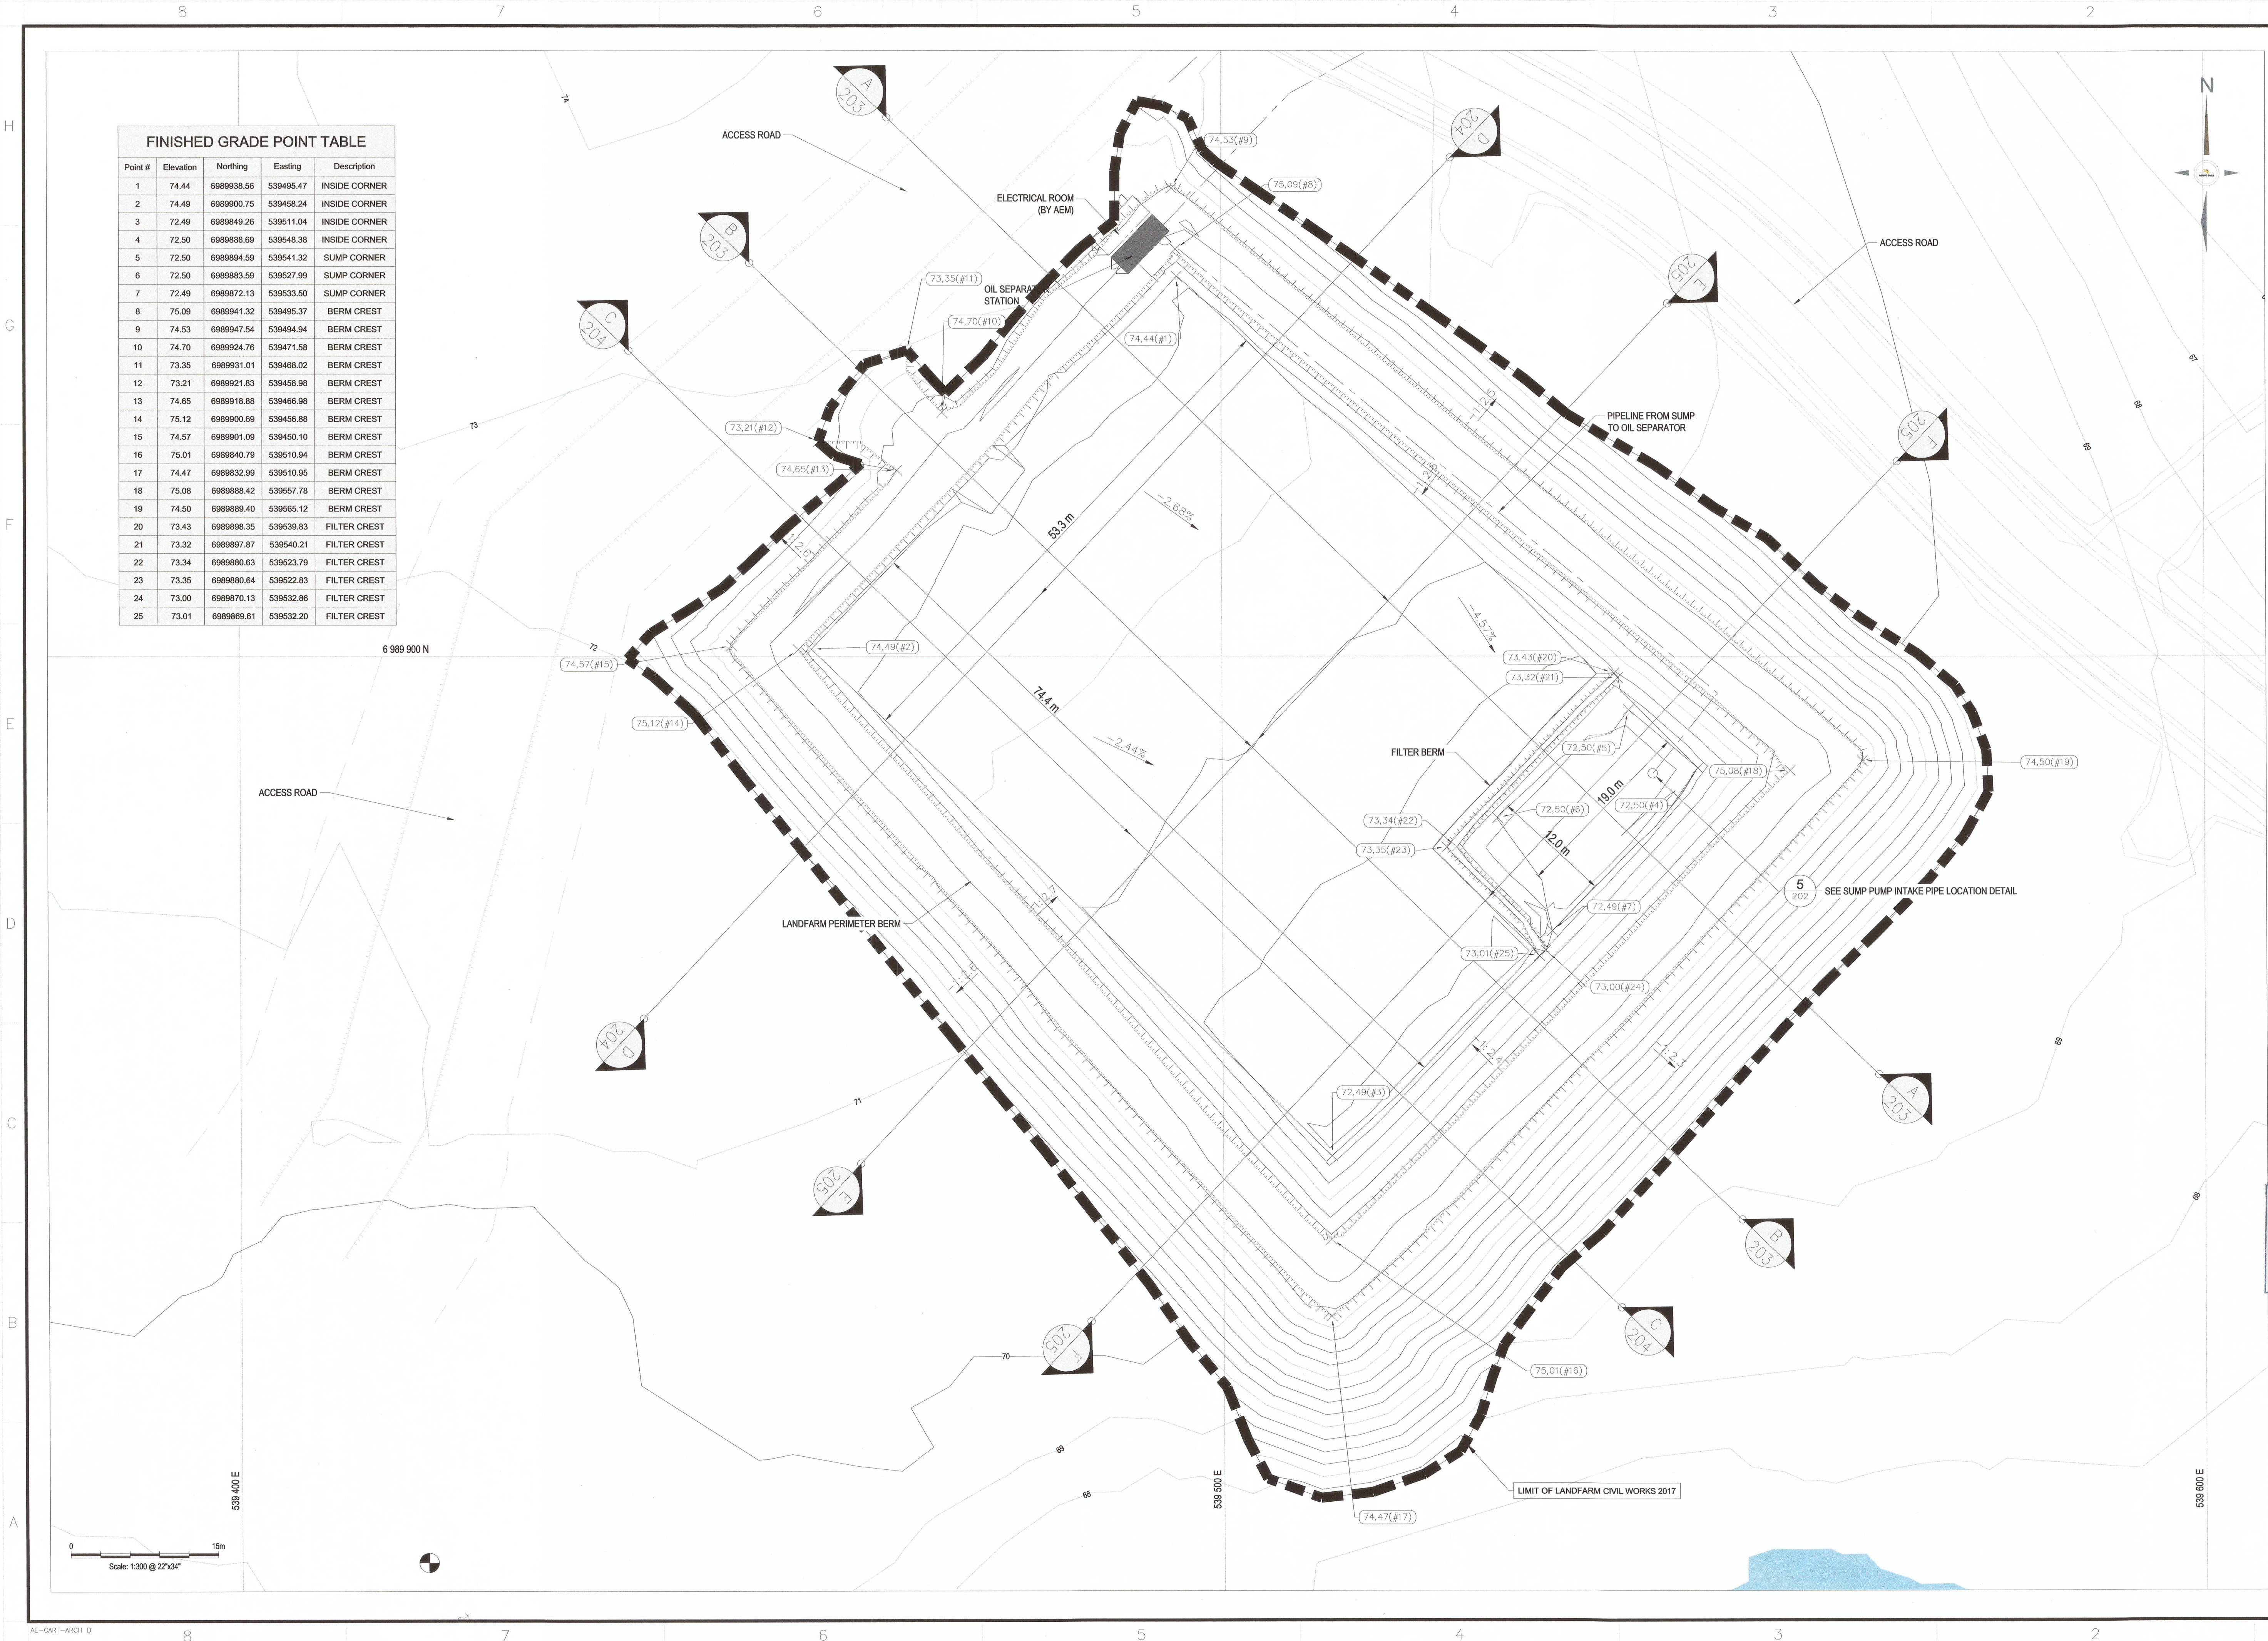

NOTES GÉNÉRALES / GENERAL NOTES

TEL QUE CONSTRUIT
AS BUILT

AGNICO EAGLE

DATE : 2018-02-02

INFORMATION CONTAINED HEREIN IS THE PROPERTY OF AGNICO EAGLE LTD. AND MUST BE RETURNED UPON REQUEST. NO COPY SHALL BE MADE OR TRANSMITTED TO OTHERS AND ANY USE WITHOUT THE WRITTEN PERMISSION OF AGNICO EAGLE LTD. IS PROHIBITED.

DESSINS EN RÉFÉRENCE / REFERENCE DRAWINGS

TITRE / TITLE	# DWG.



REV.	DATE	DESCRIPTION	PAR/APP.	CLIENT
2	2018-02-02	ISSUED AS-BUILT - GENERAL REVISION	CM	JA
1	2017-06-01	RE-ISSUED FOR CONSTRUCTION	EL	GZ
0	2017-02-08	ISSUED FOR CONSTRUCTION	EP	GZ
A	2017-01-16	ISSUED FOR REVIEW	EP	GZ

PERMIT TO PRACTICE
TERRA TECH INDUSTRIES, INC.
O/A T&A TECH

Signature: *[Signature]*
Date: 2018-02-01

PERMIT NUMBER: P 1029

N/AU Association of Professional Engineers and Geoscientists

AGNICO EAGLE MELIADINE GOLD PROJECT

LANDFARM LAYOUT PLAN

DESSIN PAR DRAWN BY	EP	DATE 2017-01-16
VERIFIÉ PAR CHECKED BY	GZ	2017-01-16
APPROUVE PAR APPROVED BY		
ECHELLE SCALE	1:300	DATE 2017-01-16
NO. DESSIN DRAWING NO.	65-696-230-201	
NO. PROJET PROJECT NO.	6515	REVISION 2
FEUILLE / SHEET	2 / 6	