


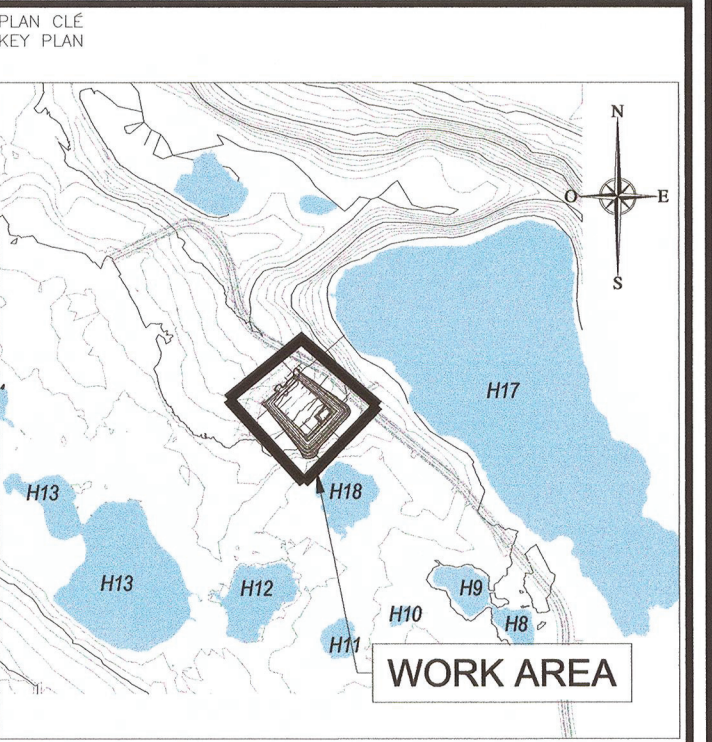

- (A) ESKER CL. A MATERIAL (600 mm MINUS)
- (B) TRANSITION ROCKFILL (200 mm MINUS)
- (C) GRANULAR FILL (30 mm MINUS)

TEL QUE CONSTRUIT
AS BUILT

AGNICO EAGLE

DATE : 2018-02-02

INFORMATION O-CONTENEUR EST LA PROPRIÉTÉ DE AGNICO EAGLE L'ÉE ET DOIT ÊTRE RETOURNÉE
 POUR DEMANDE, SANS AUTORISATION ÉCRITE PRÉALABLE, TOUTE TRANSMISSION DE COPIE(S) À AUTRUI
 ET TOUTE UTILISATION AUTRE QUE CELLE POUR LAQUELLE L'INFORMATION EST PRÉÉE SONT
 INTERDITES.

AGNICO EAGLE L'ÉE
 THE INFORMATION HERE ON IS THE PROPERTY OF AGNICO EAGLE LTD. AND MUST BE RETURNED UPON
 REQUEST. WITHOUT WRITTEN PERMISSION, ANY COPYING TRANSMITTAL TO OTHERS AND ANY USE
 EXCEPT THAT FOR WHICH IT IS LOANED ARE PROHIBITED.

[illegible]

2	2018-02-02	ISSUED AS-BUILT	CM	JA	
1	2017-06-01	RE-ISSUED FOR CONSTRUCTION	EL	GZ	
0	2017-02-08	ISSUED FOR CONSTRUCTION	EP	GZ	
A	2017-01-16	ISSUED FOR REVIEW	EP	GZ	
REV.	DATE	DESCRIPTION	PAR/BY	APP.	CLIENT

PERMIT TO PRACTICE
TETRA TECH INDUSTRIES, INC.
O/A TETRA TECH

Signature: *[Signature]*
Date: *2015-08-01*

PERMIT NUMBER: P 1029

NTA/ Association of Professional
Engineers and Geoscientists

REGISTERED PROFESSIONAL ENGINEER
J.M.F. ALARIE
LICENSED
[Signature]
2015-02-07

LANDFARM
TYPICAL DESIGN SECTION, DETAILS, AND QUANTITIES

DESSINÉ PAR DRAWN BY	EP	DATE 2017-01-16
-------------------------	----	--------------------

VERIFIÉ PAR CHECKED BY	GZ	2017-01-16
---------------------------	----	------------

APPROUVE PAR APPROVED BY	
-----------------------------	--

ECHELLE SCALE	1:200	DATE	2017-01-16
------------------	-------	------	------------

DRAWING NO. 65-696-230-202

NO. PROJET PROJECT NO.	REVISION	FEUILLE / SHT
6515	2	3 / 6

