
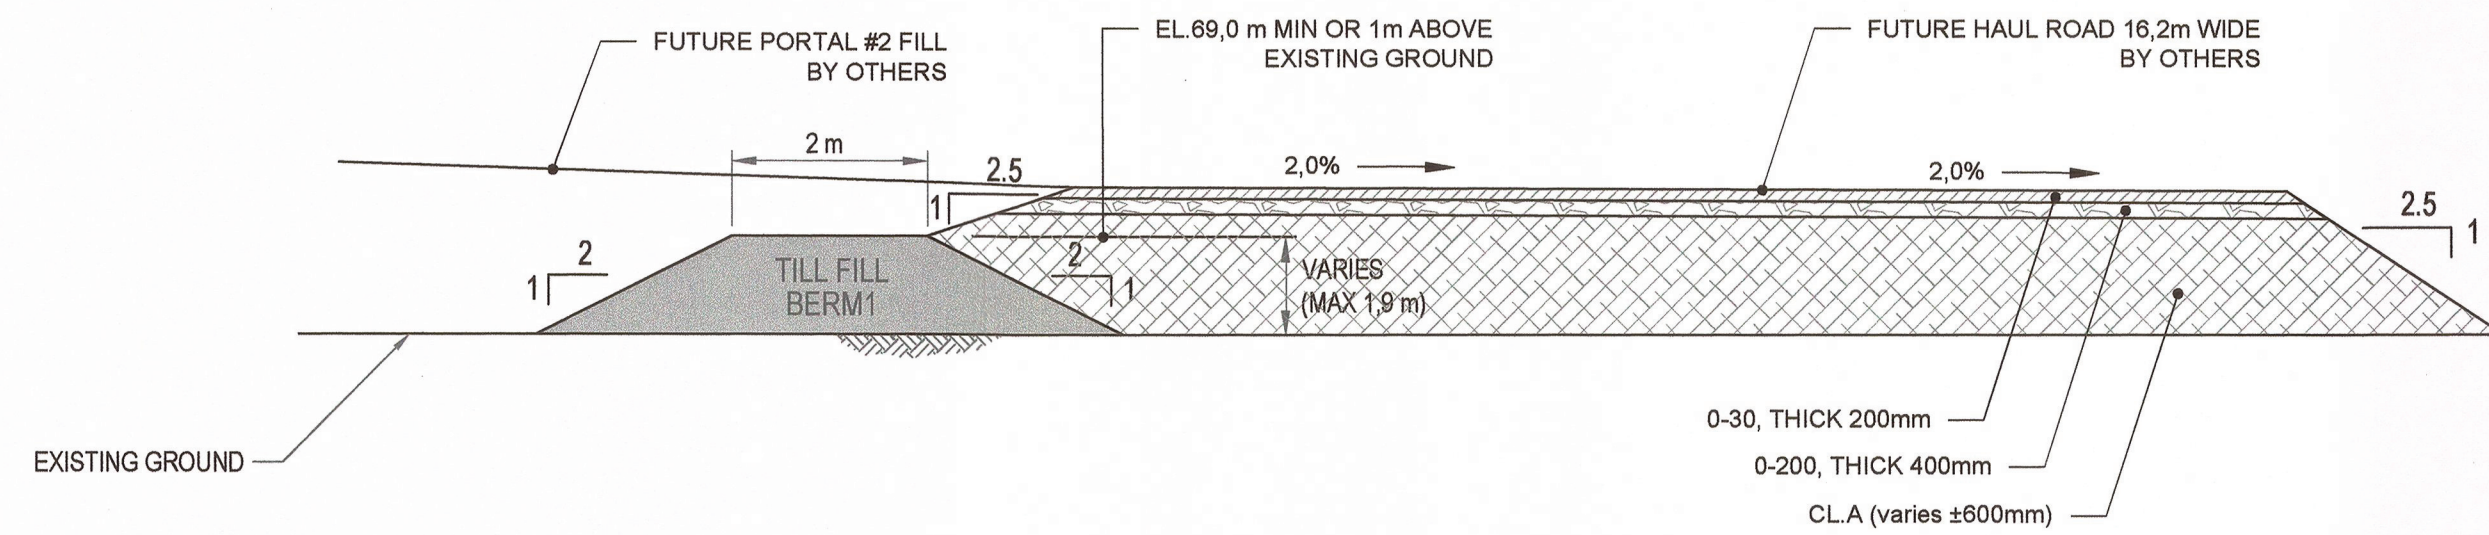




Appendix O

Infrastructures As-Built and Design

Meliadine Interim Closure and Reclamation Plan - Update 2020		Original -V.03
2021/04/07	674942-4000-4EER-0002	Technical Report

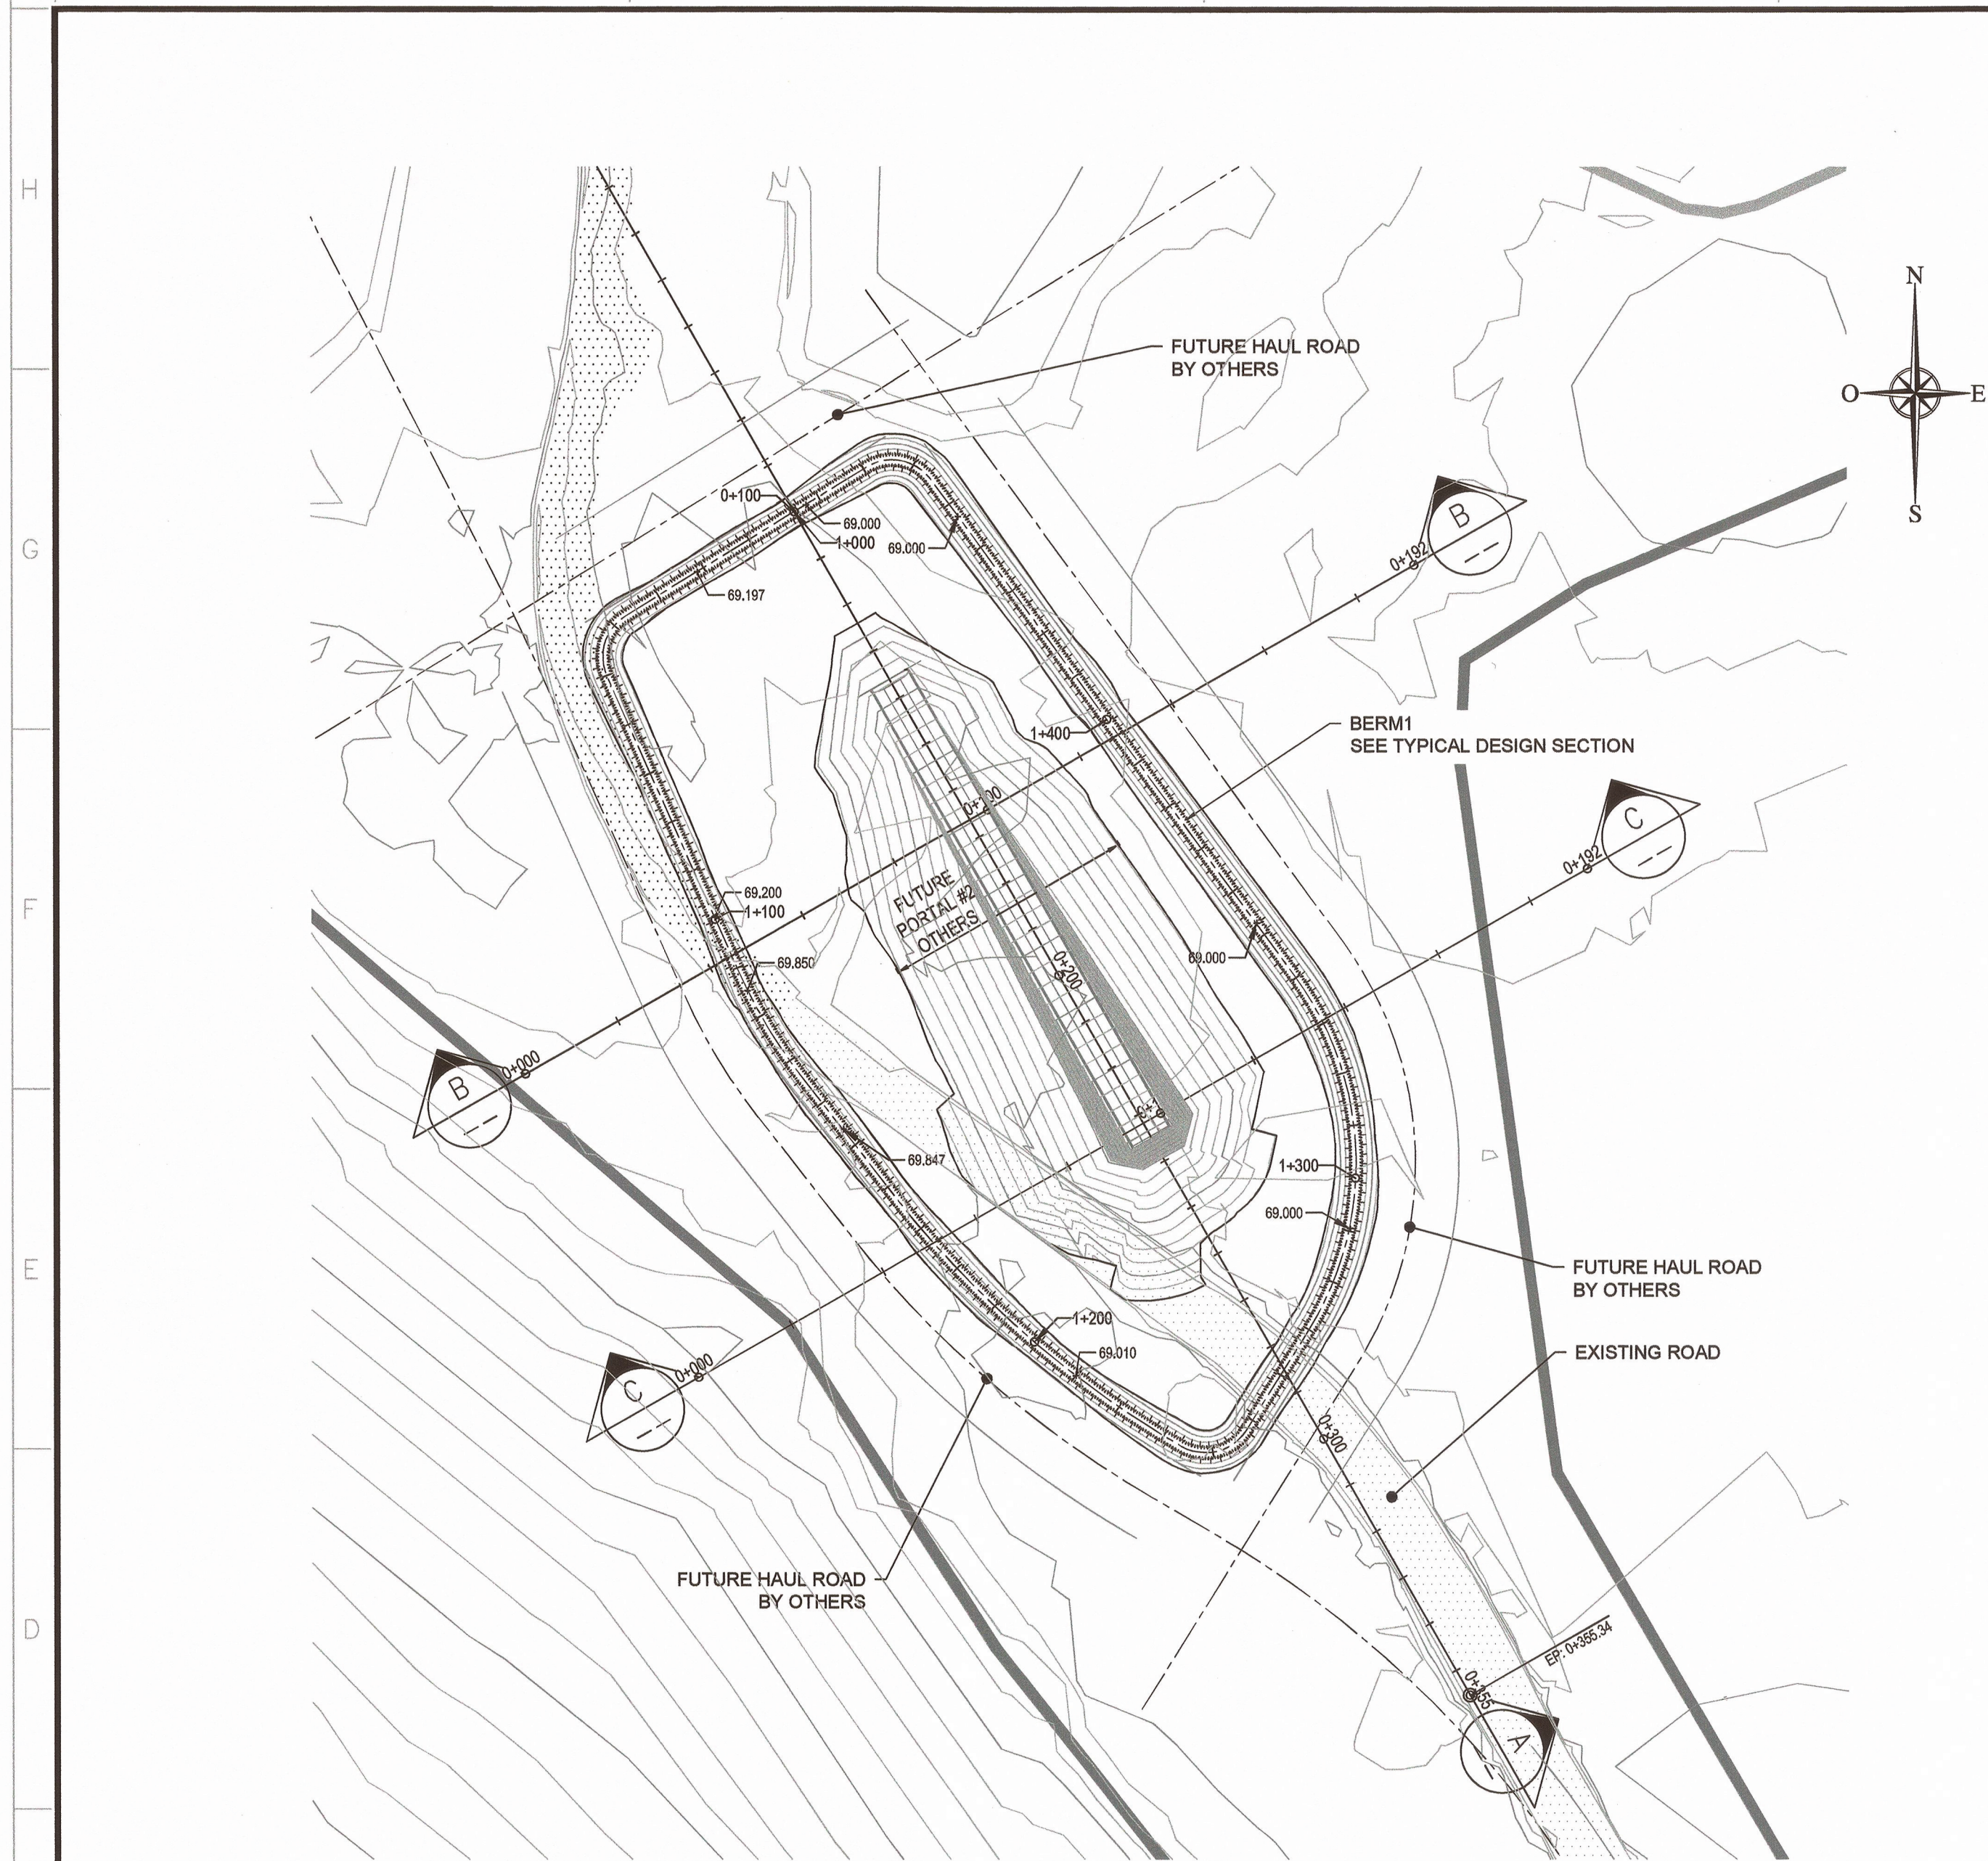

QUANTITIES CONSTRUCTION CHART *	
BERM1	
MATERIAL	QUANTITIES
SELECTED UNFROZEN TILL FILL	3260 m³
* MATERIAL QUANTITIES ARE ESTIMATED IN-PLACE QUANTITIES	

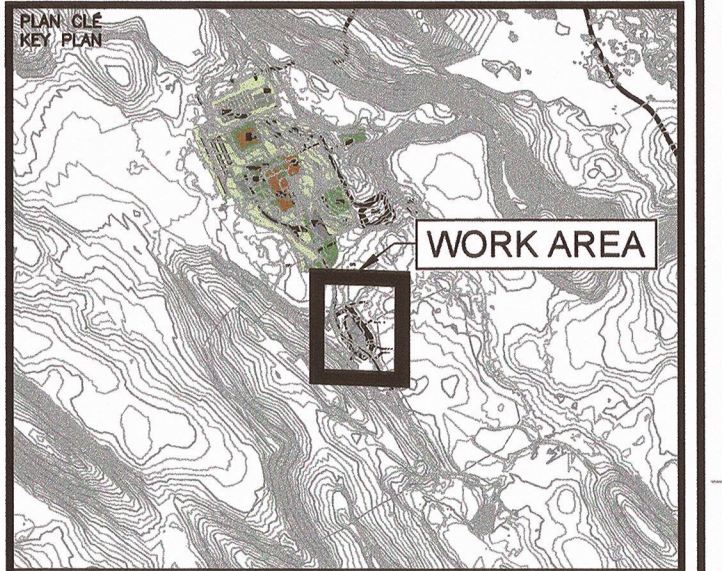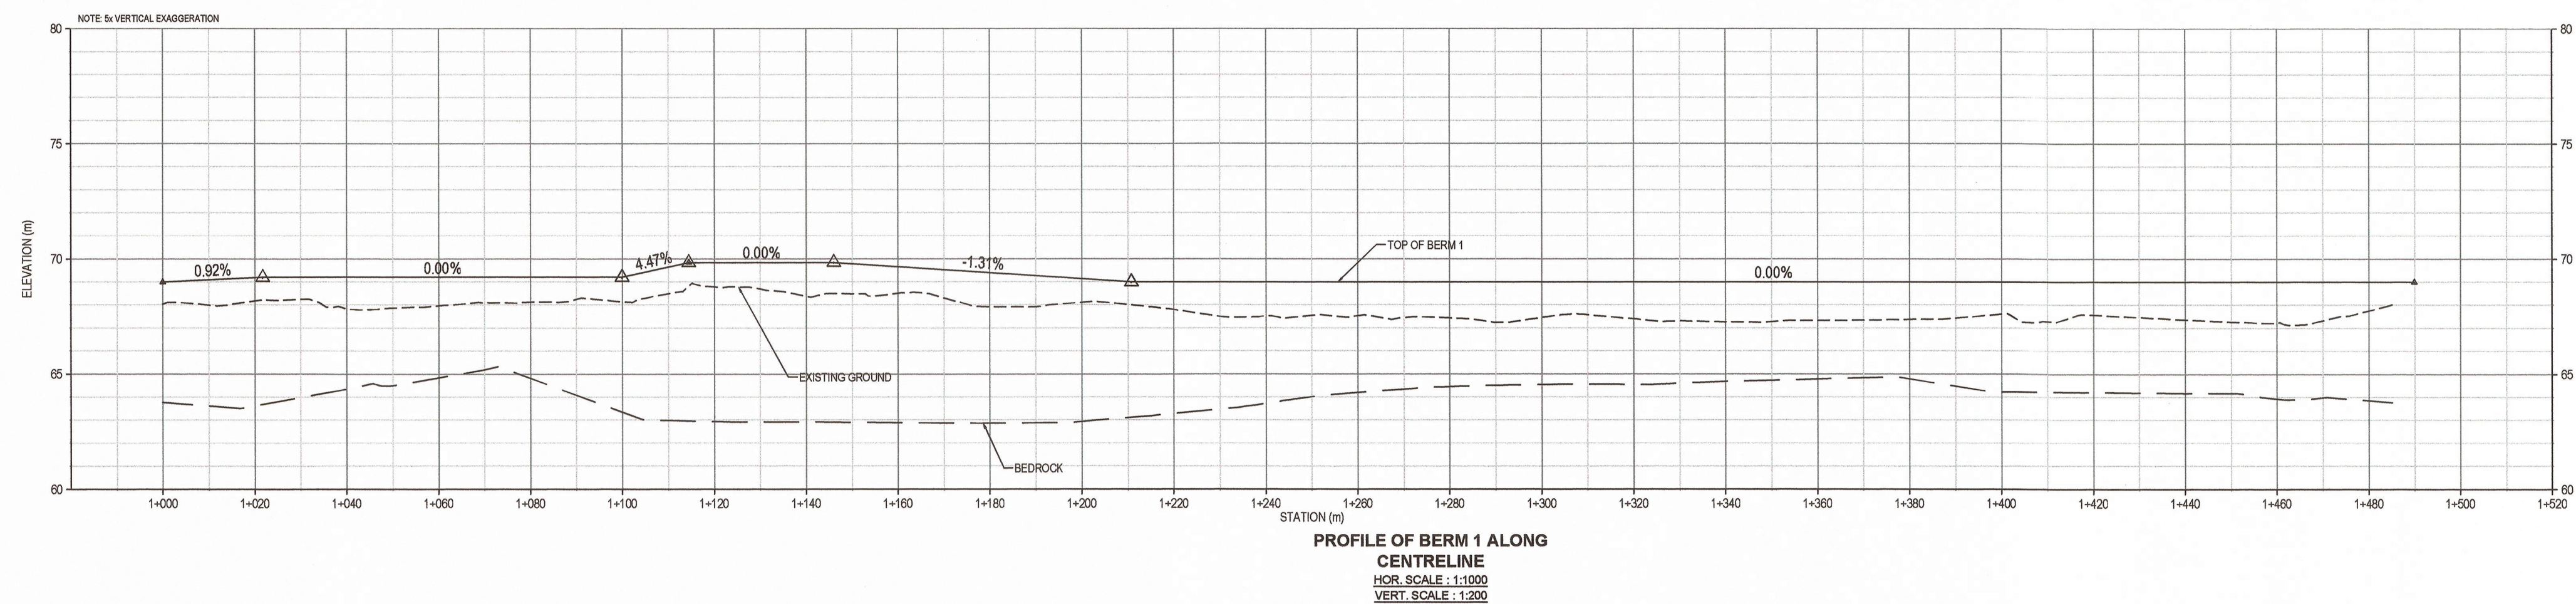

NOTES GÉNÉRALES / GENERAL NOTES

**POUR CONSTRUCTION
FOR CONSTRUCTION**
DATE : 2017-02-17

INFORMATION O-CONTAINE EST LA PROPRIÉTÉ DE AGNICO EAGLE LTD. ET DOIT ÊTRE RETENUE PAR AGNICO EAGLE. Toute information ou
PROJET, TOUTE INFORMATION DE CONCEPT À AUTRE ET TOUTE UTILISATION AUTRE QUE CELLE POUR LAQUELLE L'INFORMATION EST PRÉPARÉE
AGNICO EAGLE LTD.

DESIGNS EN REFERENCE / REFERENCE DRAWINGS

TITLE / TITRE	# DWG



REV.	DATE	DESCRIPTION	PAR/APP.	APP. CLIENT
0	2017-02-17	ISSUED FOR CONSTRUCTION	P.J.H.	J.A.
A	2017-02-13	ISSUED FOR COMMENTS	P.J.H.	J.A.

PERMIT TO PRACTICE
TETRA TECH INDUSTRIES, INC.

O/A TETRA TECH

Signature: *J.M.F. Alarie*

Date: 2017-02-17

PERMIT NUMBER: P 1029

ITANU Association of Professional Engineers and Geoscientists

2017-02-17

TITLE / TITRE
AGNICO EAGLE - MELADINE DIVISION
695 - WATER MANAGEMENT
230 - GENERAL EARTH WORKS
BERM #1
LAYOUT PLAN AND PROFILE

DESIGNER
DRAWN BY: PATRICK HAMEL

DATE
2017-02-17

VERIFIER
CHECKED BY: MELANIE YIP WOON SUN

DATE
2017-02-17

APPROVED BY: JOSÉE ALARIE



DATE
2017-02-17

SCALE
AS INDICATED

DATE
2016-09-15

NO. DESIGN
DRAWING NO. 65-695-230-219

NO. PROJECT PROJECT NO.	REVISION	FEUILLE / SHEET
6515/28920	0	1 / 1

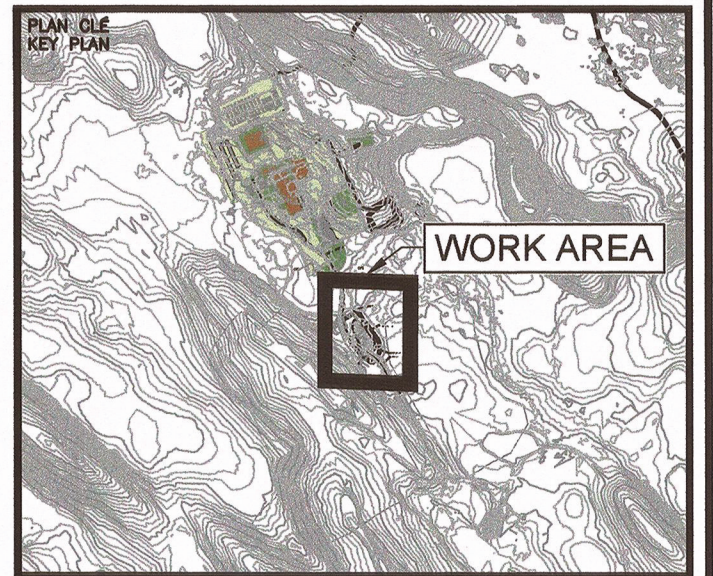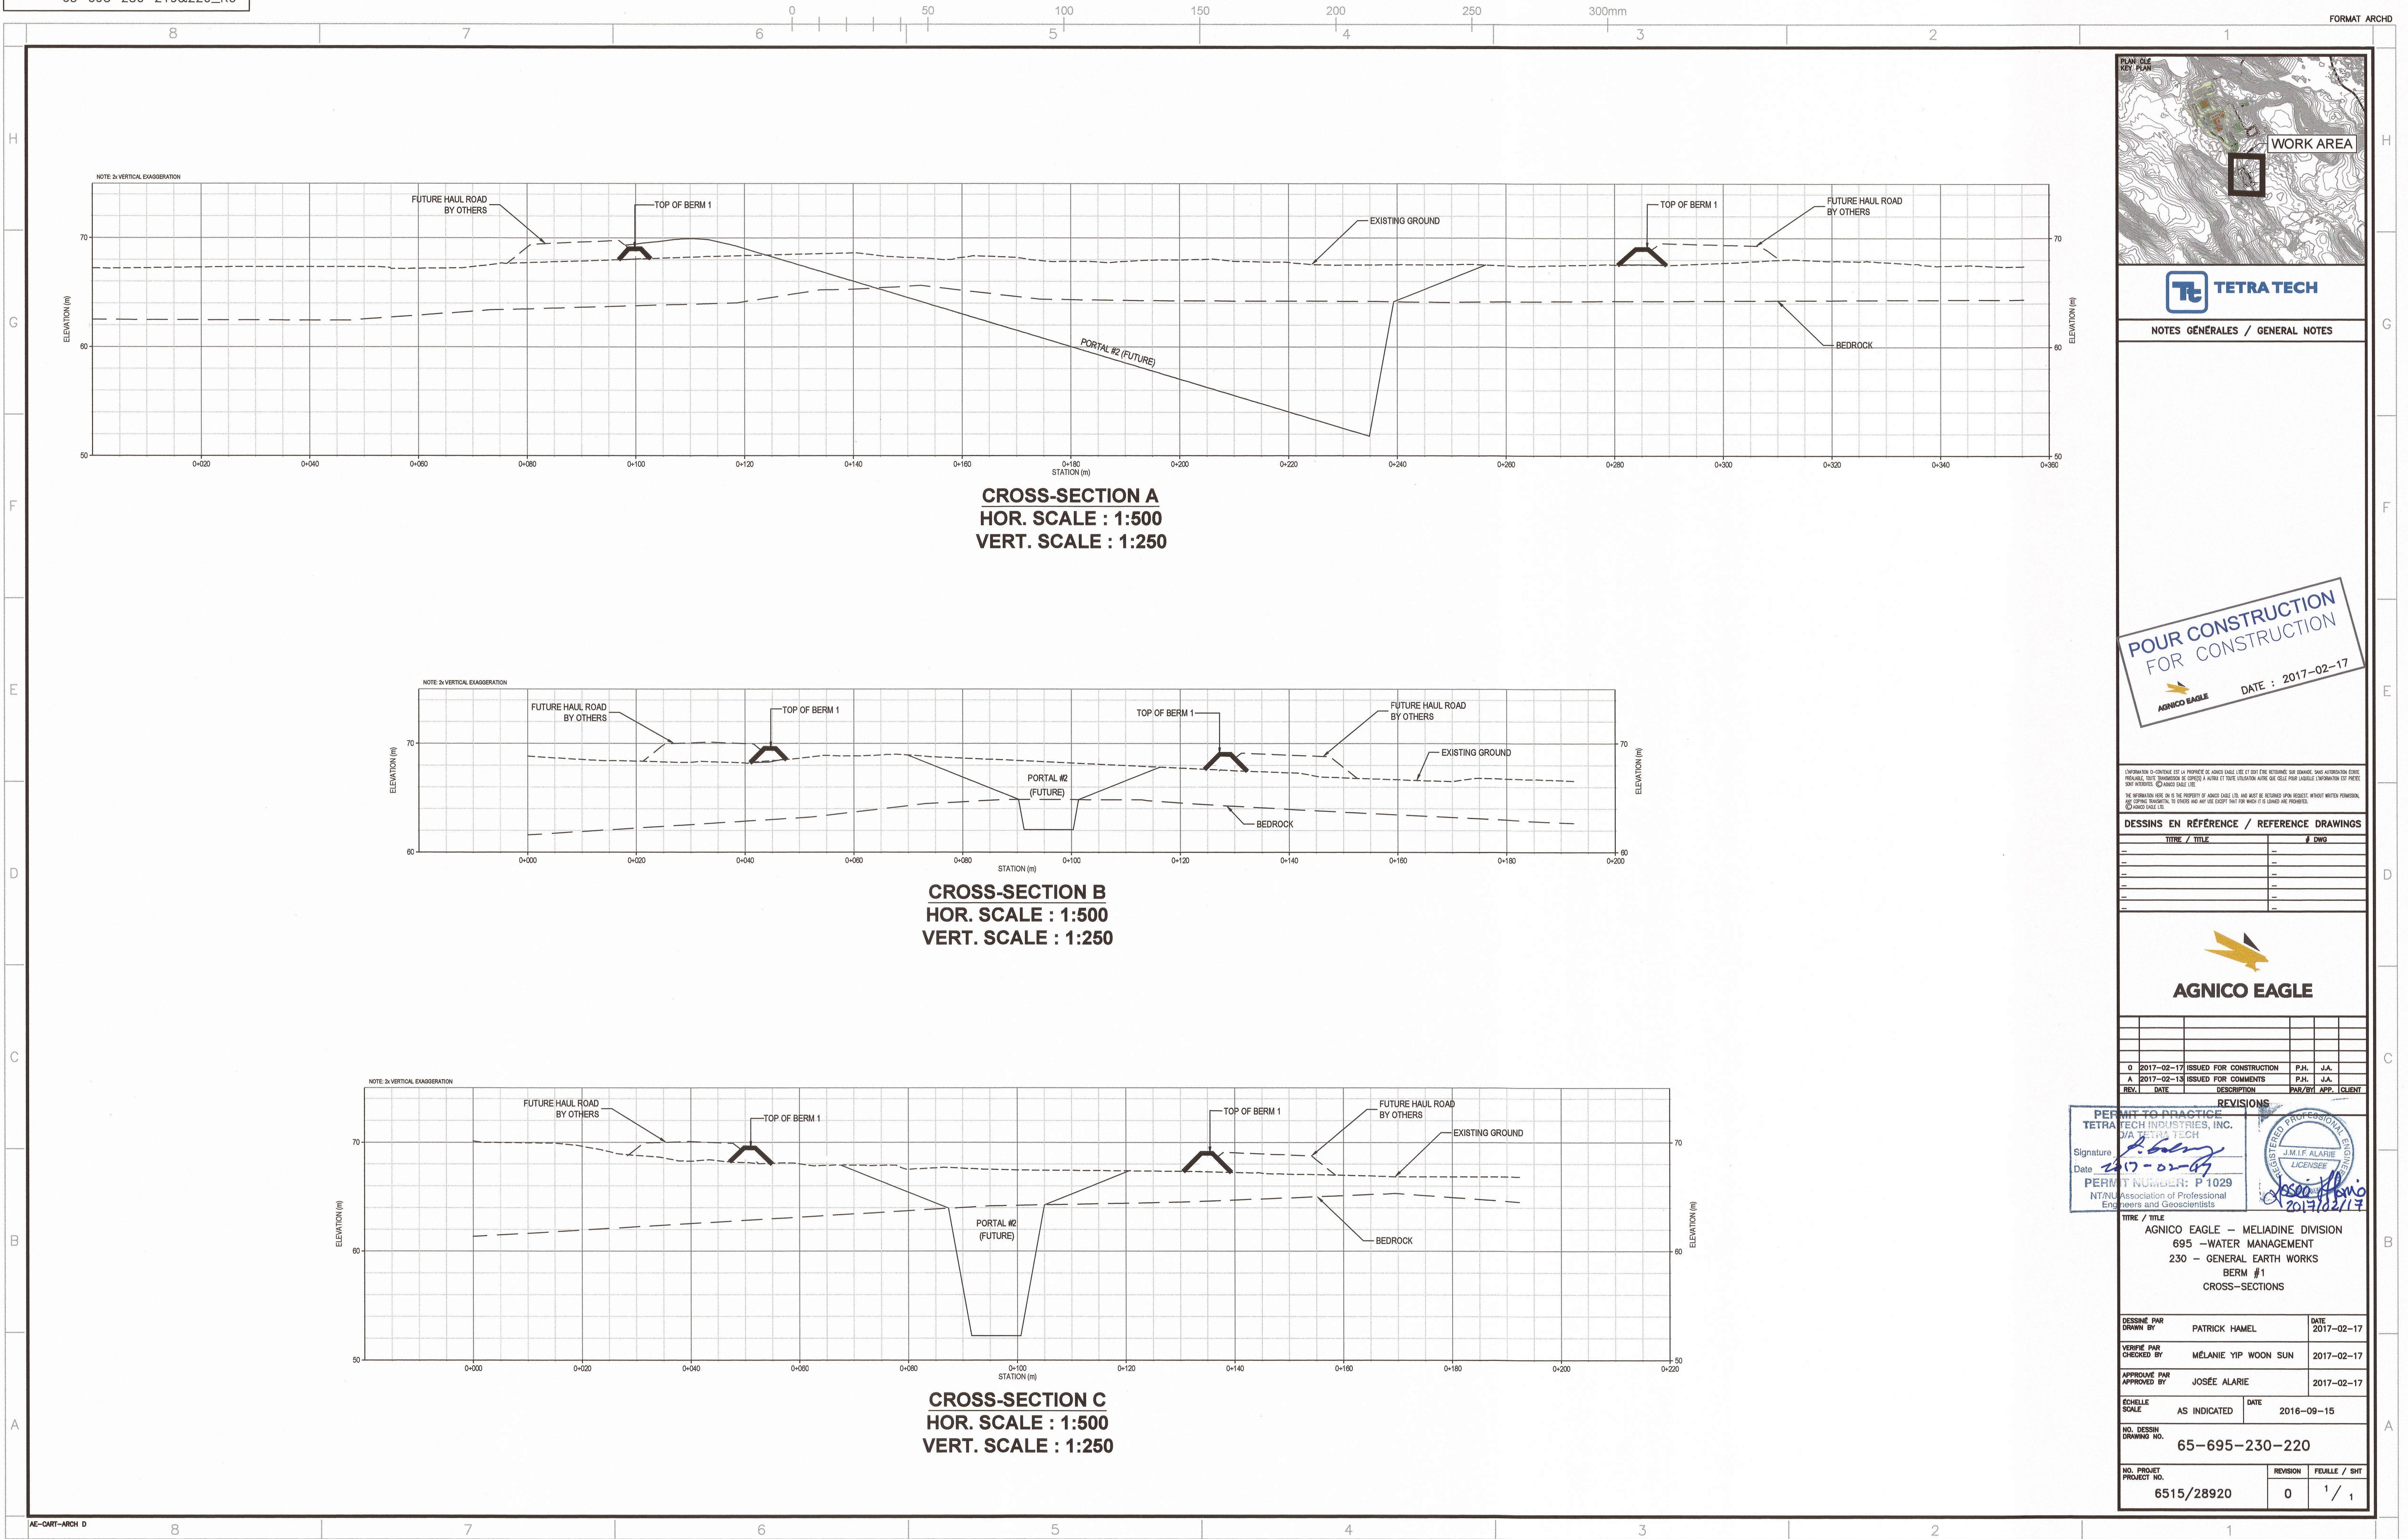

NOTES GÉNÉRALES / GENERAL NOTES



L'INFORMATION DONT CONTIENNE EST LA PROPRIÉTÉ DE AGNICO EAGLE LTD. ET NE DOIT ÊTRE RÉVÉLÉE À UN TIERS SANS AUTORISATION ÉCRITE PRÉALABLE. TOUTE RÉVÉLATION DE CÉLUI À AUTRE À TITRE D'EXEMPLE AUTRE QUE CELLE POUR LAQUELLE L'INFORMATION EST FOURNIE SERA INTERDITE. © AGNICO EAGLE LTD.


THE INFORMATION HERE ON IS THE PROPERTY OF AGNICO EAGLE LTD. AND MUST BE RETURNED UPON REQUEST WITHOUT WRITTEN PERMISSION. ANY FURTHER DISSEMINATION TO OTHERS AND ANY USE EXCEPT THAT FOR WHICH IT IS ISSUED ARE PROHIBITED. © AGNICO EAGLE LTD.

DESSINS EN RÉFÉRENCE / REFERENCE DRAWINGS

TITRE / TITLE	# DWG
--	--
--	--
REV.	DATE	DESCRIPTION	PAR/APP.	APP. CLIENT
0	2017-02-17	ISSUED FOR CONSTRUCTION	P.H.	J.A.
1	2017-02-17	ISSUED FOR COMMENTS	P.H.	J.A.

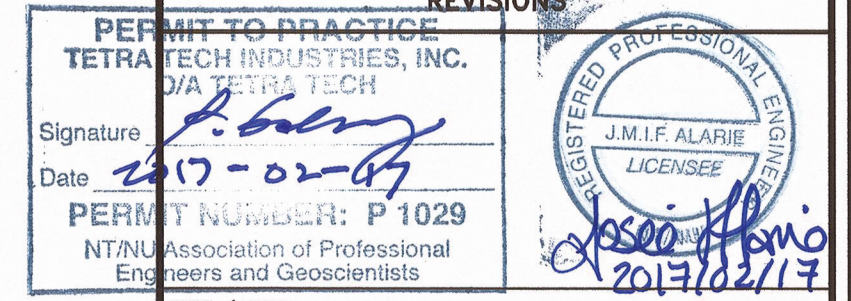

TITRE / TITLE
AGNICO EAGLE - MELIADINE DIVISION
695 - WATER MANAGEMENT
230 - GENERAL EARTH WORKS
BERM #1
CROSS-SECTIONS

DESSINÉ PAR DRAWN BY	PATRICK HAMEL	DATE 2017-02-17
VÉRIFIÉ PAR CHECKED BY	MÉLANIE YIP WOON SUN	2017-02-17
APPROUVÉ PAR APPROVED BY	JOSÉE ALARIE	2017-02-17

ÉCHELLE SCALE	AS INDICATED	DATE 2016-09-15
NO. DESSIN DRAWING NO.	65-695-230-220	
NO. PROJET PROJECT NO.	6515/28920	REVISION 0
		FEUILLE / SHEET 1 / 1

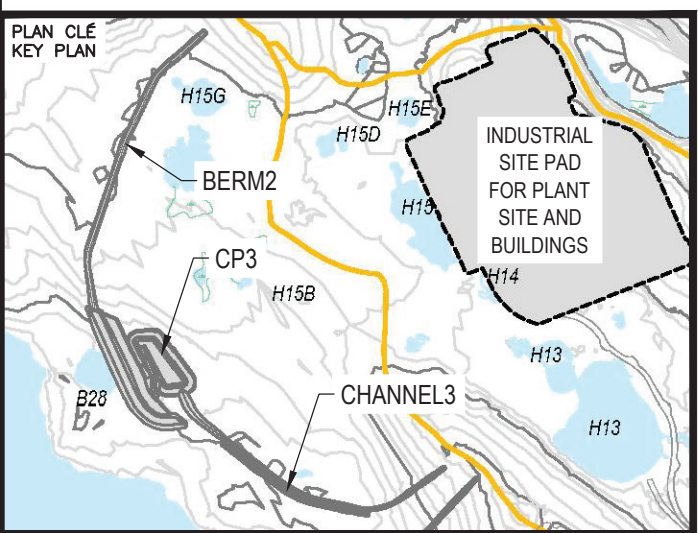

- PERMIT TO PRACTICE
TETRA TECH CANADA INC.

Signature

Date JUNE 21, 2018

PERMIT NUMBER: P 018
NT/NU Association of Professional
Engineers and Geoscientists

POUR CONSTRUCTION
FOR CONSTRUCTION

DATE : 2018-08-2

THE INFORMATION IS-CONTAINS IS THE PROPERTY OF ADNOC EAGLE LTD. AND MUST BE RETURNED UPON REQUEST, WITHOUT WRITTEN PERMISSION ANY COPYING, TRANSMISSION, TO OTHERS AND ANY USE EXCEPT THAT FOR WHICH IT IS LOANED ARE PROHIBITED.
© ADNOC EAGLE LTD.


DESSINS EN RÉFÉRENCE / REFERENCE DRAWING:

TITRE / TITLE	# DWG
—	—
—	—
0	2018-06-21	ISSUED FOR CONSTRUCTION	HX	WTH	
A.	2018-05-29	ISSUED FOR REVIEW	HX	WTH	
REV.	DATE	DESCRIPTION	PAR/BY	APP.	CLEN

REVISIONS

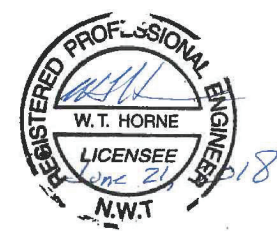

TITRE / TITLE	
1	1
2	2
3	3
100	100

BERM2
LAYOUT PLAN

DESSINÉ PAR	DATE
0000000000	0000000000

VERIFIÉ PAR CHECKED BY	HX	2018-06-
---------------------------	----	----------

APPROVED BY	WTH	2018-06-
-------------	-----	----------














SCALE	1:1000	2018-08-21
-------	--------	------------

65-695-230-245

NO. PROJ PROJECT NO.	REVISION	FEUILLE / SH
	0	10 / 13



SCALE: H-1:1000 V-1:100

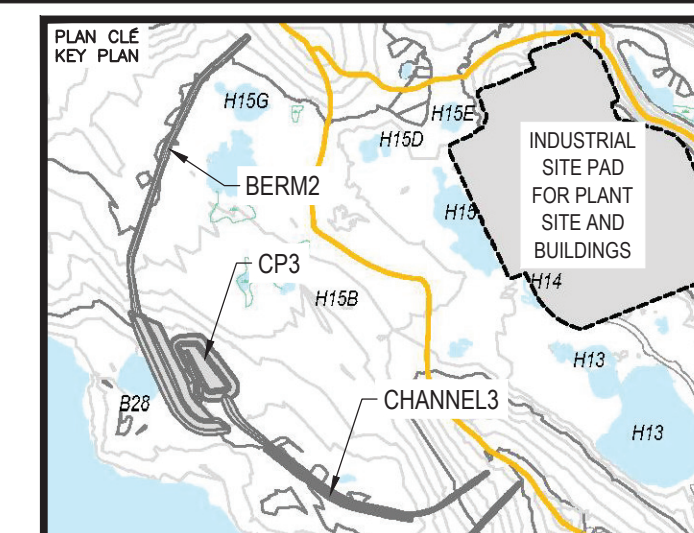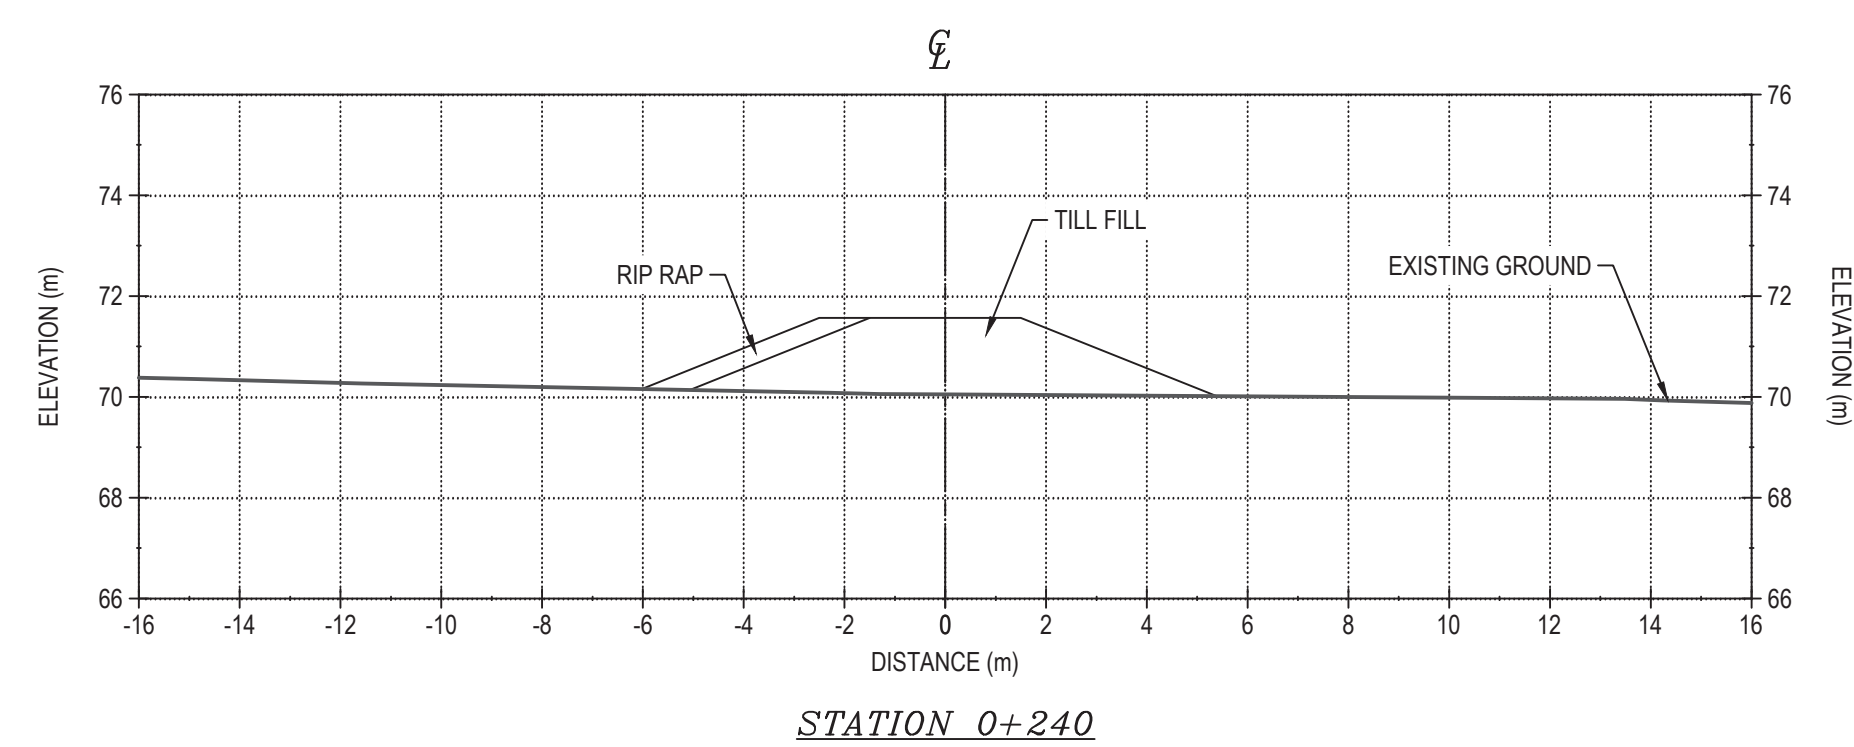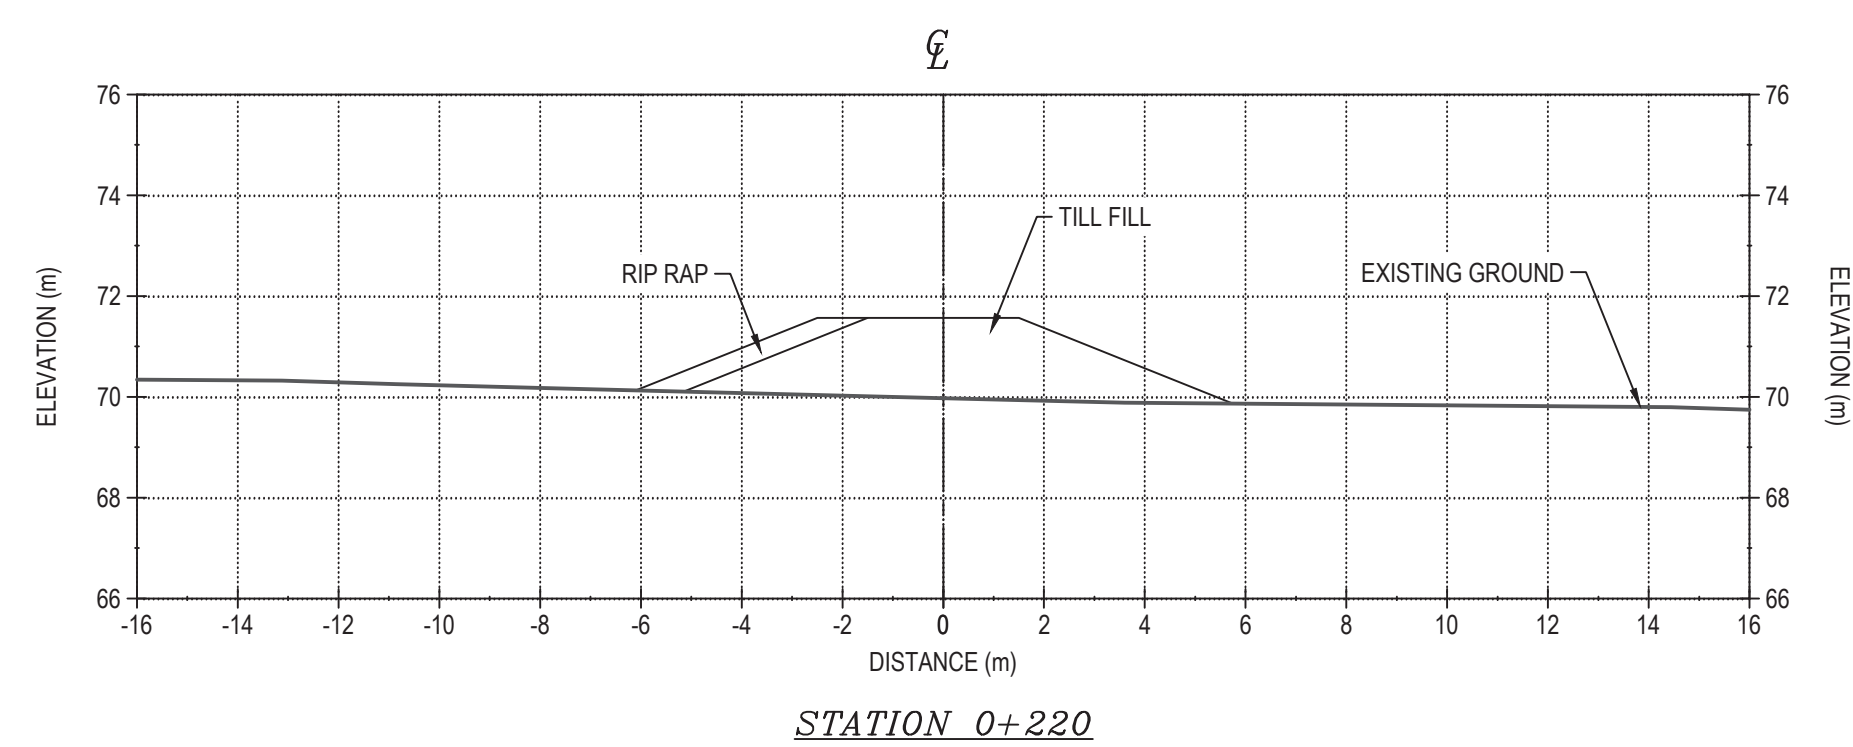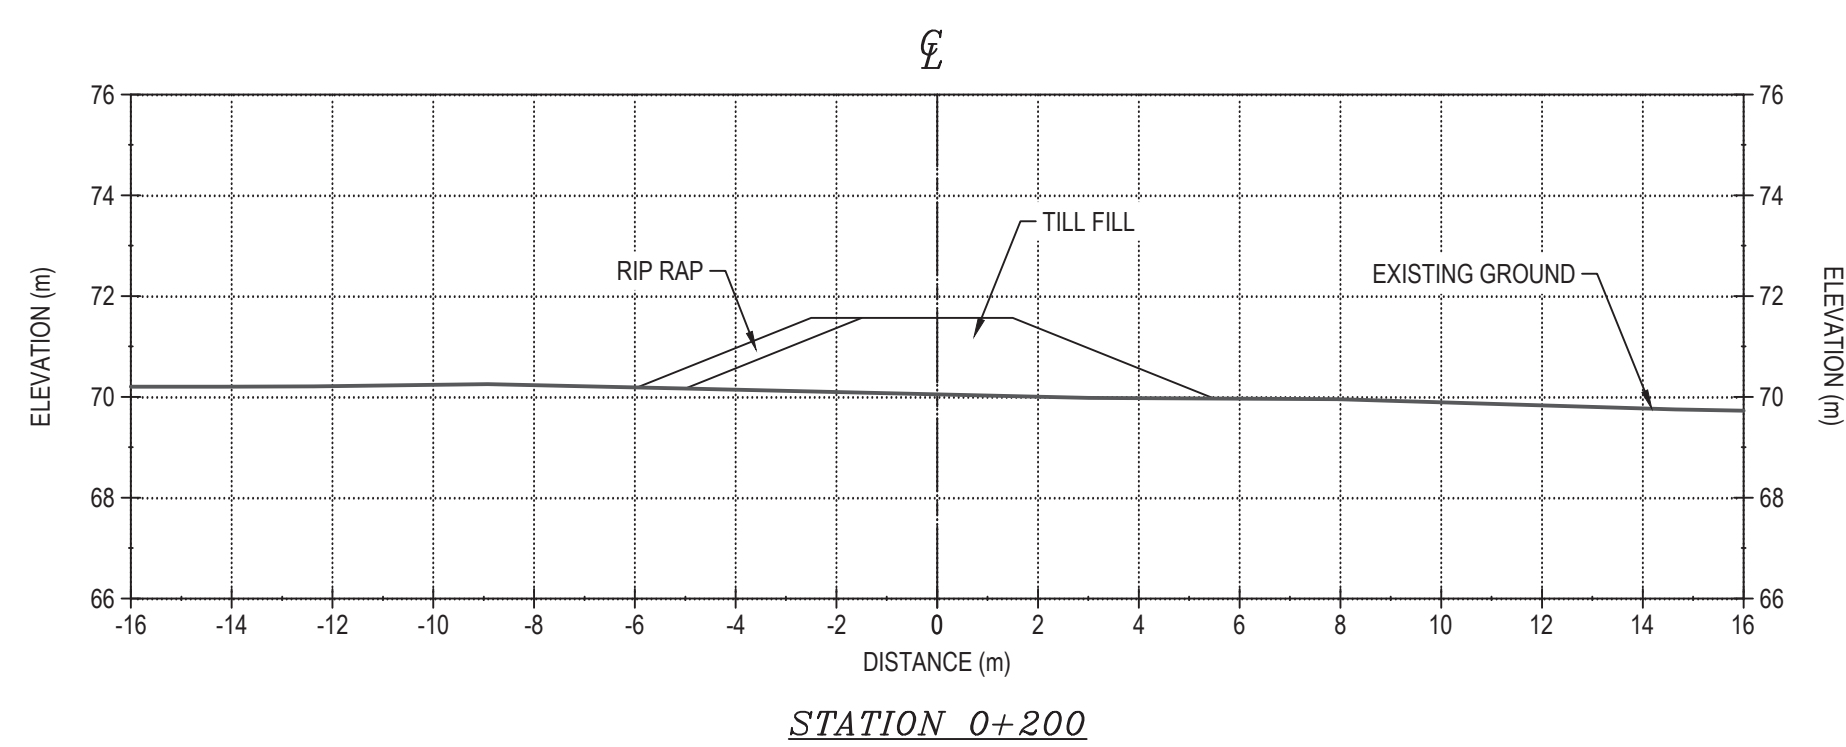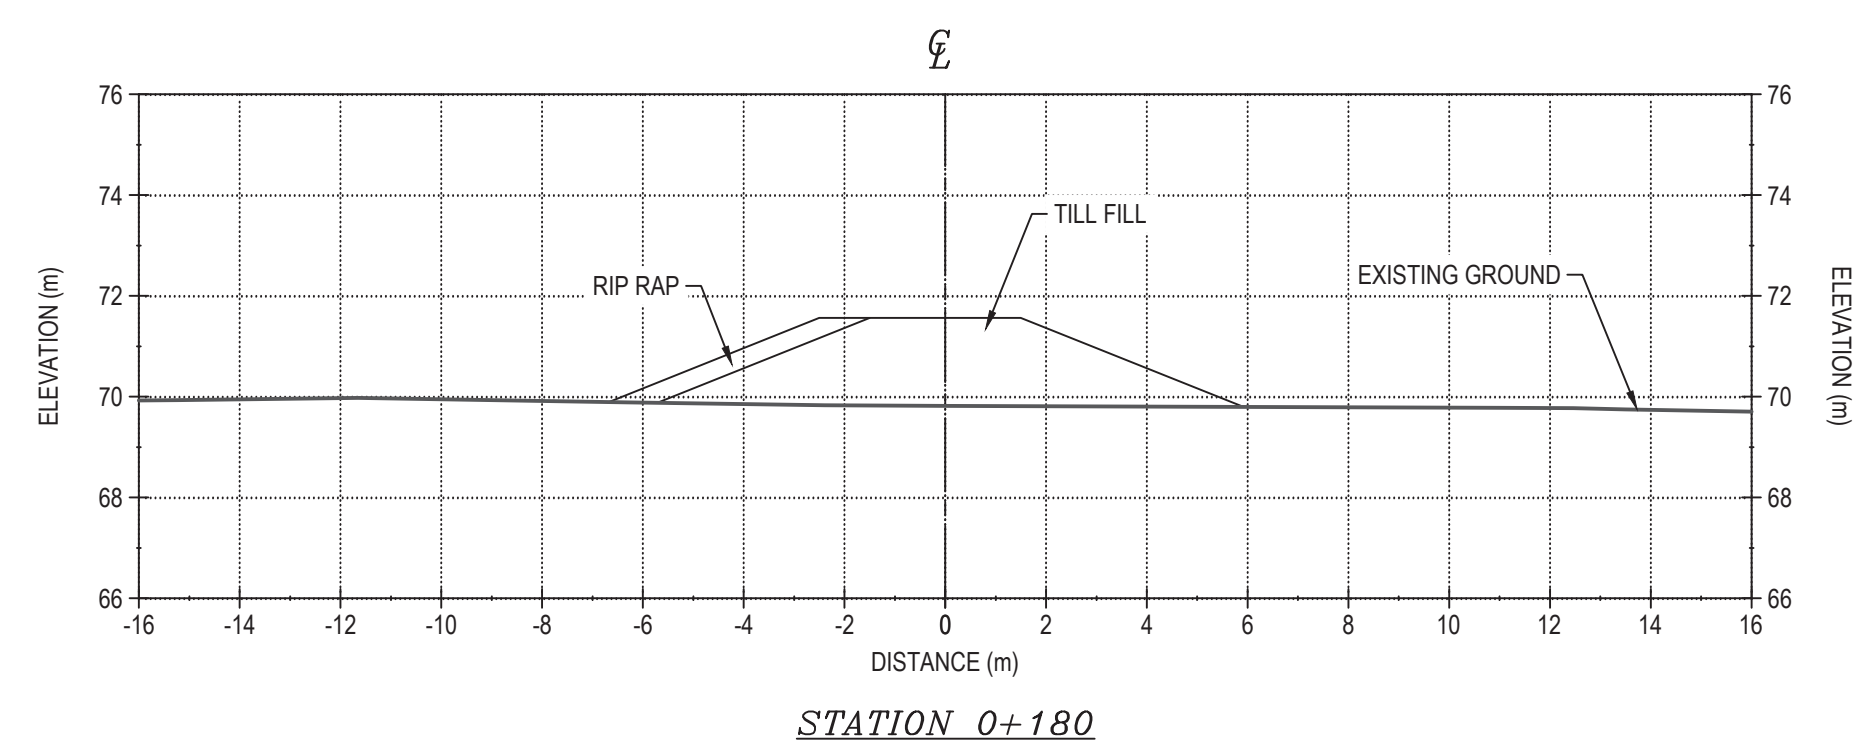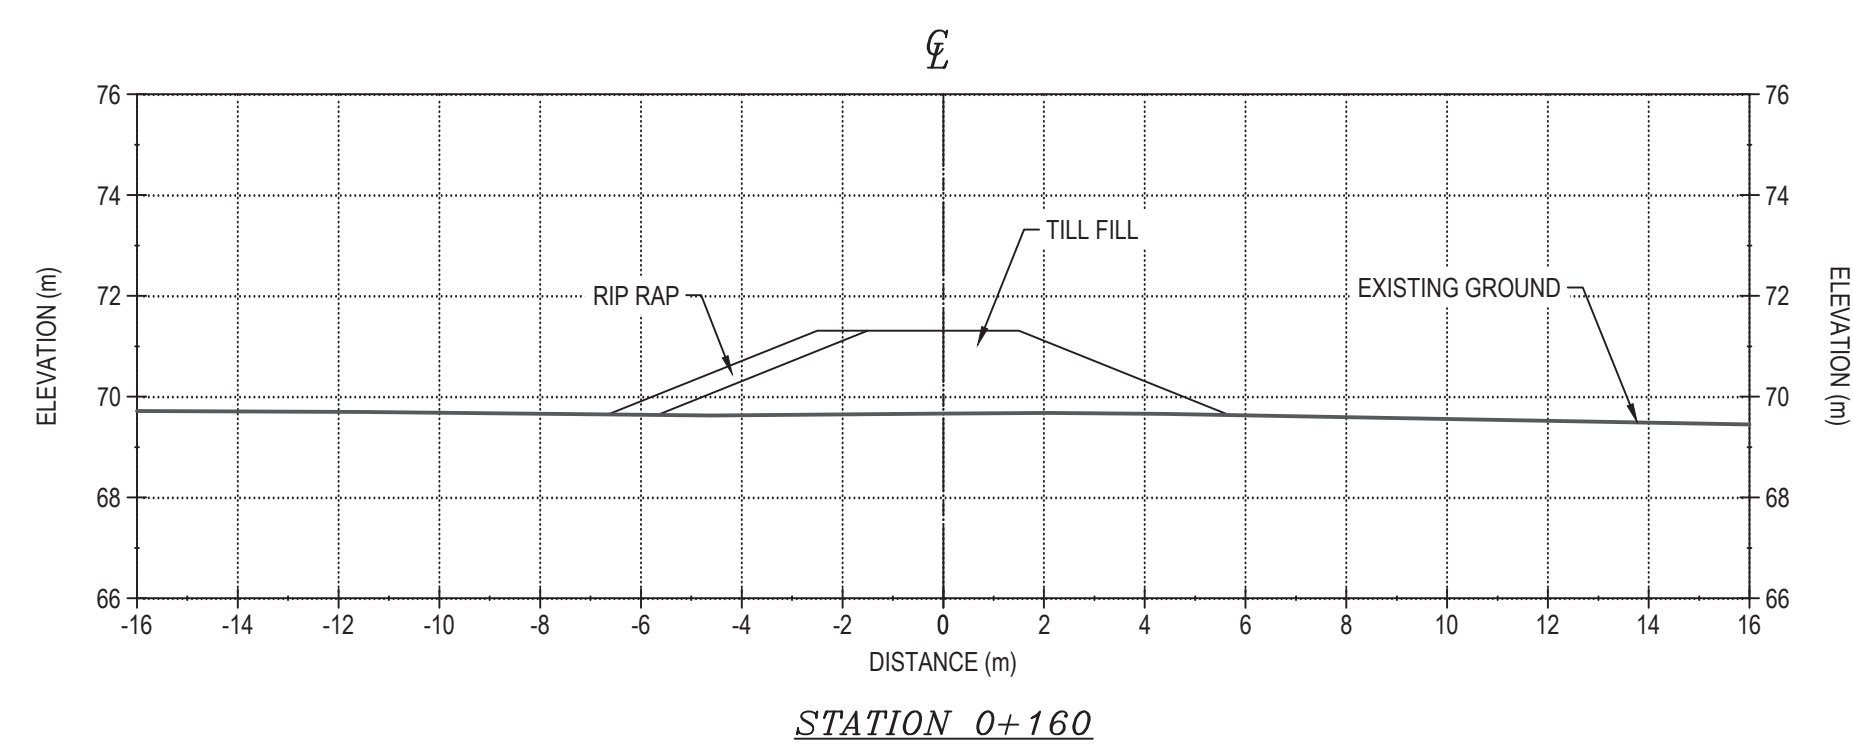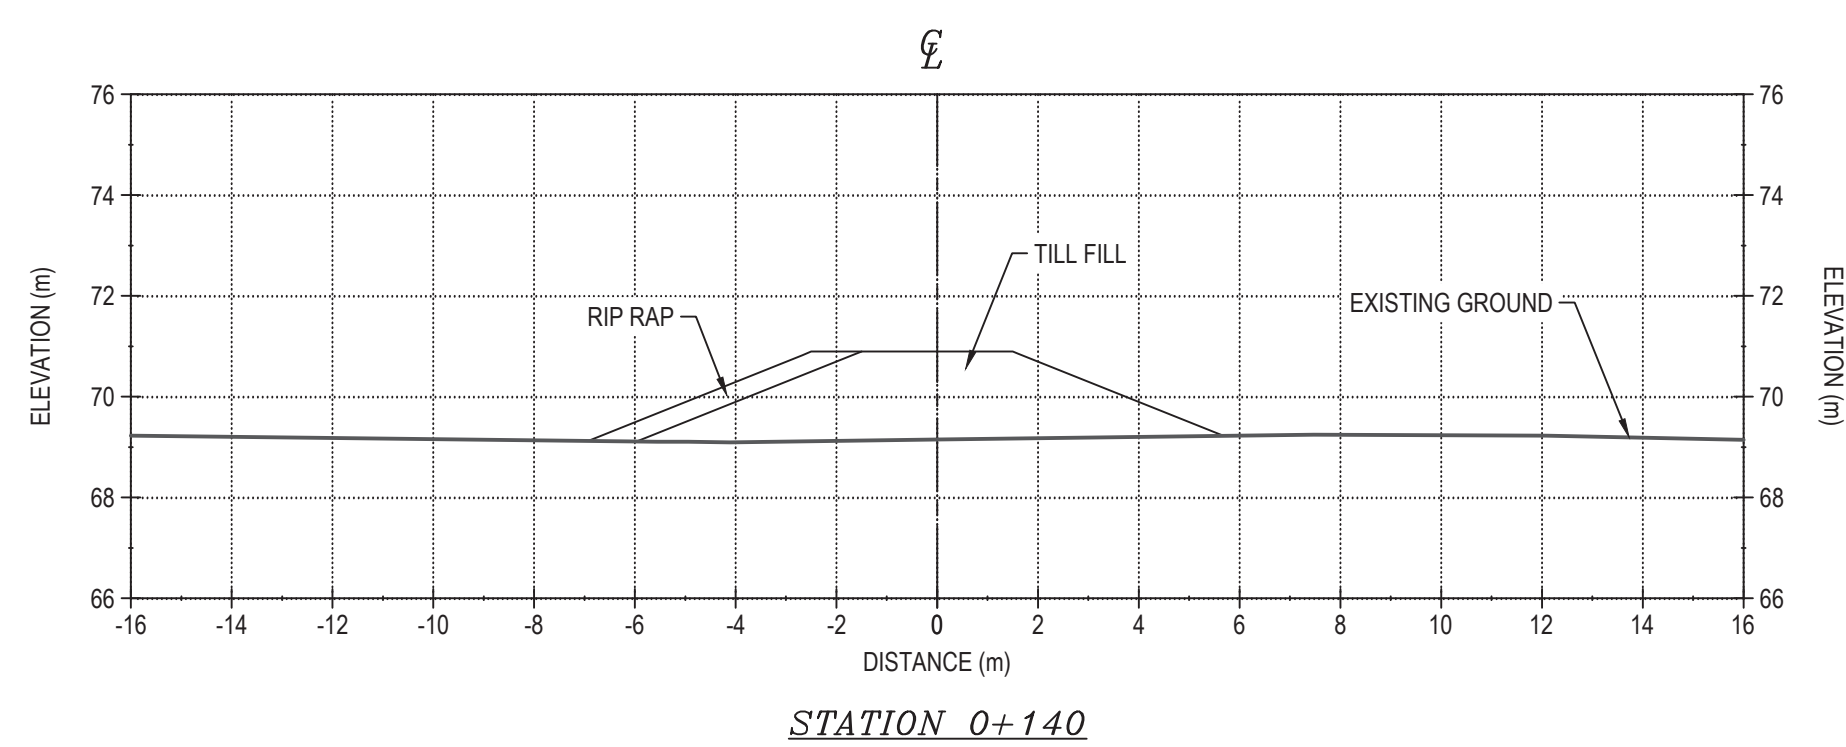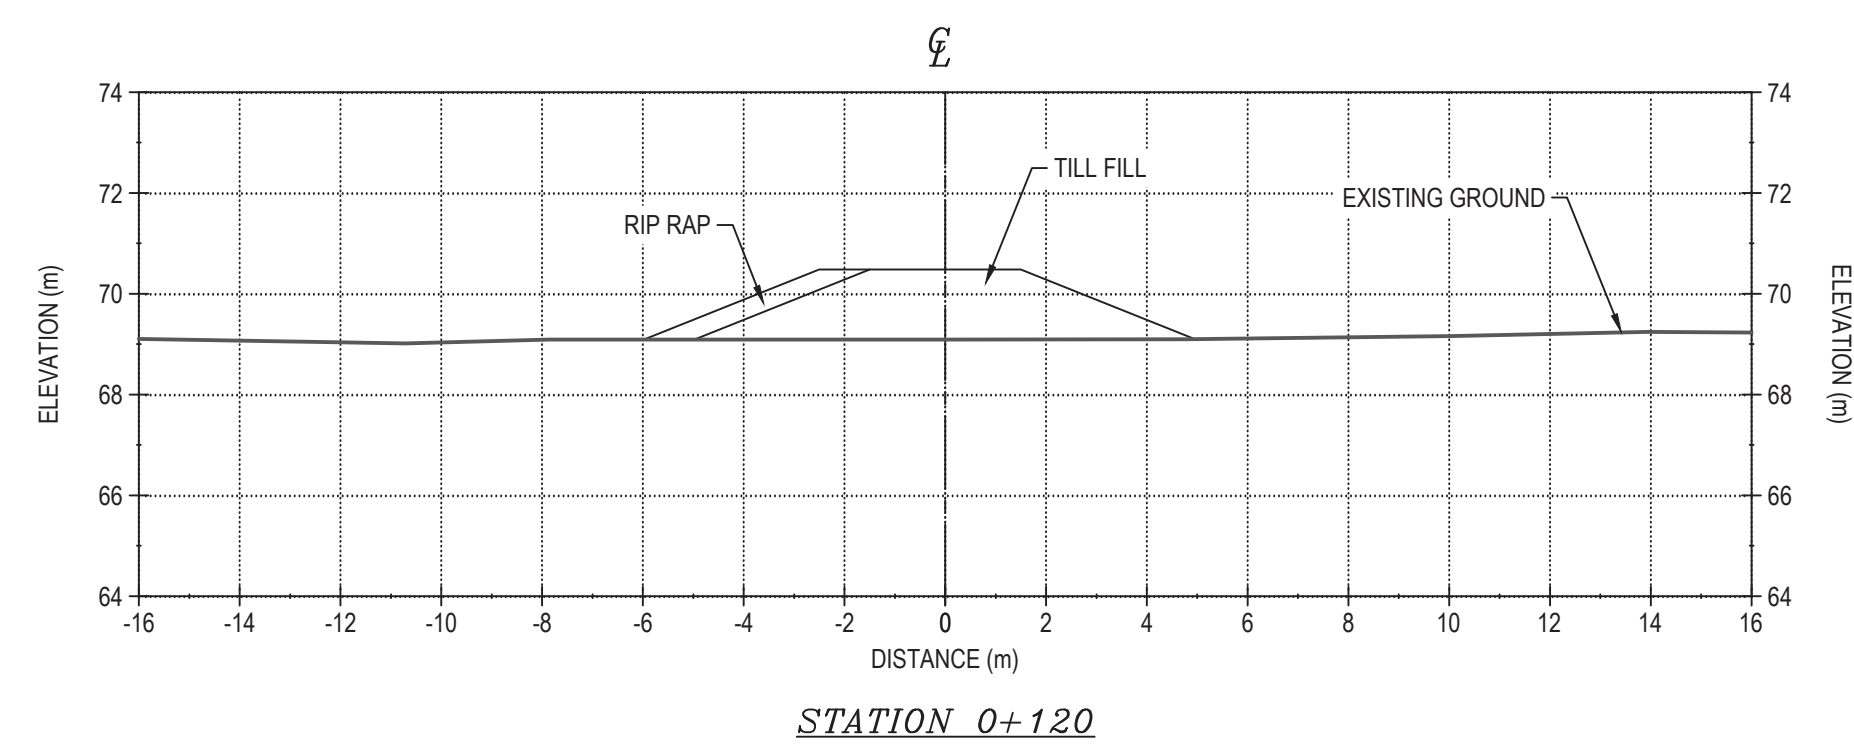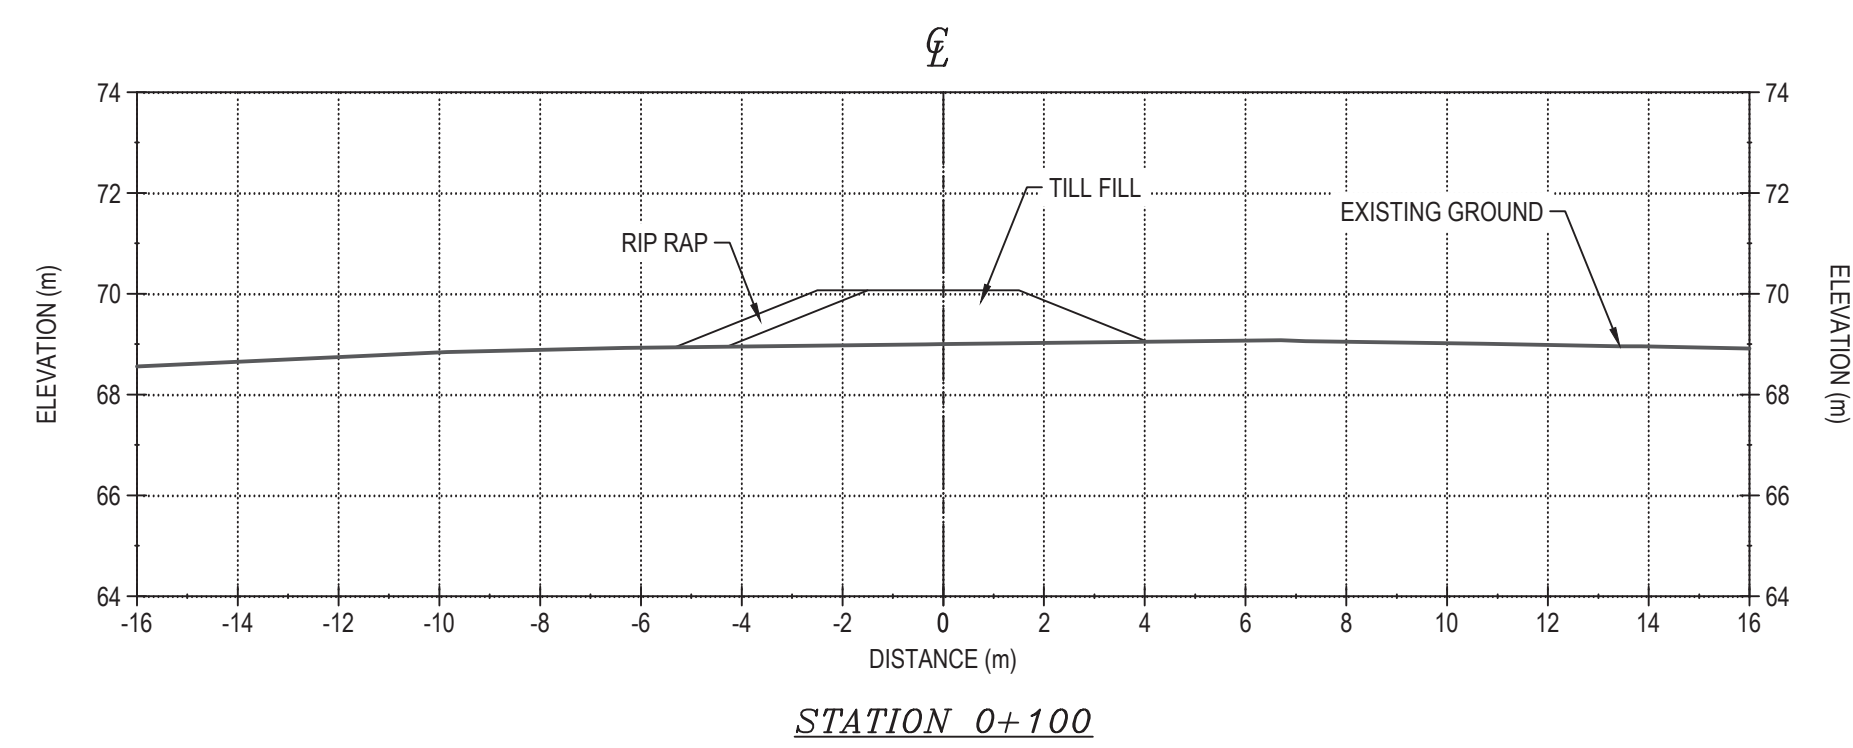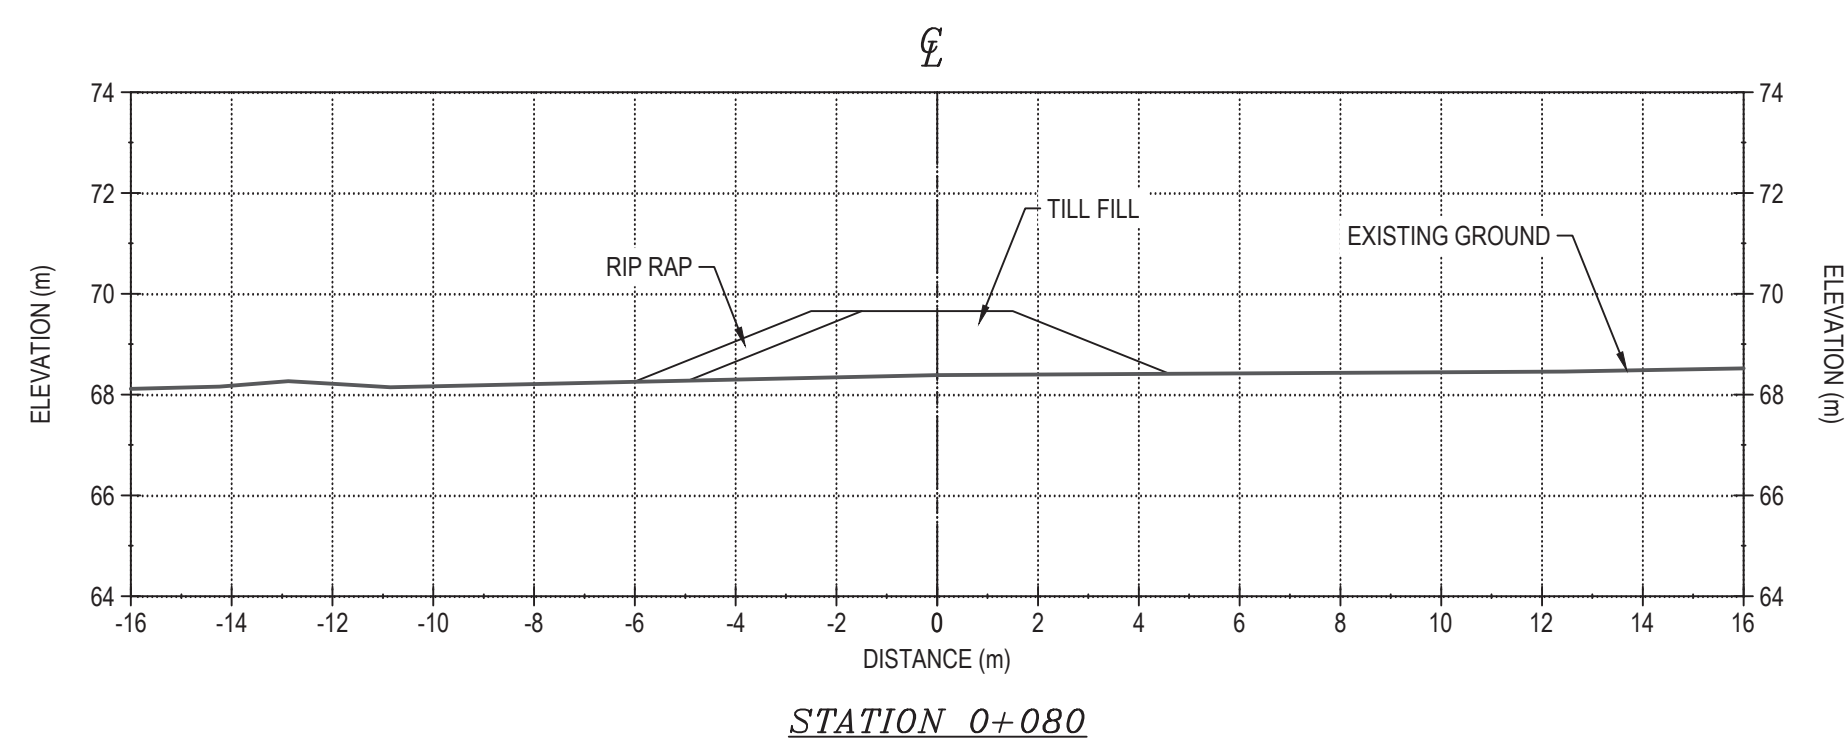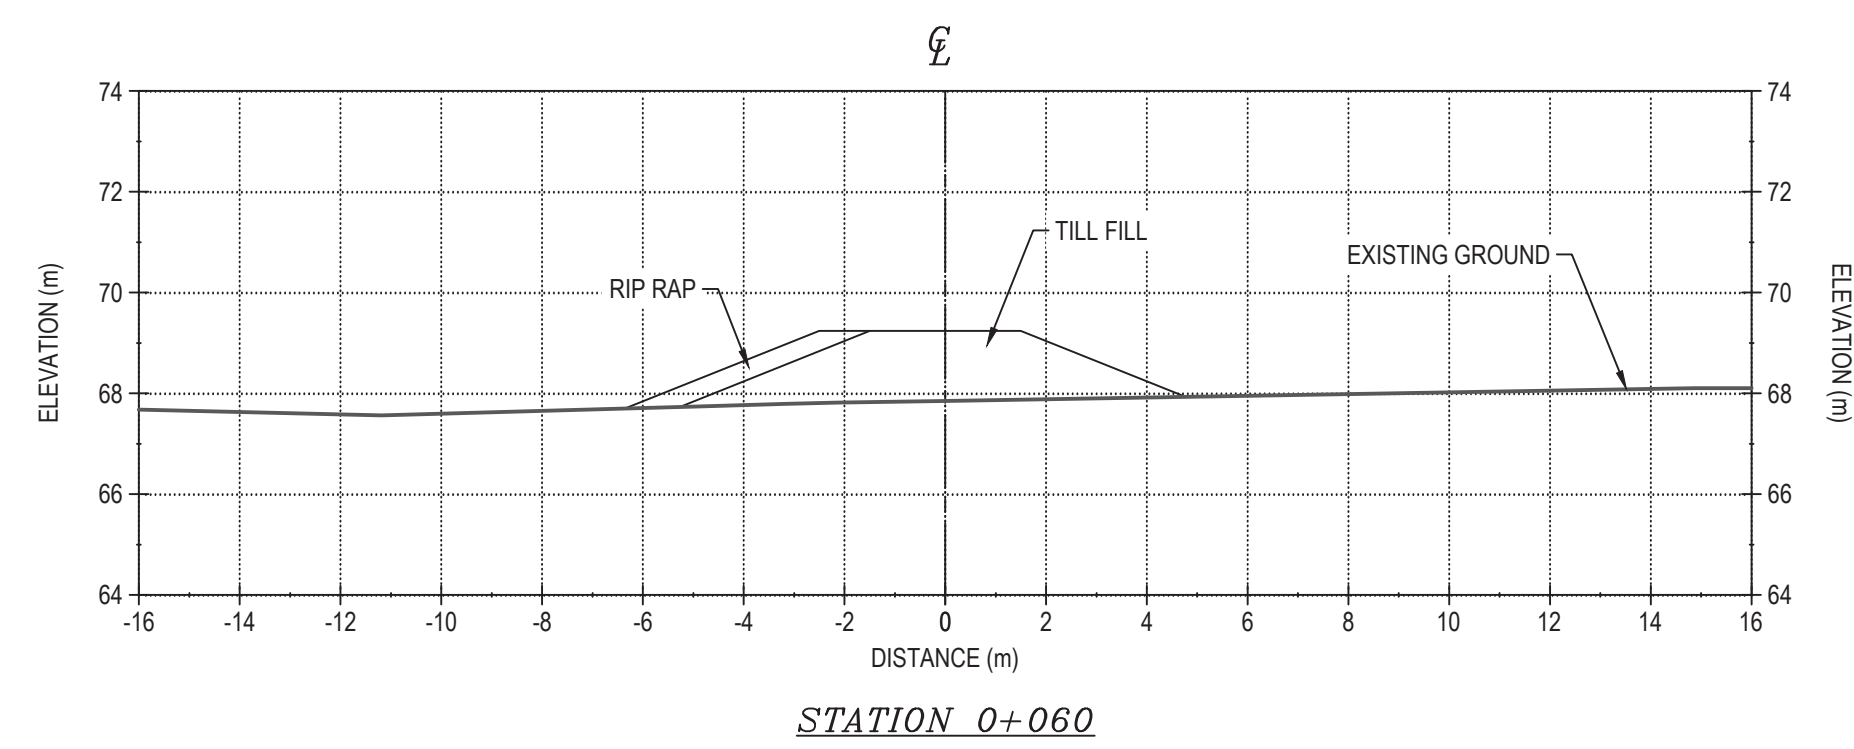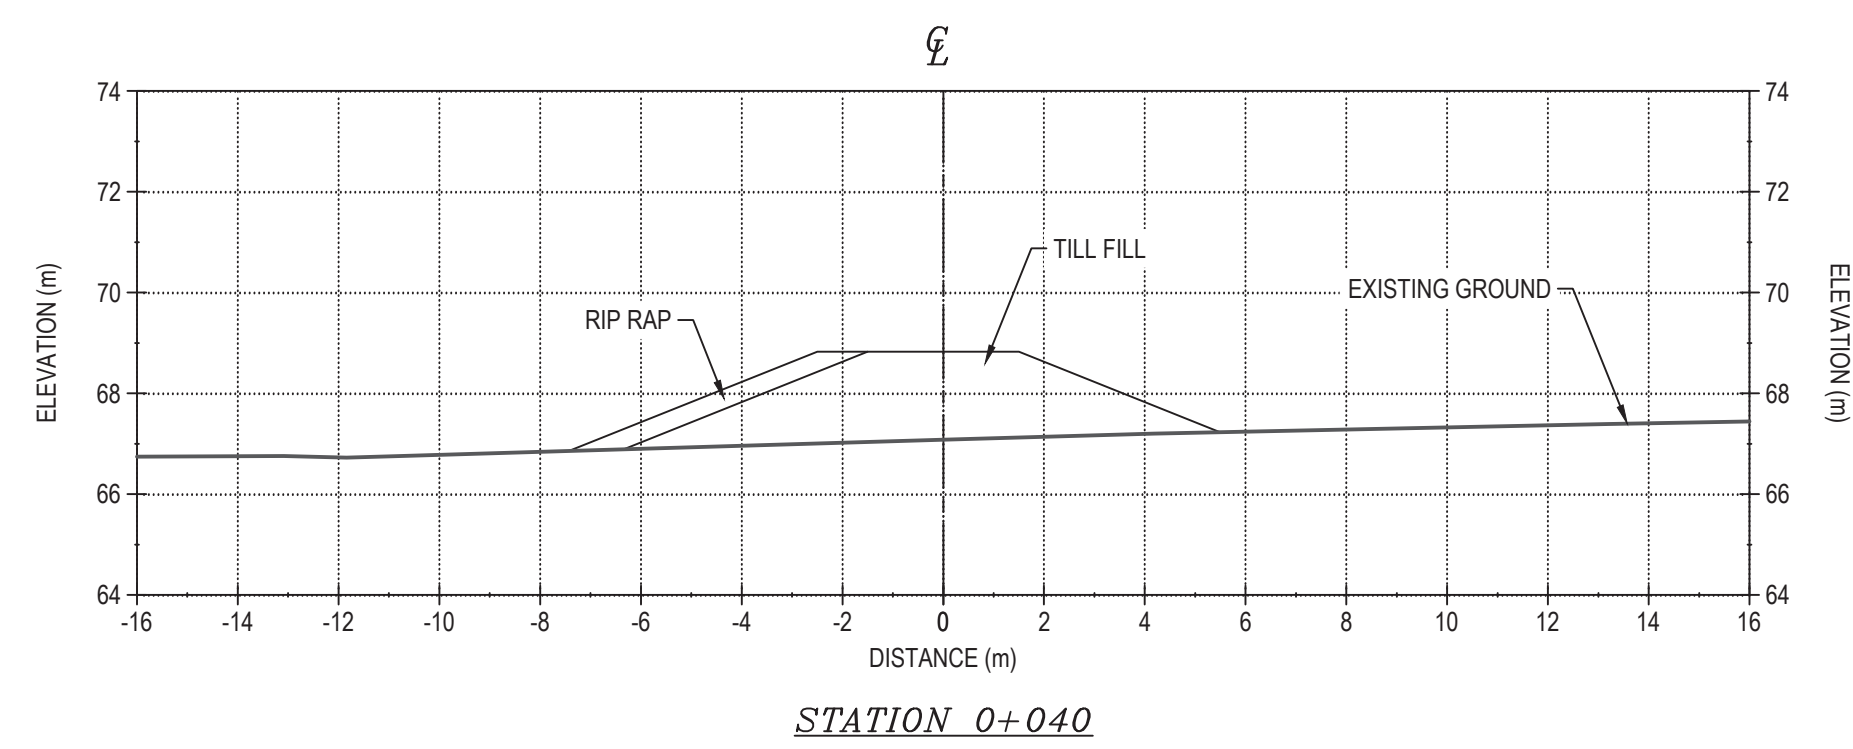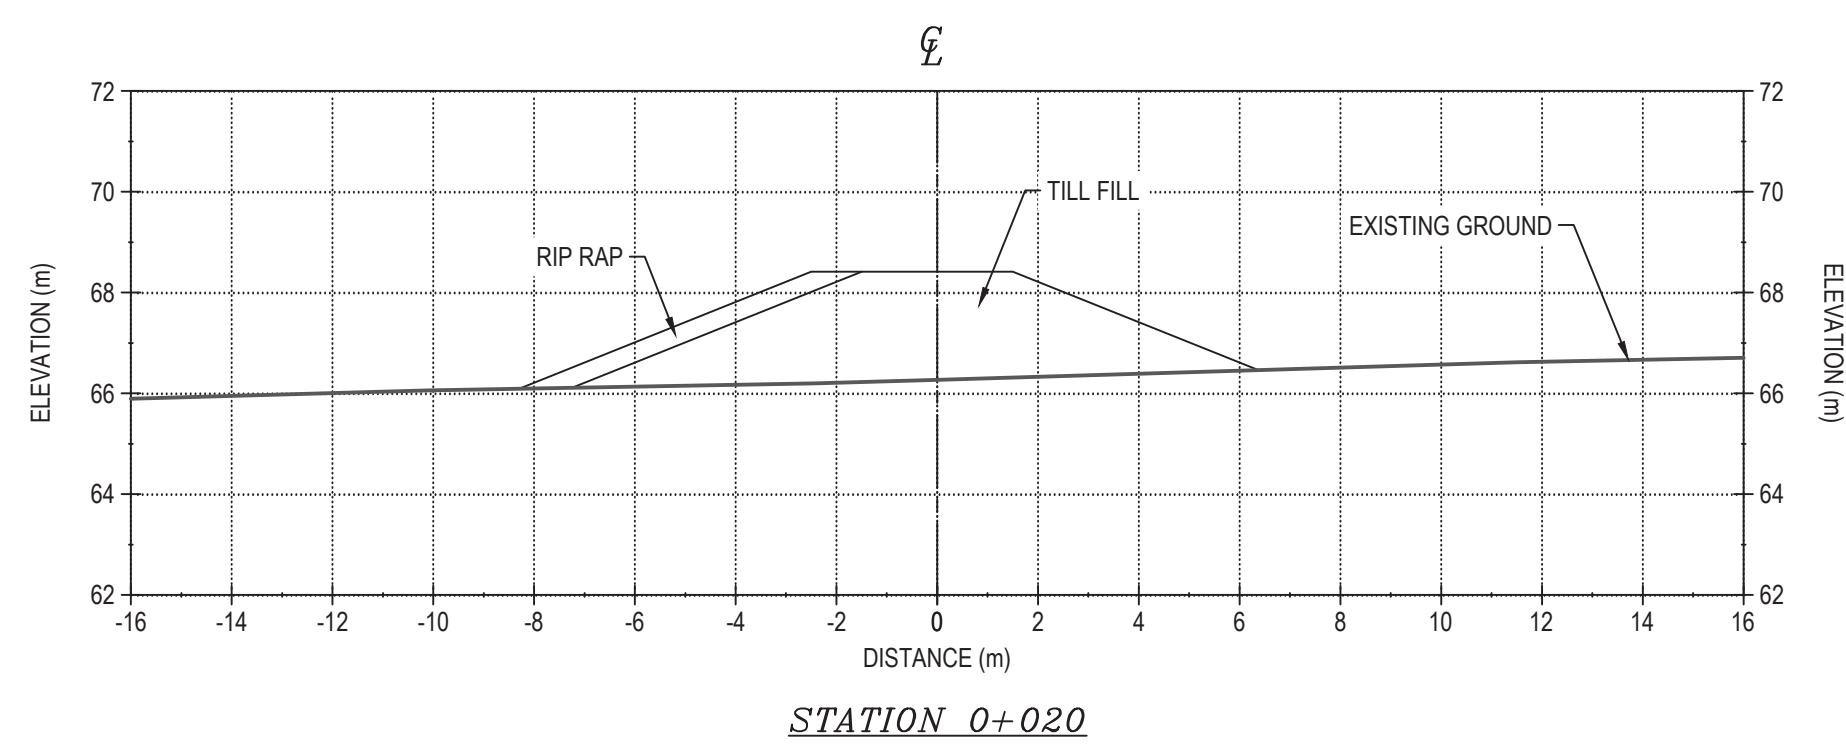

NOTES GÉNÉRALES / GENERAL NOTES

1. ASSUMED CONSTRUCTION SCHEDULE FOR CHANNEL3 FALL / WINTER 2018.
2. ASSUMED GEOTEXTILE THAT MEETS MATERIAL SPECIFICATION WILL BE AVAILABLE AT SITE FOR CHANNEL3 CONSTRUCTION.
3. MATERIAL PLACEMENT AND FOUNDATION PREPARATION SHOULD BE IN ACCORDANCE WITH THE REQUIREMENTS OF GEOTECHNICAL CONSTRUCTION / MATERIAL SPECIFICATIONS (TETRA TECH 2018).

**PERMIT TO PRACTICE
TETRA TECH CANADA INC.**

Signature [Signature]
Date JUNE 21, 2018

PERMIT NUMBER: P 018
NT/NU Association of Professional
Engineers and Geoscientists

POUR CONSTRUCTION
FOR CONSTRUCTION

ABNICO EABLE DATE : 2018-06-21

L'INFORMATION CI-CONTRE EST LA PROPRIÉTÉ DE AONCO EAGLE LTD. ELLE DOIT ÊTRE RETOURNÉE SUR DEMANDE, SANS AUTORISATION ET
PRÉALABLE, TOUTE REPRODUCTION DE COPIES À AUTRUI ET TOUTE UTILISATION AUTRE QUE CELLE POUR LAQUELLE L'INFORMATION EST PRÉ-
SENTÉE INTERDIT. (C) AONCO EAGLE LTD.

THE INFORMATION HERE ON IS THE PROPERTY OF AONCO EAGLE LTD. AND MUST BE RETURNED UPON REQUEST, WITHOUT WRITTEN PERMIS-
SION. ANY COPYING, TRANSMISSION TO OTHERS AND ANY USE EXCEPT THAT FOR WHICH IT IS LOANED ARE PROHIBITED.
(C) AONCO EAGLE LTD.

DESSINS EN RÉFÉRENCE / REFERENCE DRAWING

TITRE / TITLE	# DWG
--	--
--	--
AGNICO EAGLE

0	2018-06-21	ISSUED FOR CONSTRUCTION	HX	WTH	
A	2018-05-29	ISSUED FOR REVIEW	HX	WTH	
REV.	DATE	DESCRIPTION	PAR/BY	APP.	CLIP

REVISIONS

REVISIONS

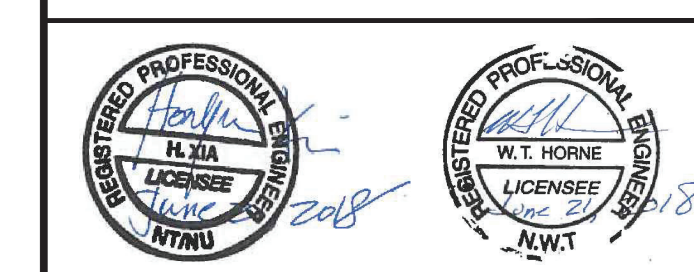














TITRE / TITLE	AGNICO EAGLE MELIADINE GOLD PROJECT
---------------	-------------------------------------

BERM2 DESIGN SECTIONS
(1 of 3)

DESSINÉ PAR DRAWN BY	EL	DATE	2018-06-21
VÉRIFIÉ PAR CHECKED BY	HX	DATE	2018-06-21
APPROUVÉ PAR APPROVED BY	WTH	DATE	2018-06-21
ÉCHELLE SCALE	1:150	DATE	2018-06-21

NO. DESSIN
DRAWING NO. 65-695-230-246-1

NO. PROJ PROJECT NO.	REVISION	FEUILLE /
6515	0	11 / 13

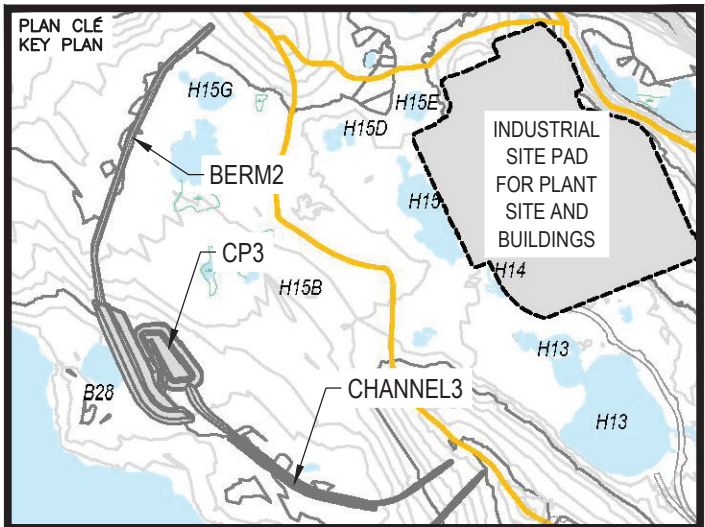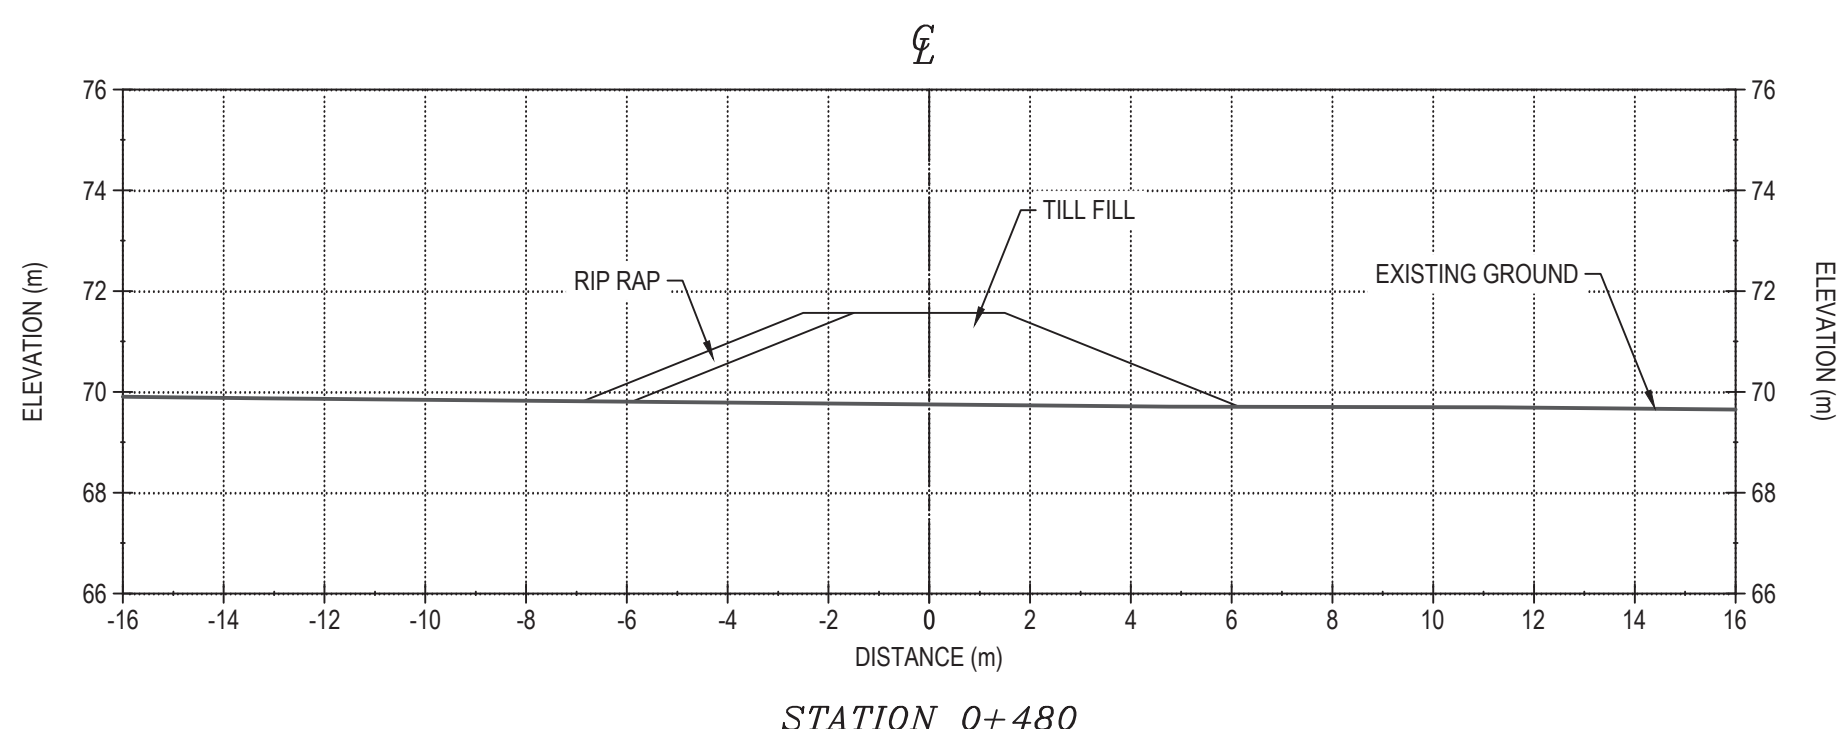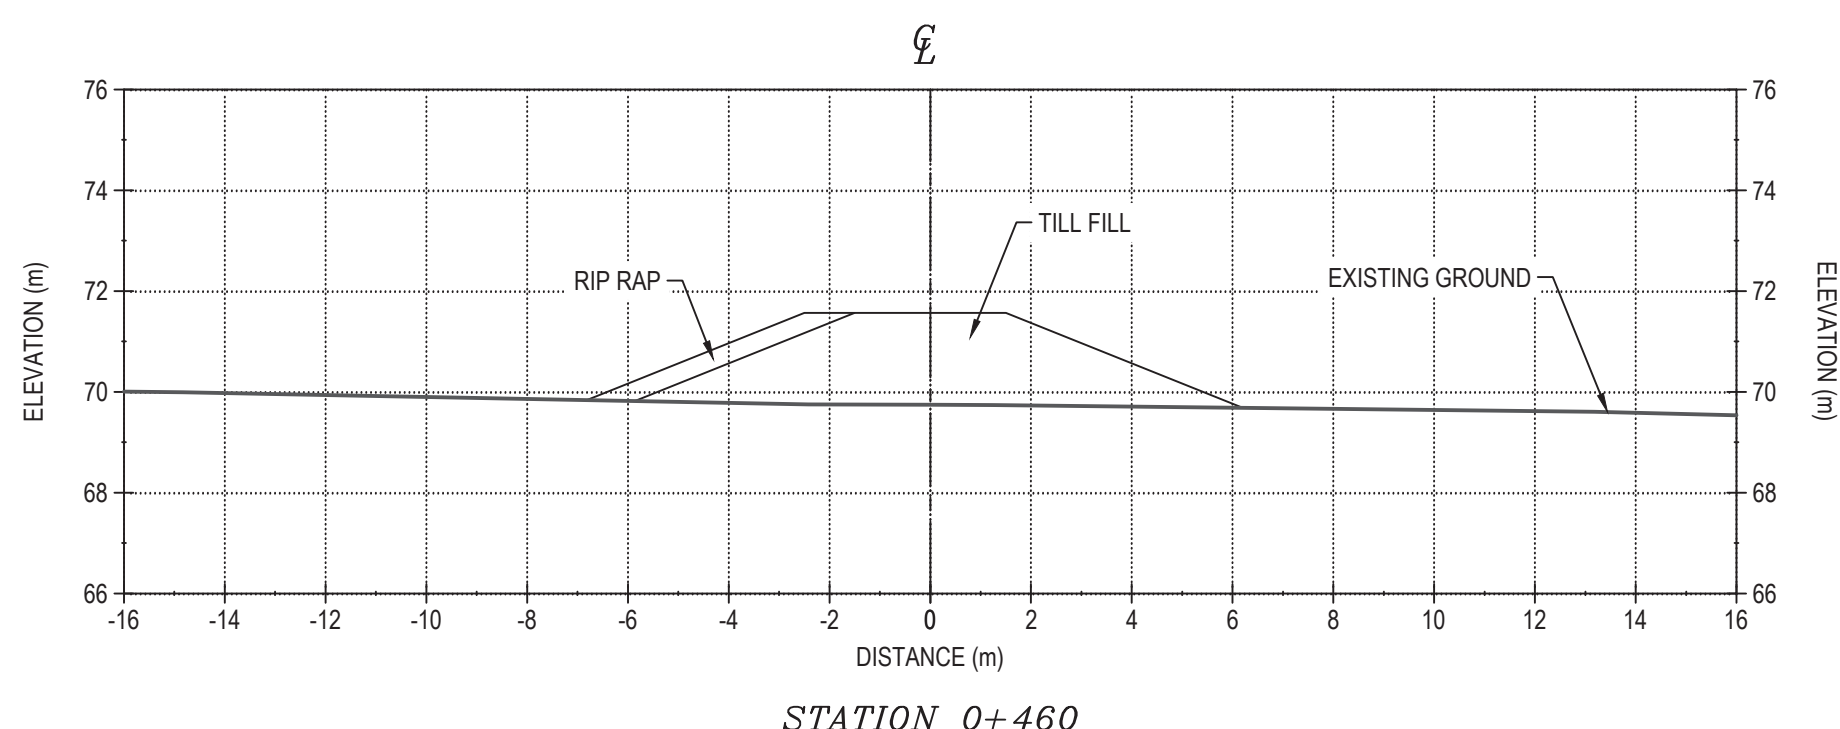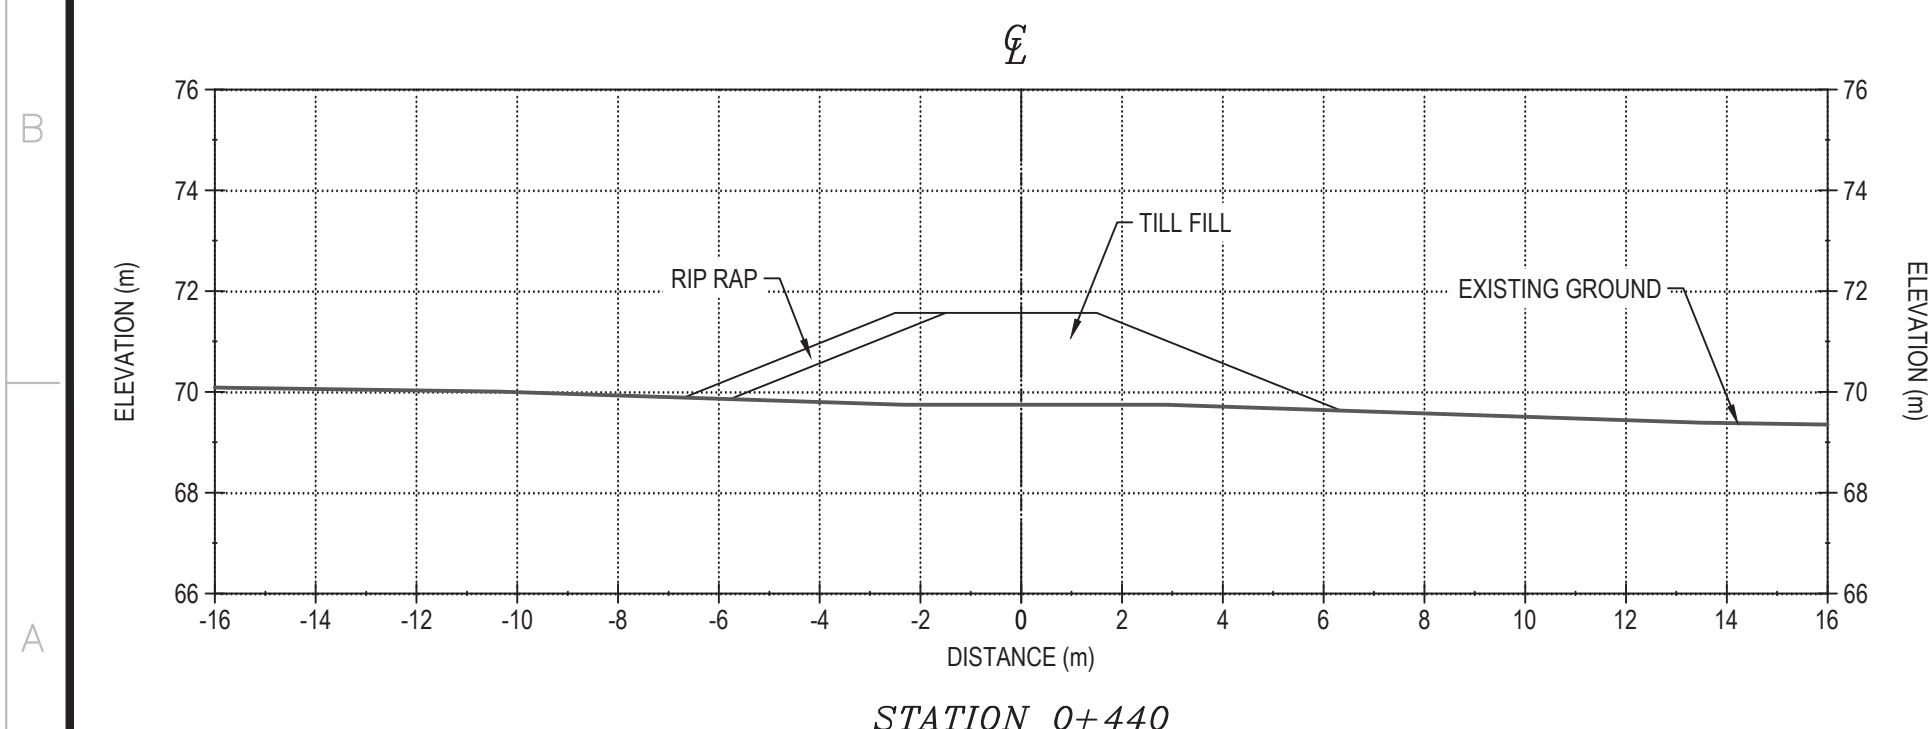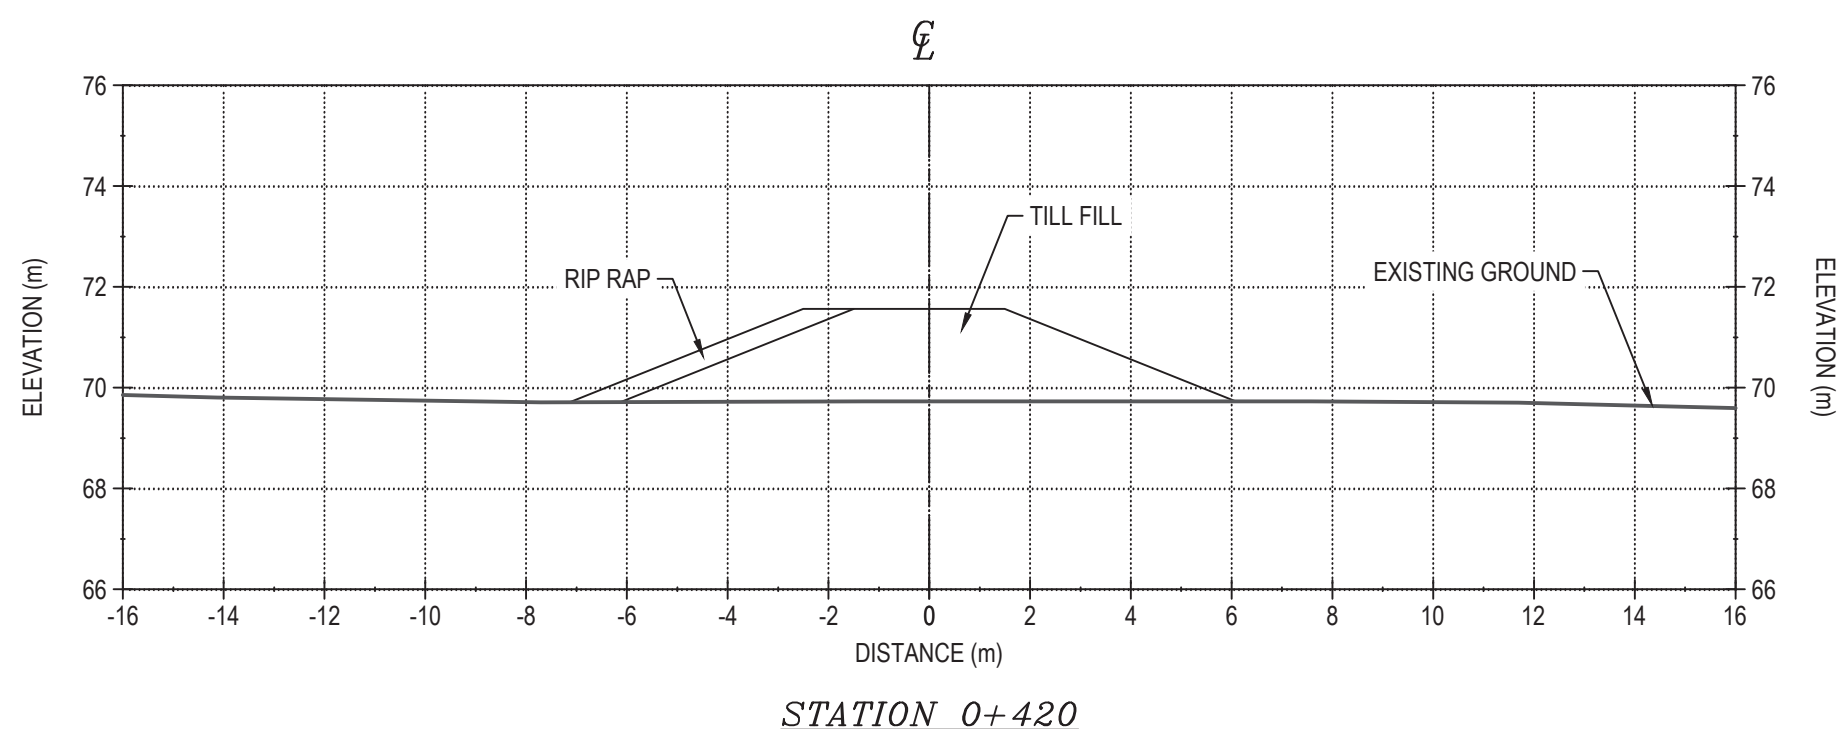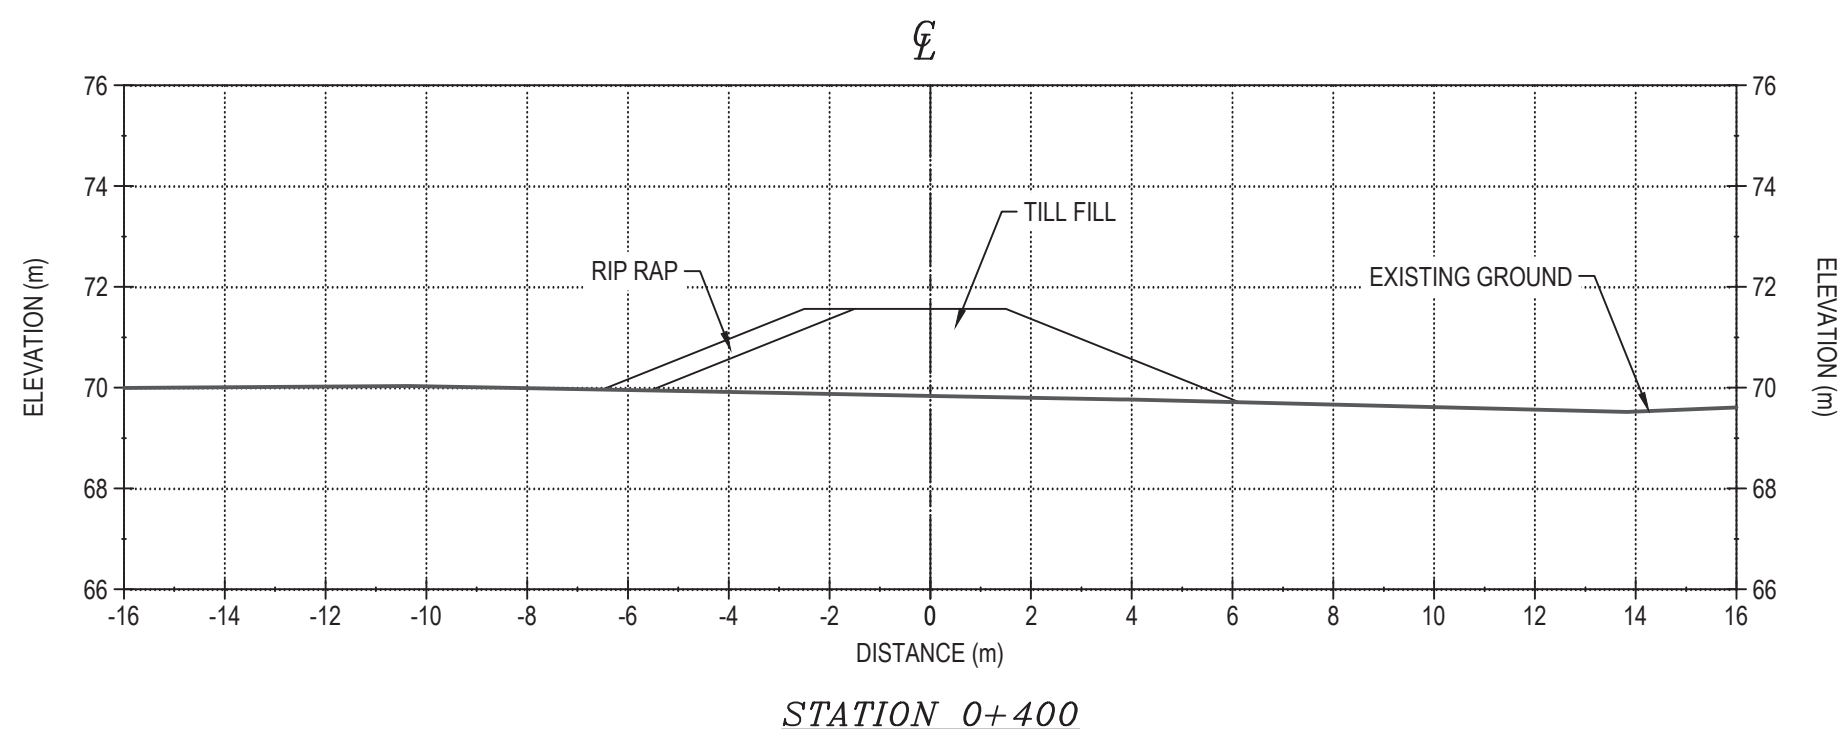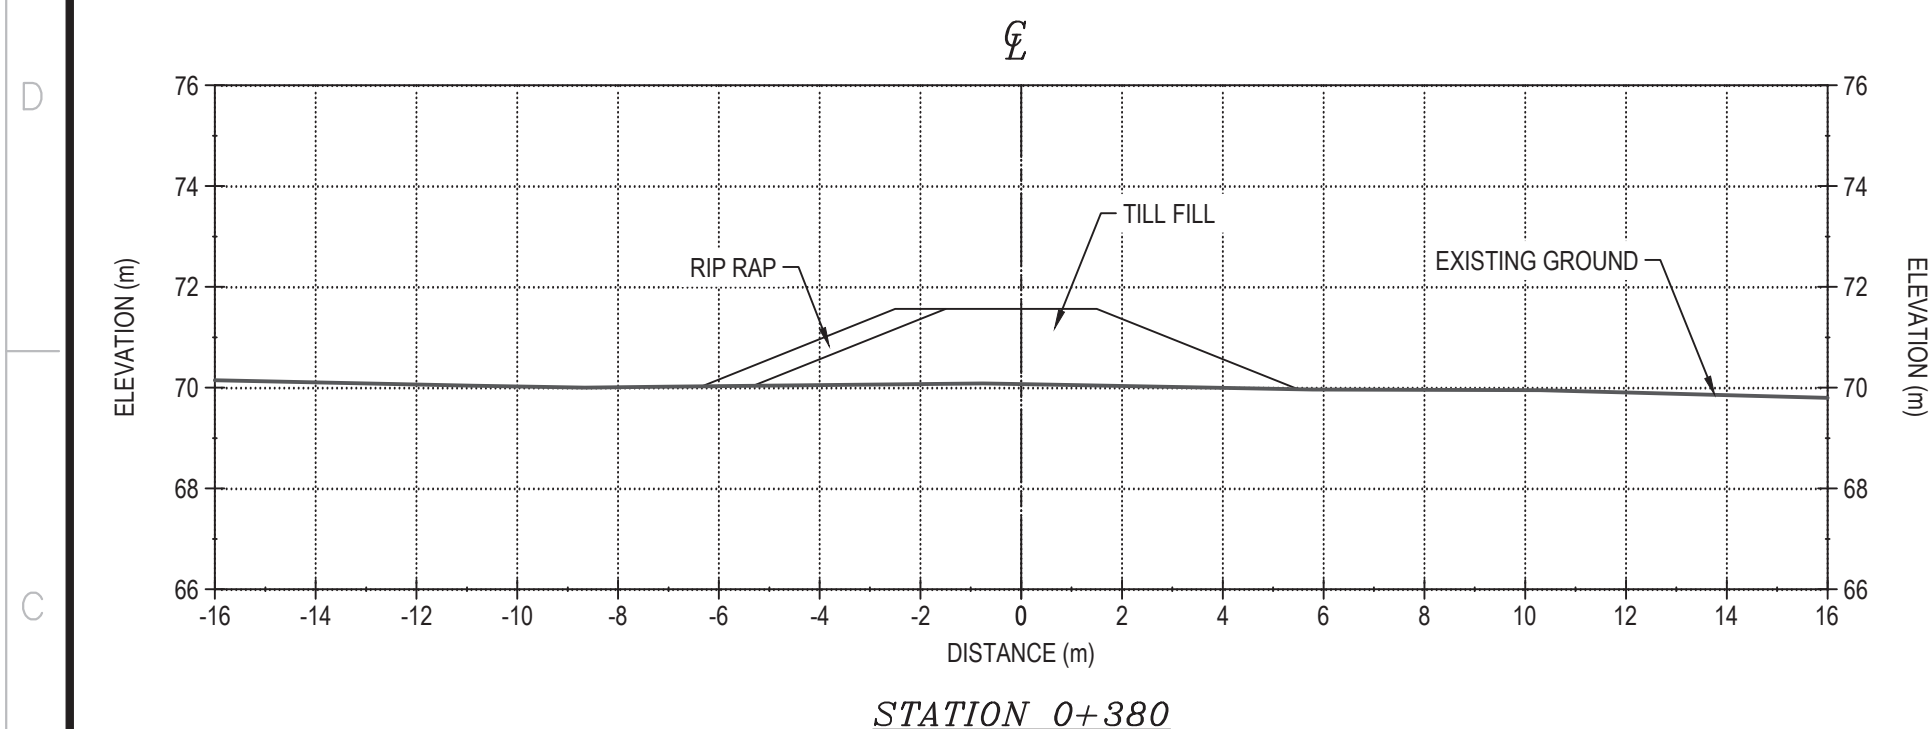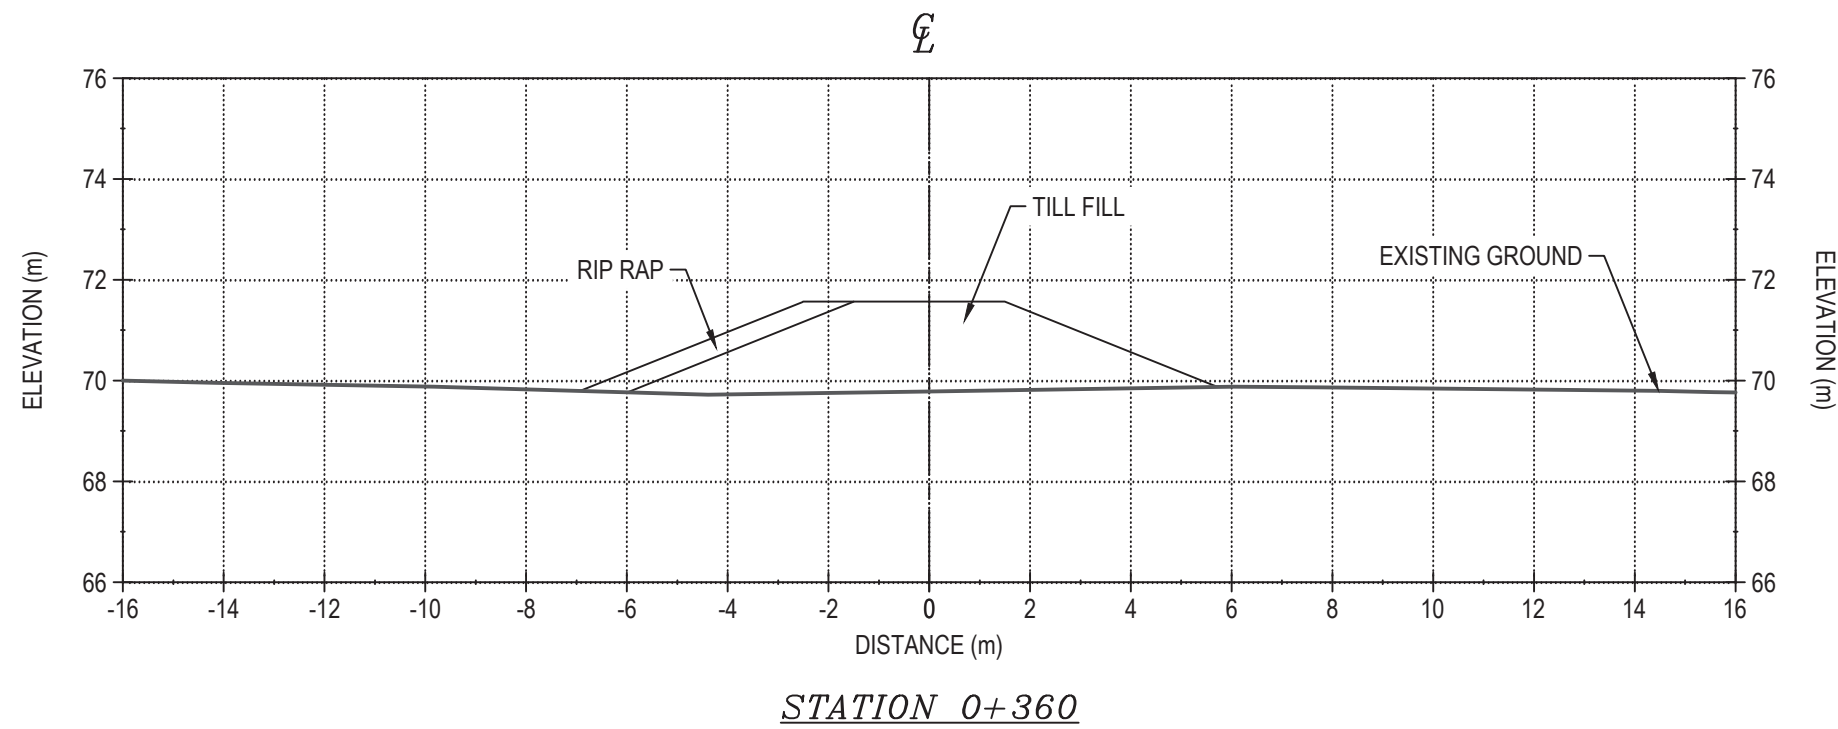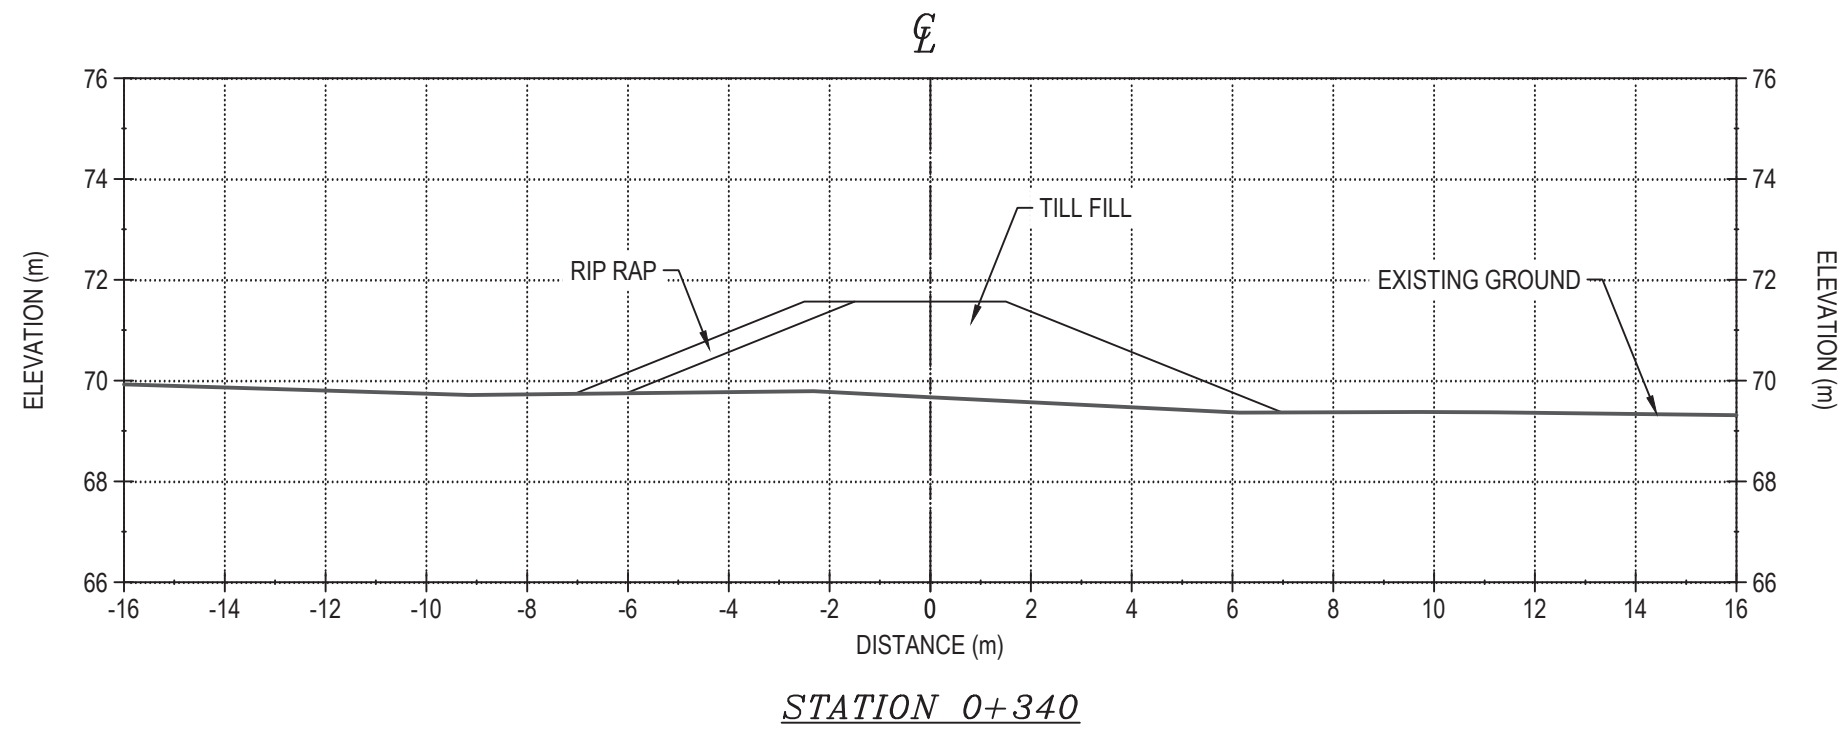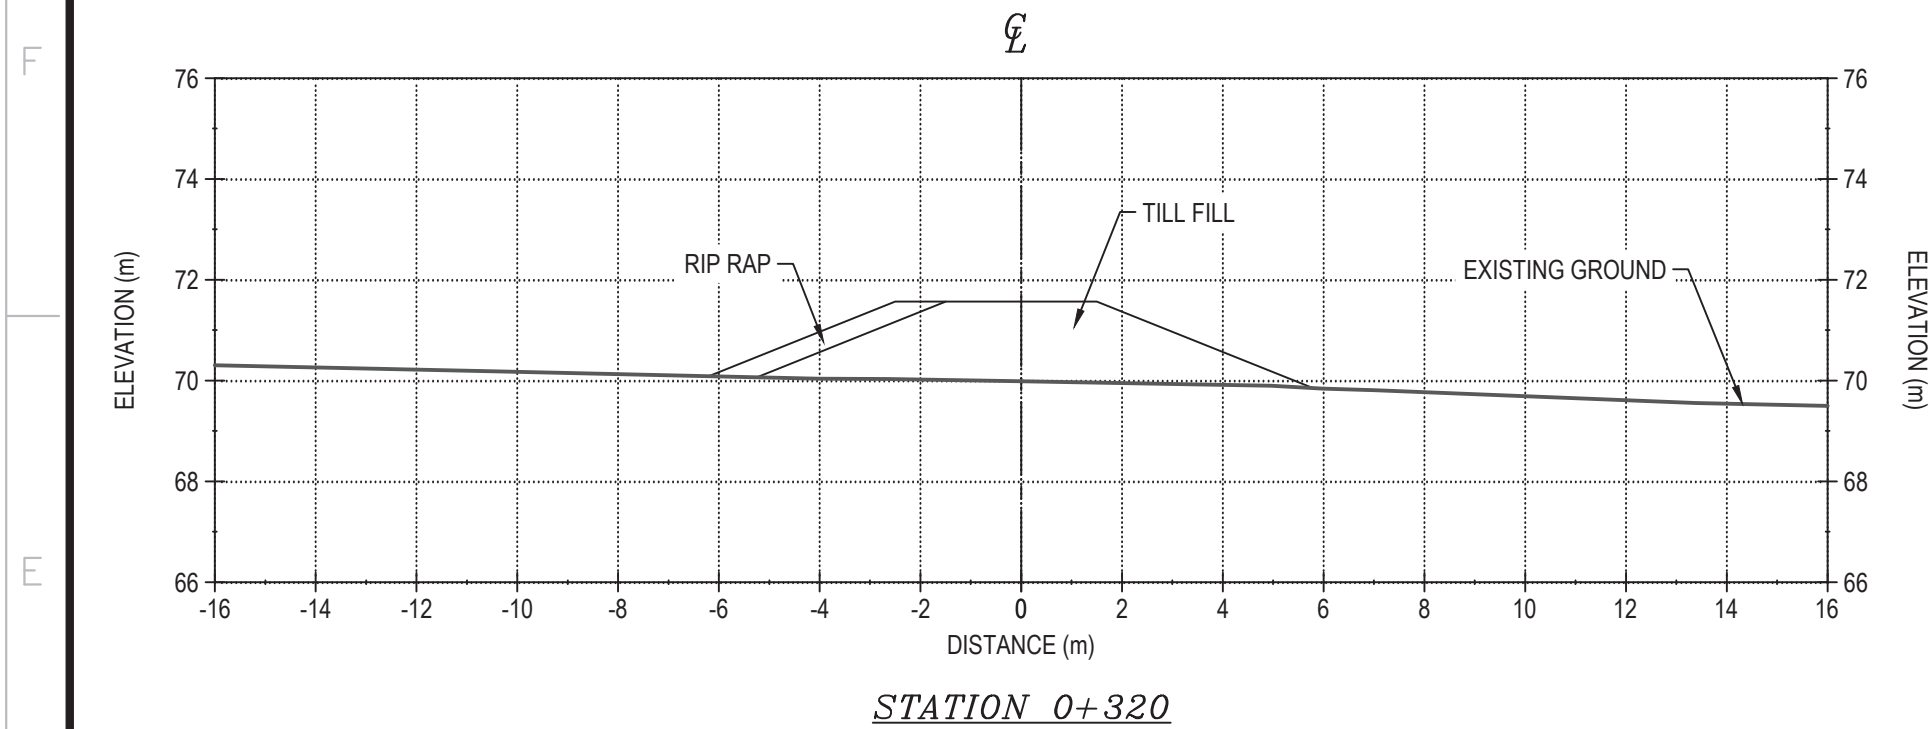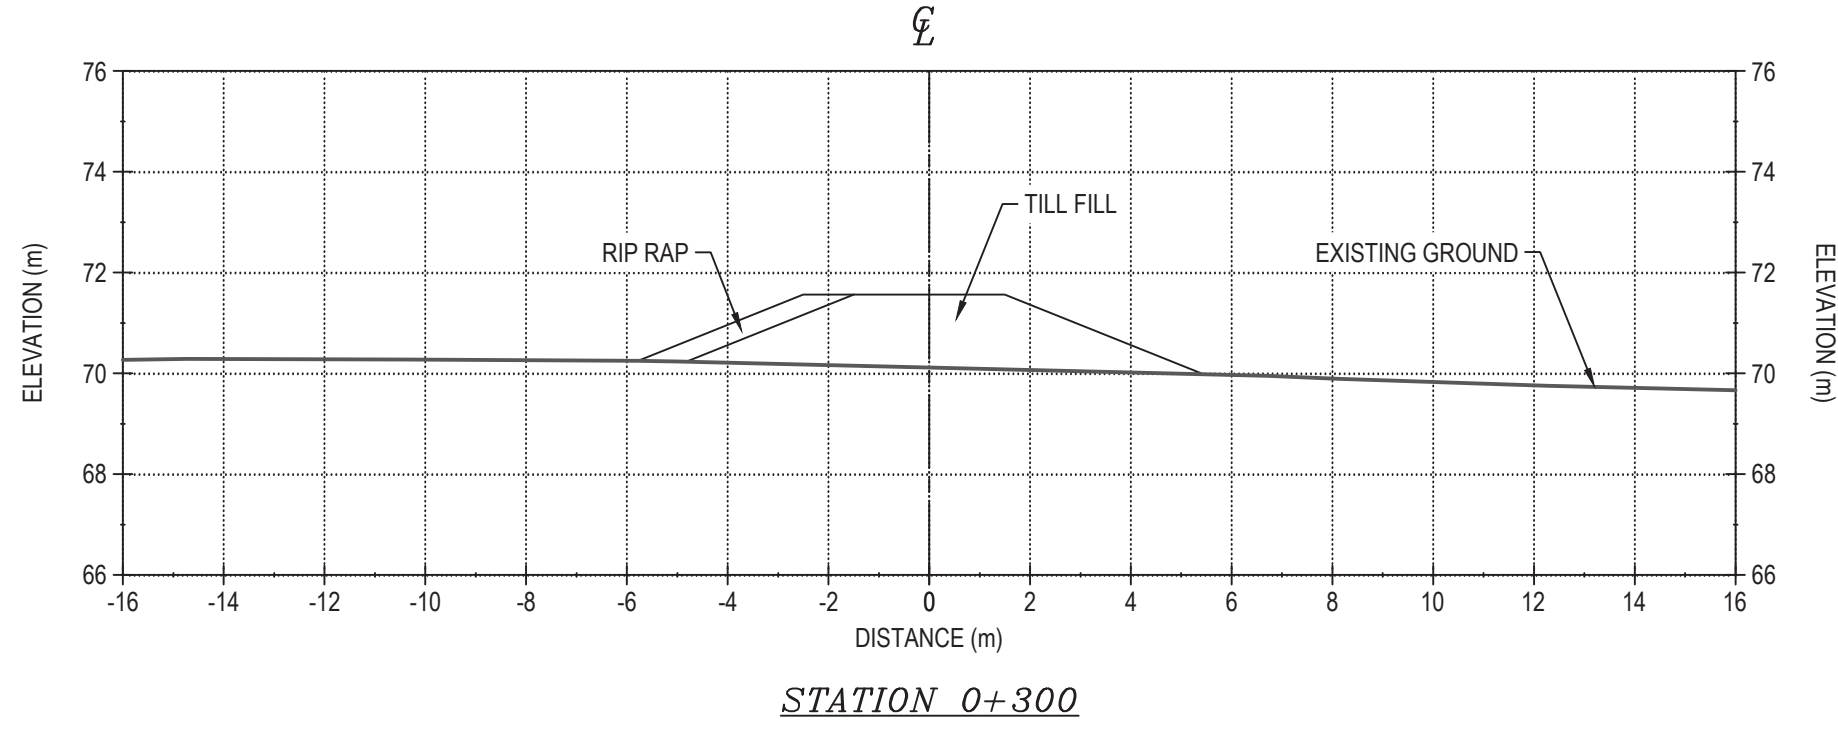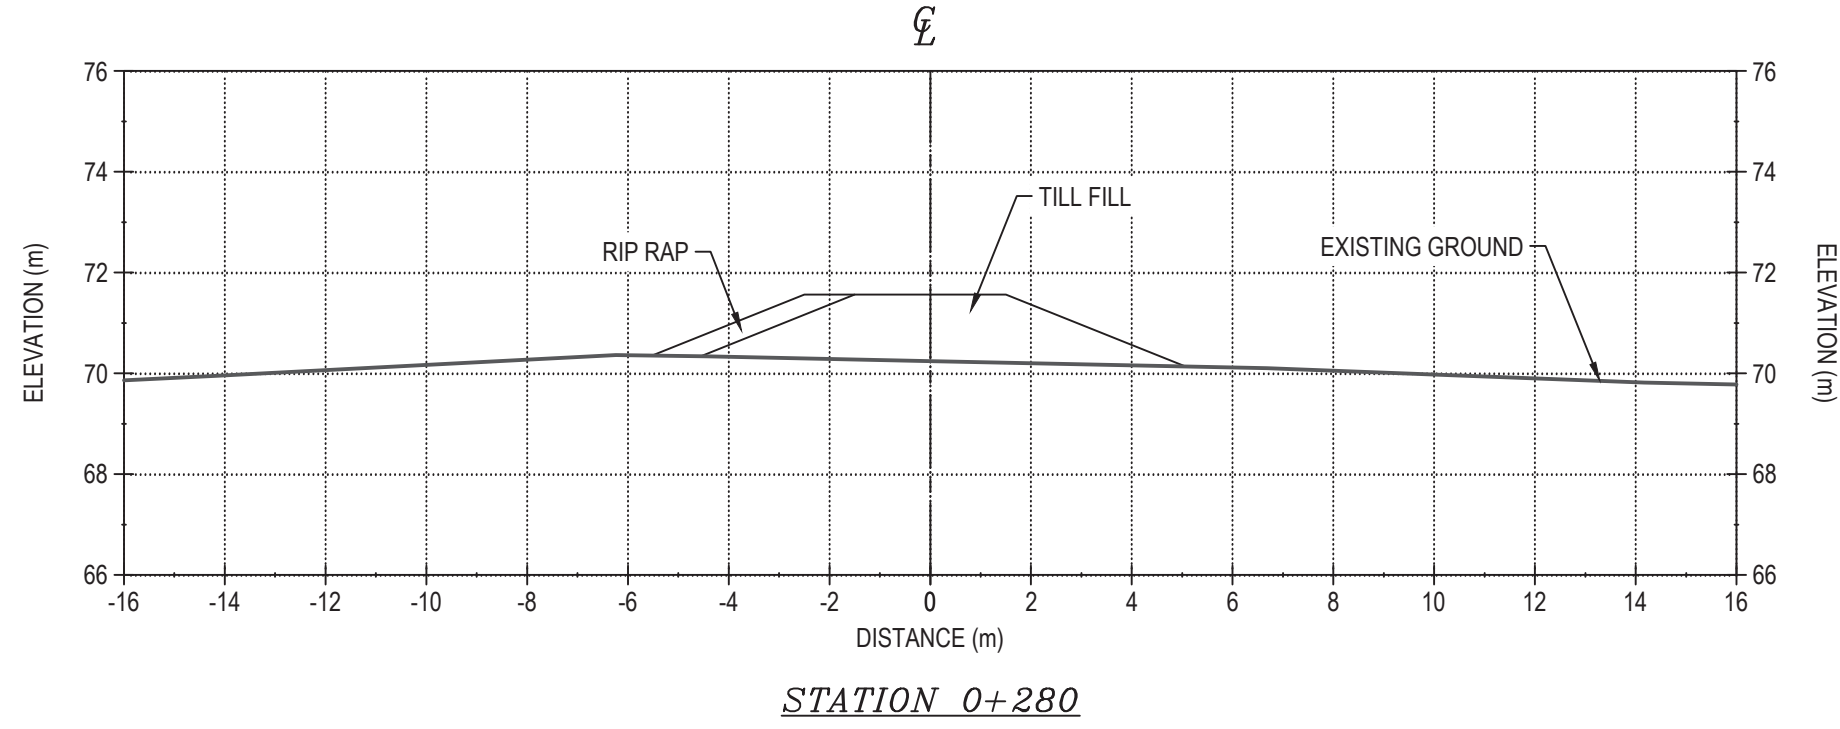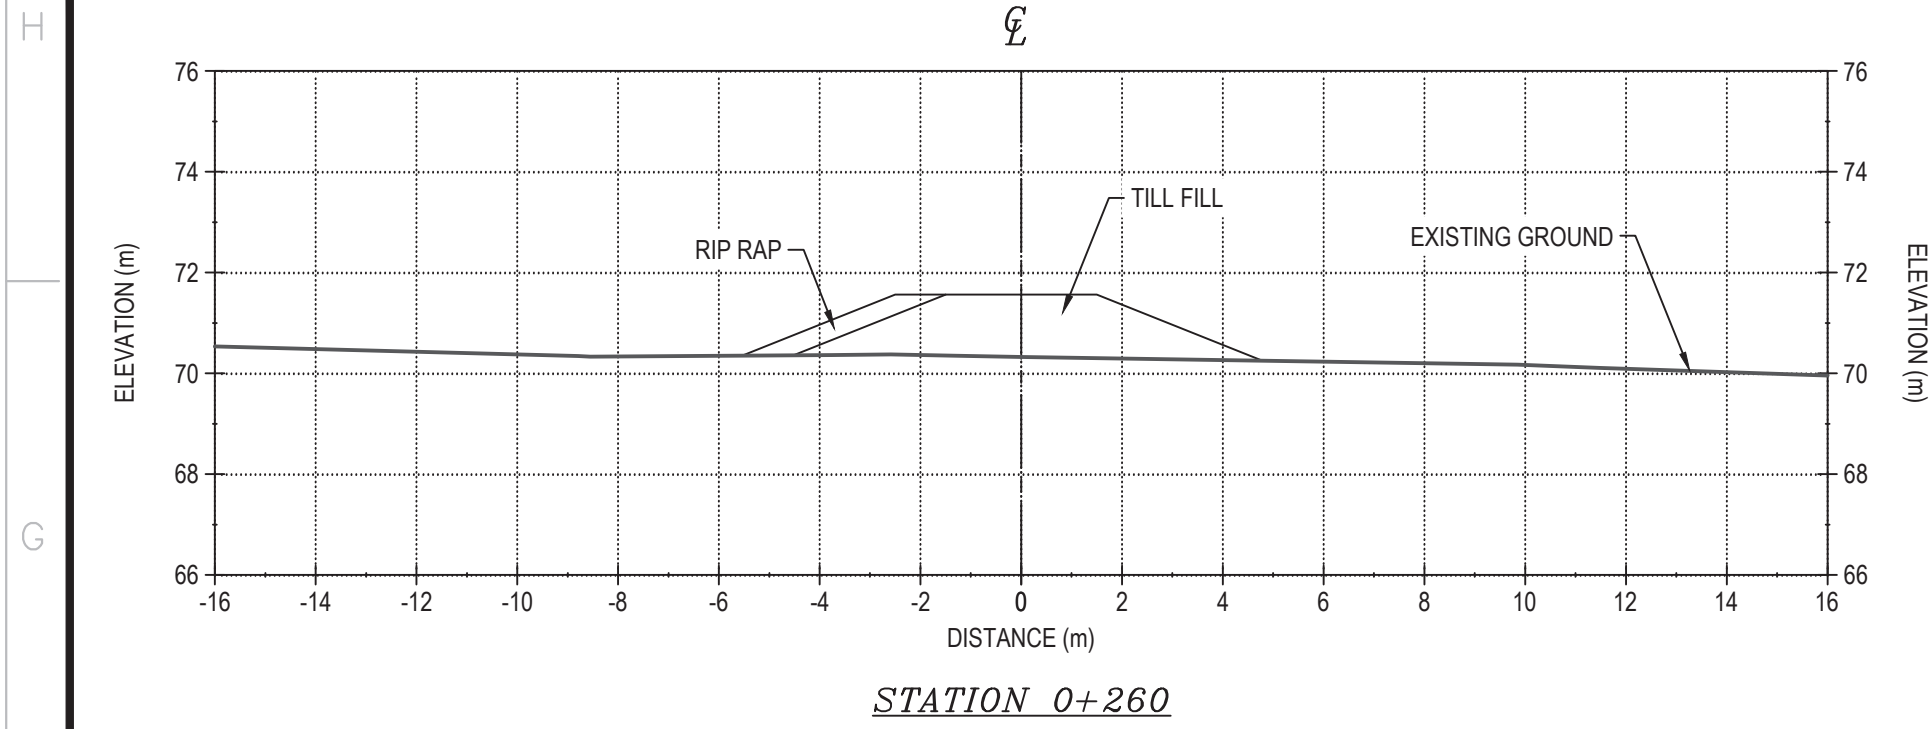

NOTES GÉNÉRALES / GENERAL NOTES

1. ASSUMED CONSTRUCTION SCHEDULE FOR CHANNEL3 FALL / WINTER 2018.
2. ASSUMED GEOTEXTILE THAT MEETS MATERIAL SPECIFICATION WILL BE AVAILABLE AT SITE FOR CHANNEL3 CONSTRUCTION.
3. MATERIAL PLACEMENT AND FOUNDATION PREPARATION SHOULD BE IN ACCORDANCE WITH THE REQUIREMENTS OF GEOTECHNICAL CONSTRUCTION / MATERIAL SPECIFICATIONS (TETRA TECH 2018).

PERMIT TO PRACTICE
TETRA TECH CANADA INC.
Signature: *[Signature]*
Date: *June 21, 2018*
PERMIT NUMBER: P 018
NT/NU Association of Professional
Engineers and Geoscientists



L'INFORMATION CONTENUE EST LA PROPRIÉTÉ DE L'AGNICO EAGLE LTD. ET DOIT ÊTRE RETENUE SANS DEMANDE, SANS AUTORIZATION ÉCRITE, PROHIBÉE. TOUTE TRANSMISSION DE COPIES À AUTRES ET TOUTE UTILISATION NON DE CLASSE POUR VOUS SEULEMENT L'INFORMATION EST PROHIBÉE. TOUTES AUTRES COPIES SONT INTERDITES. © AGNICO EAGLE LTD.

ALL INFORMATION HEREIN IS THE PROPERTY OF AGNICO EAGLE LTD. AND MUST BE RETAINED UNDER RESTRICTED WORK/NOT WRITTEN PERMISSION, AND COPIES TRANSMISSION, TO OTHERS AND ANY USE EXCEPT THAT FOR WHICH IT IS ISSUED ARE PROHIBITED. © AGNICO EAGLE LTD.

DESSINS EN RÉFÉRENCE / REFERENCE DRAWINGS

TITRE / TITLE	# DWG
---	---
---	---
0	2018-06-21	ISSUED FOR CONSTRUCTION	HX	WITH
1	2018-06-29	ISSUED FOR REVIEW	LOK	WITH
REV.	DATE	DESCRIPTION	PAR/ÉV.	APP. CLIENT

REVISIONS











TITRE / TITLE
AGNICO EAGLE MELIADINE GOLD PROJECT

BERM2 DESIGN SECTIONS
(2 of 3)


DESSINE PAR DRAWN BY	EL	DATE 2018-06-21
VÉRIFIÉ PAR CHECKED BY	HX	2018-06-21
APPROUVÉ PAR APPROVED BY	WTH	2018-06-21
ÉCHELLE SCALE	1:150	DATE 2018-06-21

NO. DESSIN
DRAWING NO. 65-695-230-246-2

NO. PROJET PROJECT NO.	REVISION	FEUILLE / SHEET
6515	0	12 / 13

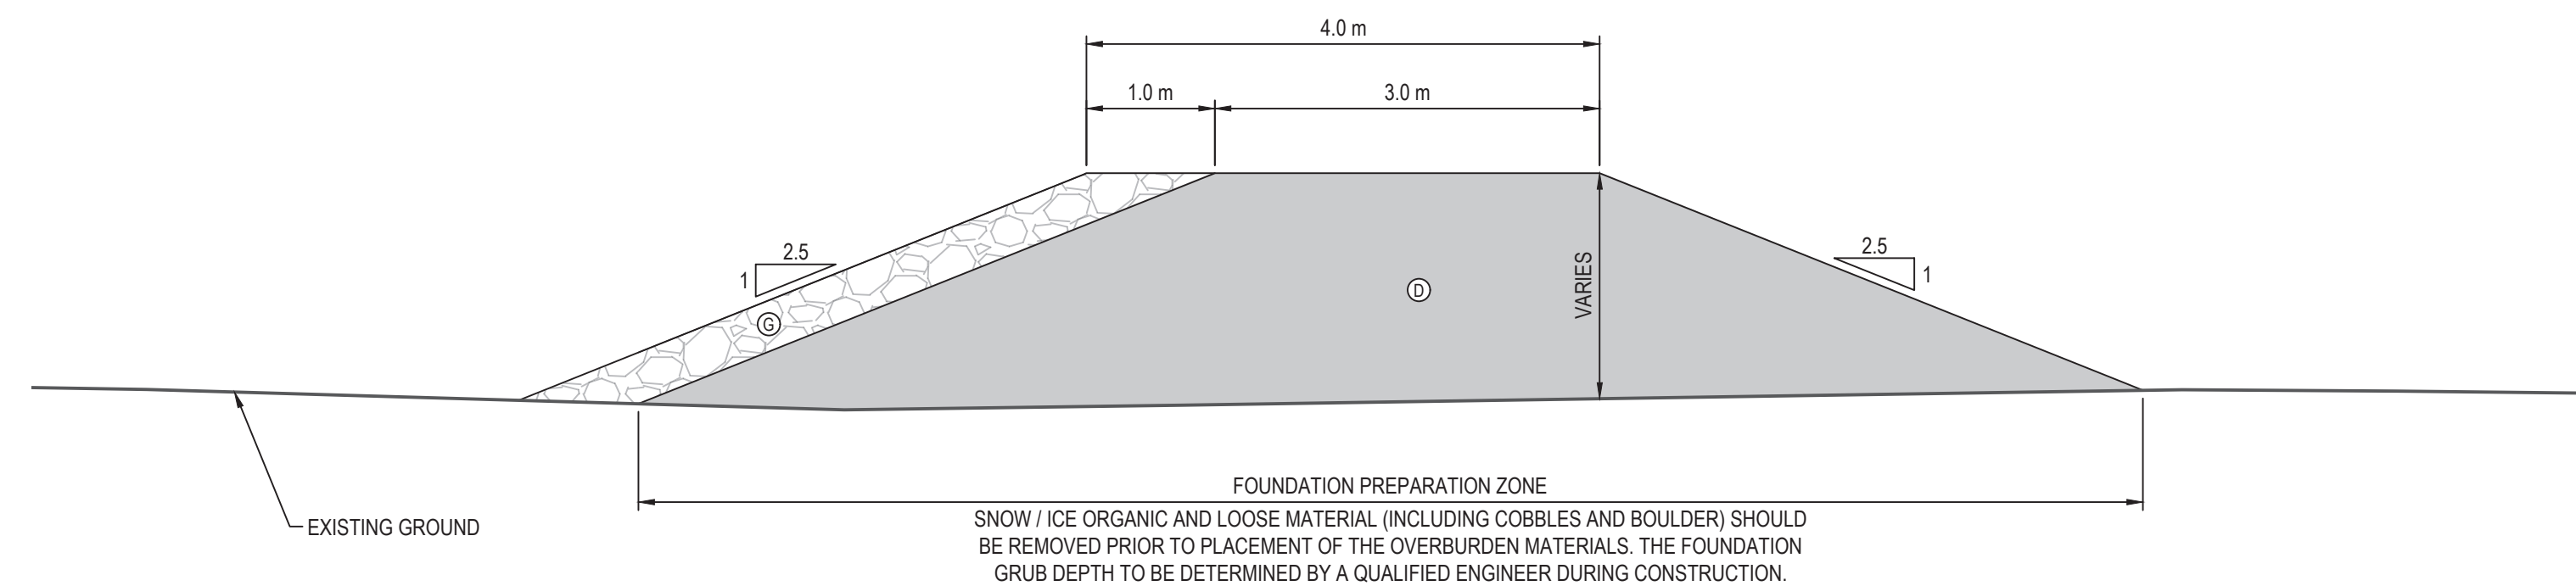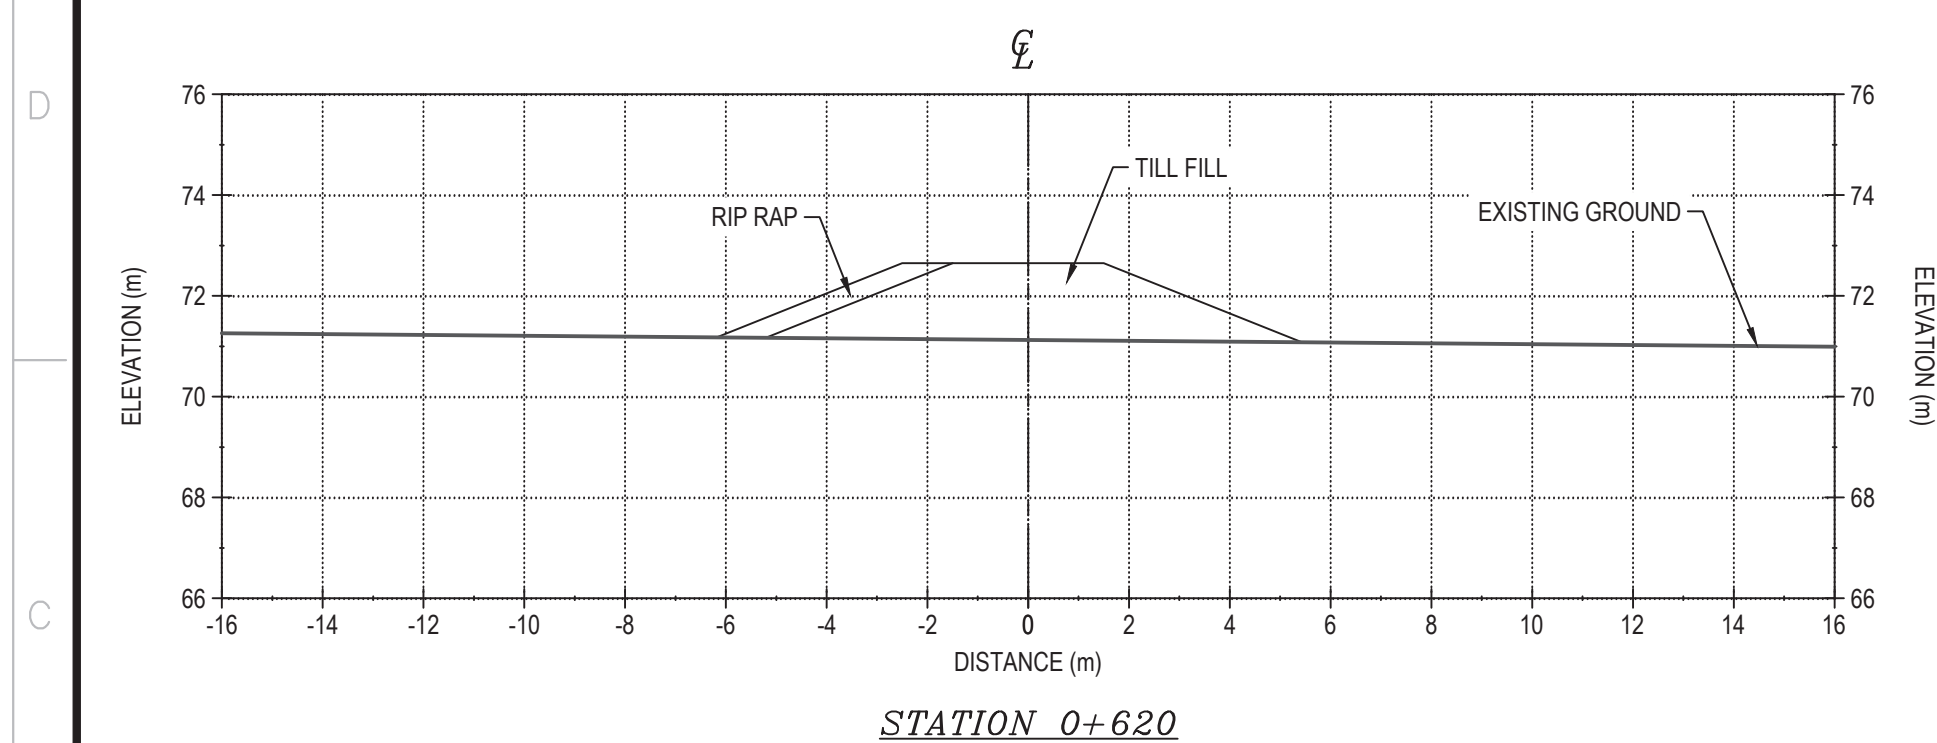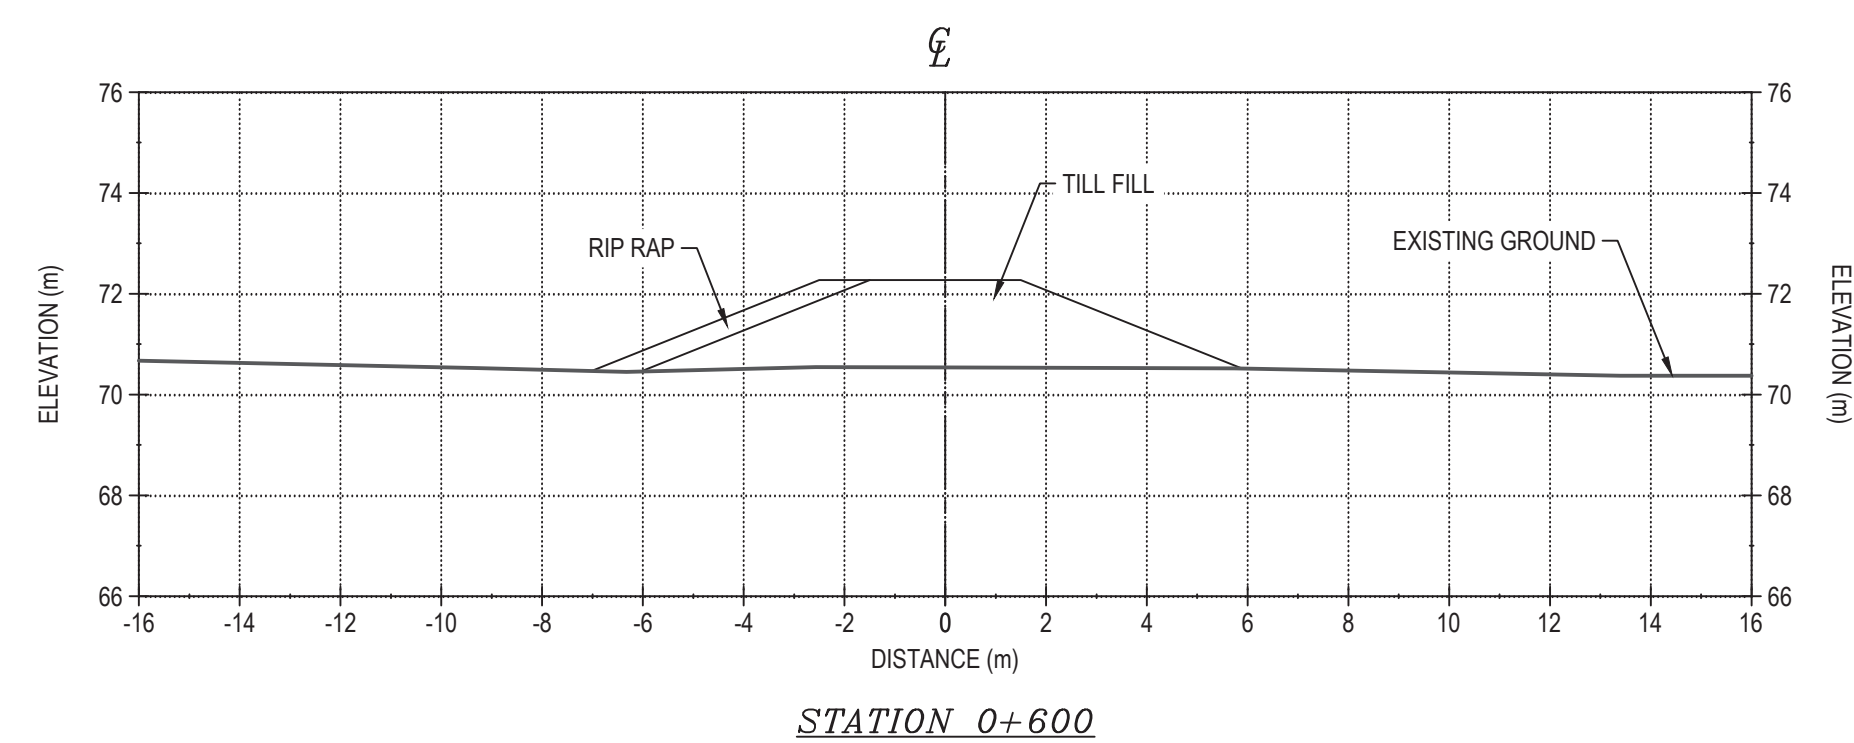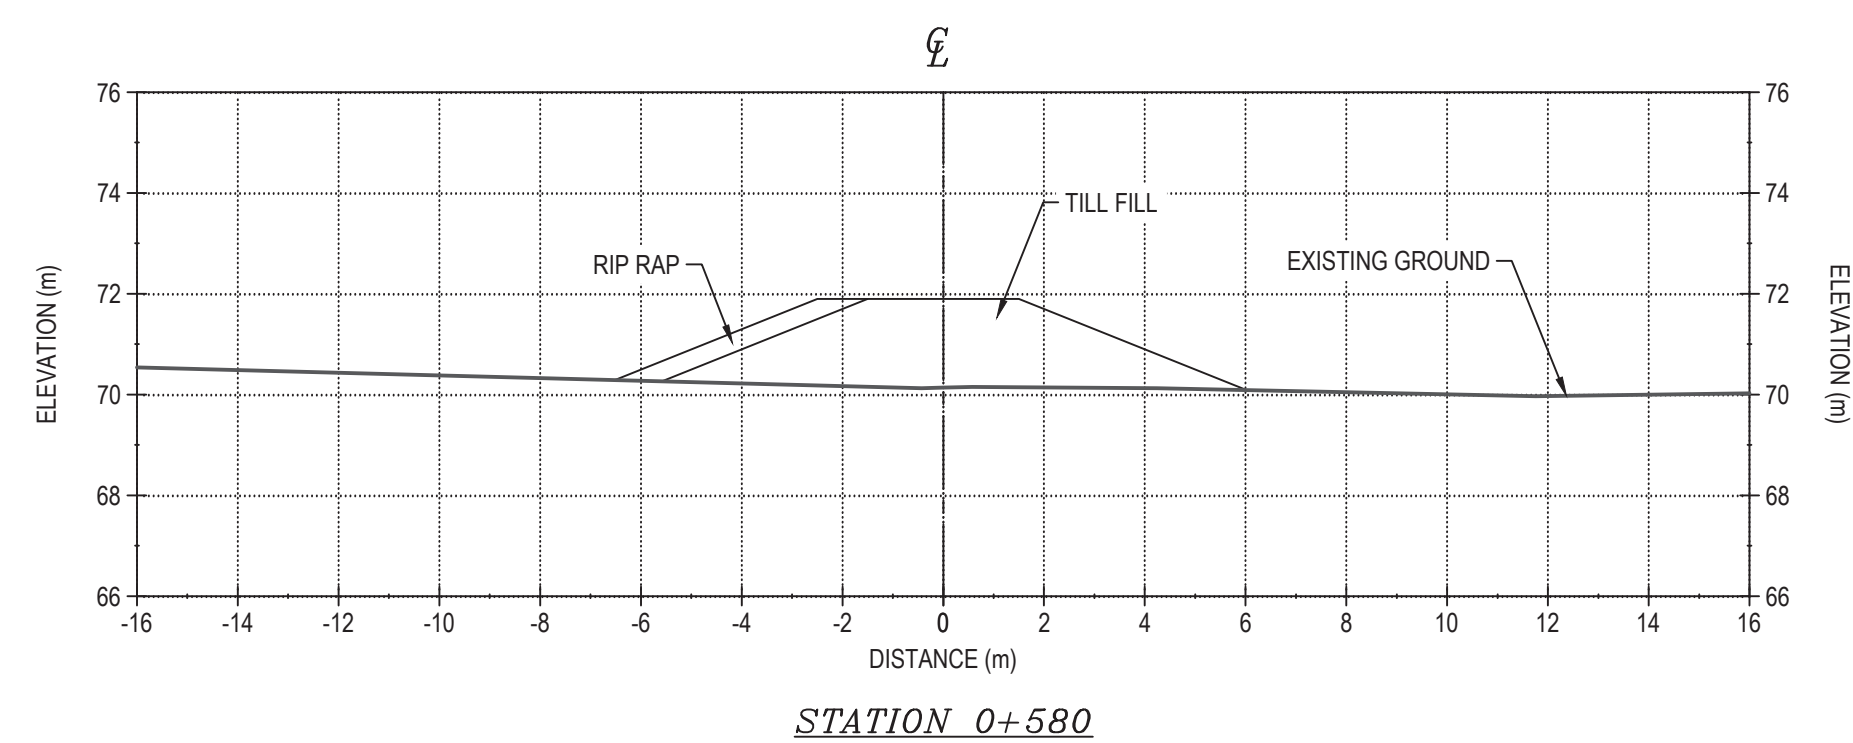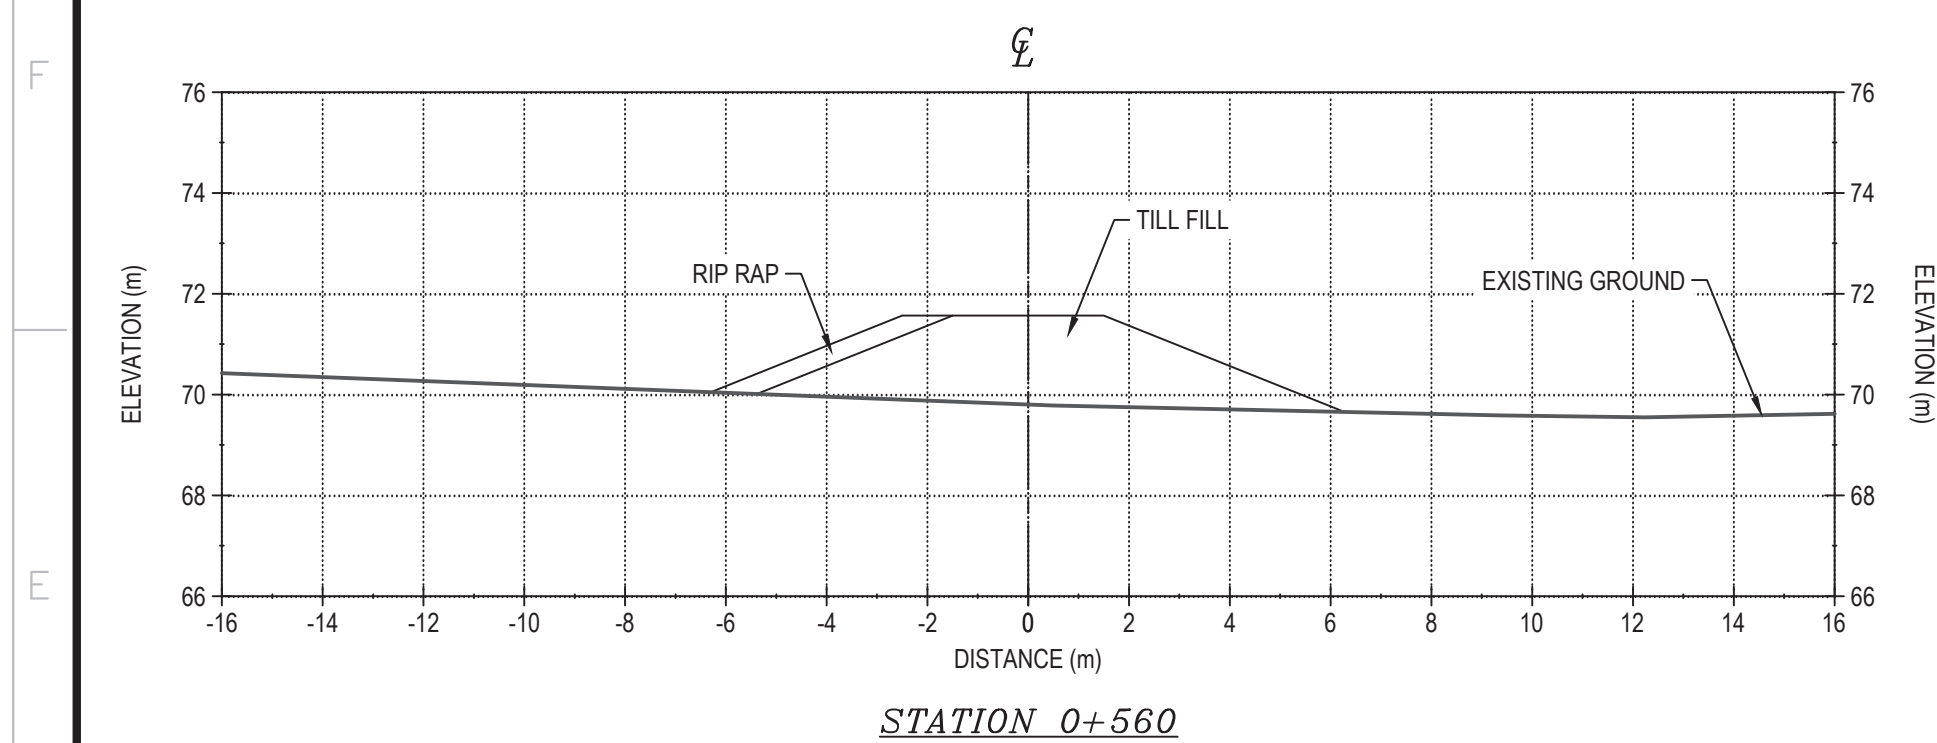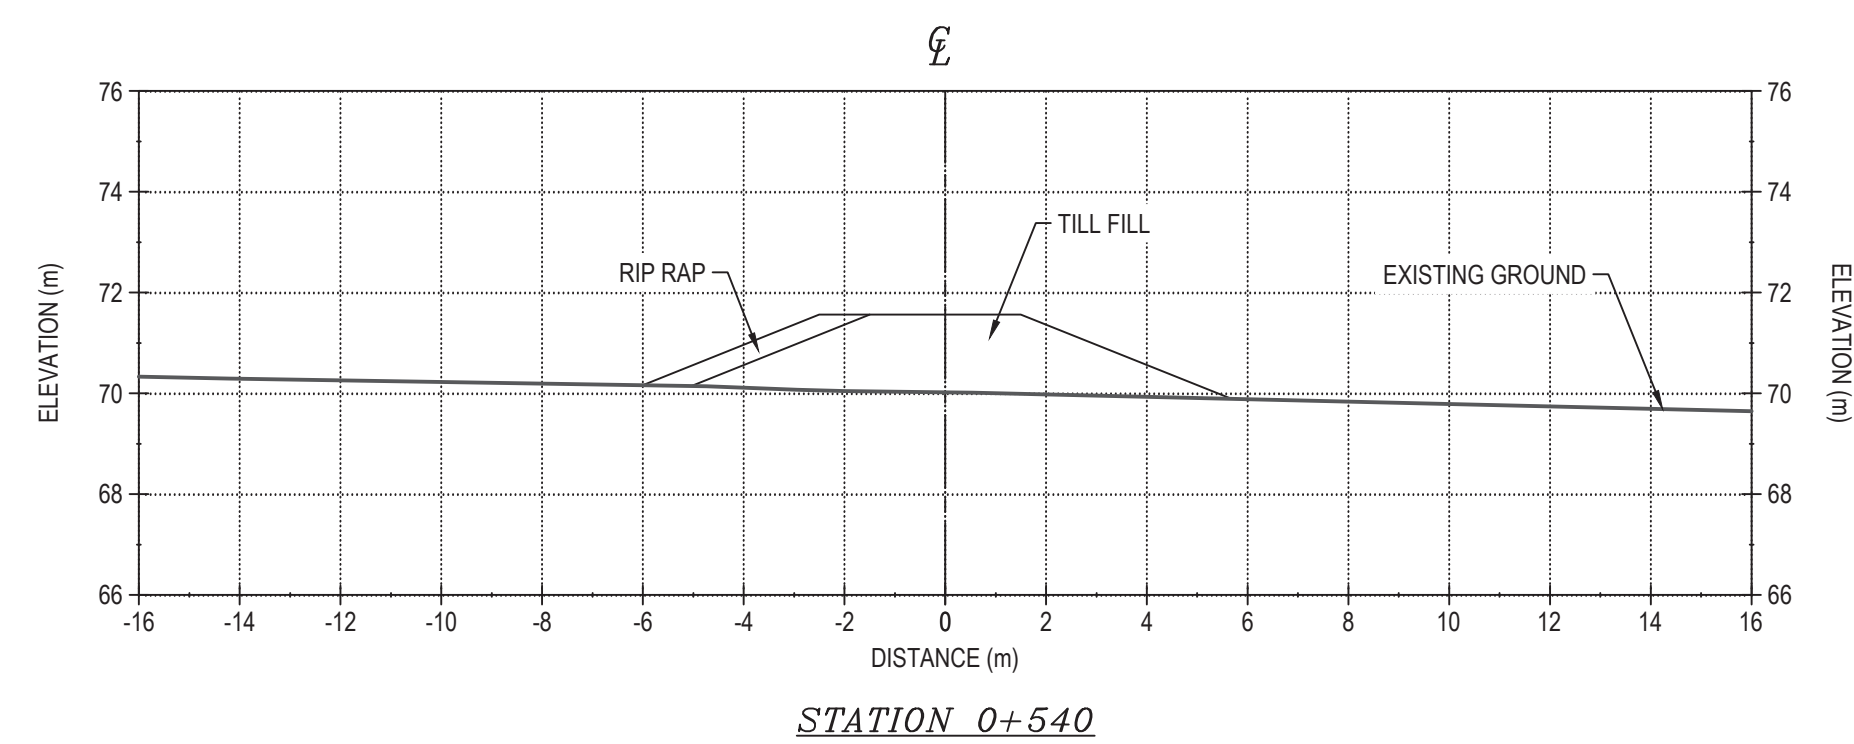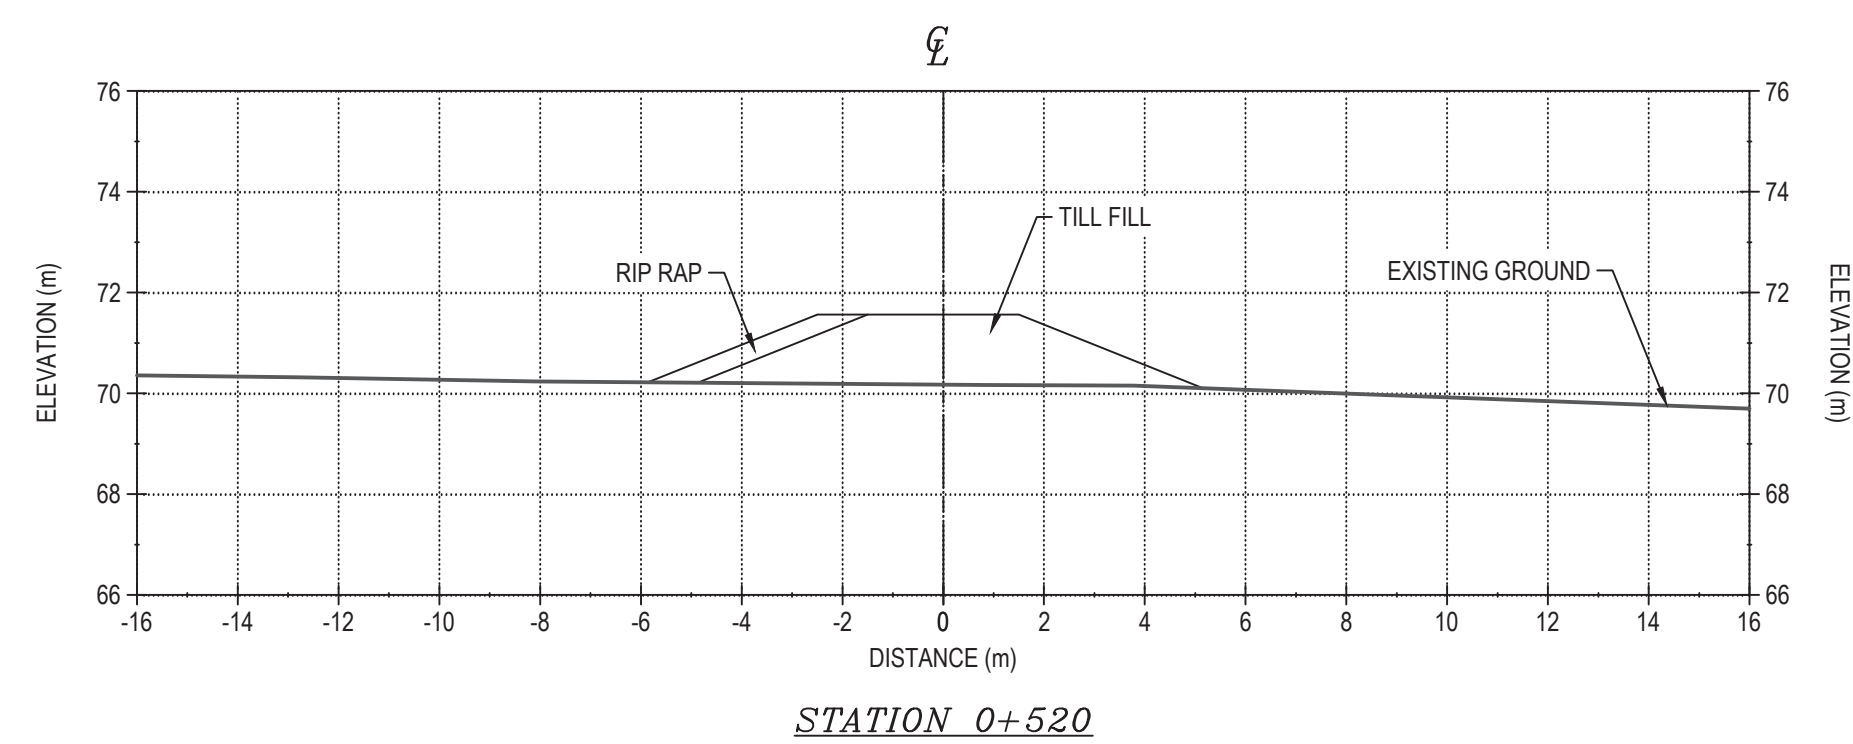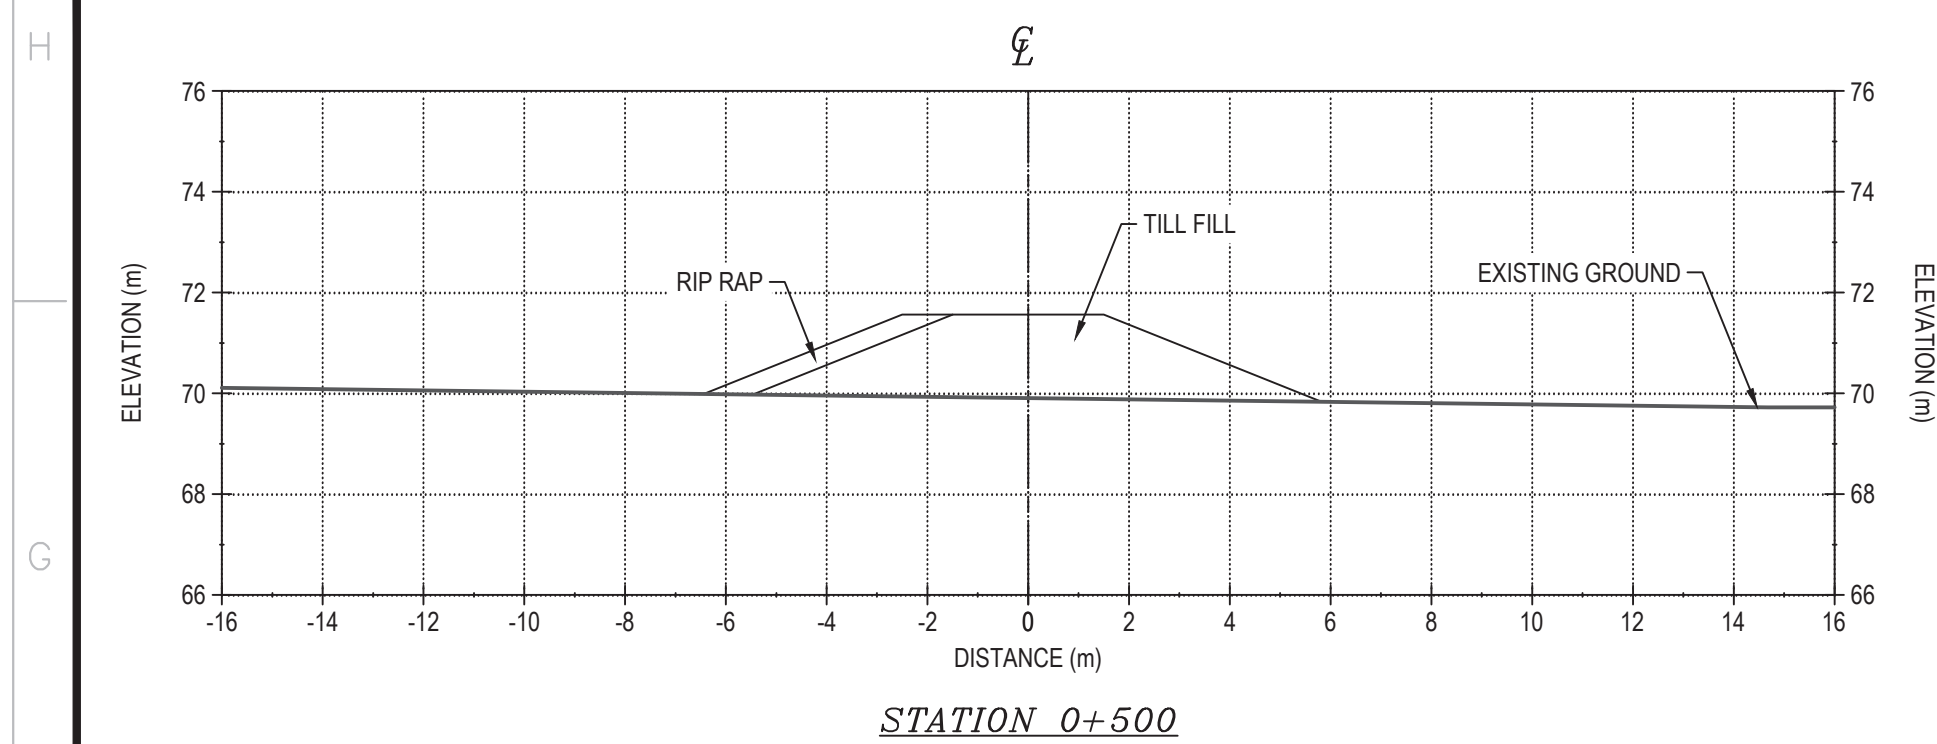

ITEM		UNITS	ESTIMATED IN-PLACE QUANTITY
②	EXCAVATED OVERBURDEN TILL FILL (300 mm MINUS)	m³	7,060
③	RIP RAP	m³	970

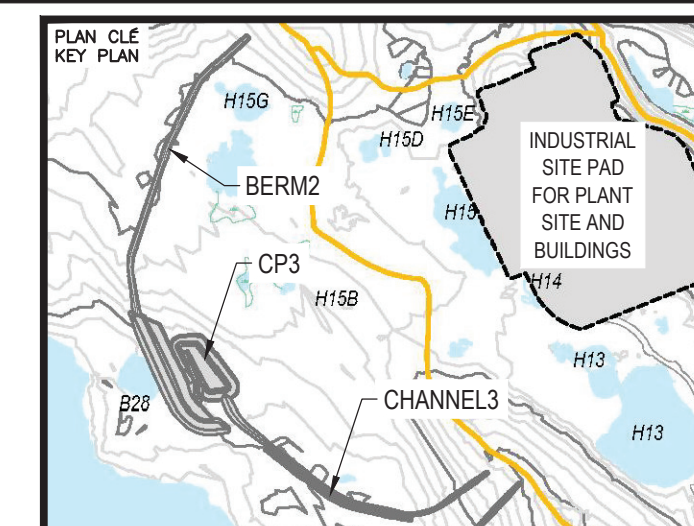

NOTES GÉNÉRALES / GENERAL NOTES

1. ASSUMED CONSTRUCTION SCHEDULE FOR CHANNEL3 FALL / WINTER 2018.
2. ASSUMED GEOTEXTILE THAT MEETS MATERIAL SPECIFICATION WILL BE AVAILABLE AT SITE FOR CHANNEL3 CONSTRUCTION.
3. MATERIAL PLACEMENT AND FOUNDATION PREPARATION SHOULD BE IN ACCORDANCE WITH THE REQUIREMENTS OF GEOTECHNICAL CONSTRUCTION / MATERIAL SPECIFICATIONS (TETRA TECH 2018).

PERMIT TO PRACTICE
TETRA TECH CANADA INC.

Signature [Signature]
Date June 21, 2018

PERMIT NUMBER: P 018
NT/NU Association of Professional
Engineers and Geoscientists

POUR CONSTRUCTION
FOR CONSTRUCTION
AGRICOLA EAGLE
DATE : 2018-06-21

L'INFORMATION CI-CONTRE EST LA PROPRIÉTÉ DE AIGIONC LAKE LTD. ET DOIT ÊTRE RETOURNÉE SUR DEMANDE, SANS AUTORISATION ET PRÉALABLE, TOUTE REPRODUCTION DE COPIES À AUTRUI ET TOUTE UTILISATION AUTRE QUE CELLE POUR LAQUELLE L'INFORMATION EST PRÉSENTÉE. (C) AIGIONC LAKE LTD.

THE INFORMATION HERE ON IS THE PROPERTY OF AIGIONC LAKE LTD. AND MUST BE RETURNED UPON REQUEST, WITHOUT WRITTEN PERMITS ANY COPYING TRANSMITTAL TO OTHERS AND ANY USE EXCEPT THAT FOR WHICH IT IS ISSUED ARE PROHIBITED.
(C) AIGIONC LAKE LTD.

DESSINS EN RÉFÉRENCE / REFERENCE DRAWINGS

TITRE / TITLE	# DWG
---	---
---	---
O	2018-06-21	ISSUED FOR CONSTRUCTION	HX	WTH	
A	2018-05-29	ISSUED FOR REVIEW	HX	WTH	
REV.	DATE	DESCRIPTION	PAR/BY	APP.	CHECKED

REVISIONS



TITRE / TITLE
AGNICO EAGLE MELIADINE GOLD PROJECT

BERM2 DESIGN SECTIONS
(3 of 3)

DESSINÉ PAR DRAWN BY	EL	DATE	2018-06-21
VÉRIFIÉ PAR CHECKED BY	HX	DATE	2018-06-21
APPROUVÉ PAR APPROVED BY	WTH	DATE	2018-06-21
ÉCHELLE SCALE	1:150	DATE	2018-06-21


NO. DESSIN
DRAWING NO. 65-695-230-246-3

NO. PROJET PROJECT NO.	REVISION	FEUILLE / S
	0	13 / 13




BERM3 LAYOUT POINTS ALONG CENTRELINE		
POINT #	NORTHING	EASTING
1	698551.369	53955.476
2	698545.911	53955.719
3	698540.463	53977.963
4	698535.015	53997.207
5	698529.567	53916.450
6	698524.119	53935.694
7	698518.671	53954.938
8	698513.223	53974.181
9	698507.775	53993.425
10	698502.327	54012.669
11	698496.879	54031.912
12	698491.431	54051.156
13	698485.983	54070.400
14	698480.535	54089.644
15	698475.087	54108.887
16	698469.639	54128.131
17	698464.191	54146.248

BERM3 SITE LAYOUT PLAN VIEW

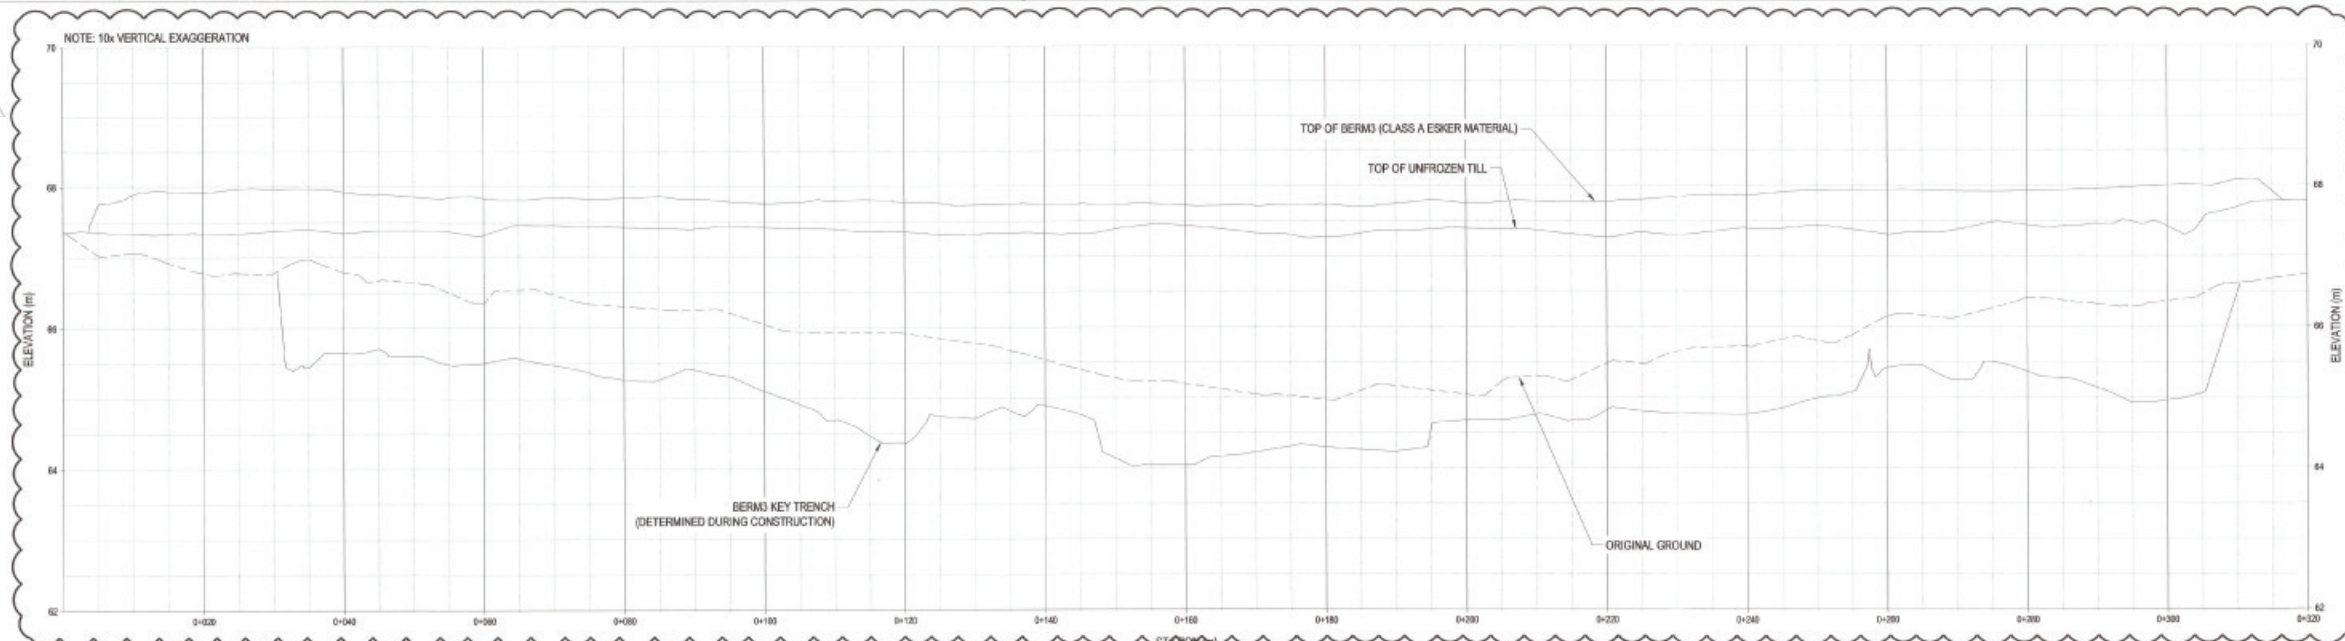

PROFILE OF BERM3 ALONG CENTRELINE

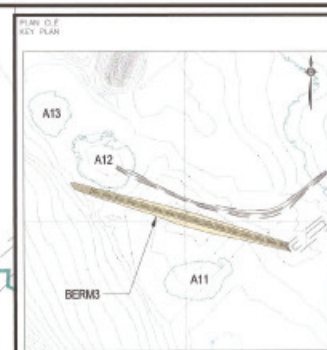

NOTES GÉNÉRALES / GENERAL NOTES

- NOTES:
1. ASSUMING BERM3 WILL BE CONSTRUCTED IN OCTOBER AND EARLY NOVEMBER 2016
 2. ASSUMING SELECTED UNFROZEN TILL FILL THAT MEETS MATERIAL SPECIFICATIONS WILL BE AVAILABLE AT THE SITE FOR BERM3 CONSTRUCTION

LEGEND

BOREHOLE



L'INFORMATION CONTENUE EST LA PROPRIÉTÉ DE AGNICO EAGLE LTD ET EST SOUS RÉSERVE. LES CHANGEMENTS ALIÉNÉS SONT PROHIBÉS. TOUTE MODIFICATION DE L'INFORMATION CONTENUE DOIT ÊTRE APPRouvÉE PAR AGNICO EAGLE LTD. LA PRÉCISION DES DONNÉES NE DOIT PAS ÊTRE EXAGÉRÉE. L'INFORMATION EST FOURNIE SANS GARANTIE. L'USAGER S'ENGAGE À S'ASSURER QUE LES DONNÉES SONT ADÉQUATES À L'USAGE INTENDU. L'USAGER S'ENGAGE À S'ASSURER QUE LES DONNÉES SONT ADÉQUATES À L'USAGE INTENDU. L'USAGER S'ENGAGE À S'ASSURER QUE LES DONNÉES SONT ADÉQUATES À L'USAGE INTENDU.

DESSINS EN RÉFÉRENCE / REFERENCE DRAWINGS

FIG. / TITLE	#	DATE
1	1	2016-09-20
2	2	2016-09-20
3	3	2016-09-20
100	100	2016-09-20

AGNICO EAGLE

REV.	DATE	DESCRIPTION	PREP.	APP.	CLIENT
1	2017-12-06	FOR AS-BUILT	J.A.	J.A.	
2	2016-09-20	FOR CONSTRUCTION	G2	G2	
3	2016-09-15	FOR REVIEW	G2	G2	

PERMIT TO PRACTICE
TETRA TECH INDUSTRIES, INC.
OIA TETRA TECH
Signature: [Signature]
Date: 2017-12-06
PERMIT NUMBER: P 1029
NTNU Association of Professional Engineers and Geoscientists

AGNICO EAGLE MELIADINE GOLD PROJECT
BERM3 LAYOUT PLAN AND PROFILE

DESIGNED BY	DBD	DATE	2016-09-20
CHECKED BY	G2	DATE	2016-09-20
APPROVED BY	KJ	DATE	2016-09-20

NO. RECORD
DRAWING NO. 65-695-230-214

NO. PROJECT	REVISION	DATE / SHEET
6515	1	1 / 3

[illegible]

DESSINS EN RÉFÉRENCE / REFERENCE DRAWING

DATE / TIME	# STOPS
---	---
---	---
---	---
---	---



1	2016-12-05	ISSUED FOR AS-BUILT	D/W	J/A	
G	2016-08-20	ISSUED FOR CONSTRUCTION	G/L	G/Z	
A	2016-09-15	ISSUED FOR REVIEW	OBD	GZ	
REV	DATE	DESCRIPTION	PUR/SI	APP	CHECKED

REVISIONS

PERMIT TO PRACTICE
 TETRA TECH INDUSTRIES, INC.
 O/A TETRA TECH
 Signature: *[Signature]*
 Date: *Dec 7, 2017*
 PERMIT NUMBER: P 1029
 NTRAU Association of Professional
 Engineers and Geoscientists

AGNICO EAGLE MELUADINE GOLD PROJECT

BERM3 DESIGN SECTIONS

DESIGNED PAR DRAWN BY	DBB	DATE 2016-09-01
CHECKED BY	GZ	2016-09-01
APPROVAL PAR APPROVED BY	KJ	2016-09-01

ÉCHELLE SCAIF	DATE
------------------	------

65-695-230-215


NO. PROJECT PROJECT NO.	REASON	FEEDBACK / SUGGESTION
	1	2 / 3

	STATION	EASTING	NORTHING	ELEVATION
C	● 0+007.28	540053.88	698910.60	66.70
	● 0+025	540062.98	6989125.10	66.74
	● 0+050	540077.33	6989145.42	66.02
	● 0+075	540091.49	6989165.96	65.59
	● 0+100	540105.33	6989186.76	65.10
	● 0+125	540119.51	6989207.28	64.60
	● 0+150	540132.87	6989228.40	63.66
	● 0+175	540146.16	6989249.56	62.93
	● 0+187.74	540153.33	6989260.05	62.89
	● 0+200	540157.97	6989271.09	64.05
	● 0+213.50	540160.30	6989284.32	64.17
	● 0+225	540161.37	6989295.76	62.88
	● 0+250	540163.61	6989320.43	62.62
	● 0+275	540164.97	6989345.33	62.43
	● 0+300	540166.96	6989370.24	62.59
	● 0+325	540169.47	6989395.09	62.56
	● 0+350	540171.72	6989419.92	62.44
	● 0+362.58	540172.12	6989432.44	62.86
	● 0+375	540172.77	6989444.81	62.52
	● 0+389.01	540173.27	6989458.80	62.23
● 0+400	540174.28	6989469.71	62.52	
● 0+413.15	540176.68	6989482.25	62.62	
● 0+425	540177.63	6989494.06	62.95	
● 0+450	540173.93	6989517.63	64.18	
● 0+475	540180.78	6989540.04	64.28	
● 0+500	540178.61	6989563.92	64.45	
● 0+513.42	540179.61	6989577.29	64.88	
● 0+525	540186.34	6989586.77	63.86	
● 0+539.17	540188.15	6989599.65	64.13	
● 0+550	540191.75	6989609.63	64.98	
● 0+559.53	540195.57	6989618.28	66.28	
● 0+566.21	540197.85	6989624.56	66.68	
● 0+575	540199.05	6989633.24	67.61	
● 0+593.75	540200.65	6989651.72	68.78	




D-CP1 KEY TRENCH PLAN VIEW
SCALE: 1:1250

STATION	EASTING	NORTHING
● +1000	540046.76	6809008.08
● +1025	540061.71	6809118.11
● +1050	540076.67	6809138.15
● +1075	540091.62	6809158.16
● +1100	540106.57	6809178.21
● +1125	540121.53	6809198.25
● +1150	540136.48	6809218.28
● +1175	540151.43	6809238.32
● +1200	540166.39	6809258.35
● +1225	540172.64	6809262.09
● +1250	540174.62	6809307.01
● +1275	540176.59	6809331.93
● +1300	540178.57	6809356.85
● +1325	540180.54	6809381.78
● +1350	540182.52	6809406.70
● +1375	540184.50	6809431.62
● +1400	540186.47	6809456.54
● +1425	540188.45	6809481.46
● +1450	540190.43	6809506.39
● +1475	540192.40	6809531.31
● +1500	540194.38	6809556.23
● +1525	540196.35	6809581.15
● +1550	540198.33	6809606.07
● +1575	540200.31	6809630.99
● +1600	540202.28	6809655.92
● +1615	540203.49	6809671.13

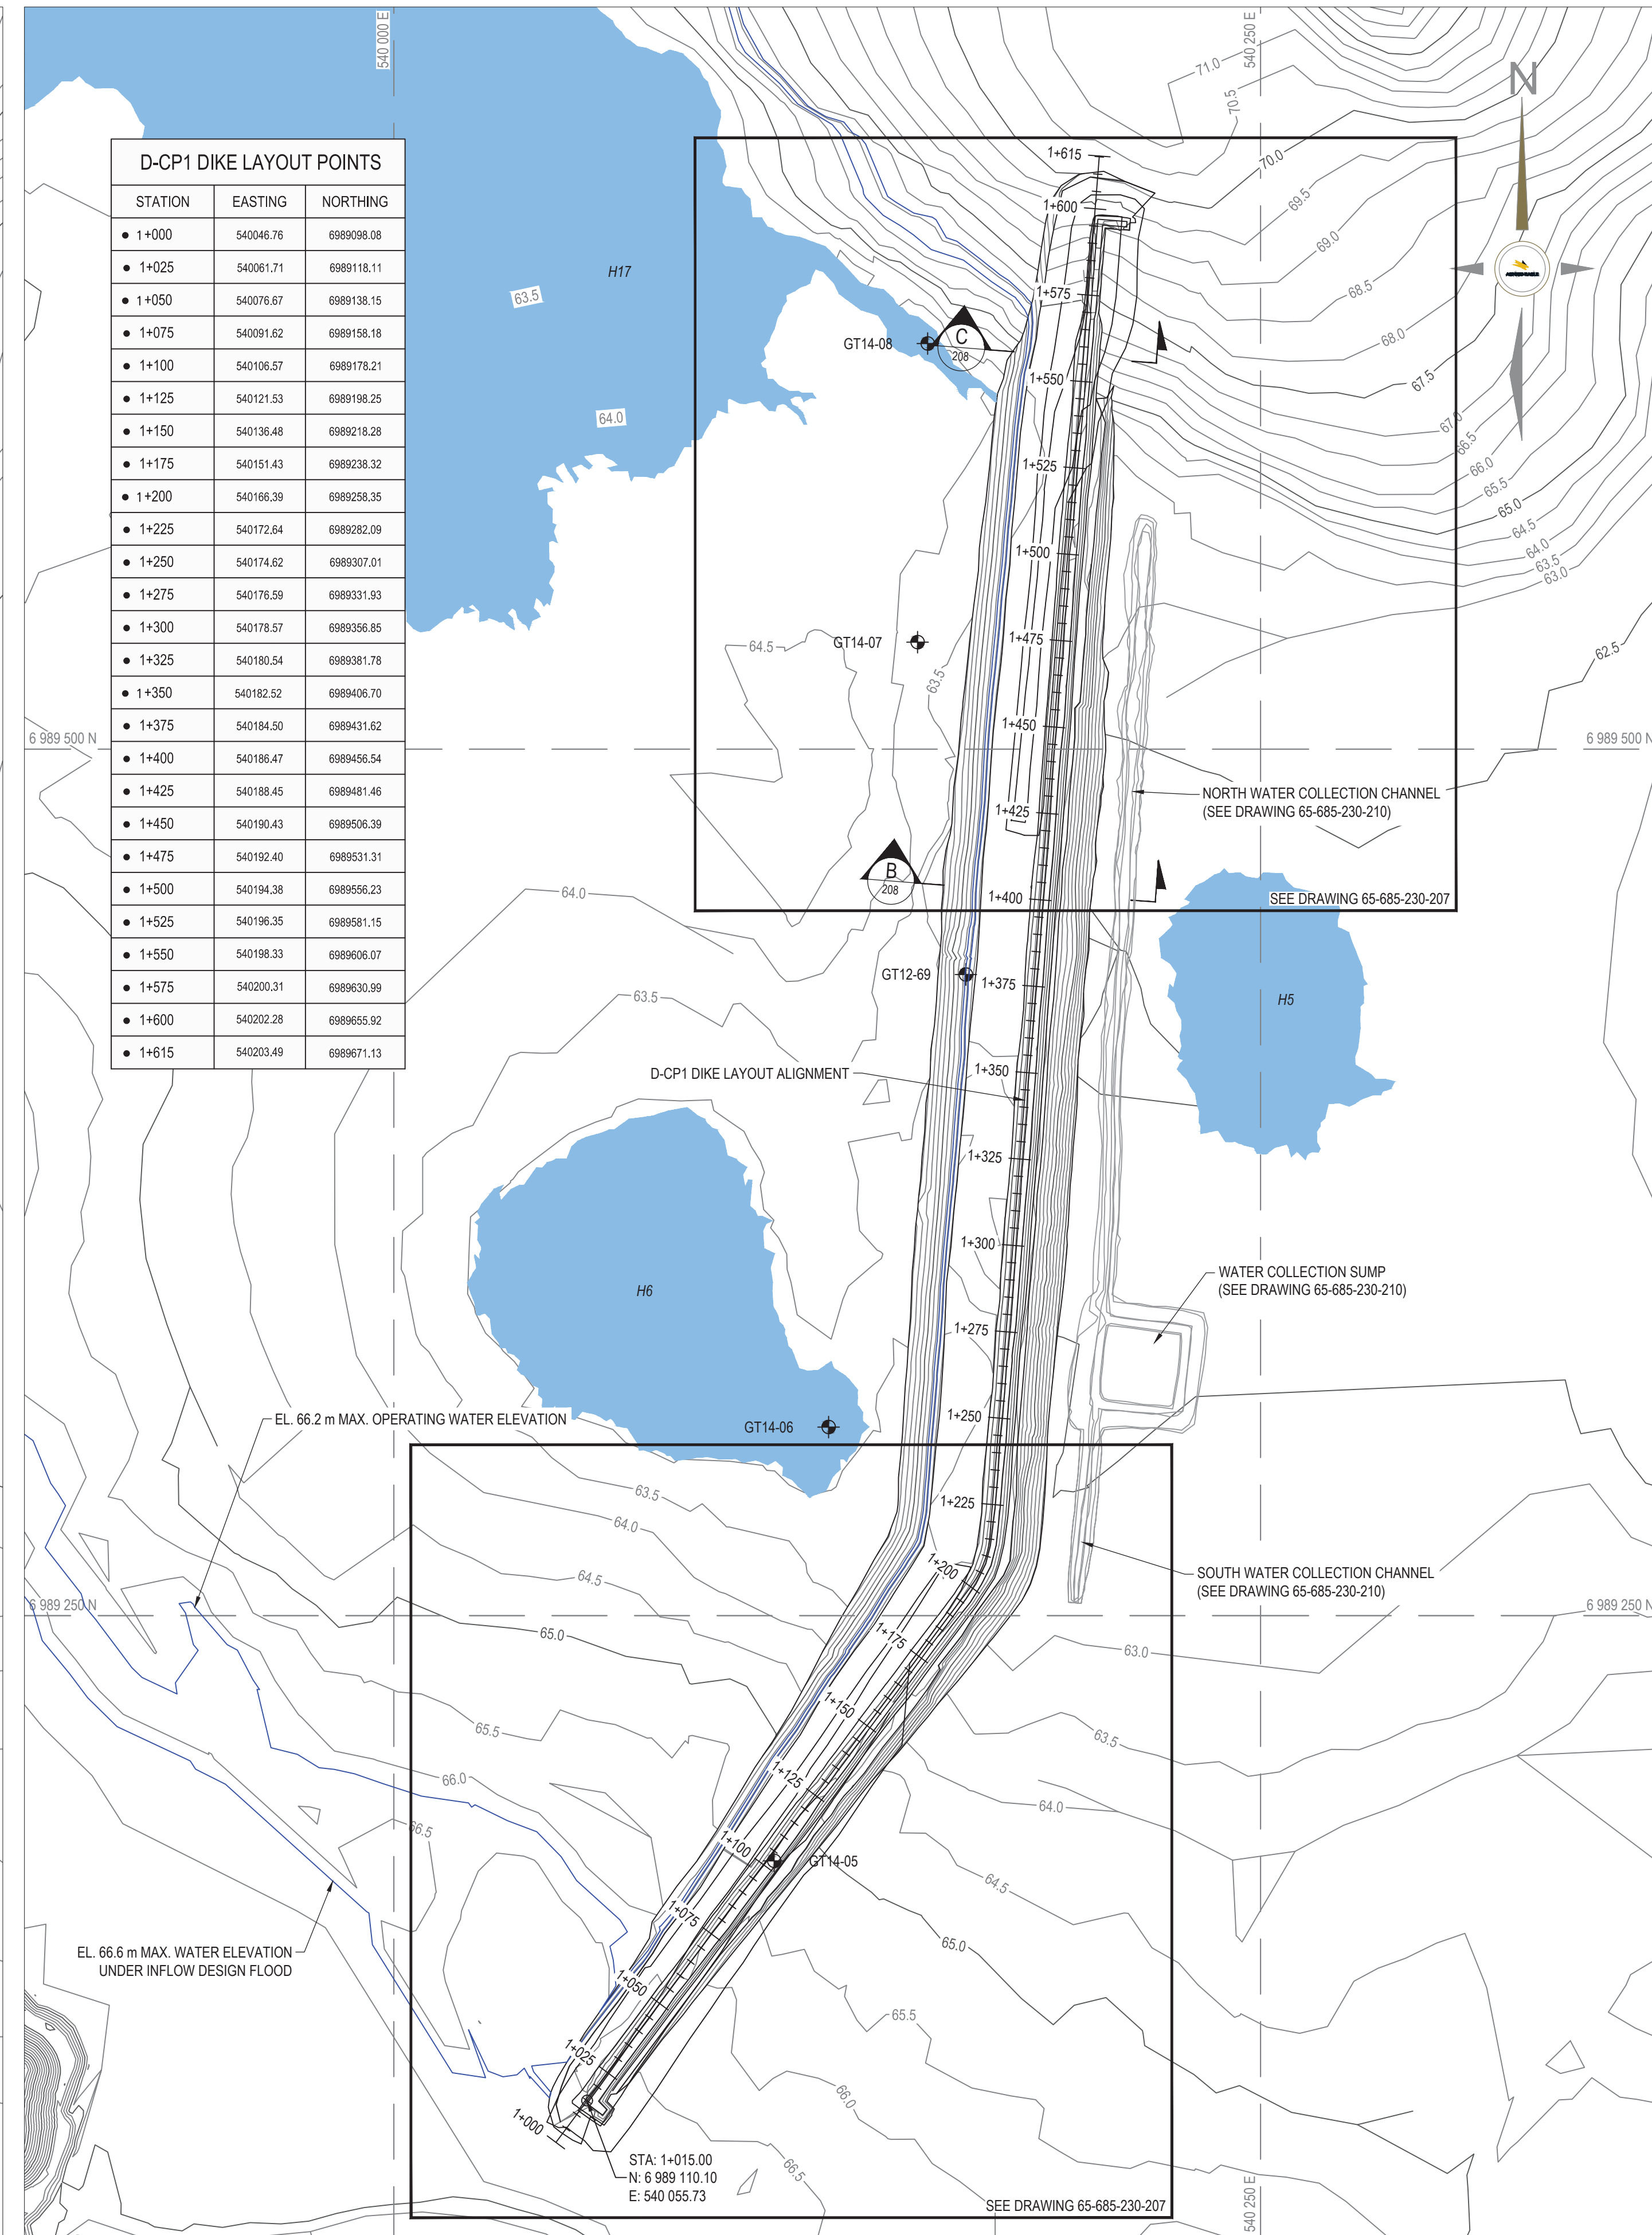


D-CP1 PLAN VIEW
SCALE: 1:1250

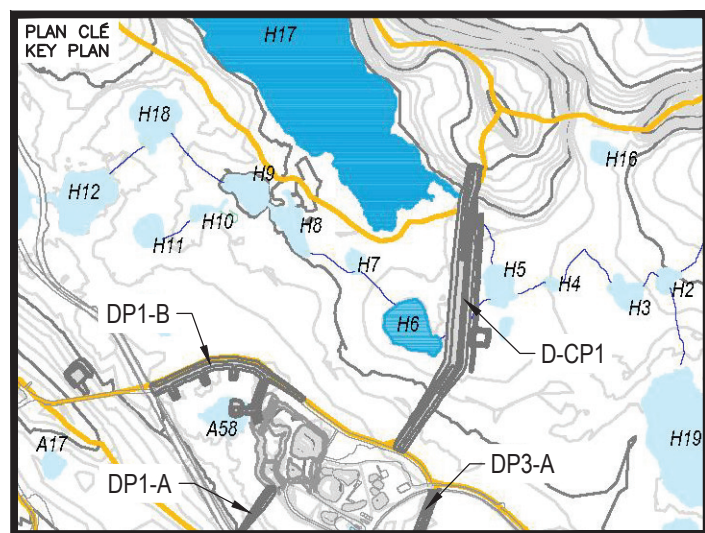

NOTES GÉNÉRALES / GENERAL NOTES

LEGEND

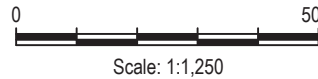

PERMIT TO PRACTICE
TETRA TECH CANADA INC.

Signature *[Signature]*

Date Oct 19, 2017

PERMIT NUMBER: P 018
NT/NU Association of Professional
Engineers and Geoscientists

TEL QUE CONSTRUIT
AS BUILT


THE INFORMATION ON-CONTAINED IS THE PROPERTY OF AIGWCO EAGLE LTD. AND MUST BE RETURNED UPON REQUEST, WITHOUT WRITTEN PERMISSION. ANY COPYING TRANSMITTAL TO OTHERS AND ANY USE EXCEPT THAT FOR WHICH IT IS LOANED ARE PROHIBITED.

DESSINS EN RÉFÉRENCE / REFERENCE DRAWINGS

[illegible]**AGNICO EAGLE**

2	2017-10-19	ISSUED FOR RECORD	WTH	NG	
1	2016-09-26	ISSUED FOR CONSTRUCTION	GZ	KJ	
0	2016-08-15	ISSUED FOR CONSTRUCTION	GZ	KJ	
B	2016-08-11	ISSUED FOR REVIEW	GZ	KJ	
A	2016-08-05	ISSUED FOR REVIEW	GZ	KJ	
REV.	DATE	DESCRIPTION	PAR/BY	APP.	CLIENT

REVISIONS

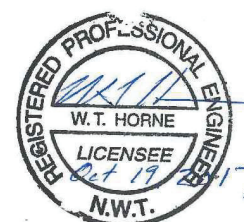


TITRE / TITLE	AGNICO EAGLE MELIADINE GOLD PROJECT
---------------	-------------------------------------

D-CP1 AS-BUILT
KEY TRENCH AND DIKE LAYOUT PLAN


DESSINÉ PAR DRAWN BY EL		DATE 2017-10-06
VÉRIFIÉ PAR CHECKED BY WTH		2017-10-06
APPROUVÉ PAR APPROVED BY NG		2017-10-06
ÉCHELLE SCALE 1:1250	DATE 2017-10-06	

65-685-230-205


NO. PROJ. PROJECT NO.	REVISION	FEUILLE / SHT
6515	2	2 / 12

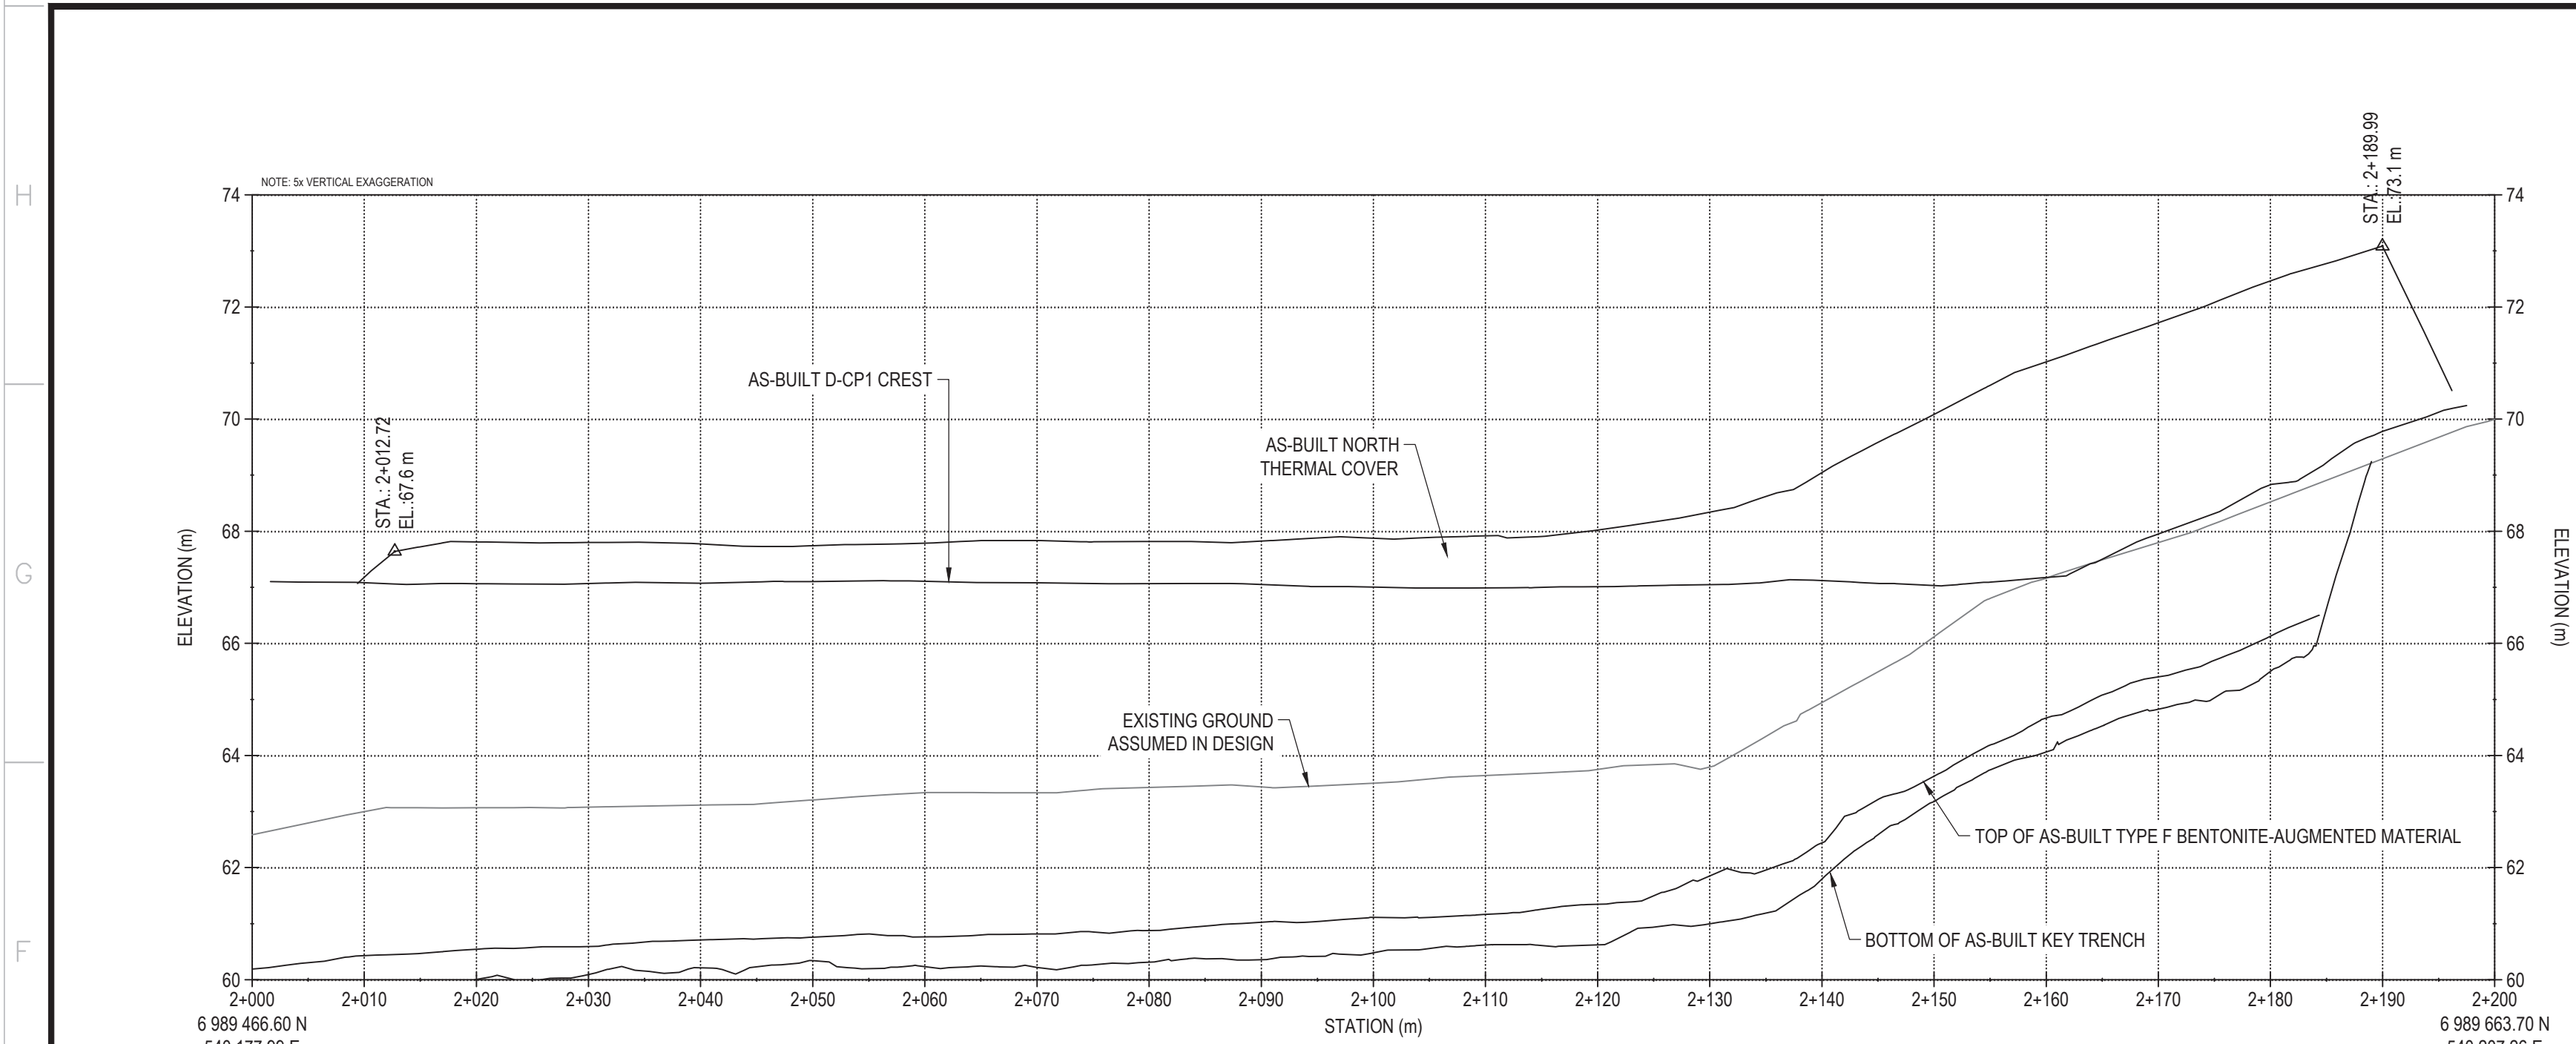

D-CP1 NORTH THERMAL COVER PROFILE
SCALE: H=1:500 V=1:100

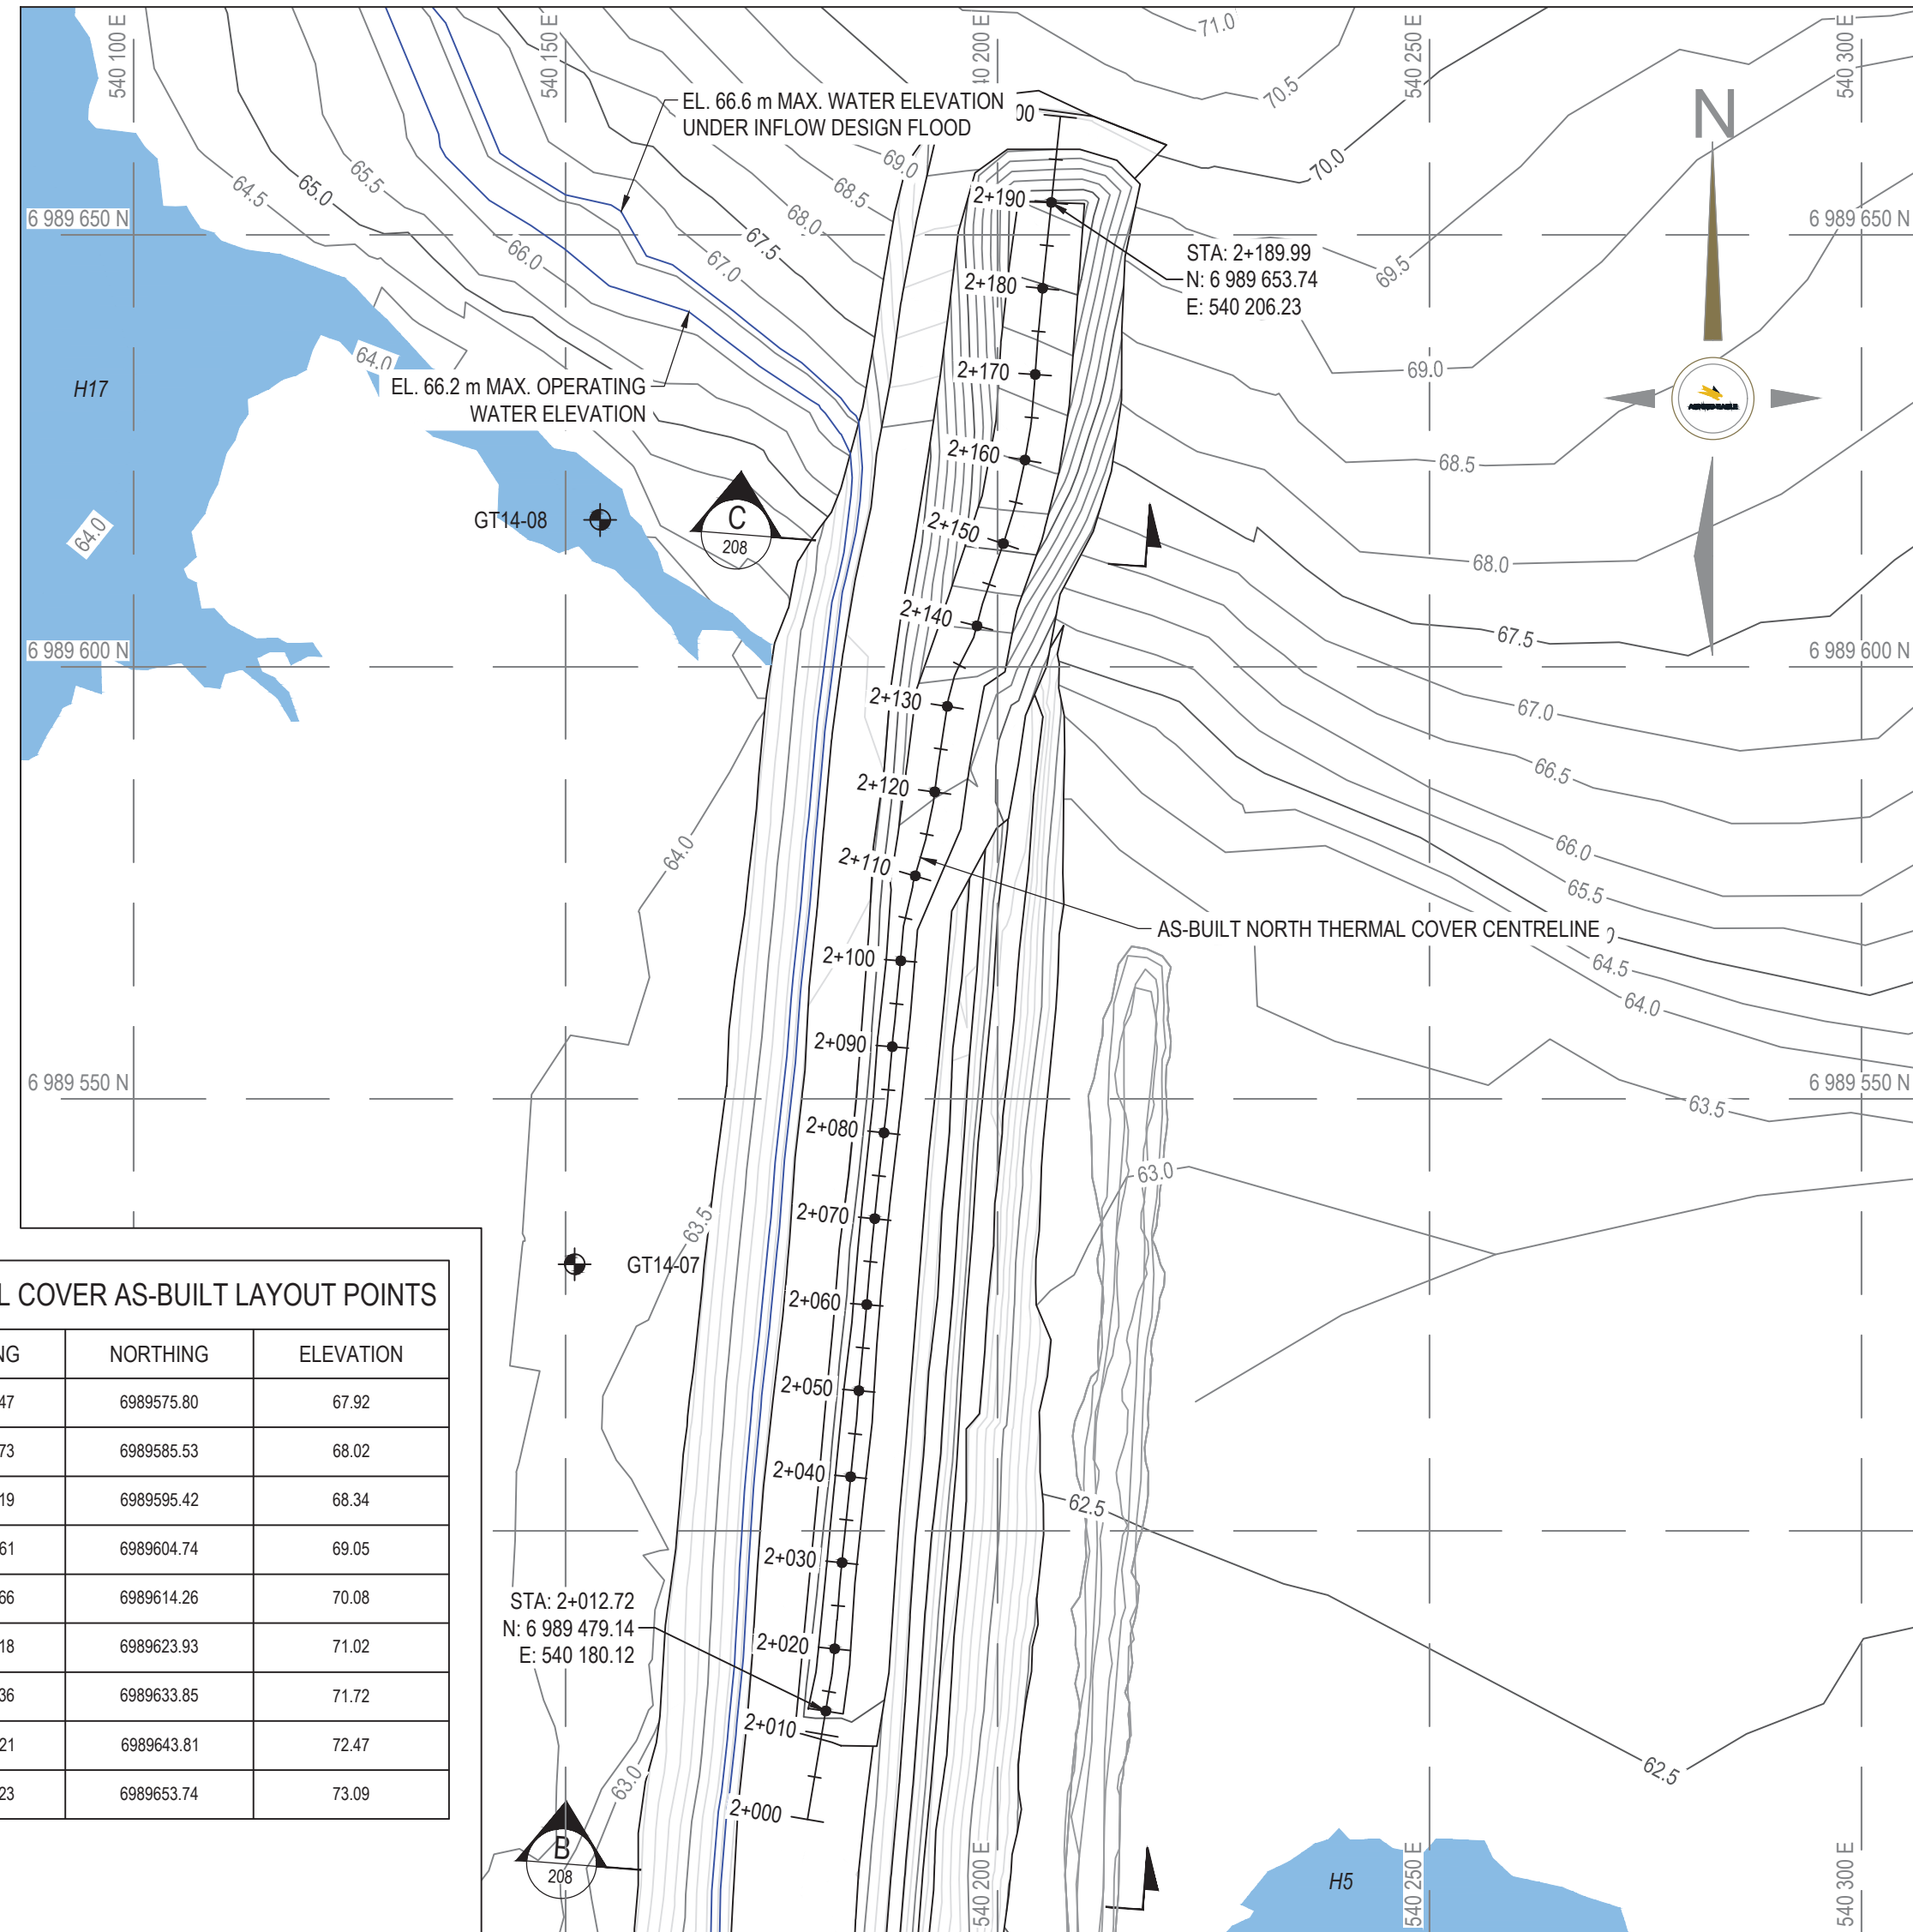


D-CP1 NORTH THERMAL COVER
SCALE: 1:750

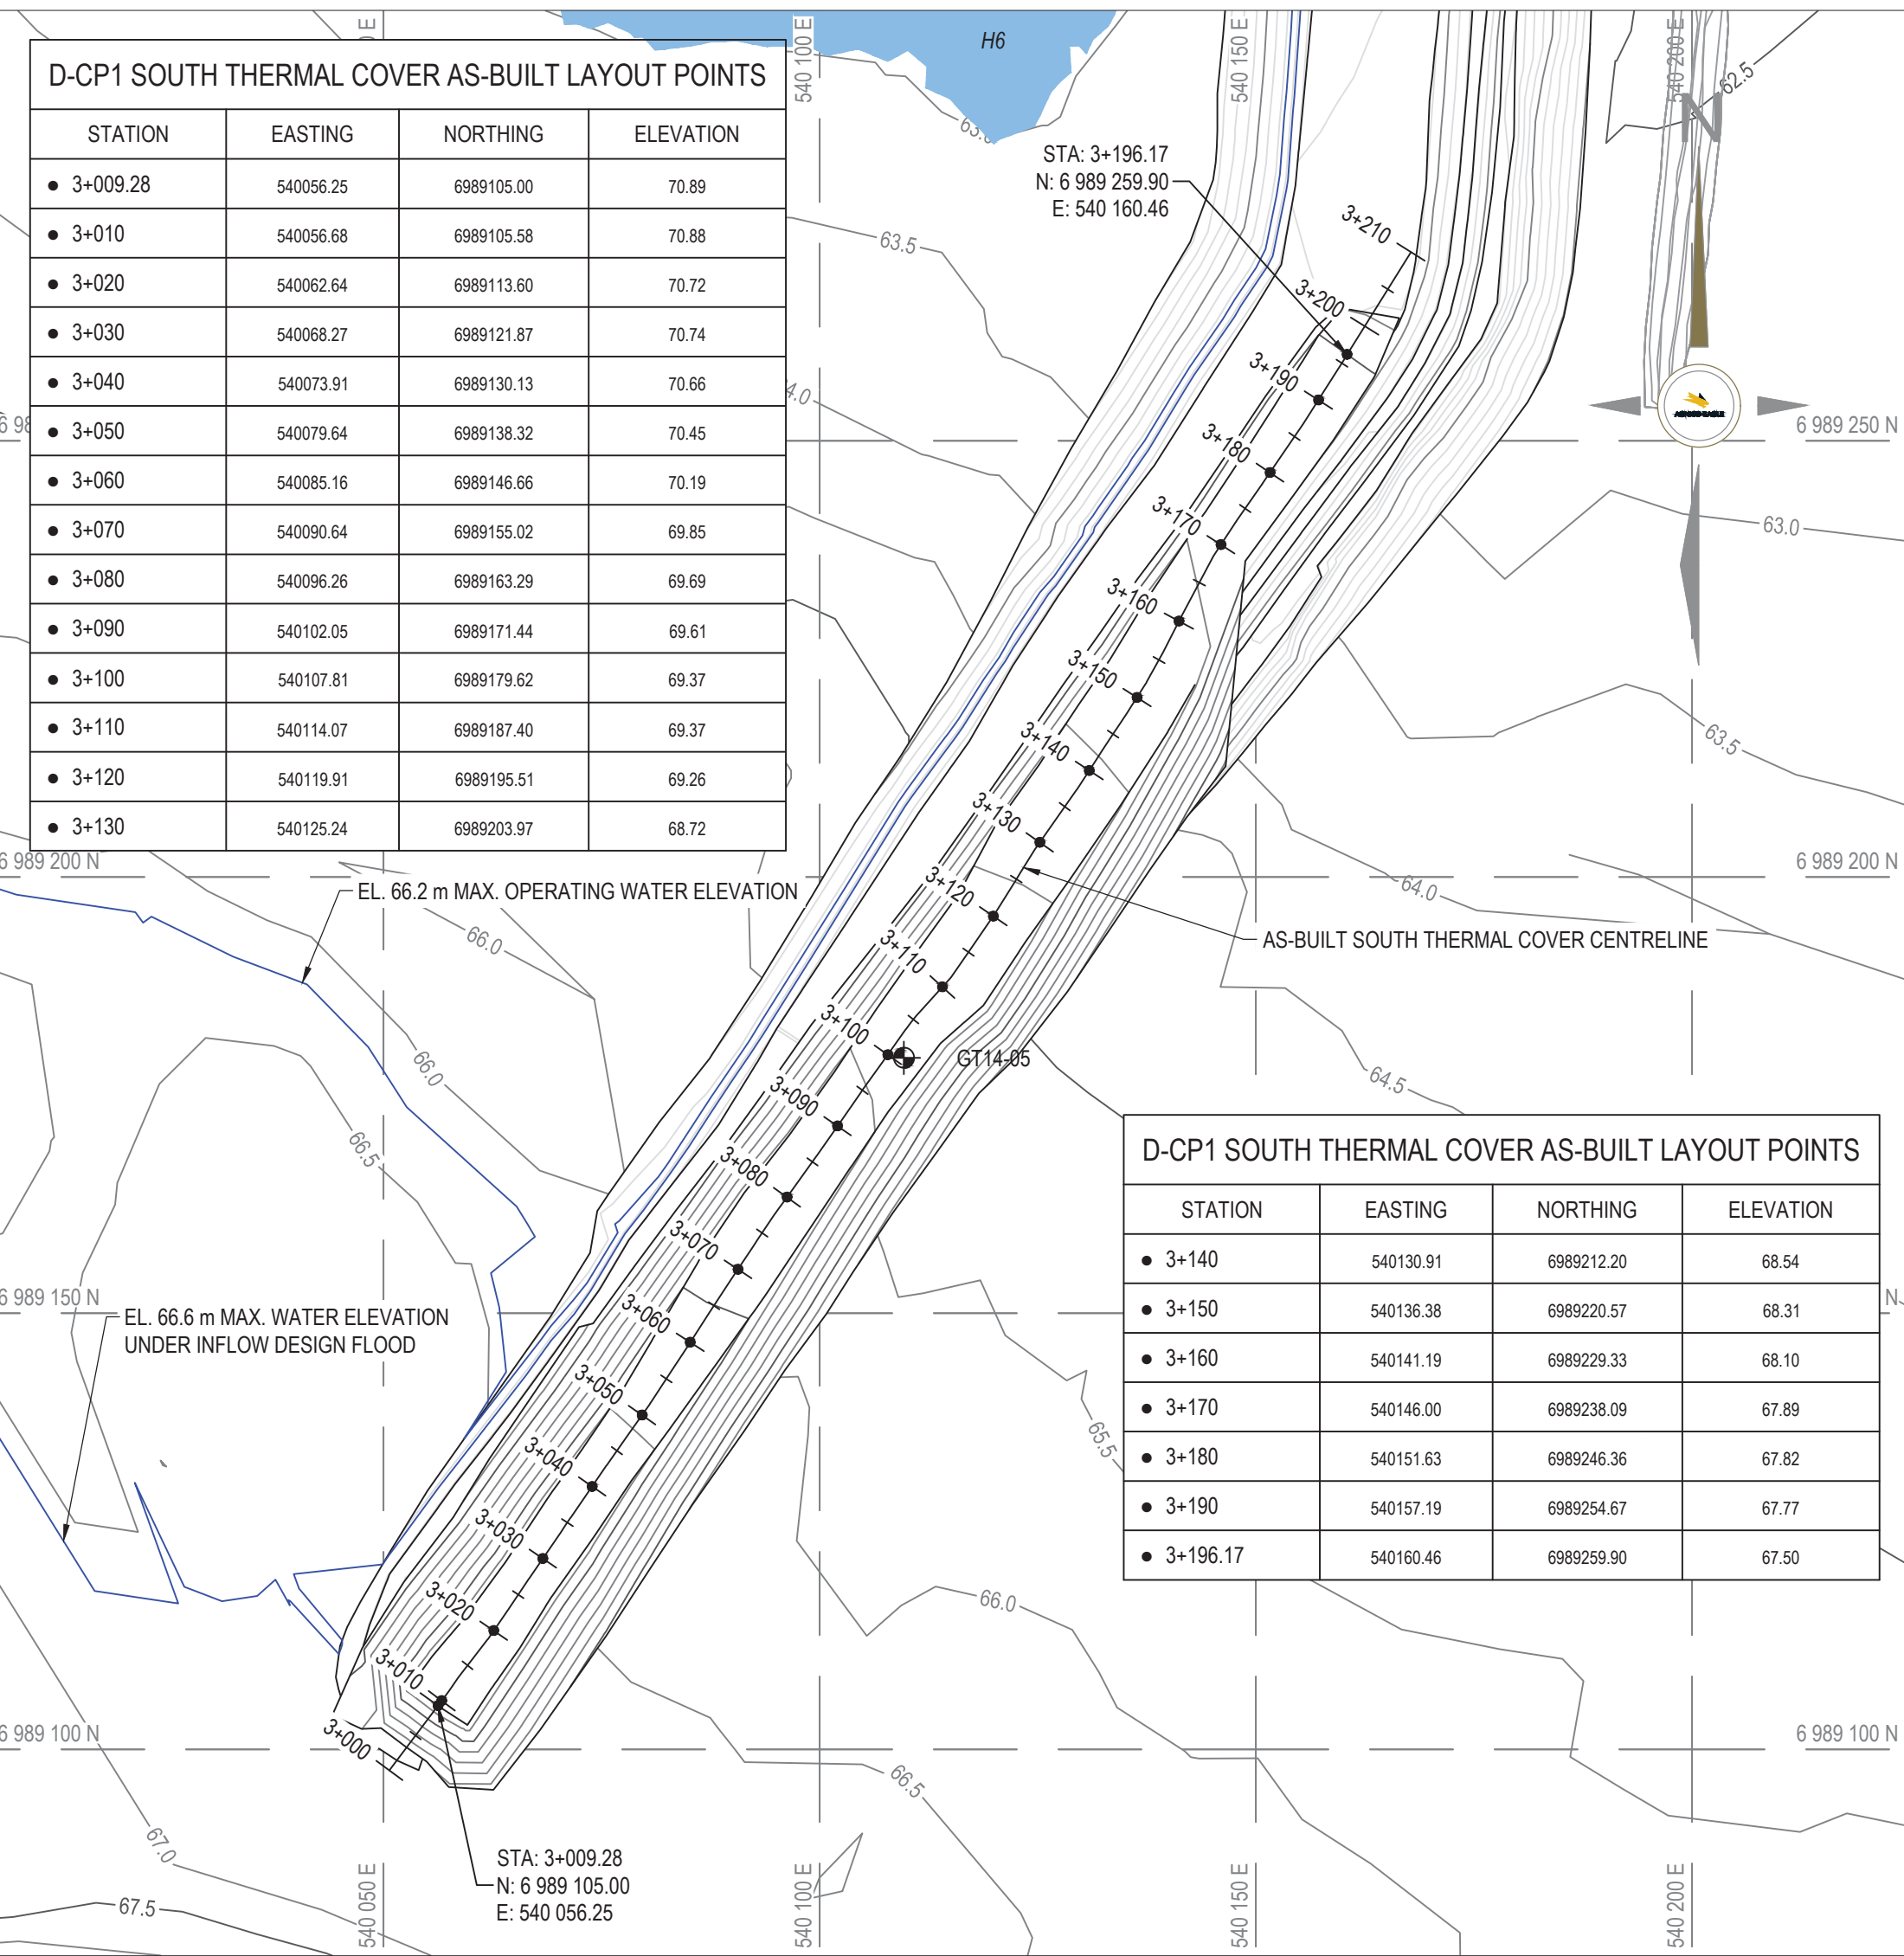


D-CP1 SOUTH THERMAL COVER
SCALE: 1:750

D-CP1 NORTH THERMAL COVER AS-BUILT LAYOUT POINTS			
STATION	EASTING	NORTHING	ELEVATION
• 2+012.72	540180.12	6989479.14	67.64
• 2+020	540181.14	6989486.34	67.81
• 2+030	540181.99	6989496.31	67.80
• 2+040	540183.00	6989506.25	67.77
• 2+050	540183.95	6989516.21	67.74
• 2+060	540184.86	6989526.17	67.79
• 2+070	540185.78	6989536.12	67.84
• 2+080	540186.85	6989546.07	67.82
• 2+090	540187.81	6989556.02	67.82
• 2+100	540188.79	6989565.97	67.87

D-CP1 NORTH THERMAL COVER AS-BUILT LAYOUT POINTS			
STATION	EASTING	NORTHING	ELEVATION
• 2+110	540190.47	6989575.80	67.92
• 2+120	540192.73	6989585.53	68.02
• 2+130	540194.19	6989596.42	68.34
• 2+140	540197.61	6989604.74	69.05
• 2+150	540200.66	6989614.26	70.08
• 2+160	540203.18	6989623.93	71.02
• 2+170	540204.36	6989633.85	71.72
• 2+180	540205.21	6989643.81	72.47
• 2+189.99	540206.23	6989653.74	73.09

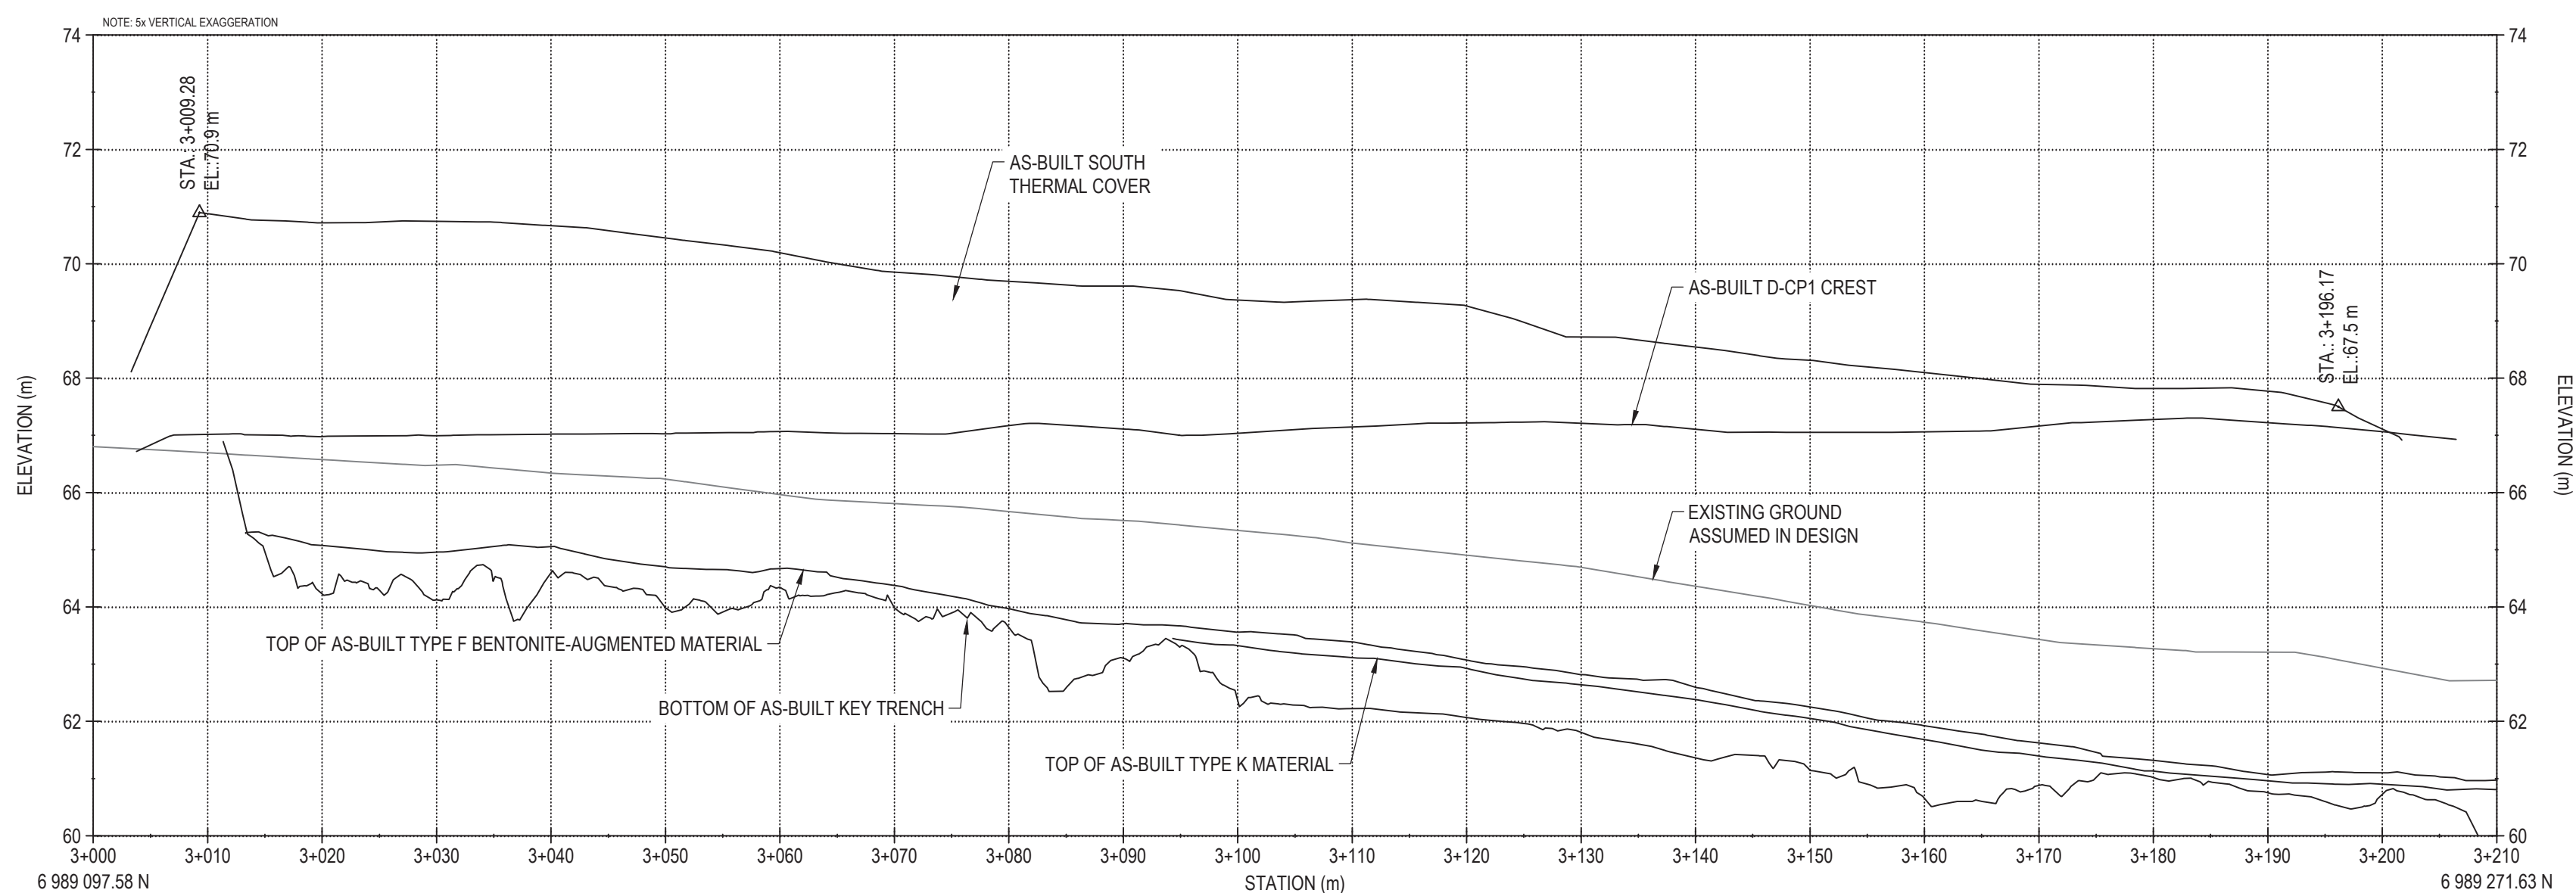

D-CP1 SOUTH THERMAL COVER PROFILE
SCALE: H=1:500 V=1:100

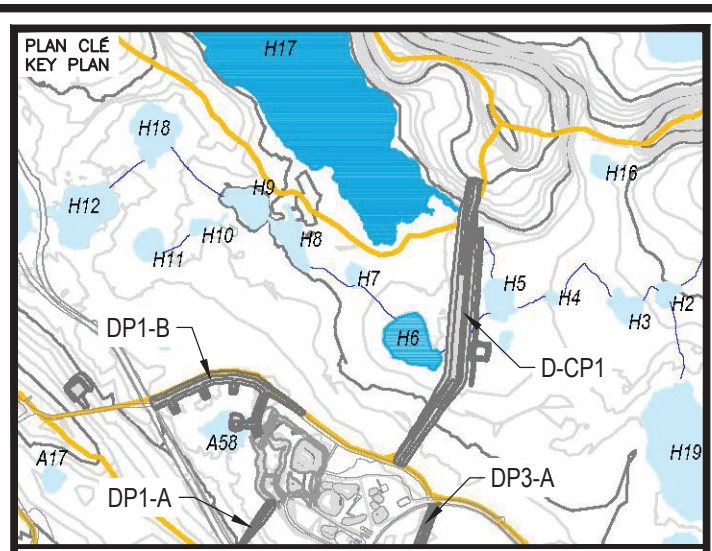

NOTES GÉNÉRALES / GENERAL NOTES

LEGEND

BOREHOLE

PERMIT TO PRACTICE
TETRA TECH CANADA INC.

Signature: [Signature]

Date: [Date]

PERMIT NUMBER: P 018

NT/NU Association of Professional
Engineers and Geoscientists



L'INFORMATION D-CONTRÔLE EST LA PROPRIÉTÉ DE L'AGNICO EAGLE LTD. ET DOIT ÊTRE RETENUE SUR DEMANDE, SANS AUTORIZATION ÉCRITE. PRÉPARÉ PAR: [Nom] RÉVISÉ PAR: [Nom] APPROUVÉ PAR: [Nom] DATE: [Date] L'AGNICO EAGLE LTD. EST LE PROPRIÉTAIRE DE L'INFORMATION D-CONTRÔLE. L'AGNICO EAGLE LTD. EST LE PROPRIÉTAIRE DE L'INFORMATION D-CONTRÔLE. L'AGNICO EAGLE LTD. EST LE PROPRIÉTAIRE DE L'INFORMATION D-CONTRÔLE. L'AGNICO EAGLE LTD. EST LE PROPRIÉTAIRE DE L'INFORMATION D-CONTRÔLE.


DESSEINS EN RÉFÉRENCE / REFERENCE DRAWINGS

TITLE / TITRE	# DWG
---	---
---	---
2	2017-10-19	ISSUED FOR RECORD	WTH	NG
1	2016-09-26	ISSUED FOR CONSTRUCTION	GZ	KJ
0	2016-08-15	ISSUED FOR CONSTRUCTION	GZ	KJ
B	2016-08-11	ISSUED FOR REVIEW	GZ	KJ
A	2016-08-05	ISSUED FOR REVIEW	GZ	KJ
REV.	DATE	DESCRIPTION	PAR/ETI	APP. CLIENT

REVISIONS

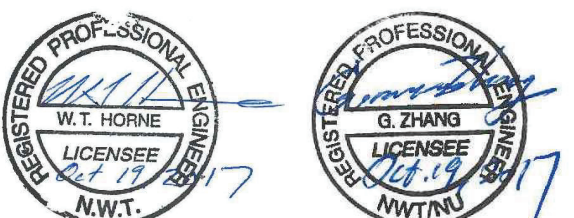

TITRE / TITLE
AGNICO EAGLE MELIADINE GOLD PROJECT

D-CP1 AS-BUILT THERMAL COVER
LAYOUT PLAN AND PROFILES

DESSEIN PAR EL DATE 2017-10-06


VÉRIFIÉ PAR WTH 2017-10-06

APPROUVÉ PAR NG 2017-10-06

ÉCHELLE AS SHOWN DATE 2017-10-06

NO. DESIGN 65-685-230-207

NO. PROJET	REVISION	FEUILLE / SHEET
6515	2	4 / 12

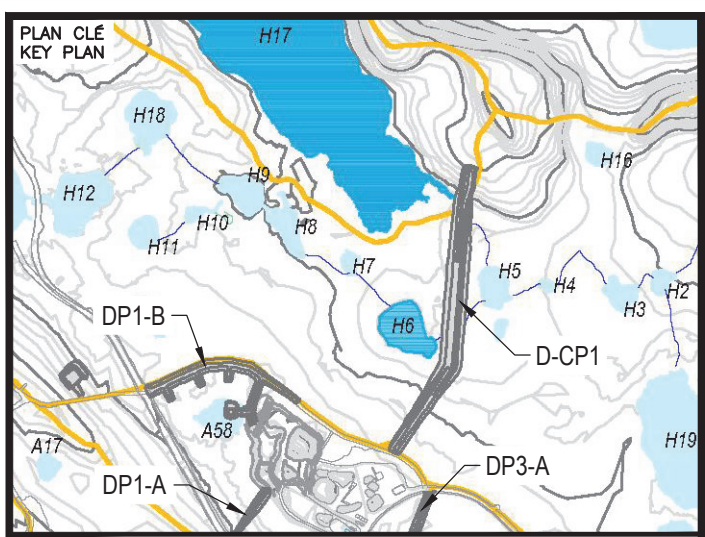

NOTES GÉNÉRALES / GENERAL NOTES

LEGEND

- (A) RUN-OF-MINE ROCKFILL (600 mm MINUS) IN DIKE UPSTREAM AND FOR THERMAL COVER
- (A1) RUN-OF-MINE ROCKFILL (600 mm MINUS) IN DIKE DOWNSTREAM
- (B) TRANSITION ROCKFILL (150 mm MINUS)
- (B1) TRANSITION ROCKFILL (150 mm MINUS)
- (C) GRANULAR FILL OR ESKER SAND (20 mm MINUS)
- (F) BENTONITE-AUGMENTED MATERIAL (MIXTURE OF BENTONITE AND TYPE C MATERIAL)
- (H) ESKER SAND AND GRAVEL (75 mm MINUS)
- (K) NEARLY-SATURATED BACKFILL (20 mm MINUS)

DASHED LINES REFER TO NO AS-BUILT DATA BUT
ESTIMATED BASED ON FIELD VISUAL OBSERVATION

COLETANCHE ES2 LINER WAS USED FOR ABOVE
ORIGINAL GROUND PORTION OF THE LINER FOR
STATIONS 1+520 TO 1+570

STATIONS 1+520 TO 1+570

TEL QUE CONSTRUIT
AS BUILT

AGNICO EAGLE DATE : 2017-10

THE INFORMATION CONTAINED HEREON IS THE PROPERTY OF AGNICO EAGLE LTD. AND MUST BE RETURNED UPON REQUEST, WITHOUT WRITTEN PERMISSION, ANY COPYING TRANSMITTAL TO OTHERS AND ANY USE, EXCEPT THAT FOR WHICH IT IS LOANED ARE PROHIBITED.
 (C) AGNICO EAGLE LTD.

DESSINS EN RÉFÉRENCE / REFERENCE DRAWINGS

TITRE / TITLE	# DWG
---	---
---	---
AGNICO EAGLE

2	2017-10-19	ISSUED FOR RECORD	WTH	NG	
1	2016-09-26	ISSUED FOR CONSTRUCTION	GZ	KJ	
0	2016-08-15	ISSUED FOR CONSTRUCTION	GZ	KJ	
B	2016-08-11	ISSUED FOR REVIEW	GZ	KJ	
A	2016-08-05	ISSUED FOR REVIEW	GZ	KJ	
REV.	DATE	DESCRIPTION	PAR/BY	APP.	CLIENT

REVISIONS




TITRE / TITLE
AGNICO EAGLE MELIADINE GOLD PROJECT

D-CP1 AS-BUILT
TYPICAL SECTIONS AND QUANTITIES

DESIGNED PAR DRAWN BY	EL	DATE 2017-09-21
VERIFIED PAR CHECKED BY	WTH	2017-09-21
APPROVED PAR APPROVED BY	NG	2017-09-21


ECHELLE SCALE		1:75	DATE		2017-09-22
NO. DESSIN DRAWING NO.					
65-685-230-208					
NO. PROJET PROJECT NO.			REVISION		FEUILLE / SHEET
			2		5 / 9

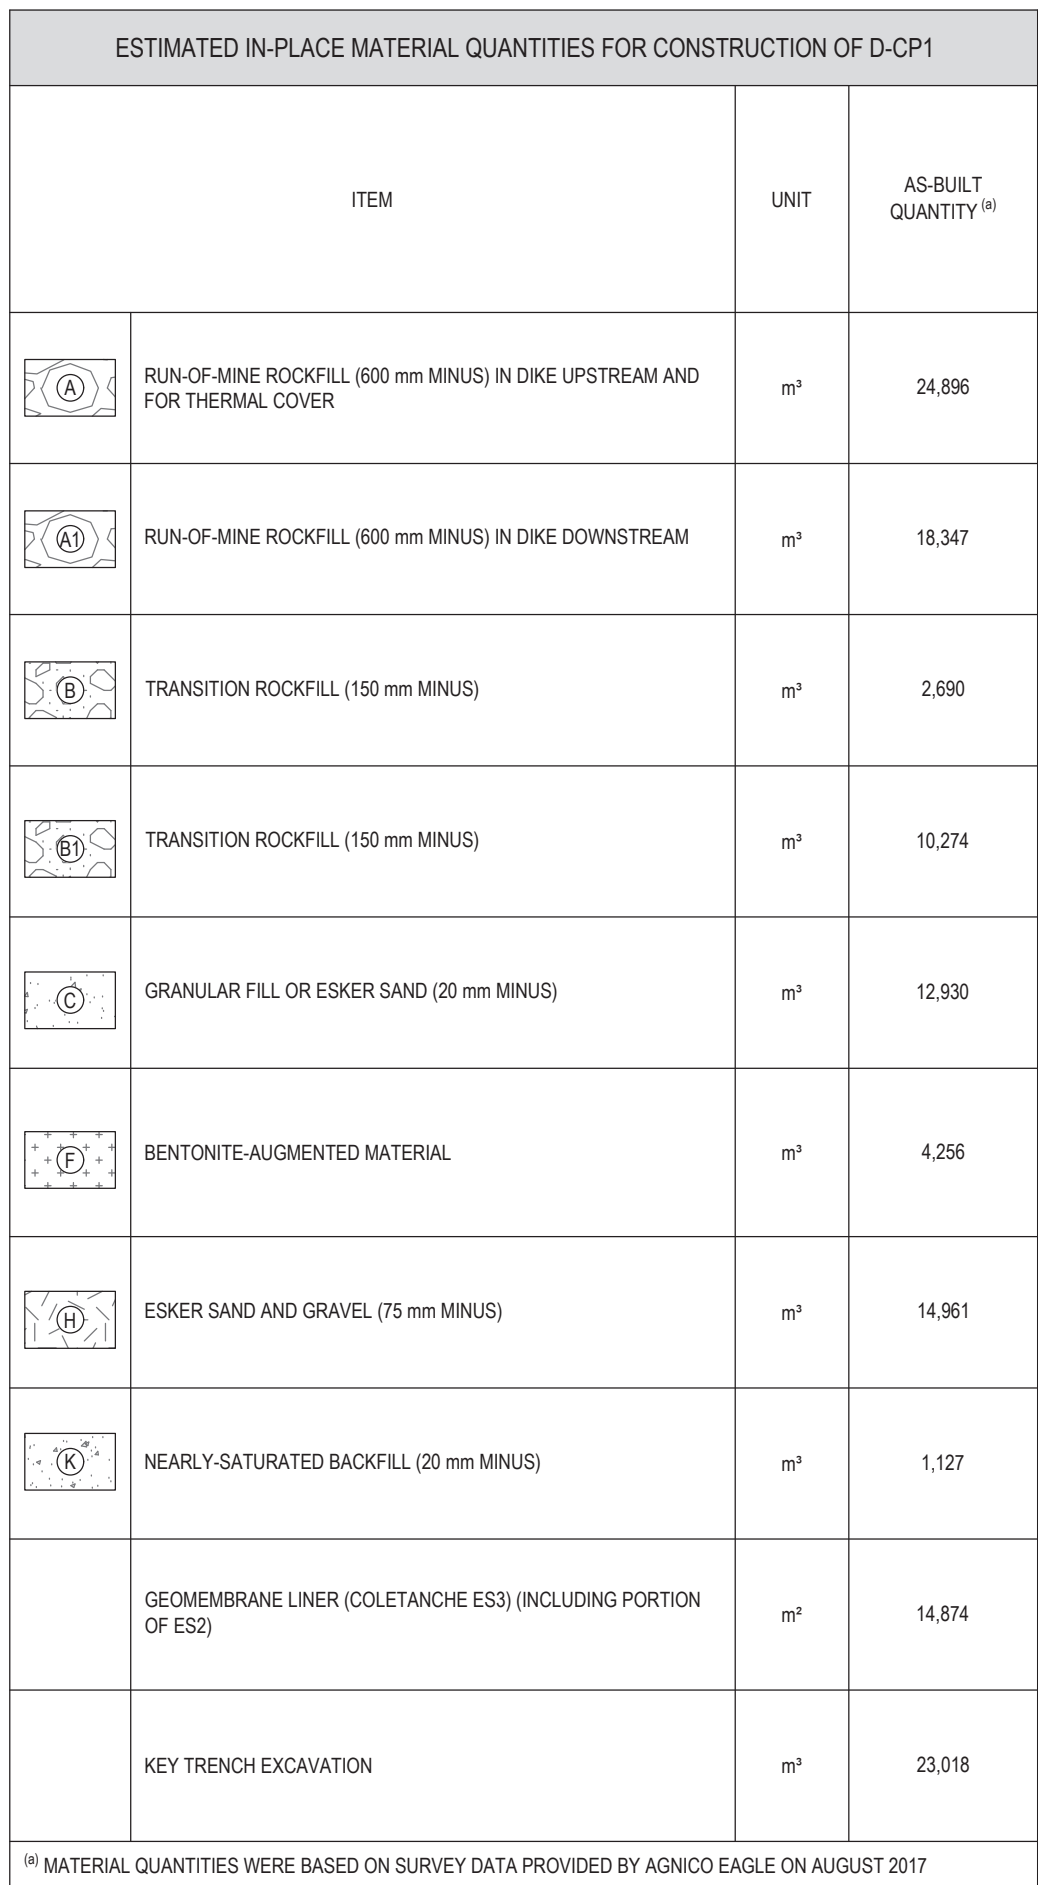


(a) MATERIAL QUANTITIES WERE BASED ON SURVEY DATA PROVIDED BY AGNICO EAGLE ON AUGUST 2011.

NOTE

THE DESIGN MINIMUM LINER CREST ELEVATION WAS 67.50 m
THE DESIGN MINIMUM LINER CREST ELEVATION IS 67.37 m.


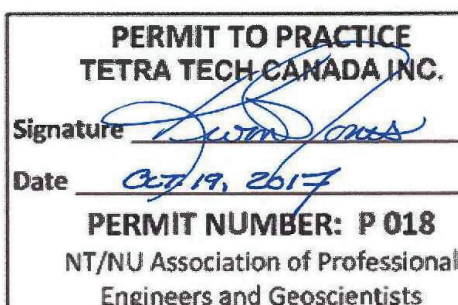


D-CP5 THERMAL COVER LAYOUT POINTS			
STATION	EASTING	NORTHING	ELEVATION
● 2+230	540317.70	6988597.83	67.75
● 2+240	540325.86	6988603.61	67.95
● 2+250	540334.20	6988609.14	68.25
● 2+260	540342.58	6988614.59	68.59
● 2+270	540350.91	6988620.11	68.80
● 2+280	540359.23	6988625.66	69.09
● 2+290	540367.59	6988631.15	69.62
● 2+300	540375.94	6988636.65	69.90
● 2+309.57	540383.79	6988642.13	69.86

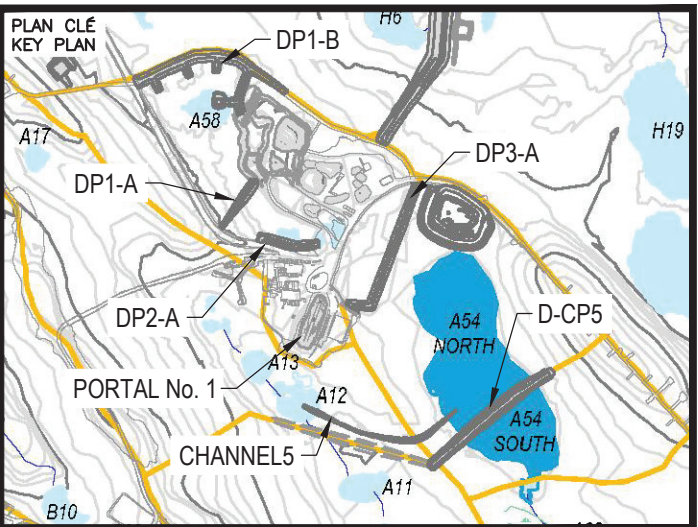

NOTES GÉNÉRALES / GENERAL NOTES

LEGEND

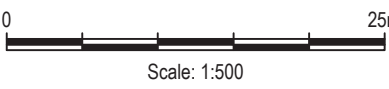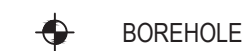

PERMIT TO PRACTICE
TETRA TECH CANADA INC.

Signature *[Signature]*

Date Oct 19, 2017

PERMIT NUMBER: P 018
NT/NU Association of Professional
Engineers and Geoscientists

TEL QUE CONSTRUIT
AS BUILT

AGNICO EAGLE

DATE : 2017-10-19

L'INFORMATION CI-DESSOUS EST LA PROPRIÉTÉ DE AONCO EAGLE LTD. ET DOIT ÊTRE RETOURNÉE SUR DEMANDE, SANS AUTORISATION ÉCRITE PRÉALABLE, TOUTE TRANSMISSION DE COPIES) A AUTRI (ET TOUTE UTILISATION AUTRE QUE CELLE POUR LAQUELLE L'INFORMATION EST PRÊTÉE) SONT INTERDITES.
 AONCO EAGLE LTD.
 THE INFORMATION HERE ON IS THE PROPERTY OF AONCO EAGLE LTD. AND MUST BE RETURNED UPON REQUEST, WITHOUT WRITTEN PERMISSION, ANY COPYING, TRANSMITTING TO OTHERS AND ANY USE EXCEPT THAT FOR WHICH IT IS LOANED ARE PROHIBITED.
 AONCO EAGLE LTD.

DESSINS EN RÉFÉRENCE / REFERENCE DRAWINGS

TITRE / TITLE	# DWG
-	-
-	-
AGNICO EAGLE

1	2017-10-19	ISSUED FOR RECORD	WITH	NG					
0	2016-08-15	ISSUED FOR CONSTRUCTION	GZ	KJ					
A	2016-08-10	ISSUED FOR REVIEW	GZ	KJ					
REV.	DATE	DESCRIPTION	PAR/BY	APP.	CLIENT				
REVISIONS									

REVISIONS



TITLE / TITLE
AGNICO EAGLE MELIADINE GOLD PROJECT



D-CP5 AS-BUILT THERMAL COVER
LAYOUT PLAN AND PROFILES

DESIGNÉ PAR DRAWN BY	EL	DATE 2016-08-1
VÉRIFIÉ PAR CHECKED BY	GZ	2016-08-1
APPROUVÉ PAR APPROVED BY	GZ	2016-08-1

CHELLE CALE	1:500	DATE	2016-08-15
----------------	-------	------	------------

65-685-230-217

NO. PROJET PROJECT NO.	REVISION	FEUILLE / SHEET
6515	1	4 / 9

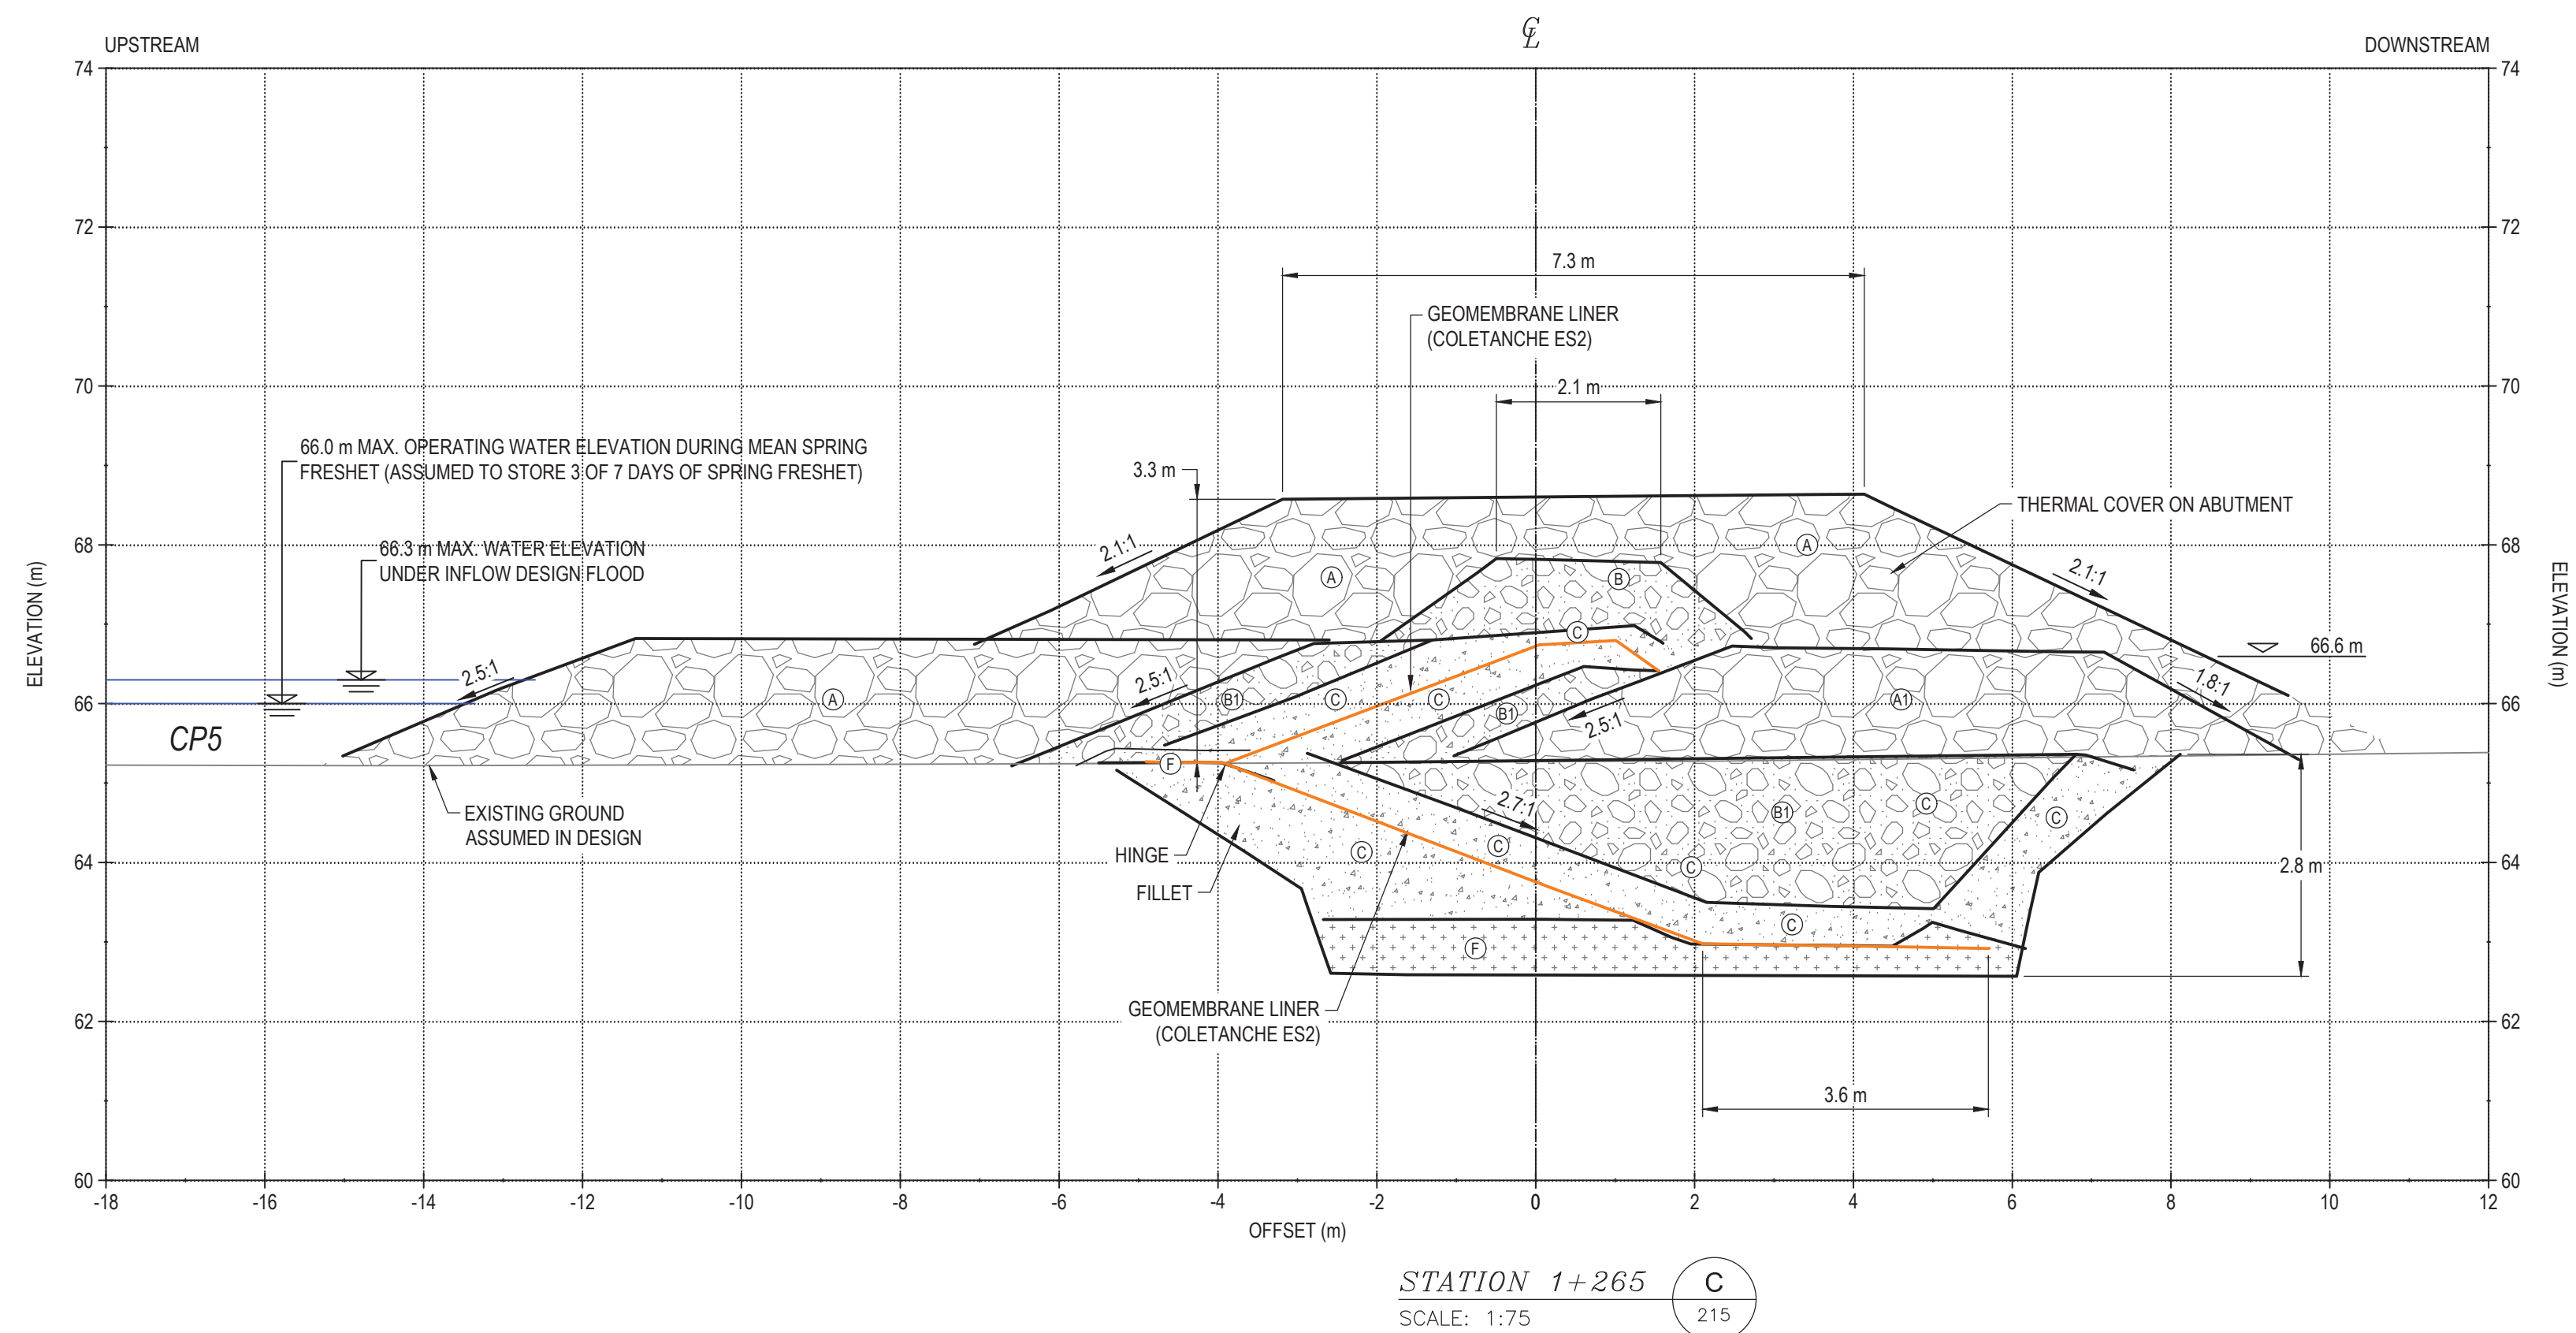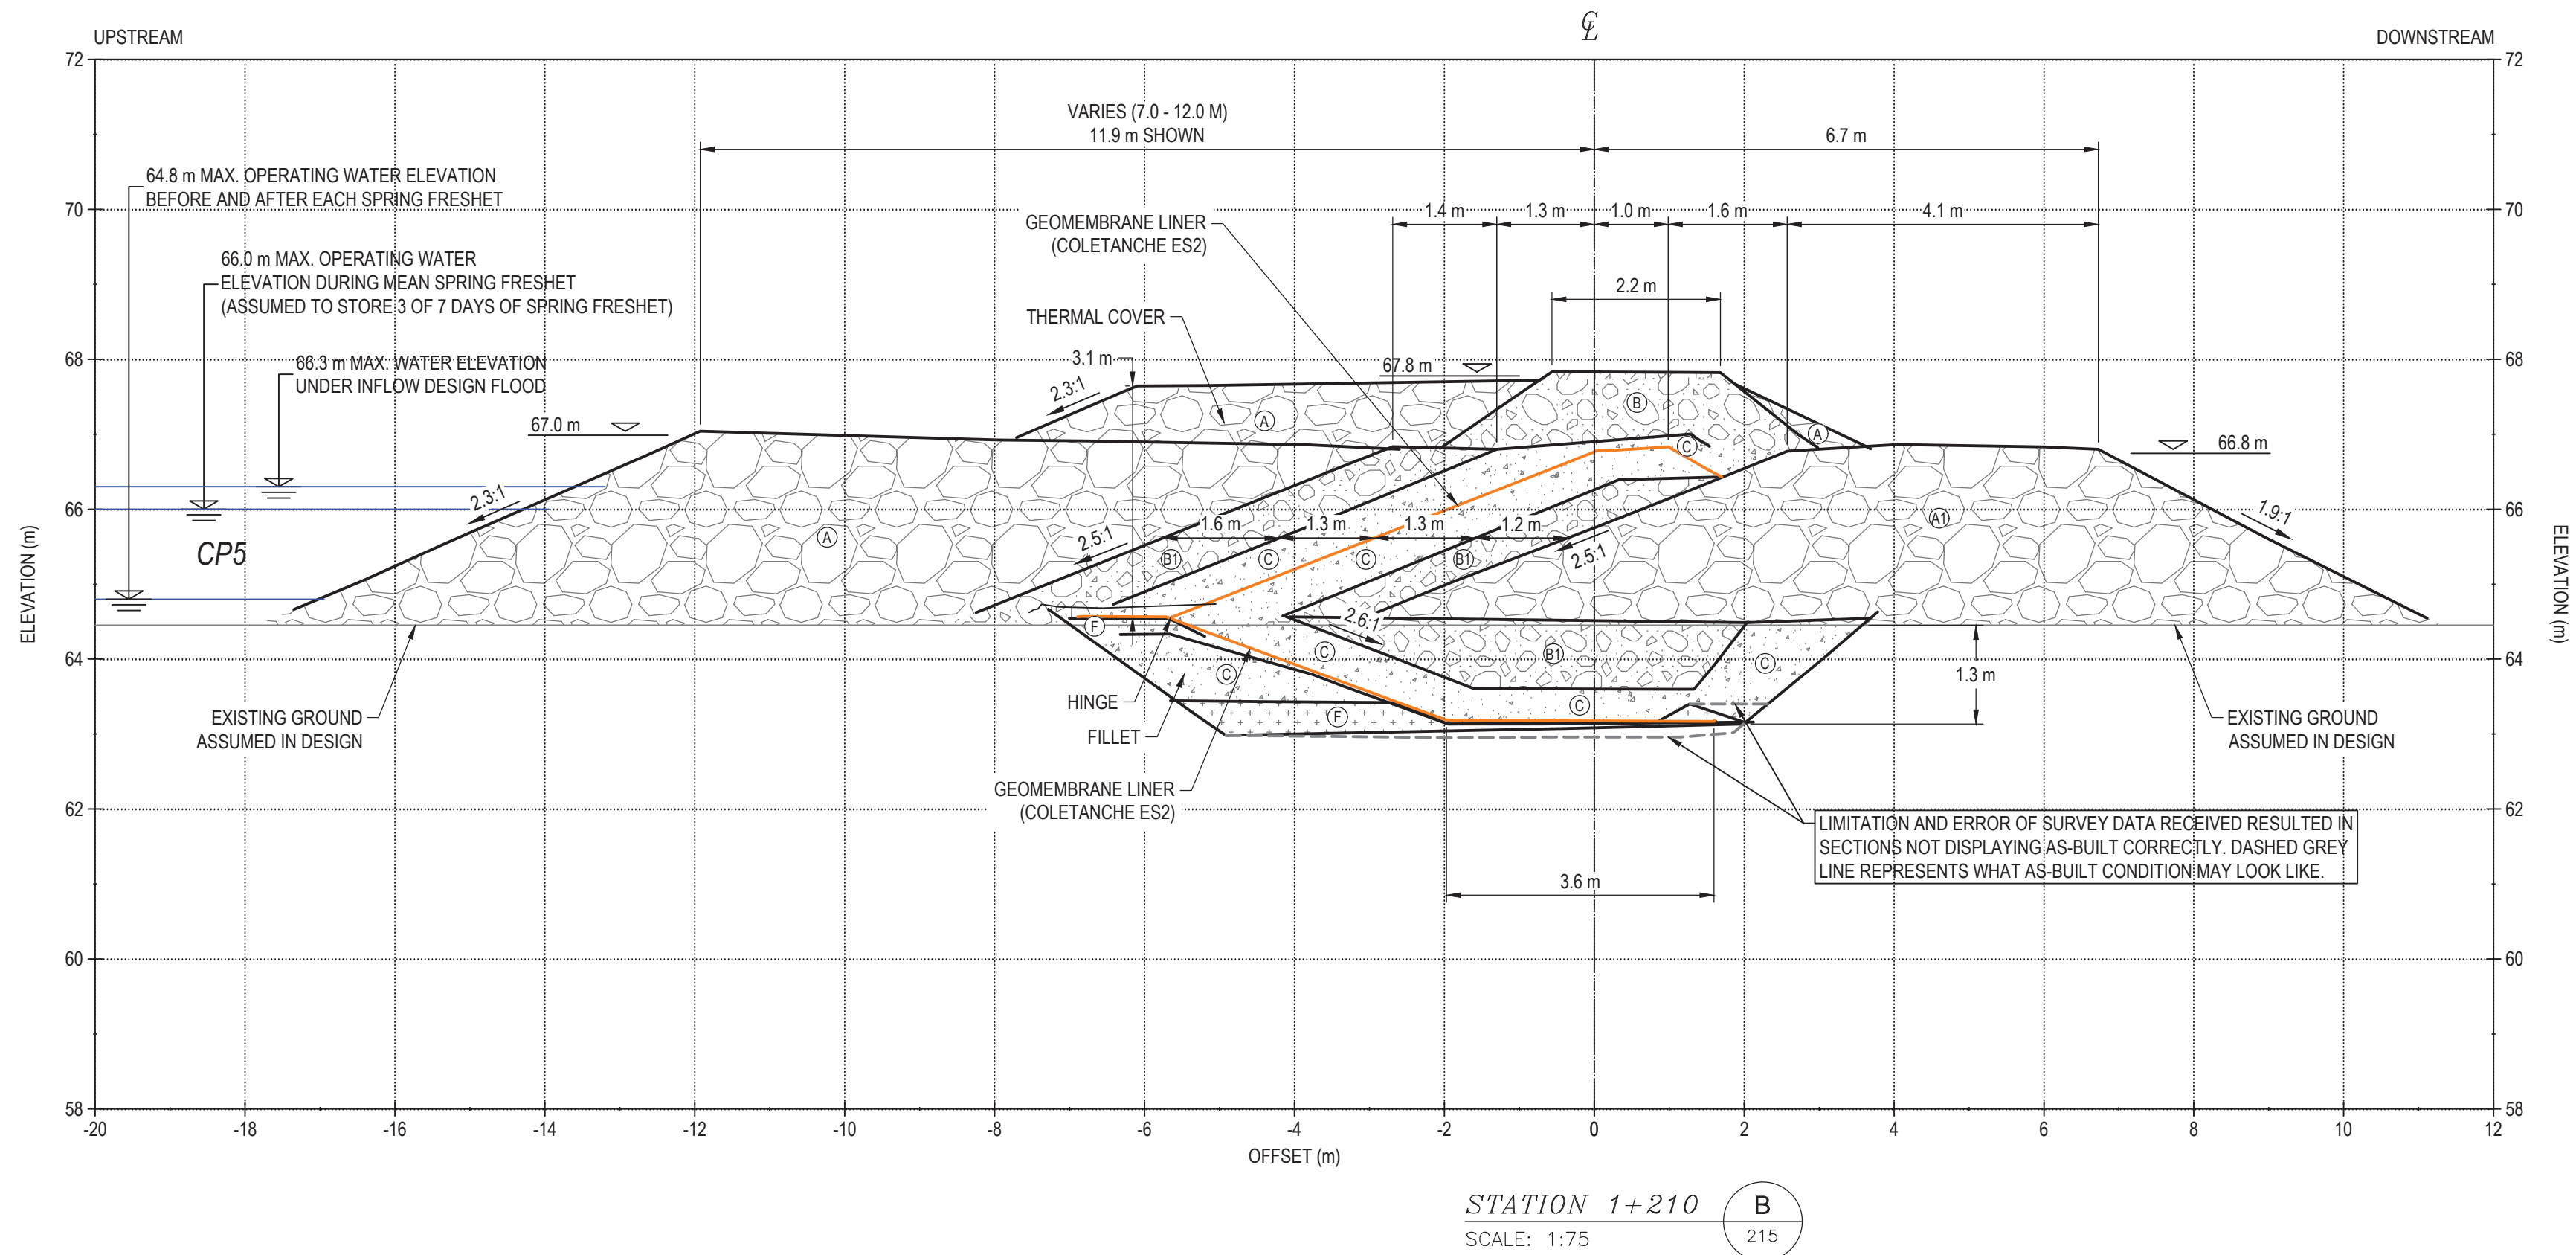


ESTIMATED IN-PLACE MATERIAL QUANTITIES FOR CONSTRUCTION OF D-CP5		
ITEM	UNIT	AS-BUILT QUANTITY ^(M)
 RUN-OF-MINE ROCKFILL (600 mm MINUS) IN DIKE UPSTREAM AND FOR THERMAL COVER	m ³	10,029
 RUN-OF-MINE ROCKFILL (600 mm MINUS) IN DIKE DOWNSTREAM	m ³	3,137
 TRANSITION ROCKFILL (150 mm MINUS)	m ³	3,971
 GRANULAR FILL OR ESKER SAND (20 mm MINUS)	m ³	4,096
 BENTONITE-AUGMENTED MATERIAL	m ³	979
GEOMEMBRANE LINER (COLETANCHE ES2)	m ²	4437
KEY TRENCH EXCAVATION	m ³	5788


^(M) MATERIAL QUANTITIES WERE BASED ON SURVEY DATA PROVIDED BY AGNICO EAGLE ON AUGUST 2017

NOTE

THE DESIGN MINIMUM LINER CREST ELEVATION WAS 66.80 m.

THE DESIGN MINIMUM LINER CREST ELEVATION IS 66.72 m.

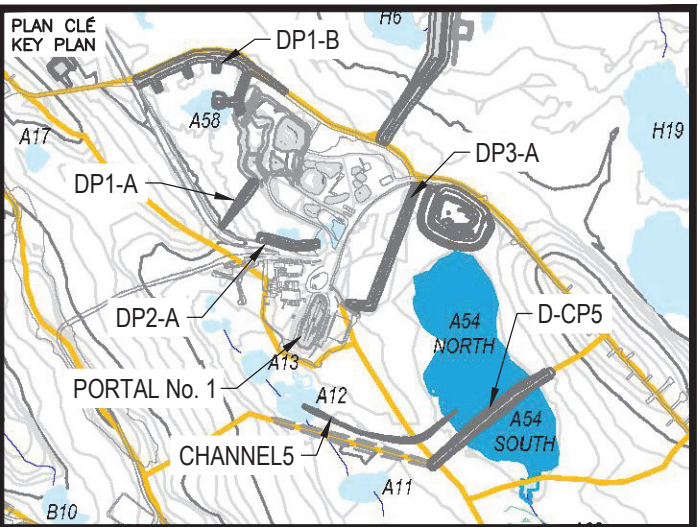

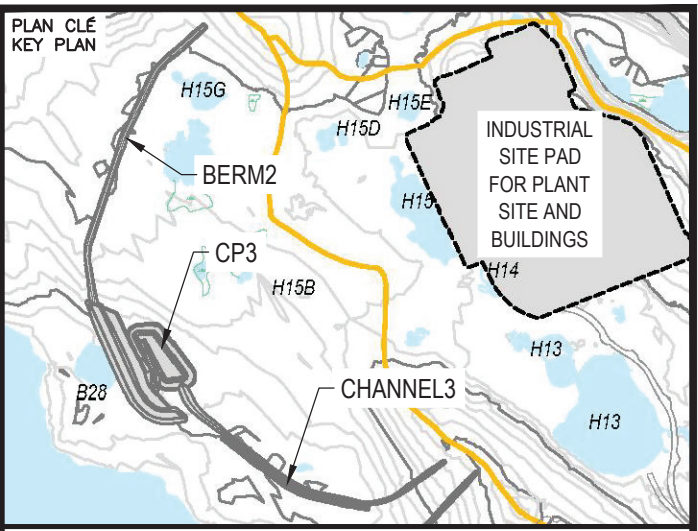

NOTES GÉNÉRALES / GENERAL NOTES

1. ASSUMED CONSTRUCTION SCHEDULE WINTER 2018 / 2019
2. ASSUMED OPERATION SCHEDULE STARTING TO STORE WATER FROM FRESHET OF 2019.
3. POND DESIGN CAPACITY IS BASED ON STORING 3 OUT OF 7 FRESHET WATER UNDER 1:100 WET YEAR CONDITION.
4. THE MAXIMUM ALLOWABLE OPERATING WATER LEVEL IS AT ELEVATION 63.0 m UNDER THE DESIGN IDF CONDITION.
5. MATERIAL PLACEMENT AND FOUNDATION PREPARATION SHOULD BE IN ACCORDANCE WITH THE REQUIREMENTS OF GEOTECHNICAL CONSTRUCTION / MATERIAL SPECIFICATIONS (TETRA TECH 2018).

PERMIT TO PRACTICE
TETRA TECH CANADA INC.

Signature [Signature]

Date June 21, 2018

PERMIT NUMBER: P 018
NT/NU Association of Professional
Engineers and Geoscientists

POUR CONSTRUCTION
FOR CONSTRUCTION

DATE : 2018-06-

L'INFORMATION CI-DESSOUS EST LA PROPRIÉTÉ DE AONCO EAGLE LTD. [ET DOIT ÊTRE RETOURNÉE SUR DEMANDE, SANS AUTORISATION ÉCRITE, PRÉALABLE, TOUTE TRANSMISSION DE COPIES À AUTRUI ET TOUTE UTILISATION AUTRE QUE CELLE POUR LAQUELLE L'INFORMATION EST PRIÉE] SONT INTERDITES. © AONCO EAGLE LTD.

THE INFORMATION HERE ON IS THE PROPERTY OF AONCO EAGLE LTD. AND MUST BE RETURNED UPON REQUEST, WITHOUT WRITTEN PERMISSION, ANY COPYING TRANSMISSION TO OTHERS AND ANY USE EXCEPT THAT FOR WHICH IT IS LOANED ARE PROHIBITED.


© AONCO EAGLE LTD.

DESSINS EN RÉFÉRENCE / REFERENCE DRAWINGS

[illegible]**AGNICO EAGLE**

0	2018-06-21	ISSUED FOR CONSTRUCTION	HX	WTH	
A	2018-05-29	ISSUED FOR REVIEW	HX	WTH	
REV.	DATE	DESCRIPTION	PAR/BY	APP.	CLIENT

REVISIONS

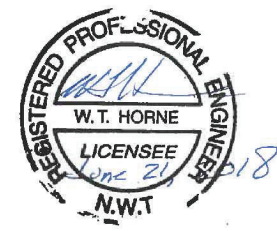

TITRE / TITLE	AGNICO EAGLE MELIADINE GOLD PROJECT
---------------	-------------------------------------

CP3 AND CP3 THERMAL PROTECTION BERM
LAYOUT PLAN

DESSINÉ PAR DRAWN BY	EL	DATE 2018-06-21
-------------------------	----	--------------------

VERIFIÉ PAR CHECKED BY	HX	2018-06-21
---------------------------	----	------------

APPROUVE PAR APPROVED BY	WTH	2018-06-21
ÉCHELLE	DATE	

NO. DESSIN
DRAWING NO. 65-695-230-238

NO. PROJ. PROJECT NO. 6515	REVISION	FEUILLE / SHT
	0	1 / 13

H

G

F

E

D


C

B

A


AE-CART-ARCH D

C:\Edmonton\Engineering\ET141\Projects\MELIADINE\CP3_CP4 Detailed Design\CP3\65-695-230-239.dwg-2013-02-19 14:03:29

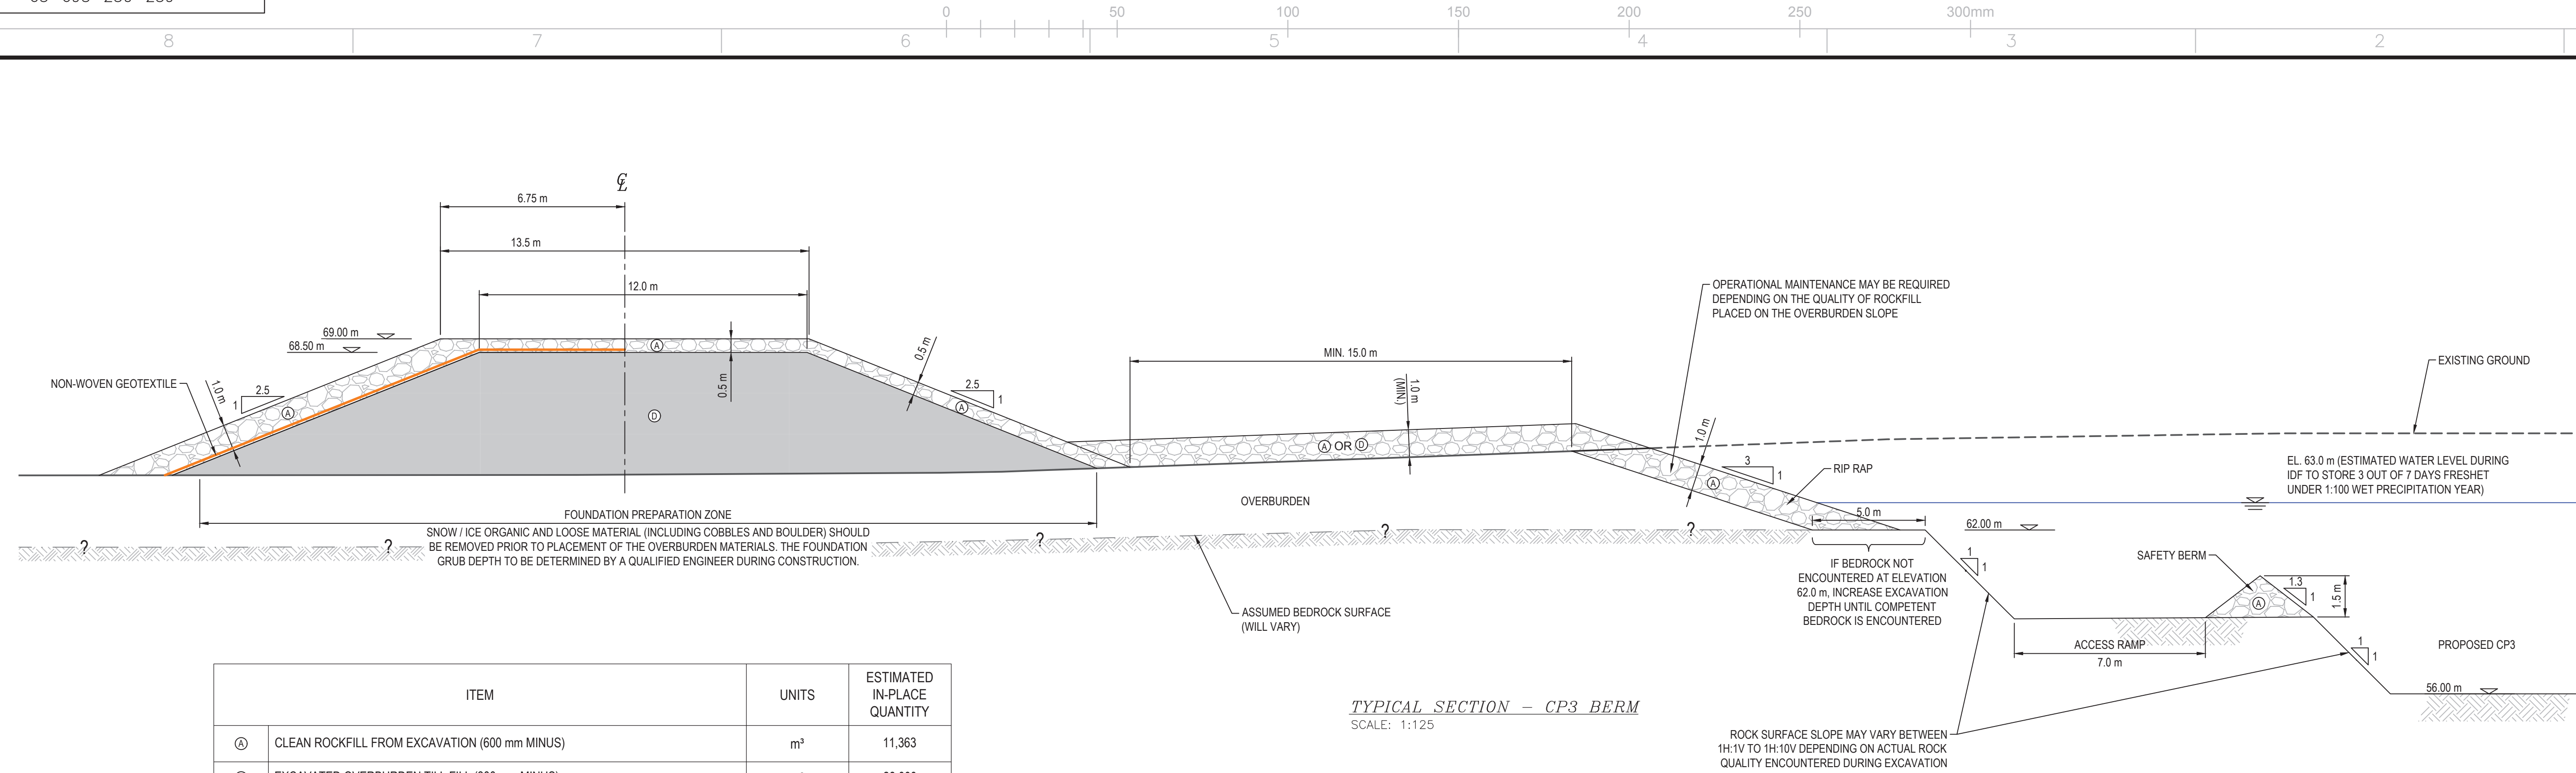


TYPICAL SECTION - CP3 BERM
SCALE: 1:125

ITEM	UNITS	ESTIMATED IN-PLACE QUANTITY
(A) CLEAN ROCKFILL FROM EXCAVATION (600 mm MINUS)	m³	11,363
(B) EXCAVATED OVERBURDEN TILL FILL (300 mm MINUS)	m³	28,000
NON-WOVEN GEOTEXTILE	m²	5,250
TOTAL CP3 EXCAVATION VOLUME (CONSIDERING 25% BULK FACTOR)	m³	70,112
ESTIMATED OVERBURDEN EXCAVATION VOLUME (CONSIDERING 25% BULK FACTOR)	m³	28,687
ESTIMATED ROCK EXCAVATION VOLUME (CONSIDERING 25% BULK FACTOR)	m³	41,425

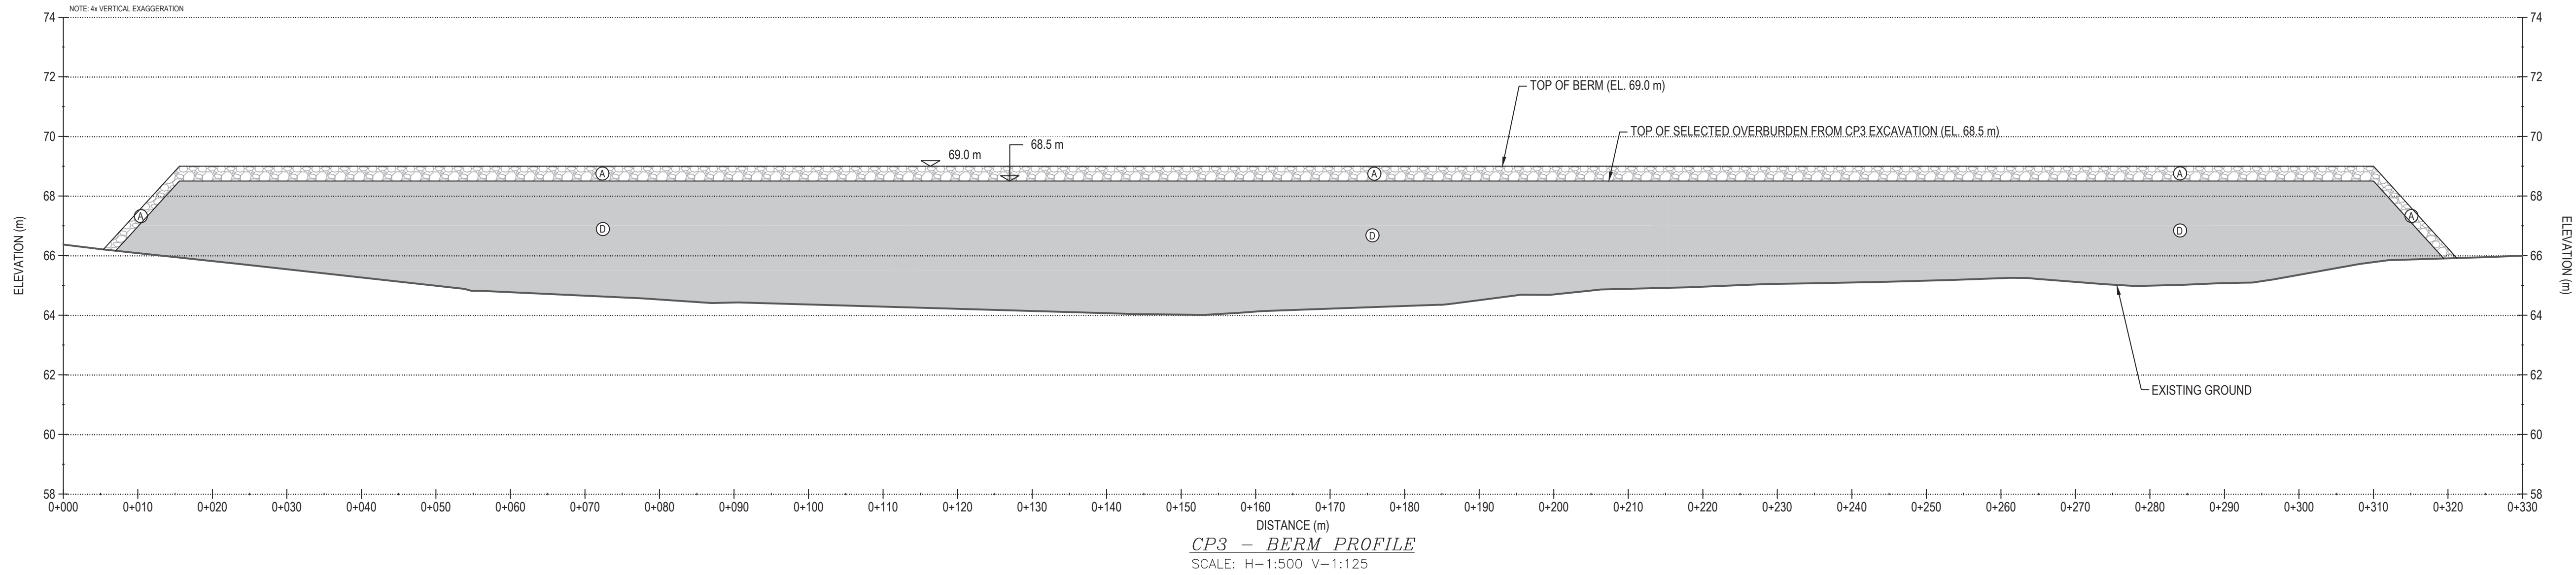

CP3 - BERM PROFILE
SCALE: H-1:500 V-1:125

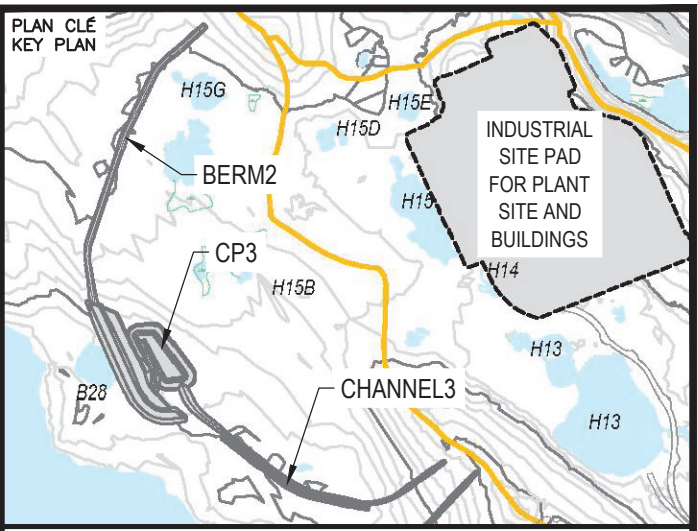

NOTES GÉNÉRALES / GENERAL NOTES

1. ASSUMED CONSTRUCTION SCHEDULE WINTER 2018 / 2019
2. ASSUMED OPERATION SCHEDULE STARTING TO STORE WATER FROM FRESHET OF 2019.
3. POND DESIGN CAPACITY IS BASED ON STORING 3 OUT OF 7 FRESHET WATER UNDER 1:100 WET YEAR CONDITION.
4. THE MAXIMUM ALLOWABLE OPERATING WATER LEVEL IS AT ELEVATION 63.0 m UNDER THE DESIGN IDF CONDITION.
5. MATERIAL PLACEMENT AND FOUNDATION PREPARATION SHOULD BE IN ACCORDANCE WITH THE REQUIREMENTS OF GEOTECHNICAL CONSTRUCTION / MATERIAL SPECIFICATIONS (TETRA TECH 2018).

LEGEND

- (A) CLEAN ROCKFILL FROM EXCAVATION (600 mm MINUS)
(B) OVERBURDEN FROM EXCAVATION (300 mm MINUS)

PERMIT TO PRACTICE
TETRA TECH CANADA INC.

Signature: [Signature]

Date: June 21, 2018

PERMIT NUMBER: P 018

NT/NU Association of Professional Engineers and Geoscientists

L'INFORMATION CONTENUE EST LA PROPRIÉTÉ DE AGNICO EAGLE LTD. ET DOIT ÊTRE RETENUE, SANS AUTORISATION ÉCRITE, PAR AGNICO EAGLE LTD. SEULEMENT. TOUTE REPRODUCTION DE CE DOKUMENT SANS LA PERMISSE D'AGNICO EAGLE LTD. EST INTERDITE. L'INFORMATION EST FOURNIE EN L'ÉTAT. AGNICO EAGLE LTD. NE GARANTIT PAS L'ACCURACIE DE L'INFORMATION. AGNICO EAGLE LTD. ASSUME AUCUNE RESPONSABILITÉ POUR LES DOMMAGES, RÉELS OU VIRTUELS, EN DÉPENDANCE DE L'UTILISATION DE L'INFORMATION. L'UTILISATION DE L'INFORMATION EST À VOS RISQUES. AGNICO EAGLE LTD. ASSUME AUCUNE RESPONSABILITÉ POUR LES DOMMAGES, RÉELS OU VIRTUELS, EN DÉPENDANCE DE L'UTILISATION DE L'INFORMATION. L'UTILISATION DE L'INFORMATION EST À VOS RISQUES.

DESSINS EN RÉFÉRENCE / REFERENCE DRAWINGS

TITRE / TITLE	# DWG
---	---
---	---
REV.	DATE	DESCRIPTION	PAR/ÉV.	APP.	CLIENT
0	2018-06-21	ISSUED FOR CONSTRUCTION	HK	WITH	
1	2018-06-29	ISSUED FOR REVIEW	HK	WITH	

REVISIONS



TITRE / TITLE
AGNICO EAGLE MELIADINE GOLD PROJECT

CP3 TYPICAL SECTION AND
CP3 THERMAL PROTECTION BERM PROFILE

DESSINÉ PAR
DRAWN BY EL

DATE
2018-06-21

VÉRIFIÉ PAR
CHECKED BY HX

2018-06-21

APPROUVÉ PAR
APPROVED BY WITH

2018-06-21

ÉCHELLE
SCALE AS SHOWN

DATE
2018-06-21

NO. DESSIN
DRAWING NO. 65-695-230-239

NO. PROJET
PROJECT NO. 6515

REVISION
0

FEUILLE / SHEET
2 / 13



NOTES GÉNÉRALES / GENERAL NOTES

1. ASSUMED CONSTRUCTION SCHEDULE WINTER 2018 / 2019
2. ASSUMED OPERATION SCHEDULE STARTING TO STORE WATER FROM FRESHET OF 2019.
3. POND DESIGN CAPACITY IS BASED ON STORING 3 OUT OF 7 FRESHET WATER UNDER 1:100 WEIR YEAR CONDITION.
4. THE MAXIMUM ALLOWABLE OPERATING WATER LEVEL IS AT ELEVATION 63.0 m UNDER THE DESIGN IDF CONDITION.
5. MATERIAL PLACEMENT AND FOUNDATION PREPARATION SHOULD BE IN ACCORDANCE WITH THE REQUIREMENTS OF GEOTECHNICAL CONSTRUCTION / MATERIAL SPECIFICATIONS (TETRA TECH 2018).

**PERMIT TO PRACTICE
TETRA TECH CANADA INC.**

Signature [Signature]

Date JUNE 21, 2018

PERMIT NUMBER: P 018
NT/NU Association of Professional
Engineers and Geoscientists

POUR CONSTRUCTION
FOR CONSTRUCTION

18-06-21



THE INFORMATION HEREON IS THE PROPERTY OF AGNICO EAGLE LTD. AND MUST BE RETURNED UPON REQUEST, WITHOUT WRITTEN PERMISSION. ANY COPYING, TRANSMISSION TO OTHERS AND ANY USE EXCEPT THAT FOR WHICH IT IS LOANED ARE PROHIBITED.
 © AGNICO EAGLE LTD.

DESSINS EN RÉFÉRENCE / REFERENCE DRAWINGS

[illegible]**AGNICO EAGLE**

O	2018-06-21	ISSUED FOR CONSTRUCTION	HX	WTH	
A	2018-05-29	ISSUED FOR REVIEW	HX	WTH	
REV.	DATE	DESCRIPTION	PAR/BY	APP.	CLIENT

REVISIONS

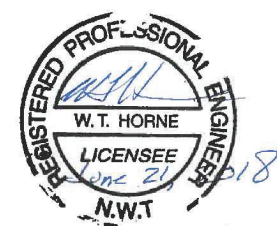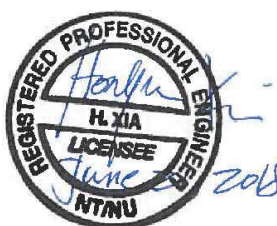

TITRE / TITLE
AGRIC. FAIR. MELBINE GOLD PROJECT

CP4 AND CP4 THERMAL PROTECTION BERM
LAYOUT PLAN


DESSINÉ PAR DRAWN BY	EL	DATE 2018-06-21
-------------------------	----	--------------------

VERIFIÉ PAR CHECKED BY	HX	2018-06-21
APPROUVÉ PAR		


APPROVED BY	WTH	2018-06-21
ÉCHELLE SCALE	1:750	DATE 2018-06-21

NO. DISSIN DRAWING NO.	65 605 030 047
---------------------------	----------------


65-695-230-247		
NO. PROJ. PROJECT NO.	REVISION	FEUILLE / SHT
	0	1 / 9

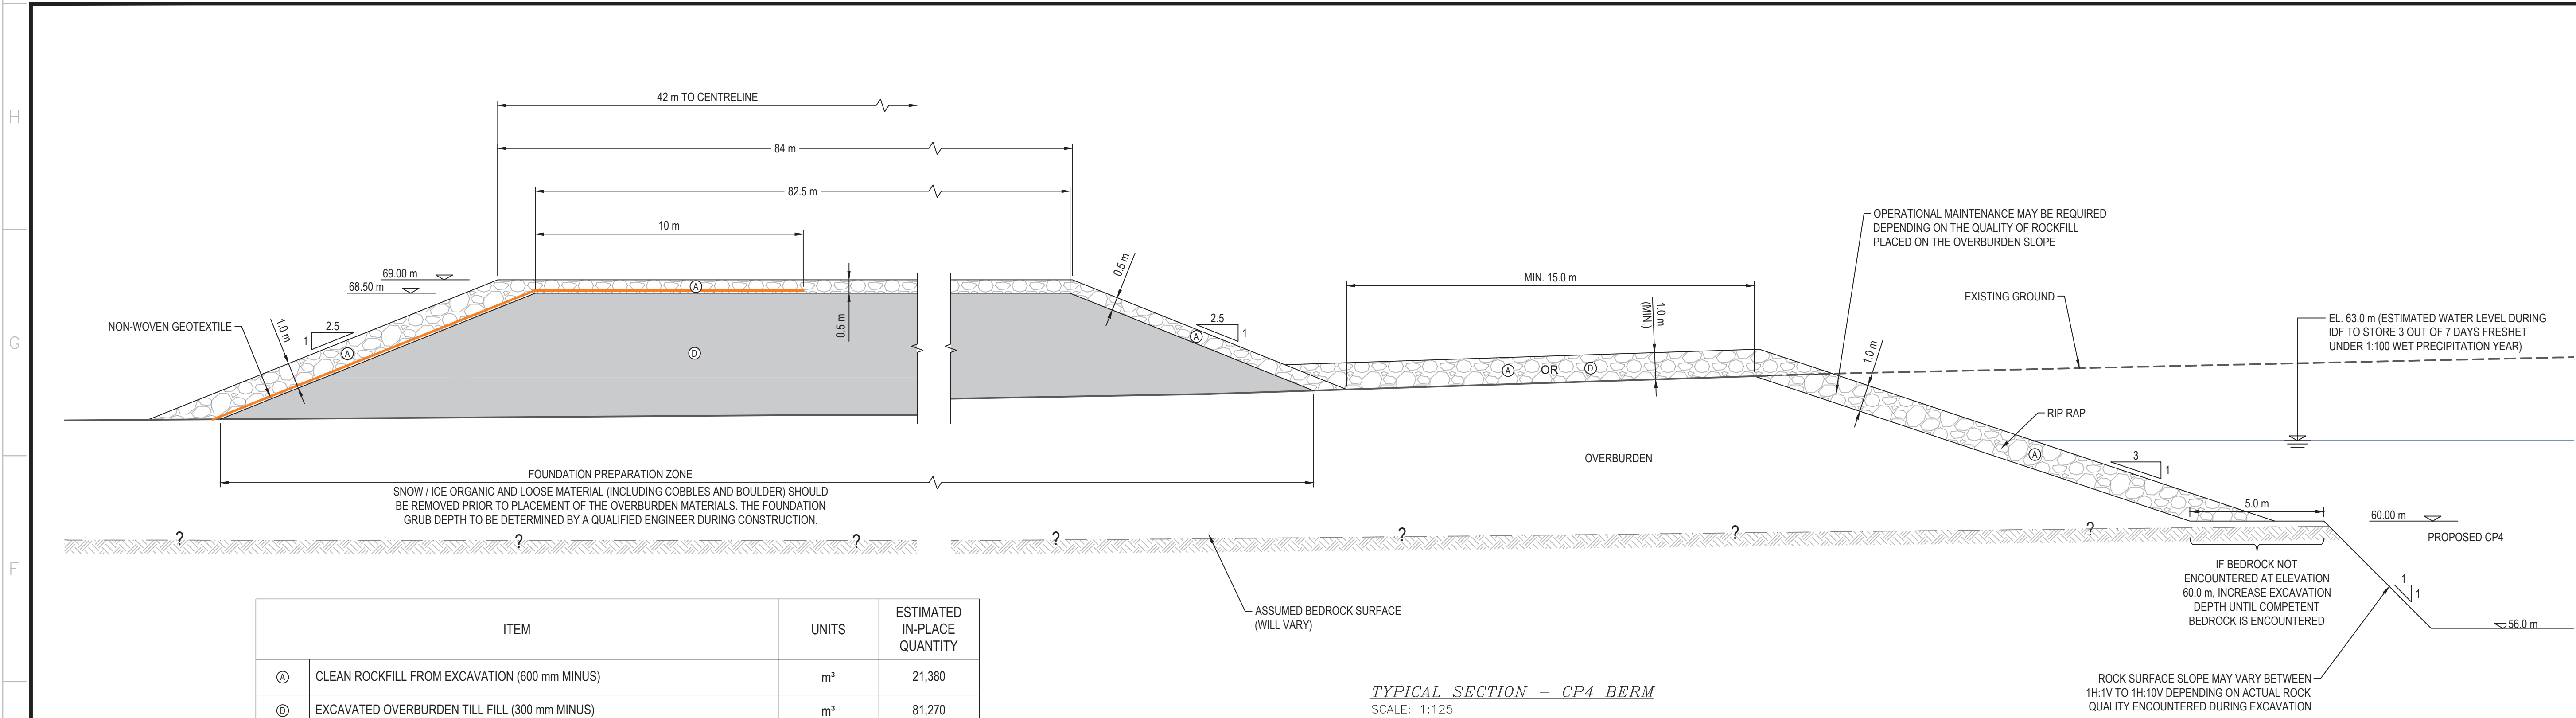

ITEM	UNITS	ESTIMATED IN-PLACE QUANTITY
Ⓐ CLEAN ROCKFILL FROM EXCAVATION (600 mm MINUS)	m³	21,380
Ⓢ EXCAVATED OVERBURDEN TILL FILL (300 mm MINUS)	m³	81,270
NON-WOVEN GEOTEXTILE	m²	5,900
TOTAL CP4 EXCAVATION VOLUME (CONSIDERING 25% BULK FACTOR)	m³	103,143
ESTIMATED OVERBURDEN EXCAVATION VOLUME (CONSIDERING 25% BULK FACTOR)	m³	81,643
ESTIMATED ROCK EXCAVATION VOLUME (CONSIDERING 25% BULK FACTOR)	m³	21,500

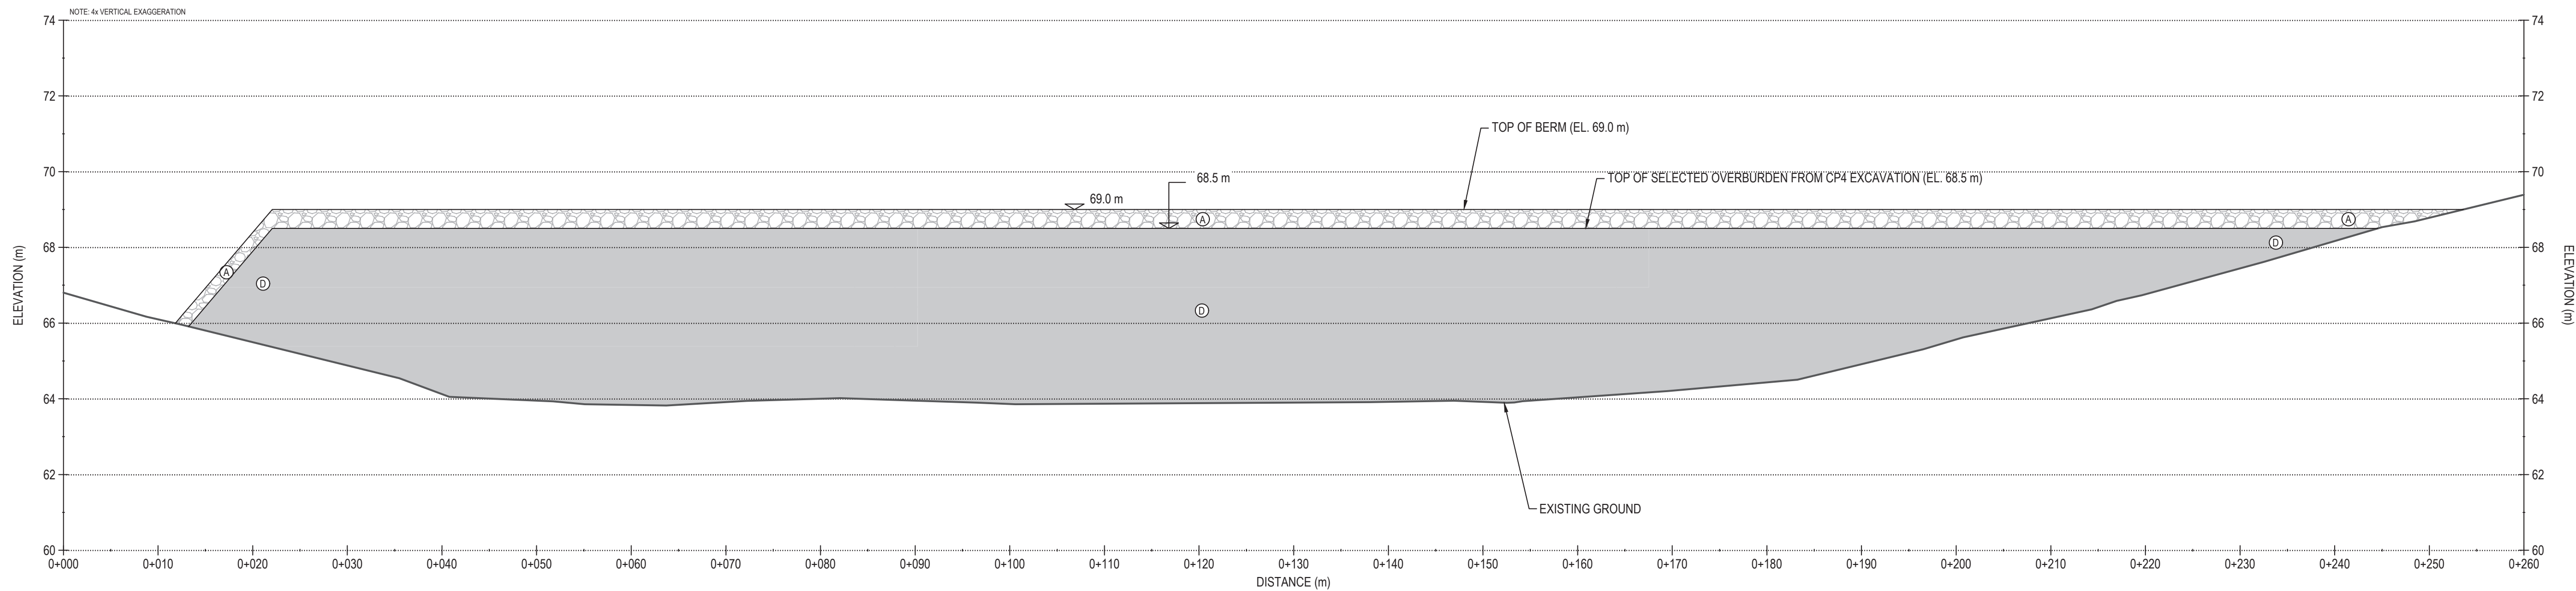

CP4 - BERM PROFILE
SCALE: H=1:400 V=1:100

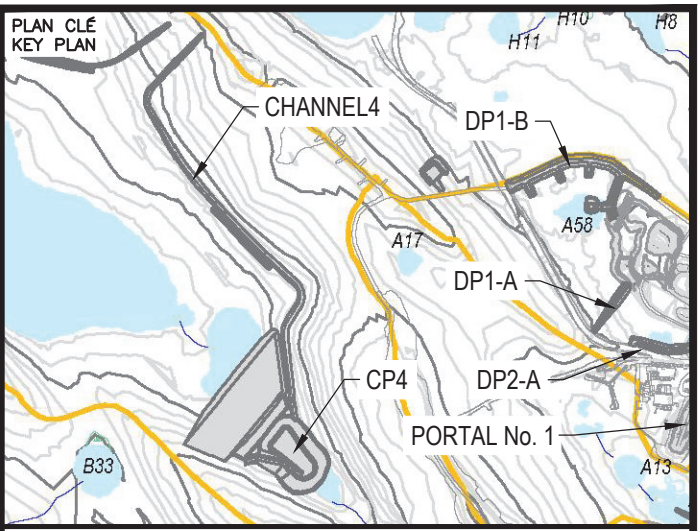

NOTES GÉNÉRALES / GENERAL NOTES

1. ASSUMED CONSTRUCTION SCHEDULE WINTER 2018 / 2019
2. ASSUMED OPERATION SCHEDULE STARTING TO STORE WATER FROM FRESHET OF 2019.
3. POND DESIGN CAPACITY IS BASED ON STORING 3 OUT OF 7 FRESHET WATER UNDER 1:100 WET YEAR CONDITION.
4. THE MAXIMUM ALLOWABLE OPERATING WATER LEVEL IS AT ELEVATION 63.0 m UNDER THE DESIGN IDF CONDITION. MATERIAL PLACEMENT AND FOUNDATION PREPARATION SHOULD BE IN ACCORDANCE WITH THE REQUIREMENTS OF GEOTECHNICAL CONSTRUCTION / MATERIAL SPECIFICATIONS (TETRA TECH 2018).

LEGEND

- Ⓐ CLEAN ROCKFILL FROM EXCAVATION (600 mm MINUS)
- Ⓢ OVERBURDEN FROM EXCAVATION (300 mm MINUS)



L'INFORMATION CONTENUE EST LA PROPRIÉTÉ DE AGNICO EAGLE LTD. ET DOIT ÊTRE RETENUE, SANS AUTORISATION ÉCRITE, PAR AGNICO EAGLE LTD. SEULEMENT. TOUTE REPRODUCTION DE CE DOCUMENT SANS LAutorisation ÉCRITE DE AGNICO EAGLE LTD. EST INTERDITE.

THE INFORMATION HEREIN IS THE PROPERTY OF AGNICO EAGLE LTD. AND MUST BE RETAINED FROM REPRODUCTION WITHOUT WRITTEN PERMISSION. NO COPYING, TRANSMISSION, TO OTHERS AND ANY USE EXCEPT THAT FOR WHICH IT IS ISSUED ARE PROHIBITED.

© AGNICO EAGLE LTD.

DESSINS EN RÉFÉRENCE / REFERENCE DRAWINGS

TITRE / TITLE	# DWG
---	---
---	---
0	2018-06-21	ISSUED FOR CONSTRUCTION	HX	WTH
A	2018-06-29	ISSUED FOR REVIEW	10X	WTH
REV.	DATE	DESCRIPTION	PAR/ÉV. APP.	CLIENT

REVISIONS




TITRE / TITLE
AGNICO EAGLE MELIADINE GOLD PROJECT



CP4 TYPICAL SECTION AND
CP4 THERMAL PROTECTION BERM PROFILE

DESSINÉ PAR DRAWN BY	EL	DATE 2018-06-21
VÉRIFIÉ PAR CHECKED BY	HX	2018-06-21
APPROUVÉ PAR APPROVED BY	WTH	2018-06-21
ÉCHELLE SCALE	AS SHOWN	DATE 2018-06-21

NO. DESSIN DRAWING NO.	65-695-230-248
NO. PROJET PROJECT NO.	6515
REVISION	0
FEUILLE / SHIT	2 / 9



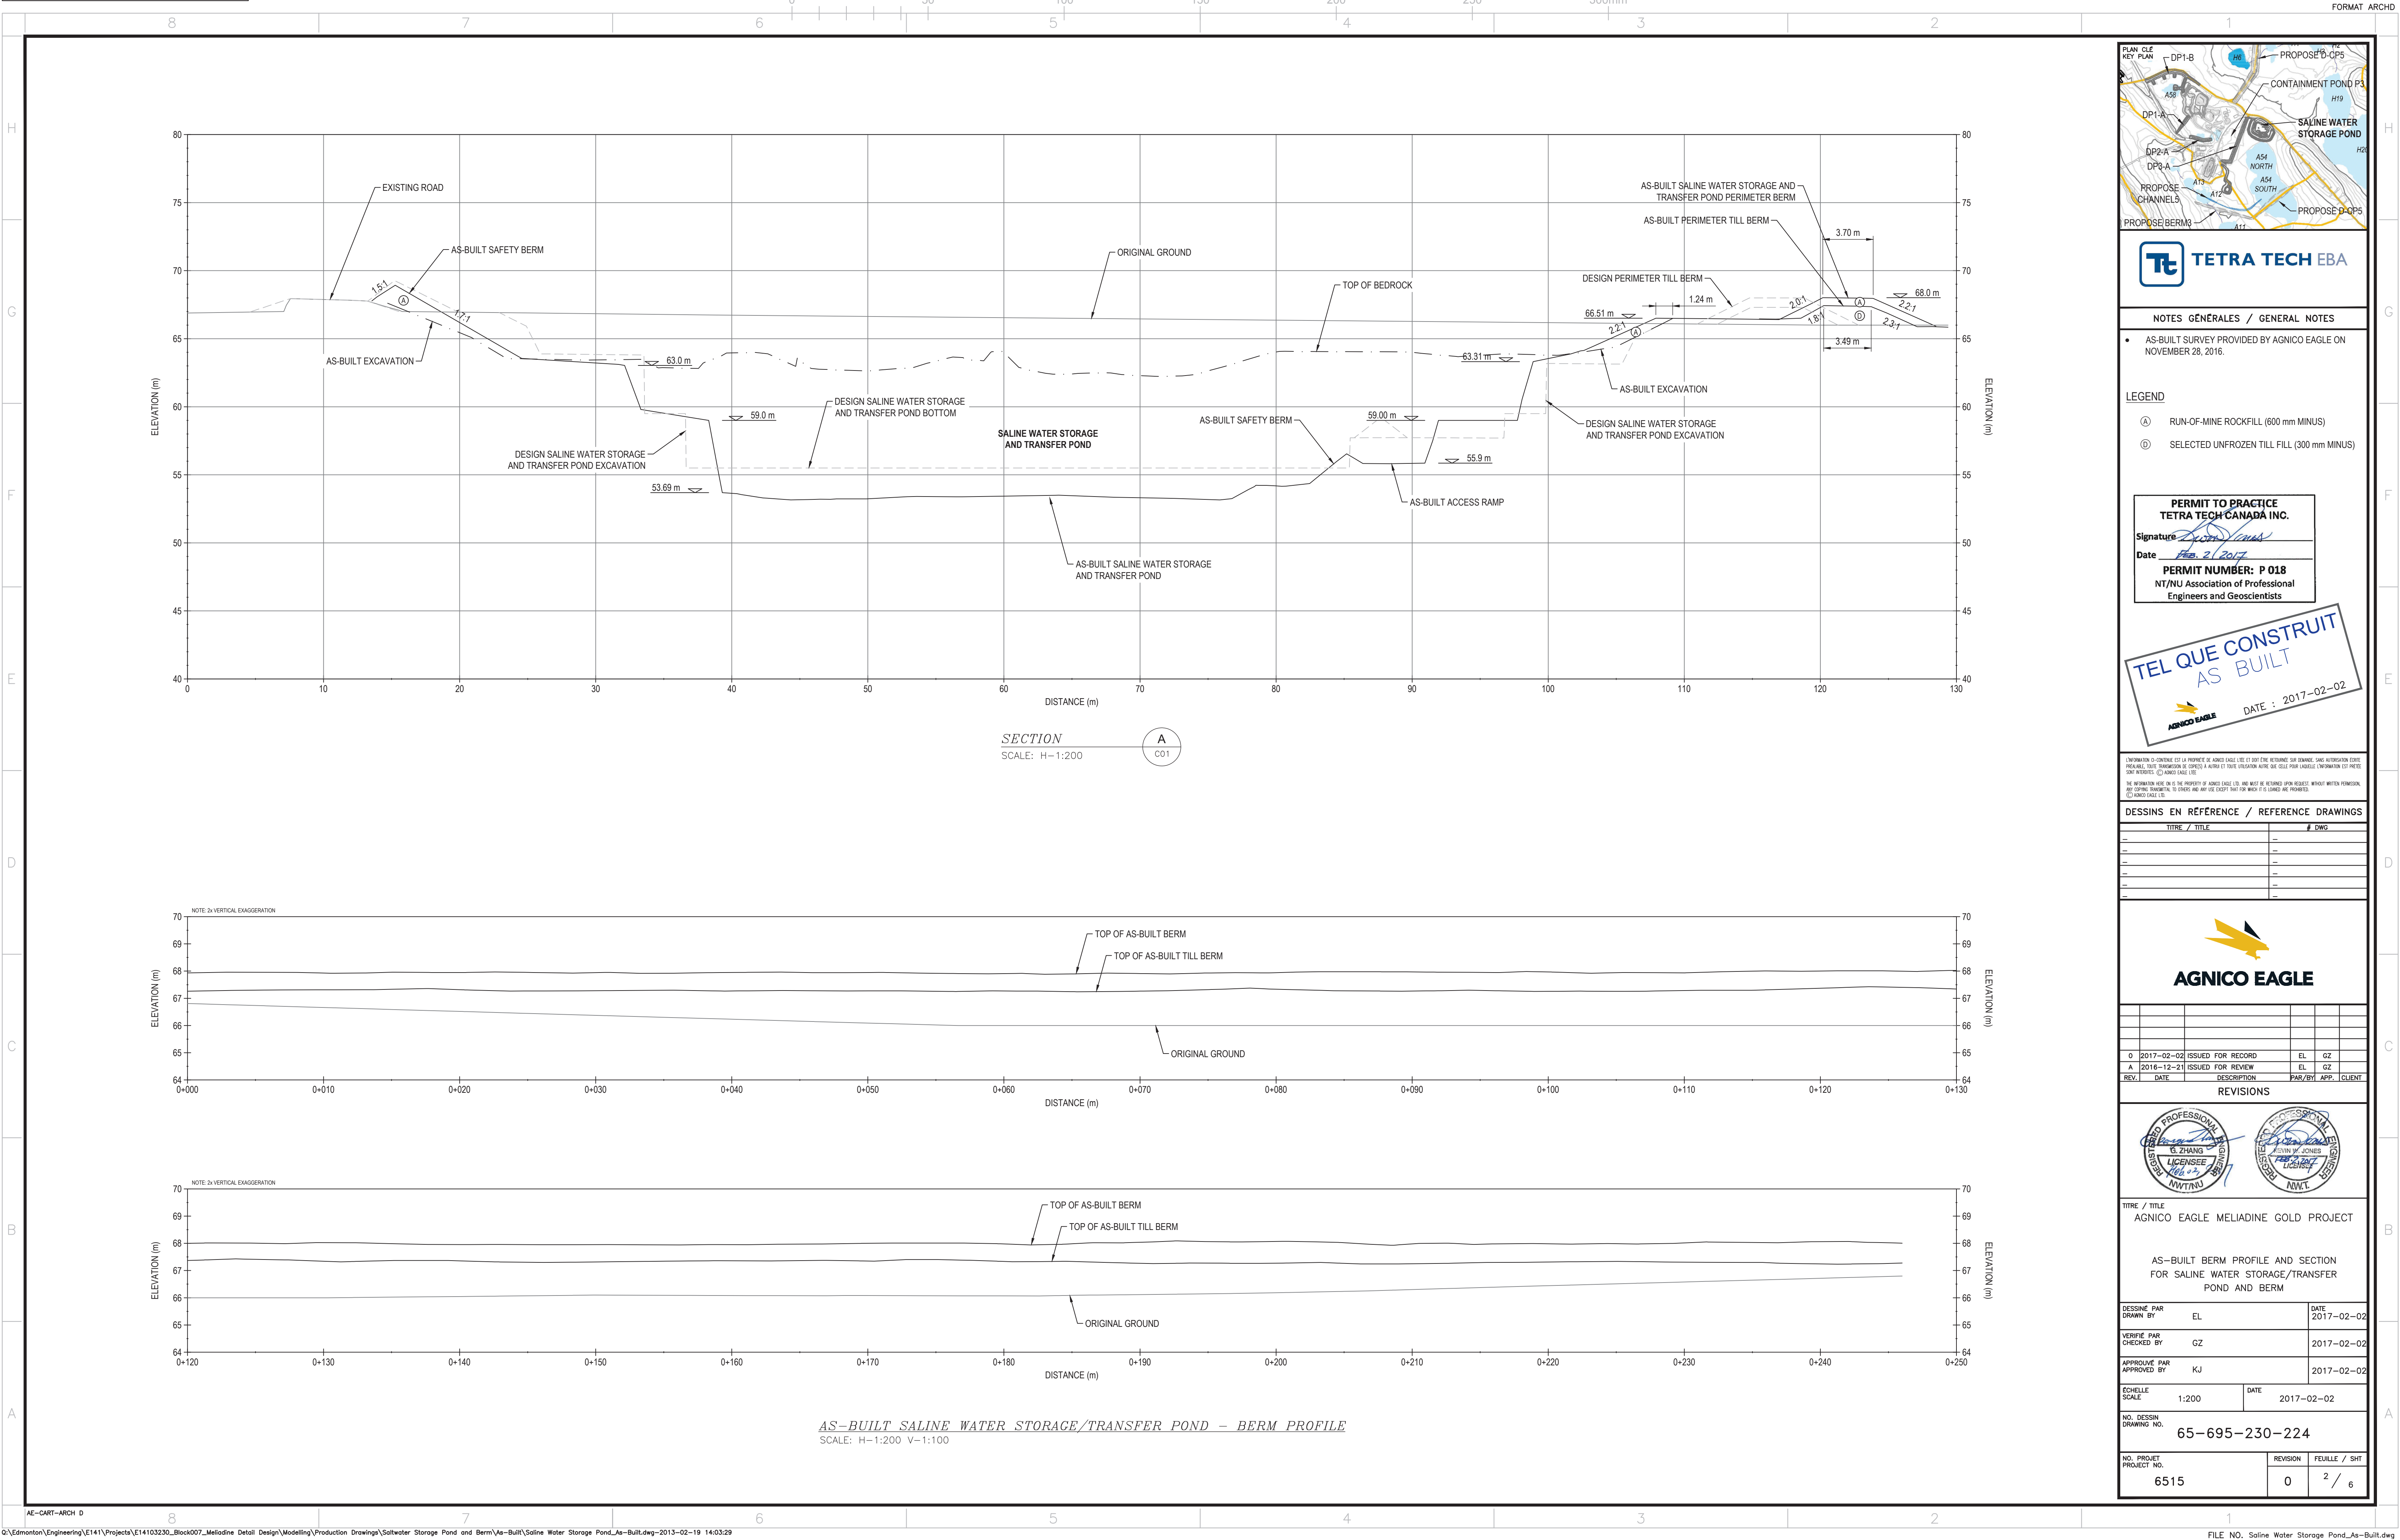

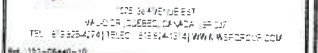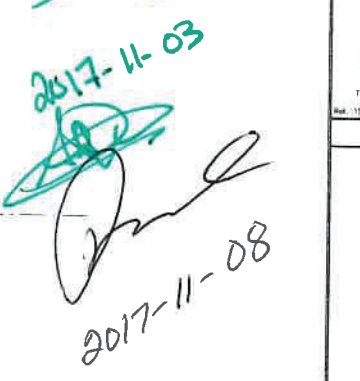[illegible]

TIME	TITLE	# DMS
0000		00
0005		00
0010		00
0015		00
0020		00
0025		00
0030		00
0035		00
0040		00
0045		00
0050		00
0055		00
0100		00
0105		00
0110		00
0115		00
0120		00
0125		00
0130		00
0135		00
0140		00
0145		00
0150		00
0155		00
0200		00
0205		00
0210		00
0215		00
0220		00
0225		00
0230		00
0235		00
0240		00
0245		00
0250		00
0255		00
0300		00
0305		00
0310		00
0315		00
0320		00
0325		00
0330		00
0335		00
0340		00
0345		00
0350		00
0355		00
0400		00
0405		00
0410		00
0415		00
0420		00
0425		00
0430		00
0435		00
0440		00
0445		00
0450		00
0455		00
0500		00
0505		00
0510		00
0515		00
0520		00
0525		00
0530		00
0535		00
0540		00
0545		00
0550		00
0555		00
0600		00
0605		00
0610		00
0615		00
0620		00
0625		00
0630		00
0635		00
0640		00
0645		00
0650		00
0655		00
0700		00
0705		00
0710		00
0715		00
0720		00
0725		00
0730		00
0735		00
0740		00
0745		00
0750		00
0755		00
0800		00
0805		00
0810		00
0815		00
0820		00
0825		00
0830		00
0835		00
0840		00
0845		00
0850		00
0855		00
0900		00
0905		00
0910		00
0915		00
0920		00
0925		00
0930		00
0935		00
0940		00
0945		00
0950		00
0955		00
1000		00
1005		00
1010		00
1015		00
1020		00
1025		00
1030		00
1035		00
1040		00
1045		00
1050		00
1055		00
1100		00
1105		00
1110		00



8	2017-06-21	GENERAL REVISION FOR HENCE BUILDING	V.1	D.F.	
9	2017-04-26	BUILDING REVISION	V.1	D.F.	
5	2017-03-34	ISSUED FOR CONSTRUCTION	1.0	B.F.	
1	2017-03-03	GENERAL REVISION AFTER INFO	V.1	B.F.	
0	2016-12-13	ISSUED FOR TENDER	1.0	B.F.	
REV.	DATE	DESCRIPTION	PAR/SH	APP.	CLIENT

DESIGNED BY	STEVEN PERRON	DATE	2015-11-30
-------------	---------------	------	------------

VERIFIED BY	CHECKED BY	DATE
	STEVEN PERRON	2015-12-02
APPROVED BY		

APPROUVE PAR APPROVED BY	EERTRAND FORTIN, ing	2015-12-02
ECHELLE SCALE	DATE	

SCALE	INDICATED	20:5-11-30
NO. DESIGN DRAWING NO.		


65-693-210-200		
NO. PROJ. PROJECT NO.	REVISION	FUILLE / SHEET

PROJECT NO	6515	4	17
------------	------	---	----

POUR CONSTRUCTION

DATE 2017-06-21

MISCO EMBL

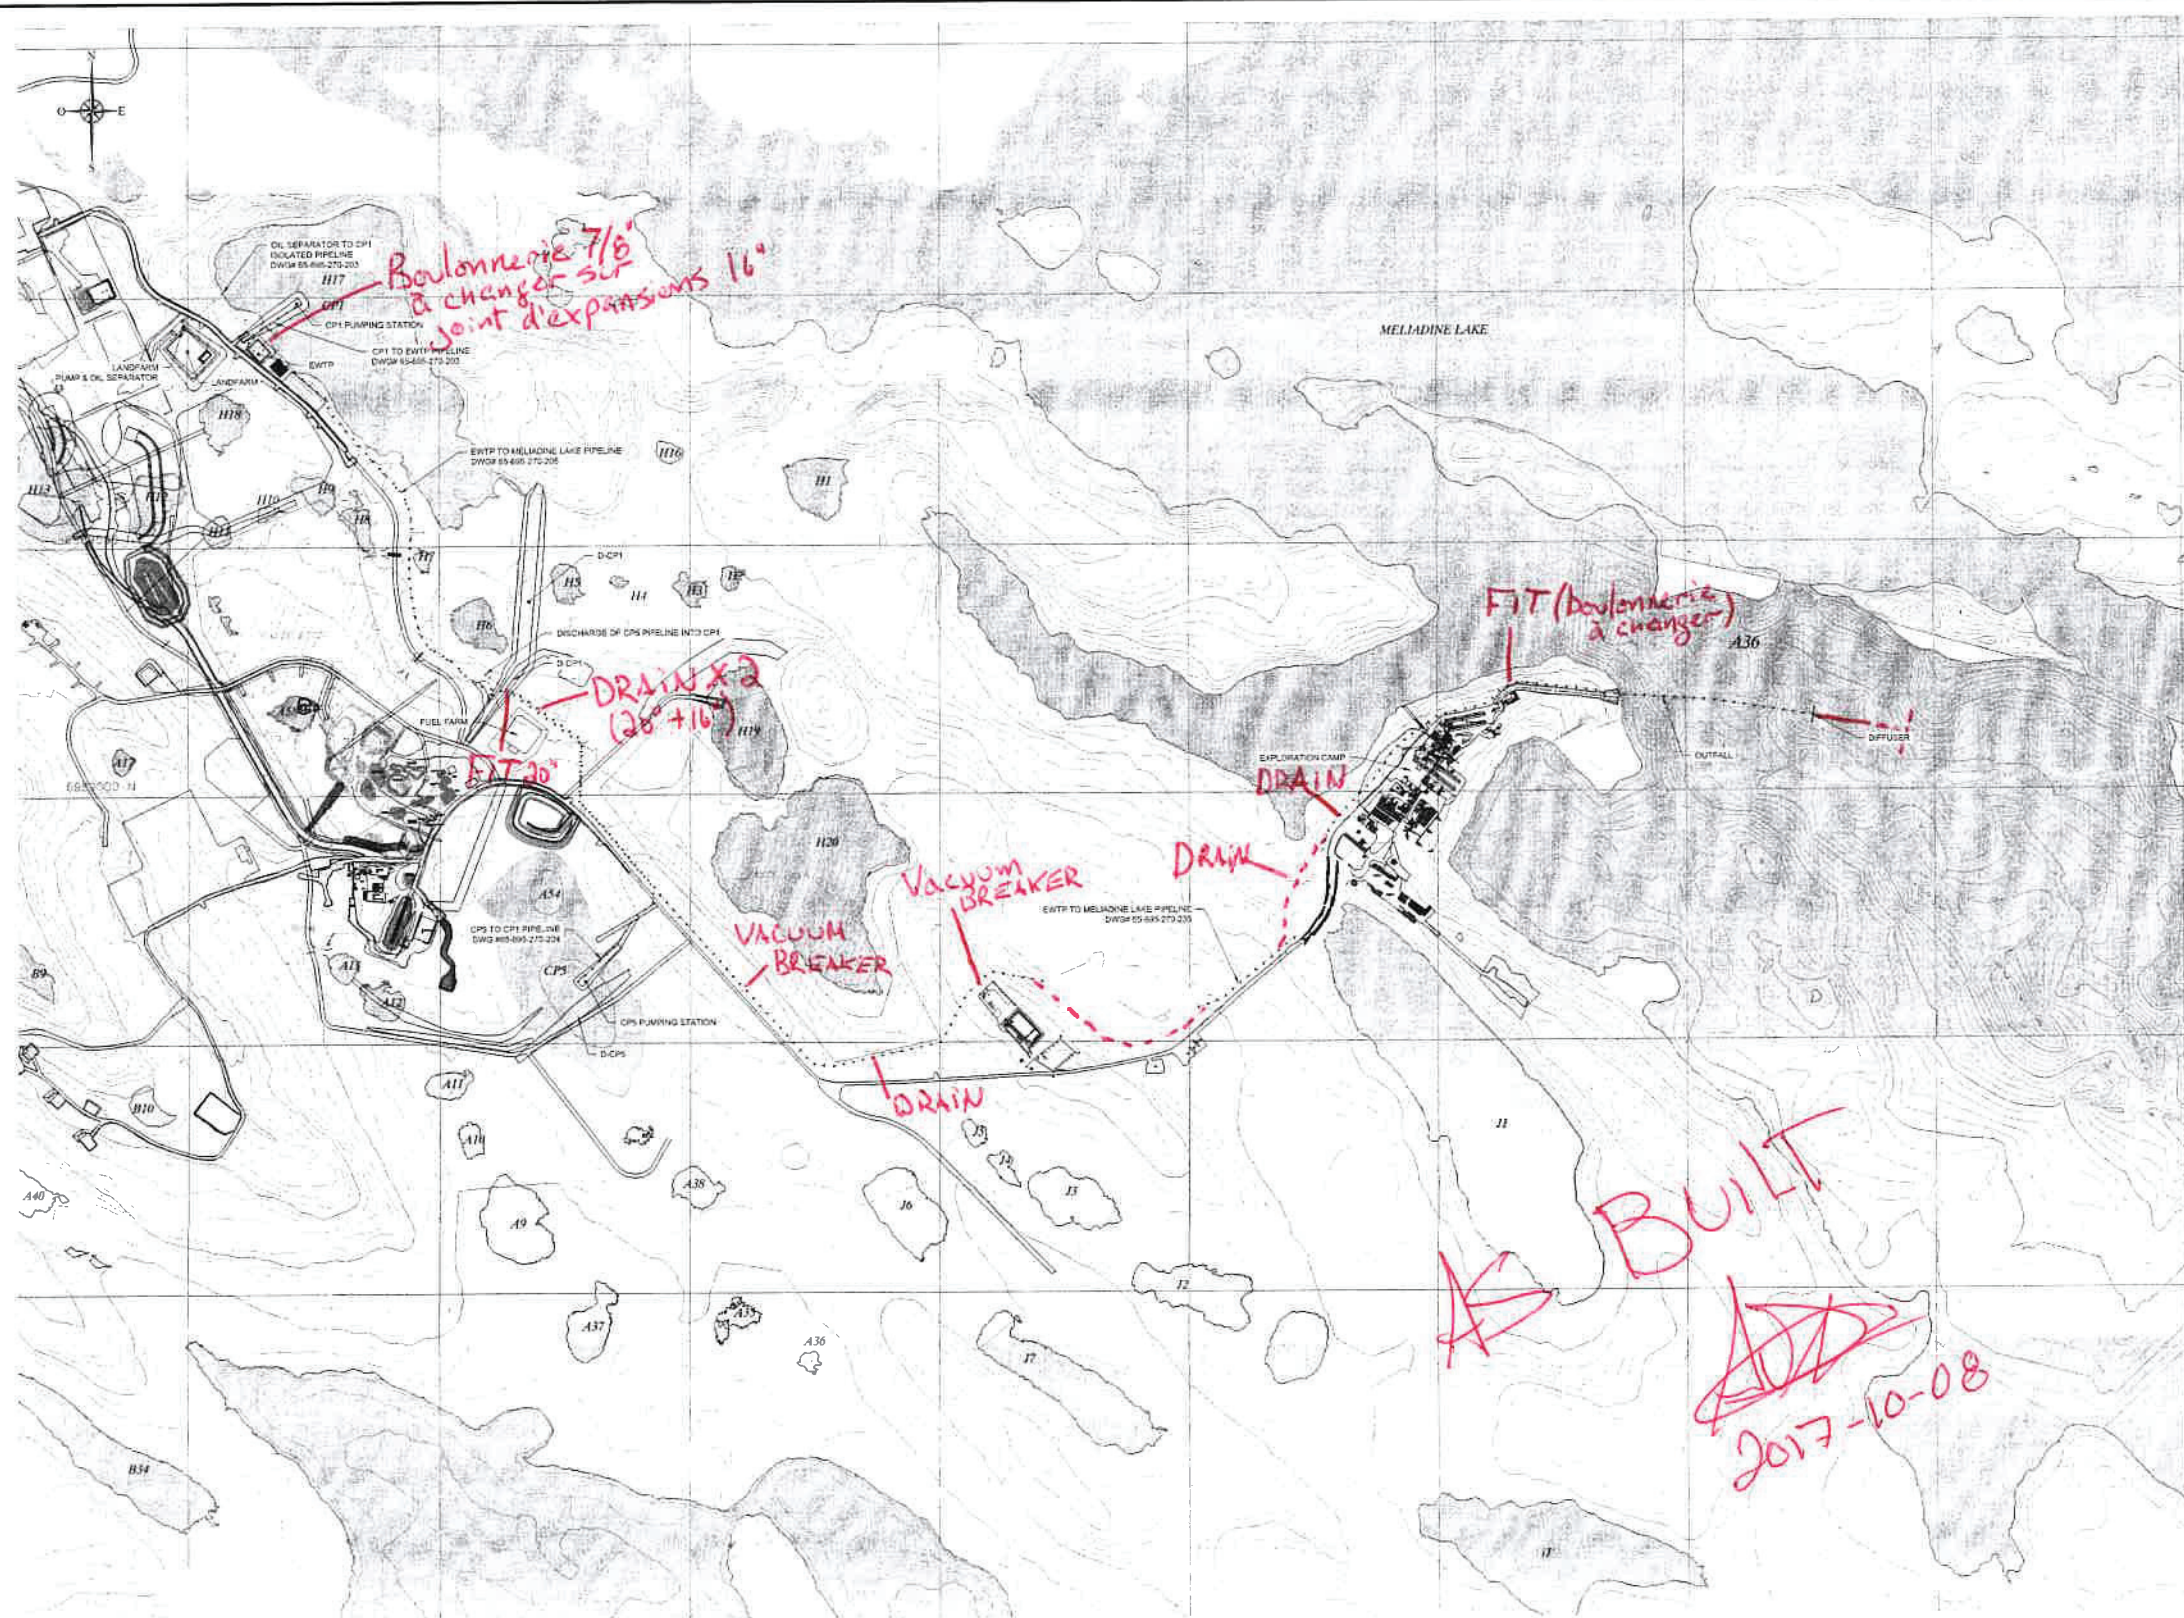

HDPE PIPELINES - GENERAL VIEW 2017
SCALE: 1:5000

PLAN DE
NOTES

NOTES GÉNÉRALES / GENERAL NOTES

1. FOR EACH PIPELINE, A 4" FISH SHALL BE GRADED AND FREE OF BOULDERS AND SHARP ROCKS TO AVOID DAMAGES TO THE PIPE AS IT WANDERS WITH TEMPERATURE VARIATIONS.
2. PIPES SHALL BE ANCHORED EVERY 30m WITH EARTHEN FILL (EXCEPT FOR OTHER SECTIONS SPECIFICALLY DETAILED) AND SHALL BE SHAKED BETWEEN EACH ANCHOR POINTS. SEE DETAIL #11 ON DWG #65-695-270-206 S4.3
3. SEE INSTALLATION SPECIFICATIONS #65-695-265-018-265-SPT-003 #65-695-265-018-265-SOW-001



DESSINS EN RÉFÉRENCE / REFERENCE DRAWINGS

NO.	TITLE	DATE
1		
2		
3		
4		
5		



AGNICO EAGLE



NO.	DATE	DESCRIPTION	BY	CHKD.
1	2017/07/11	FOR CONSTRUCTION	S.C.	O.B.
2	2017/08/22	FOR TENDER (CONSTRUCTION)	S.C.	O.B.
3	2018/11/30	FOR TENDER (SUPPLY)	M.	M.R.

REVISIONS



AGNICO EAGLE - MELIADINE
WATER MANAGEMENT
HDPE PIPELINES - GENERAL ARRANGEMENT
2017 - CONSTRUCTION PLAN

DESIGNED BY	MARIO C.	DATE	2016/11/30
CHECKED BY	BENOIT T.	DATE	2017/06/22
APPROVED BY	ORPHE B.	DATE	2017/06/22
SCALE	SHOWN	DATE	2017/06/22

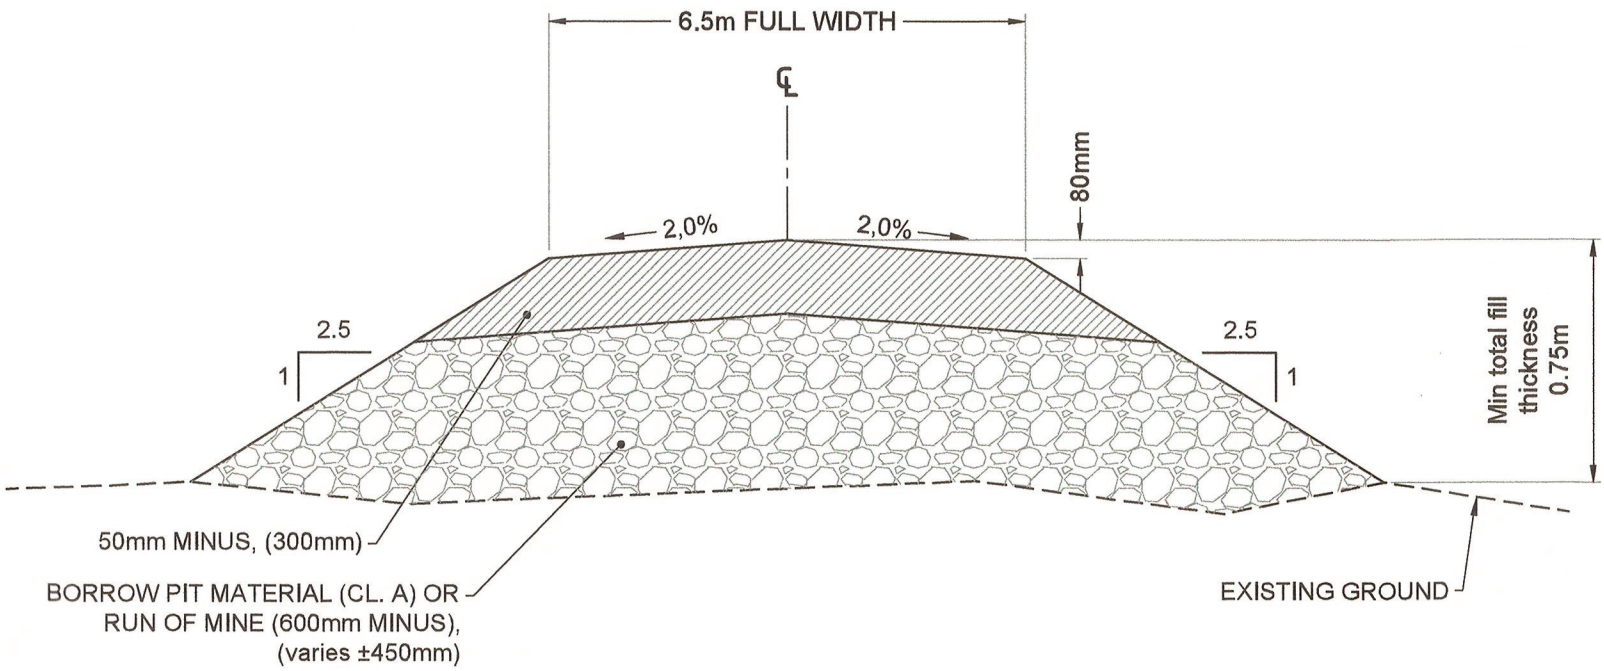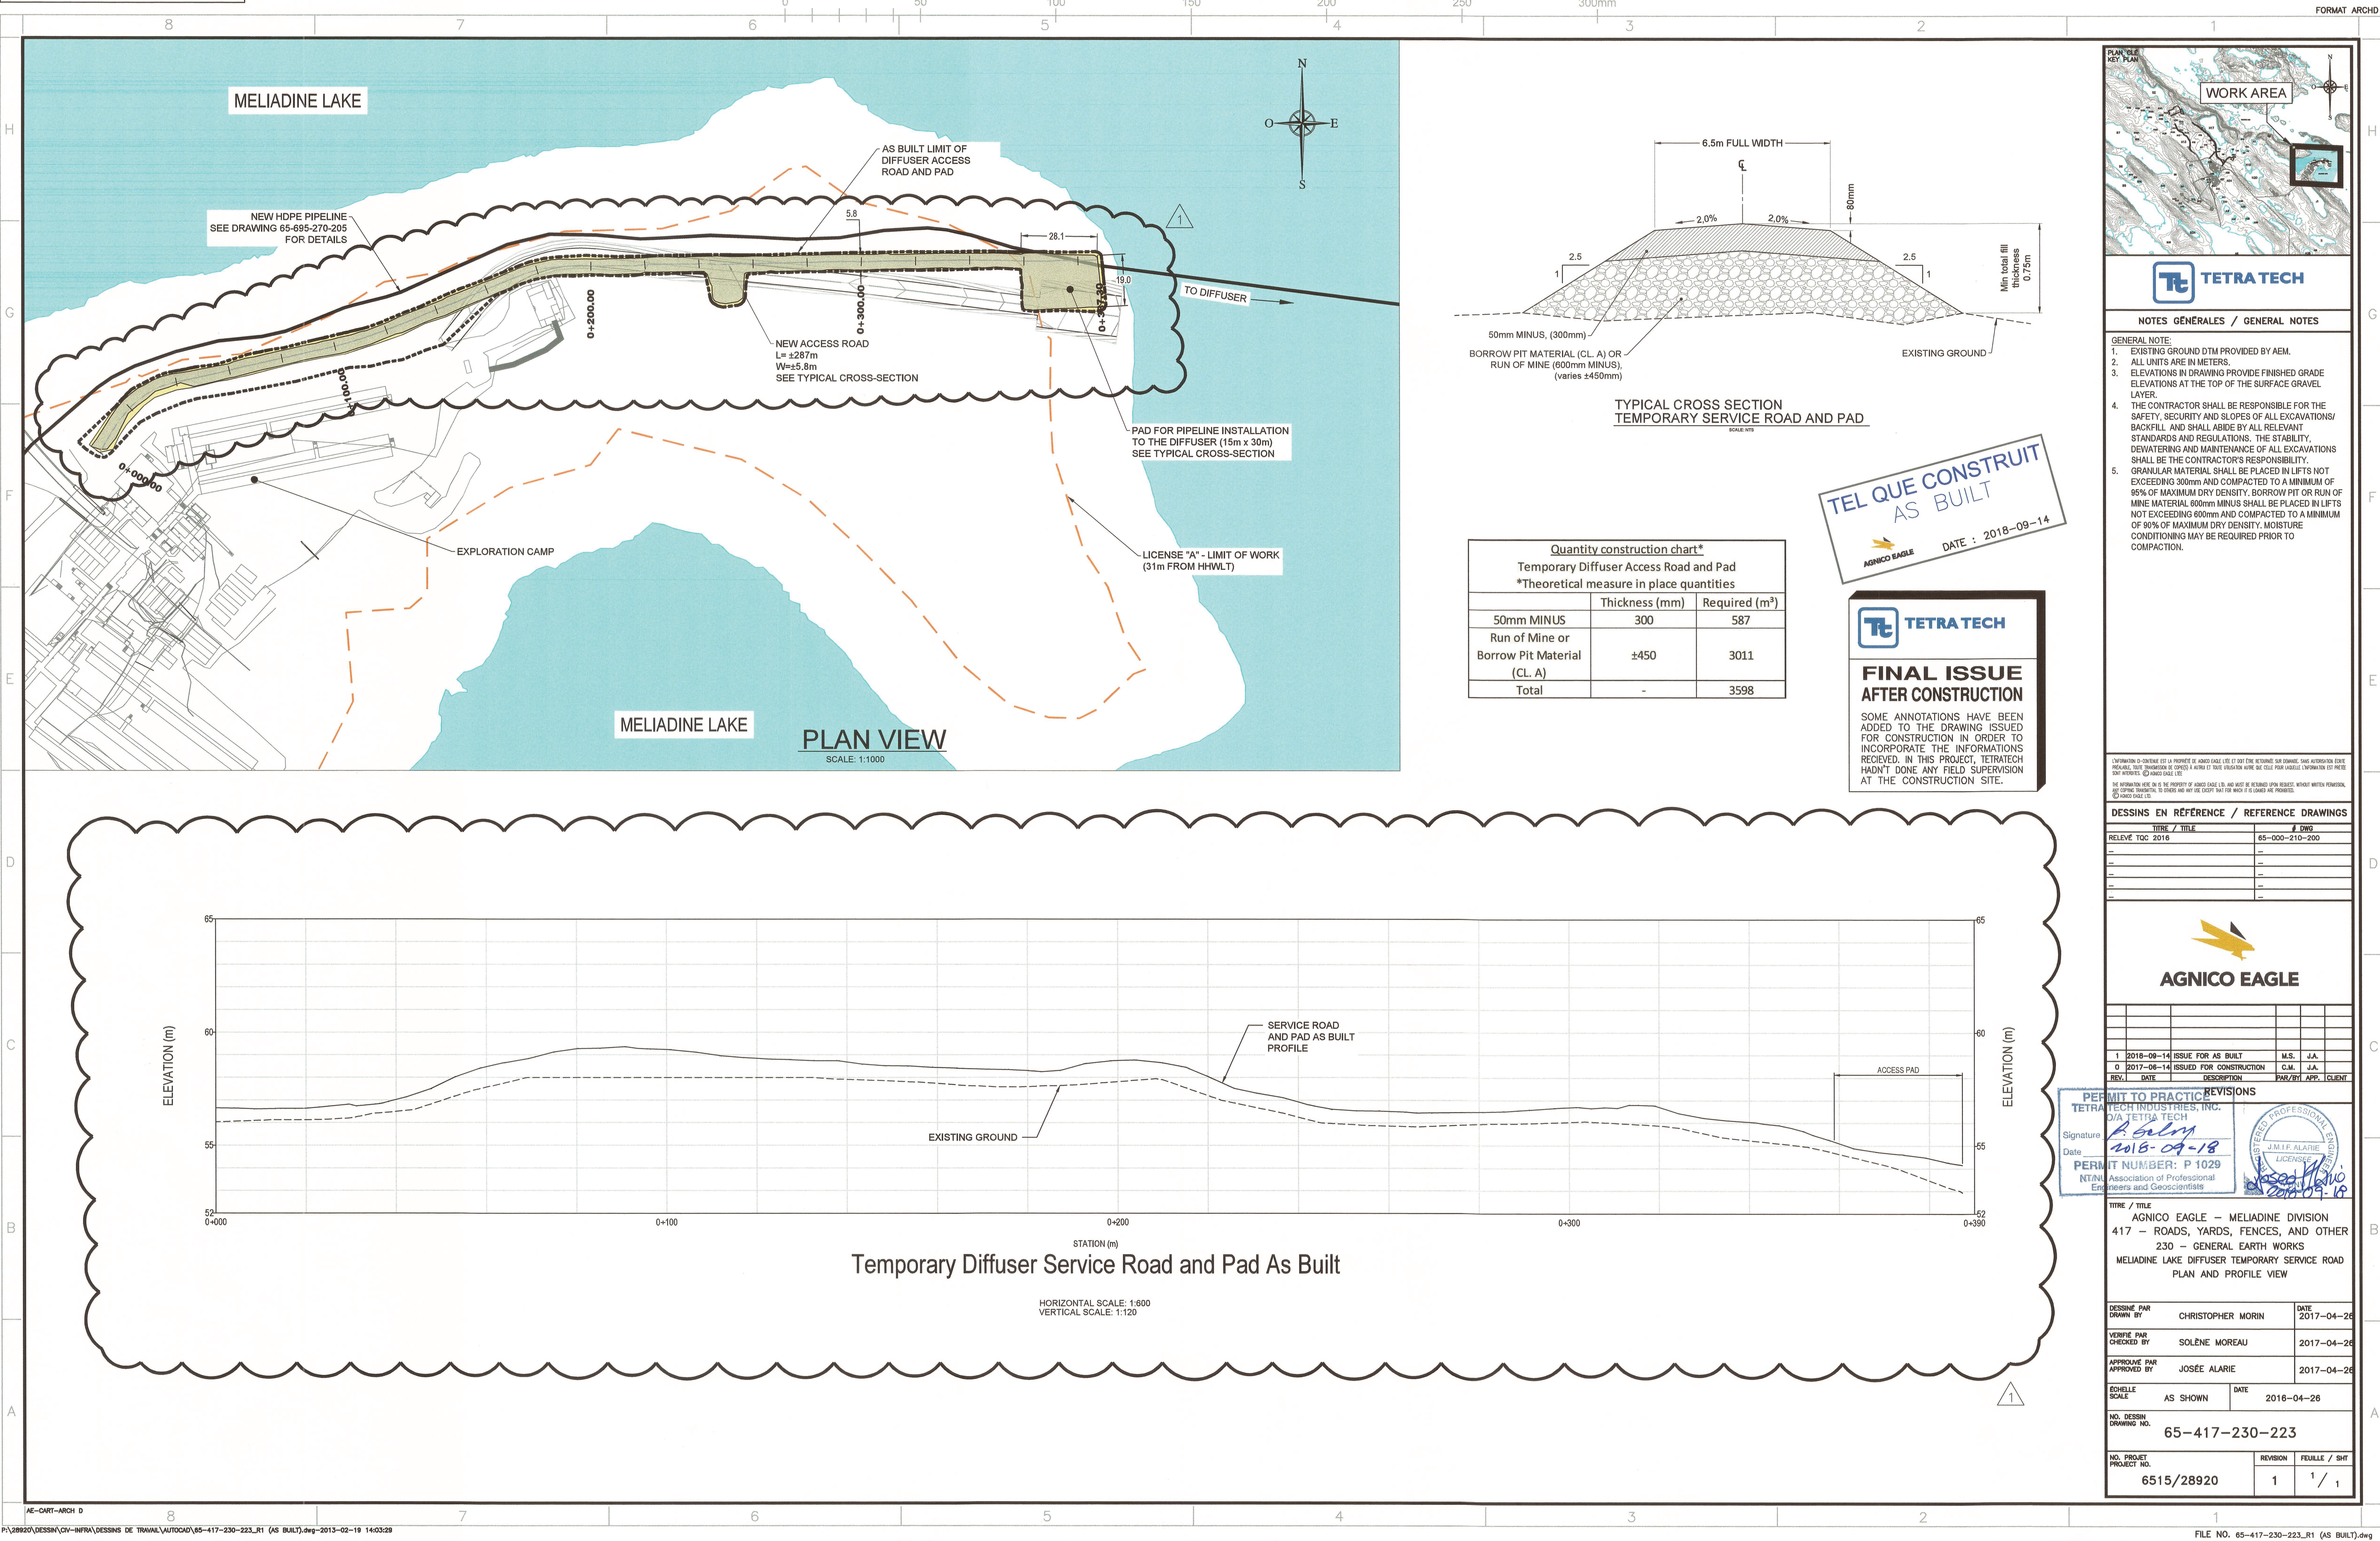

Quantity construction chart*
Temporary Diffuser Access Road and Pad
*Theoretical measure in place quantities


	Thickness (mm)	Required (m³)
50mm MINUS	300	587
Run of Mine or Borrow Pit Material (CL. A)	±450	3011
Total	-	3598

TEL QUE CONSTRUIT
AS BUILT
AGNICO EAGLE
DATE : 2018-09-14

TETRA TECH

**FINAL ISSUE
AFTER CONSTRUCTION**

SOME ANNOTATIONS HAVE BEEN ADDED TO THE DRAWING ISSUED FOR CONSTRUCTION IN ORDER TO INCORPORATE THE INFORMATIONS RECEIVED. IN THIS PROJECT, TETRA TECH HADN'T DONE ANY FIELD SUPERVISION AT THE CONSTRUCTION SITE.

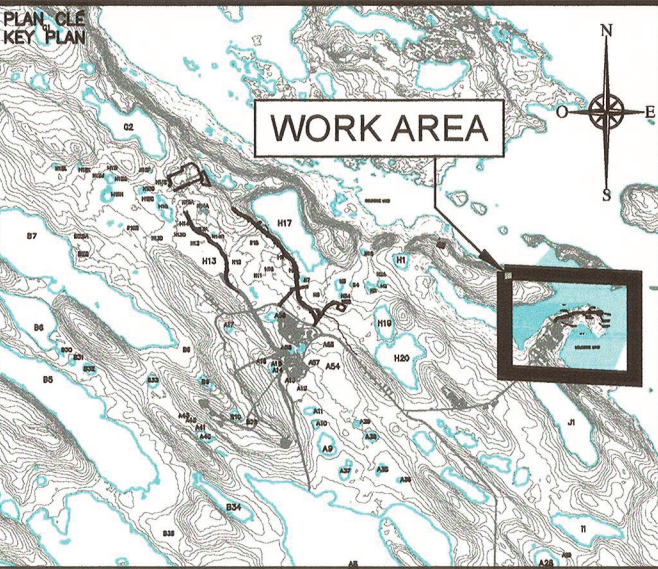

TETRA TECH

NOTES GÉNÉRALES / GENERAL NOTES

GENERAL NOTE:
1. EXISTING GROUND DTM PROVIDED BY AEM.
2. ALL UNITS ARE IN METERS.
3. ELEVATIONS IN DRAWING PROVIDE FINISHED GRADE ELEVATIONS AT THE TOP OF THE SURFACE GRAVEL LAYER.
4. THE CONTRACTOR SHALL BE RESPONSIBLE FOR THE SAFETY, SECURITY AND SLOPES OF ALL EXCAVATIONS/ BACKFILL AND SHALL ABIDE BY ALL RELEVANT STANDARDS AND REGULATIONS. THE STABILITY, DEWATERING AND MAINTENANCE OF ALL EXCAVATIONS SHALL BE THE CONTRACTOR'S RESPONSIBILITY.
5. GRANULAR MATERIAL SHALL BE PLACED IN LIFTS NOT EXCEEDING 300mm AND COMPACTED TO A MINIMUM OF 95% OF MAXIMUM DRY DENSITY. BORROW PIT OR RUN OF MINE MATERIAL 600mm MINUS SHALL BE PLACED IN LIFTS NOT EXCEEDING 600mm AND COMPACTED TO A MINIMUM OF 90% OF MAXIMUM DRY DENSITY. MOISTURE CONDITIONING MAY BE REQUIRED PRIOR TO COMPACTION.

L'information de contenu est la propriété de Agnico Eagle Ltd et doit être retenue par le client. Toute réimpression ou copie sans autorisation écrite est interdite. Toute réimpression ou copie sans autorisation écrite est interdite. Toute réimpression ou copie sans autorisation écrite est interdite.

DESSINS EN RÉFÉRENCE / REFERENCE DRAWINGS

TITRE / TITLE	# DWG
RELEVÉ TQC 2016	65-000-210-200



1	2018-09-14	ISSUE FOR AS BUILT	M.S.	J.A.
0	2017-06-14	ISSUED FOR CONSTRUCTION	C.M.	J.A.
REV.	DATE	DESCRIPTION	PAR/REV	APP. CLIENT

PERMIT TO PRACTICE REVISIONS

TETRA TECH INDUSTRIES, INC.
O/A TETRA TECH

Signature: *[Signature]*
Date: 2018-09-18


PERMIT NUMBER: P 1029
NTNL Association of Professional Engineers and Geoscientists

[Professional Engineer Stamp]


TITRE / TITLE
AGNICO EAGLE - MELIADINE DIVISION
417 - ROADS, YARDS, FENCES, AND OTHER
230 - GENERAL EARTH WORKS
MELIADINE LAKE DIFFUSER TEMPORARY SERVICE ROAD
PLAN AND PROFILE VIEW

DESSINÉ PAR DRAWN BY	CHRISTOPHER MORIN	DATE 2017-04-26
VÉRIFIÉ PAR CHECKED BY	SOLÈNE MOREAU	2017-04-26
APPROUVÉ PAR APPROVED BY	JOSÉE ALARIE	2017-04-26

ÉCHELLE SCALE	AS SHOWN	DATE 2016-04-26
NO. DESSIN DRAWING NO.	65-417-230-223	
NO. PROJET PROJECT NO.	REVISION	FEUILLE / SHEET
6515/28920	1	1 / 1

 

OBJECTIVE: AEM AND SW CONFIRM SYSTEM UNDERSTANDING

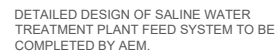

RECOMMENDED:


- SW PLC CONTROL PUMPS ON/OFF WITH LOCAL OVERRIDE
- INSTALLATION OF POND PUMP SEDIMENT SUCTION PREVENTION
- REDUNDANT PUMP FOR SALINE POND
- VFD WITH ETHERNET ON PUMPS FOR SMART DAQ AND PUMP PERFORMANCE

MINE SHAFT



13800 Steveston Hwy
Richmond, BC, Canada, V6W 1A8
Tel: 604.628.6508 Fax: 604.676.2463
www.saltworkstech.com

DRAWING STATUS:	DRAWING STATUS	LTR	DATE	DESCRIPTION	REV. BY:	TITLE: AEM INTEGRATION PFD					REVISION
THIS DOCUMENT EMBODIES DESIGNS AND INFORMATION THAT ARE PROPRIETARY TO SALTWORKS. IT IS TO BE USED ONLY FOR THE PURPOSE AND BY THE ENTITY FOR WHICH IT WAS ORIGINALLY SUPPLIED. THE DOCUMENT MAY NOT BE DUPLICATED OR DISCLOSED TO OTHER PERSON OR ENTITY, OR USED FOR MANUFACTURE OF THE ITEM IN PART OR IN WHOLE WITHOUT THE PRIOR WRITTEN PERMISSION OF SALTWORKS.		1	26-SEP-2017	INITIAL DRAFT	XX	PROJECT: SALTMAKER GEN III		CUSTOMER: AGNICO EAGLE MINES		3	
		2	06-OCT-2017	UPDATED PER AEM COMMENTS	XX	PREPARED BY: XX		DATE: 26-SEP-2017	DWG. NO: SW_EN_SM_GEN III_PID_DWG_INTEGRATPFD		
		3	30-OCT-2017	UPDATED PER AEM COMMENTS	ML	CHECKED BY:		DATE:	JOB/CO NO: (JOB NO.)		
	DO NOT SCALE DRAWING					APPROVED BY: APPROVED BY		DATE: APPROVED DATE	SHEET: # OF #		

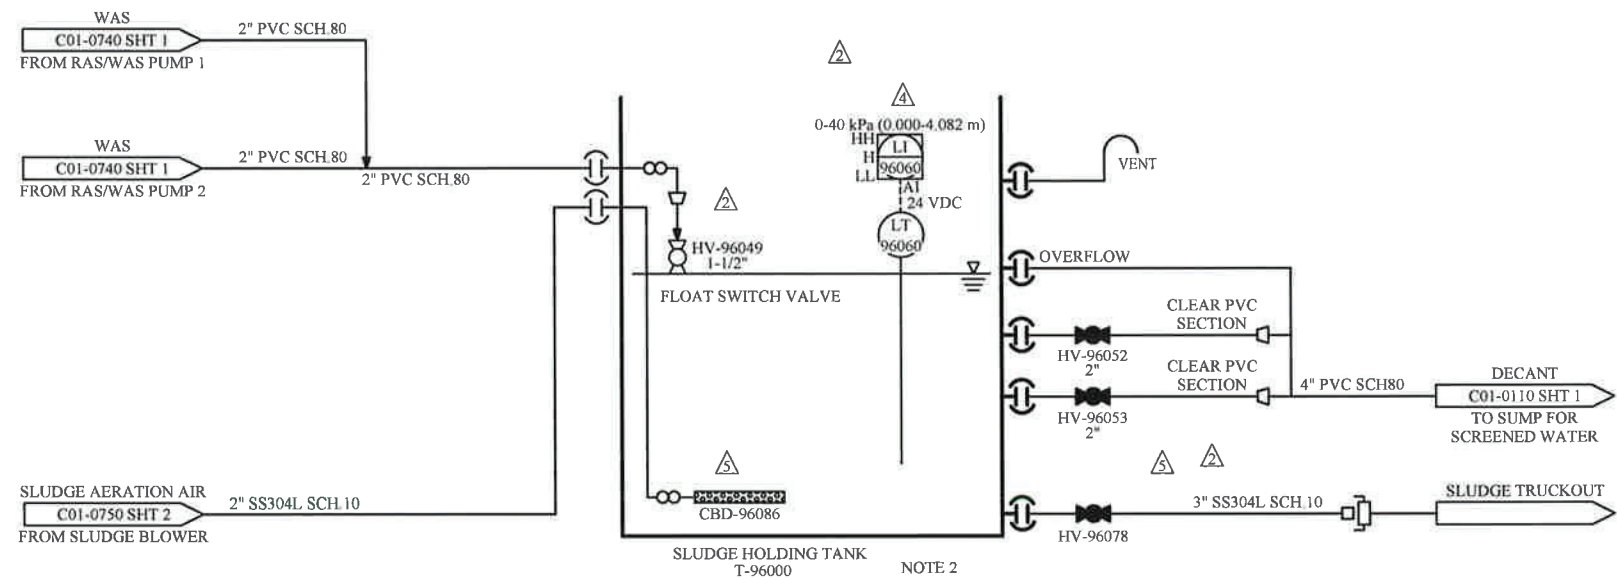

- NOTES:
1. ALL COMPONENTS GOING INTO RIO 101.
 2. SLUDGE HOLDING TANK WITH COVER.
 3. ALL VENT TO OUTSIDE.

NOTE:
THE INFORMATION, SPECIFICATIONS AND DATA SHOWN ON THIS PRINT ARE FURNISHED BY AND ARE TO REMAIN THE PROPERTY OF H₂O INNOVATION.

THE PURPOSE OF THIS DOCUMENT IS TO FACILITATE THE INSTALLATION, MAINTENANCE AND OPERATION OF THE EQUIPMENT REPRESENTED BY SAID PRINT. NO OTHER USE OF THIS DOCUMENT SHALL BE MADE WITHOUT EXPRESS WRITTEN CONSENT FROM H₂O INNOVATION.

DRAWING REVISION						
REV	DATE	REVISION DESCRIPTION	DRAWN	CHKD	ENG	APPVD
06	02/12/2016	REVISED AS INSTALLED	M.P.	R.D.	H.C.	R.D.
05	21/09/2016	REVISED AS BUILT	M.P.	H.S.	H.C.	R.D.
04	08/02/2016	REVISED AS PER COMMENT	M.P.	H.S.	H.C.	H.C.
03	25/07/2016	REVISED AS PER COMMENT	M.P.	H.S.	H.C.	H.C.
01	11/07/2016	CHANGE SUMP TANK BALL TO GATE VALVE, SOLENOID TO ELECTRIC VALVE, TURBIDITY METER TO 120V	M.P.	H.S.	H.C.	H.C.



UNLESS NOTED OTHERWISE
INTERPRETATION
ANSI Y14.5

TOLERANCES
FRACTIONS
DECIMALS
ANGLES
HOLE SIZES
HOLE CENTERS

DO NOT SCALE PRINTS

MELIADINE STP
216 M3/DAY

TITLE:		
SLUDGE HANDLING SYSTEM PROCESS & INSTRUMENTATION DIAGRAM		
SCALE: N/A	DRAWING NUMBER: U65875-C01-0960	REVISION 06
SHEET: 1 of 1		

4

3

2

1

VALVE SYMBOLS

N OPEN N CLOSED

BALL

V-BALL

BUTTERFLY

DIAPHRAGM

GATE

GLOBE

NEEDLE

PLUG

SAMPLE/DRAIN CHECK

BACKFLOW PREVENTER

INJECTION QUILL

3-WAY, 4-WAY

PRESSURE REGULATING

BACK PRESSURE REGULATING

FLOW CONTROL

2-WAY SOLENOID

3-WAY SOLENOID

4-WAY SOLENOID

AIR RELEASE

VACUUM BREAKER

PRESSURE RELEASE

SLUICE GATE/WEIR

VALVE ACTUATOR SYMBOLS

PNEUMATIC (FAIL LAST POSITION)

F.C. PNEUMATIC FAIL CLOSE

F.O. PNEUMATIC FAIL OPEN

ELECTRIC

DIAPHRAGM

POSITIONER (ANY ACTUATOR TYPE)

HAND OVERRIDE (ANY ACTUATOR TYPE)

TRAVEL STOPS (ANY ACTUATOR TYPE)

FLOWMETER SYMBOLS

ROTAMETER

ROTAMETER W/ INTEGRAL NEEDLE VALVE

THERMAL

INTEGRAL

REMOTE

MAGNETIC

PADDLE

VORTEX

DP/ORIFICE

PIPING ABBREVIATIONS

316 SS 316 STAINLESS STEEL

304 SS 304 STAINLESS STEEL

316L SS LOW CARBON 316 STAINLESS STEEL

304L SS LOW CARBON 304 STAINLESS STEEL

CPVC CHLORINATED POLYVINYL CHLORIDE

CS CARBON STEEL

DI DUCTILE IRON

HDPE HIGH-DENSITY POLYETHYLENE

PE POLYETHYLENE

PVC POLYVINYL CHLORIDE

RLCS RUBBER LINED CARBON STEEL

SCH SCHEDULE

SDR STANDARD DIMENSION RATIO

LINE SYMBOLOGY

MAIN PROCESS LINE

SECONDARY PROCESS LINE

PROCESS LINE, BY OTHERS

COMM LINK (EX. PLC TO HMI)

COMM LINK (EX. PLC TO DCS)

ELECTRIC WIRING

PNEUMATIC LINE

LINE JUMPER

PIPE DISCONTINUATION

FLOW DIRECTION ARROWS

4" 316 SS SCH.10 LINES SIZE/MATERIAL IDENTIFIER

SKID BOUNDARY

NOT BY H₂O INNOVATION

SKID BY H₂O INNOVATION

REVISION

LINES TO/FROM OTHER SHEETS

DESCRIPTION

C01-0001 SHT 1

DESTINATION

PUMP SYMBOLS

CENTRIFUGAL

CHEMICAL METERING

DIAPHRAGM

POSITIVE DISPLACEMENT

VACUUM

SUBMERSIBLE OR FLOATING

VERTICAL TURBINE

PERISTALTIC/HOSE

MISCELLANEOUS EQUIPMENT SYMBOLS

CARTRIDGE FILTER HOUSING

AUTOMATIC STRAINER

SILENCER

MOTORIZED MIXER

STATIC MIXER

RESIN TRAP

MOTOR

EDUCTOR OR VENTURI

Y STRAINER

CONICAL OR TEMPORARY STRAINER

PULSATION DAMPENER

DIAPHRAGM

FLOW ORIFICE

RUPTURE DISK (PRESSURE)

RUPTURE DISK (VACUUM)

SPECTACLE BLIND (NORMALLY OPEN, NORMALLY CLOSED)

COARSE BUBBLE DIFFUSER

FINE BUBBLE DIFFUSER

FILTER

TURBOCHARGER

MANWAY

TANK

IMMERSED HEATER

IN-LINE HEATER

ULTRASONIC LEVEL TRANSMITTER

FLOAT-STYLE LEVEL SWITCH

CHEMICAL CONTAINMENT

CALIBRATION COLUMN

MEMBRANE

UV STERILIZER

AIR COMPRESSOR

POSITIVE DISPLACEMENT BLOWER

REGENERATIVE BLOWER

CENTRIFUGAL BLOWER

REFRIGERATED AIR DRYER

FLOW CHAMBER

BIO-WHEEL

FLOW INSTRUMENTS

FAH FLOW ALARM HIGH

FAL FLOW ALARM LOW

FCV FLOW CONTROL VALVE

FE FLOW ELEMENT

FI FLOW INDICATOR

FIC FLOW INDICATING CONTROLLER

FIT FLOW INDICATING TRANSMITTER

FR FLOW RECORDING

FSH FLOW SWITCH HIGH

FSL FLOW SWITCH LOW

FV FLOW CONTROL OR ON/OFF VALVE

FQ FLOW TOTALIZER

FY FLOW SIGNAL CONVERT, I/P, OR SOLN

PRESSURE INSTRUMENTS

PAH PRESSURE ALARM HIGH

PAL PRESSURE ALARM LOW

PC PRESSURE CONTROLLER

PCV SELF REG PRESS CONTROL VALVE

PDH DIFFERENTIAL PRESSURE HIGH

PDI DIFFERENTIAL PRESSURE INDICATOR

PDI* DIFF PRESS INDICATING TRANSMITTER

PDSH DIFFERENTIAL PRESS SWITCH HIGH

PG PRESSURE GAUGE

PI PRESSURE INDICATOR

PIC PRESSURE INDICATING CONTROLLER

PIT PRESSURE INDICATING TRANSMITTER

PSH PRESSURE SWITCH HIGH

PSL PRESSURE SWITCH LOW

PSV SELF REG PRESS SAFETY VALVE

PT PRESSURE TRANSMITTER

PY PRESS SIGNAL CONVERT, I/P, OR SOLN

PSLH PRESSURE SWITCH LOW HIGH

LEVEL INSTRUMENTS

LAH LEVEL ALARM HIGH

LAL LEVEL ALARM LOW

LCV SELF REG LEVEL CONTROL VALVE

LE LEVEL ELEMENT

LG LEVEL GAUGE

LI LEVEL INDICATOR

LIC LEVEL INDICATING CONTROLLER

LIT LEVEL INDICATING TRANSMITTER

LSH LEVEL SWITCH HIGH

LSL LEVEL SWITCH LOW

LT LEVEL TRANSMITTER

LV LEVEL CONTROL OR ON/OFF VALVE

LY LEVEL SIGNAL CONVERT, I/P, OR SOLN

TEMPERATURE INSTRUMENTS

TAH TEMPERATURE ALARM HIGH

TAL TEMPERATURE ALARM LOW

TC TEMPERATURE CONTROLLER

TE TEMPERATURE ELEMENT

TG TEMPERATURE GAUGE

TI TEMPERATURE INDICATOR

TIC TEMP INDICATING CONTROLLER

TIT TEMP INDICATING TRANSMITTER

TSH TEMPERATURE SWITCH HIGH

TSL TEMPERATURE SWITCH LOW

TT TEMPERATURE TRANSMITTER

TV TEMP CONTROL OR ON/OFF VALVE

TY TEMP SIGNAL CONVERT, I/P, OR SOLN

ELECTRICAL ABBREVIATIONS

JB JUNCTION BOX

MCP MAIN CONTROL PANEL

RIO REMOTE I/O PANEL

PP POWER PANEL

VFD VARIABLE FREQUENCY DRIVE

HOA HAND-OFF-AUTO

ANALYTICAL INSTRUMENTS

AAH ANALYTICAL ALARM HIGH

AAL ANALYTICAL ALARM LOW

AE ANALYTICAL ELEMENT

AI ANALYTICAL INDICATOR

AIC ANAL INDICATING CONTROLLER

AIT ANAL INDICATING TRANSMITTER

ASH ANALYTICAL SWITCH HIGH

ASL ANALYTICAL SWITCH LOW

AT ANALYTICAL TRANSMITTER

AY ANALYTICAL SIGNAL CONVERT, I/P, OR SOLN

MISCELLANEOUS INSTRUMENTS

HS HAND SWITCH

HI HAND SWITCH POSITION INDICATOR

II CURRENT INDICATOR

QOI TOTALIZER INDICATOR

SC SPEED CONTROLLER

SI SPEED INDICATOR

YA MOTOR ALARM

YC MOTOR CONTROL

YI MOTOR ON/OFF INDICATOR

ZI POSITION INDICATOR

ZIC SWITCH CLOSE INDICATOR

ZIO SWITCH OPEN INDICATOR

ZSC POSITION SWITCH CLOSED

ZSO POSITION SWITCH OPEN

ZT POSITION TRANSMITTER

ZY POSITIONER

VALVES & EQUIPMENT

AC AIR COMPRESSOR

ARV AIR RELEASE VALVE

AS AIR SUPPLY

B BLOWER

BT BULK TOTE

CBD COARSE BUBBLE DIFFUSER

CV CHECK VALVE

ED EDUCTOR

F FILTER

FBD FINE BUBBLE DIFFUSER

FL FAIL LAST (DEFAULT IF NOT SHOWN)

FC FAIL CLOSED

FO FAIL OPEN

FQG CALIBRATION COLUMN

H HEATER

HCV HAND CONTROL VALVE

HTR HEATER

HV HAND VALVE

M MOTOR

MX MIXER

P PUMP

RT RESIN TRAP

ST SPILL TANK

STR STRAINER

T TANK

UV ULTRAVIOLET

HV HAND VALVE

MV MULTI FUNCTION VALVE

OTHER ABBREVIATIONS

CAP CAPACITANCE

CIP CLEAN-IN-PLACE

COND CONDUCTIVITY

DO₂ DISSOLVED OXYGEN

ESP EMERGENCY STOP

IA INSTRUMENT AIR

I/P CURRENT TO PNEUMATIC CONVERTER

ORP OXIDATION REDUCTION POTENTIAL

pH HYDROGEN ION

RES RESISTIVITY

RTD RESISTANCE TEMP DETECTOR

SOL SOLENOID

SP SET POINT

uS MICROSIEMENS

NOTE:

THE INFORMATION, SPECIFICATIONS AND DATA SHOWN ON THIS PRINT ARE FURNISHED BY AND ARE TO REMAIN THE PROPERTY OF H₂O INNOVATION.

THE PURPOSE OF THIS DOCUMENT IS TO FACILITATE THE INSTALLATION, MAINTENANCE AND OPERATION OF THE EQUIPMENT REPRESENTED BY SAID PRINT. NO OTHER USE OF THIS DOCUMENT SHALL BE MADE WITHOUT EXPRESS WRITTEN CONSENT FROM H₂O INNOVATION.

DRAWING REVISION

REV DATE REVISION DESCRIPTION DRAWN CHKD ENG APPVD

04 14/06/2017 AS INSTALLED M.P. M.B. R.D. A.M.

03 09/08/2016 AS BUILT M.P. S.B. R.D. A.M.

02 25/07/2016 REVISED AS PER COMMENTS M.P. S.B. R.D. A.M.

01 29/06/2016 AS PER COMMENTS M.P. S.B. R.D. A.M.

00 13/06/2016 INITIAL RELEASE M.P. S.B. R.D. A.M.

h₂O INNOVATION

knowledge to share du savoir à partager

UNLESS NOTED OTHERWISE

INTERPRETATION AND 114 5

TOLERANCES

FRACTIONS 1/16" 3/32" 1/8" 3/16" 1/4"

DECIMALS 0.01 0.03125 0.0625 0.125 0.25 0.5 1.0

ANGLES 15° 30° 45° 60° 90°

HOLE SIZES 0.015 0.031 0.062 0.125 0.25 0.5 1.0

HOLE CENTERS 0.015 0.031 0.062 0.125 0.25 0.5 1.0

DO NOT SCALE PRINTS

MELIADINE

WTP CONTAINERIZED UNIT


TITLE: PROCESS AND INSTRUMENTATION DIAGRAMS LEGEND

SCALE: N/A

DRAWING NUMBER: P65873-C01-0001



REVISION: 04

SHEET: 1 of 1

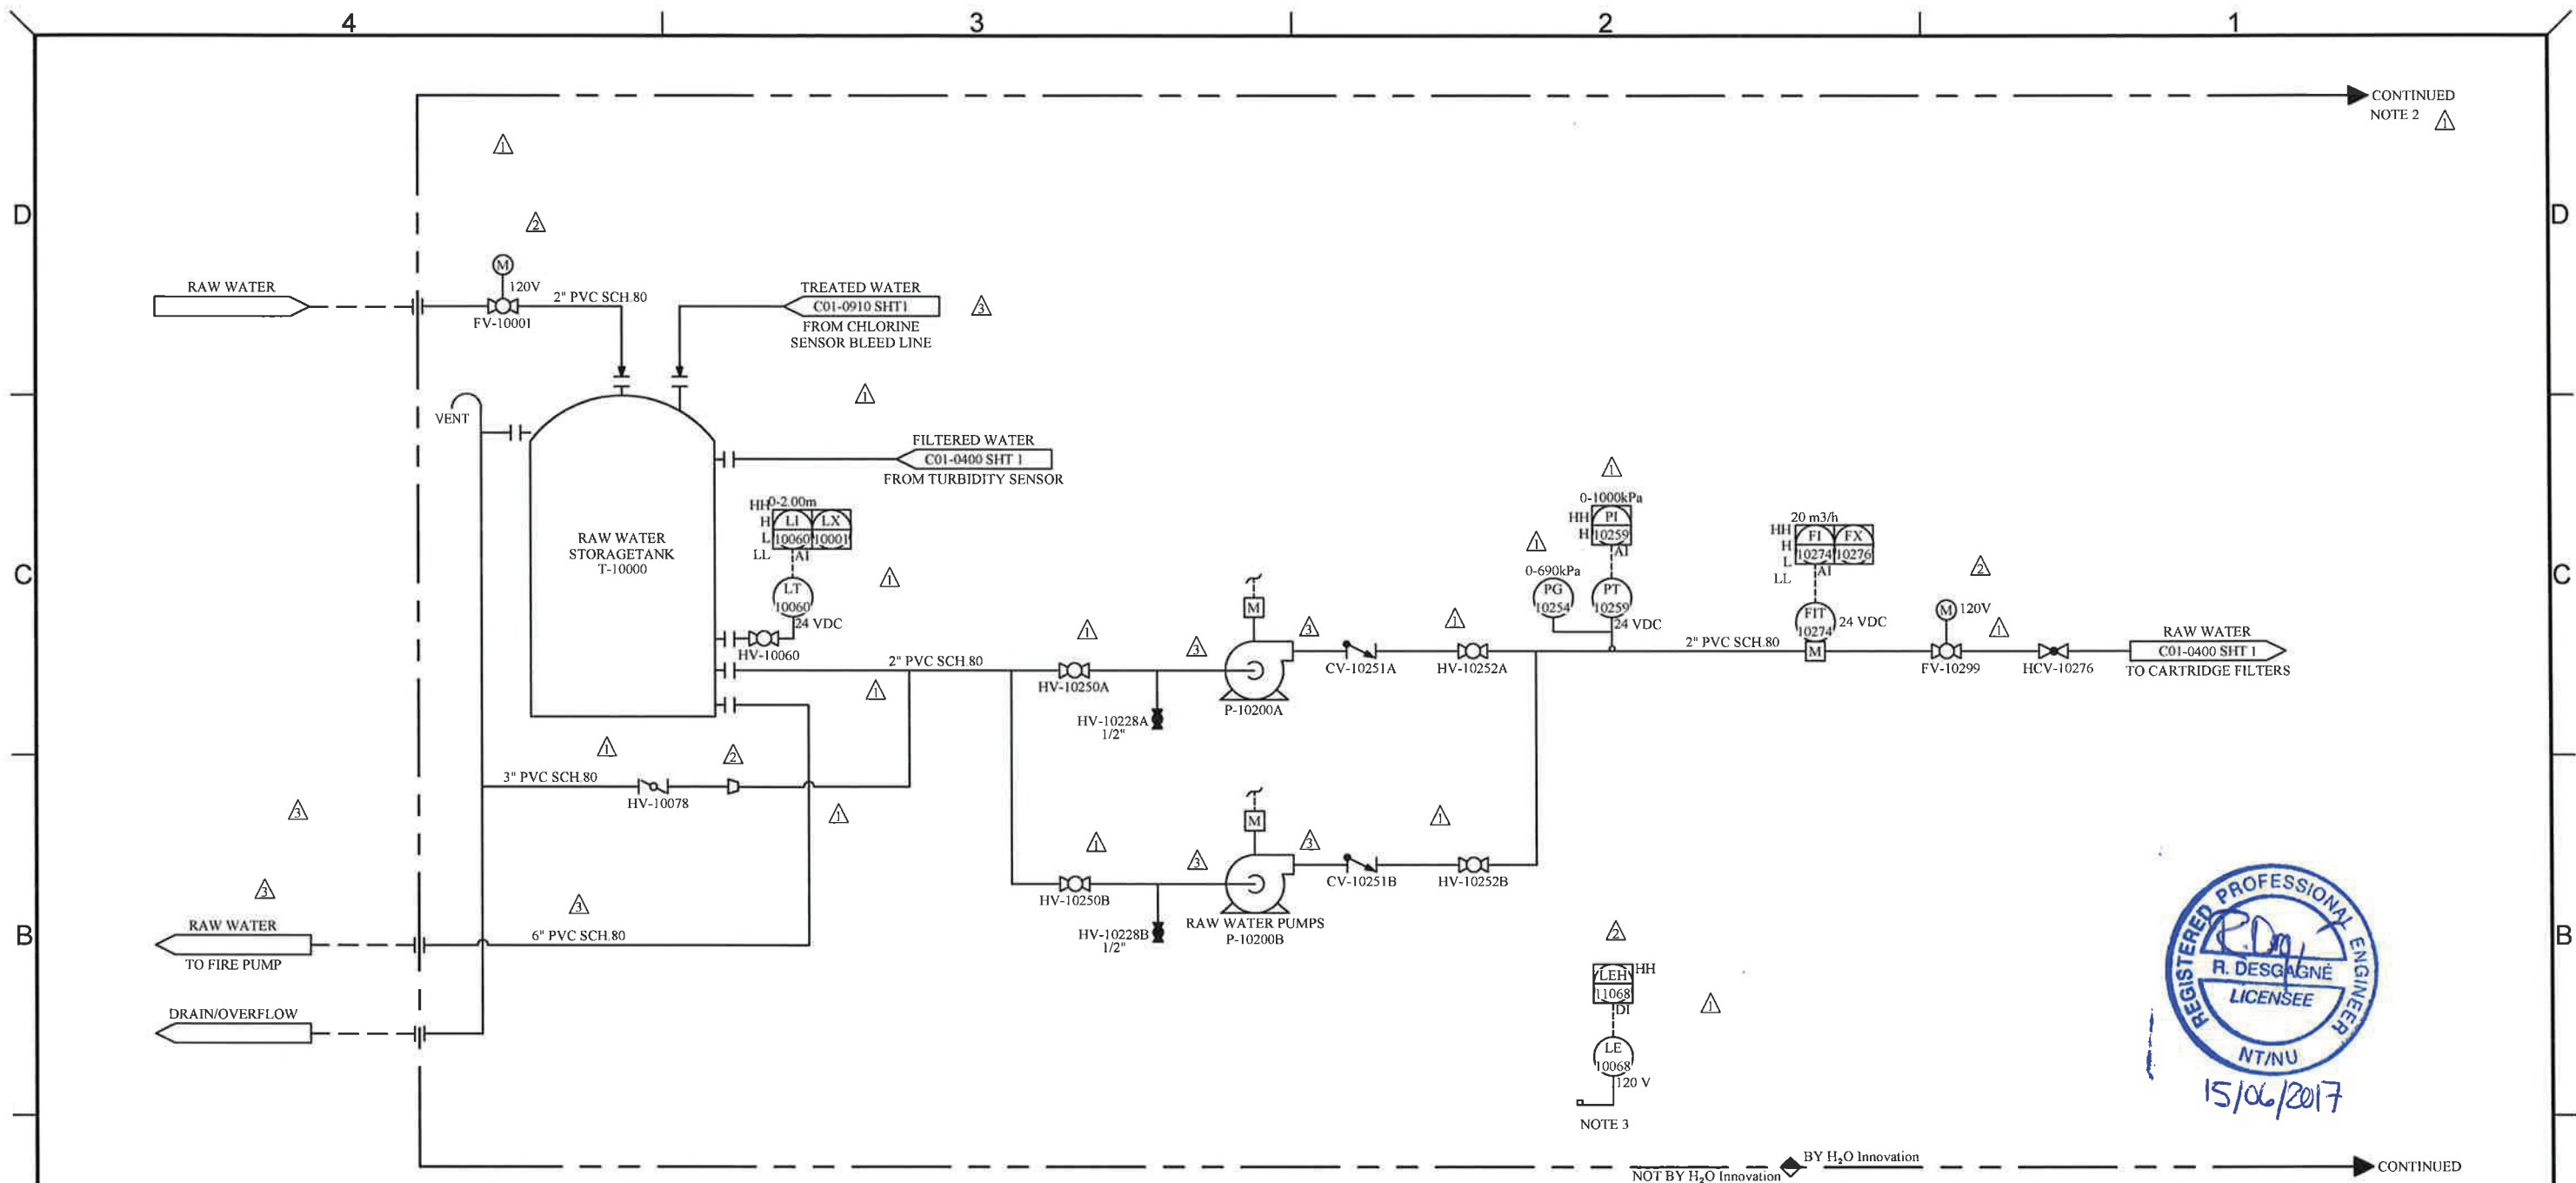

NOTES:

- ALL SIGNALS GOING INTO MCP-101.
- EQUIPMENT TO BE PLACED IN CONTAINER #1.
- WATER LEAK DETECTOR

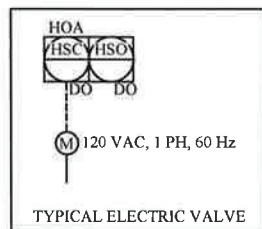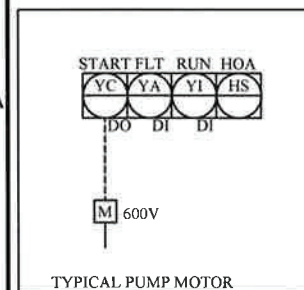

NOTE:
THE INFORMATION, SPECIFICATIONS AND DATA SHOWN ON THIS PRINT ARE FURNISHED BY AND ARE TO REMAIN THE PROPERTY OF H₂O INNOVATION.

THE PURPOSE OF THIS DOCUMENT IS TO FACILITATE THE INSTALLATION, MAINTENANCE AND OPERATION OF THE EQUIPMENT REPRESENTED BY SAID PRINT. NO OTHER USE OF THIS DOCUMENT SHALL BE MADE WITHOUT EXPRESS WRITTEN CONSENT FROM H₂O INNOVATION.

DRAWING REVISION					
REV	DATE	REVISION DESCRIPTION	DRAWN	CHKD	ENG
04	14/06/2017	AS INSTALLED	M.P.	M.B.	R.D.
03	09/08/2016	AS BUILT	M.P.	S.B.	R.D.
02	25/07/2016	REVISED AS PER COMMENTS	M.P.	S.B.	R.D.
01	29/06/2016	AS PER COMMENTS	M.P.	S.B.	R.D.
00	13/06/2016	INITIAL RELEASE	M.P.	S.B.	R.D.



UNLESS NOTED OTHERWISE
INTERPRETATION
ANSI 114.5

TOLERANCES
FRACTIONS
DECIMALS
ANGLES
HOLE SIZES
HOLE CENTERS

DO NOT SCALE PRINTS


MELIADINE
WTP CONTAINERIZED UNIT

TITLE:		
RAW WATER FEED SYSTEM PROCESS & INSTRUMENTATION DIAGRAM		
SCALE: N/A	DRAWING NUMBER: P65873-C01-0100	REVISION 04
SHEET: 1 of 1		

CONTINUES

CONTINUES

NOTE 2

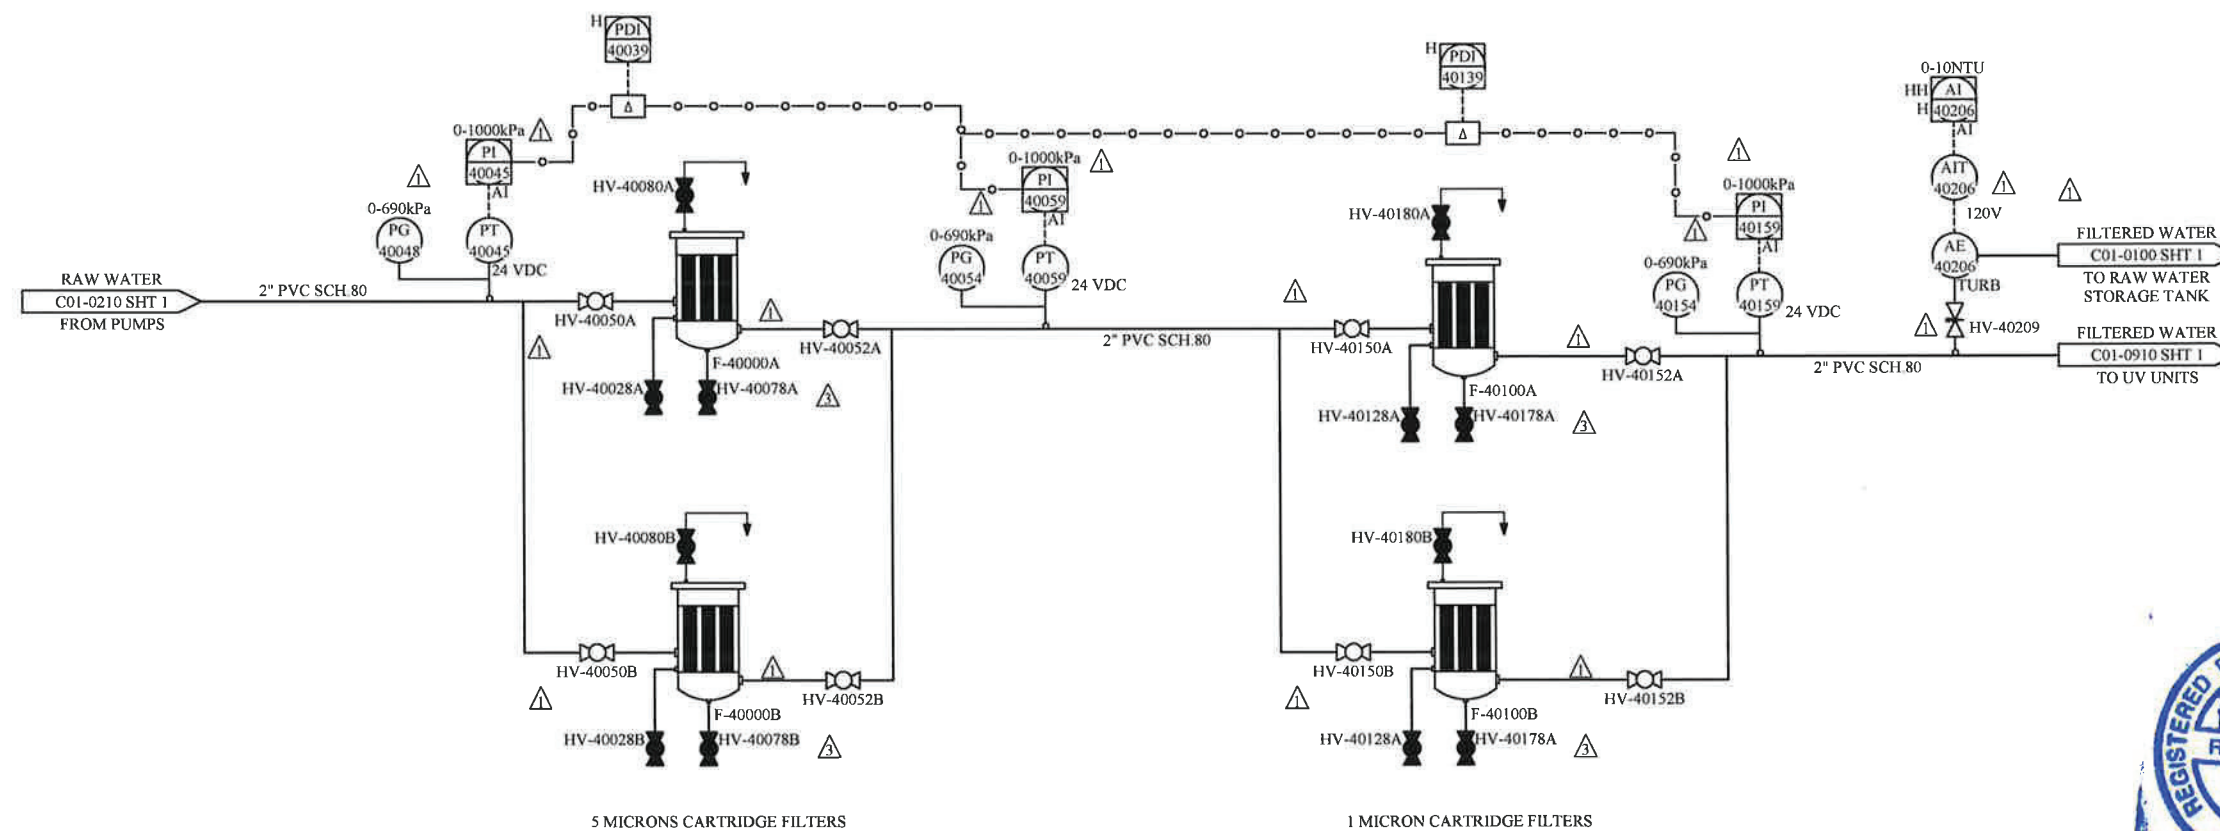

5 MICRONS CARTRIDGE FILTERS

1 MICRON CARTRIDGE FILTERS



CONTINUES

NOT BY H₂O Innovation

CONTINUES

NOTES:

1. ALL SIGNALS GOING INTO MCP-101.
2. EQUIPEMENT TO BE PLACED IN CONTAINER #1.

NOTE:
THE INFORMATION, SPECIFICATIONS AND DATA SHOWN ON THIS PRINT ARE FURNISHED BY AND ARE TO REMAIN THE PROPERTY OF H₂O INNOVATION.

THE PURPOSE OF THIS DOCUMENT IS TO FACILITATE THE INSTALLATION, MAINTENANCE AND OPERATION OF THE EQUIPMENT REPRESENTED BY SAID PRINT. NO OTHER USE OF THIS DOCUMENT SHALL BE MADE WITHOUT EXPRESS WRITTEN CONSENT FROM H₂O INNOVATION.


DRAWING REVISION					
REV	DATE	REVISION DESCRIPTION	DRAWN	CHKD	ENG
04	14/06/2017	AS INSTALLED	M.P.	M.B.	R.D.
03	09/08/2016	AS BUILT	M.P.	S.B.	R.D.
02	25/07/2016	REVISED AS PER COMMENTS	M.P.	S.B.	R.D.
01	29/06/2016	AS PER COMMENTS	M.P.	S.B.	R.D.
00	13/06/2016	INITIAL RELEASE	M.P.	S.B.	R.D.



UNLESS NOTED OTHERWISE
INTERPRETATION
TOLERANCES
FRACTIONS
DECIMALS
ANGLES
HOLE SIZES
HOLE CENTERS
DO NOT SCALE PRINTS


MELIADINE
WTP CONTAINERIZED UNIT

TITLE:		
CARTRIDGE FILTERS PROCESS & INSTRUMENTATION DIAGRAM		
SCALE: N/A	DRAWING NUMBER: P65873-C01-0400	REVISION 04
SHEET: 1 of 1		

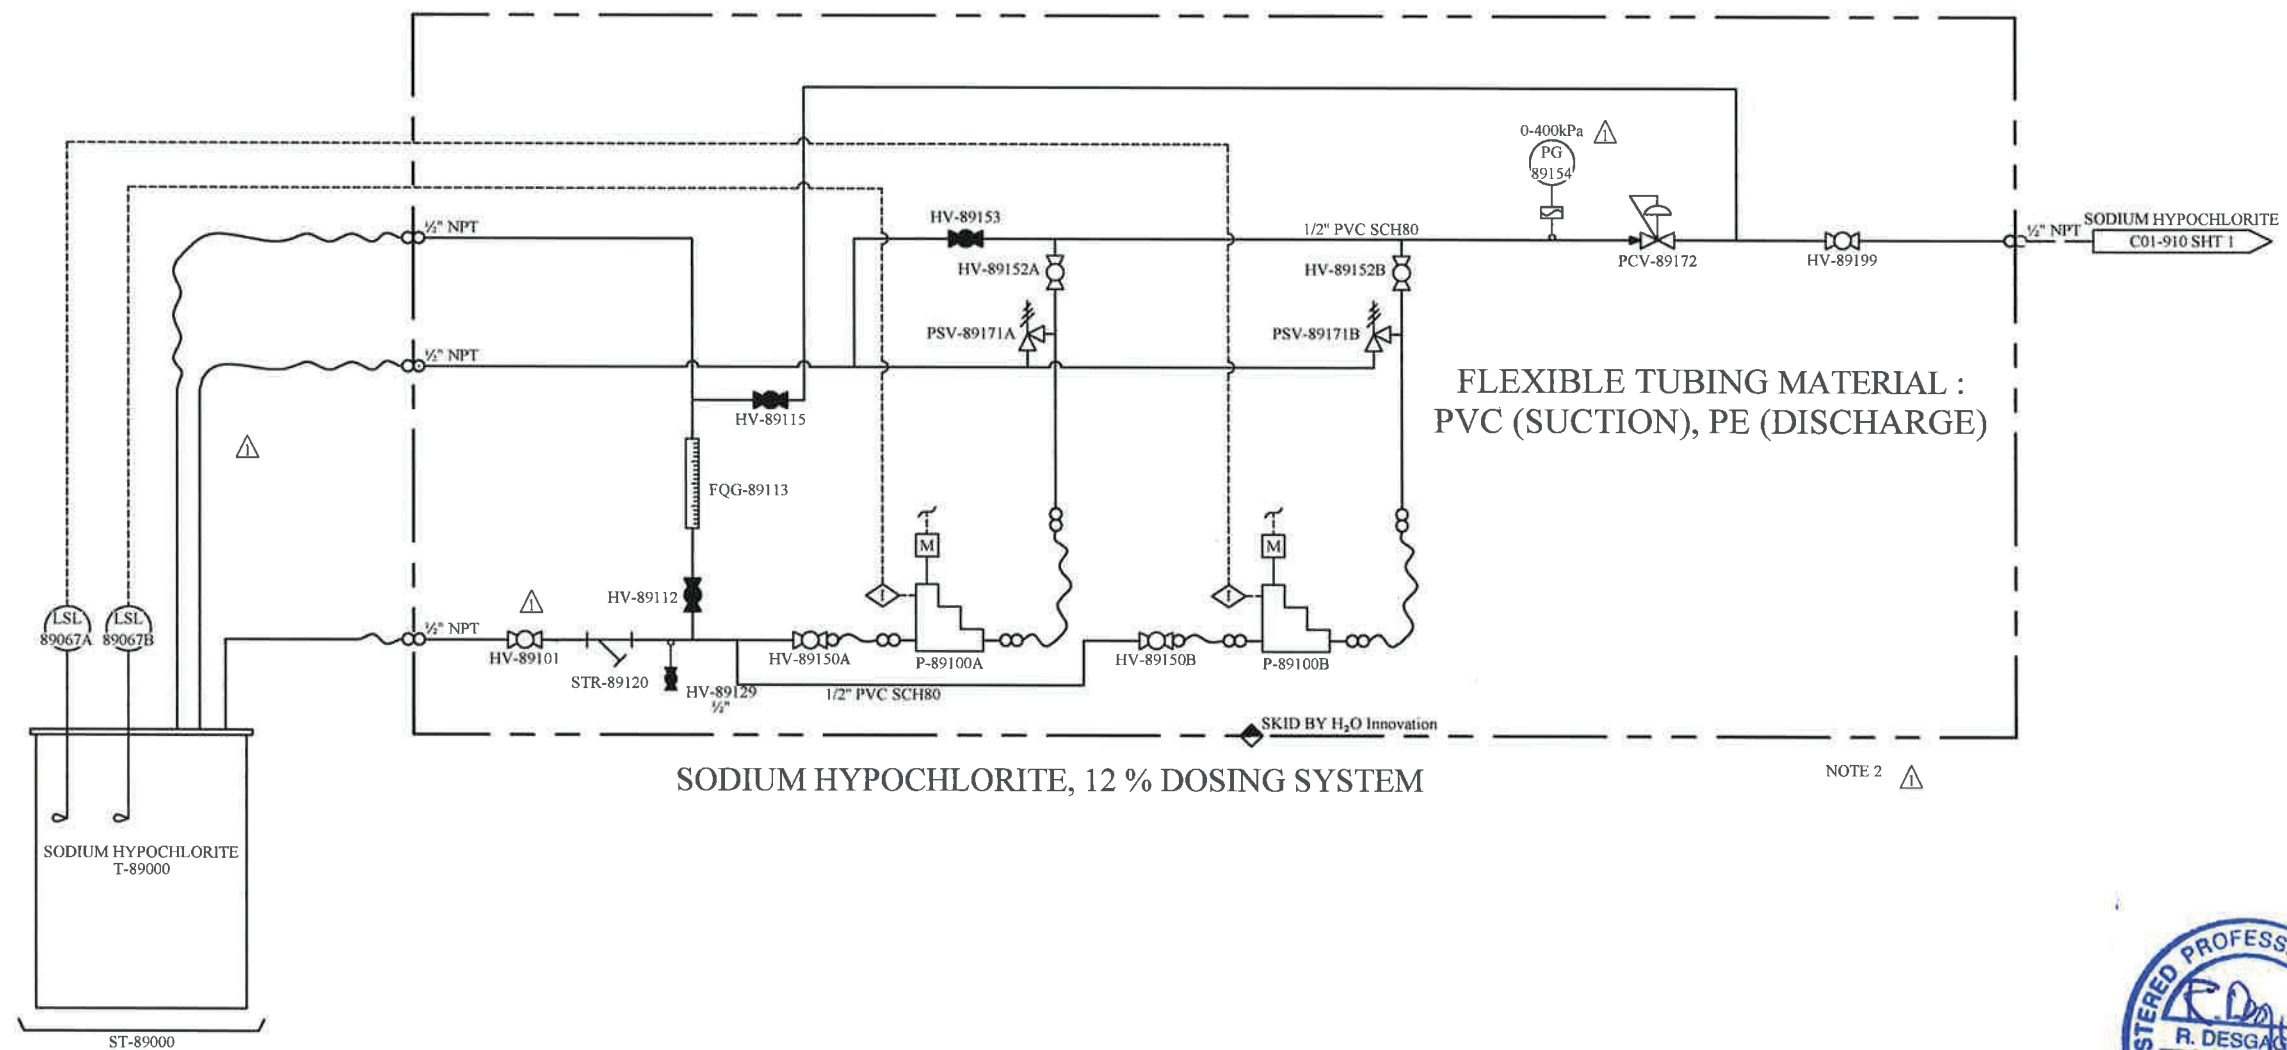

NOTES:

1. ALL SIGNALS GOING INTO MCP-101.
2. EQUIPMENT TO BE PLACED IN CONTAINER #1.

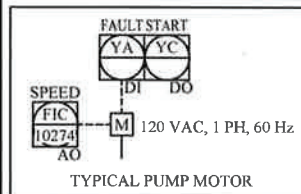

NOTE:
THE INFORMATION, SPECIFICATIONS AND DATA SHOWN ON THIS PRINT ARE FURNISHED BY AND ARE TO REMAIN THE PROPERTY OF H₂O INNOVATION.

THE PURPOSE OF THIS DOCUMENT IS TO FACILITATE THE INSTALLATION, MAINTENANCE AND OPERATION OF THE EQUIPMENT REPRESENTED BY SAID PRINT. NO OTHER USE OF THIS DOCUMENT SHALL BE MADE WITHOUT EXPRESS WRITTEN CONSENT FROM H₂O INNOVATION.

DRAWING REVISION					
REV	DATE	REVISION DESCRIPTION	DRAWN	CHKD	ENG
04	14/06/2017	AS INSTALLED	M.P.	M.B.	R.D.
03	09/08/2016	AS BUILT	M.P.	S.B.	R.D.
02	25/07/2016	REVISED AS PER COMMENTS	M.P.	S.B.	R.D.
01	29/06/2016	AS PER COMMENTS	M.P.	S.B.	R.D.
00	13/06/2016	INITIAL RELEASE	M.P.	S.B.	R.D.



UNLESS NOTED OTHERWISE
INTERPRETATION
ANSI 114.5


TOLERANCES
FRACTIONS
DECIMALS
ANGLES
HOLE SIZES
HOLE CENTERS

DO NOT SCALE PRINTS

MELIADINE

WTP CONTAINERIZED UNIT

TITLE:			
DOSING SKIDS - DUPLEX SOLENOID PROCESS & INSTRUMENTATION DIAGRAM			
SCALE:	DRAWING NUMBER:		REVISION
N/A	P65873-C01-0800		04
SHEET: 1 of 1			

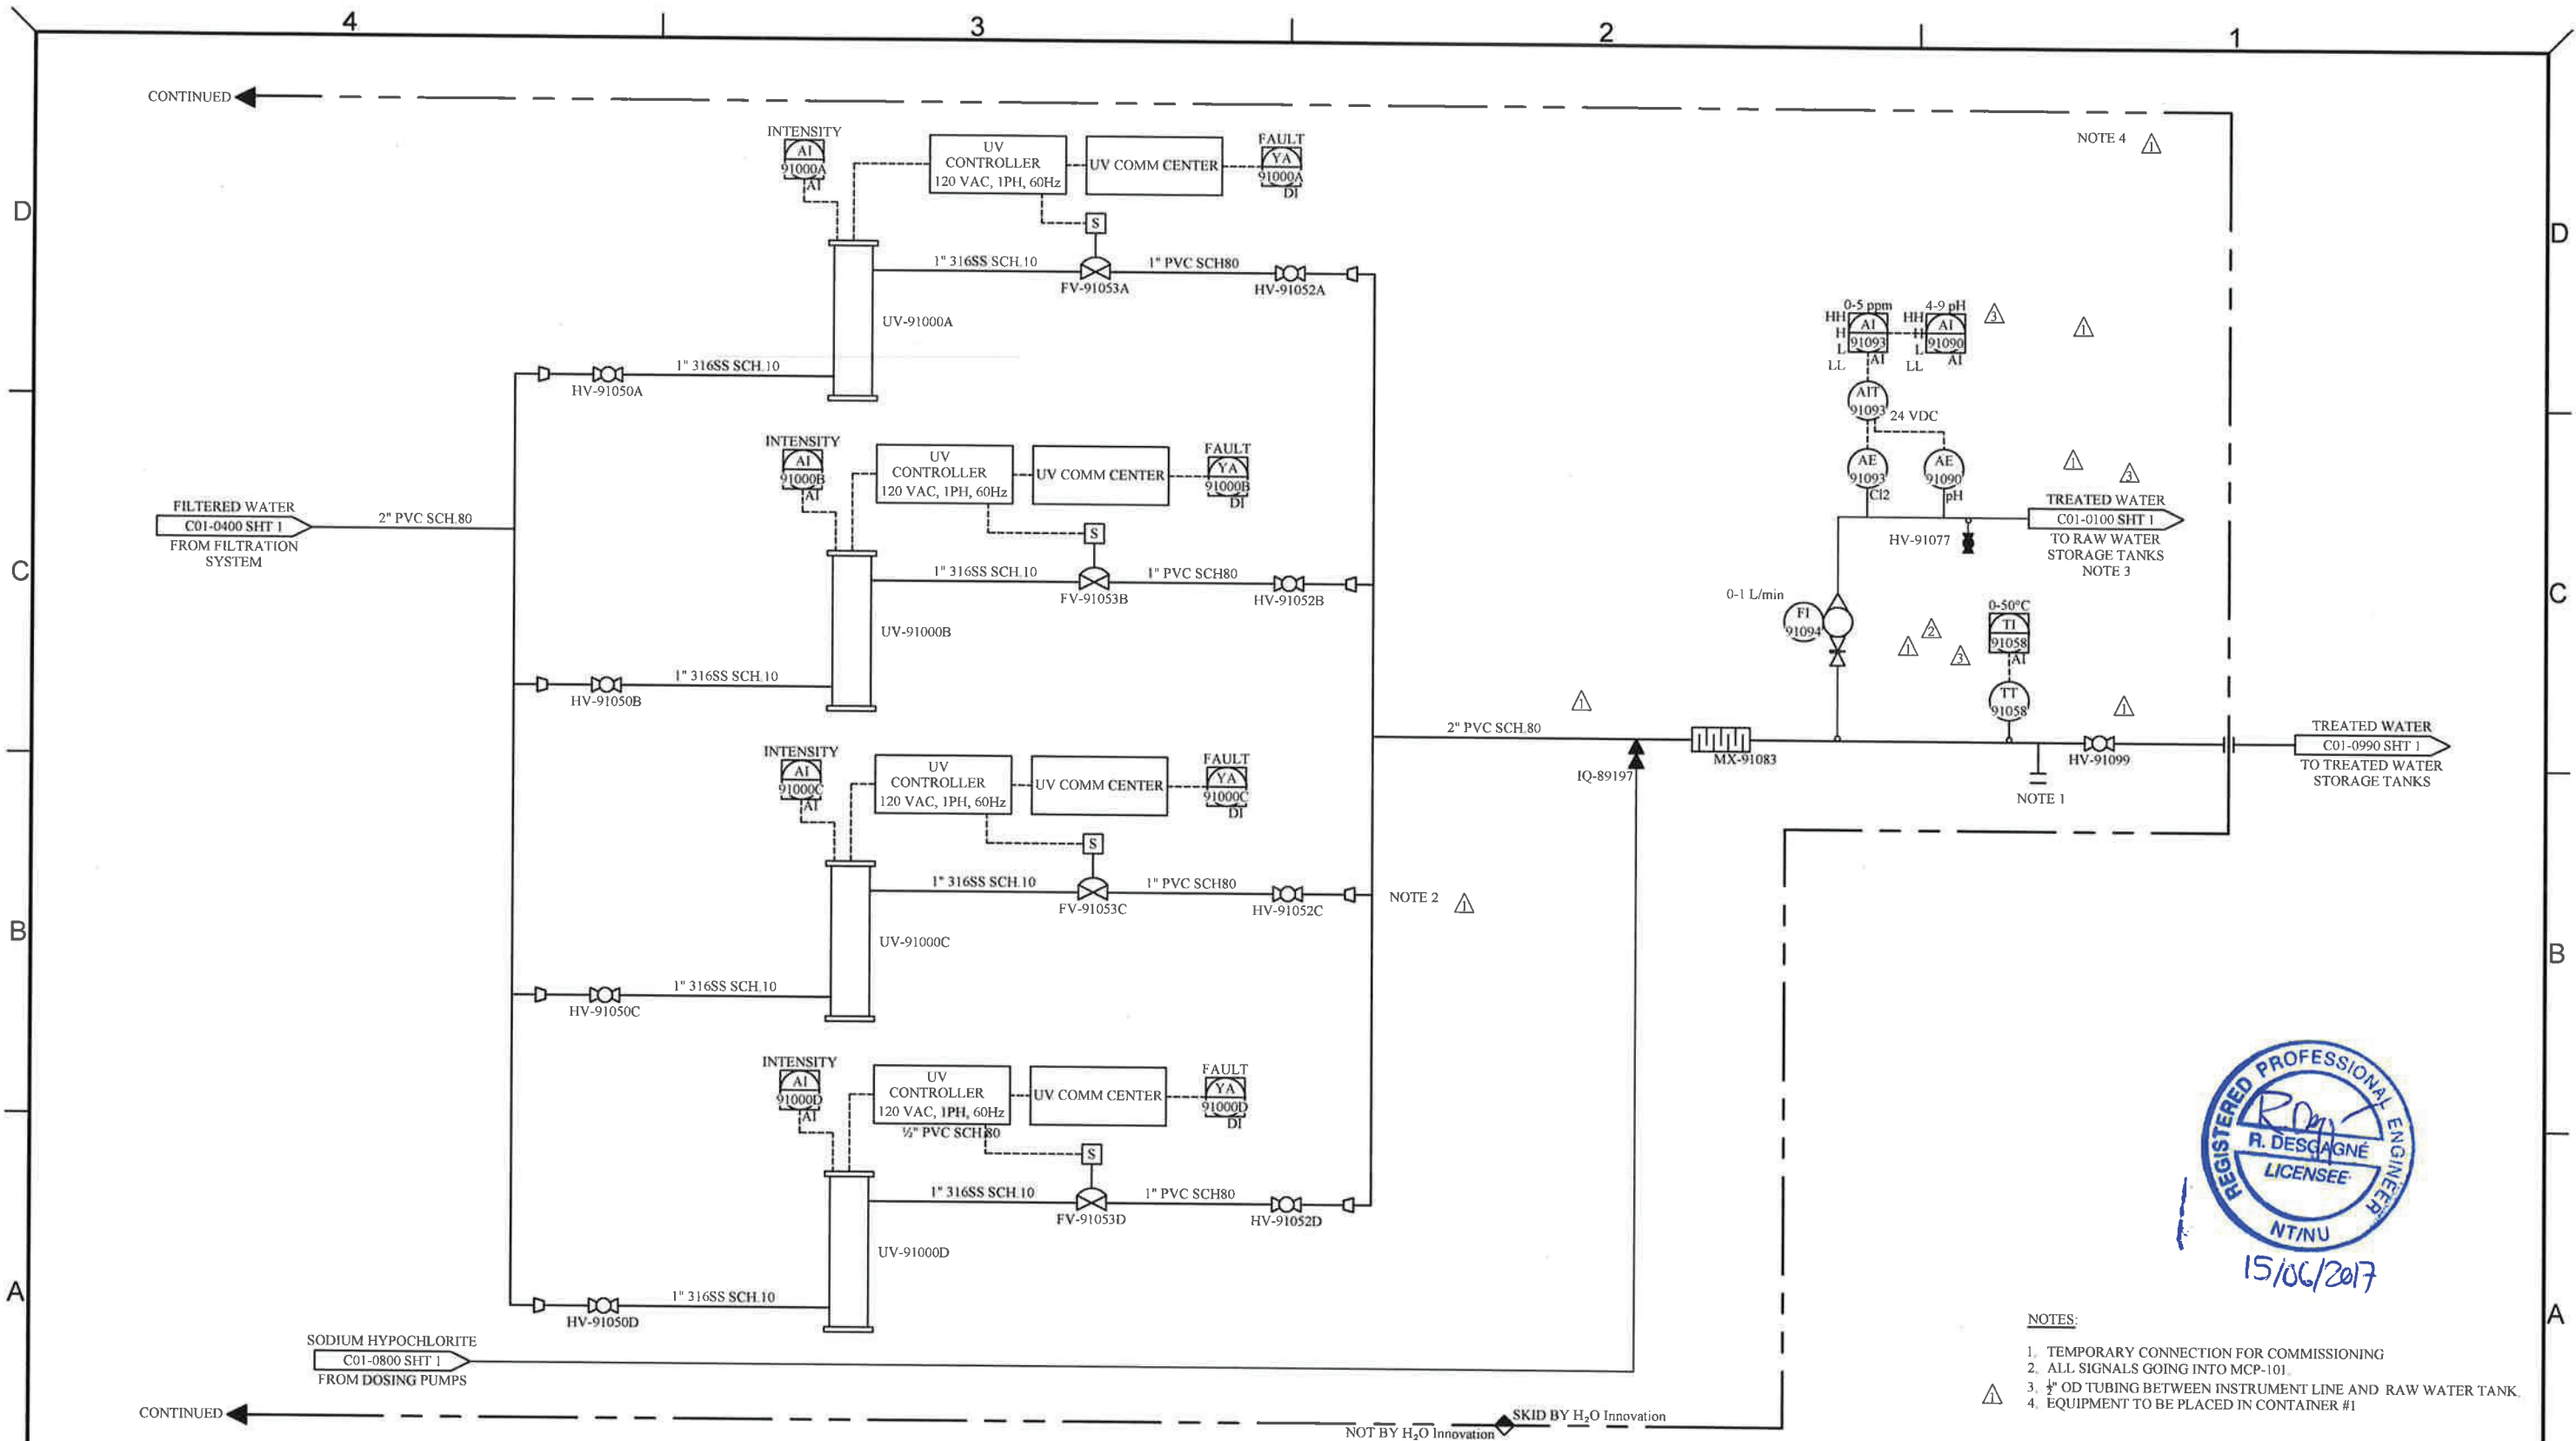

NOTE:
THE INFORMATION, SPECIFICATIONS AND DATA SHOWN ON THIS PRINT ARE FURNISHED BY AND ARE TO REMAIN THE PROPERTY OF H₂O INNOVATION.

THE PURPOSE OF THIS DOCUMENT IS TO FACILITATE THE INSTALLATION, MAINTENANCE AND OPERATION OF THE EQUIPMENT REPRESENTED BY SAID PRINT. NO OTHER USE OF THIS DOCUMENT SHALL BE MADE WITHOUT EXPRESS WRITTEN CONSENT FROM H₂O INNOVATION.

DRAWING REVISION				REVISION DESCRIPTION				DRAWN CHKD ENG APPVD			
REV	DATE	REVISION									
04	14/06/2017	AS INSTALLED						M.P.	M.B.	R.D.	A.M.
03	09/08/2016	AS BUILT						M.P.	S.B.	R.D.	A.M.
02	25/07/2016	REVISED AS PER COMMENTS						M.P.	S.B.	R.D.	A.M.
01	29/06/2016	AS PER COMMENTS						M.P.	S.B.	R.D.	A.M.
00	13/06/2016	INITIAL RELEASE						M.P.	S.B.	R.D.	A.M.



UNLESS NOTED OTHERWISE

INTERPRETATION
ANSI Y14.5


TOLERANCES
FRACTIONS
DECIMALS
ANGLES
HOLE SIZES
HOLE CENTERS

DO NOT SCALE PRINTS

MELIADINE

WTP CONTAINERIZED UNIT

TITLE: UV TREATMENT UNITS PROCESS & INSTRUMENTATION DIAGRAM		
SCALE: N/A	DRAWING NUMBER: P65873-C01-0910	REVISION 04
SHEET: 1 of 1		

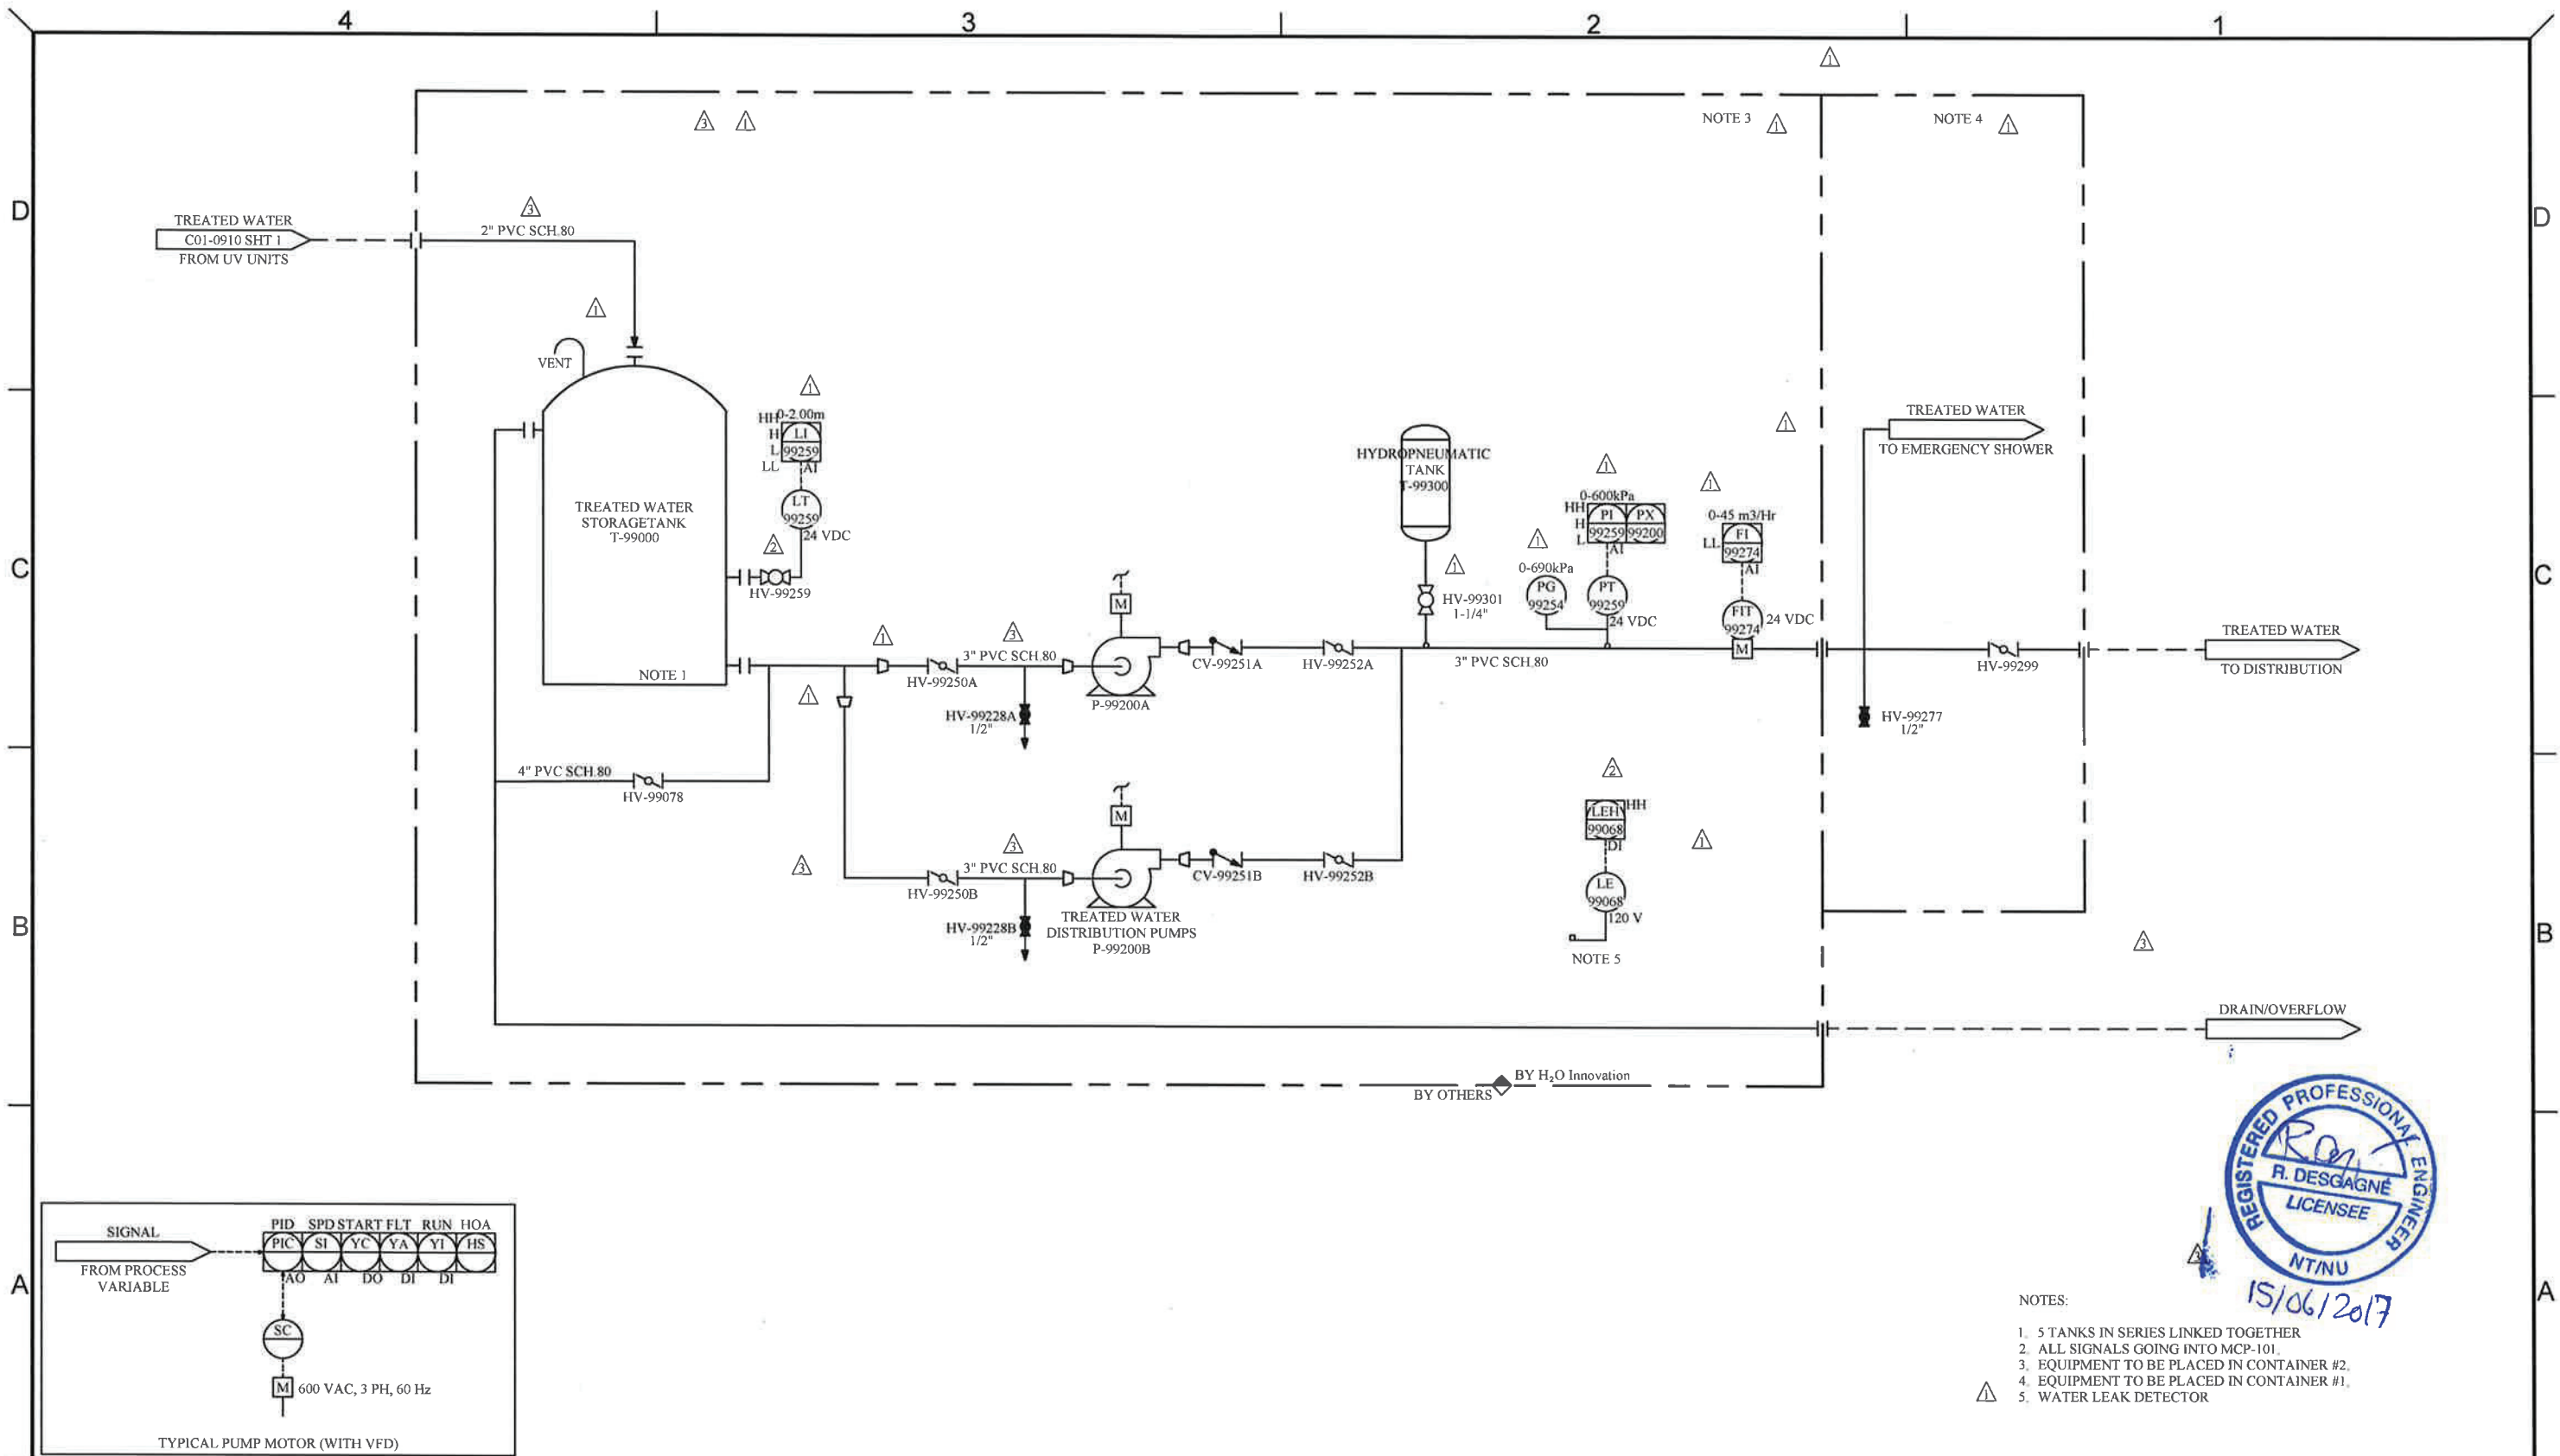

NOTES:

- 5 TANKS IN SERIES LINKED TOGETHER
- ALL SIGNALS GOING INTO MCP-101.
- EQUIPMENT TO BE PLACED IN CONTAINER #2.
- EQUIPMENT TO BE PLACED IN CONTAINER #1.
- WATER LEAK DETECTOR

NOTE:
THE INFORMATION, SPECIFICATIONS AND DATA SHOWN ON THIS PRINT ARE FURNISHED BY AND ARE TO REMAIN THE PROPERTY OF H₂O INNOVATION.

THE PURPOSE OF THIS DOCUMENT IS TO FACILITATE THE INSTALLATION, MAINTENANCE AND OPERATION OF THE EQUIPMENT REPRESENTED BY SAID PRINT. NO OTHER USE OF THIS DOCUMENT SHALL BE MADE WITHOUT EXPRESS WRITTEN CONSENT FROM H₂O INNOVATION.

REV	DATE	REVISION DESCRIPTION	DRAWN	CHKD	ENG	APPVD
04	14/06/2017	AS INSTALLED	M.P.	M.B.	R.D.	A.M.
03	09/08/2016	AS BUILT	M.P.	S.B.	R.D.	A.M.
02	25/07/2016	REVISED AS PER COMMENTS	M.P.	S.B.	R.D.	A.M.
01	29/06/2016	AS PER COMMENTS	M.P.	S.B.	R.D.	A.M.
00	13/06/2016	INITIAL RELEASE	M.P.	S.B.	R.D.	A.M.



UNLESS NOTED OTHERWISE
INTERPRETATION
ANSI Y14.5


TOLERANCES
FRACTIONS
DECIMALS
ANGLES
HOLE SIZES
HOLE LOCATIONS

DO NOT SCALE PRINTS


MELIADINE

WTP CONTAINERIZED UNIT


TITLE: TREATED WATER DISTRIBUTION SYSTEM PROCESS & INSTRUMENTATION DIAGRAM		
SCALE: N/A	DRAWING NUMBER: P65873-C01-0990 SHEET: 1 of 1	REVISION 04

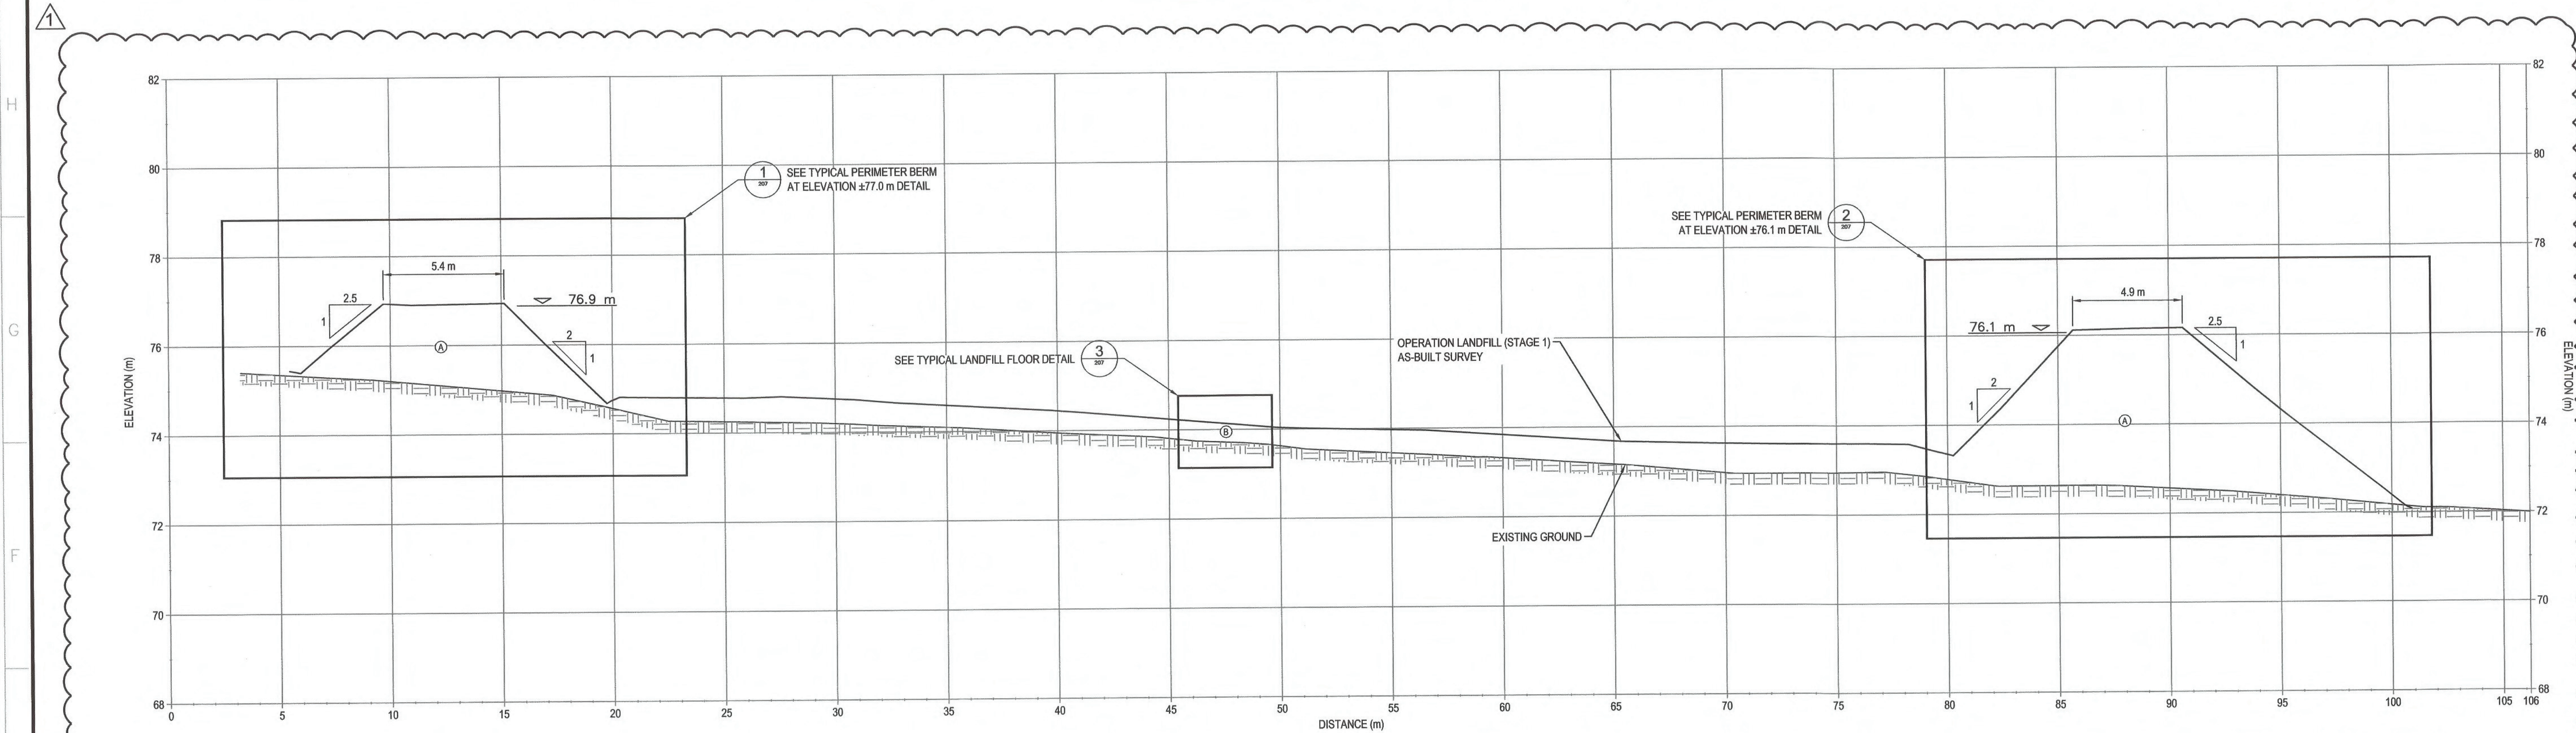

CROSS-SECTION A
SCALE: H-1:150 V-1:75

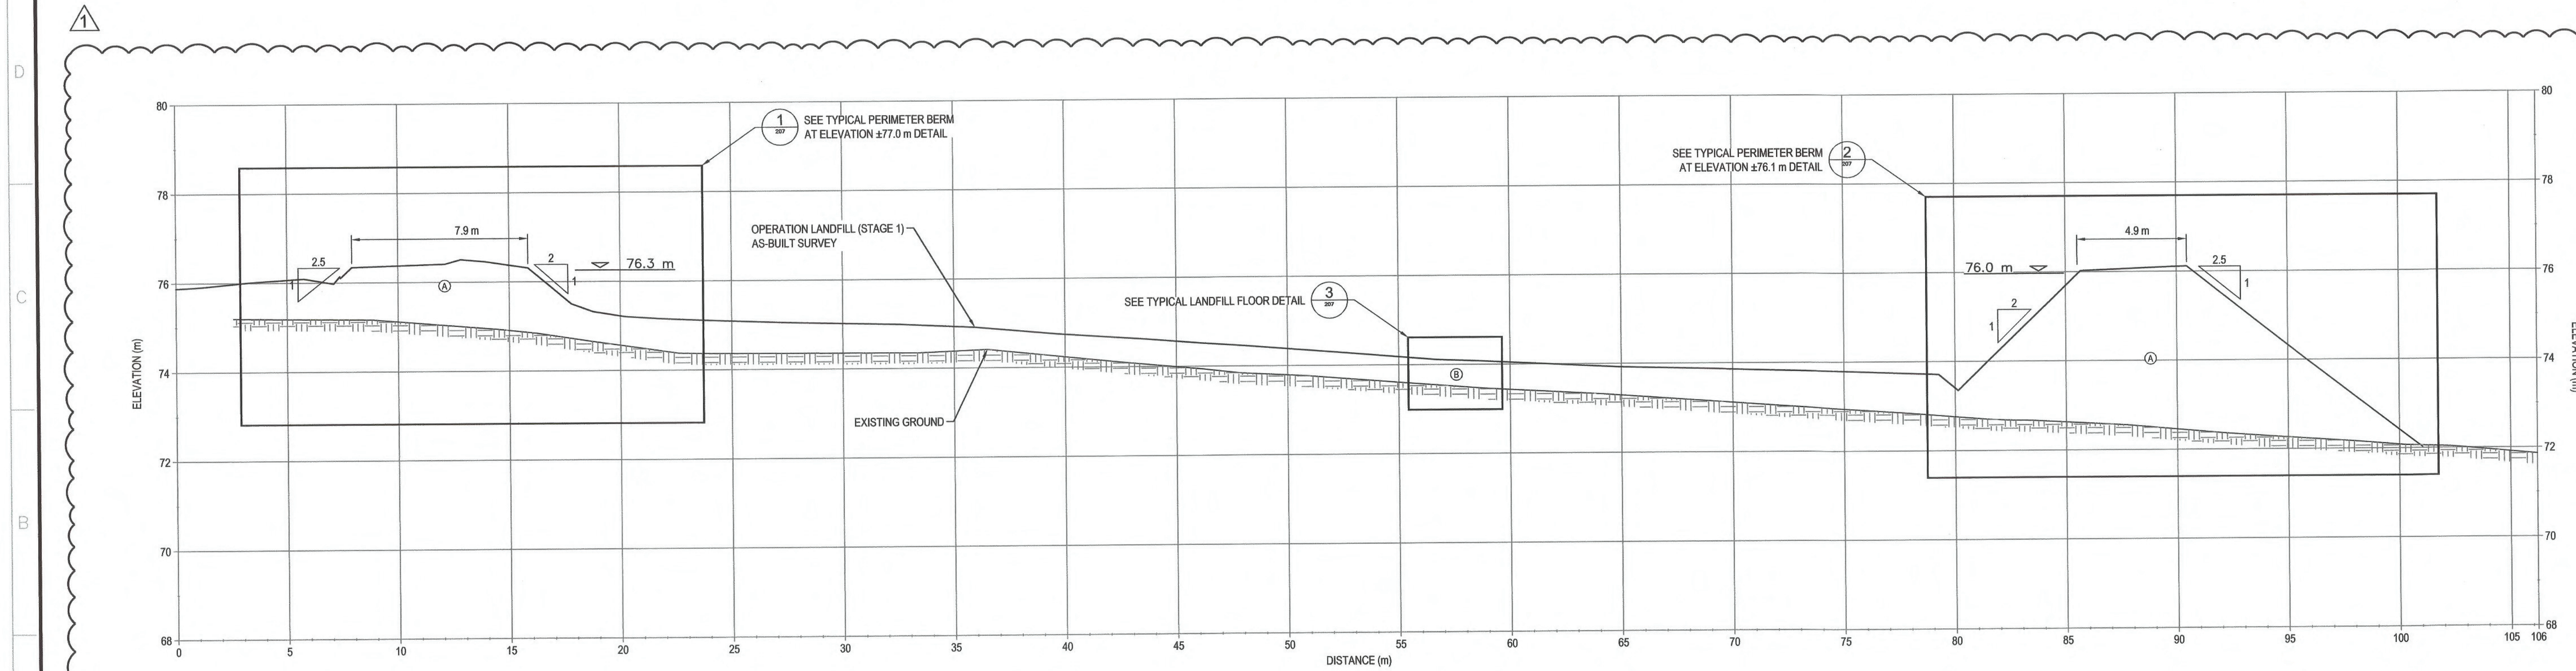

CROSS-SECTION B
SCALE: H-1:150 V-1:75

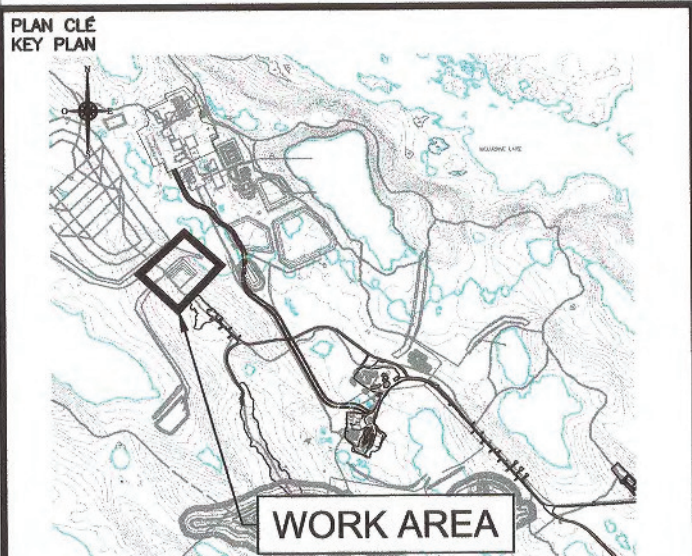

NOTES GÉNÉRALES / GENERAL NOTES

LEGEND

- (A) ESKER GRANULAR FILL (CL. A) (600mm MINUS)
- (B) GRANULAR FILL (50mm MINUS)

TEL QUE CONSTRUIT
AS BUILT

AGNICO EAGLE

DATE : 2017-12-01

UNCONSTRUCTED IS CONSIDERED FOR THE PURPOSE OF AS-BUILT SURVEY. THIS IS NOT THE SAME AS A CONSTRUCTION SURVEY. AVAILABLE DATA IS PROVIDED FOR CONSTRUCTION SURVEY. THIS INFORMATION IS NOT TO BE USED FOR ANY OTHER PURPOSE. THIS INFORMATION IS NOT TO BE USED FOR ANY OTHER PURPOSE. THIS INFORMATION IS NOT TO BE USED FOR ANY OTHER PURPOSE.

DESSINS EN RÉFÉRENCE / REFERENCE DRAWINGS	
TITRE / TITLE	# DWG



REV.	DATE	DESCRIPTION	PAR/APP.	CLIENT
1	2017-12-01	ISSUED AS-BUILT	CM	JA
0	2017-02-08	ISSUED FOR CONSTRUCTION	GZ	KJ
A	2017-01-23	ISSUED FOR REVIEW	GZ	KJ

PERMIT TO PRACTICE
TETRA TECH INDUSTRIES, INC.
O/A TETRA TECH

Signature: *[Signature]*

DATE: 2017-12-01

PERMIT NUMBER: P 1029

NTNU Association of Professional Engineers and Geoscientists

TITRE / TITLE

AGNICO EAGLE - MELJADINE DIVISION

697 - LANDFILL

230 - GENERAL EARTH WORKS

OPERATION LANDFILL (STAGE 1)

CROSS SECTIONS A-A AND B-B

DESSIN PAR DRAWN BY	EL	DATE 2017-01-23
VÉRIFIÉ PAR CHECKED BY	GZ	2017-01-23
APPROUVÉ PAR APPROVED BY	KJ	2017-01-23


ÉCHELLE
SCALE AS SHOWN

DATE 2017-01-23

NO. DESSIN
DRAWING NO. 65-697-230-205

NO. PROJET PROJECT NO.	REVISION	FEMILLE / SHT
6515 / 28920	1	1 / 1

1

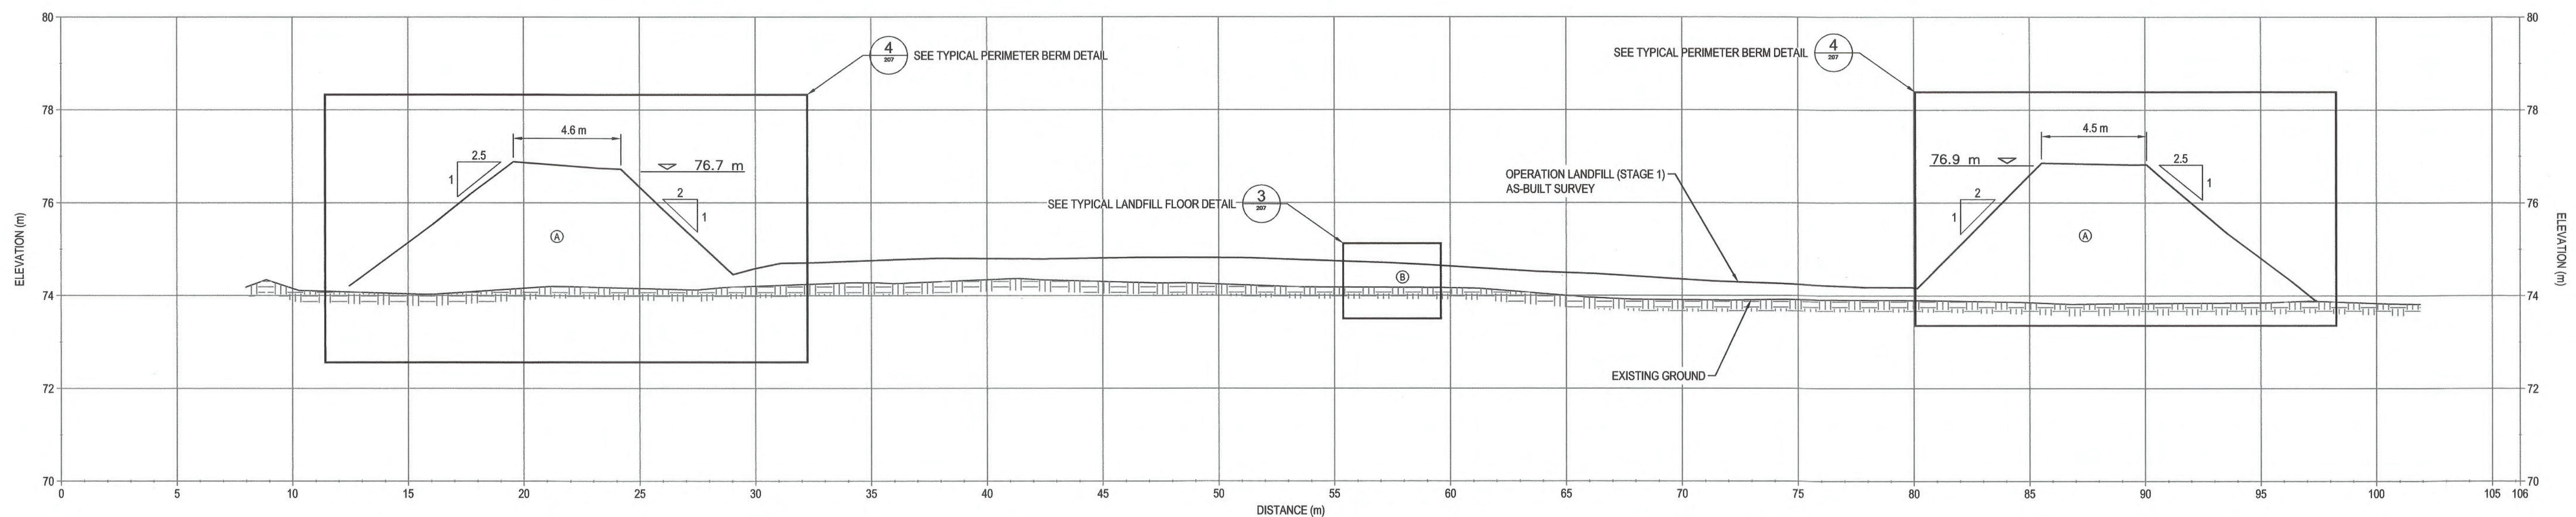


CROSS-SECTION


SCALE: H-1:150 V-1:75

C

204

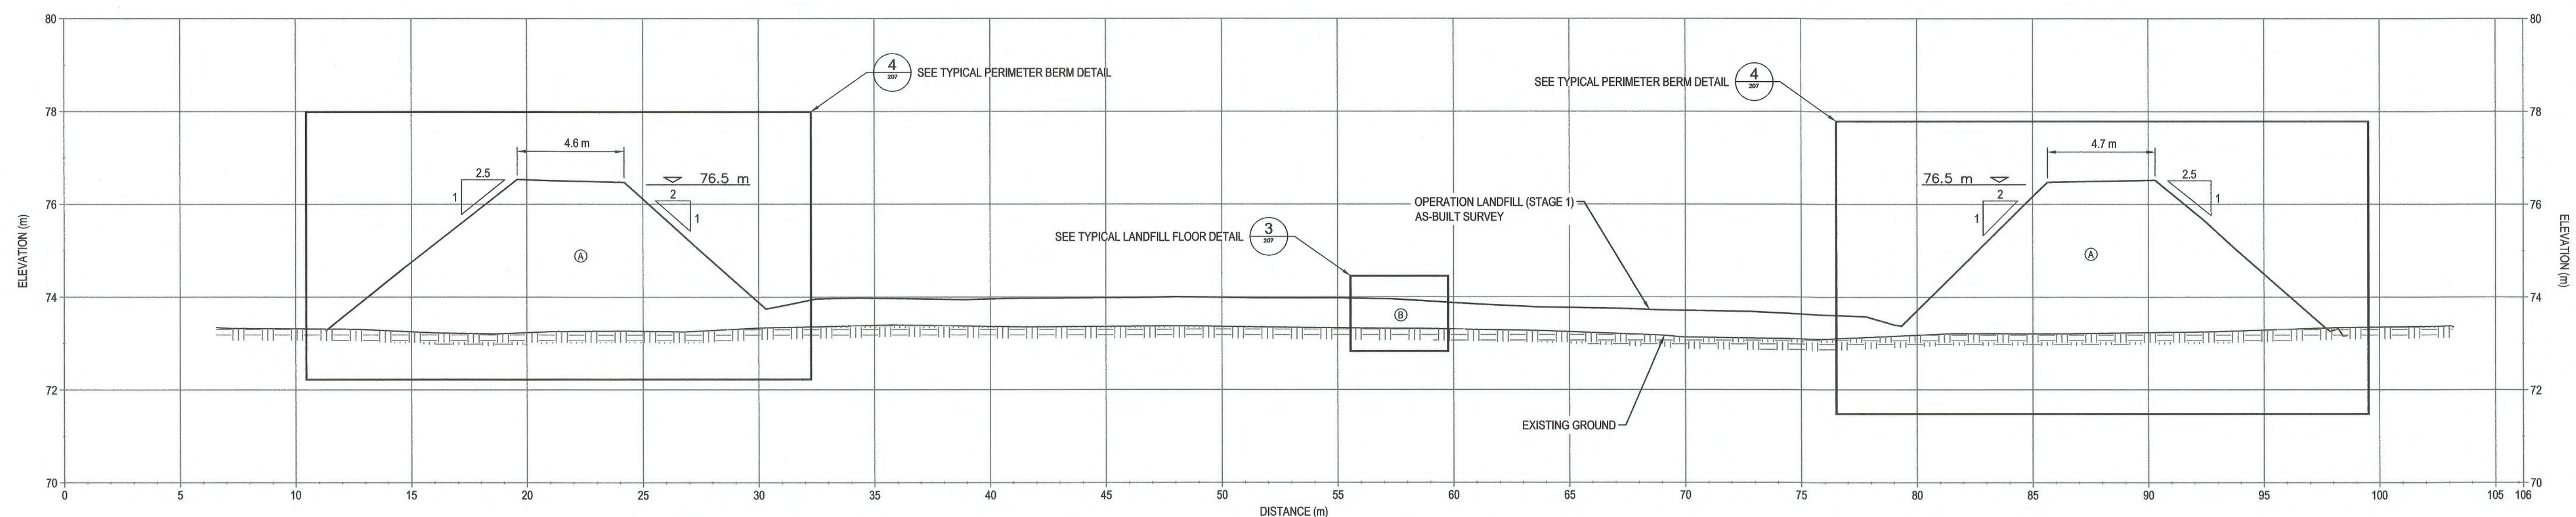

CROSS-SECTION D
SCALE: H-1:150 V-1:75 204

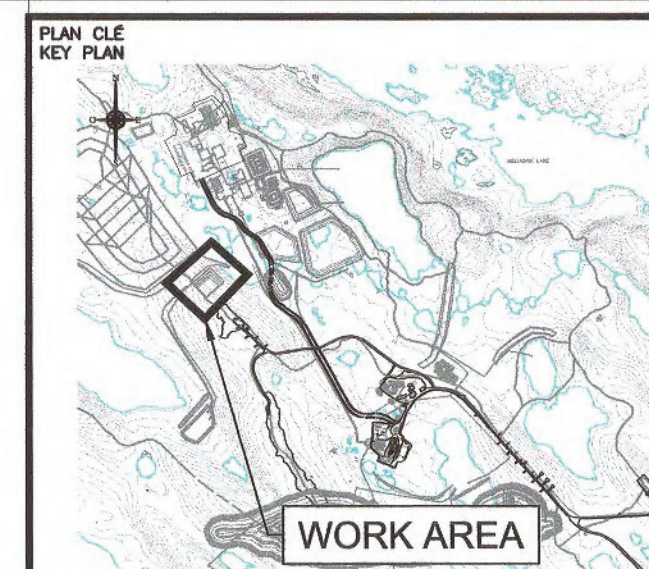

NOTES GÉNÉRALES / GENERAL NOTES

LEGEND

- ☐ (A) ESKER GRANULAR FILL (CL. A) (600mm MINUS)
☐ (B) GRANULAR FILL (50mm MINUS)

 $\triangle 1$

TEL QUE CONSTRUIT
AS BUILT



DATE : 2017-12-01

L'INFORMATION CI-DESSUS EST LA PROPRIÉTÉ DE AGENCO EAGLE LTD. ET DOIT ÊTRE RETENUE, SUR DEMANDE, SANS AUTORISATION PRÉALABLE, TOUTE TRANSMISSION DE COPIES À AUTRI ET TOUTE UTILISATION AUTRE QUE CELLE POUR LAQUELLE L'INFORMATION EST SOUS-SCRITE. © AGENCO EAGLE LTD.

THE INFORMATION HERE ON IS THE PROPERTY OF AGENCO EAGLE LTD. AND MUST BE RETURNED UPON REQUEST, WITHOUT WRITTEN PERMISSION, ANY COPYING, TRANSMISSION TO OTHERS AND ANY USE EXCEPT THAT FOR WHICH IT IS LOANED ARE PROHIBITED.
© AGENCO EAGLE LTD.

DESSINS EN RÉFÉRENCE / REFERENCE DRAWINGS

TITRE / TITLE	# DWG
---	---
---	---
AGNICO EAGLE

1	2017-12-01	ISSUED AS-BUILT	CM	JA	
0	2017-02-08	ISSUED FOR CONSTRUCTION	GZ	KJ	
A.	2017-01-23	ISSUED FOR REVIEW	GZ	KJ	
REV.	DATE	DESCRIPTION	PAR/BY	APP.	CL

REVISIONS


PERMIT TO PRACTICE
 TETRA TECH INDUSTRIES, INC.
 O/A TETRA TECH
 Signature: *B. Galy*
 Date: *2017-12-01*
 PERMIT NUMBER: P 1029
 NT/NU Association of Professional
 Engineers and Geoscientists

AGNICO EAGLE - MELIADINE DIVISION
697 - LANDFILL
230 - GENERAL EARTH WORKS
OPERATION LANDFILL (STAGE 1)
CROSS SECTIONS C-C AND D-D

DESSINÉ PAR DRAWN BY	EL	DATE 2017-0
VÉRIFIÉ PAR CHECKED BY	GZ	2017-0
APPROUVÉ PAR APPROVED BY	KJ	2017-0

NO. DESSIN
DRAWING NO. 65-697-230-206

NO. PROJ PROJECT NO.	REVISION	FEUILLE /
	1	1 /

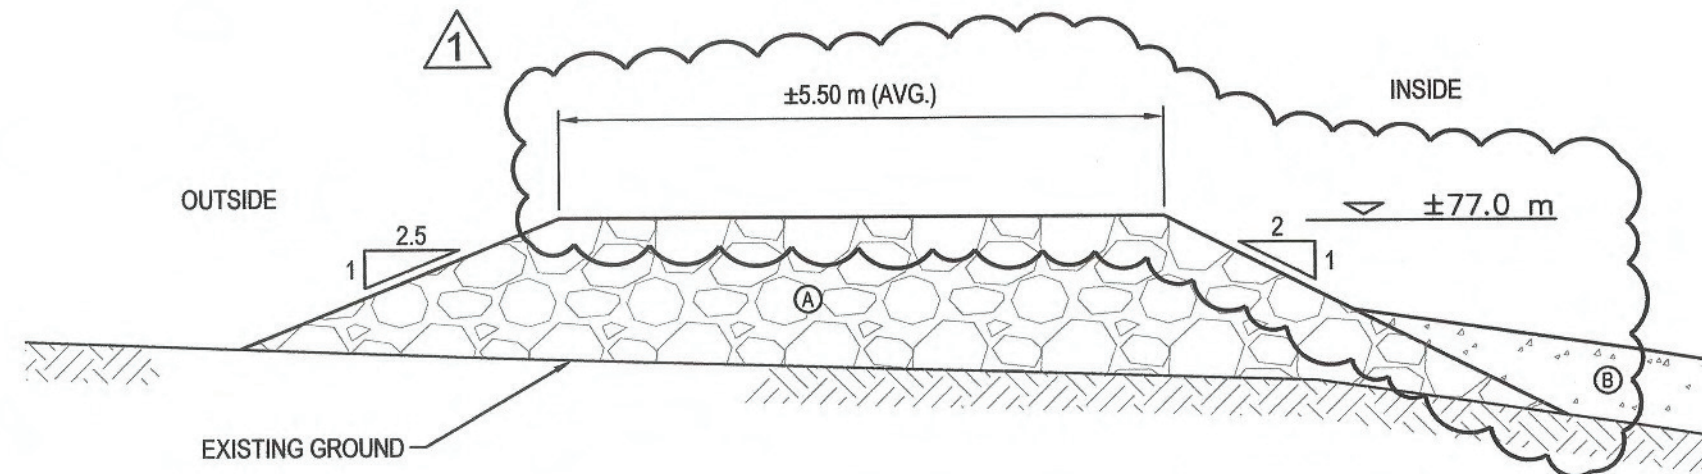


TYPICAL PERIMETER BERM AT ELEVATION ±77.0 m
NTS

ESTIMATED IN-PLACE MATERIAL
QUANTITIES FOR CONSTRUCTION OF
OPERATION LANDFILL STAGE 1

ITEM	UNIT	ESTIMATED IN-PLACE QUANTITY
① ESKER GRANULAR FILL (600mm MINUS)	m³	9,750
② GRANULAR FILL (50mm MINUS)	m³	1,649

IT SHOULD BE NOTED THAT THE ACTUAL QUANTITIES COULD BE DIFFERENT FROM THE ESTIMATED DUE TO THE FOLLOWING REASONS:

- ORIGINAL GROUND CONDITIONS / ELEVATIONS MAY BE DIFFERENT FROM THE TOPOGRAPHIC DATA USED FOR THE DESIGN.
- THE FIELD OBSERVATIONS DURING CONSTRUCTION MAY LEAD TO DESIGN AND CONSTRUCTION RELATED MODIFICATIONS, WHICH MAY IN TURN AFFECT THE QUANTITIES.
- THE ORIGINAL GROUND MAY SETTLE DURING CONSTRUCTION.

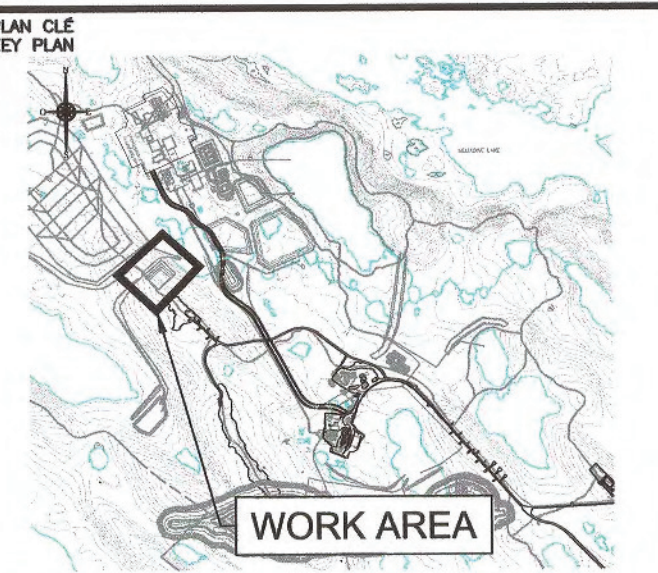

NOTES GÉNÉRALES / GENERAL NOTES

LEGEND

- ① ESKER GRANULAR FILL (CL. A) (600mm MINUS)
- ② GRANULAR FILL (50mm MINUS)



L'INFORMATION CI-CONTENUE EST LA PROPRIÉTÉ DE L'AGNICO EAGLE. L'USAGE DE CETTE INFORMATION EST INTERDIT SANS LAutorisation écrite d'AGNICO EAGLE. Toute réimpression ou utilisation non autorisée sans la permission écrite d'AGNICO EAGLE est considérée comme une violation de la loi sur le droit d'auteur. L'information est fournie en français et en anglais.

DESSINS EN RÉFÉRENCE / REFERENCE DRAWINGS

TITLE / TITRE	# DWG



AGNICO EAGLE

REV.	DATE	DESCRIPTION	PAR/APP.	CLIENT
1	2017-12-01	ISSUED AS-BUILT	CM	JA
0	2017-02-08	ISSUED FOR CONSTRUCTION	GZ	KJ
A	2017-01-23	ISSUED FOR REVIEW	GZ	KJ

REVISIONS

PERMIT TO PRACTICE
TETRA TECH INDUSTRIES, INC.
O/A TETRA TECH

Signature: *[Signature]*
Date: 2017-12-01

PERMIT NUMBER: P 1029
NTNU Association of Professional
Engineers and Geoscientists

DATE: 2017-12-01


TITLE / TITRE
AGNICO EAGLE - MELIADINE DIVISION
697 - LANDFILL
230 - GENERAL EARTH WORKS
OPERATION LANDFILL (STAGE 1)
TYPICAL DETAILS AND MATERIAL QUANTITIES

DESSINÉ PAR DRAWN BY	EL	DATE	2017-01-23
VÉRIFIÉ PAR CHECKED BY	GZ	DATE	2017-01-23
APPROUVÉ PAR APPROVED BY	KJ	DATE	2017-01-23


ÉCHELLE
SCALE AS SHOWN

NO. DESSIN
DRAWING NO. 65-697-230-207


NO. PROJET PROJECT NO.	REVISION	FEUILLE / SHEET
6515 / 28920	1	1 / 1

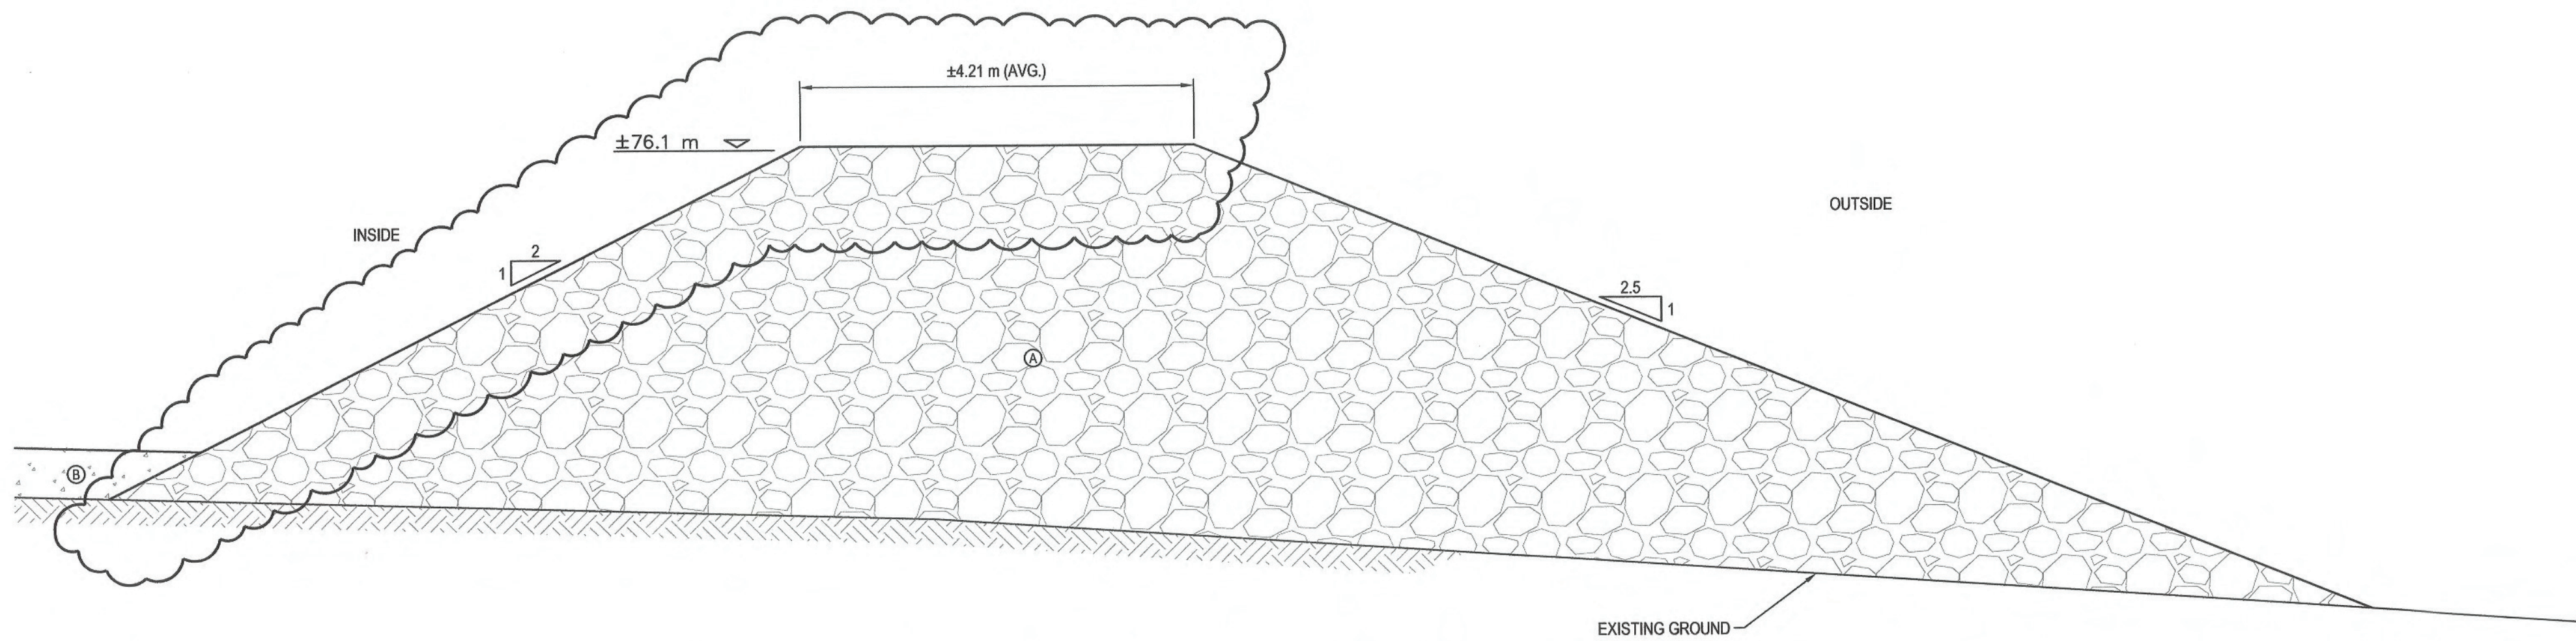



TYPICAL PERIMETER BERM AT ELEVATION ±76.1 m
NTS

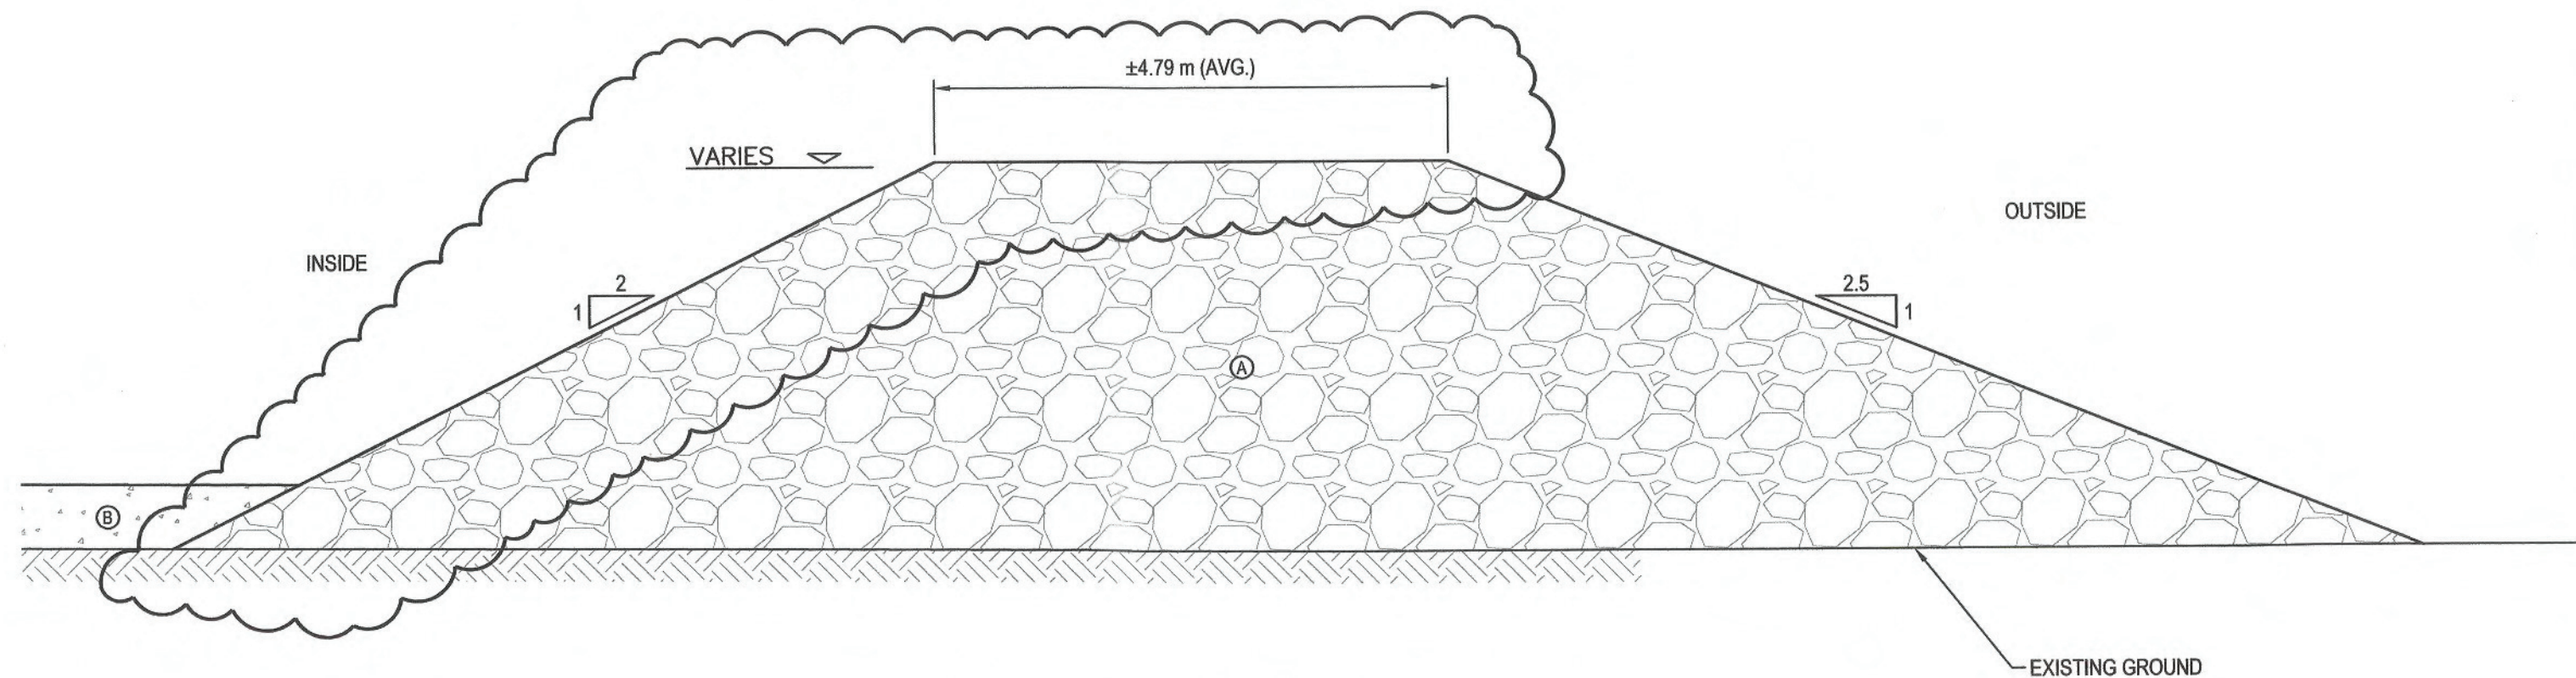

TYPICAL PERIMETER BERM
NTS

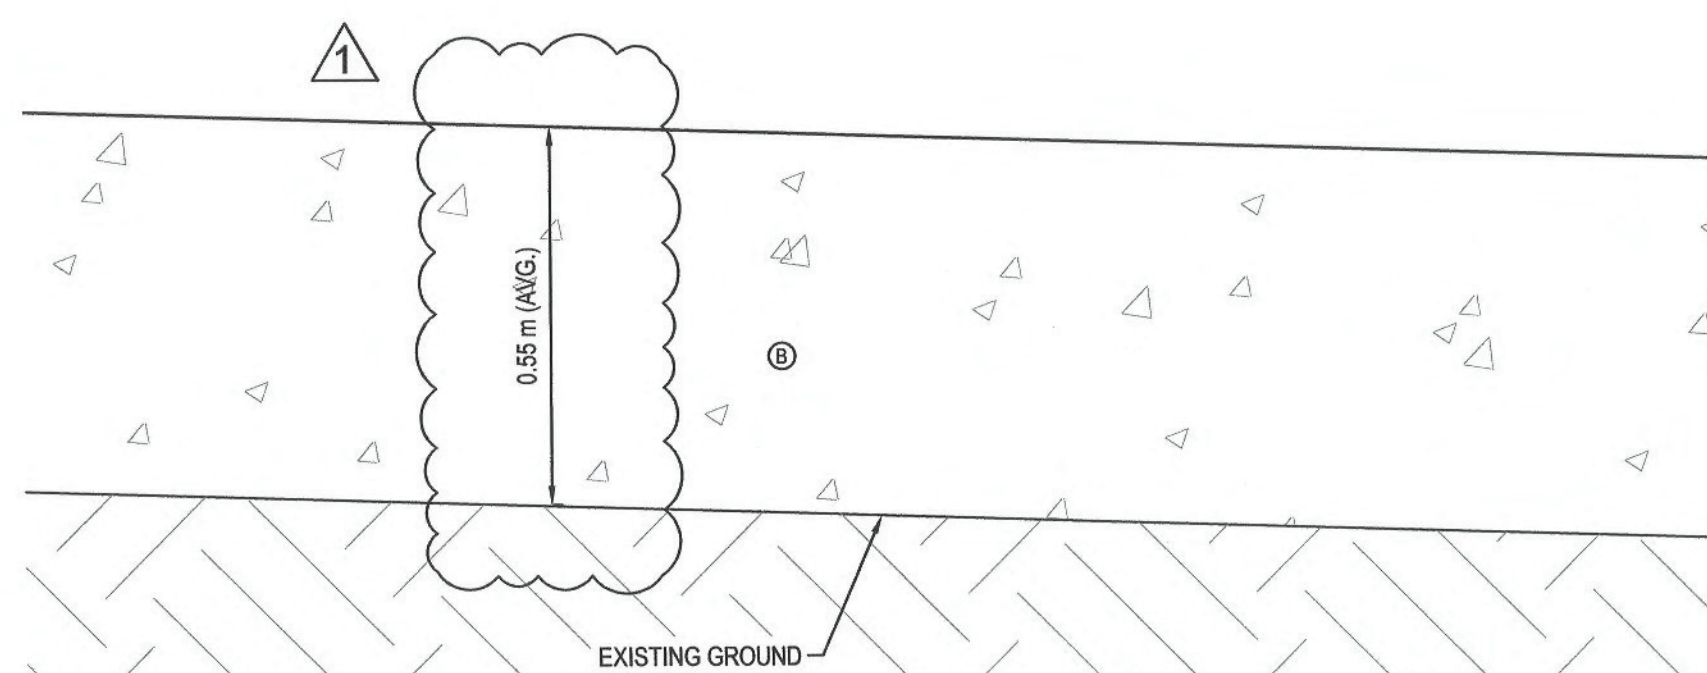

TYPICAL LANDFILL FLOOR
NTS

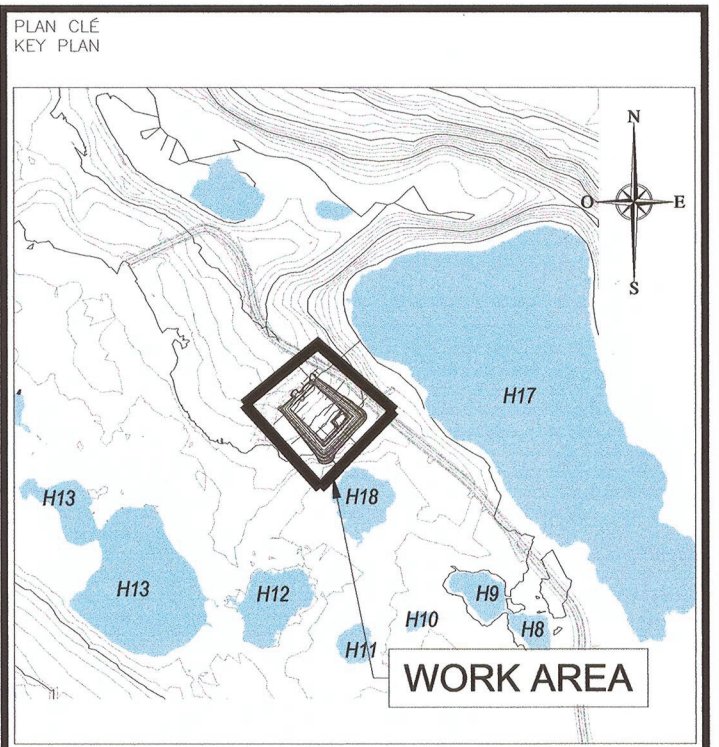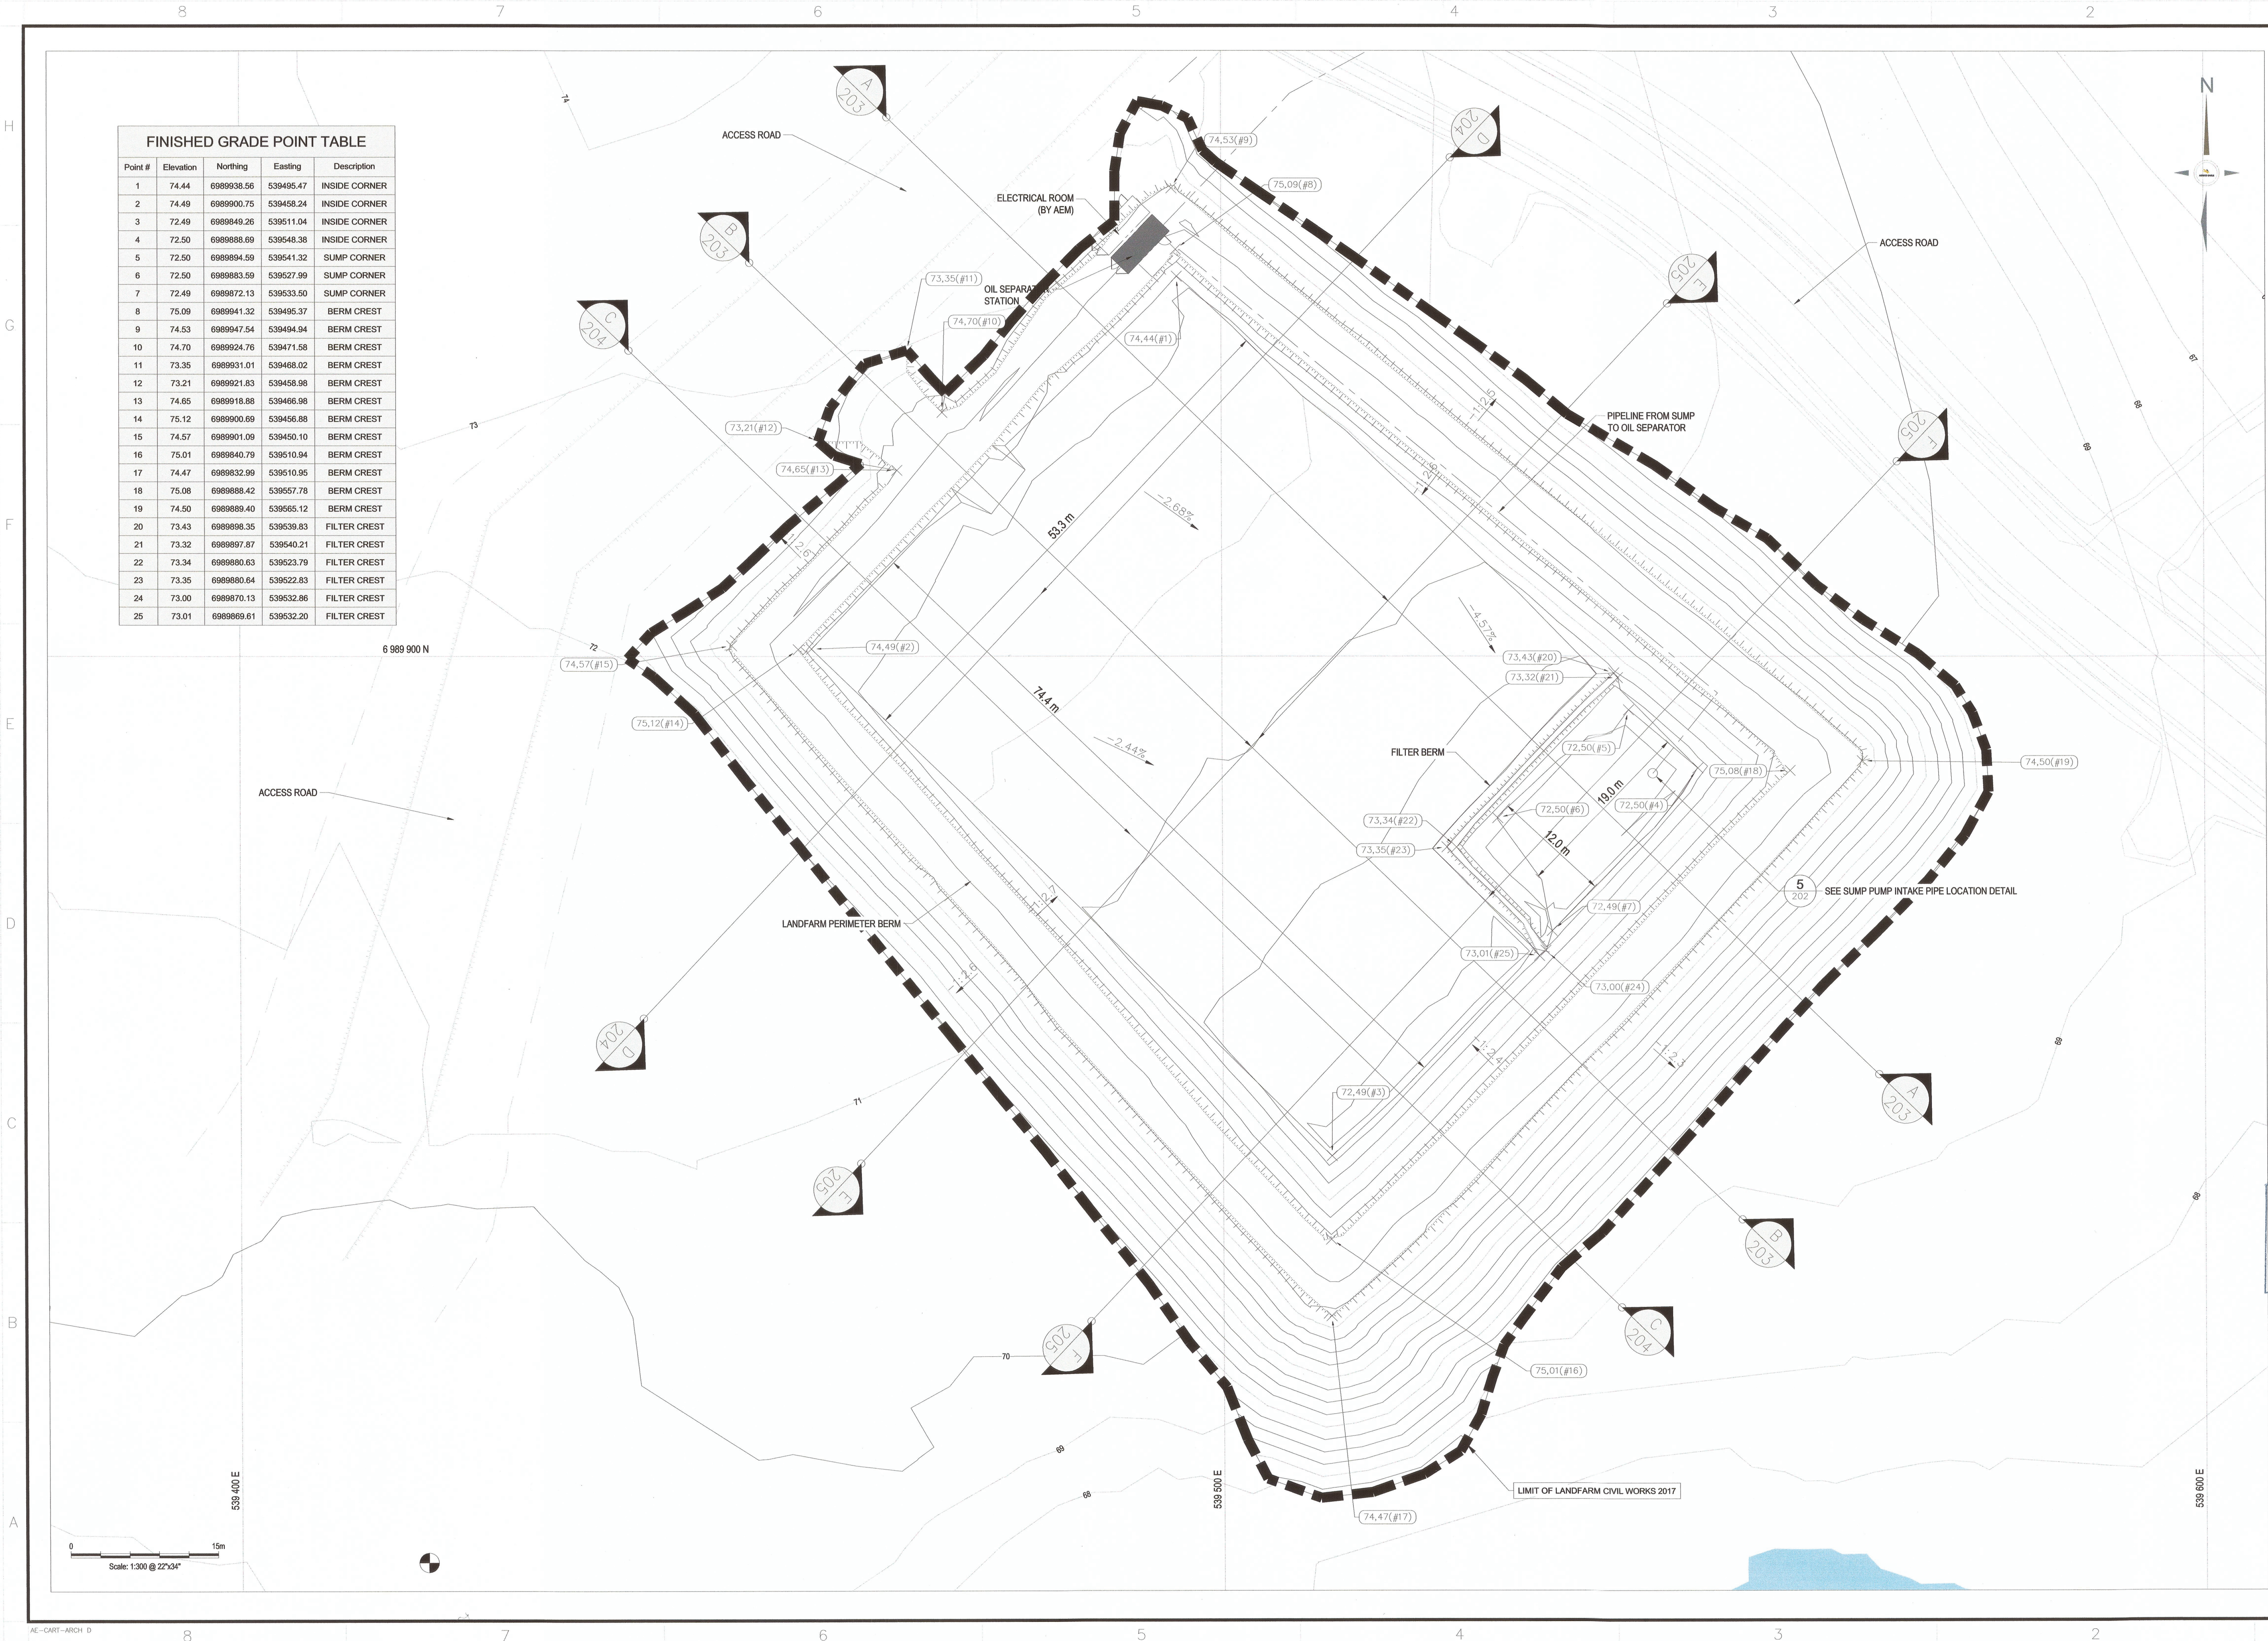

NOTES GÉNÉRALES / GENERAL NOTES

TEL QUE CONSTRUIT
AS BUILT

AGNICO EAGLE

DATE : 2018-02-02

INFORMATION CONTAINED HEREIN IS THE PROPERTY OF AGNICO EAGLE LTD. AND MUST BE RETURNED UPON REQUEST. NO COPY SHALL BE MADE OR TRANSMITTED TO OTHERS AND ANY USE WITHOUT THE WRITTEN PERMISSION OF AGNICO EAGLE LTD. IS PROHIBITED.

DESSINS EN RÉFÉRENCE / REFERENCE DRAWINGS

TITRE / TITLE	# DWG.



REV.	DATE	DESCRIPTION	PAR/APP.	CLIENT
2	2018-02-02	ISSUED AS-BUILT - GENERAL REVISION	CM	JA
1	2017-06-01	RE-ISSUED FOR CONSTRUCTION	EL	GZ
0	2017-02-08	ISSUED FOR CONSTRUCTION	EP	GZ
A	2017-01-16	ISSUED FOR REVIEW	EP	GZ

PERMIT TO PRACTICE
TERRA TECH INDUSTRIES, INC.
O/A T&A TECH

Signature: *[Signature]*
Date: 2018-02-01

PERMIT NUMBER: P 1029

N/AU Association of Professional Engineers and Geoscientists

AGNICO EAGLE MELIADINE GOLD PROJECT

LANDFARM LAYOUT PLAN

DESSIN PAR DRAWN BY	EP	DATE 2017-01-16
VERIFIÉ PAR CHECKED BY	GZ	2017-01-16
APPROUVÉ PAR APPROVED BY		
ECHELLE SCALE	1:300	DATE 2017-01-16
NO. DESSIN DRAWING NO.	65-696-230-201	
NO. PROJET PROJECT NO.	6515	REVISION 2
		FEUILLE / SHEET 2 / 6

H

G

F

E

D

C

B

A

H

G

F



E

D


C

B

A

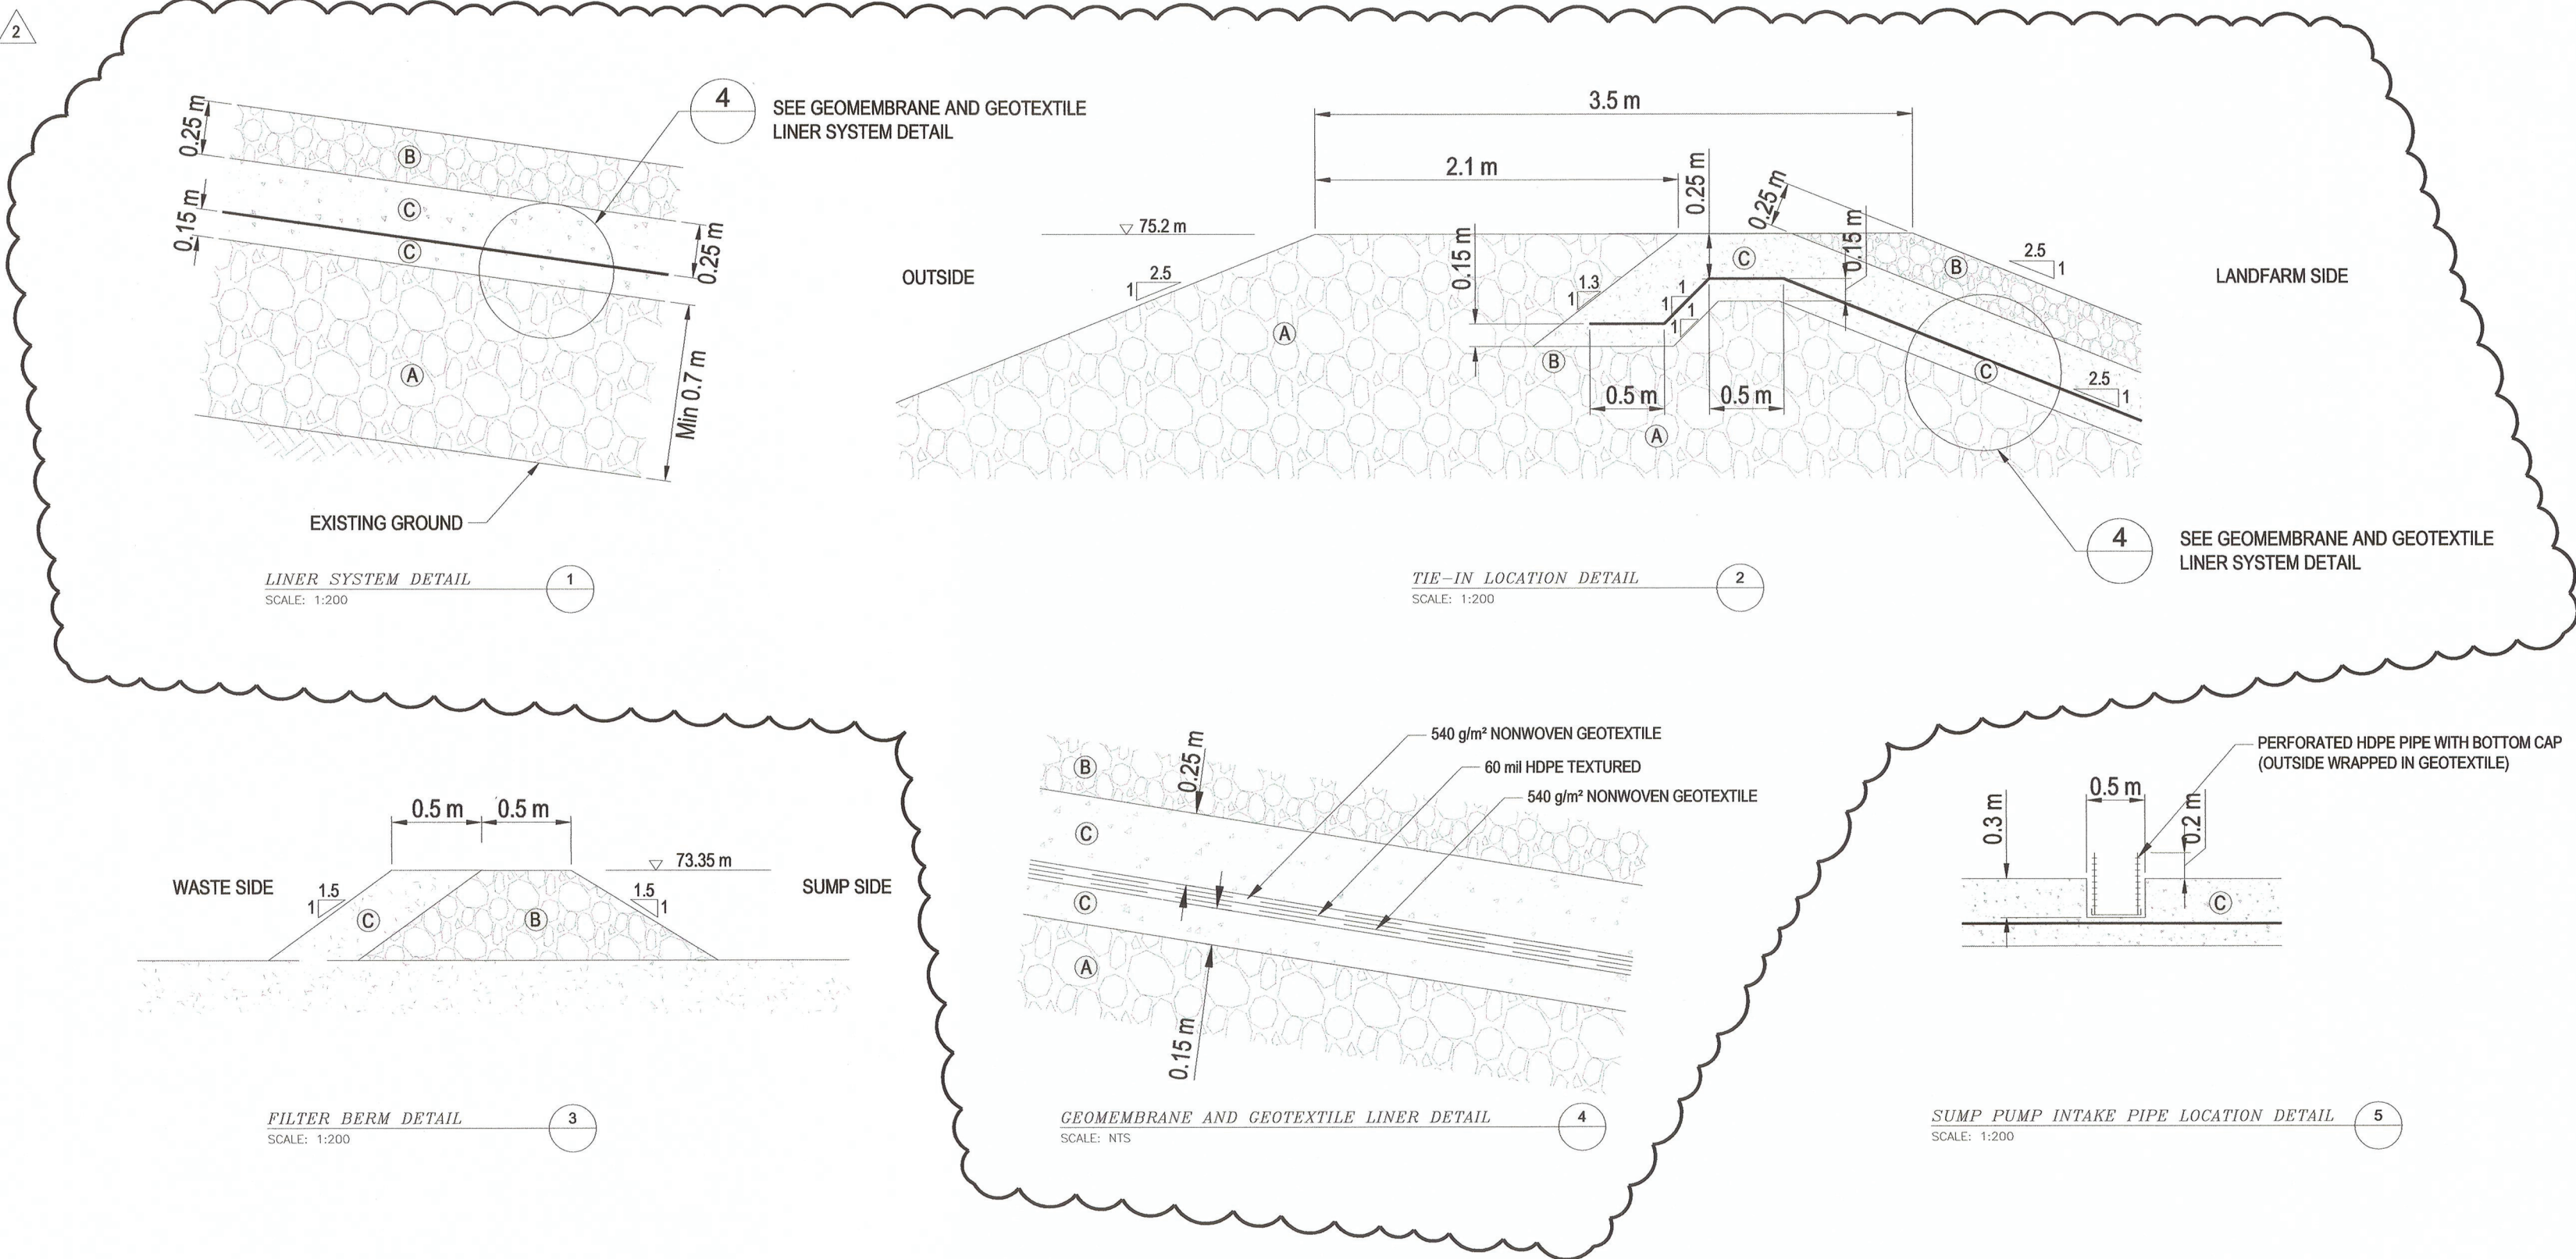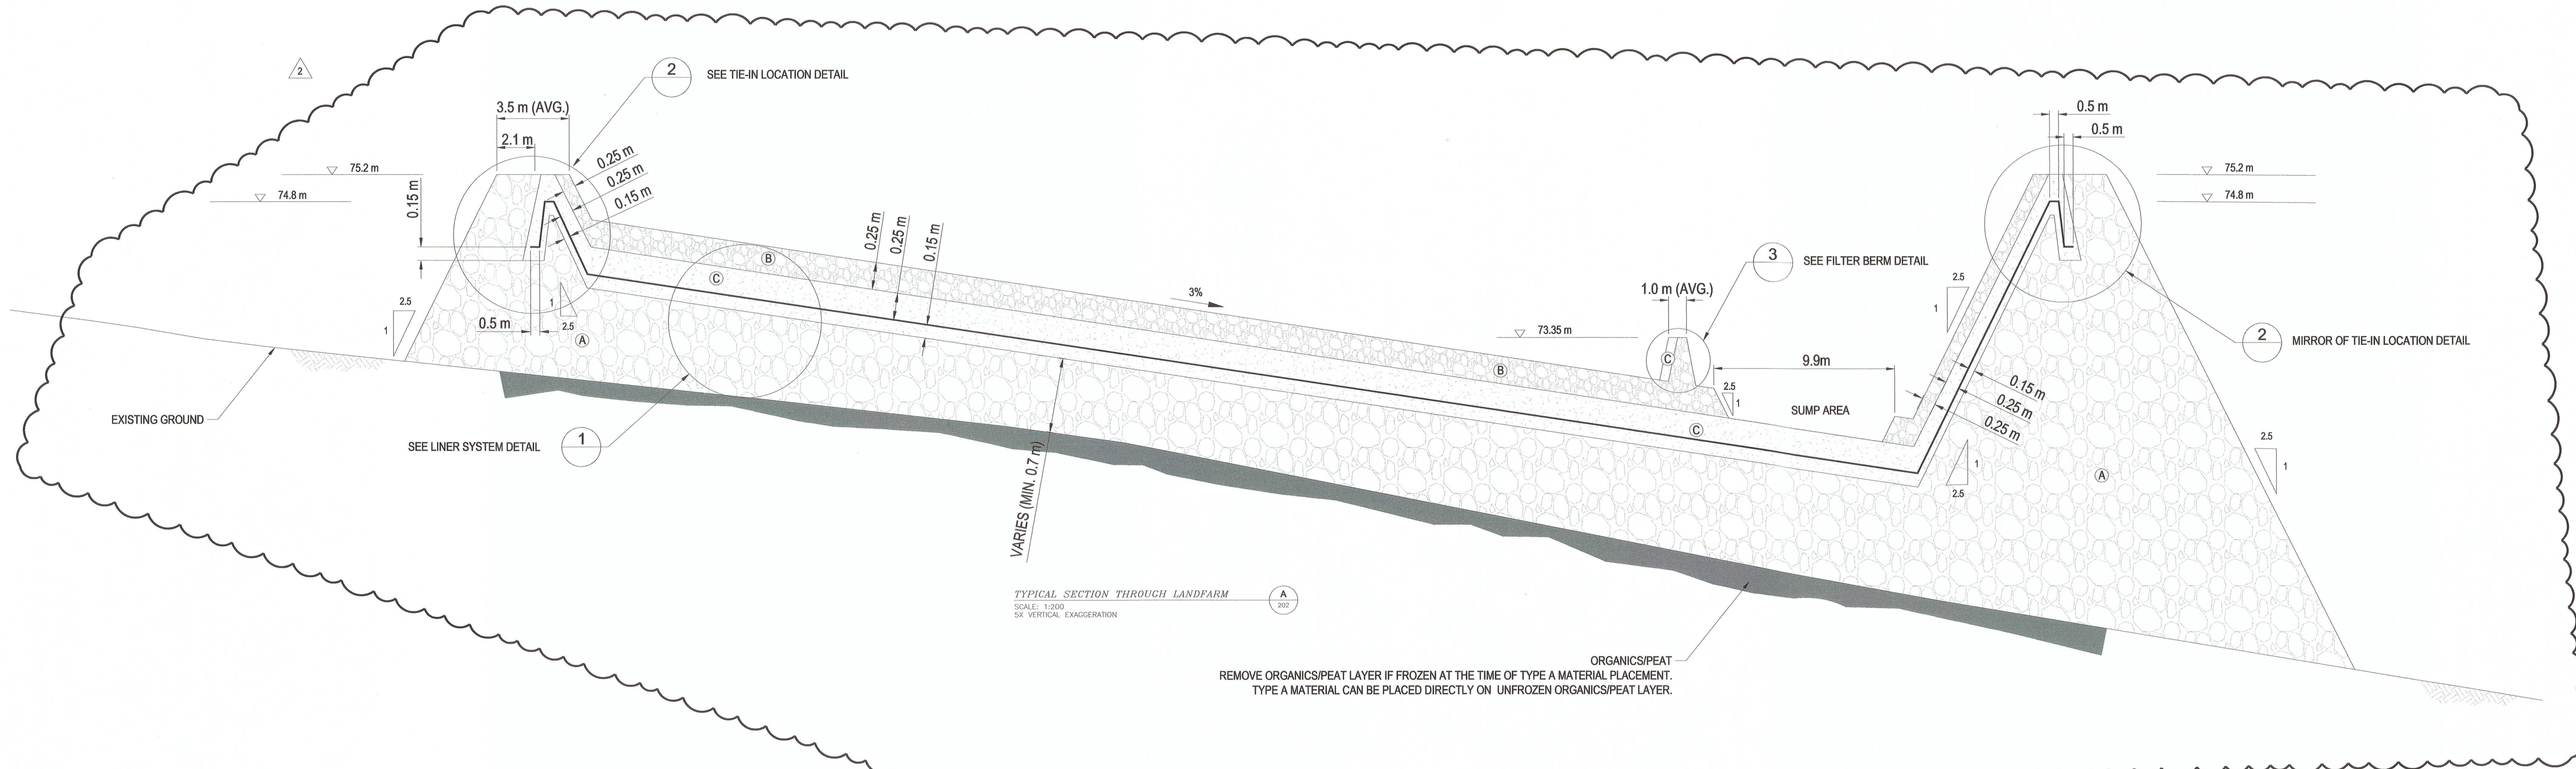

QUANTITIES CONSTRUCTION CHART		
LANDFARM		
	MATERIAL	QUANTITIES
A	600mm MINUS CL. A Esker Material	18 193 m ³
B	Transition Rockfill (200mm MINUS)	1 491 m ³
C	Granular Fill (30mm MINUS)	2 759 m ³
	HDPE Geomembrane	6 131 m ²
	Non-woven Geotextile	12 262 m ²

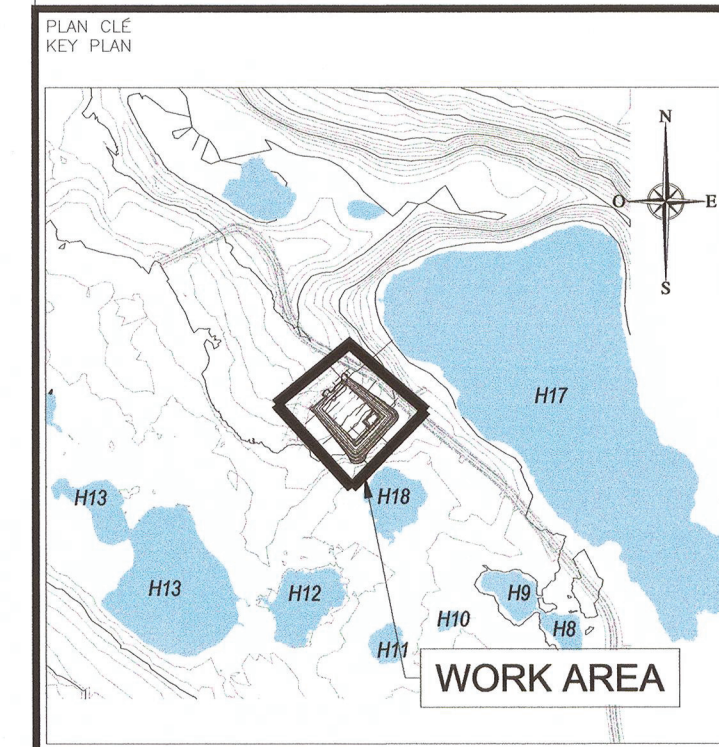

NOTES GÉNÉRALES / GENERAL NOTES

- (A) ESKER CL. A MATERIAL (600 mm MINUS)
(B) TRANSITION ROCKFILL (200 mm MINUS)
(C) GRANULAR FILL (30 mm MINUS)

TEL QUE CONSTRUIT
AS BUILT
AGNICO EAGLE
DATE : 2018-02-02

L'INFORMATION DE CONSTRUCTION EST LA PROPRIÉTÉ DE AGNICO EAGLE LTD. ET DOIT ÊTRE RETENUE
SANS DEMANDE, SANS AUTORISATION ÉCRITE PRÉALABLE, TOUTE TRANSMISSION DE COPIES À AUTRUI
EST INTERDITE. L'INFORMATION AUTRUI QUE CELLE POUR LAQUELLE L'INFORMATION EST PRÉPARÉE
EST INTERDITE.
© AGNICO EAGLE LTD.
THE INFORMATION HERE ON IS THE PROPERTY OF AGNICO EAGLE LTD. AND MUST BE RETURNED UPON
REQUEST, WITHOUT WRITTEN PERMISSION, ANY COPYING, TRANSMISSION, TO OTHERS AND ANY USE
EXCEPT THAT FOR WHICH IT IS LOANED ARE PROHIBITED.
© AGNICO EAGLE LTD.

DESSINS EN RÉFÉRENCE / REFERENCE DRAWINGS

TITRE / TITLE	# DWG



REV.	DATE	DESCRIPTION	PAS/BY	APP.	CLIENT
2	2018-02-02	ISSUED AS-BUILT	CM	JA	
1	2017-06-01	RE-ISSUED FOR CONSTRUCTION	EL	GZ	
0	2017-02-08	ISSUED FOR CONSTRUCTION	EP	GZ	
A	2017-01-16	ISSUED FOR REVIEW	EP	GZ	


PERMIT TO PRACTICE
TETRA TECH INDUSTRIES, INC.
O/A TETRA TECH
Signature: [Signature]
Date: 2018-02-01
PERMIT NUMBER: P 1029
NTNU Association of Professional
Engineers and Geoscientists

AGNICO EAGLE MELIADINE GOLD PROJECT
LANDFARM
TYPICAL DESIGN SECTION, DETAILS, AND QUANTITIES

DESSINÉ PAR DRAWN BY	EP	DATE 2017-01-16
VÉRIFIÉ PAR CHECKED BY	GZ	2017-01-16
APPROUVÉ PAR APPROVED BY		

ECHELLE
SCALE 1:200
DATE 2017-01-16
NO. DESSIN
DRAWING NO. 65-696-230-202

NO. PROJET PROJECT NO.	REVISION	FEUILLE / SHEET
6515	2	3 / 6

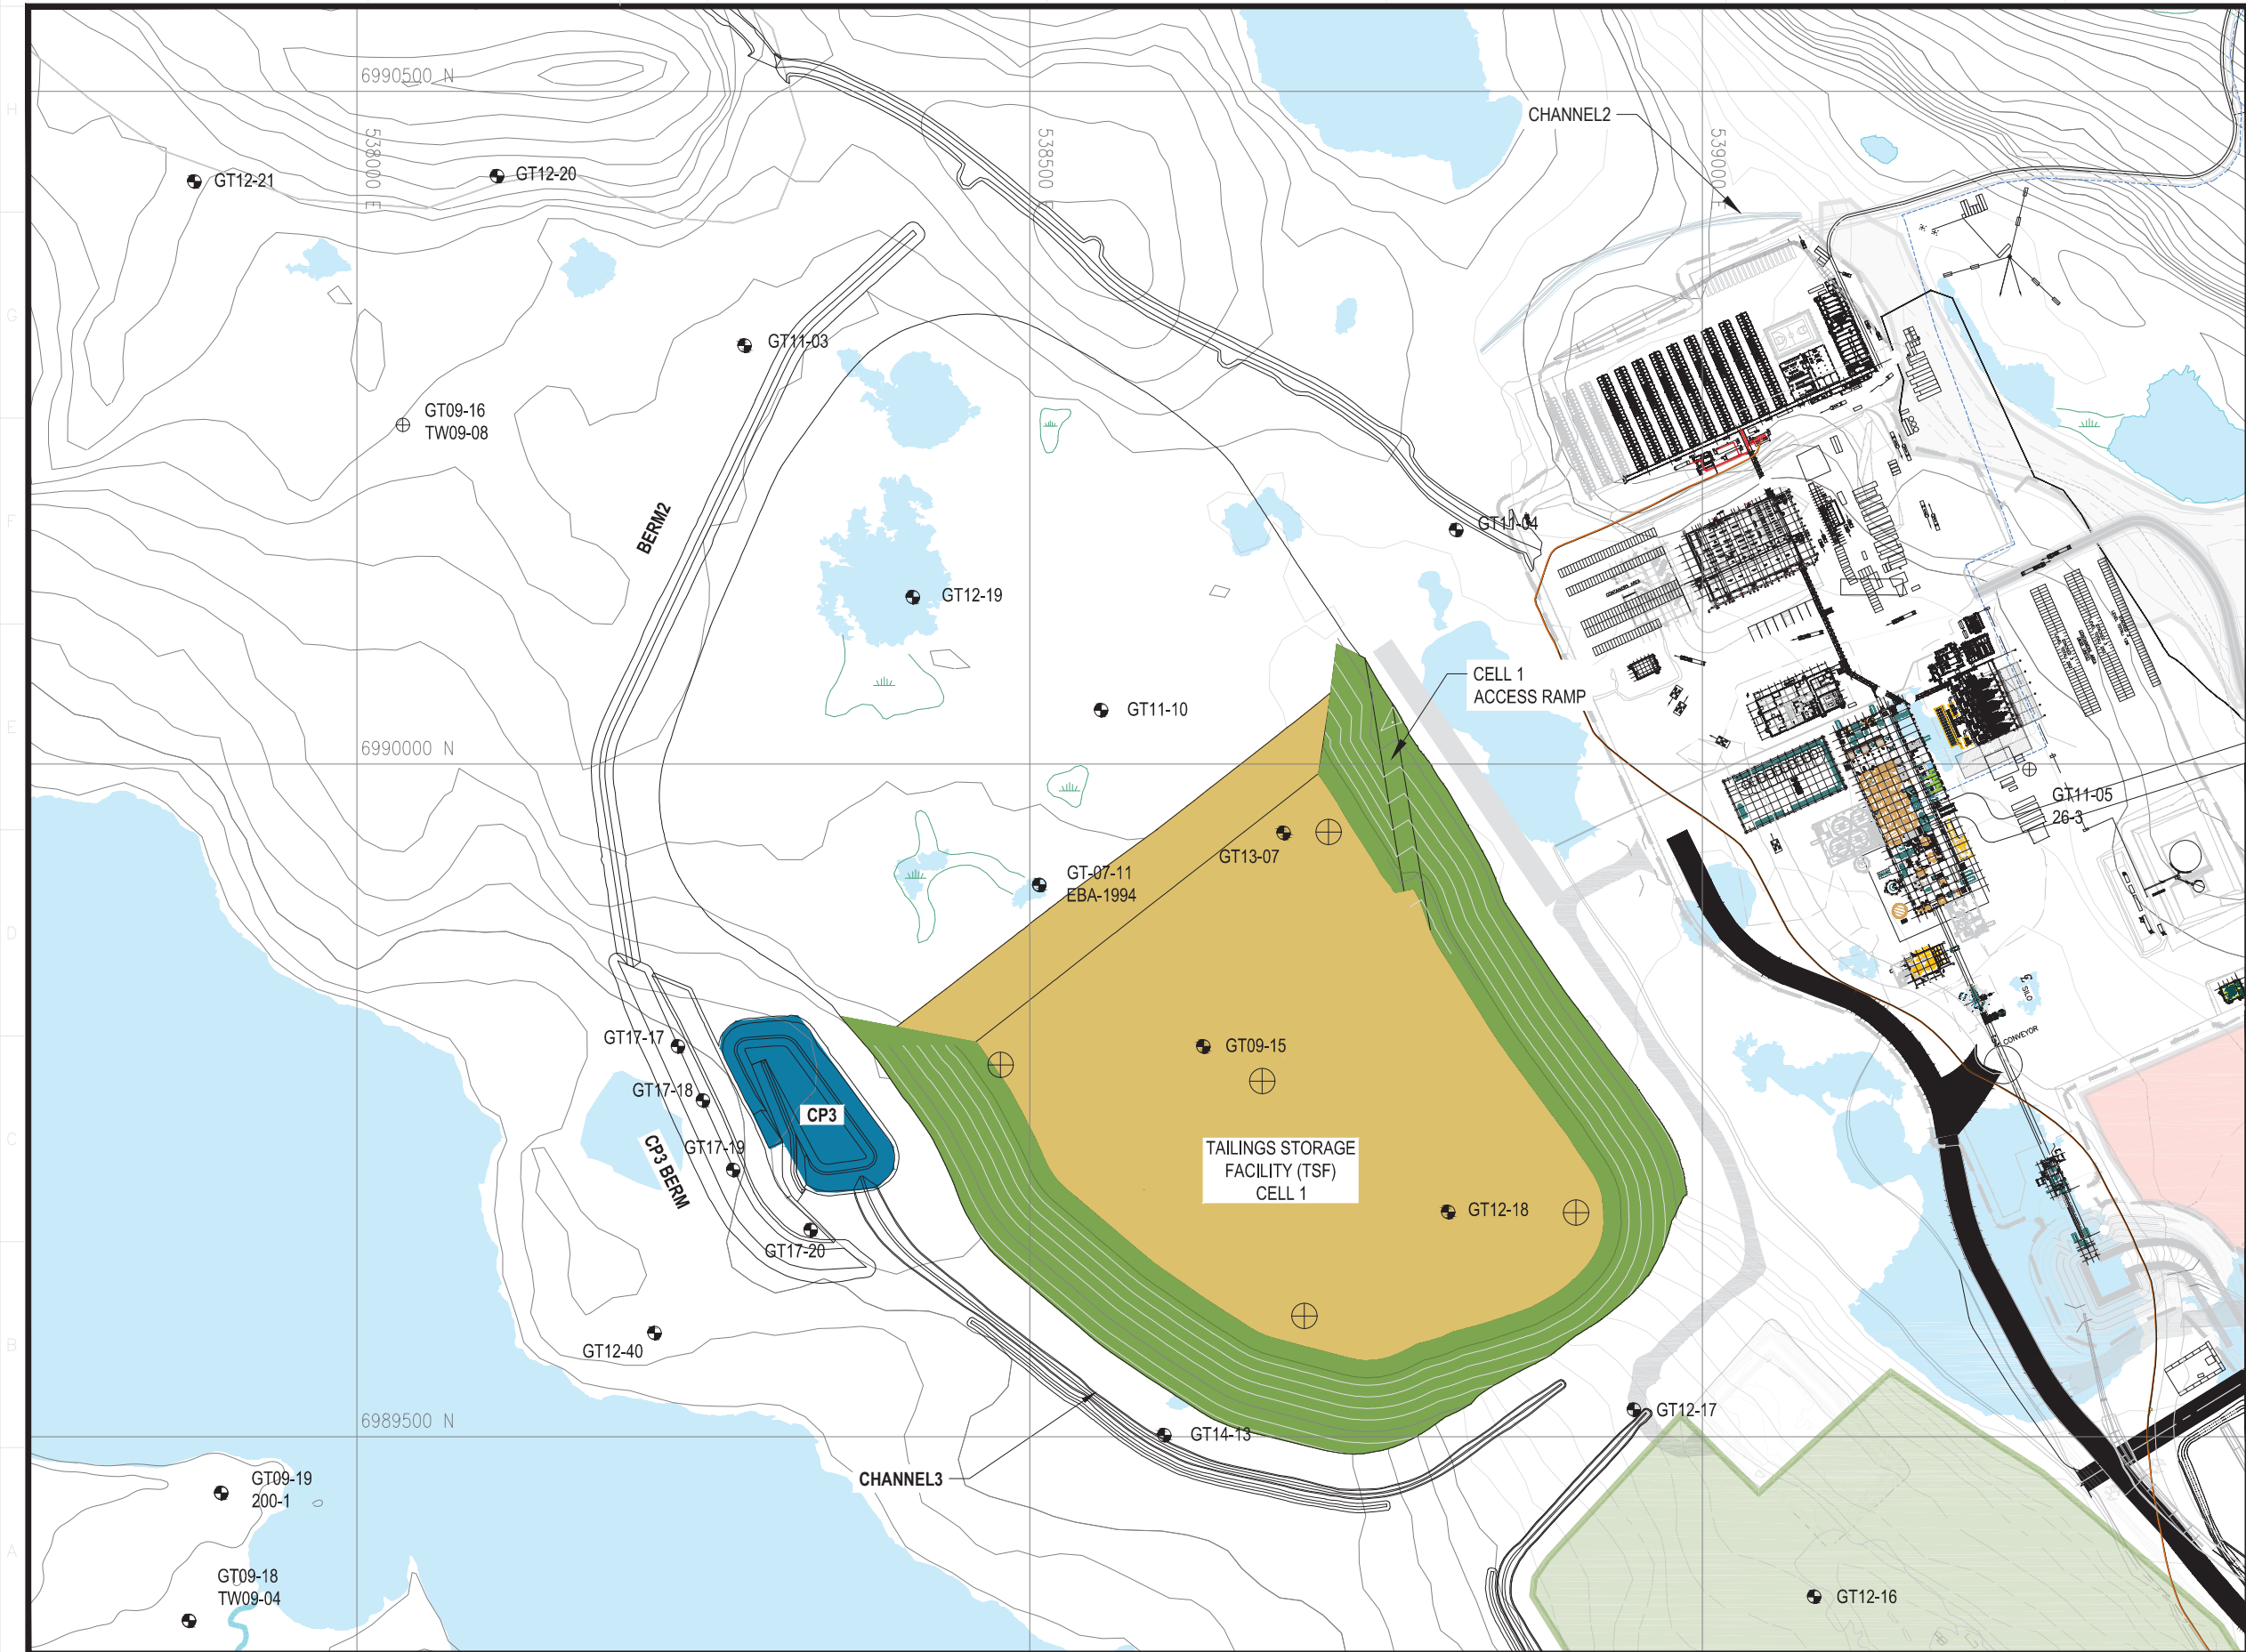

LEGEND

- WASTE ROCK
- ORE
- TAILINGS
- WATER COLLECTION POND
- BOREHOLE
- PROPOSED GROUND TEMPERATURE CABLE LOCATION

PERMIT TO PRACTICE
TETRA TECH CANADA INC.
Signature: [Signature]
Date: Nov 14, 2018
PERMIT NUMBER: P 018
NT/NU Association of Professional Engineers and Geoscientists

PROFESSIONAL ENGINEER
G. ZHANG
Licence No. 146 288
NWTNU

AGNICO EAGLE

TETRA TECH

POUR CONSTRUCTION
DATE: 11/14/2018

L'INFORMATION CI-CONTENUE EST LA PROPRIÉTÉ D'AGNICO EAGLE LTD. ET DOIT ÊTRE RETENUE SANS DOMMAGE, SANS AUTORISATION ÉCRITE PRÉALABLE. TOUTE TRANSMISSION DE COPIES À AUTRI ET TOUTE UTILISATION AUTRE QUE CELLE POUR LAQUELLE L'INFORMATION EST PRÉPARÉE SONT INTERDITES.
© AGNICO EAGLE LTD.

THE INFORMATION HEREON IS THE PROPERTY OF AGNICO EAGLE LTD. AND MUST BE RETURNED UPON REQUEST. REPRODUCING, DISTRIBUTION, OR ANY OTHER TRANSMISSION TO OTHERS AND ANY USE EXCEPT THAT FOR WHICH IT IS LOANED ARE PROHIBITED.
© AGNICO EAGLE LTD.

REV	DESCRIPTION	DATE	PAR BY
0	ISSUED FOR CONSTRUCTION	2018-11-14	
B	ISSUED FOR REVIEW	2018-11-06	
A	ISSUED FOR REVIEW	2018-11-05	

REVISIONS

DESSINÉ PAR DRAWN BY	EL/EP	DATE	2018-11-14
VÉRIFIÉ PAR CHECKED BY	GZ/WT		2018-11-14
APPROUVÉ PAR APPROVED BY			

No. PROJET
PROJECT NO.


DATE

TITRE / TITLE
MELIADINE TAILINGS STORAGE FACILITY DESIGN

YEAR 2

ECHELLE/ SCALE	FICHIER FILE	REVISION	FEUILLE/SHT
No. DESSIN/ DRAWING NO.	.DWG	0	2 / 8

6515-583-163-002

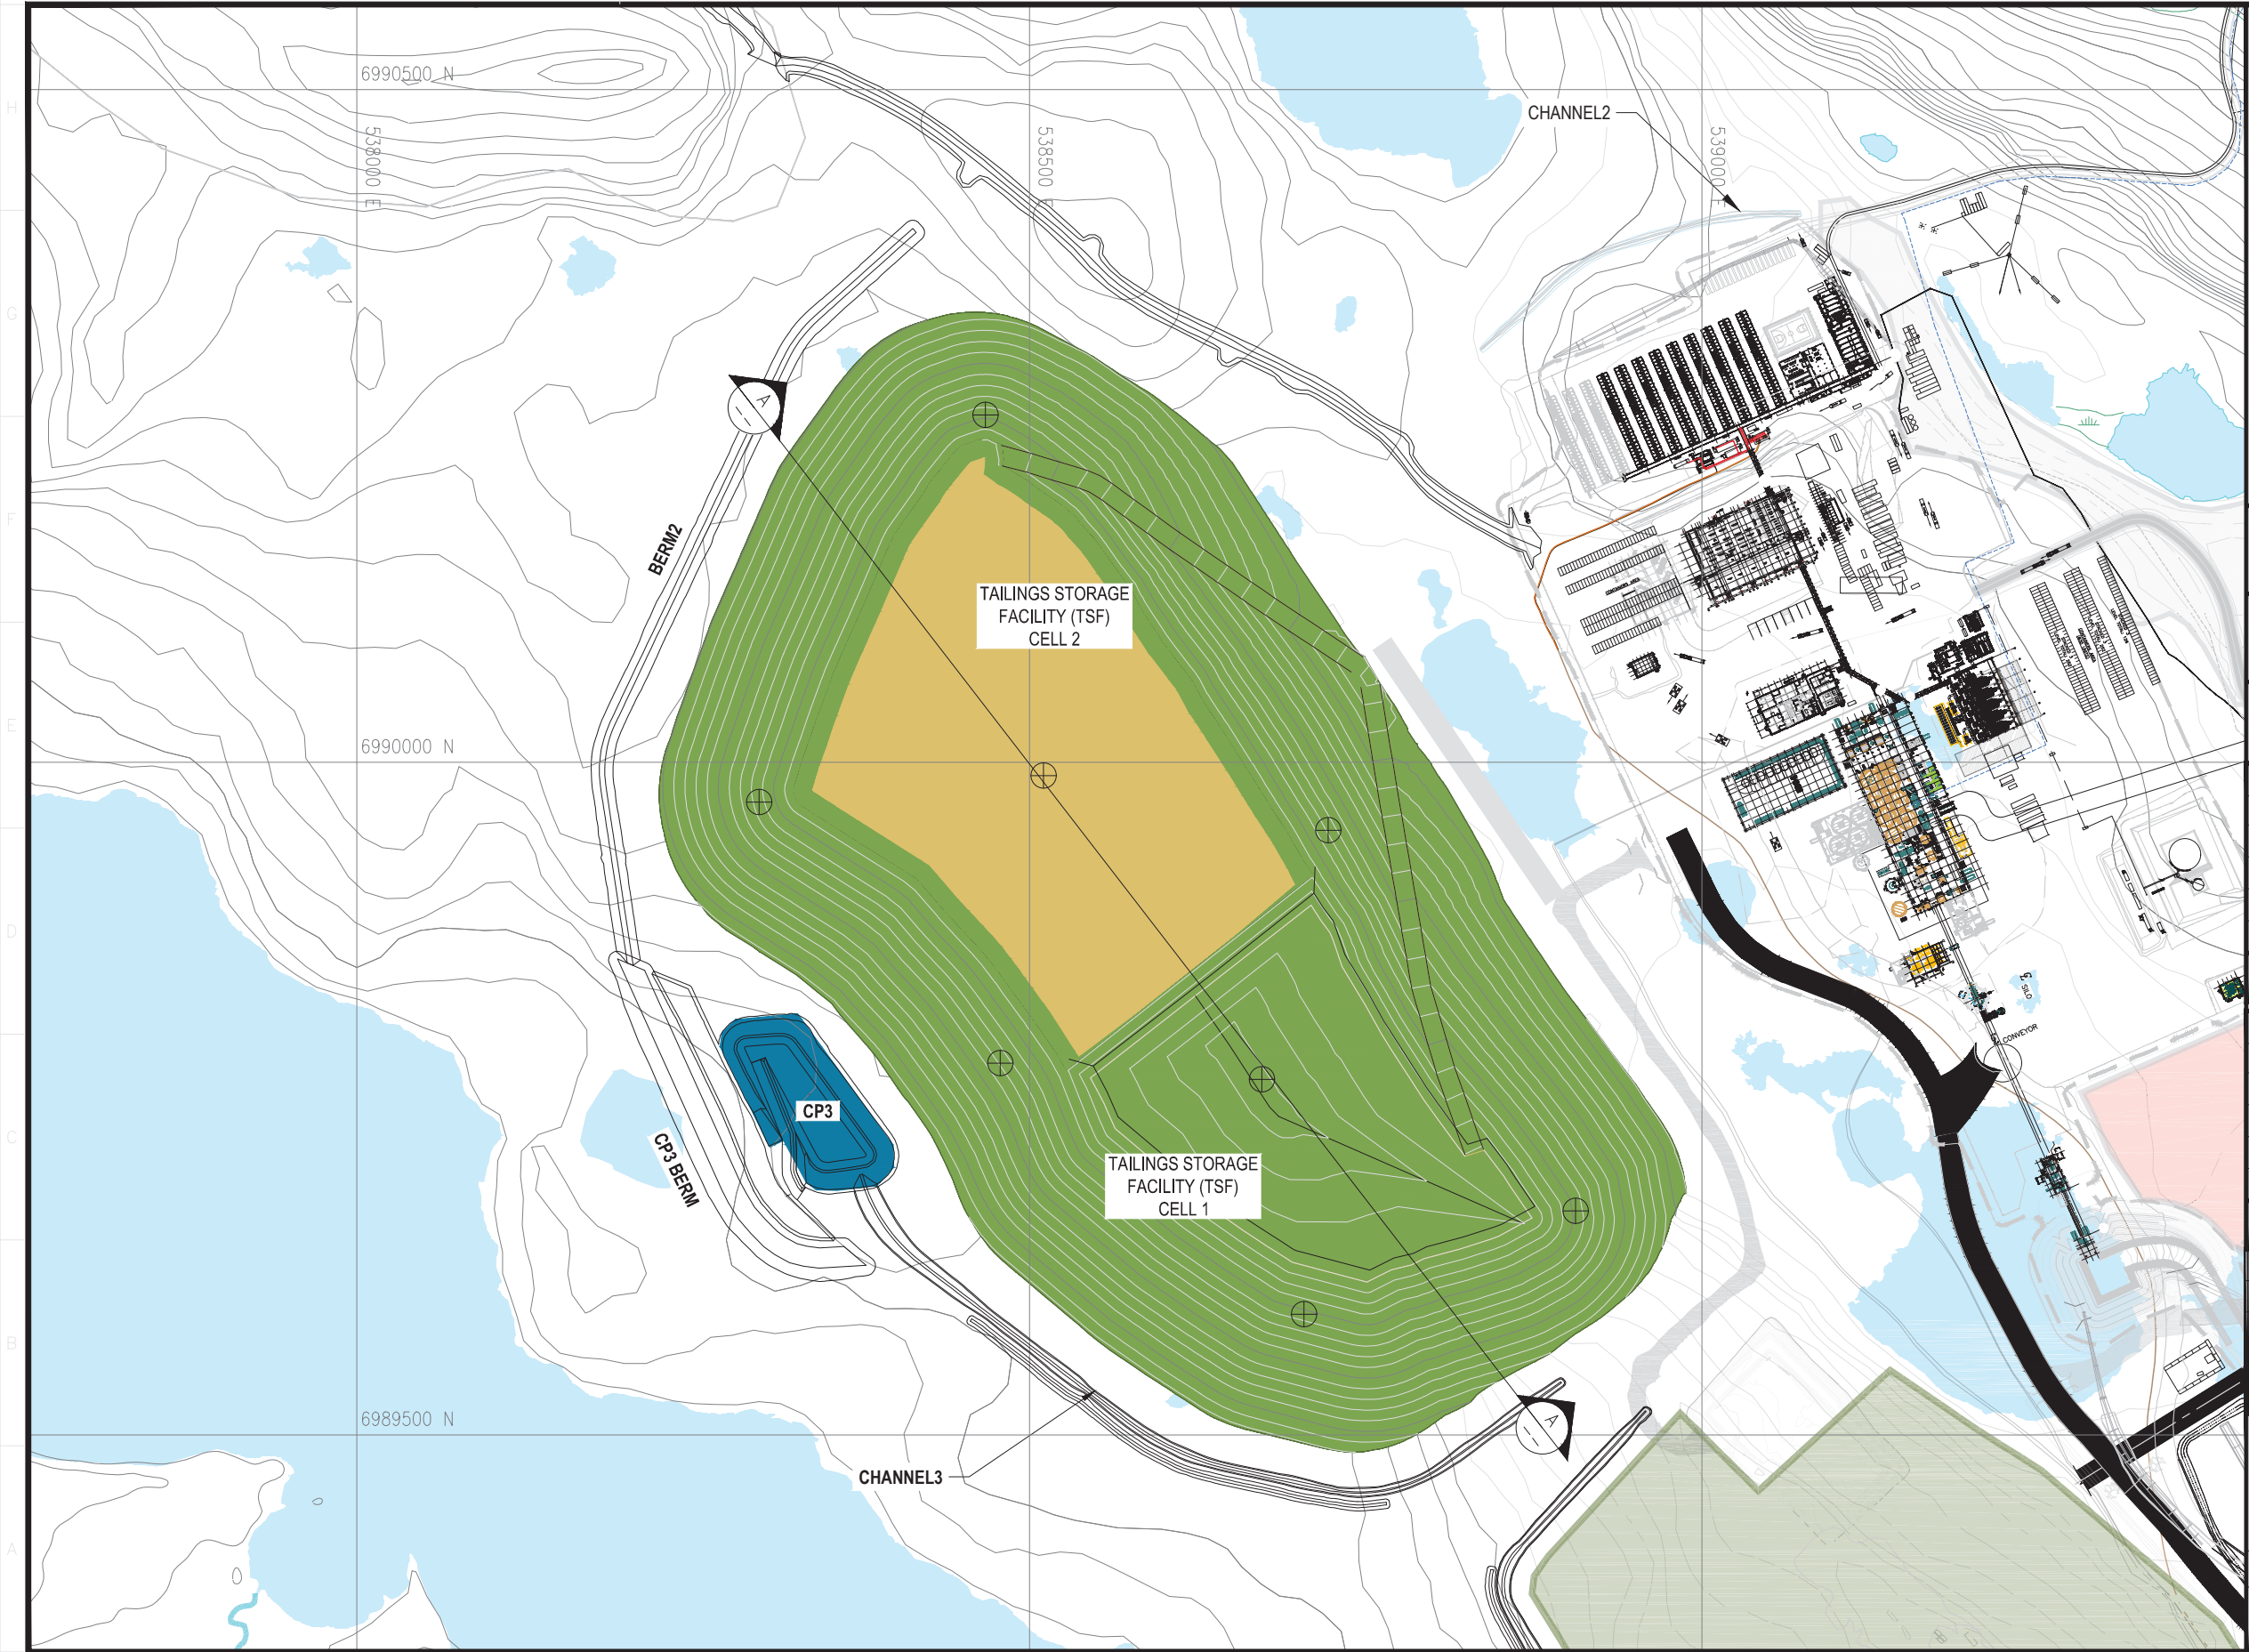

LEGEND

- WASTE ROCK
- ORE
- TAILINGS
- WATER COLLECTION POND
- PROPOSED GROUND TEMPERATURE CABLE LOCATION

PERMIT TO PRACTICE
TETRA TECH CANADA INC.

Signature: *[Signature]*
Date: *Nov 14, 2018*
PERMIT NUMBER: P 018
NT/NU Association of Professional Engineers and Geoscientists

REGISTERED PROFESSIONAL ENGINEER
G. ZHANG
LICENSEE
Nov 14, 2018
NWTNU

AGNICO EAGLE

TETRA TECH

POUR CONSTRUCTION FOR CONSTRUCTION
DATE: 11/14/2018

L'INFORMATION CI-CONTENUE EST LA PROPRIÉTÉ DE AGNICO EAGLE LTD. ET DOIT ÊTRE RETOURNÉE SANS AUTORISATION ÉCRITE PRÉALABLE. TOUTE TRANSMISSION DE COPIES À AUTRI ET TOUTE UTILISATION AUTRE QUE CELLE POUR LAQUELLE L'INFORMATION EST PRÉPARÉE SONT INTERDITES.
© AGNICO EAGLE LTD.

THE INFORMATION HERE ON IS THE PROPERTY OF AGNICO EAGLE LTD. AND MUST BE RETURNED UPON REQUEST. REPRODUCING, DISTRIBUTION, AND COPYING TRANSMITTING TO OTHERS AND ANY USE EXCEPT THAT FOR WHICH IT IS LOANED ARE PROHIBITED.
© AGNICO EAGLE LTD.

—	—
—	—
TITRE / TITLE	
# DWG	

DESSINS EN RÉFÉRENCE/REFERENCE DRAWINGS

REV	DESCRIPTION	DATE	PAR BY
0	ISSUED FOR CONSTRUCTION	2018-11-14	
B	ISSUED FOR REVIEW	2018-11-06	
A	ISSUED FOR REVIEW	2018-11-05	

REVISIONS

DESSINÉ PAR DRAWN BY	EL/EP	DATE	2018-11-14
VÉRIFIÉ PAR CHECKED BY	GZ/WT		2018-11-14
APPROUVÉ PAR APPROVED BY			

No. PROJET
PROJECT NO.


DATE

TITRE / TITLE
MELIADINE TAILINGS STORAGE FACILITY DESIGN

YEAR 7

ECHELLE/ SCALE	FICHIER FILE	REVISION	FEUILLE/SHT
No. DESSIN/ DRAWING NO.	.DWG	0	3 / 8

6515-583-163-003

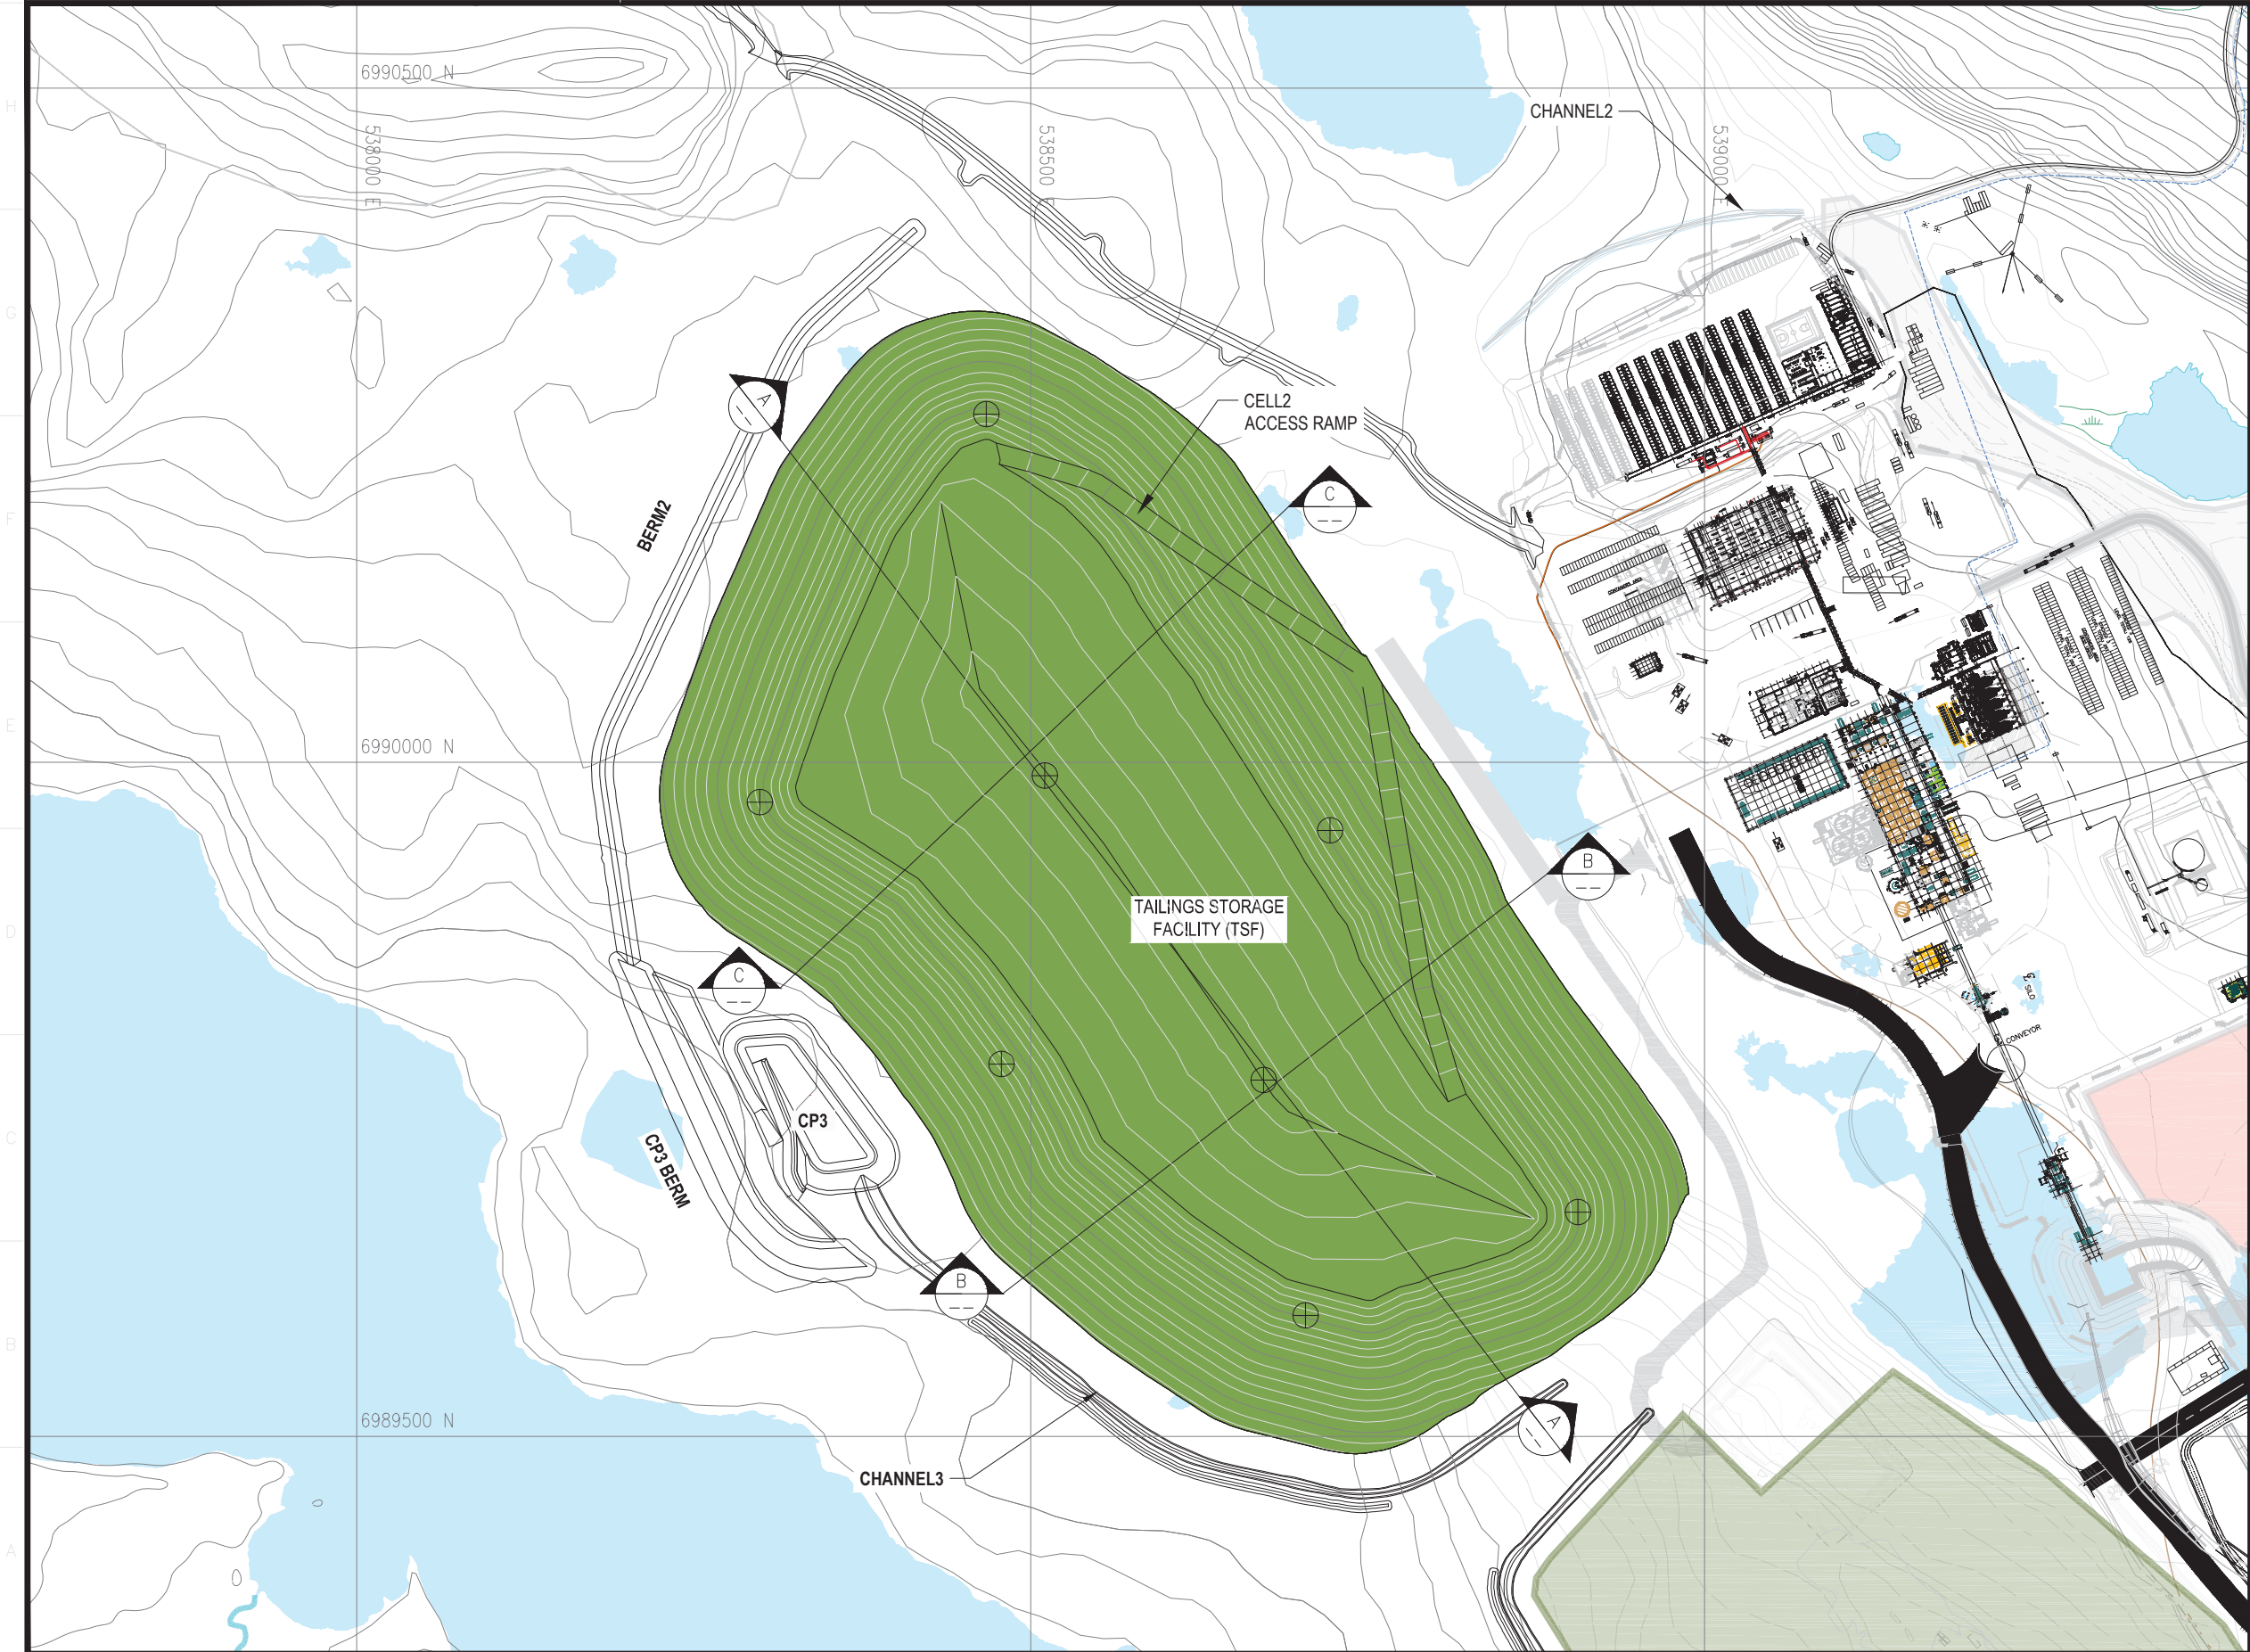

LEGEND

- WASTE ROCK
- ORE
- TAILINGS
- PROPOSED GROUND TEMPERATURE CABLE LOCATION

PERMIT TO PRACTICE
TETRA TECH CANADA INC.
Signature: [Signature]
Date: Nov. 14, 2018
PERMIT NUMBER: P 018
NT/NU Association of Professional
Engineers and Geoscientists



L'INFORMATION CI-CONTENUE EST LA PROPRIÉTÉ DE AGNICO EAGLE LTD. ET DOIT ÊTRE RETENUE SUR DEMANDE, SANS AUTORISATION ÉCRITE PRÉALABLE.
TOUTE TRANSMISSION DE COPIES À AUTRUI ET TOUTE UTILISATION AUTRE QUE CELLE POUR LAQUELLE L'INFORMATION EST PRÉÉE SONT INTERDITES.
© AGNICO EAGLE LTD.
THE INFORMATION HERE ON IS THE PROPERTY OF AGNICO EAGLE LTD. AND MUST BE RETURNED UPON REQUEST.
WITHOUT WRITTEN PERMISSION, ANY COPYING TRANSMITTAL TO OTHERS AND ANY USE EXCEPT THAT FOR WHICH IT IS LOANED ARE PROHIBITED.
© AGNICO EAGLE LTD.

TITRE / TITLE # DWG

DESSINS EN RÉFÉRENCE/REFERENCE DRAWINGS

REV	DESCRIPTION	DATE	PAR BY
0	ISSUED FOR CONSTRUCTION	2018-11-14	
B	ISSUED FOR REVIEW	2018-11-06	
A	ISSUED FOR REVIEW	2018-11-05	

REVISIONS

DESSINÉ PAR DRAWN BY	EL/EP	DATE	2018-11-14
VERIFIÉ PAR CHECKED BY	GZ/WITH		2018-11-14
APPROUVÉ PAR APPROVED BY			

No. PROJET
PROJECT NO.

DATE

TITRE / TITLE
MELIADINE TAILINGS STORAGE FACILITY DESIGN

CLOSURE

ECHELLE/
SCALE

FICHIER
FILE .DWG

No. DESSIN/
DRAWING NO.

6515-583-163-004


REVISION

0

FEUILLE/SHIT

4 / 8



NOTES:

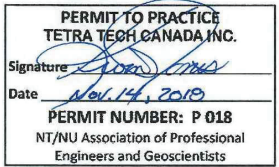


L'INFORMATION CI-CONTENUE EST LA PROPRIÉTÉ DE AGNICO EAGLE LTD. ET DOIT ÊTRE RETOURNÉE SUR DEMANDE, SANS AUTORIZATION ÉCRITE PRÉALABLE.
TOUTE TRANSMISSION DE COPIES À AUTRE ET TOUTE UTILISATION AUTRE QUE CELLE POUR LAQUELLE L'INFORMATION EST PRÉÉE SONT INTERDITES.
© AGNICO EAGLE LTD.
THE INFORMATION HERE ON IS THE PROPERTY OF AGNICO EAGLE LTD. AND MUST BE RETURNED UPON REQUEST.
WITHOUT WRITTEN PERMISSION, ANY COPYING, TRANSMITTAL TO OTHERS AND ANY USE EXCEPT THAT FOR WHICH IT IS LOANED ARE PROHIBITED.
© AGNICO EAGLE LTD.

NOTE: TSF CLOSURE COVER THICKNESS AND CONFIGURATION TO BE FINALIZED DURING THE DEVELOPMENT OF THE FINAL CLOSURE COVER DESIGN PENDING PERFORMANCE MONITORING OF DRY STACKED TAILINGS FACILITY DURING OPERATION.

TYPICAL DESIGN SECTION FOR TSF

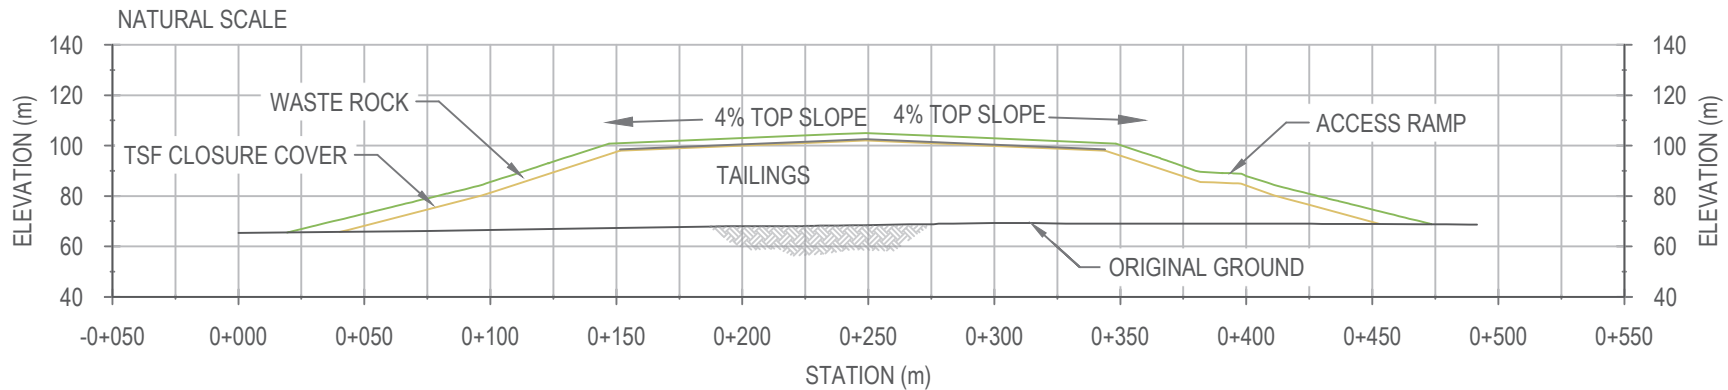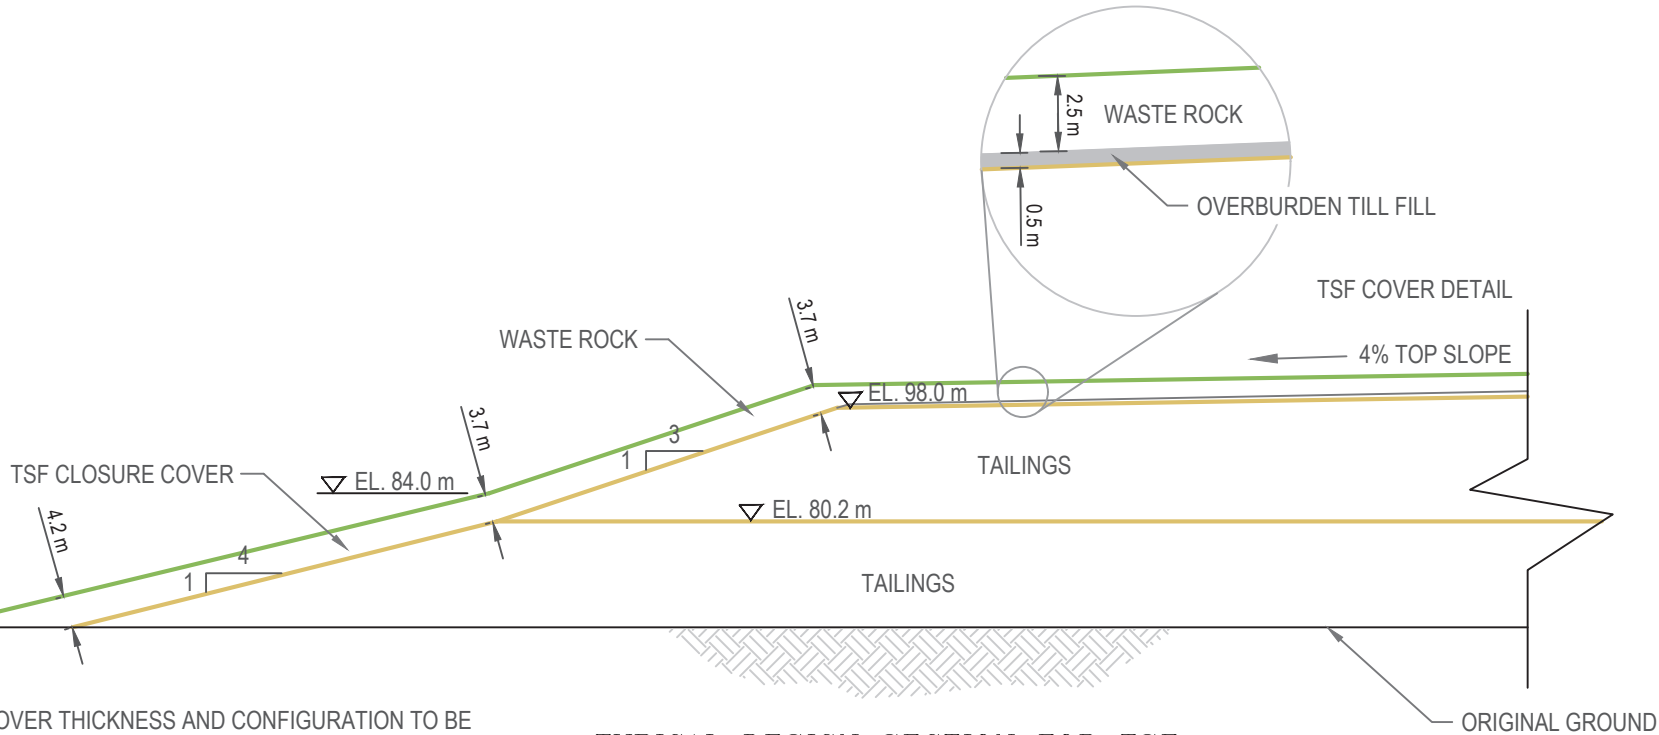

SECTION B-B THROUGH CELL 1

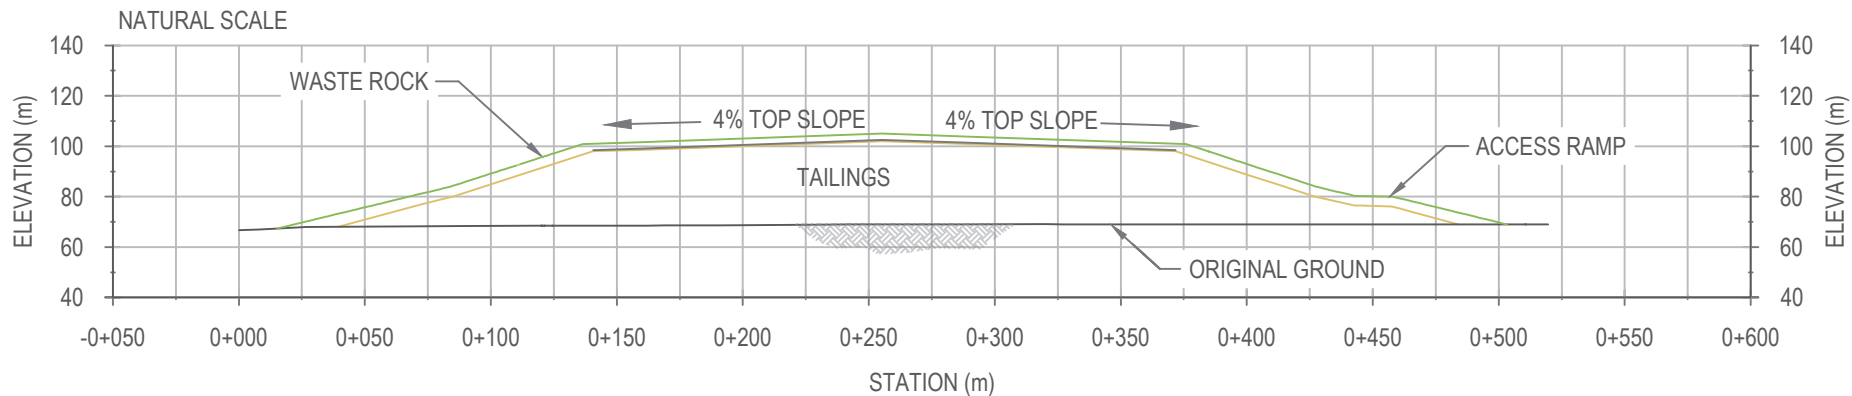

SECTION C-C THROUGH CELL 2

DESSINS EN RÉFÉRENCE/REFERENCE DRAWINGS

REV	DESCRIPTION	DATE	PAR BY
0	ISSUED FOR CONSTRUCTION	2018-11-14	
B	ISSUED FOR REVIEW	2018-11-06	
A	ISSUED FOR REVIEW	2018-11-05	

REVISIONS


DESSINÉ PAR DRAWN BY	EP	DATE	2018-11-14
VÉRIFIÉ PAR CHECKED BY	GZ/WTH		2018-11-14
APPROUVÉ PAR APPROVED BY			
No. PROJET PROJECT NO.			
DATE			

TITRE / TITLE
MELIADINE TAILINGS STORAGE FACILITY DESIGN

TYPICAL DESIGN SECTION OF TSF AND
SECTIONS B-B AND C-C THROUGH CELLS 1 AND 2

ÉCHELLE/ SCALE	FICHIER FILE	REVISION	FEUILLE/SHT
No. DESSIN/ DRAWING NO.	.DWG	0	5 / 9
6515-583-163-005			

Figure 3: Proposed Waterlines Alignment along the All-weather Access Road

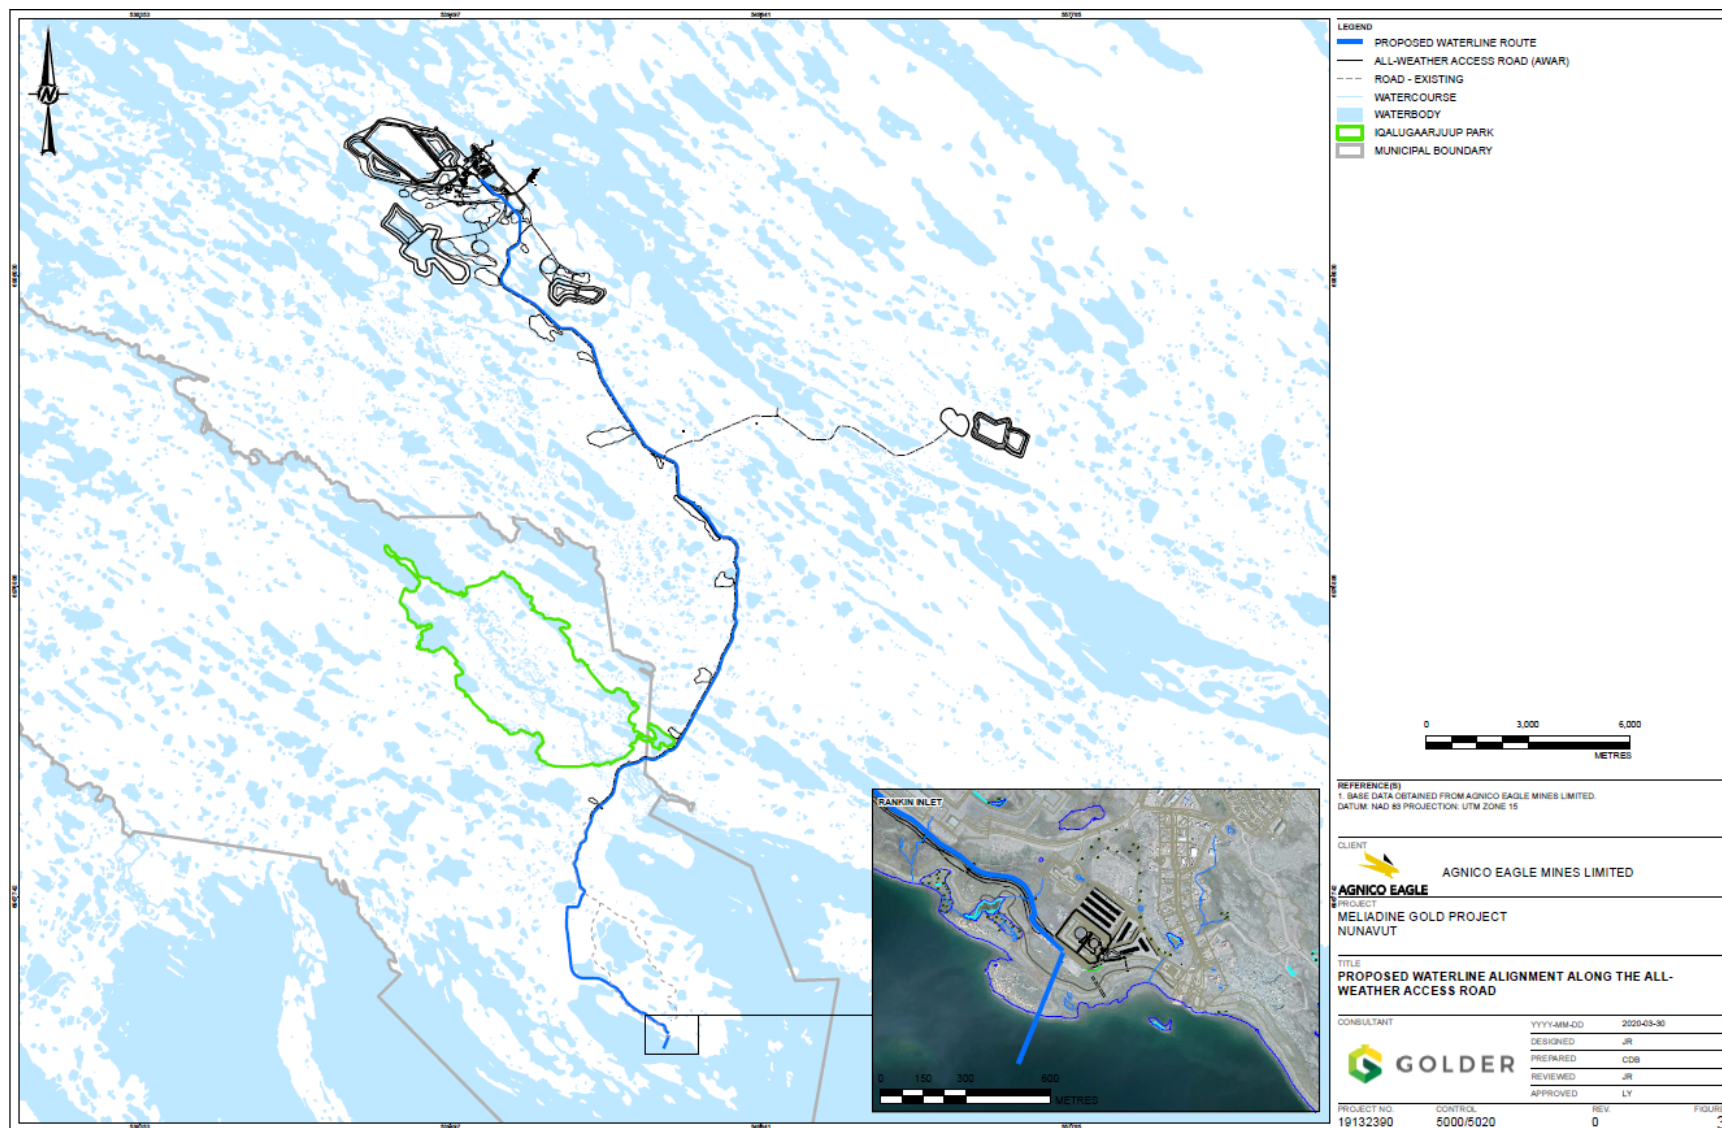

TYPICAL SECTION - 2x18" WATERLINE
SCALE 1/8" = 1'-0"

TYPICAL SECTION - ROAD CROSSING
SCALE 1/8" = 1'-0"

TYPICAL SECTION - WATERLINE ABOVE A CULVERT
SCALE 1/8" = 1'-0"


TYPICAL SECTION - WATERLINE ABOVE A WATER STREAM
SCALE 1/8" = 1'-0"



LEGEND

- ① EXISTING GROUND TO 150mm LAYER
- ② PROTECTIVE COVER TO 150mm LAYER
- ③ LATERAL GROUND TO 150mm LAYER
- ④ FUNDATION TO 150mm LAYER

[illegible]

Figure 6: Engineered Marine Outfall Cross-Section Schematic (Drawing 65-695-265-221)

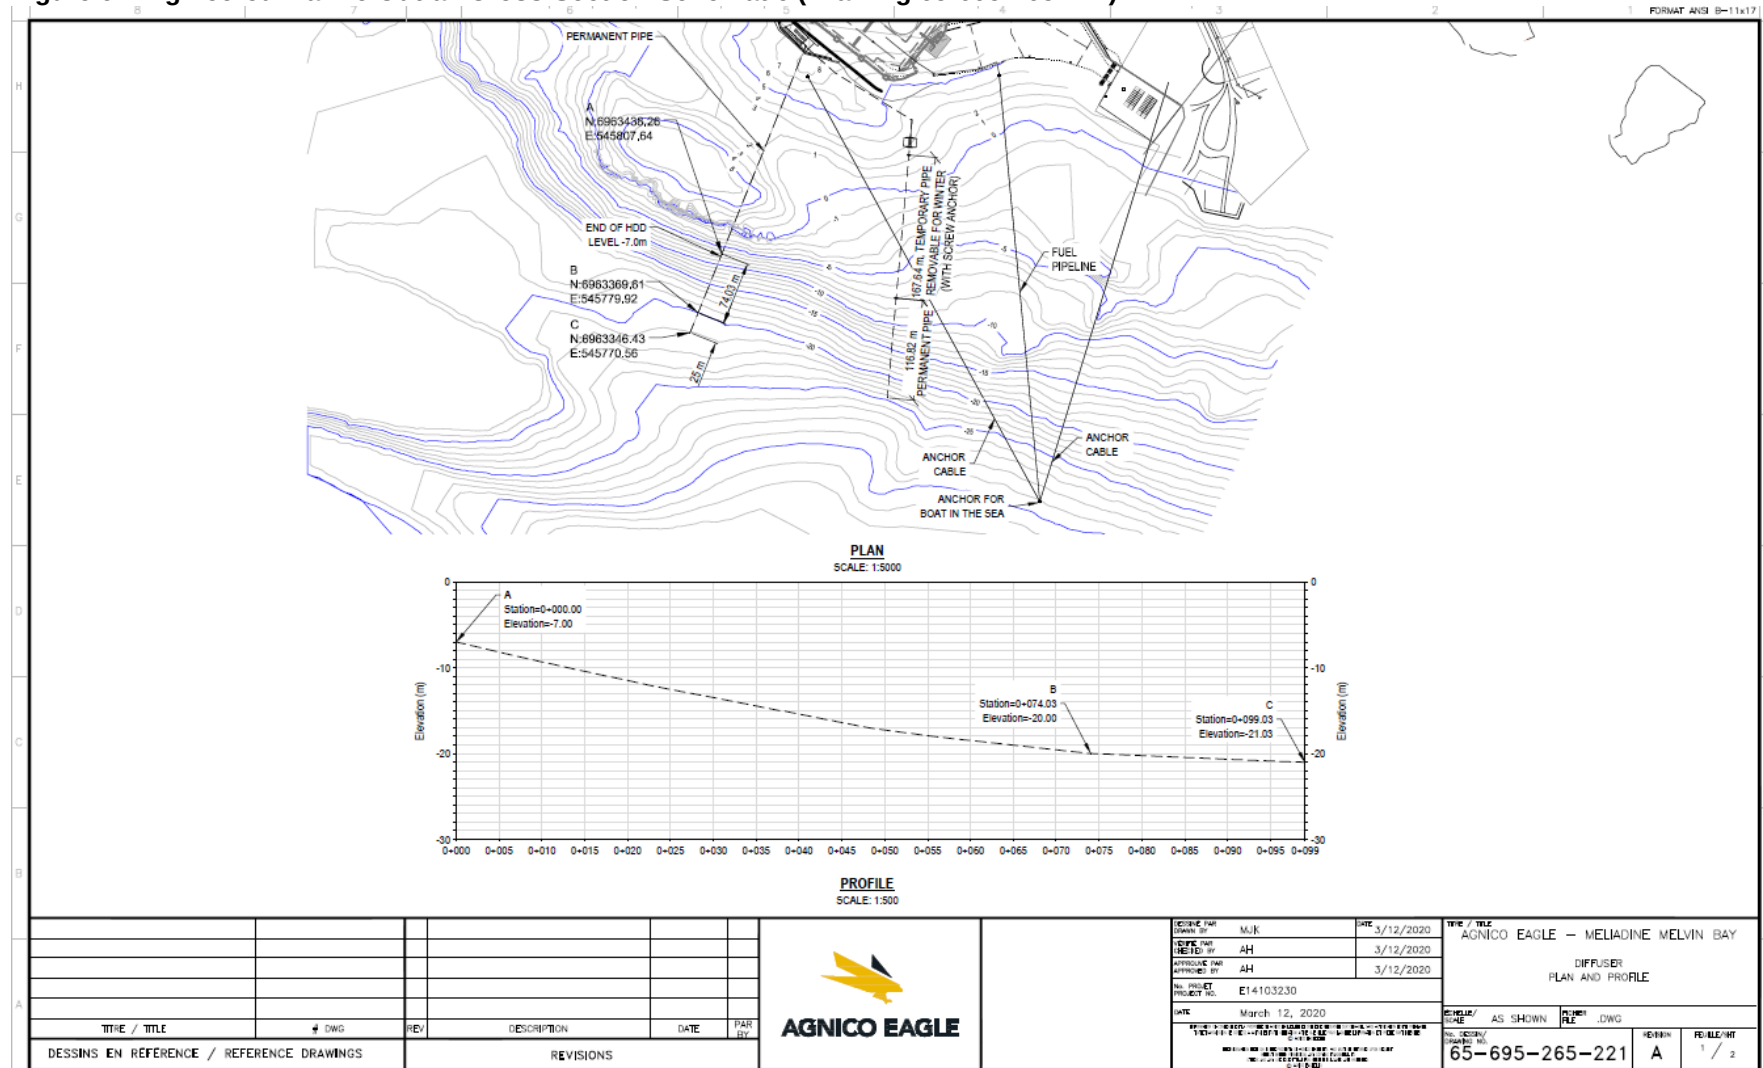

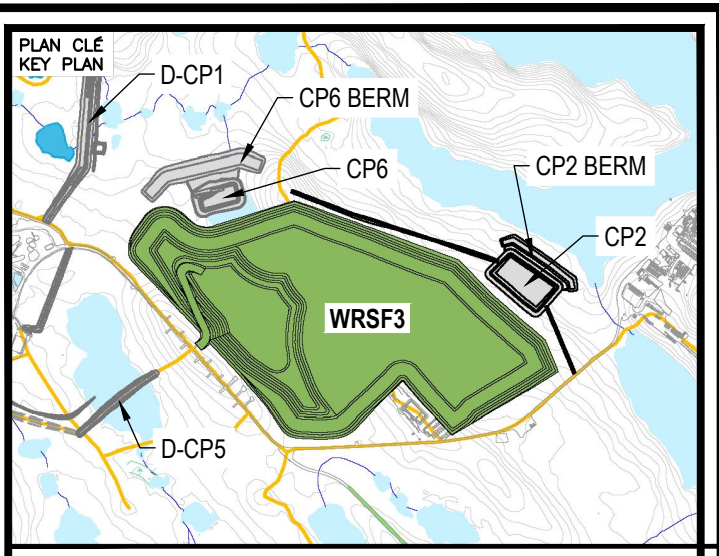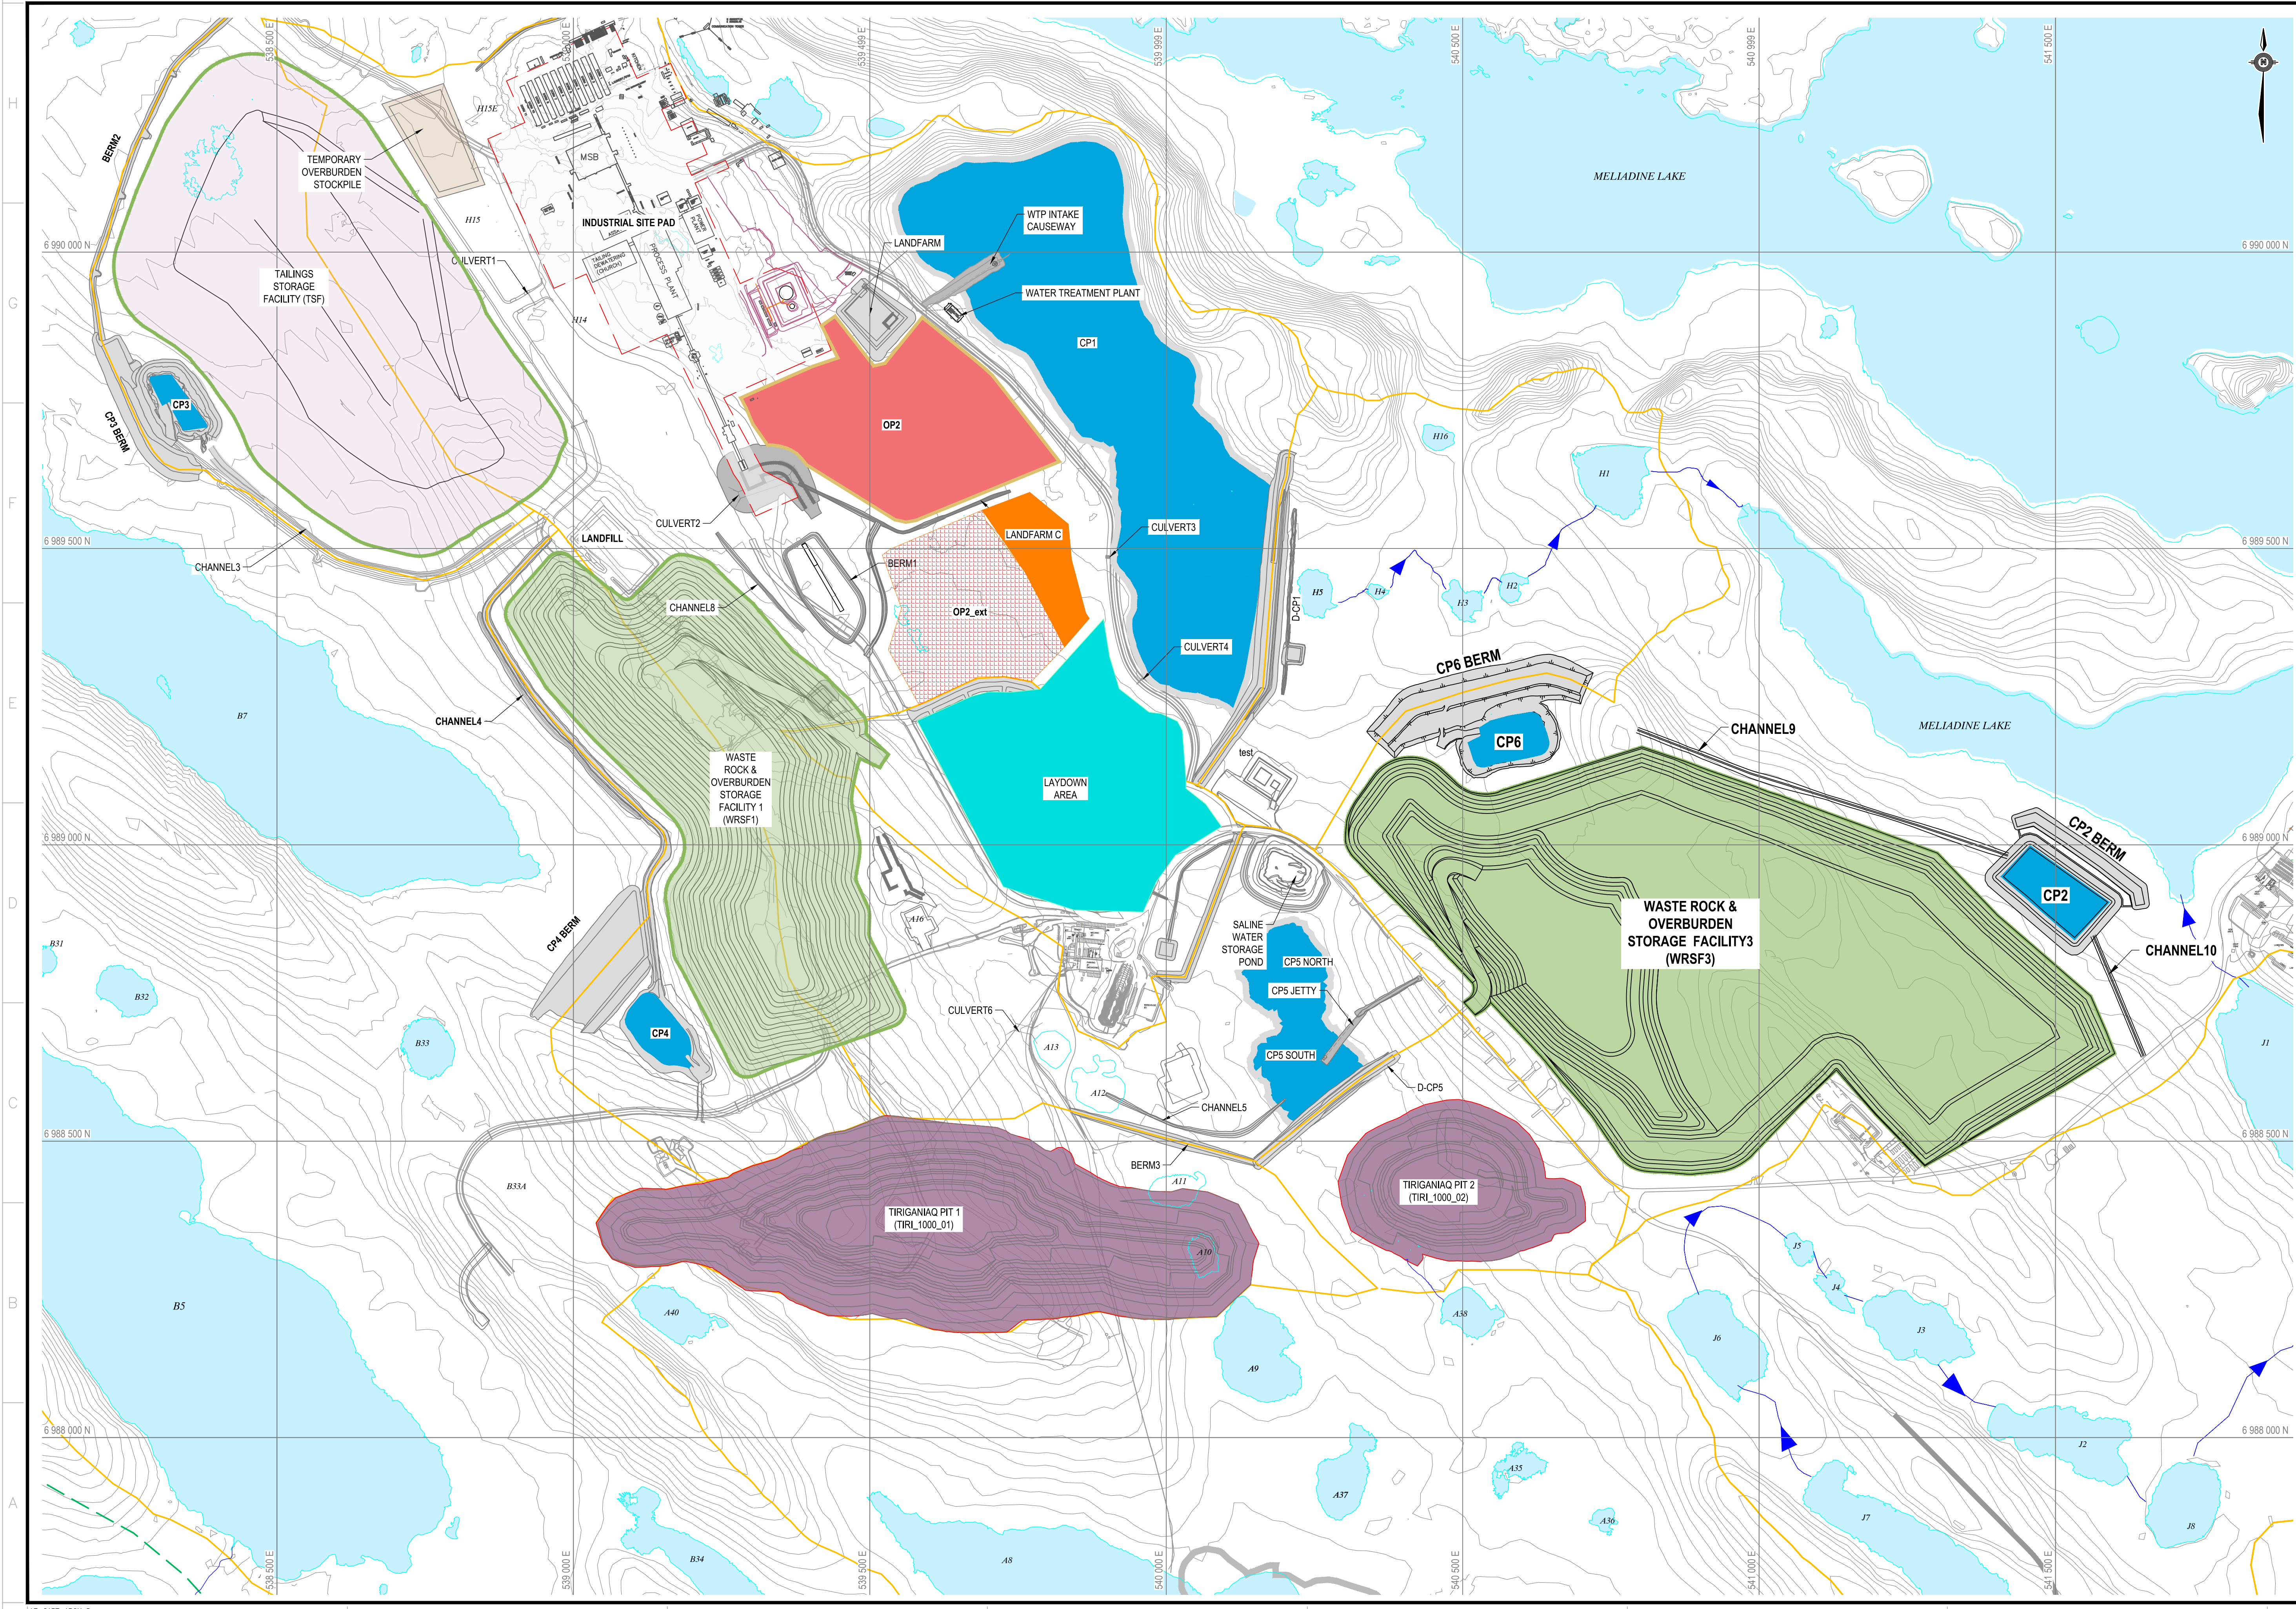

NOTES GÉNÉRALES / GENERAL NOTES

1. DIMENSIONS ARE IN METERS UNLESS SPECIFIED OTHERWISE
2. WASTE ROCK AND OVERBURDEN STORAGE FACILITY 3 WAS DESIGNED TO STORE 2.1 Mm³ OF OVERBURDEN AND 6.5 Mm³ OF WASTE ROCK
3. OVERBURDEN THICKNESS AROUND CP2 AREA IS ASSUMED TO BE 4.0 m. THE ACTUAL OVERBURDEN THICKNESS TO BE DETERMINED DURING FUTURE SITE INVESTIGATION PROGRAMS
4. CP2 WAS DESIGNED TO STORE 3/7 OF EQUIVALENT UNIT RUNOFF DURING SPRING FRESHET FOR 1 IN 100 WET YEAR (73.3 mm)
5. CHANNELS (CHANNEL9 AND CHANNEL10) WERE DESIGNED TO PASS AN EXTREME INTENSITY FLOW UNDER A 5-MINUTE 1 IN 100 RETURN RAINFALL (5.0 mm)

L'INFORMATION CONTENUE EST LA PROPRIÉTÉ DE AGNICO EAGLE LTD. ET NE DOIT ÊTRE RÉVÉLÉE À UN TIERS SANS L'AUTORISATION ÉCRITE D'AGNICO EAGLE LTD. AGNICO EAGLE LTD. ASSUME LA RESPONSABILITÉ DE L'INFORMATION CONTENUE. AGNICO EAGLE LTD. ASSUME LA RESPONSABILITÉ DE L'INFORMATION CONTENUE. AGNICO EAGLE LTD. ASSUME LA RESPONSABILITÉ DE L'INFORMATION CONTENUE.

DESSINS EN RÉFÉRENCE / REFERENCE DRAWINGS

TITRE / TITLE	# DWG



REV.	DATE	ISSUED FOR USE	DESCRIPTION	PAR/EN	APP.	CLIENT
0	07/22/20	ISSUED FOR USE		HX	NG	


REVISIONS






TITRE / TITLE
AGNICO EAGLE MELIADINE GOLD PROJECT
JULY 2020 WATER LICENSE AMENDMENT

SITE LAYOUT
PLAN VIEW

DESSINÉ PAR DRAWN BY	EL	DATE 2020-07-03
VÉRIFIÉ PAR CHECKED BY	HX	2020-07-03
APPROUVÉ PAR APPROVED BY	NG	2020-07-03
ÉCHELLE SCALE	1:5000	DATE 2020-07-03

NO. DESSIN DRAWING NO.	FIGURE 1
NO. PROJET PROJECT NO.	6515
REVISION	0
FEUILLE / SHEET	1 / 5

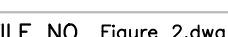

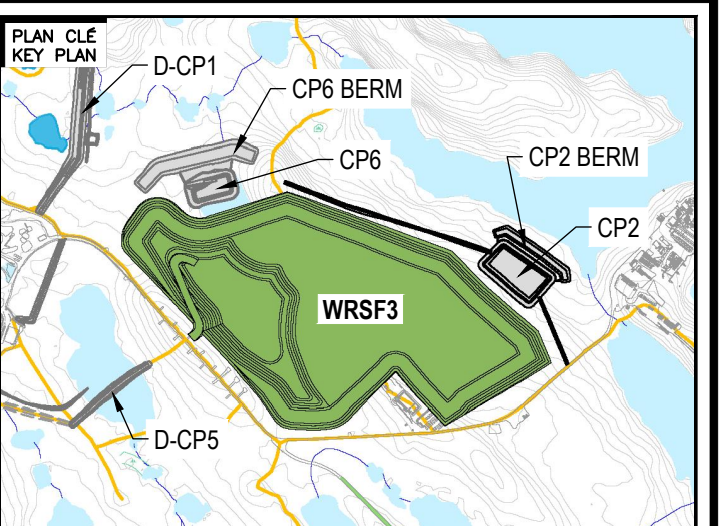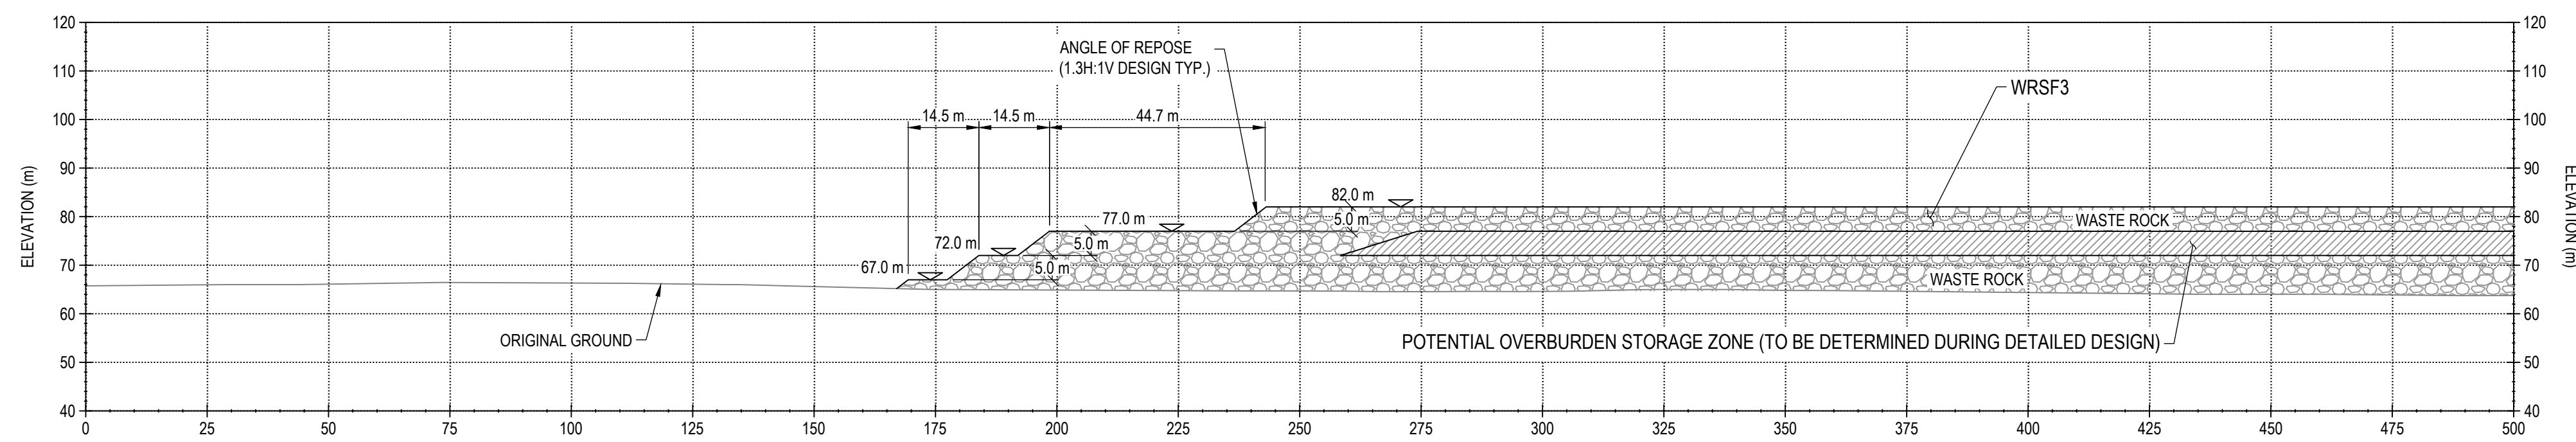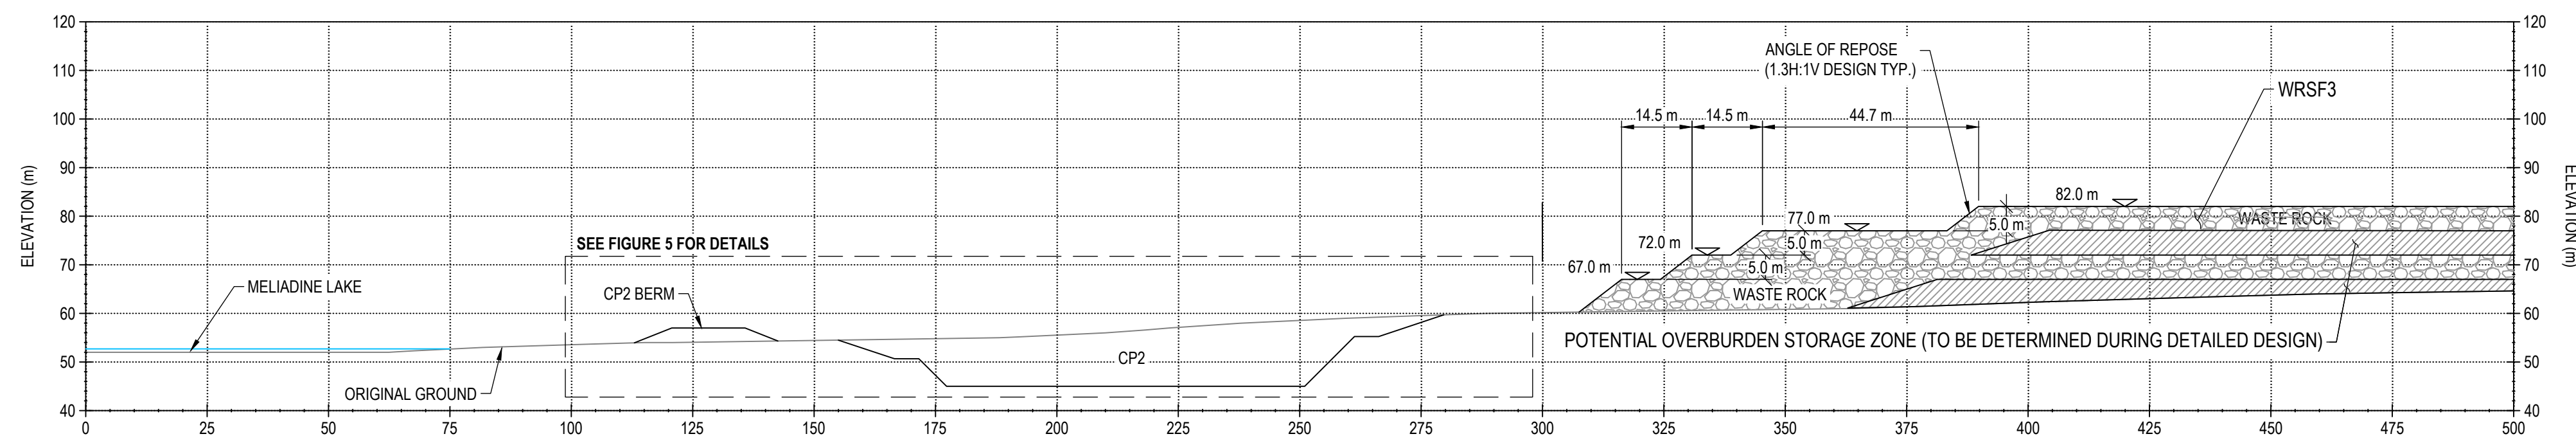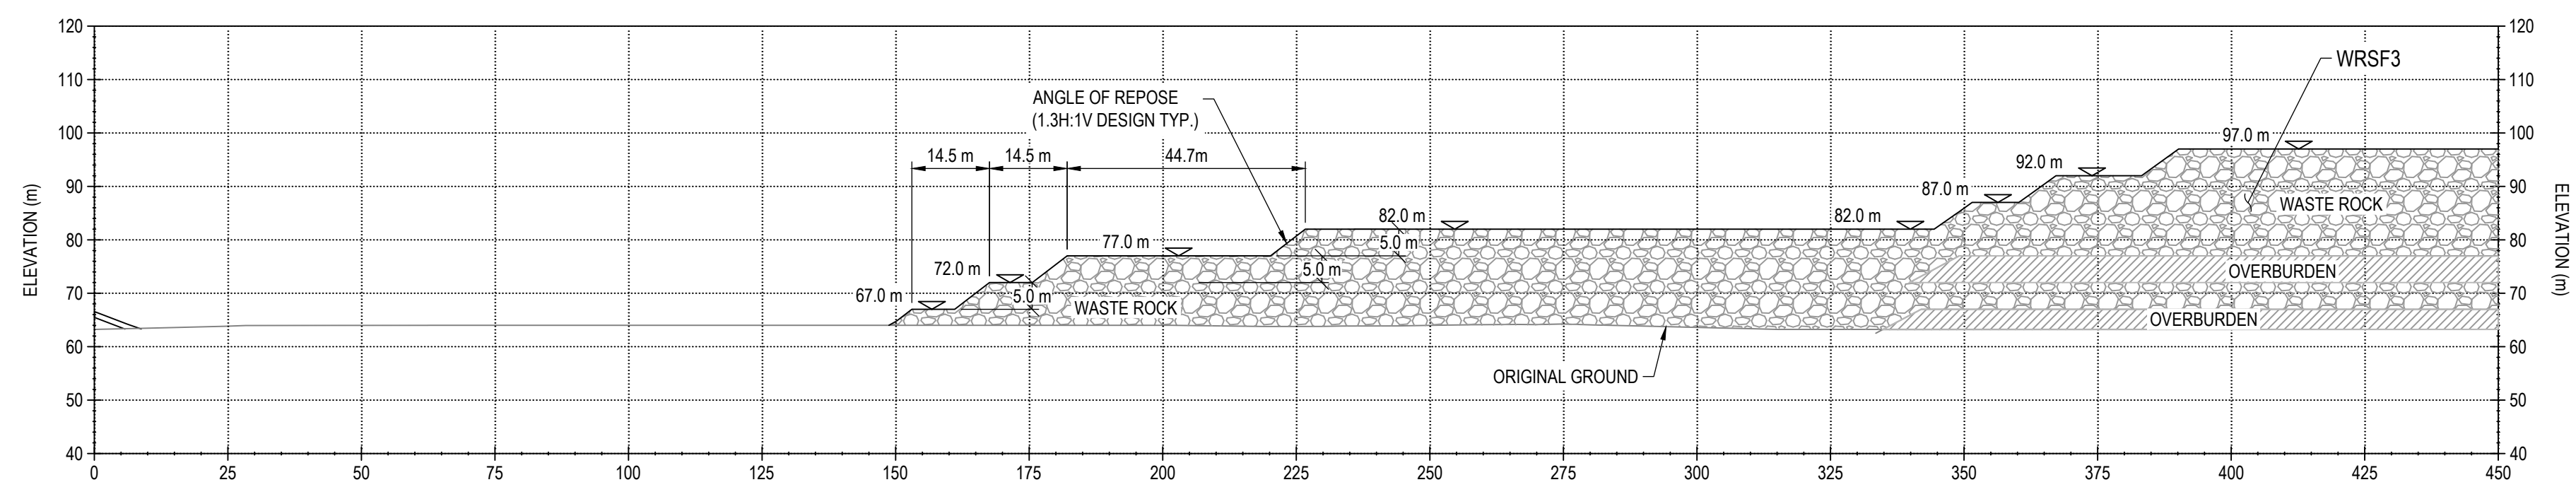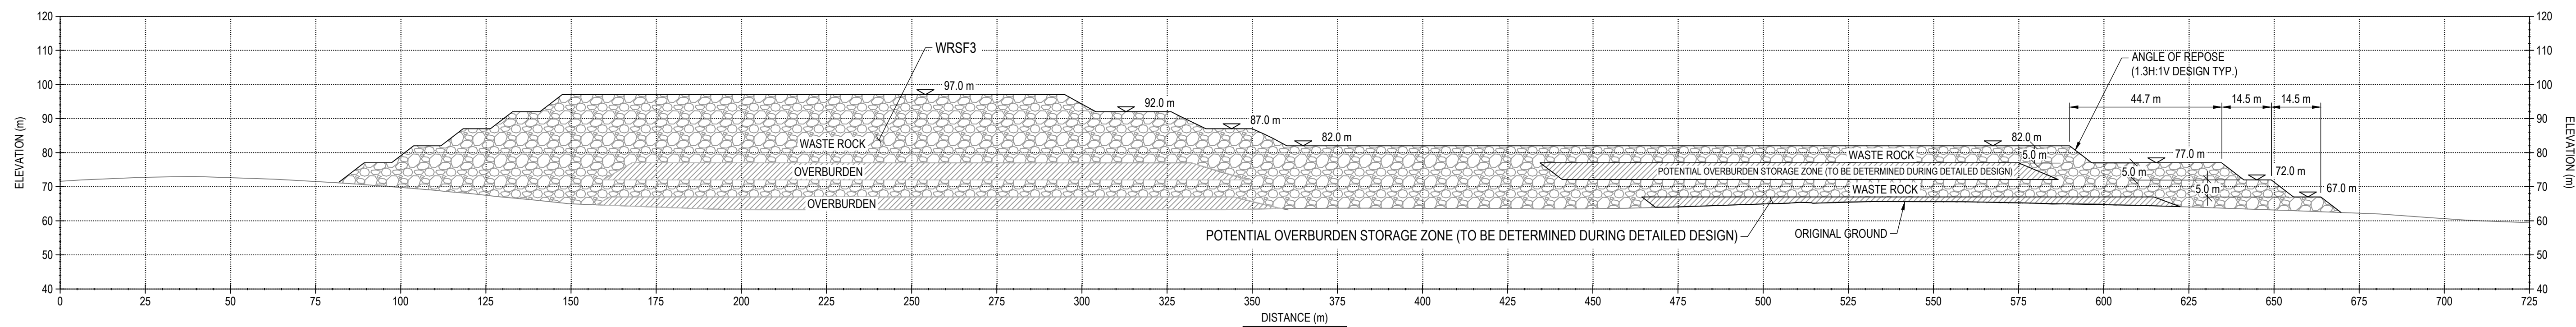

NOTES GÉNÉRALES / GENERAL NOTES

1. DIMENSIONS ARE IN METERS UNLESS SPECIFIED OTHERWISE
2. WASTE ROCK AND OVERBURDEN STORAGE FACILITY 3 WAS DESIGNED TO STORE 2.1 Mm³ OF OVERBURDEN AND 6.5 Mm³ OF WASTE ROCK
3. OVERBURDEN STORAGE ZONE TO BE DETERMINED DURING DETAILED DESIGN STAGE
4. TYPICAL SIDE SLOPE OF WASTE ROCK LAYER : 1.3H:1V (ANGLE OF REPOSE FOR WASTE ROCK :37°)

L'INFORMATION CI-CONTENUE EST LA PROPRIÉTÉ DE AONCO EAGLE L.L.C. ET DOIT ÊTRE RETENUE SUR DEMANDE, SANS AUTORISATION (SOIT PRÉALABLE, TOUTE TRANSMISSION DE COPIES) À AUTRI ET TOUTE UTILISATION AUTRE QUE CELLE POUR LAQUELLE L'INFORMATION EST PRÉSENTÉ. © AONCO EAGLE L.L.C.

DESSINS EN RÉFÉRENCE / REFERENCE DRAWINGS

[illegible]

AGNICO EAGLE

0	07/22/20	ISSUED FOR USE	HX	NG		
REV.	DATE	DESCRIPTION	PAR/BY	APP.	CLIENT	

REVISIONS

TITRE / TITLE
AGNICO EAGLE MELIADINE GOLD PROJECT
JULY 2020 WATER LICENSE AMENDMENT


MELIADINE WRSI
SECTIONS A TO

DESSINÉ PAR DRAWN BY	EL	DATE 2020-07-0
VÉRIFIÉ PAR CHECKED BY	HX	2020-07-0
APPROUVÉ PAR APPROVED BY	NG	2020-07-0

ÉCHELLE SCALE	1:750	DATE	2020-07-03
------------------	-------	------	------------

FIGURE 3

NO. PROJ PROJECT NO.	REVISION	FEUILLE / SHT
6515	0	3 / 5

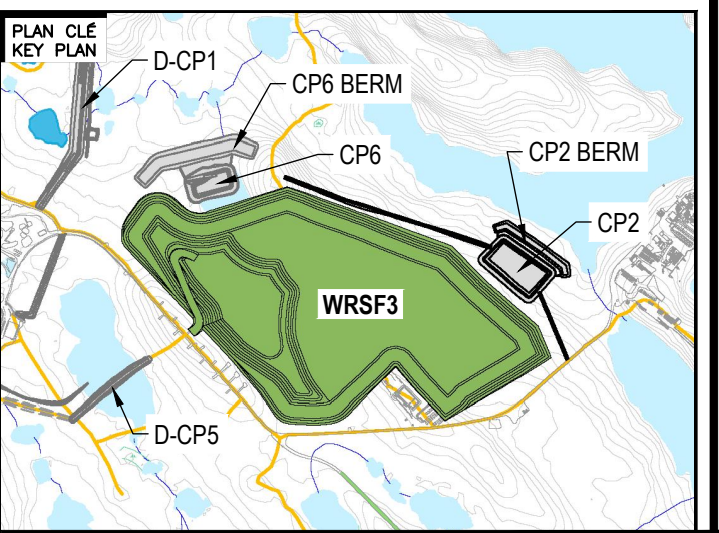

NOTES GÉNÉRALES / GENERAL NOTES

1. DIMENSIONS ARE IN METERS UNLESS SPECIFIED OTHERWISE
2. OVERBURDEN THICKNESS AROUND CP2 AREA IS ASSUMED TO BE 4.0 m. THE ACTUAL OVERBURDEN THICKNESS TO BE DETERMINED DURING FUTURE SITE INVESTIGATION PROGRAMS
3. CP2 WAS DESIGNED TO STORE 3/ 7 OF EQUIVALENT UN RUNOFF DURING SPRING FRESHET FOR 1 IN 100 WET YEAR (73.3 mm)
4. CHANNELS (CHANNEL9 AND CHANNEL10) WERE DESIGNED TO PASS AN EXTREME INTENSITY FLOW UNDER A 5-MINUTE 1 IN 100 RETURN RAINFALL (5.0 mm)

- (A) PIT-RUN OR QUARRY ROCKFILL
- (B) TRANSITION ROCKFILL
- (C) LINER BEDDING TILL
- (D) TILL FILL
- (E) TILL FILTER FILL
- (F) ROAD SURFACES FILL
- (G) RIP RAP

THE INFORMATION HERE ON IS THE PROPERTY OF HONDA EAGLE LTD. AND MUST BE RETURNED UPON REQUEST. WITHOUT WRITTEN PERMISSION, ANY COPYING TRANSMITTAL TO OTHERS AND ANY USE EXCEPT THAT FOR WHICH IT IS LOANED ARE PROHIBITED.
© HONDA EAGLE LTD.

DESSINS EN RÉFÉRENCE / REFERENCE DRAWING

[illegible]

AGNICO EAGLE

0	07/22/20	ISSUED FOR USE	HX	NG		
REV.	DATE	DESCRIPTION	PAR/BY	APP.	CLN	

REVISIONS

TITRE / TITLE
AGNICO EAGLE MELIADINE GOLD PROJECT
JULY 2020 WATER LICENSE AMENDMENT

CP2 TYPICAL SECTION AND
CP2 THERMAL PROTECTION BERM PROFILE

DESSINÉ PAR DRAWN BY	EL	DATE 2020-07-
VÉRIFIÉ PAR CHECKED BY	HX	2020-07-
APPROUVÉ PAR APPROVED BY	NG	2020-07-

ÉCHELLE SCALE	AS SHOWN	DATE	2020-07-03
------------------	----------	------	------------

FIGURE 5

NO. PROJ PROJECT NO.	REVISION	FEUILLE / SH
	0	5 / 5

