



	Spill Contingency Plan	Issue Date: March 07, 2016 Revision: 2	
	Environment	Document #: BAF-PH1-830-P16-0036	

Appendix A-

2016 Layouts for Milne Port and Mary River


The information contained herein is proprietary to Baffinland Iron Mines Corporation and is used solely for the purpose for which it is supplied. It shall not be disclosed in whole or in part, to any other party, without the express permission in writing by Baffinland Iron Mines Corporation.

Note: This is an UNCONTROLLED COPY. All staff members are responsible to ensure the latest revision is used.

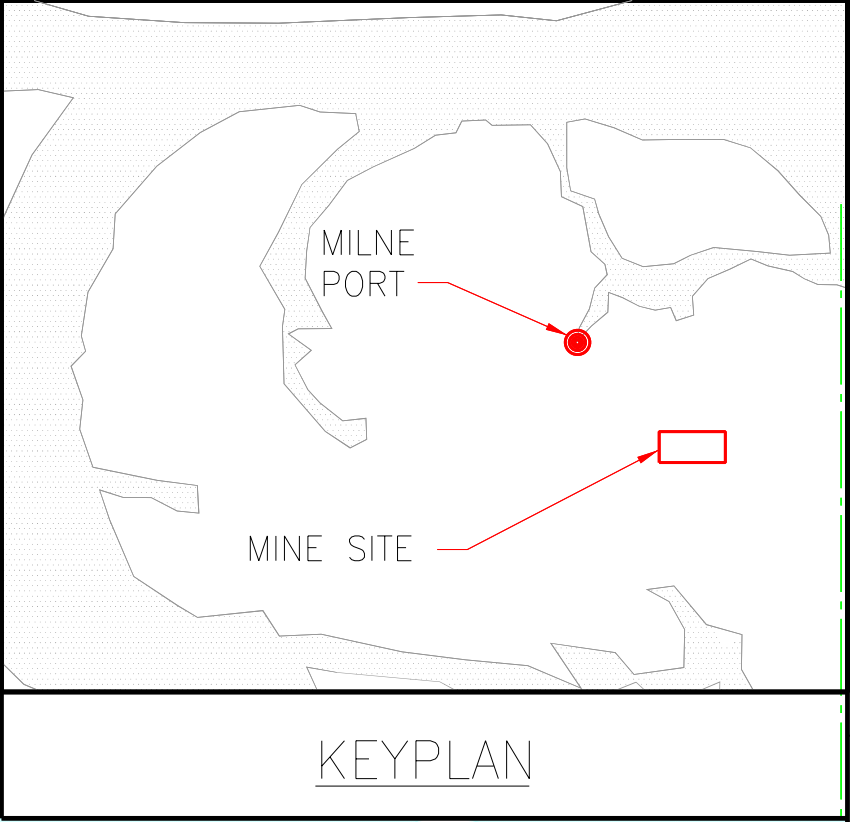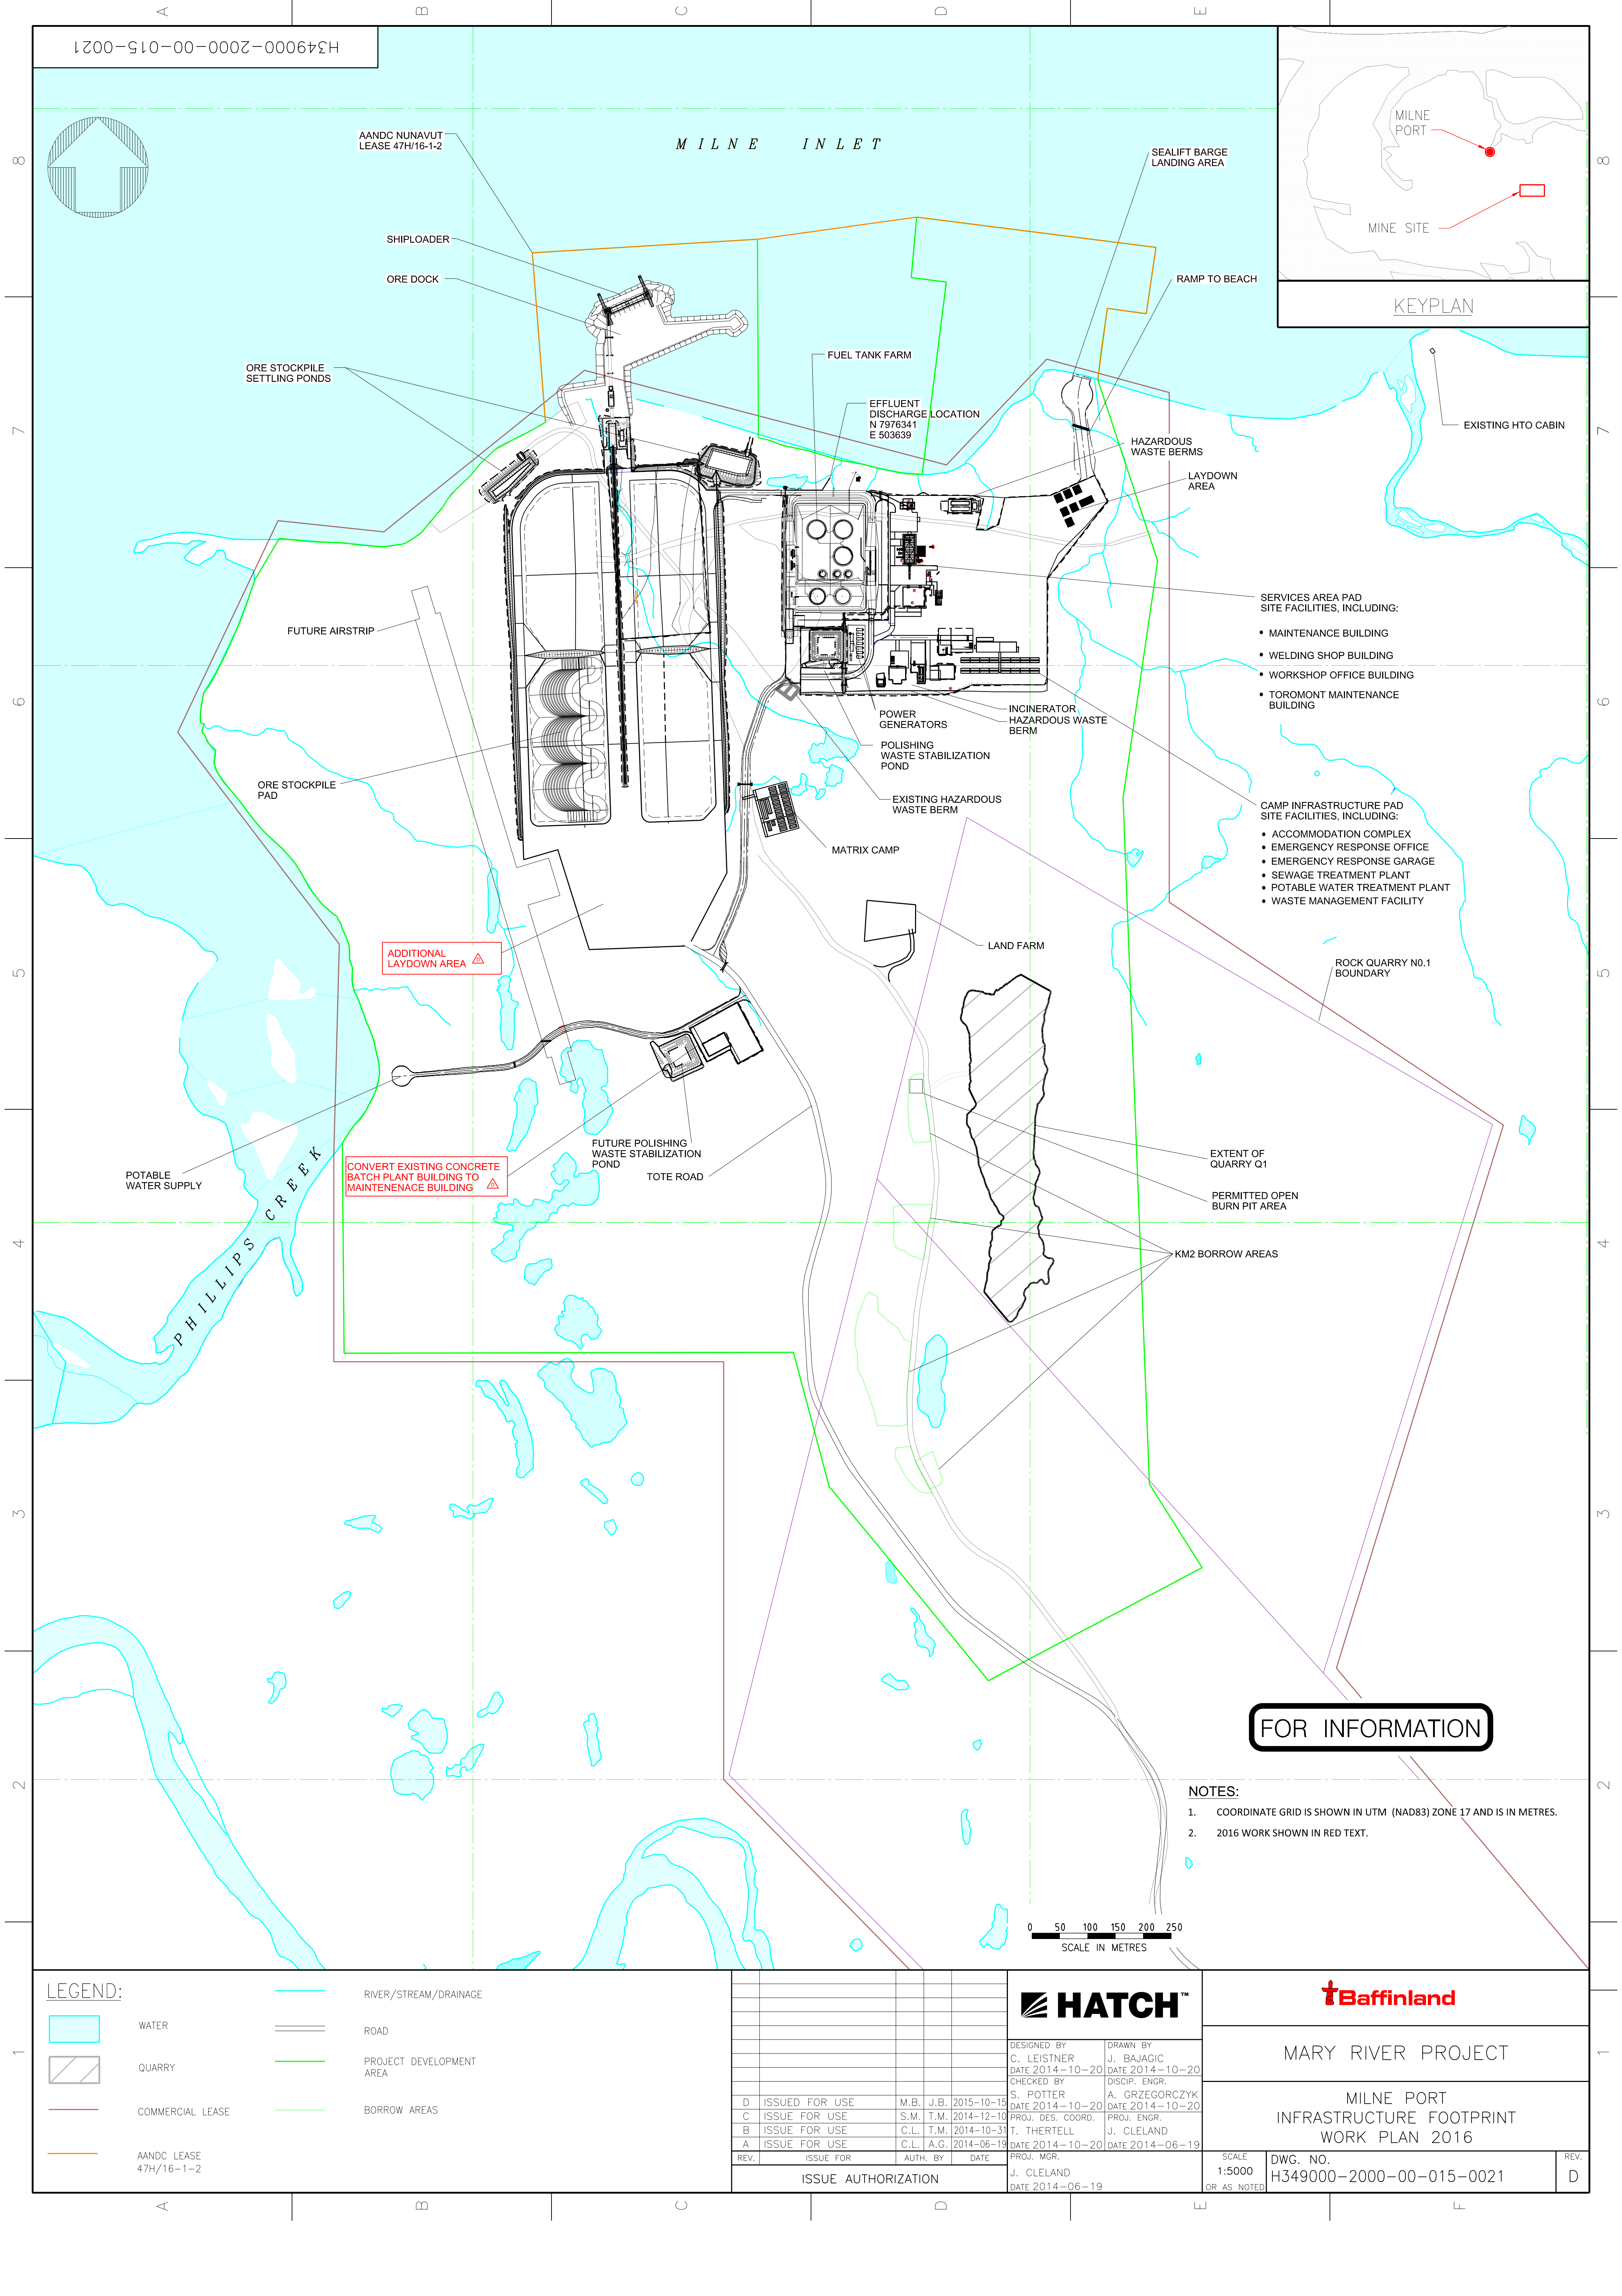

FOR INFORMATION

- NOTES:
- 1. COORDINATE GRID IS SHOWN IN UTM (NAD83) ZONE 17 AND IS IN METRES.
 - 2. 2016 WORK SHOWN IN RED TEXT.


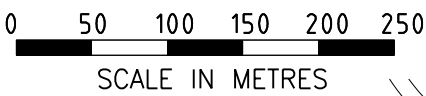


LEGEND:

	RIVER/STREAM/DRAINAGE
	ROAD
	PROJECT DEVELOPMENT AREA
	BORROW AREAS
	QUARRY
	COMMERCIAL LEASE
	AANDC LEASE 47H/16-1-2

DESIGNED BY C. LEISTNER DATE 2014-10-20		DRAWN BY J. BAJAGIC DATE 2014-10-20	
CHECKED BY S. POTTER DATE 2014-10-20		DISCIP. ENGR. A. GRZEGORCZYK DATE 2014-10-20	
PROJ. DES. COORD. T. THERTELL DATE 2014-10-20		PROJ. ENGR. J. CLELAND DATE 2014-06-19	
PROJ. MGR. J. CLELAND DATE 2014-06-19			
REV.	ISSUE FOR	AUTH. BY	DATE
D	ISSUED FOR USE	M.B. J.B.	2015-10-15
C	ISSUE FOR USE	S.M. T.M.	2014-12-10
B	ISSUE FOR USE	C.L. T.M.	2014-10-31
A	ISSUE FOR USE	C.L. A.G.	2014-06-19
ISSUE AUTHORIZATION			

MARY RIVER PROJECT	
MILNE PORT INFRASTRUCTURE FOOTPRINT WORK PLAN 2016	
SCALE 1:5000 OR AS NOTED	DWG. NO. H349000-2000-00-015-0021
REV. D	

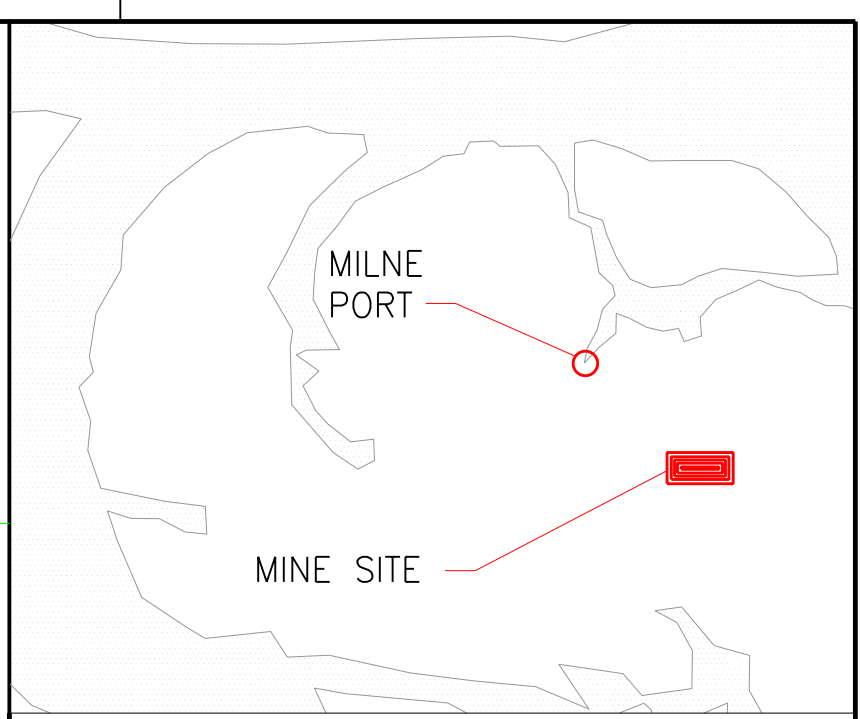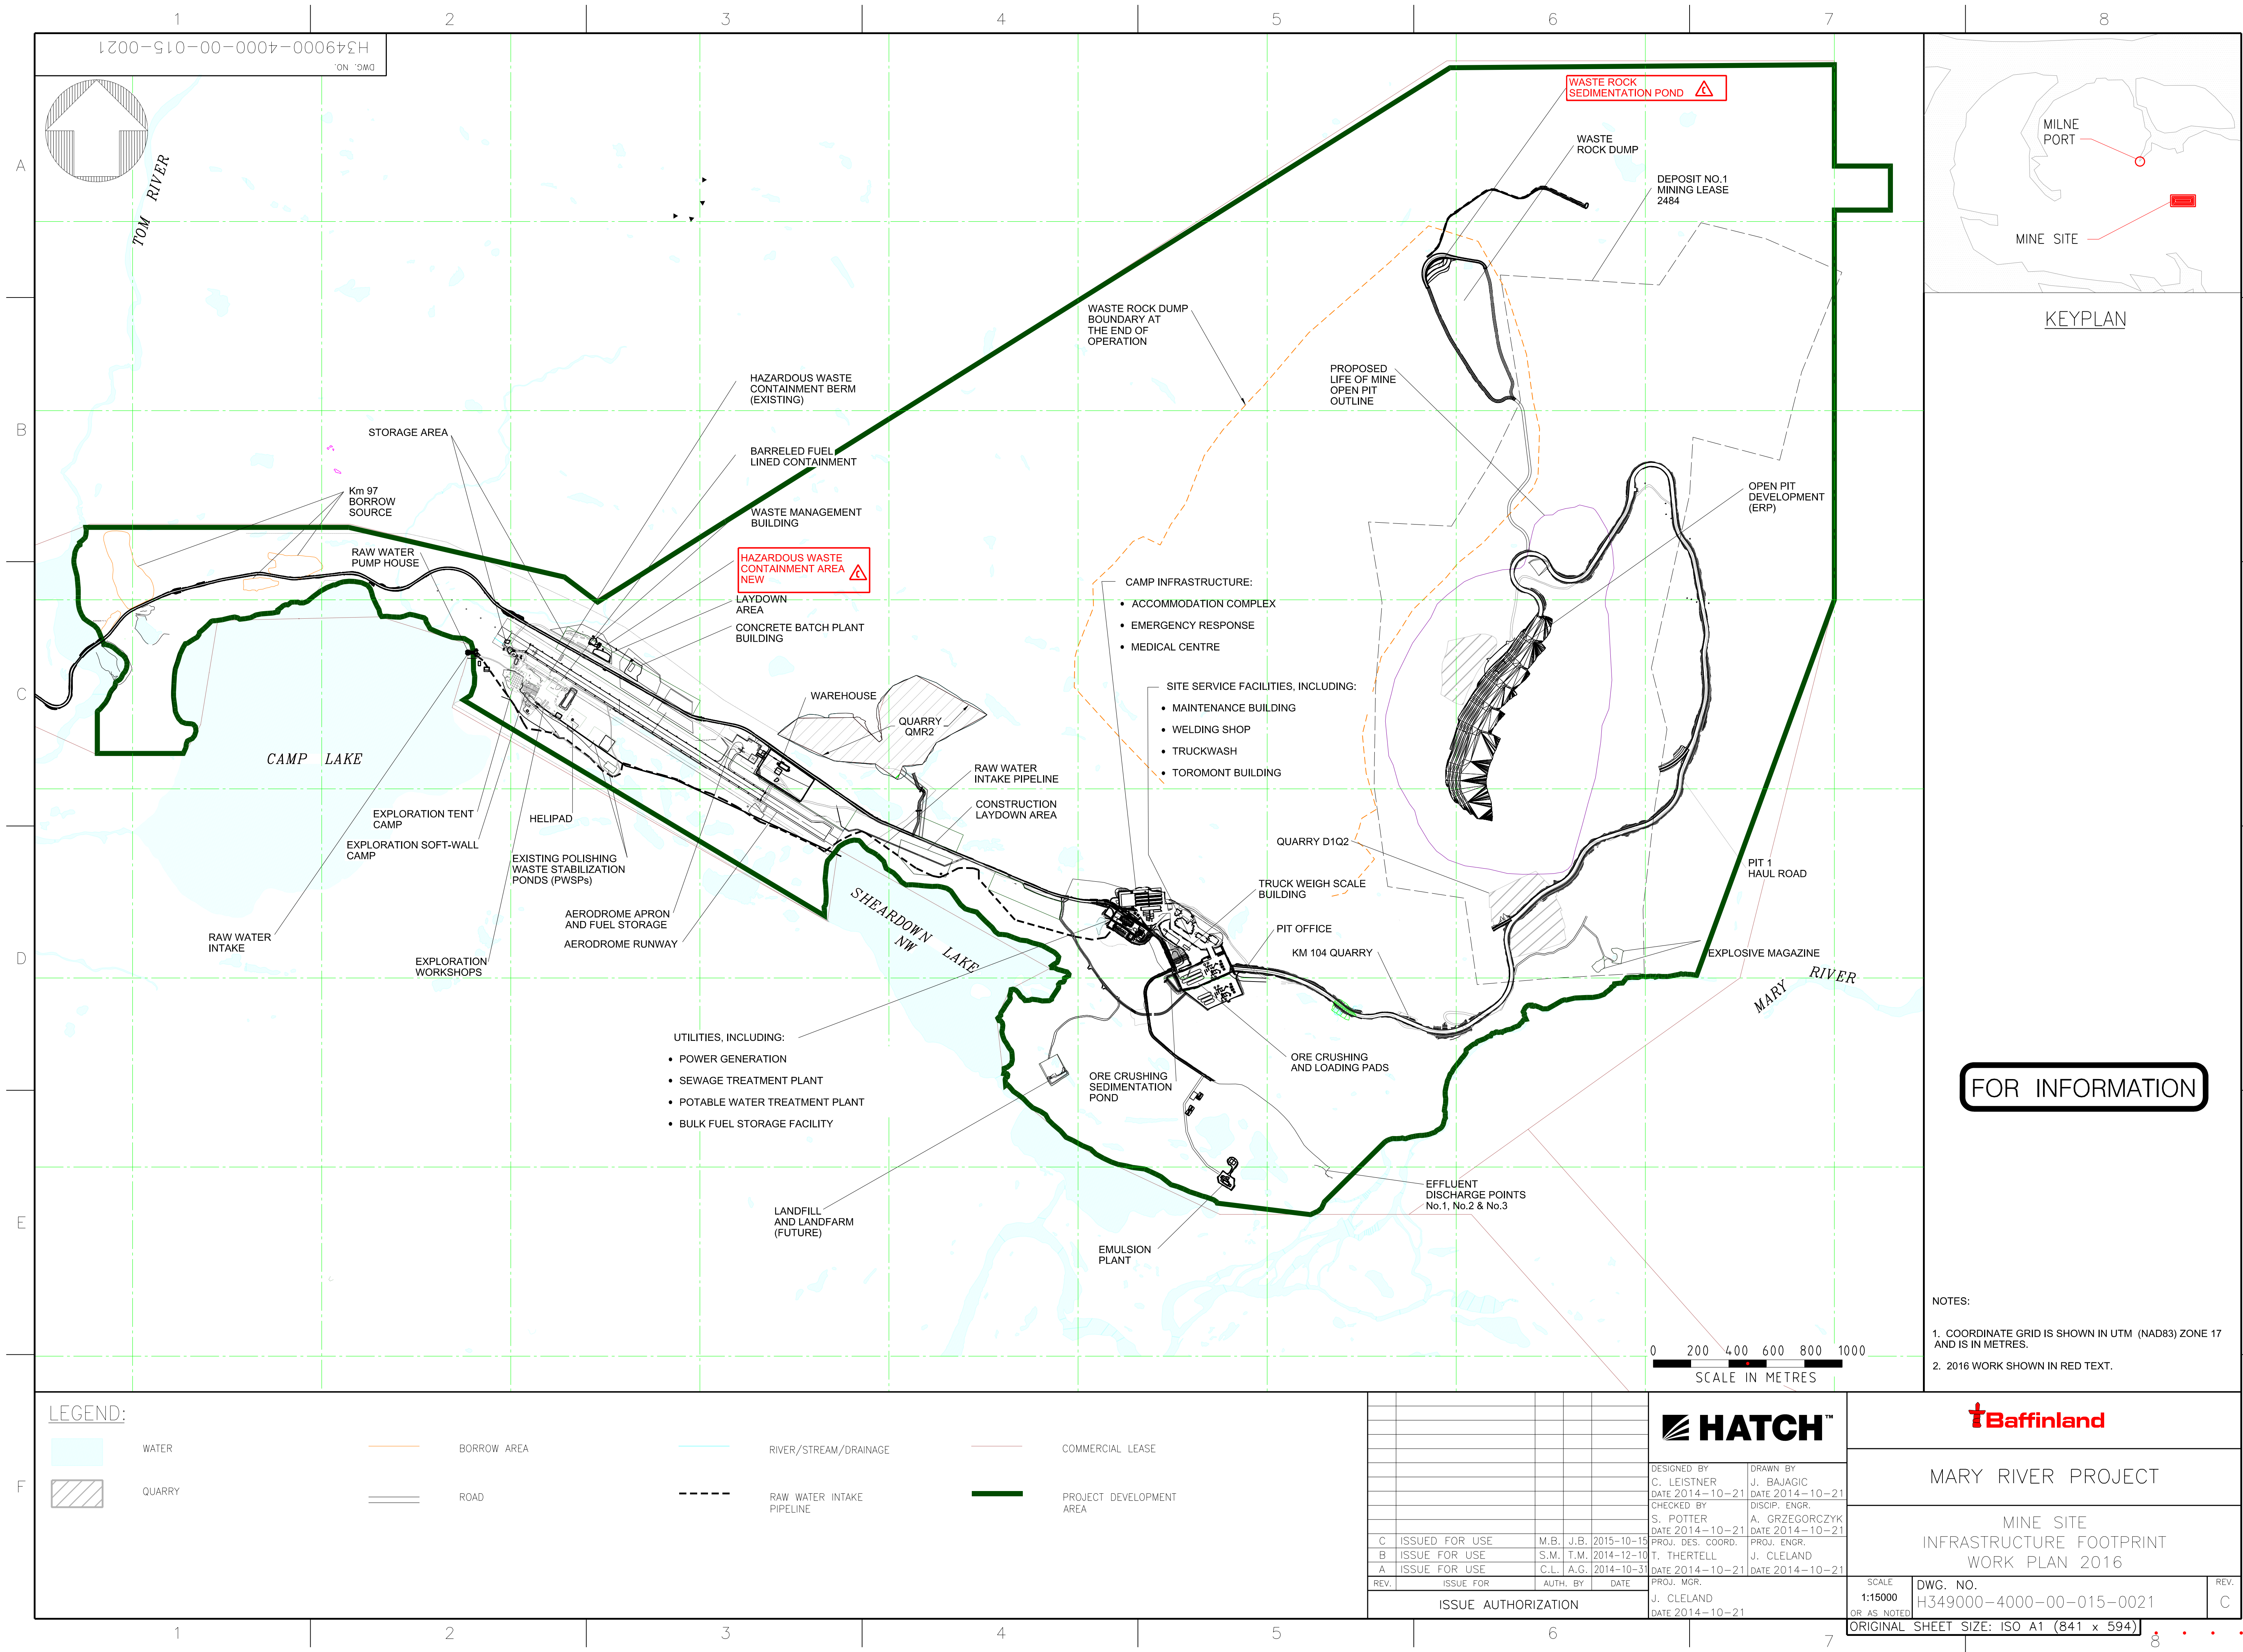

FOR INFORMATION

NOTES:
1. COORDINATE GRID IS SHOWN IN UTM (NAD83) ZONE 17 AND IS IN METRES.
2. 2016 WORK SHOWN IN RED TEXT.

LEGEND:

- | | | | | | | | |
|--|--------|--|-------------|--|---------------------------|--|--------------------------|
| | WATER | | BORROW AREA | | RIVER/STREAM/DRAINAGE | | COMMERCIAL LEASE |
| | QUARRY | | ROAD | | RAW WATER INTAKE PIPELINE | | PROJECT DEVELOPMENT AREA |



MARY RIVER PROJECT

MINE SITE
INFRASTRUCTURE FOOTPRINT
WORK PLAN 2016

DESIGNED BY	C. LEISTNER	DATE	2014-10-21
DRAWN BY	J. BAJAGIC	DATE	2014-10-21
CHECKED BY	S. POTTER	DATE	2014-10-21
PROJ. DES. COORD.	T. THERTELL	DATE	2014-10-21
PROJ. ENGR.	J. CLELAND	DATE	2014-10-21
PROJ. MGR.	J. CLELAND	DATE	2014-10-21
ISSUE FOR	M.B. J.B.	2015-10-15	
ISSUE FOR	S.M. T.M.	2014-12-10	
ISSUE FOR	C.L. A.G.	2014-10-31	
REV.	ISSUE FOR	AUTH. BY	DATE

ISSUE AUTHORIZATION

DWG. NO.
H349000-4000-00-015-0021

ORIGINAL SHEET SIZE: ISO A1 (841 x 594)

00045702
3/20/2015 9:49:01 AM
c:\p\projectwise\ba045702\pw_idc_data\source\mrs88660\H349000-4000-00-015-0021.dgn