

## Baffinland Iron Mines LP Mary River Expansion Project

### Construction Summary Report: Mary River Tank Farm (2019)

PERMIT TO PRACTICE	
HATCH LTD.	
Signature	<i>G. Peace</i>
Date	<i>APRIL 7, 2020</i>
PERMIT NUMBER: P 512	
The Association of Professional Engineers, Geologists and Geophysicists of NWT/NU	



			<i>G. Peace</i>	<i>N. Mason</i>	<i>N. Mason</i>	-
2020-04-07	0	Approved for Use	G. Peace	N. Mason	N. Mason	D. Henkelman
Date	Rev.	Status	Prepared By	Checked By	Approved By	Approved By
HATCH						Client

## Table of Contents

<b>1. Facility Description .....</b>	<b>1</b>
1.1 Purpose and Design Basis .....	1
1.2 Location and Base Elevations .....	2
1.3 Geometry and Access .....	2
1.4 Earthworks Materials Details .....	2
<b>2. Construction Activity Summary .....</b>	<b>2</b>
2.1 Preparation of the Containment Area .....	2
2.2 Fuel Tank .....	3
<b>3. QA/QC .....</b>	<b>3</b>
<b>4. Photographic Records .....</b>	<b>4</b>
<b>5. As-built Drawings .....</b>	<b>9</b>
<b>6. Field Decisions .....</b>	<b>10</b>
<b>7. Performance Evaluation .....</b>	<b>10</b>
<b>8. Vibration Monitoring and Quarrying Activity .....</b>	<b>10</b>
<b>9. Environmental Monitoring .....</b>	<b>11</b>
<b>10. Earthworks Data .....</b>	<b>11</b>
<b>11. Unanticipated Observations .....</b>	<b>11</b>
<b>12. Surface Monitoring .....</b>	<b>12</b>
<b>13. Required Maintenance .....</b>	<b>12</b>
<b>14. Adaptive Management .....</b>	<b>12</b>
<b>15. Concordance with Type “A” Water Licence .....</b>	<b>12</b>
<b>16. Concordance with Commercial Lease Requirements .....</b>	<b>13</b>

### *List of Tables*

Table 5-1: As-built Drawing List .....	9
Table 15-1: Concordance with Type “A” Water Licence .....	12
Table 16-1: Concordance with Commercial Lease Requirements .....	13

### *List of Photos*

Photo 4-1: Early Earthworks .....	4
Photo 4-2: Preparing Pad for Tank 005 .....	5
Photo 4-3: Pad for Tank 005 .....	5
Photo 4-4: Tank 005 Construction in Progress .....	6

Photo 4-5: Tank 005 Fourth Ring Installed .....	6
Photo 4-6: Liner Installation (remaining area).....	7
Photo 4-7: Earthworks Including One Sump.....	7
Photo 4-8: Aerial of Tank Farm.....	8
Photo 4-9: Aerial Closer View .....	8

### ***List of Appendices***

#### **Appendix A**

As-builts

#### **Appendix B**

Earthworks and Secondary Containment

#### **Appendix C**

Tank 005

#### **Appendix D**

Contact Information as per Components 1 and 2 of the Commercial Lease Requirement

#### **Appendix E**

Map to Show Construction in Relation to Lease Boundaries and Water Bodies

#### **Appendix F**

CCME Code Compliance Review

#### **Appendix G**

Geotechnical Investigation and Geotechnical Inspections 2018 Mine Site Geotechnical  
Investigation Report H353004-10000-229-230-0006

## **1. Facility Description**

### **1.1 Purpose and Design Basis**

Baffinland Iron Mines Corporation (Baffinland) recently added a new fuel storage area at the Mary River mine site. A 15-million-litre above ground diesel fuel storage tank was constructed along with a containment area to allow for future expansion. This tank is in addition to the existing 2 million litres of storage in the previously constructed tank farm at Mary River.

The initial Mary River tank farm consisted of four (4) 500,000-litre above ground diesel fuel storage tanks.

This current report summarizes the new 15-million-litre tank constructed inside a new containment area. This report does not cover the piping, electrical and instrumentation other than what was required to allow filling of the tank. This is covered in Construction Summary Report: "Mary River Tank Farm (2019) Piping and Electrical" (H353004-10000-430-066-0004).

The new tank is a vertical single wall steel construction tank designed to API 650. It has been inspected and tested to API Section 8 which includes visual inspection of all welds, vacuum box test of welds, liquid penetration testing, magnetic particle testing and ultrasonic tests (UT) as required. In lieu of hydrostatic testing, additional liquid penetration tests and vacuum box tests have been completed in accordance with API 650 Section 7.3.5. Complete information on inspection and testing for each tank is contained in the tank "Data Book" referenced in Appendix C.

The following documents were utilized in the design and construction of the Mary River tank Farm:

- H353004-10000-240-210-0001 Design Criteria Mary River Mine Site Fuel Storage Facility.
- H353004-00000-200-210-0001 Civil Design Philosophy.
- H349000-1000-10-122-0001 Civil Design Criteria.

The secondary containment dyke is designed and constructed to the requirements of the National Fire Code of Canada.

The facility was designed and constructed to the following codes and standards:

- Tank construction will adopt the API 650 12<sup>th</sup> Edition, 2013, Welded Steel tanks for Oil Storage.
- Tank inspection, repair, alteration and reconstruction will use API 653 4<sup>th</sup> Edition, 2009; including Addendums 1 and 2.
- National Building Code of Canada (NBC) 2010.



- National Fire Code of Canada (NFCC) 2010.
- NFPA 30, 2012 Edition, Flammable and Combustible Liquids Code.
- CCME Environmental Code of Practice for Aboveground Storage Tank Systems containing Petroleum Products, 2003.
- ANSI B31.3-2012, Process Piping.
- CSA W47.1-09, Certification of Companies for Fusion Welding of Steel.
- CSA W59-03 (R2008) – Welded Steel Construction (Metal Arc Welding).
- Canadian Environmental Protection Act 1999 (2008 Update), Storage Tank System for Petroleum Products and Allied Petroleum Products Regulations.
- CSA W178.2-08, Certification of Welding Inspectors.

## **1.2 Location and Base Elevations**

The new Mary River Tank Farm is located on the north side of the tote road, northeast of the Sailiivik Camp between northing N7913385 and N7913535, and easting E560953 and E561212. The 15-million-litre tank (TK-005) setting out point (center of tank) is Northing N7913435.039, Easting E561129.825, elevation 187.101 m.

## **1.3 Geometry and Access**

The containment area and access was constructed as shown on the as-built drawings.

## **1.4 Earthworks Materials Details**

The containment area around the tank farm has been constructed with raised earthworks and welded geomembrane liner for the containment of spills. Additionally, the facility is designed for containment of rainwater and snowmelt that can potentially be contaminated by contact with fuel originating from leakage or spills. Contact water is removed and treated if required before it is discharged to the receiving environment.

The liner is buried 300 mm below the floor as shown on as-built drawings.

## **2. Construction Activity Summary**

Construction activities for the 15 million litre tank and containment started April 18, 2019, and were completed on August 9, 2019.

The following summarizes construction activities:

### **2.1 Preparation of the Containment Area**

- Existing ground was rough excavated to subgrade elevation.
- Areas below subgrade elevation were filled with type 8 material.
- Fill material was sourced from existing stockpiles.

- A layer of geotextile was placed.
- Type 5 material was placed and compacted.
- Type 6 material was placed in the area under the tank pads followed by insulation.
- Type 9 material was placed on the complete floor followed by geotextile, liner and another layer of geotextile. The geotextile and liner was also placed under the area for a new fuel module and sloped so that any spill would drain into the containment area.
- Type 6 material was placed on the geotextile, followed by type 5.
- One new earthwork tank foundation pad (for Tank 005) was constructed along with an access ramp for access to the tank farm as detailed in the as-built drawings.
- Two drainage sumps were constructed in the drainage area.
- Dykes were constructed and the final layer of Type 7 was placed on the floor of the tank farm.
- Tank grounding system for Tank 005 and possible future Tank 006 was installed in conjunction with earthworks.
- The perimeter fencing was installed.

## **2.2 Fuel Tank**

- Installed fuel tank body.
- Installed piping vents and drain assemblies.
- Installed pressure relief valves, piping and gate valve assemblies.
- Installed tank emergency vent/gauge hatch.
- Installed radar gauge assembly and components.
- Installed miscellaneous bolting, gaskets for valves and piping required to allow the tank to be filled.
- Installed tank obstruction light.
- Installed tank/stairway station and light fixture.
- Tested and calibrated tank level gauges and display units.

## **3. QA/QC**

Quality Assurance (QA) was performed by the Hatch Construction Supervisor during daily audits with the Nuna Supervisor during the construction of the containment area. Quality Surveillance Inspection Acceptance and Sign-off Reports were prepared by the Nuna

Supervisor and signed off by the Hatch Representative. Quality reports for the geomembrane liner installation are included with the other quality reports referenced in Appendix B.

QA was also performed by the Hatch Construction Supervisor during daily audits with the Laframboise Supervisor during the erection and placement of the fuel tank. The new tank was inspected and tested to API Section 8 which includes visual inspection of all welds, vacuum box test of welds, liquid penetration testing, magnetic particle testing and UT tests as required. In lieu of hydrostatic testing, additional liquid penetration tests and vacuum box tests have been completed in accordance with API 650 Section 7.3.5. Complete information on inspection and testing for the tank is contained in the document "TK 005 Arctic Fuel Diesel History Document" referenced in Appendix C.

#### **4. Photographic Records**



**Photo 4-1: Early Earthworks**



**Photo 4-2: Preparing Pad for Tank 005**



**Photo 4-3: Pad for Tank 005**





**Photo 4-4: Tank 005 Construction in Progress**



**Photo 4-5: Tank 005 Fourth Ring Installed**



**Photo 4-6: Liner Installation (remaining area)**



**Photo 4-7: Earthworks Including One Sump**



**Photo 4-8: Aerial of Tank Farm**



**Photo 4-9: Aerial Closer View**

## 5. As-built Drawings

The as-built drawings incorporate contractor red line markups, field instructions, requests for information, field sketches and all other inputs provided by the EPCM field team. As-built drawings are attached in Appendix A. These drawings are representative of the final as-built conditions.

**Table 5-1: As-built Drawing List**

Drawing Number	Title	Revision
H353004-10000-220-260-0002-0001	Mine Site Tank Farm Dyke Miscellaneous Details	1
H353004-10000-220-272-0009-0001	Mine Site Tank Farm Grading Plan	2
H353004-10000-220-272-0010-0001	Mine Site Tank Farm Layout and Grading Points	2
H353004-10000-220-272-0011-0001	Mine Site Tank Farm Subgrade Plan	1
H353004-10000-220-272-0012-0001	Mine Site Tank Farm Subgrade Layout and Grading Points	1
H353004-10000-220-273-0001-0001	Mine Site Tank Farm Dyke Sections A to D	2
H353004-10000-220-273-0002-0001	Mine Site Tank Farm Dyke Sections E & F	2
H353004-10000-220-273-0003-0001	Mine Site Tank Farm Dyke Sections G & H	1
H353004-10000-220-273-0004-0001	Mine Site Tank Farm Dyke Sections and Details	1
H353004-10000-220-273-0006-0001	Mine Site Tank Farm Sections Thru Truck Loading/Offloading	1
H353004-10000-221-294-0006-0001	Site Wide Standard Drawing Earthworks and Drainage Details	1
H353004-10000-240-272-0002-0001	Mine Site Tank Farm General Arrangement	3
H353004-10000-240-272-0003-0001	Mine Site Tank Farm Enlarged Piping Plan	2
MRTF Pedestal Insulation Tanks 5 & 6 & 7 2019 (Nuna)	Mary River Tank Farm Pedestal Foundation Insulation	
CC005-0001A-MRTF Final Asbuilt (Nuna)	Mary River Tank Farm Final Asbuilt Aug 15, 2019	
CAB 190903 MRTF Tk 5 & 6 Grnd Cables Rods & Pipe Crossing	Mary River Tank Farm Ground Grid and Rods Asbuilt 2019	
C-70942-LG-31 (Laframboise)	15,000,000 L Arctic Diesel Storage Tank General Arrangement	1
C-70942-LG-52 (Laframboise)	15,000,000 L Arctic Diesel Storage Tank Roof Plates Layout	0
C-70942-LG-51 (Laframboise)	15,000,000 L Arctic Diesel Storage Tank Orientation, Nozzles Description	0
C-70942-LG-53 (Laframboise)	15,000,000 L Arctic Diesel Storage Tank Shell Plates Layout	0



## 6. Field Decisions

The following section describes field decisions made during construction:

- The design specified two layers of 38 mm board insulation under the tank pedestals. In order to utilize on site material two layers of 50 mm insulation were installed with the fill below the insulation reduced to 176 mm from 200 mm to accommodate for the thicker insulation.
- The design specified 100 mm of type 5 material above the bottom most layer of geotextile in the area of the tank pedestals and 200 mm of type 5 above the bottom most layer of geotextile for the tank farm floor. For construction purposes this was changed to 200 mm of type 5 material throughout.
- The design specified use of type 6 material above and below the board insulation. Due to the limited availability of type 6 and the availability and suitability of type 9 material, type 9 material was substituted.
- The design specified use of type 6 material above and below the geotextile/liner/geotextile installation. Due to the limited availability of type 6 and the availability and suitability of type 9 material, type 9 material was substituted.
- The tank pedestal capping was modified to accommodate the tank manufacturer. This included creating a 1.835 m flat section at the center of the pedestal and a 0.071 m increase in the elevation at the center of the tank and 0.074 increase in the elevation at the edge of the tank.
- The exterior slope of the dyke was overbuilt to accommodate equipment access for Key Trench excavation.

## 7. Performance Evaluation

Prior to erection of the tank a detailed survey was conducted to ensure the suitability of the pedestal. Minor corrections were made and the survey repeated. The survey results were reviewed and accepted by Hatch and the tank erector.

A leak has developed in a 1" socket weld on the piping at the tank. An in situ repair has been completed. The amount of diesel fuel leaked was a very small quantity (estimated at 10 ml per day) and was contained with no diesel fuel actually being spilled.

## 8. Vibration Monitoring and Quarrying Activity

No vibration monitoring was conducted during the construction of this work as it was not deemed necessary based on the scope of activities required for construction.

Material for the containment area and tank pads was obtained from existing stockpiles, therefore there were no specific quarrying activities conducted.

## 9. Environmental Monitoring

Baffinland Environment was responsible for environmental monitoring at the site during this work and following-up with construction if there were any reported environmental incidents or non-conformances. Environmental monitoring during the construction of the Mary River Tank Farm was conducted as per the Environmental Protection Plan (EPP), Baffinland document number BAF-PH1-830-P16-0008.

The Spill Contingency Plan (BAF-PH1-830-P16-0036), in conjunction with the Emergency Response Plan (BAF-PH1-830-P16-0007), provides guidance and instructions for first responders and Baffinland Management in the event of a spill event or other emergency such as fire or accident.

The risks to the environment as a result of construction activity for this work would originate from spills from equipment. There were no spills reported.

Compliance with CCME is included in Appendix E.

## 10. Earthworks Data

Completion surveys were conducted for each material required to build the fuel tank farm containment. Nuna's completion of construction report for the Mine Site Tank Farm (E353004-CC005-130-066-0004) includes this information in Section 4 in Appendix B.

Two geotechnical inspections (late June and late September) were conducted in 2019 by a 3rd party, independent, Nunavut certified engineer under Part D, Section 19 of Type "A" Water Licence 2AM-MRY1325. The inspection is inclusive of waste containment structures at the Mary River Mine Site and Milne Port site including the new Mine Site fuel tank farm containment. The inspector noted in Section 2.5 c of the late June report, "Based on our field review the tank farm is constructed as specified in the design drawings (subgrade, berms, bedding layer, liner and protective cover). In the late September report under Section 2.5 c it was noted that "The tank farm's new containment earthen structure did not exhibit any signs of instability, including seepage. Based on field observations it appears that the geosynthetic liner component of the structure has received protective soil cover throughout." The Annual Geotechnical Investigation Reports – 2019 are provided in Appendix G.

A geotechnical investigation was conducted in 2018 for the Mary River Mine Site which included the proposed Mary River Tank Farm location and provided recommendations. Reference report H353004-10000-229-230-0006 "2018 Mine Site Geotechnical Investigation Report". This report is also provided in Appendix G.

## 11. Unanticipated Observations

Not applicable.

## 12. Surface Monitoring

Not applicable.

## 13. Required Maintenance

Not applicable.

## 14. Adaptive Management

Construction changes were managed through issue of Engineering Change Notices (ECNs) for changes to the design and through Requests For Information (RFIs) for changes requested by the Contractor.

For discussion of adaptive management principles and practices applied and their overall effectiveness please refer to the Annual Reports to the Nunavut Water Board and the Nunavut Impact Review Board.

## 15. Concordance with Type “A” Water Licence

Baffinland's Type A Water Licence, Schedule D, outlines the requirements for Construction Summary/Monitoring Reports. Table 15-1 provides a concordance of this report with the requirements of Schedule D.

**Table 15-1: Concordance with Type “A” Water Licence**

Schedule D Item No.	Schedule D Description	Corresponding Section in this Report
1a	Description of all infrastructure and facilities designed and constructed to contain, withhold, divert or retain Water and/or Waste;	1
1b	A summary of construction activities including photographic records before, during and after construction of the facilities and infrastructure designed to contain, withhold, divert or retain Water and/or Waste;	2, 3, 4
1c	As-built drawings and design for facilities and infrastructure, in Item 1(a) of this schedule, designed and constructed to contain, withhold, divert or retain Water and/or Waste;	5
1d	Documentation of field decisions that deviate from the original plans and any data used to support or developed facilities and infrastructure to withhold, divert or retain Water and/or Waste;	6
1e	A comparison of measured versus predicted performance of infrastructure and facilities;	7
1f	Any blast vibration monitoring and control for quarrying activity carried out in close proximity to fish bearing waters;	8
1g	Monitoring conducted for sediment and explosives residue release from construction areas;	9
1h	Monitoring undertaken in accordance with Part D of the Licence during the Construction Phase of the Project;	8, 9
1i	Details confirming that the requirements of the CCME guidance document entitled “Aboveground Storage Tank Systems for Petroleum and Allied Petroleum Products (2003)” have been met by the Licensee;	Appendix E

Schedule D Item No.	Schedule D Description	Corresponding Section in this Report
1j	Data collected from instrumentation used to monitor earthworks and the interpretation of that data;	10
1k	A discussion of any unanticipated observations including changes in risk and mitigation measures implemented to reduce risk during construction;	11
1l	An overview of any method including frequency used to monitor deformations, seepage and geothermal responses;	12
1m	A summary of maintenance work undertaken as a result of settlement or deformation of dikes and dams;	13
1n	A summary of adaptive management principles and practices applied during the relevant phases of the Project and their overall effectiveness.	14

## 16. Concordance with Commercial Lease Requirements

Table 16-1 provides a concordance of this report with the requirements of the Commercial Lease for As-built reporting.

**Table 16-1: Concordance with Commercial Lease Requirements**

Component	Minimum Information Requirements	Corresponding Section in this report
1	The name and contact information of the person and company responsible for completing the construction, construction monitoring and preparing the As-built Report	Appendix D
2	The name and contact information of the Baffinland representatives(s) that QIA can contact should it have any questions or comments regarding the As-built Report	Appendix D
3	An introduction to the infrastructure or facilities including but not limited to the construction background, concept and construction history	1,2
4	Construction records including As-built drawings signed and stamped by a professional engineer detailing surveys, planar and cross sections that illustrate all designed components. This should be provided in PDF format and if requested the native file (e.g. CAD, .dxf, etc.)	Appendix A Appendix B Appendix C
5	Detailed description of any deviations from the For Construction Design. Deviations that should be noted include, but are not limited to, changes in design and construction materials, construction methodology or monitoring	6
6	Observed performance of the construction including a comparison to predicted performance. Recommendations for performance monitoring based on observations during construction if applicable	NA
7	A description and list of instrumentation installed, if applicable, and results of construction monitoring including all environmental data. Recommendations for additional performance or environmental monitoring based on observations and monitoring results, if applicable.	NA
8	A summary of quality assurance testing results, if applicable, and comparison of these results to construction/design requirements to ensure performance of the infrastructure or facilities.	3 Appendix B Appendix C
9	A summary of adaptive management principles and practices related to environmental management and monitoring applied during the relevant phases of the Project and their overall effectiveness	NA
10	Photographic records before, during and after construction of the facilities or infrastructure.	4

Component	Minimum Information Requirements	Corresponding Section in this report
11	Map(s) to illustrate the completed construction in relation to Lease boundaries and water bodies. The minimum distance from completed or modified facilities and infrastructure to the surveyed boundary of the Property, surveyed boundary of the Impact Area, and the original high water mark should be provided.	Appendix E

# **Appendix A**

## **As-builts**



# NOTES

1. DIMENSIONS IN MILLIMETERS (mm) UNLESS NOTED OTHERWISE

A







B

C

D

E

F

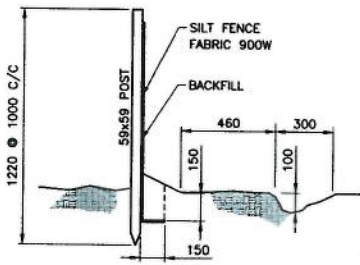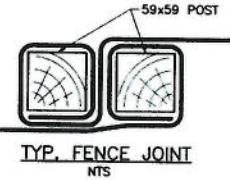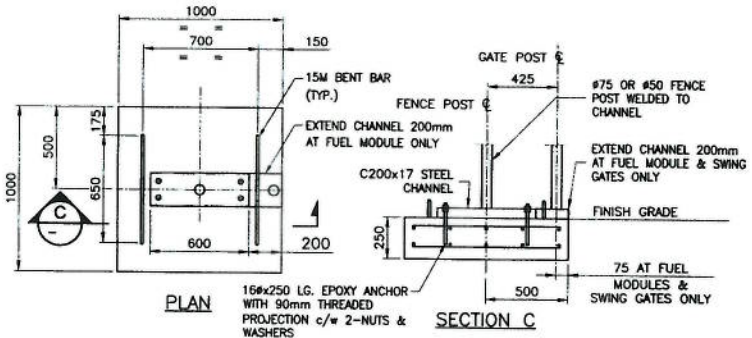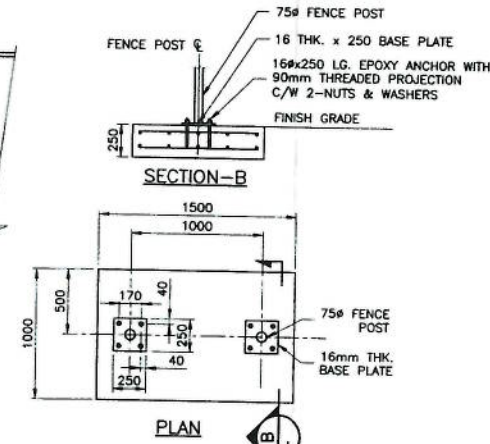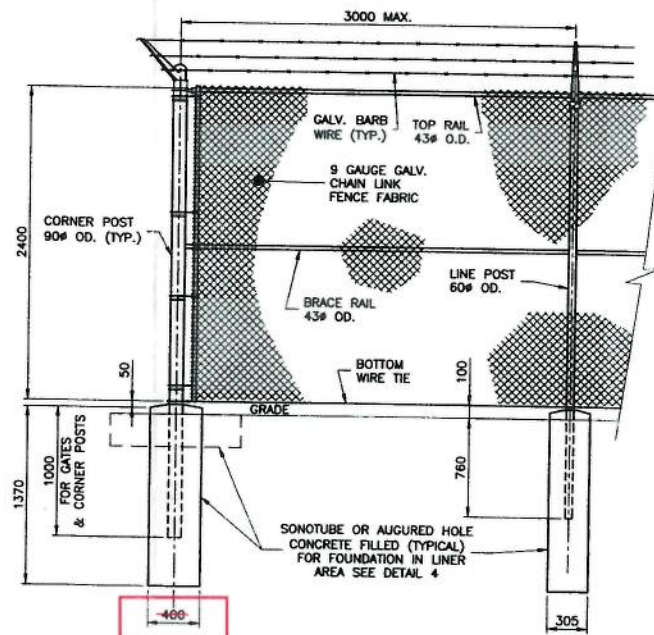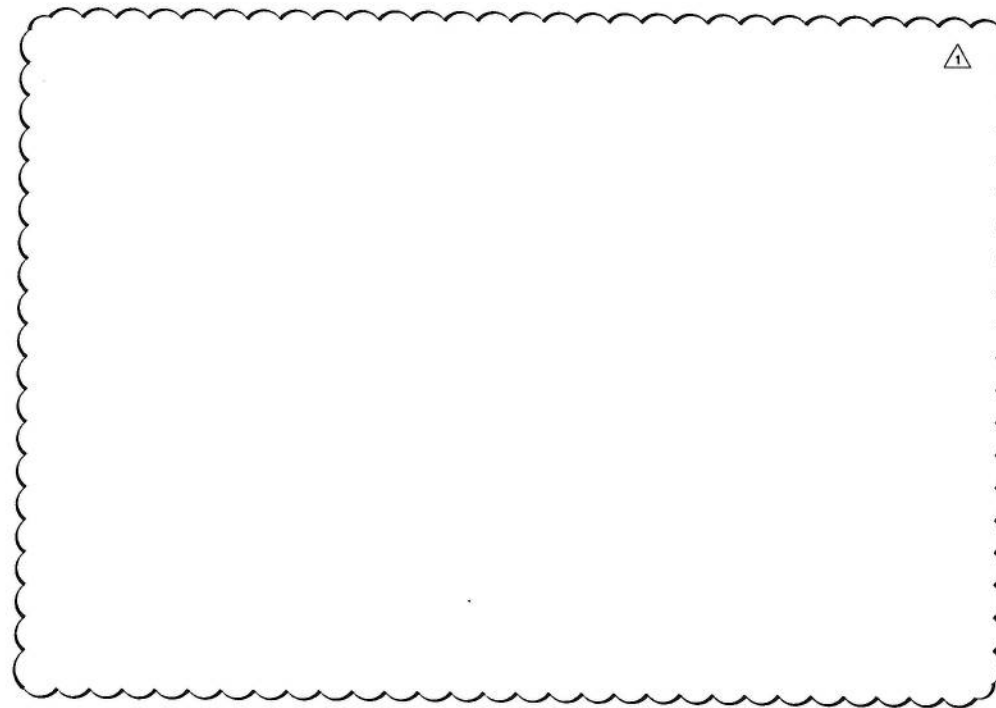

**DETAIL**  
FENCE POST BASE (IN LINER AREA ONLY)  
SCALE: 1:20

**DETAIL**  
TEMPORARY SILT FENCE DURING  
CONSTRUCTION IN RAINY SEASON  
SCALE: 1:20

Fence Post holes changed to 305mm per RFI-0013

Released for Use

**NUNA EAST LTD**  
REDLINE DRAWING

CHANGES, ADDITIONS, DELETIONS AND RELOCATIONS IN RED INK USING STANDARD SYMBOLS, DELETIONS TO BE CLOUDED AND HATCHED.

REDLINE BY: ☒ CONSTRUCTION ☐ COMMISSIONING ☐ SUSTAINMENT

NAME/SIGN: *[Signature]* COMPANY: *[Signature]*

DATE OF AS-BUILT: 9/26/19 ☐ CHECK IF NO CHANGE

CHECKED BY: *[Signature]*

NAME/SIGN: *[Signature]* COMPANY: *[Signature]*

PERMIT TO PRACTICE  
HATCH LTD.  
Signature: *[Signature]*  
Date: 19-01-18  
PERMIT NUMBER: P 512  
The Association of Professional Engineers, Geologists and Geophysicists of NWT/NU

DRAWING No.	DRAWING TITLE
H353004-10000-240-272-0002-0001	MINE SITE TANK FARM GENERAL ARRANGEMENT
H353004-10000-220-273-0001-0001	MINE SITE TANK FARM DYKE SECTIONS A TO D
H353004-10000-220-273-0001-0002	MINE SITE TANK FARM DYKE SECTIONS E & F
H353004-10000-220-273-0001-0003	MINE SITE TANK FARM DYKE SECTIONS G & H



No.	DESCRIPTION	BY	CHKD	DATE
1	DYKE ACCESS STAIR DETAIL-1 RELOCATED TO DWG H353004-10000-220-260-0003-0001	STM	KM	19/01/18
0	ISSUED FOR CONSTRUCTION	HPC	MM	18-07-25

ROLE	NAME	SIGNATURE	DATE
DRAFTSPERSON	S. SKINNER		18-07-06
DESIGNER	K. MacLEAN		18-07-06
CHECKER	M. MacINTYRE		19/01/18
DESIGN COORD.	M. MacINTYRE		19/01/18
RESP. ENG.	F. BUTTS		19/01/18
LEAD DISC. ENG.	K. MacLEAN		19/01/18
ENG. MANAGER	Glen Pearce		19/01/18
PROJ. MANAGER			
CLIENT	T. ATIBA		19/01/18

**HATCH**

**Baffinland**


MARY RIVER EXPANSION PROJECT  
BAFFINLAND IRON MINES LP

MINE SITE  
TANK FARM  
DYKE MISCELLANEOUS DETAILS


SCALE: 1:30  
DWG. No.: H353004-10000-220-260-0002-0001  
REV: 1



H353004-10000-220-272-0009-0001  
DWG. No.

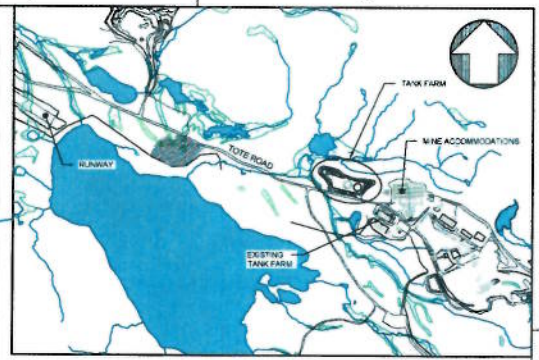

KEYPLAN  
NTS

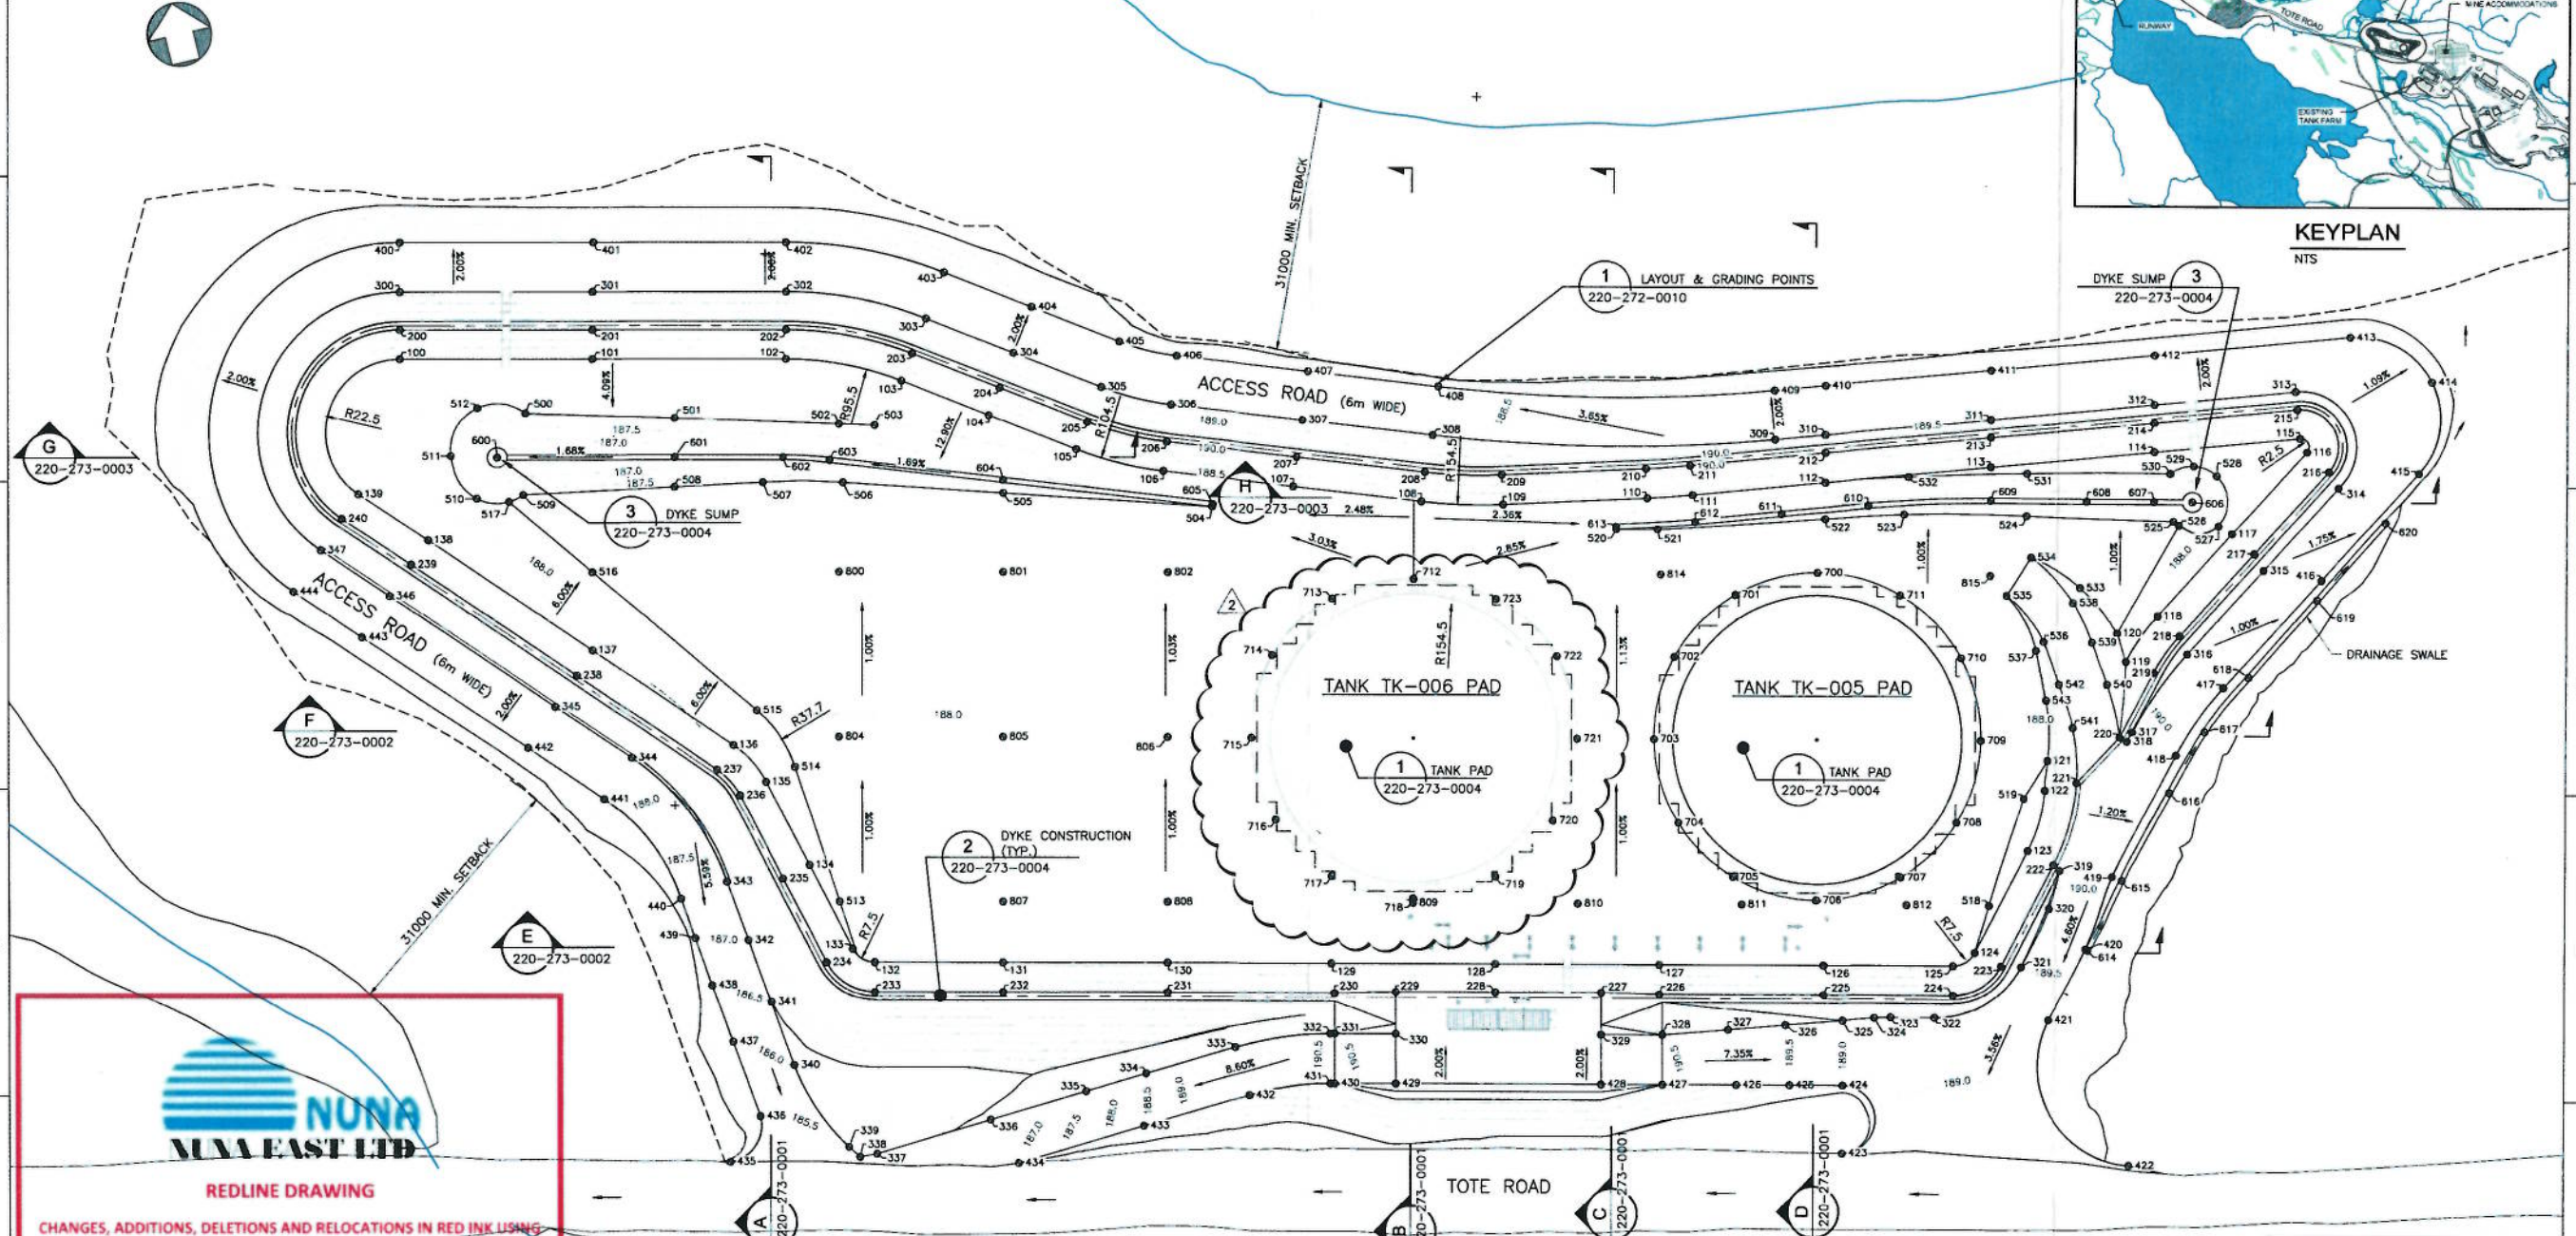

REDLINE DRAWING

CHANGES, ADDITIONS, DELETIONS AND RELOCATIONS IN RED INK USING  
STANDARD SYMBOLS, DELETIONS TO BE CLOUDED AND HATCHED.

REDLINE BY: ☒ CONSTRUCTION ☐ COMMISSIONING ☐ SUSTAINMENT

NAME/SIGN: DR. J. W. K. B. B. COMPANY: NUNA

DATE OF AS-BUILT: 7/26/19 ☐ CHECK IF NO CHANGE

CHECKED BY: R. J.

NAME/SIGN: R. J. COMPANY: NUNA

\* FOR CHANGES  
SEE OTHER PKG  
DRAWING SET  
SURVEY AS-BUILT

PLAN  
TANK FARM GRADING  
SCALE: 1:400

SCALE: 1:400  
0m 10m 20m 30m

PERMIT TO PRACTICE  
HATCH LTD.  
Signature: [Signature]  
Date: 11/02/01

PERMIT NUMBER: P 512  
The Association of Professional Engineers,  
Geologists and Geophysicists of NWT/NT

Released for Use



H353004-10000-220-272-0010-0001	MINE SITE TANK FARM LAYOUT & GRADING POINTS
H353004-10000-220-273-0004-0001	MINE SITE DYKE SECTIONS & DETAILS
H353004-10000-220-273-0003-0001	MINE SITE TANK FARM DYKE SECTION G
H353004-10000-220-273-0002-0001	MINE SITE TANK FARM DYKE SECTIONS E & F
H353004-10000-220-273-0001-0001	MINE SITE TANK FARM DYKE SECTIONS A TO D

REG. PROFESSIONAL

No.	DESCRIPTION	BY	CHKD	DATE
2	SECOND TANK PAD & GRADING POINTS ADDED			
1	DYKE ACCESS & ROAD REVISED	SS	MMI	19-01-18
0	ISSUED FOR CONSTRUCTION	SS	MMI	18-07-25

HATCH			
DRAFTSPERSON	S. SKINNER	NR	18-07-06
DESIGNER	K. MacLEAN	NR	18-07-06
CHECKER	M. MacINTYRE		17/07/01
DESIGN COORD.	M. MacINTYRE		17/07/01
RESP. ENG.	F. BUTTS		11/02/01
LEAD DISC. ENG.	K. MacLEAN		11/02/01
ENG. MANAGER	G. PEACE		19/01/04
AT/PA MANAGER	H. VENTER		19/01/05
CLIENT	T. ATIBA		19/01/05

**Baffinland**

MARY RIVER EXPANSION PROJECT  
BAFFINLAND IRON MINES LP

MINE SITE  
TANK FARM GRADING  
PLAN

SCALE: 1:400  
OR AS NOTED

DWG. No. H353004-10000-220-272-0009-0001

REV 2

SHEET SIZE: A1



H353004-10000-220-272-0010-0001  
DWG NO.

LAYOUT & GRADING POINTS				
TARGET No.	FEATURE	ELEVATION	NORTHING	EASTING
100	TOE OF DYKE	188.300	7913526.921	560972.360
101	TOE OF DYKE	188.300	7913515.359	560965.065
102	TOE OF DYKE	188.300	7913509.740	561018.002
103	TOE OF DYKE	188.300	7913503.841	561030.947
104	TOE OF DYKE	188.300	7913497.247	561040.287
105	TOE OF DYKE	188.300	7913490.852	561049.628
106	TOE OF DYKE	188.300	7913485.578	561059.282
107	TOE OF DYKE	188.300	7913480.100	561074.141
108	TOE OF DYKE	188.300	7913474.624	561089.000
109	TOE OF DYKE	188.300	7913471.948	561098.569
110	TOE OF DYKE	188.300	7913468.607	561115.743
111	TOE OF DYKE	188.300	7913467.681	561121.230
112	TOE OF DYKE	188.300	7913465.383	561137.258
113	TOE OF DYKE	188.300	7913462.532	561157.151
114	TOE OF DYKE	188.300	7913459.650	561177.044
115	TOE OF DYKE	188.300	7913457.160	561194.825
116	TOE OF DYKE	188.300	7913455.343	561195.045
117	TOE OF DYKE	188.300	7913447.798	561183.924
118	TOE OF DYKE	188.300	7913440.253	561172.804
119	TOE OF DYKE	188.300	7913435.730	561167.785
120	TOE OF DYKE	187.895	7913439.355	561167.528
121	TOE OF DYKE	188.050	7913428.311	561155.815
122	TOE OF DYKE	188.207	7913422.856	561154.444
123	TOE OF DYKE	188.300	7913418.180	561150.680
124	TOE OF DYKE	188.300	7913405.728	561141.546
125	TOE OF DYKE	188.300	7913404.788	561138.573
126	TOE OF DYKE	188.300	7913408.523	561123.329
127	TOE OF DYKE	188.300	7913413.281	561103.904
128	TOE OF DYKE	188.300	7913418.040	561084.478
129	TOE OF DYKE	188.300	7913422.798	561065.052
130	TOE OF DYKE	188.300	7913427.557	561045.627
131	TOE OF DYKE	188.300	7913432.318	561028.201
132	TOE OF DYKE	188.300	7913436.050	561010.957
133	TOE OF DYKE	188.300	7913435.297	561008.755
134	TOE OF DYKE	188.300	7913440.312	561006.078
135	TOE OF DYKE	188.300	7913450.367	561003.368
136	TOE OF DYKE	188.300	7913485.640	561000.590
137	TOE OF DYKE	188.300	7913490.906	560998.628
138	TOE OF DYKE	188.300	7913498.663	560970.384
139	TOE OF DYKE	188.300	7913508.105	560983.578
200	TOP OF DYKE	190.100	7913524.417	560973.216
201	TOP OF DYKE	190.100	7913518.855	560995.922
202	TOP OF DYKE	190.100	7913513.237	561018.858
203	TOP OF DYKE	190.100	7913506.782	561033.024
204	TOP OF DYKE	190.100	7913500.187	561042.383
205	TOP OF DYKE	190.100	7913493.593	561051.702
206	TOP OF DYKE	190.100	7913488.954	561060.527
207	TOP OF DYKE	190.100	7913483.478	561075.388
208	TOP OF DYKE	190.100	7913478.002	561090.245
209	TOP OF DYKE	190.100	7913475.482	561099.258
210	TOP OF DYKE	190.100	7913472.141	561116.431
211	TOP OF DYKE	190.100	7913471.244	561121.741
212	TOP OF DYKE	190.100	7913468.897	561138.119
213	TOP OF DYKE	190.100	7913466.045	561158.012
214	TOP OF DYKE	190.100	7913463.194	561177.905
215	TOP OF DYKE	190.100	7913460.724	561195.136
216	TOP OF DYKE	190.100	7913452.364	561197.086
217	TOP OF DYKE	190.100	7913444.819	561185.945
218	TOP OF DYKE	190.100	7913437.274	561174.825
219	TOP OF DYKE	190.100	7913433.647	561170.728

LAYOUT & GRADING POINTS				
TARGET No.	FEATURE	ELEVATION	NORTHING	EASTING
220	TOP OF DYKE	190.100	7913426.988	561164.887
221	TOP OF DYKE	190.100	7913422.871	561158.448
222	TOP OF DYKE	190.100	7913413.811	561153.300
223	TOP OF DYKE	190.100	7913403.309	561144.257
224	TOP OF DYKE	190.100	7913401.292	561137.717
225	TOP OF DYKE	190.100	7913405.028	561122.473
226	TOP OF DYKE	190.100	7913409.762	561103.049
227	TOP OF DYKE	190.020	7913411.637	561096.159
228	TOP OF DYKE	190.020	7913414.699	561083.680
229	TOP OF DYKE	190.020	7913417.584	561071.879
230	TOP OF DYKE	190.100	7913419.214	561064.555
231	TOP OF DYKE	190.100	7913424.080	561044.770
232	TOP OF DYKE	190.100	7913428.819	561026.345
233	TOP OF DYKE	190.100	7913432.553	561010.101
234	TOP OF DYKE	190.100	7913437.409	561005.257
235	TOP OF DYKE	190.100	7913448.464	561002.578
236	TOP OF DYKE	190.100	7913459.519	560999.669
237	TOP OF DYKE	190.100	7913463.210	560987.933
238	TOP OF DYKE	190.100	7913478.414	560984.027
239	TOP OF DYKE	190.100	7913486.258	560987.705
240	TOP OF DYKE	190.100	7913503.675	560980.921
300	ROAD EDGE	188.300	7913528.885	560974.311
301	ROAD EDGE	188.300	7913523.323	560997.016
302	ROAD EDGE	188.300	7913517.704	561019.953
303	ROAD EDGE	188.300	7913510.540	561036.677
304	ROAD EDGE	188.300	7913503.945	561045.018
305	ROAD EDGE	188.300	7913497.350	561054.356
306	ROAD EDGE	188.300	7913493.270	561062.118
307	ROAD EDGE	188.300	7913487.718	561077.189
308	ROAD EDGE	188.302	7913482.162	561092.259
309	ROAD EDGE	188.500	7913471.921	561132.528
310	ROAD EDGE	189.500	7913471.044	561138.645
311	ROAD EDGE	189.500	7913468.192	561158.538
312	ROAD EDGE	189.500	7913465.341	561178.431
313	ROAD EDGE	189.500	7913462.802	561195.448
314	ROAD EDGE	189.500	7913450.182	561197.769
315	ROAD EDGE	189.829	7913442.588	561196.578
316	ROAD EDGE	189.769	7913434.871	561175.202
317	ROAD EDGE	190.081	7913427.216	561166.514
318	ROAD EDGE	190.100	7913428.278	561165.837
319	ROAD EDGE	190.100	7913412.953	561153.870
320	ROAD EDGE	189.873	7913408.794	561151.621
321	ROAD EDGE	189.501	7913402.720	561146.618
322	ROAD EDGE	189.200	7913399.109	561134.859
323	ROAD EDGE	189.200	7913400.370	561129.711
324	ROAD EDGE	189.156	7913400.765	561127.748
325	ROAD EDGE	188.000	7913401.357	561124.000
326	ROAD EDGE	189.500	7913402.451	561117.077
327	ROAD EDGE	190.000	7913403.545	561110.154
328	ROAD EDGE	190.574	7913404.802	561102.207
329	ROAD EDGE	190.124	7913406.595	561094.922
330	ROAD EDGE	190.124	7913412.534	561070.640
331	ROAD EDGE	190.574	7913414.319	561063.355
332	ROAD EDGE	190.555	7913414.437	561062.872
333	ROAD EDGE	189.668	7913415.567	561061.153
334	ROAD EDGE	188.500	7913415.027	561059.880
335	ROAD EDGE	187.500	7913414.680	561032.234
336	ROAD EDGE	186.546	7913414.081	561020.182
337	ROAD EDGE	185.801	7913413.387	561005.884
338	ROAD EDGE	185.800	7913413.501	561003.575

LAYOUT & GRADING POINTS				
TARGET No.	FEATURE	ELEVATION	NORTHING	EASTING
339	ROAD EDGE	185.534	7913414.980	561022.575
340	ROAD EDGE	185.018	7913426.183	560998.483
341	ROAD EDGE	185.500	7913434.287	560997.641
342	ROAD EDGE	187.000	7913442.249	560998.695
343	ROAD EDGE	187.335	7913449.714	560995.863
344	ROAD EDGE	188.300	7913467.108	560986.134
345	ROAD EDGE	188.300	7913475.386	560980.580
346	ROAD EDGE	188.300	7913483.206	560984.263
347	ROAD EDGE	188.300	7913500.870	560977.527
400	ROAD EDGE	188.180	7913534.713	560975.738
401	ROAD EDGE	188.180	7913529.122	560966.259
402	ROAD EDGE	188.180	7913523.532	561021.380
403	ROAD EDGE	188.180	7913515.441	561039.138
404	ROAD EDGE	188.180	7913508.846	561046.477
405	ROAD EDGE	188.180	7913502.251	561057.818
406	ROAD EDGE	188.180	7913498.900	561064.193
407	ROAD EDGE	188.180	7913493.346	561079.283
408	ROAD EDGE	188.182	7913487.792	561084.334
409	ROAD EDGE	189.380	7913477.786	561133.892
410	ROAD EDGE	189.380	7913476.900	561140.079
411	ROAD EDGE	189.380	7913474.048	561159.272
412	ROAD EDGE	188.380	7913471.197	561179.885
413	ROAD EDGE	188.380	7913467.814	561203.461
414	ROAD EDGE	189.380	7913460.185	561211.786
415	ROAD EDGE	189.380	7913449.840	561207.857
416	ROAD EDGE	189.547	7913439.773	561193.114
417	ROAD EDGE	189.842	7913429.806	561178.571
418	ROAD EDGE	189.981	7913423.249	561171.018
419	ROAD EDGE	190.000	7913410.718	561160.058
420	ROAD EDGE	189.628	7913402.999	561154.795
421	ROAD EDGE	189.279	7913395.582	561148.359
422	ROAD EDGE	189.991	7913376.227	561153.881
423	ROAD EDGE	188.557	7913365.792	561120.122
424	ROAD EDGE	189.000	7913360.742	561122.135
425	ROAD EDGE	189.500	7913395.286	561115.831
426	ROAD EDGE	190.000	7913398.831	561109.528
427	ROAD EDGE	190.694	7913398.974	561100.779
428	ROAD EDGE	190.244	7913400.758	561093.495
429	ROAD EDGE	190.244	7913408.707	561099.213
430	ROAD EDGE	190.694	7913408.491	561091.828
431	ROAD EDGE	190.648	7913408.809	561081.445
432	ROAD EDGE	189.723	7913409.574	561081.440
433	ROAD EDGE	188.500	7913408.836	561038.128
434	ROAD EDGE	187.043	7913408.175	561022.259
435	ROAD EDGE	184.010	7913416.699	560986.132
436	ROAD EDGE	185.350	7913421.139	560993.005
437	ROAD EDGE	186.000	7913430.689	560991.945
438	ROAD EDGE	186.500	7913438.012	560991.128
439	ROAD EDGE	187.000	7913444.042	560990.460
440	ROAD EDGE	187.184	7913449.051	560989.900
441	ROAD EDGE	188.180	7913463.058	560983.707
442	ROAD EDGE	188.180	7913471.317	560976.153
443	ROAD EDGE	188.180	7913469.157	560969.836
444	ROAD EDGE	188.180	7913468.521	560963.100
500	GRADE BREAK	188.032	7913510.884	560985.541
501	GRADE BREAK	188.000	7913505.942	561003.054
502	GRADE BREAK	187.965	7913500.497	561022.312
503	GRADE BREAK	187.957	7913499.325	561028.457
504	GRADE BREAK	187.739	7913479.985	561084.014
505	GRADE BREAK	187.731	7913467.594	561039.742




LAYOUT & GRADING POINTS				
TARGET No.	FEATURE	ELEVATION	NORTHING	EASTING
506	GRADE BREAK	187.718	7913483.459	561071.083
507	GRADE BREAK	187.719	7913485.776	561071.642
508	GRADE BREAK	187.724	7913497.789	561071.057
509	GRADE BREAK	187.734	7913501.240	560982.889
510	GRADE BREAK	187.738	7913502.185	560977.323
511	GRADE BREAK	187.768	7913507.943	560975.458
512	GRADE BREAK	188.065	7913512.914	560980.037
513	GRADE BREAK	188.233	7913444.150	561006.572
514	GRADE BREAK	188.264	7913461.295	561007.723
515	GRADE BREAK	187.995	7913489.071	561004.342
516	GRADE BREAK	187.827	7913480.111	560988.895
517	GRADE BREAK	187.742	7913500.845	560991.033
518	GRADE BREAK	188.233	7913414.832	561053.533
519	GRADE BREAK	188.097	7913422.479	561151.892
520	GRADE BREAK	187.740	7913484.632	561111.193
521	GRADE BREAK	187.772	7913465.825	561118.065
522	GRADE BREAK	187.759	7913461.070	561136.205
523	GRADE BREAK	187.733	7913459.395	561145.587
524	GRADE BREAK	187.733	7913455.759	561160.822
525	GRADE BREAK	187.739	7913450.931	561177.313
526	GRADE BREAK	187.753	7913460.304	561177.833
527	GRADE BREAK	188.100	7913440.098	561182.533
528	GRADE BREAK	188.100	7913455.071	561183.755
529	GRADE BREAK	188.100	7913456.894	561181.295
530	GRADE BREAK	188.100	7913456.699	561178.313
531	GRADE BREAK	188.247	7913440.767	561181.255
532	GRADE BREAK	188.288	7913463.699	561147.147
533	GRADE BREAK	187.840	7913445.700	561164.373
534	GRADE BREAK	187.804	7913450.705	561159.305
535	GRADE BREAK	187.850	7913446.823	561155.387
536	GRADE BREAK	188.500	7913440.427	561158.477
537	GRADE BREAK	187.917	7913439.598	561157.313
538	GRADE BREAK	188.500	7913444.216	561183.111
539	GRADE BREAK	188.000	7913438.984	561154.242
540	GRADE BREAK	189.500	7913433.600	561154.887
541	GRADE BREAK	189.500	7913429.428	561159.542
542	GRADE BREAK	189.000	7913434.982	561159.183
543	GRADE BREAK	188.000	7913433.499	561157.122
600	C/L SWALE	186.282	7913508.422	560980.900
601	C/L SWALE	186.628	7913501.725	561001.911
602	C/L SWALE	186.852	7913498.124	561014.747
603	C/L SWALE	186.947	7913498.405	561020.133
604	C/L SWALE	187.307	7913496.122	561040.111
605	C/L SWALE	187.740	7913480.285	561054.155
606	C/L SWALE	187.650	7913452.707	561180.080
607	C/L SWALE	187.084	7913453.813	561175.603
608	C/L SWALE	187.167	7913455.789	561167.588
609	C/L SWALE	187.284	7913458.523	561158.193
810	C/L SWALE	187.433	7913461.421	561141.642
811	C/L SWALE	187.636	7913482.918	561131.205
812	C/L SWALE	187.644	7913484.414	561120.760
813	C/L SWALE	187.740	7913486.120	561111.242
814	C/L SWALE	189.827	7913402.795	561155.011
815	C/L SWALE	189.537	7913409.965	561161.100
816	C/L SWALE	189.419	7913419.036	561169.122
817	C/L SWALE	189.335	7913425.213	561175.095
818	C/L SWALE	189.250	7913430.428	561181.811
819	C/L SWALE	189.050	7913437.584	561192.065
820	C/L SWALE	189.000	7913444.174	561202.322
900	TANK PAD TOE	187.825	7913454.943	561133.777





NAME/SIGN:  COMPANY: Hatch

**PERMIT TO PRACTICE**  
**HATCH LTD.**  
 Signature [Signature]  
 Date 19-01-18  
**PERMIT NUMBER: P 512**  
 The Association of Professional Engineers,  
 Geologists and Geophysicists of NWT/NU

		 	
H353004-10000-220-272-0012-0001 MINE SITE TANK FARM SUBGRADE LAYOUT & GRADING POINTS		MARY RIVER EXPANSION PROJECT BAFFINLAND IRON MINES LP	
DRAWING No. _____ DRAWING TITLE _____		MINE SITE TANK FARM SUBGRADE PLAN	
REFERENCE DRAWINGS		SCALE 1:400 OR AS NOTED	
REG. PROFESSIONAL _____		DWG. No. H353004-10000-220-272-0011-0001	
REVISIONS		REV 1	
SHEET SIZE: A		SHEET SIZE: A	




H353004-10000-220-272-0012-0001  
DWG. No.

A

LAYOUT & GRADING POINTS					LAYOUT & GRADING POINTS					LAYOUT & GRADING POINTS					LAYOUT & GRADING POINTS					LAYOUT & GRADING POINTS				
TARGET No.	FEATURE	ELEVATION	NORTHING	EASTING	TARGET No.	FEATURE	ELEVATION	NORTHING	EASTING	TARGET No.	FEATURE	ELEVATION	NORTHING	EASTING	TARGET No.	FEATURE	ELEVATION	NORTHING	EASTING	TARGET No.	FEATURE	ELEVATION	NORTHING	EASTING
100	TOE OF DYKE	187.532	7913520.828	500772.288	228	TOP OF SLOPE	190.221	7913309.211	501102.433	304	SWALE CA.	188.368	7913492.603	501020.874	453	DYKE GRADE BREAK	189.350	7913404.747	501120.543	528	GRADE BREAK	188.409	7913429.574	501170.328
101	TOE OF DYKE	187.532	7913517.446	500805.281	227	TOP OF SLOPE	190.200	7913308.551	501102.505	305	SWALE CA.	188.368	7913492.603	501020.874	454	DYKE GRADE BREAK	189.349	7913403.102	501120.517	527	GRADE BREAK	188.425	7913430.240	501175.379
102	TOE OF DYKE	187.532	7913512.888	501004.707	226	TOP OF SLOPE	190.294	7913309.527	501092.829	306	SWALE CA.	188.378	7913493.842	501020.860	455	DYKE GRADE BREAK	189.350	7913404.016	501120.523	529	GRADE BREAK	188.409	7913429.574	501170.318
103	TOE OF DYKE	187.532	7913509.449	501017.930	229	TOP OF SLOPE	190.294	7913404.471	501058.005	307	SWALE CA.	188.368	7913492.603	501020.874	456	DYKE GRADE BREAK	189.349	7913403.102	501120.517	530	GRADE BREAK	188.409	7913429.574	501170.318
104	TOE OF DYKE	187.532	7913503.596	501030.774	230	TOP OF SLOPE	190.303	7913407.929	501061.278	308	SWALE CA.	188.368	7913492.603	501020.874	457	DYKE GRADE BREAK	189.349	7913403.028	501120.513	531	GRADE BREAK	188.409	7913429.574	501170.318
105	TOE OF DYKE	187.532	7913497.002	501040.113	231	TOP OF SLOPE	190.199	7913405.485	501080.571	309	SWALE CA.	188.365	7913498.137	501111.298	458	DYKE GRADE BREAK	189.352	7913403.028	501099.303	530	GRADE BREAK	188.409	7913429.574	501170.318
106	TOE OF DYKE	187.532	7913490.407	501049.452	232	TOP OF SLOPE	188.888	7913418.214	501082.648	310	SWALE CA.	188.368	7913492.603	501020.874	459	DYKE GRADE BREAK	189.349	7913399.508	501101.219	532	GRADE BREAK	188.829	7913395.582	501144.359
107	TOE OF DYKE	187.532	7913485.294	501059.179	233	TOP OF SLOPE	190.687	7913422.878	501044.431	311	SWALE CA.	188.375	7913493.842	501020.860	460	DYKE GRADE BREAK	189.352	7913401.384	501101.219	533	GRADE BREAK	188.718	7913397.312	501145.411
108	TOE OF DYKE	187.532	7913470.818	501074.038	234	TOP OF SLOPE	189.687	7913427.435	501025.008	312	SWALE CA.	188.637	7913489.851	501148.387	461	DYKE GRADE BREAK	189.344	7913400.174	501093.351	534	GRADE BREAK	188.289	7913377.713	501150.785
109	TOE OF DYKE	187.532	7913474.342	501080.897	235	TOP OF SLOPE	189.687	7913431.189	501026.782	313	SWALE CA.	188.534	7913458.596	501158.187	462	DYKE GRADE BREAK	189.344	7913399.213	501093.003	535	GRADE BREAK	188.289	7913491.218	501145.380
110	TOE OF DYKE	187.532	7913471.804	501088.512	236	TOP OF SLOPE	189.687	7913437.074	501083.872	314	SWALE CA.	188.334	7913453.813	501171.087	463	DYKE GRADE BREAK	189.344	7913405.148	501098.830	536	GRADE BREAK	188.289	7913399.218	501145.380
111	TOE OF DYKE	187.532	7913468.313	501115.688	237	TOP OF SLOPE	189.687	7913458.184	500980.514	315	SWALE CA.	188.301	7913452.087	501180.145	464	DYKE GRADE BREAK	189.344	7913406.122	501099.088	537	GRADE BREAK	188.712	7913400.864	501125.402
112	TOE OF DYKE	187.532	7913467.384	501121.188	238	TOP OF SLOPE	189.687	7913462.248	500980.882	400	DYKE GRADE BREAK	189.350	7913525.146	500973.145	465	DYKE GRADE BREAK	189.352	7913407.312	501099.303	538	GRADE BREAK	188.609	7913400.718	501108.850
113	TOE OF DYKE	187.532	7913465.091	501137.187	239	TOP OF SLOPE	189.687	7913463.912	500977.088	401	DYKE GRADE BREAK	189.350	7913524.128	500973.145	466	DYKE GRADE BREAK	189.632	7913408.258	501054.598	539	GRADE BREAK	188.487	7913398.328	501111.578
114	TOE OF DYKE	187.532	7913462.239	501157.879	240	TOP OF SLOPE	189.688	7913502.713	500958.870	402	DYKE GRADE BREAK	189.350	7913528.943	500988.138	467	DYKE GRADE BREAK	189.632	7913408.168	501061.785	540	GRADE BREAK	188.888	7913383.742	501122.135
115	TOE OF DYKE	187.532	7913459.388	501178.972	241	TOP OF SLOPE	187.625	7913509.087	500975.479	403	DYKE GRADE BREAK	189.350	7913521.963	500988.388	468	DYKE GRADE BREAK	189.630	7913417.281	501091.612	541	GRADE BREAK	188.548	7913380.781	501124.494
116	TOE OF DYKE	187.532	7913458.883	501184.383	242	TOP OF SLOPE	187.315	7913512.917	500980.882	404	DYKE GRADE BREAK	189.350	7913516.184	501005.933	469	DYKE GRADE BREAK	189.108	7913418.181	501072.028	542	GRADE BREAK	188.229	7913385.748	501121.870
117	TOE OF DYKE	187.532	7913455.501	501194.878	243	TOP OF SLOPE	187.282	7913515.884	500955.541	405	DYKE GRADE BREAK	189.350	7913517.204	501005.813	470	DYKE GRADE BREAK	189.350	7913419.503	501064.400	543	GRADE BREAK	188.630	7913414.802	501101.855
118	TOE OF DYKE	187.532	7913448.048	501183.756	244	TOP OF SLOPE	187.250	7913503.842	501003.054	406	DYKE GRADE BREAK	189.350	7913512.917	501018.787	471	DYKE GRADE BREAK	189.350	7913418.484	501054.378	544	GRADE BREAK	188.409	7913415.828	501051.881
119	TOE OF DYKE	187.532	7913440.501	501172.835	245	TOP OF SLOPE	187.213	7913500.151	501023.535	407	DYKE GRADE BREAK	189.350	7913513.985	501019.037	472	DYKE GRADE BREAK	189.350	7913424.382	501044.842	545	GRADE BREAK	188.409	7913415.828	501051.881
120	TOE OF DYKE	187.532	7913438.214	501187.789	246	TOP OF SLOPE	188.900	7913479.972	501094.078	408	DYKE GRADE BREAK	189.350	7913509.537	501032.851	473	DYKE GRADE BREAK	189.350	7913423.332	501044.842	546	GRADE BREAK	187.393	7913414.842	501033.281
121	TOE OF DYKE	187.532	7913425.271	501154.948	247	TOP OF SLOPE	188.881	7913467.595	501036.743	409	DYKE GRADE BREAK	189.350	7913507.389	501033.457	474	DYKE GRADE BREAK	189.350	7913428.119	501025.148	547	GRADE BREAK	187.583	7913409.818	501033.630
122	TOE OF DYKE	187.532	7913416.977	501150.454	248	TOP OF SLOPE	188.867	7913464.791	501016.488	410	DYKE GRADE BREAK	189.350	7913499.842	501042.100	475	DYKE GRADE BREAK	189.350	7913428.091	501025.148	548	GRADE BREAK	188.058	7913413.839	501101.852
123	TOE OF DYKE	187.532	7913407.951	501141.343	249	TOP OF SLOPE	186.974	7913497.768	501001.057	411	DYKE GRADE BREAK	189.350	7913500.800	501042.708	476	DYKE GRADE BREAK	189.350	7913432.645	501016.172	549	GRADE BREAK	188.250	7913413.839	501101.852
124	TOE OF DYKE	187.532	7913405.080	501136.843	250	TOP OF SLOPE	186.984	7913501.240	500982.889	412	DYKE GRADE BREAK	189.350	7913493.344	501051.529	477	DYKE GRADE BREAK	189.350	7913431.625	501008.822	550	GRADE BREAK	188.009	7913417.602	500989.588
125	TOE OF DYKE	187.532	7913408.814	501123.401	251	TOP OF SLOPE	187.000	7913500.858	500978.488	413	DYKE GRADE BREAK	189.350	7913494.208	501052.138	478	DYKE GRADE BREAK	189.350	7913437.480	501005.548	551	GRADE BREAK	188.007	7913421.381	500992.244
126	TOE OF DYKE	187.532	7913413.573	501103.975	252	TOP OF SLOPE	186.980	7913465.825	501111.194	414	DYKE GRADE BREAK	189.350	7913488.872	501080.424	479	DYKE GRADE BREAK	189.350	7913437.233	501004.528	552	GRADE BREAK	188.409	7913421.381	500995.515
127	TOE OF DYKE	187.532	7913416.331	501084.549	253	TOP OF SLOPE	187.016	7913462.788	501128.322	415	DYKE GRADE BREAK	189.350	7913488.872	501080.424	480	DYKE GRADE BREAK	189.350	7913448.535	501002.888	553	GRADE BREAK	188.800	7913421.381	500995.515
128	TOE OF DYKE	187.532	7913423.090	501085.124	254	TOP OF SLOPE	187.000	7913458.330	501150.382	416	DYKE GRADE BREAK	189.350	7913483.188	501075.283	481	DYKE GRADE BREAK	189.350	7913448.288	501001.848	554	GRADE BREAK	188.000	7913421.381	500995.515
129	TOE OF DYKE	187.532	7913427.848	501045.880	255	TOP OF SLOPE	187.008	7913450.800	501177.318	417	DYKE GRADE BREAK	189.350	7913484.181	501075.848	482	DYKE GRADE BREAK	189.350	7913458.580	501001.848	555	GRADE BREAK	188.000	7913421.381	500995.515
130	TOE OF DYKE	187.532	7913432.807	501028.273	256	TOP OF SLOPE	187.250	7913448.858	501100.238	418	DYKE GRADE BREAK	189.350	7913477.720	501090.142	483	DYKE GRADE BREAK	189.350	7913498.343	500999.170	556	GRADE BREAK	188.000	7913421.381	500995.515
131	TOE OF DYKE	187.532	7913436.341	501011.829	257	TOP OF SLOPE	187.350	7913461.825	501194.337															



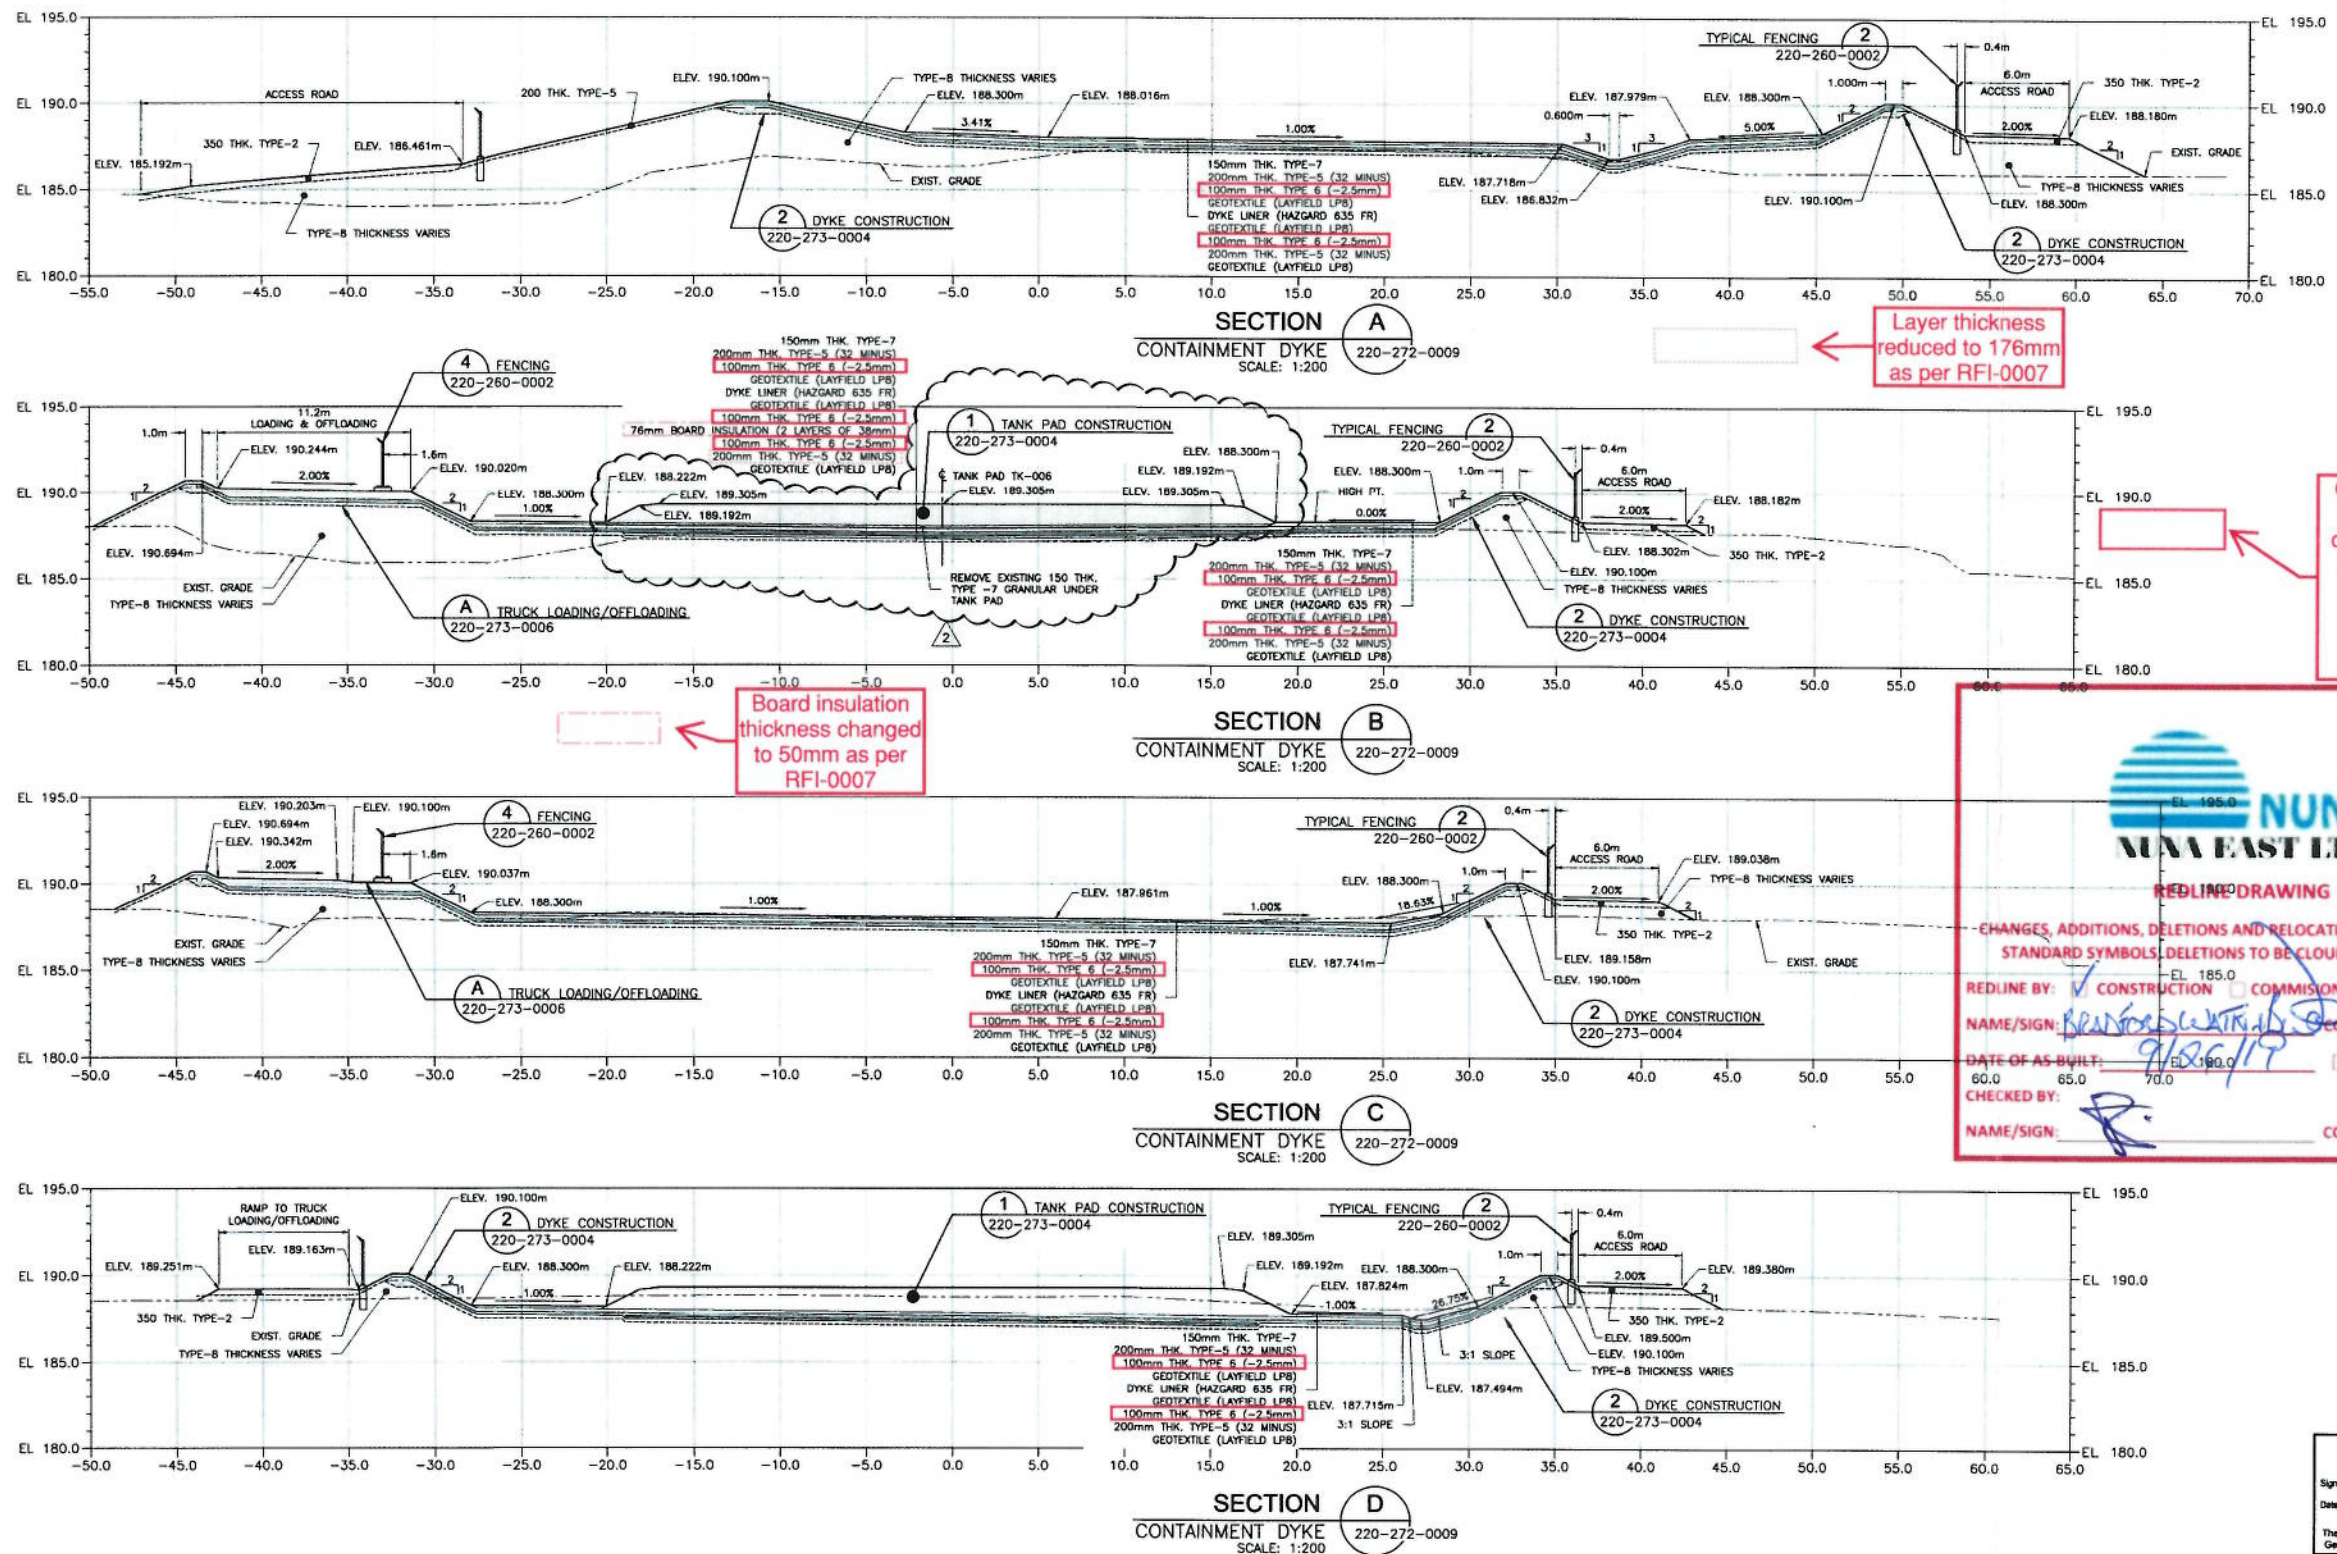

Released for Use

H353004-10000-220-273-0004-0001	MINE SITE DYKE SECTIONS & DETAILS
H353004-10000-220-272-0009-0001	MINE SITE TANK FARM GRADING PLAN
H353004-10000-220-260-0002-0001	MINE SITE TANK FARM DYKE MISCELLANEOUS DETAILS

DRAWING No. DRAWING TITLE

REFERENCE DRAWINGS



REG. PROFESSIONAL

2	TANK PAD ADDED TO SECTION B	SJM	MMI	19-01-18
1	SECTIONS UPDATED TO SUIT REVISED DYKE AND ACCESS ROAD LAYOUT. LINER TYPE REVISED	SJM	KML	18-07-25
0	ISSUED FOR CONSTRUCTION			

No. DESCRIPTION

REVISIONS

THIS DRAWING WAS PREPARED BY HATCH LTD. FOR THE EXCLUSIVE USE OF BAILLIFLAND IRON MINES LTD. CLIENTS AND ITS USE IS SUBJECT TO THE TERMS AND CONDITIONS OF THE CONTRACT BETWEEN HATCH LTD. AND THE CLIENT. INCLUDING ANY LIMITATIONS ON LIABILITY CONTAINED THEREIN. THIS DRAWING AND ITS CONTENTS REMAIN THE INTELLECTUAL PROPERTY OF HATCH LTD. AND ARE NOT TO BE REPRODUCED OR TRANSMITTED IN ANY FORM OR BY ANY MEANS, ELECTRONIC OR MECHANICAL, INCLUDING PHOTOCOPYING, RECORDING, OR BY ANY INFORMATION STORAGE AND RETRIEVAL SYSTEM, WITHOUT THE WRITTEN PERMISSION OF HATCH LTD. THE DRAWING FOR THE PURPOSES CONNECTED WITH THE PROJECT, INCLUDING THE CONSTRUCTION, COMPLETION, MAINTENANCE, EXTENSION, REINSTATEMENT AND REPAIR OF THE PROJECT. THIS DRAWING AND THE INFORMATION CONTAINED HEREIN SHALL BE TREATED AS CONFIDENTIAL FOR ALL OTHER PURPOSES AND SHALL NOT BE DISCLOSED WITHOUT THE WRITTEN CONSENT OF HATCH LTD.

HATCH

DRAFTSPERSON	S. SKINNER	NR	18-07-06
DESIGNER	K. MacLEAN	NR	18-07-06
CHECKER	M. MacINTYRE	<i>[Signature]</i>	19/02/01
DESIGN COORD.	M. MacINTYRE	<i>[Signature]</i>	19/02/01
RESP. ENG.	F. BUTTS	<i>[Signature]</i>	19/02/01
LEAD DISC. ENG.	K. MacLEAN	<i>[Signature]</i>	19/02/01
ENG. MANAGER	G. PEACE	<i>[Signature]</i>	19/02/01
AREA MANAGER	H. MENTER	<i>[Signature]</i>	19/02/01
CLIENT	T. ATIBA	<i>[Signature]</i>	19/02/01

DRAWING APPROVAL STATUS:

Approved for Construction

Baffinland

MARY RIVER EXPANSION PROJECT  
BAFFINLAND IRON MINES LPMINE SITE  
TANK FARM DYKE  
SECTIONS A TO DSCALE: 1:200 OR AS NOTED  
DWG. No. H353004-10000-220-273-0001-0001  
REV 2

SHEET SIZE: A1







H353004-10000-220-273-0002-0001



REDLINE DRAWING

CHANGES, ADDITIONS, DELETIONS AND RELOCATIONS IN RED INK USING STANDARD SYMBOLS, DELETIONS TO BE CLOUDED AND HATCHED.

REDLINE BY: ☒ CONSTRUCTION ☐ COMMISSIONING ☐ SUSTAINANCE  
NAME/SIGN: [Signature] COMPANY: NUNA  
DATE OF AS-BUILT: 7/26/19 ☐ CHECK IF NO CHANGE  
CHECKED BY: [Signature]  
NAME/SIGN: [Signature] COMPANY: Hatch

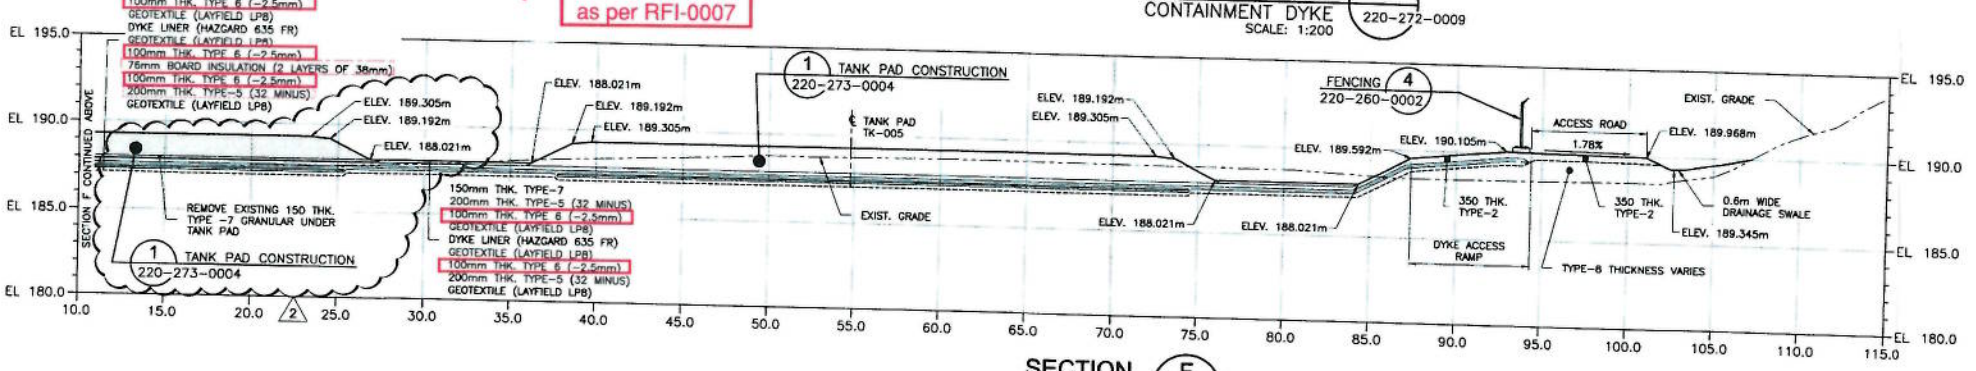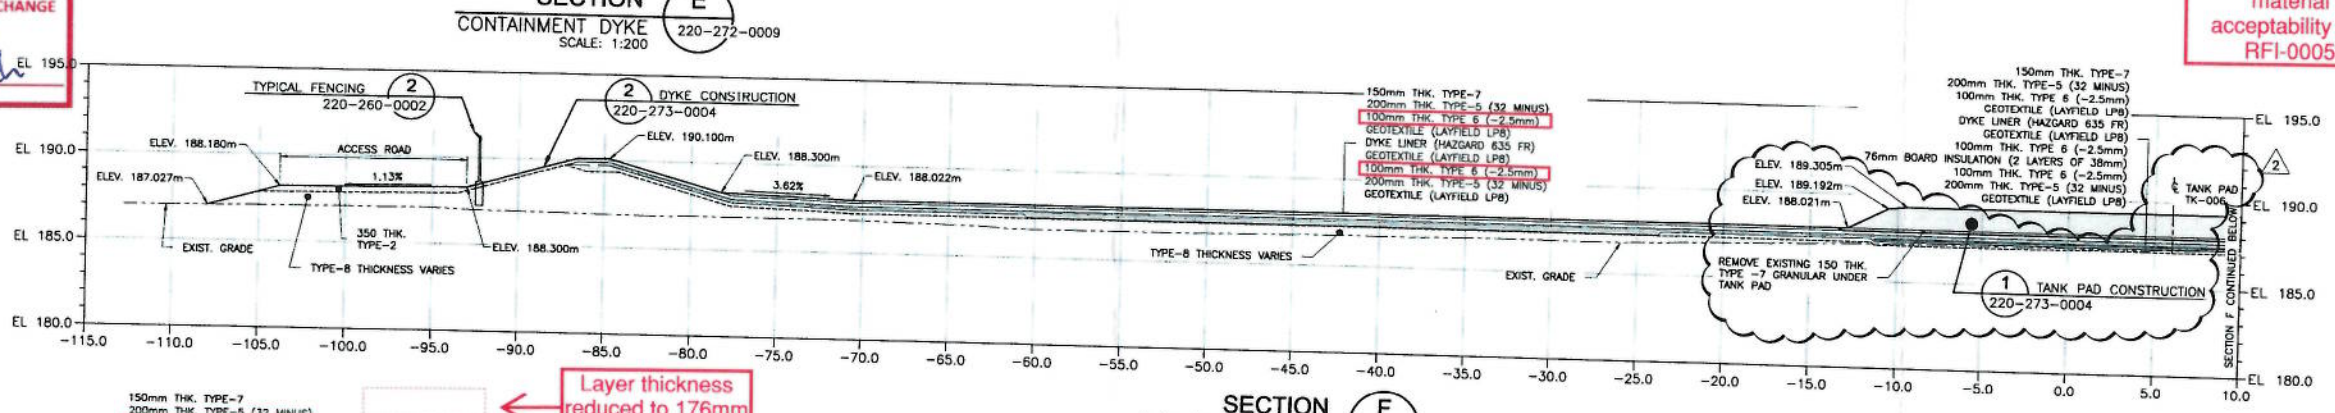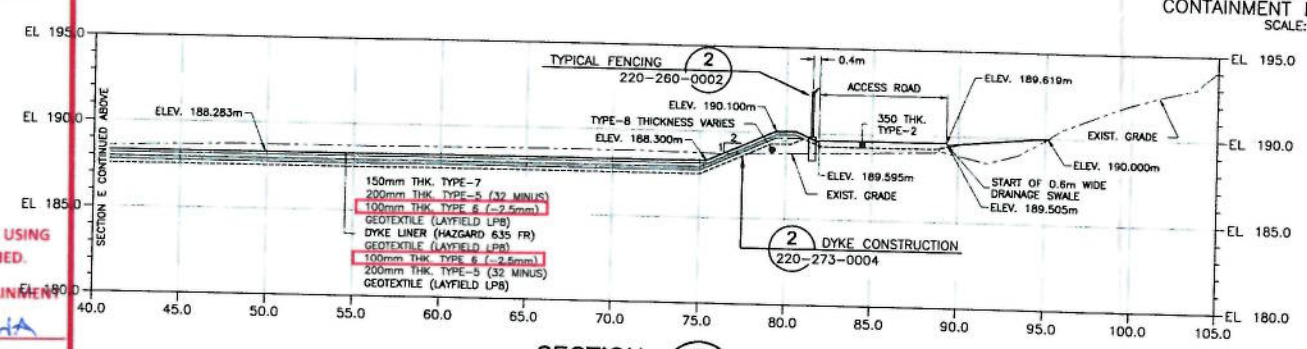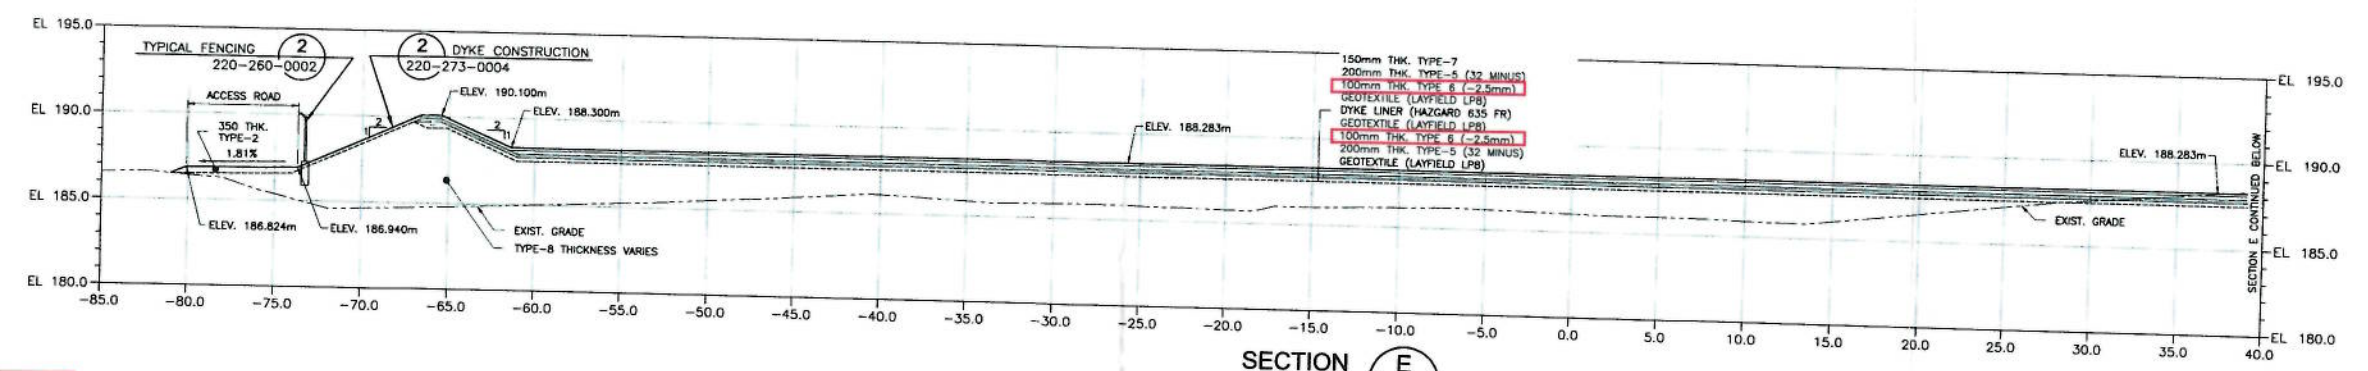

Option of areas of Type 6 material changed to Type 9 as per RFI-001 & Site screened material acceptability per RFI-0005

Board insulation thickness changed to 50mm as per RFI-0007

Layer thickness reduced to 176mm as per RFI-0007

Released for Use

PERMIT TO PRACTICE  
HATCH LTD.  
Signature: [Signature]  
Date: 11/22/01  
PERMIT NUMBER: P 512  
The Association of Professional Engineers, Geologists and Geophysicists of NWT (NAGG)

HATCH

Baffinland

MARY RIVER EXPANSION PROJECT  
BAFFINLAND IRON MINES LP

MINE SITE  
TANK FARM DYKE  
SECTIONS E & F

REFERENCE DRAWINGS	DRAWING TITLE
H353004-10000-220-273-0004-0001	MINE SITE DYKE SECTIONS & DETAILS
H353004-10000-220-272-0009-0001	MINE SITE TANK FARM GRADING PLAN
H353004-10000-220-260-0002-0001	MINE SITE TANK FARM DYKE MISCELLANEOUS DETAILS




REVISIONS	DESCRIPTION
2	TANK PAD ADDED TO SECTION B
1	SECTIONS UPDATED TO SUIT REVISED DYKE AND ACCESS ROAD LAYOUT, LINER TYPE REVISED
0	ISSUED FOR CONSTRUCTION


DRAFTSPERSON	S. SKINNER	NR	18-07-06
DESIGNER	K. MacLEAN	NR	18-07-06
CHECKER	M. MacINTYRE		19/02/01
DESIGN COORD.	M. MacINTYRE		19/02/01
RESP. ENG.	F. BUTTS		19/02/01
LEAD DISC. ENG.	K. MacLEAN		19/02/01
ENG. MANAGER	G. PEACE		19/02/01
QA MANAGER	H. VENTER		19/02/01
CLIENT	T. ATIBA		19/02/01

DRAWING APPROVAL STATUS: Approved for Construction  
SCALE: 1:200 OR AS NOTED  
DWG. No. H353004-10000-220-273-0002-0001  
REV 2  
SHEET SIZE: A1



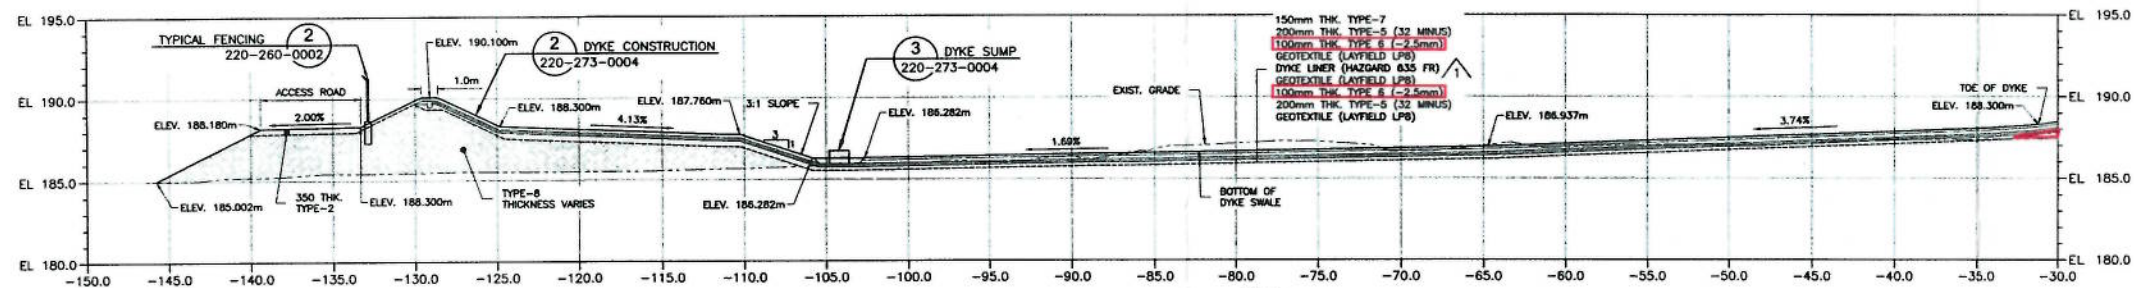

SECTION G  
CONTAINMENT DYKE  
SCALE: 1:200

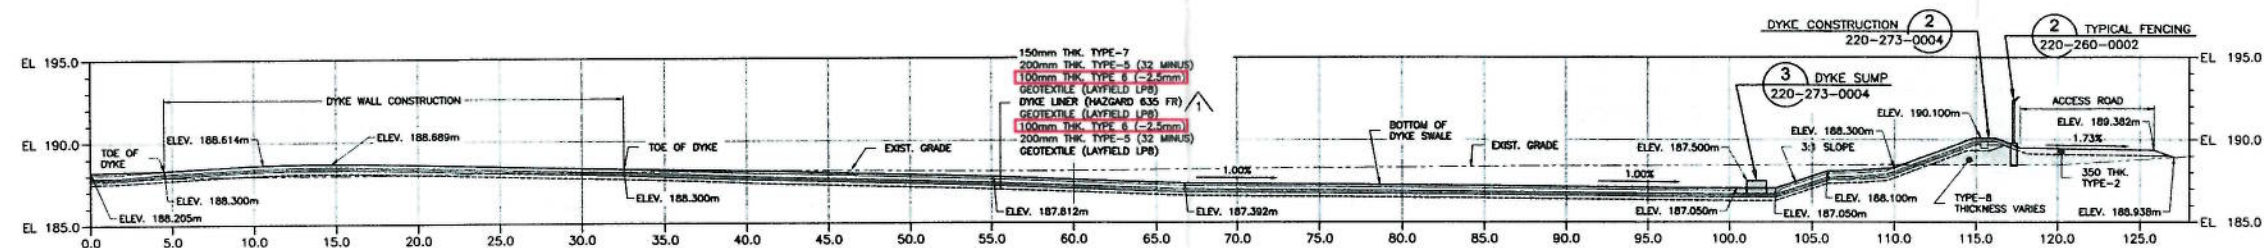

SECTION H  
CONTAINMENT DYKE  
SCALE: 1:200

Option of areas of  
Type 6 material  
changed to Type 9  
as per RFI-001 &  
Site screened  
material  
acceptability per  
RFI-0005

Released for Use

**NUNA EAST LTD**  
REDLINE DRAWING

CHANGES, ADDITIONS, DELETIONS AND RELOCATIONS IN RED INK USING STANDARD SYMBOLS, DELETIONS TO BE CLOUDED AND HATCHED.

REDLINE BY: ☒ CONSTRUCTION ☐ COMMISSIONING ☐ SUSTAINMENT  
NAME/SIGN: DAVID J. KIRK COMPANY: NUNA  
DATE OF AS-BUILT: 9/26/19 ☐ CHECK IF NO CHANGE  
CHECKED BY: [Signature]  
NAME/SIGN: [Signature] COMPANY: Hatch

PERMIT TO PRACTICE  
HATCH LTD.  
Signature: [Signature]  
Date: 19-01-18  
PERMIT NUMBER: P.512  
The Association of Professional Engineers,  
Geologists and Geophysicists of NWT/NU

DRAWING No.	DRAWING TITLE
H353004-10000-220-273-0004-0001	MINE SITE DYKE SECTIONS & DETAILS
H353004-10000-220-272-0009-0001	MINE SITE TANK FARM GRADING PLAN
H353004-10000-220-260-0002-0001	MINE SITE TANK FARM DYKE MISCELLANEOUS DETAILS




No.	DESCRIPTION	BY	CHKD	DATE
1	SECTIONS UPDATED TO SUIT REVISED DYKE AND ACCESS ROAD LAYOUT, LINER TYPE REVISED	SJM	KML	19/01/18
0	ISSUED FOR CONSTRUCTION	SJM	KML	18-07-25

ROLE	NAME	SIGNATURE	DATE
DRAFTSPERSON	S. SKINNER		18-07-06
DESIGNER	K. MacLEAN		18-07-06
CHECKER	M. MacINTYRE		19/01/18
DESIGN COORD.	M. MacINTYRE		19/01/18
RESP. ENG.	F. BUTTS		18/01/18
LEAD DISC. ENG.	K. MacLEAN		19/01/18
ENGL. MANAGER	Glen Peace		19/01/18
PROJ. MANAGER	T. ATIBA		19/01/18

<b>Baffinland</b>	MARY RIVER EXPANSION PROJECT BAFFINLAND IRON MINES LP
MINE SITE TANK FARM DYKE SECTIONS G & H	SCALE: 1:200 DWG. No. H353004-10000-220-273-0003-0001 REV 1



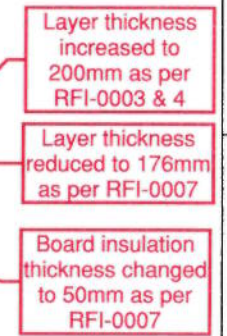

Option of areas of  
Type 6 material  
changed to Type 9  
as per RFI-001 &  
Site screened  
material  
acceptability per  
RFI-0005

Field instruction to overbuild exterior slope to accommodate equipment access for Key Trench excavation, slope varies, overbuild tie-in to engineered toe.

NAME/SIGN:  COMPANY: Heath

1200# CORRUGATED STEEL CULVERT C/W 6 THK. GALVANIZED PLATE TO BE WELDED TO GALVANIZED PIPE. SIDE WALL TO BE PERFORATED WITH 25# HOLES AT 100 C/C EQUALLY SPACED (ONLY)

200 THK. TYPE-5 (32 MINUS)  
100 THK. TYPE 6 (-2.5mm)  
GEOTEXTILE (LAYFIELD LPB)  
DYKE LINER (HAZARD 635 FR)  
GEOTEXTILE (LAYFIELD LPB)  
100 THK. TYPE 6 (-2.5mm)  
200 THK. TYPE-5 (32 MINUS)  
GEOTEXTILE (LAYFIELD LPB)

GRADE • SUMP SEE PLAN

600

450 SUMP

T.O. SUMP

600

3 1

T.O. DYKE FLOOR VERTS

TYPE-8 VARIES FILL TO SUBGRADE

BOTTOM OF SUMP EL. SEE PLAN


UNDISTURBED SOIL

WRAP TYPE-7 GRANULAR WITH GEOTEXTILE (LAYFIELD LPB)

TYPE-8 VARIES FILL TO SUBGRADE

PERM

**DETAIL** 3  
DYKE SUMP CONSTRUCTION 220-272-0009, 220-273-0001, 220-273-0002  
SCALE: 1:30

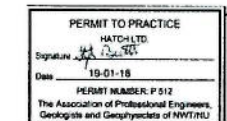


**Released for Use**

[illegible]




H353004-10000-220-273-0006-0001  
DWG. No.

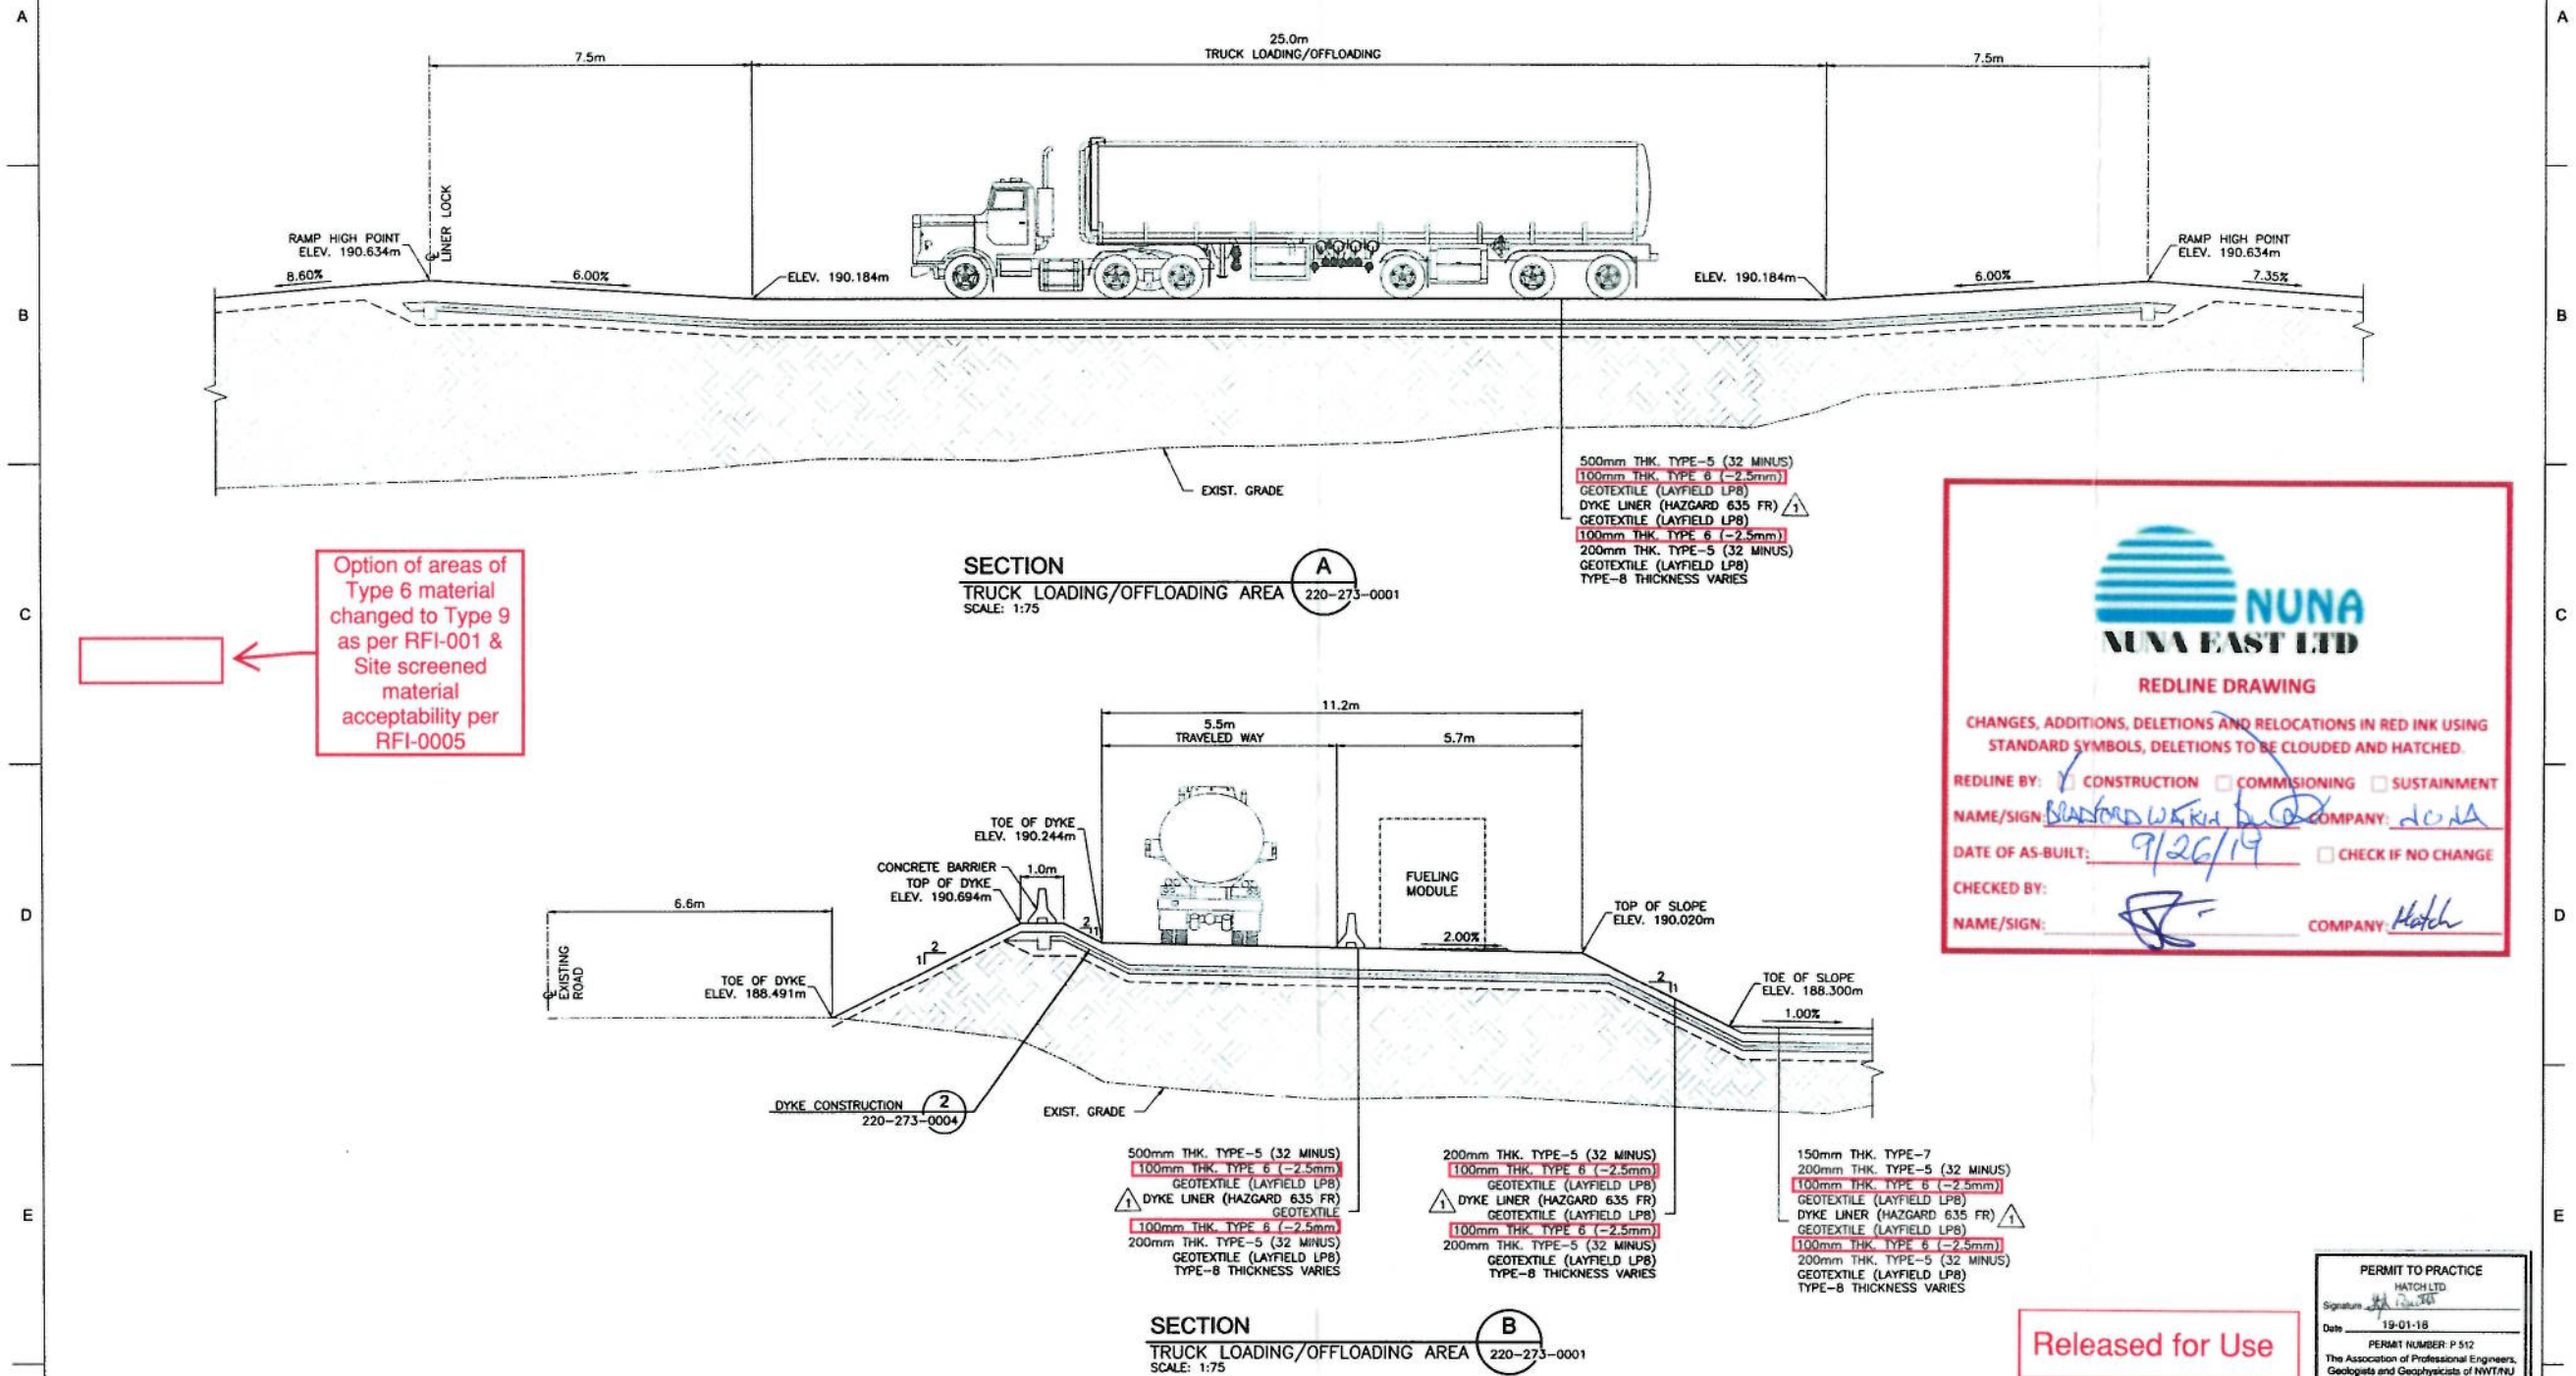


HATCH		Baffinland	
MARY RIVER EXPANSION PROJECT BAFFINLAND IRON MINES LP		MINE SITE SECTIONS THRU TRUCK LOADING/OFFLOADING AREA	
DRAFTSPERSON	S. SKINNER	NR	18-07-08
DESIGNER	K. MacLEAN	NR	18-07-08
CHECKER	M. MacINTYRE	19/01/18	19/01/18
DESIGN COORD.	M. MacINTYRE	19/01/18	19/01/18
RESP. ENG.	F. BUTTS	19/01/18	19/01/18
LEAD DISC. ENG.	K. MacLEAN	19/01/18	19/01/18
ENG. MANAGER	Glen Pearce	19/01/18	19/01/18
PROJ. MANAGER			
CLIENT	T. ATIBA		19/01/18
ROLE	NAME	SIGNATURE	DATE
DRAWING APPROVAL STATUS:		Approved for Construction	
SCALE	DWG. No.	REV	
1:50 OR AS NOTED	H353004-10000-220-273-0006-0001	1	
SHEET SIZE: A1			




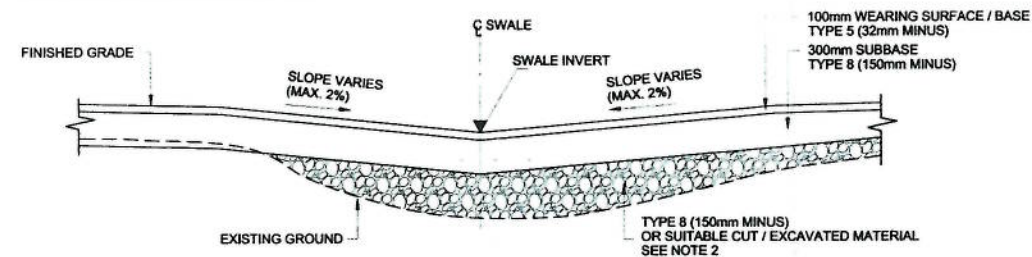


DETAIL 1 - TYPICAL SWALE SECTION (WITHOUT RIP RAP)

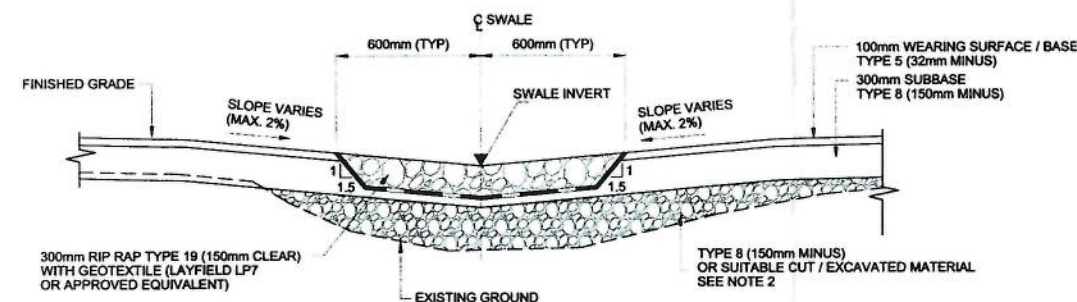

DETAIL 2 - TYPICAL SWALE SECTION (WITH RIP RAP)

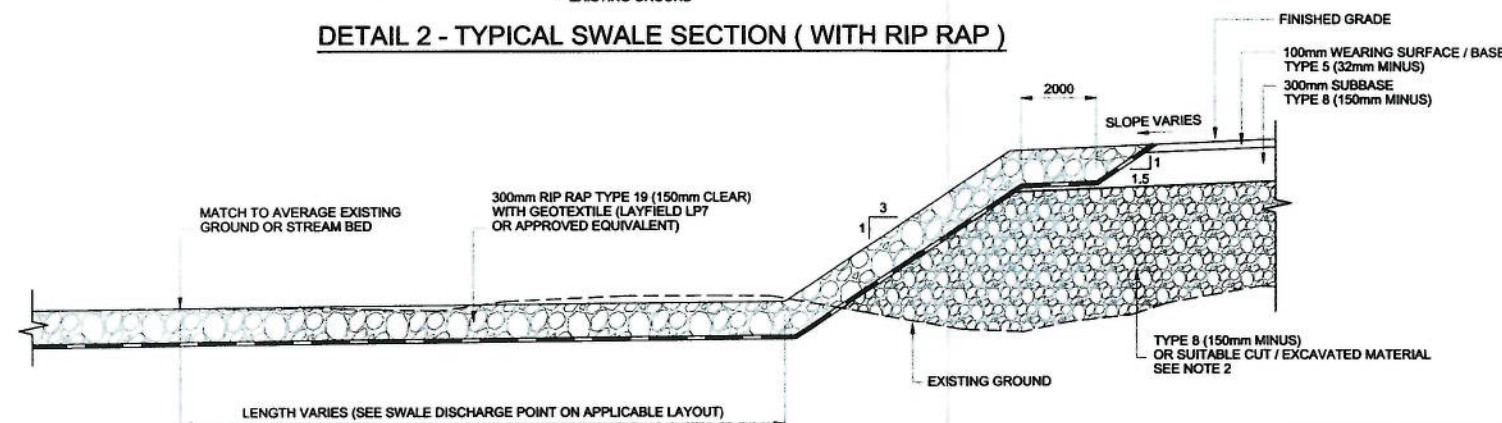

DETAIL 3 - TYPICAL DETAIL AT SWALE DISCHARGE POINT

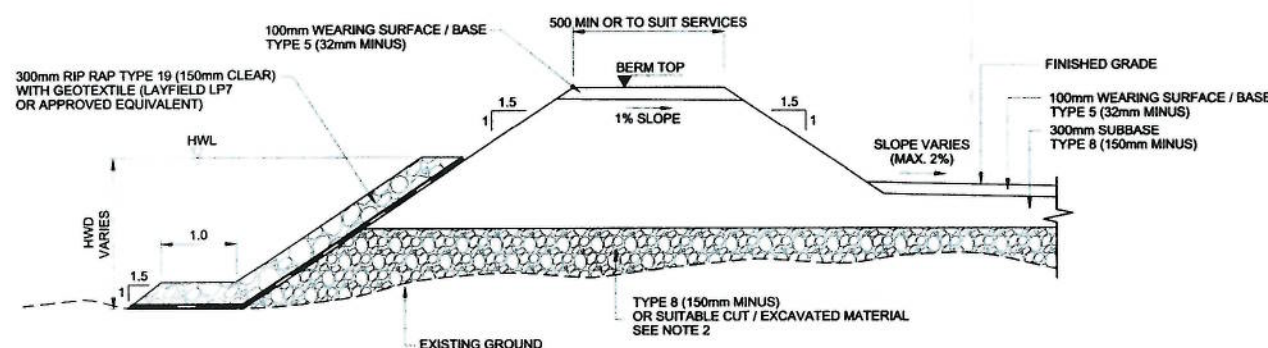

DETAIL 4 - TYPICAL DETAIL OF BERM AT EDGE OF PLATEAU EARTHWORKS

ABBREVIATIONS:  
HWD HIGH WATER DEPTH  
HWL HIGH WATER LEVEL

NOTES:

- ALL DIMENSIONS AND ELEVATIONS SHOWN ARE IN METERS UNLESS NOTED OTHERWISE.
- FOR FILL DEPTH >600mm AND DEPENDING ON FILL EXTENT, USE TYPE 12, I.E. RUN OF QUARRY (600mm MINUS).
- THIS DRAWING ONLY COVERS THE UTILITY BERM EARTHWORKS AND ALL OF DIMENSIONS AND DETAILS ARE PARAMETRIC AND SHOULD BE READ IN CONJUNCTION WITH ELECTRICAL / MECHANICAL REQUIREMENTS.
- THIS DRAWING SHALL BE READ IN CONJUNCTION WITH PROJECT UTILITY SERVICES DRAWINGS FOR CABLING AND PIPING. ALL CABLING AND PIPING UTILITIES ARE TO BE LAID DIRECTLY ON THE BERM, NO PIPE SUPPORTS ETC ARE REQUIRED.
- NUMBERS AND DIAMETERS OF STEEL CASING PIPES, WHERE APPLICABLE, SHALL BE PLACED ACCORDING TO ELECTRICAL / MECHANICAL REQUIREMENTS AS DEFINED ON THE PROJECT UTILITY SERVICES DRAWINGS.

MATERIAL AND COMPACTION SPECIFICATION:

**SUBGRADE PREPARATION:**  
THE SUBGRADE SHOULD BE PROOF-ROLLED AND INSPECTED PRIOR TO PLACING FILL MATERIALS. THE IDENTIFIED SOFT AREAS SHALL BE FURTHER COMPACTED, OR IF NECESSARY, BE MITIGATED USING GRANULAR OR ROCK FILL. A QUALIFIED GEOTECHNICAL ENGINEER SHALL INSPECT AND APPROVE THE SUBGRADE.  
THE ROCKFILL SHALL NOT BE PLACED IN WATER OR ON ICE. DEWATERING IS REQUIRED WHERE PONDING WATER IS ENCOUNTERED. OVER-EXCAVATION IS REQUIRED FOR GROUND ICE, IF ENCOUNTERED.  
THE SUBGRADE ON THE GROUND SHALL BE LEFT AS IT IS NATURALLY BEFORE CONSTRUCTION AS MUCH AS POSSIBLE. THE OVER-EXCAVATION SHOULD BE MINIMIZED TO AVOID DISTURBANCE OF THE EXISTING PERMAFROST.

**TYPE 5 (CRUSHER RUN 32mm MINUS MATERIAL) OR TYPE 3 (CRUSHER RUN 50mm MINUS):**  
THE MATERIAL MUST BE PLACED IN LIFTS NOT EXCEEDING 200mm AND SHALL BE COMPACTED BY MINIMUM 5 PASSES OF A MINIMUM 15 TON VIBRATORY ROLLER WITH VIBRATIONS IN THE RANGE OF 1200 TO 1500 vpm AND THE ROLLER SPEED OF ABOUT 2mph (3.2km/h). ALTERNATIVELY, THE COMPACTION SHOULD ACHIEVE A MINIMUM OF 100 PERCENT OF MAXIMUM DRY DENSITY AS DETERMINED BY TEST METHOD ASTM D698.

**TYPE 8 (CRUSHER RUN 150mm MINUS):**  
THE ROCKFILL MUST BE PLACED IN LIFTS NOT EXCEEDING 500mm. THE PLACEMENT SHALL AVOID SEGREGATION AND NESTING OF COARSE PARTICLES. IT SHALL BE COMPACTED BY MINIMUM 5 PASSES OF A MINIMUM 15 TON VIBRATORY ROLLER WITH VIBRATIONS IN THE RANGE OF 1200 TO 1500 vpm AND THE ROLLER SPEED OF ABOUT 2mph (3.2km/h). EACH LIFT MUST BE "PROOF-ROLLED" PRIOR TO PLACING THE SUBSEQUENT LIFT.

**TYPE 12 (RUN OF MINE, TYPICALLY 600mm MINUS):**  
THE ROCKFILL, IF USED, MUST BE PLACED IN LIFTS NOT EXCEEDING 1000mm. THE ROCKFILL SHALL BE COMPACTED BY MINIMUM 5 PASSES OF A MINIMUM 15 TON VIBRATORY ROLLER WITH VIBRATIONS IN THE RANGE OF 1200 TO 1500 vpm AND THE ROLLER SPEED OF ABOUT 2mph (3.2km/h). ALTERNATIVE COMPACTION METHODS SUCH AS HEAVY LOADED RUBBER TIRED HAUL TRUCKS CAN ONLY BE USED AS PER A WRITTEN APPROVAL FROM THE ENGINEER.



REDLINE DRAWING

CHANGES, ADDITIONS, DELETIONS AND RELOCATIONS IN RED INK USING STANDARD SYMBOLS, DELETIONS TO BE CLOUDED AND HATCHED.

REDLINE BY: ☒ CONSTRUCTION ☐ COMMISSIONING ☐ SUSTAINMENT

NAME/SIGN: [Signature] COMPANY: NUNA

DATE OF AS-BUILT: 9/26/19 ☒ CHECK IF NO CHANGE

CHECKED BY: [Signature]

NAME/SIGN: [Signature] COMPANY: Hatch

PERMIT TO PRACTICE  
HATCH LTD.  
Signature: [Signature]  
Date: 2018-09-20  
PERMIT NUMBER: P 512  
The Association of Professional Engineers, Geologists and Geophysicists of NWT/NNU

FOR CONSTRUCTION

THIS DRAWING WAS PREPARED BY HATCH LTD. (HATCH) FOR THE EXCLUSIVE USE OF BAFFINLAND IRON MINES LP (CLIENT) AND ITS USE IS SUBJECT TO THE TERMS AND CONDITIONS OF THE CONTRACT BETWEEN HATCH AND THE CLIENT. INCLUDING ANY LIMITATIONS ON LIABILITY CONTAINED THEREIN. THIS DRAWING AND ITS CONTENTS REMAIN THE INTELLECTUAL PROPERTY OF HATCH SUBJECT TO CLIENT'S ROYALTY-FREE, IRREVOCABLE, PERPETUAL AND NON-EXCLUSIVE LICENSE TO USE AND REPRODUCE THE DRAWING FOR PURPOSES CONNECTED WITH THE PROJECT, INCLUDING THE CONSTRUCTION, COMPLETION, MAINTENANCE, EXTENSION, REINSTATEMENT AND REPAIR OF THE PROJECT. THIS DRAWING, AND THE INFORMATION CONTAINED HEREIN, SHALL BE TREATED AS CONFIDENTIAL FOR ALL OTHER PURPOSES AND SHALL NOT BE DISCLOSED WITHOUT THE WRITTEN CONSENT OF HATCH.

HATCH

Baffinland

BAFFINLAND IRON MINES LP  
MARY RIVER EXPANSION PROJECT

SITE WIDE  
STANDARD DRAWING  
EARTHWORKS & DRAINAGE DETAILS


DRAFTSPERSON	I BARNARD	NR	16/08/2018
DESIGNER	I BARNARD	NR	16/08/2018
CHECKER	F HUGO		2018-09-20
DESIGN COORD.	R GOOSEN		2018-09-20
RESP. ENG.	R HALIM		2018-09-20
LEAD DISC. ENG.	A GROBBELAAR		2018-09-20
AREA LEAD	V LAVRIC		2018-09-20
ENG. MANAGER	D STANGER		2018-09-20
AREA MANAGER	T ATIBA		2018-09-20

ROLE	NAME	SIGNATURE	DATE

DRAWING APPROVAL STATUS: Approved for Construction

SCALE	DWG. No.	REV
NTS	H353004-00000-221-294-0006-0001	1

Released for Use

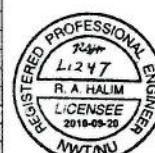


REG. PROFESSIONAL

No.	DESCRIPTION	BY	CHKD	DATE
1	MATERIALS AND COMPACTION SPECIFICATION ADDED	IHB	FH	16/08/2018
0	APPROVED FOR CONSTRUCTION	IHB	FH	01/12/2017

DRAWING No.	DRAWING TITLE

REFERENCE DRAWINGS



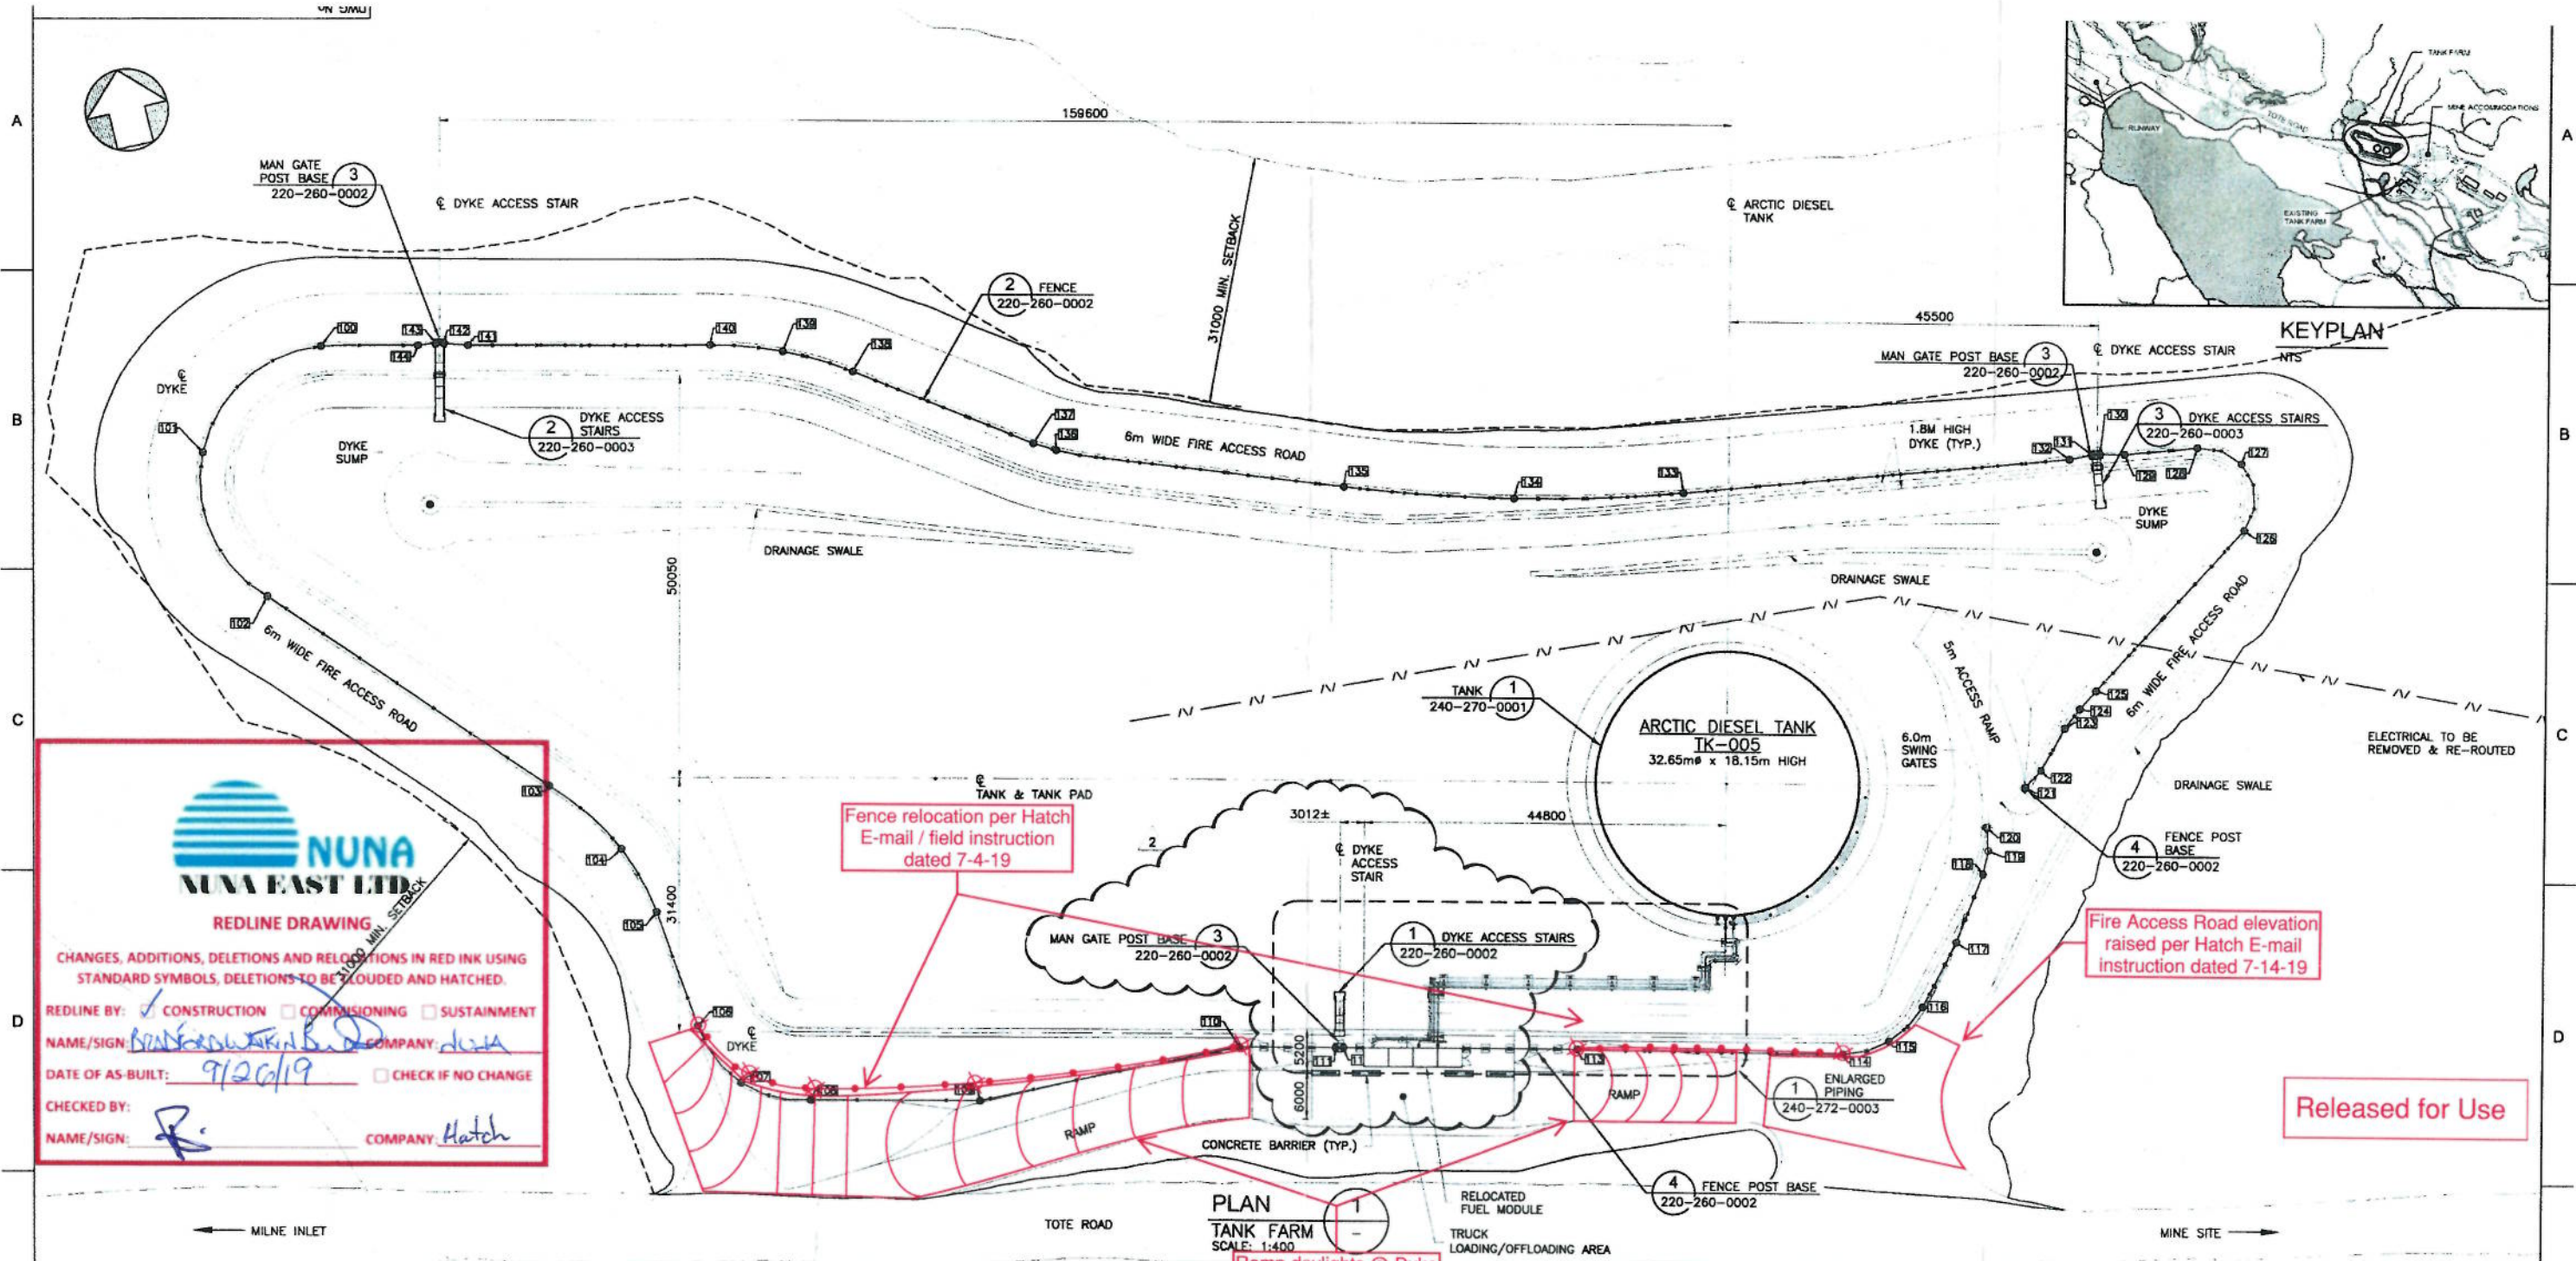

**NUNA**  
NUNA EAST LTD.

**REDLINE DRAWING**

CHANGES, ADDITIONS, DELETIONS AND RELOCATIONS IN RED INK USING STANDARD SYMBOLS, DELETIONS TO BE CLOUDED AND HATCHED.

REDLINE BY: ☒ CONSTRUCTION ☐ COMMISSIONING ☐ SUSTAINMENT

NAME/SIGN: *[Signature]* COMPANY: *NUNA*

DATE OF AS-BUILT: *9/26/19* ☐ CHECK IF NO CHANGE

CHECKED BY: *[Signature]* COMPANY: *Hatch*

Fence relocation per Hatch  
E-mail / field instruction  
dated 7-4-19

Fire Access Road elevation  
raised per Hatch E-mail  
instruction dated 7-14-19

Released for Use

FENCE LAYOUT POINTS				
TARGET No.	FEATURE	ELEVATION	NORTHING	EASTING
100	FENCE LINE	188.499	7913528.838	560972.407
101	FENCE LINE	188.500	7913519.482	560955.090
102	FENCE LINE	188.553	7913500.154	560958.592
103	FENCE LINE	188.500	7913489.092	560986.862
104	FENCE LINE	187.736	7913459.323	560893.725
105	FENCE LINE	187.598	7913450.688	560896.156
106	FENCE LINE	186.790	7913436.441	560997.802
107	FENCE LINE	186.198	7913428.210	561001.279
108	FENCE LINE	186.091	7913424.256	561009.028

FENCE LAYOUT POINTS				
TARGET No.	FEATURE	ELEVATION	NORTHING	EASTING
109	FENCE LINE	186.093	7913428.838	561030.876
110	FENCE LINE	186.754	7913420.916	561030.876
111	FENCE LINE - MAN GATE	190.065	7913420.916	561030.876
112	FENCE LINE - MAN GATE	190.065	7913414.457	561075.146
113	FENCE LINE	190.208	7913407.836	561083.837
114	FENCE LINE	189.400	7913399.723	561135.082
115	FENCE LINE	189.763	7913399.517	561141.050
116	FENCE LINE	189.704	7913402.001	561140.134
117	FENCE LINE	189.901	7913409.631	561152.119

FENCE LAYOUT POINTS				
TARGET No.	FEATURE	ELEVATION	NORTHING	EASTING
118	FENCE LINE	190.084	7913417.063	561157.195
119	FENCE LINE	190.085	7913419.740	561158.549
120	FENCE LINE - ACCESS GATE	190.094	7913422.647	561159.025
121	FENCE LINE - ACCESS GATE	190.095	7913428.344	561184.840
122	FENCE LINE	190.065	7913427.957	561187.280
123	FENCE LINE	189.952	7913432.372	561171.338
124	FENCE LINE	189.790	7913434.284	561173.668
125	FENCE LINE	189.747	7913435.982	561176.126
126	FENCE LINE	189.697	7913451.155	561198.459

FENCE LAYOUT POINTS				
TARGET No.	FEATURE	ELEVATION	NORTHING	EASTING
127	FENCE LINE	189.689	7913458.345	561200.040
128	FENCE LINE	189.700	7913462.538	561195.158
129	FENCE LINE	189.700	7913463.816	561186.250
130	FENCE LINE - MAN GATE	189.549	7913464.540	561183.323
131	FENCE LINE - MAN GATE	189.549	7913464.663	561182.333
132	FENCE LINE	189.700	7913464.778	561179.541
133	FENCE LINE	189.689	7913471.591	561132.027
134	FENCE LINE	189.303	7913475.753	561111.453
135	FENCE LINE	188.502	7913482.042	561091.427

FENCE LAYOUT POINTS				
TARGET No.	FEATURE	ELEVATION	NORTHING	EASTING
136	FENCE LINE	188.501	7913484.780	561057.768
137	FENCE LINE	188.508	7913496.291	561055.176
138	FENCE LINE	188.500	7913510.128	561035.567
139	FENCE LINE	188.500	7913514.594	561027.772
140	FENCE LINE	188.500	7913517.485	561019.251
141	FENCE LINE	188.500	7913524.603	560990.113
142	FENCE LINE - MAN GATE	188.378	7913525.551	560987.266
143	FENCE LINE - MAN GATE	188.378	7913525.789	560986.295
144	FENCE LINE	188.500	7913526.079	560984.086

DRAWING No.	DRAWING TITLE
H353004-10000-240-272-0003-0001	MINE SITE TANK FARM ENLARGED PIPING PLAN
H353004-10000-220-260-0002-0001	MINE SITE TANK FARM DYKE MISCELLANEOUS DETAILS
H353004-10000-220-260-0003-0001	MINE SITE TANK FARM DYKE ACCESS STAIRS
H353004-10000-240-270-0001-0001	MINE SITE 15,000,000L ARCTIC DIESEL TANK TK-005
H353004-10000-240-270-0002-0001	MINE SITE 15,000,000L ARCTIC DIESEL TANK TK-006
H353004-10000-220-272-0009-0001	MINE SITE TANK FARM GRADING PLAN
H353004-10000-220-273-0001-0001	MINE SITE TANK FARM DYKE SECTIONS A TO D
H353004-10000-220-273-0002-0001	MINE SITE TANK FARM DYKE SECTIONS E & F
H353004-10000-220-273-0003-0001	MINE SITE TANK FARM DYKE SECTION G & H
H353004-10000-260-272-0005-0001	MINE SITE TANK FARM ELECTRICAL GENERAL ARRANGEMENT
H353004-10000-260-272-0007-0001	MINE SITE TANK FARM GROUNDING PLAN

FOR CONSTRUCTION

No.	DESCRIPTION
3	DYKE ACCESS STAIR AND FENCE MANGATE, RELOCATED AND FENCE LAYOUT POINT TABLE REVISED TO SUIT
2	ADDITIONAL STORAGE TANK TK-008 AND PIPING ADDED
1	DYKE LAYOUT, FENCING REVISED & ACCESS STAIR CALLOUT BUBBLE REVISED
0	ISSUED FOR CONSTRUCTION

HATCH			
DRAFTSPERSON	H. P. CURRIE	NR	18-07-06
DESIGNER	K. MACLEAN	NR	18-07-06
CHECKER	M. MACINTYRE	<i>Michael MacIntyre</i>	<i>17-06-17</i>
DESIGN COORD.	M. MACINTYRE	<i>Michael MacIntyre</i>	<i>17-06-17</i>
RESP. ENG.	F. BUTTS	<i>FB</i>	<i>17-06-17</i>
LEAD DISC. ENG.	K. MACLEAN	<i>K Maclean</i>	<i>17-06-17</i>
AREA LEAD	N MASON		
PROJ. MANAGER			
CLIENT	D. HENKELMAN	<i>D Henkelman</i>	<i>18-07-06</i>
ROLE	NAME	SIGNATURE	DATE

**HATCH**

**Baffinland**

MARY RIVER EXPANSION PROJECT  
BAFFINLAND IRON MINES LP

MINE SITE  
TANK FARM  
GENERAL ARRANGEMENT

SCALE: 1:400  
OR AS NOTED



DWG. No. H353004-10000-240-272-0002-0001

REV 3

SCALE: 1:400  
0m 10m 20m 30m

PERMIT TO PRACTICE  
HATCH LTD  
Signature: *[Signature]*  
Date: *19/10/19*  
PERMIT NUMBER: P 512  
The Association of Professional Engineers, Geologists and Geophysicists of NWT/NU



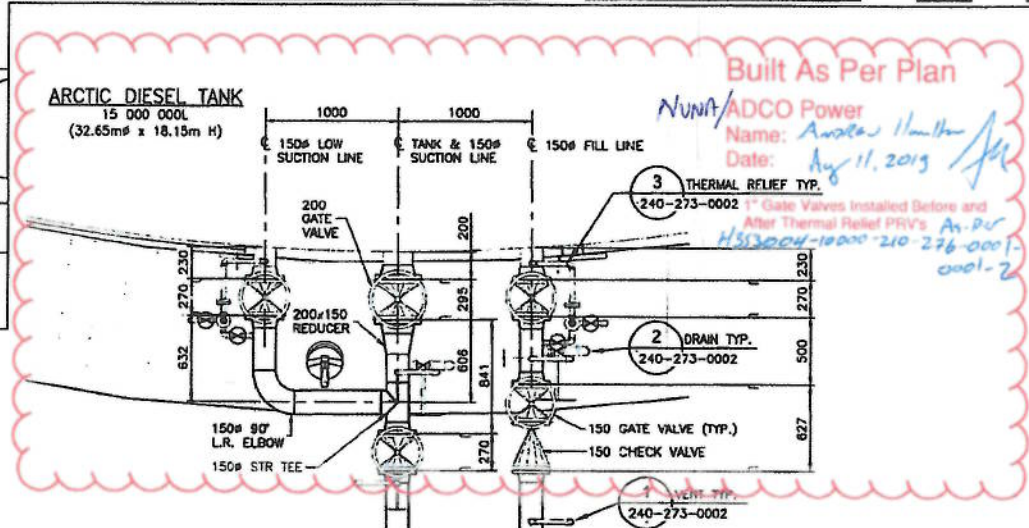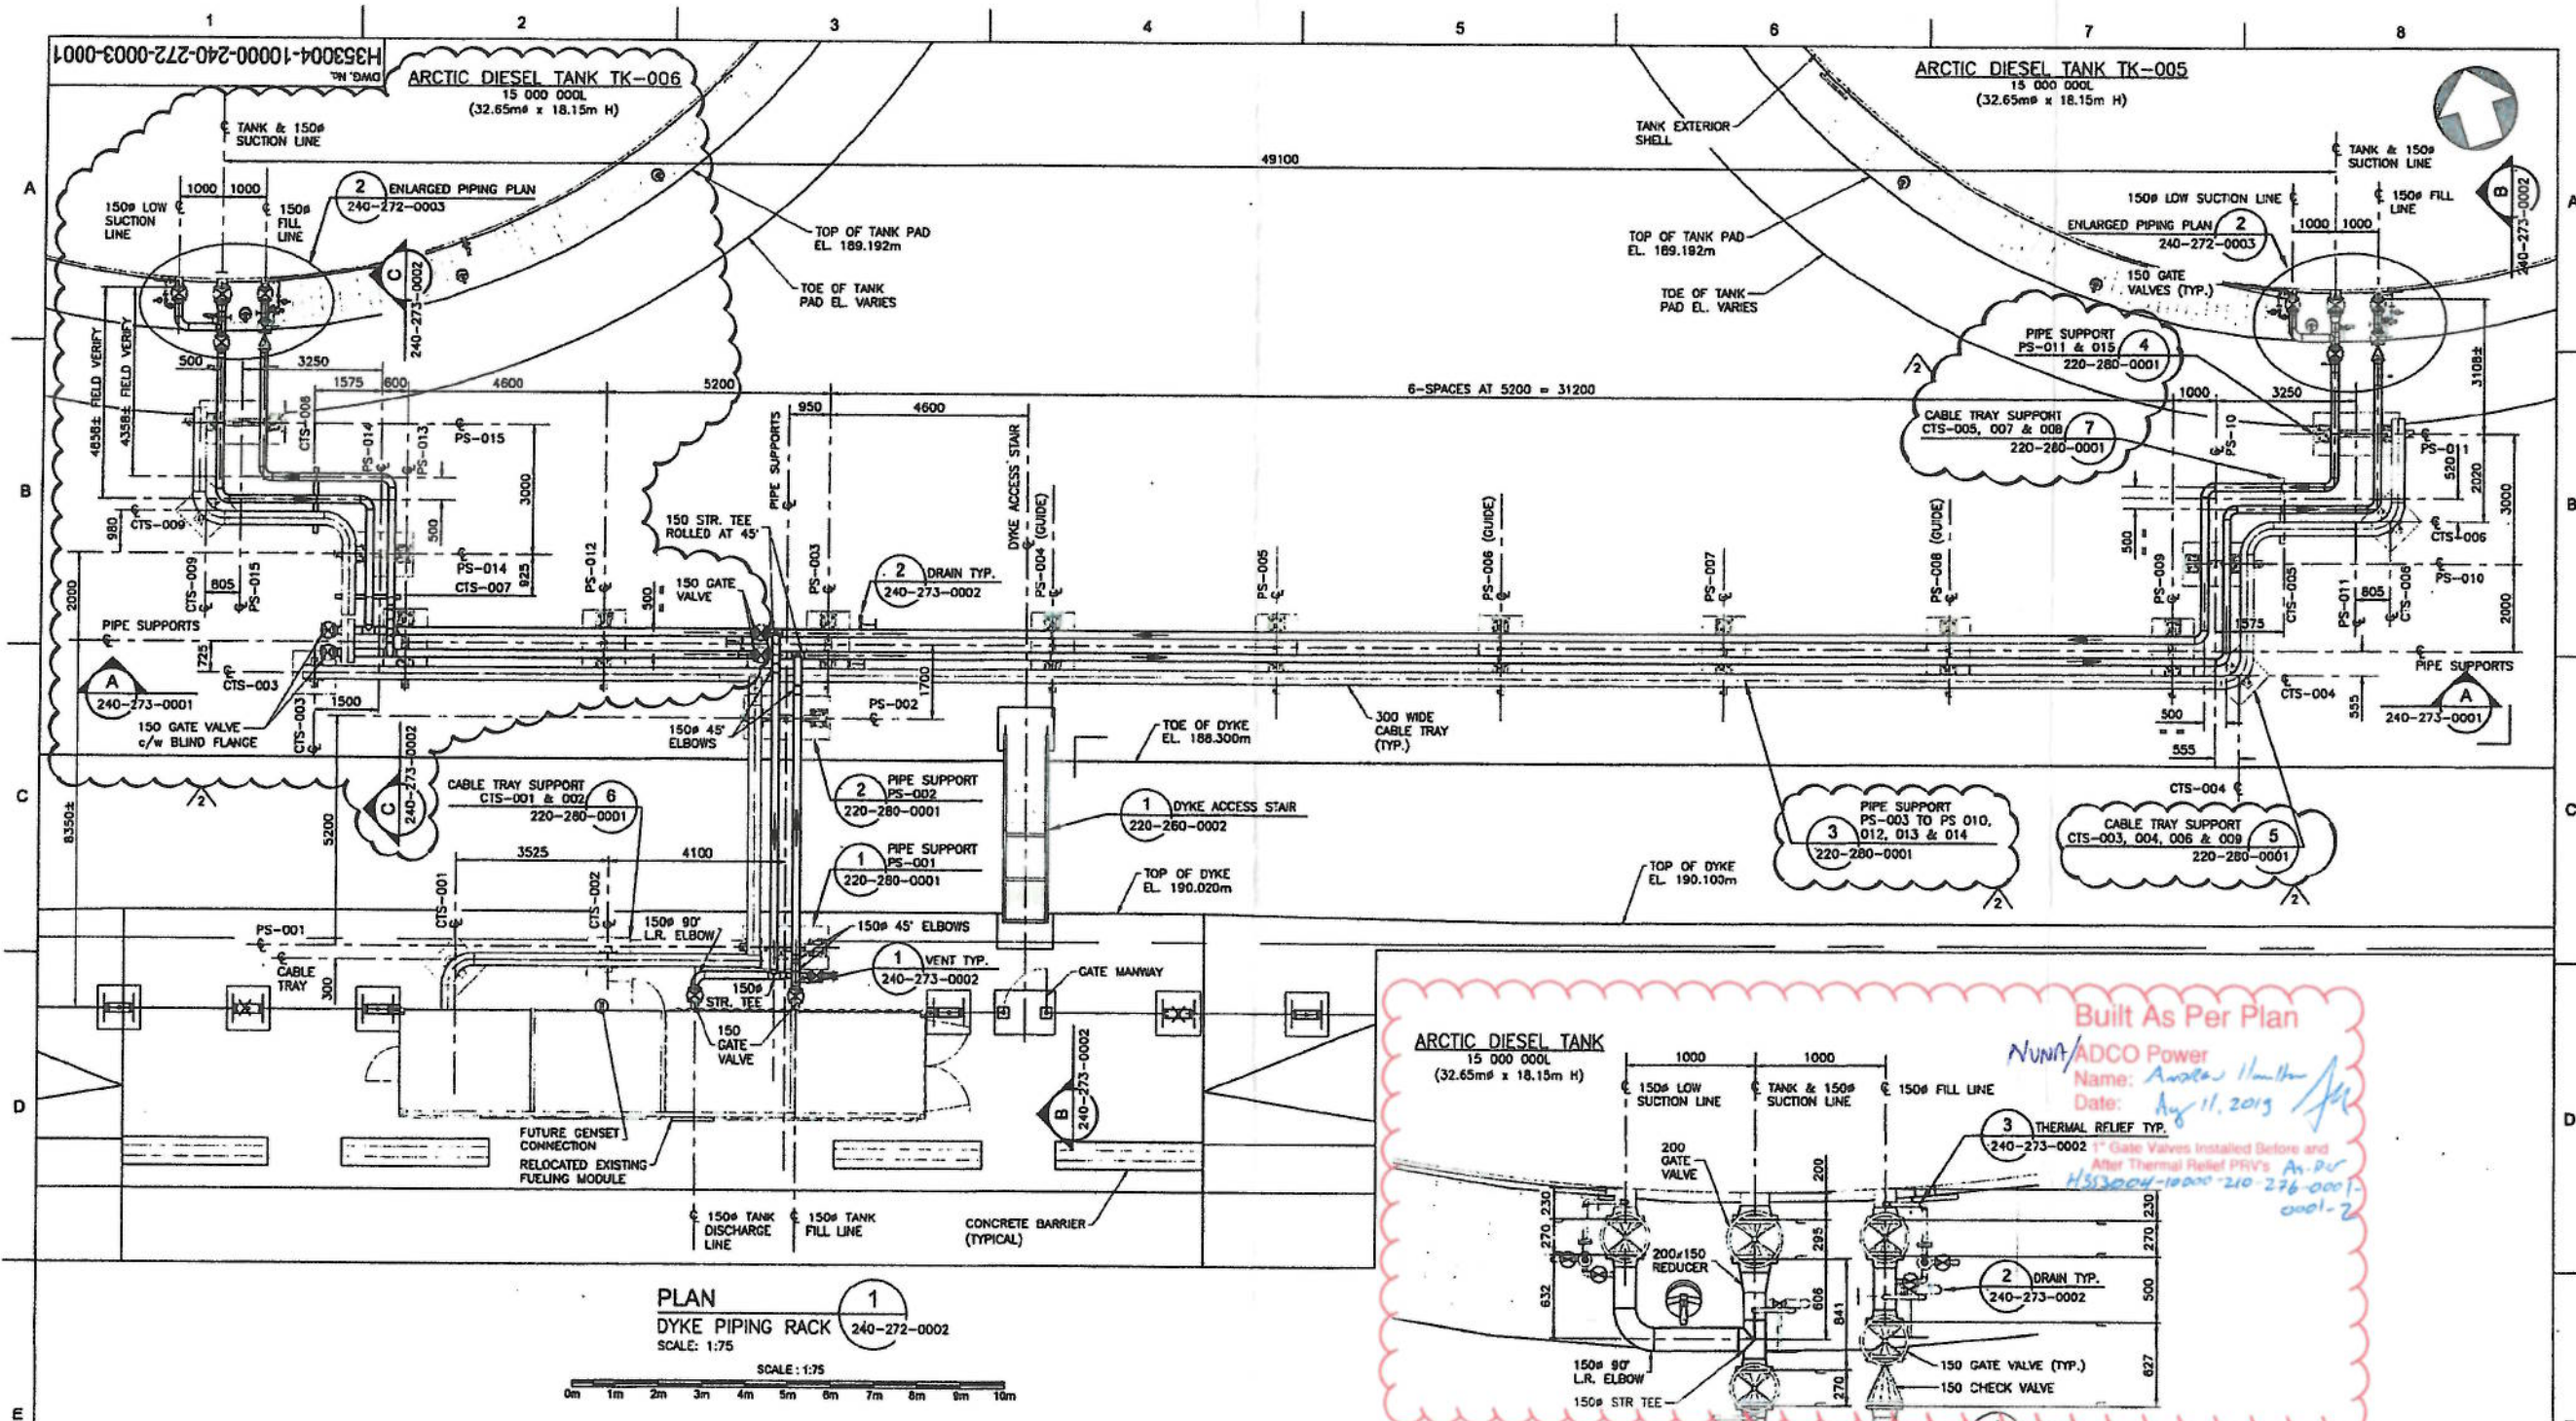

H353004-10000-210-276-0001-0001	MINE SITE ADDITIONAL TANK FARM STORAGE P&ID
H353004-10000-210-282-0001-0001	MINE SITE FUEL SYSTEM PROCESS FLOW DIAGRAM
H353004-10000-240-272-0002-0001	MINE SITE TANK FARM GENERAL ARRANGEMENT
H353004-10000-240-273-0003-0001	MINE SITE 15,000,000L ARCTIC DIESEL TANK TK-005
H353004-10000-240-273-0003-0002	MINE SITE 15,000,000L ARCTIC DIESEL TANK TK-006
H353004-10000-240-273-0003-0003	MINE SITE TANK FARM PIPING SECTION-A
H353004-10000-240-273-0003-0004	MINE SITE TANK FARM PIPING SECTIONS & MISCELLANEOUS DETAILS
H353004-10000-220-280-0001-0001	MINE SITE TANK FARM PIPE SUPPORTS
H353004-10000-220-280-0002-0001	MINE SITE PIPE SUPPORTS CONCRETE BASE DETAILS
H353004-10000-260-272-0005-0001	MINE SITE TANK FARM ELECTRICAL GENERAL ARRANGEMENT
H353004-10000-260-272-0007-0001	MINE SITE TANK FARM GROUNDING PLAN
H353004-10000-260-260-0001-0001	MINE SITE ELECTRICAL DETAILS



No.	DESCRIPTION	DATE	BY	CHKD
2	ADDITIONAL STORAGE TANK TK-005 AND PIPING ADDED	19-01-19	MM	MM
1	PS-011 LOCATION REVISED	18-07-25	MM	MM
0	ISSUED FOR CONSTRUCTION			

HATCH			
DRAFTSPERSON	H. P. CURRIE	NR	18-08-19
DESIGNER	J. MacLEAN	NR	18-08-19
CHECKER	M. MacINTYRE	19-01-19	19-01-19
DESIGN COORD.	M. MacINTYRE	19-01-19	19-01-19
RESP. ENG.	F. BUTTS	19-01-19	19-01-19
LEAD DISC. ENG.	J. MacLEAN	19-01-19	19-01-19
ENG. MANAGER	G. PEACE	19-01-19	19-01-19
AREA MANAGER	H. WEAVER	19-01-19	19-01-19
CLIENT	T. ATIBA	19-01-19	19-01-19


Baffinland	
MARY RIVER EXPANSION PROJECT BAFFINLAND IRON MINES LP	
MINE SITE TANK FARM ENLARGED PIPING PLAN	
SCALE 1:75 OR AS NOTED	DWG. No. H353004-10000-240-272-0003-0001
REV 2	SHEET SIZE: A1

PERMIT TO PRACTICE  
HATCH LTD.  
Signature: [Signature]  
Date: 19/01/19  
PERMIT NUMBER: P 212  
The Association of Professional Engineers,  
Geologists and Geophysicists of NWT/NU



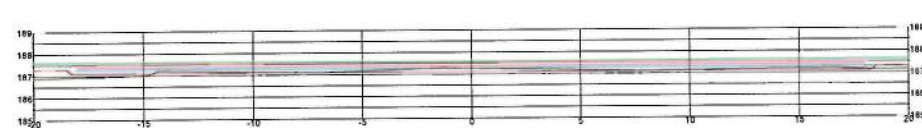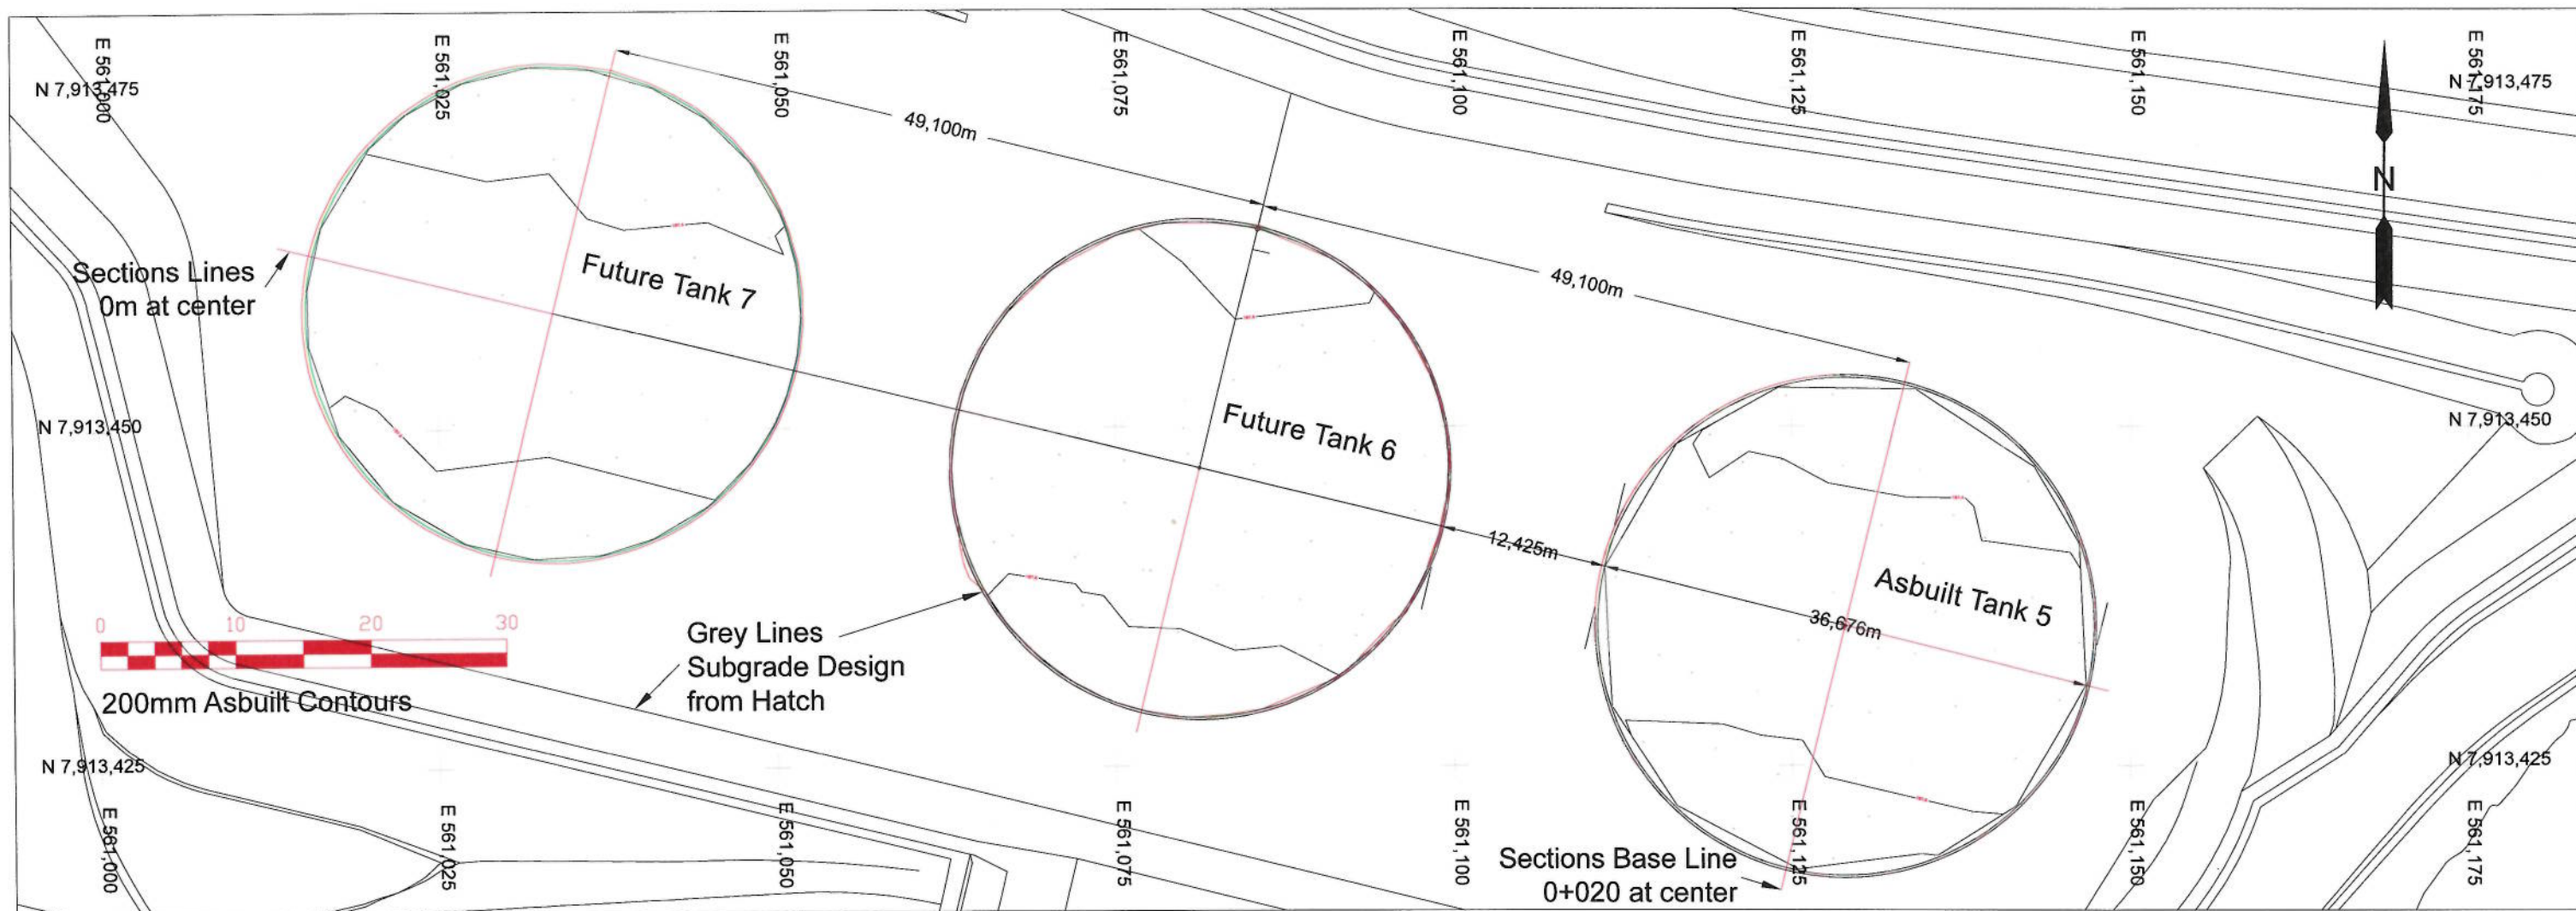

0 + 020 Tank 7

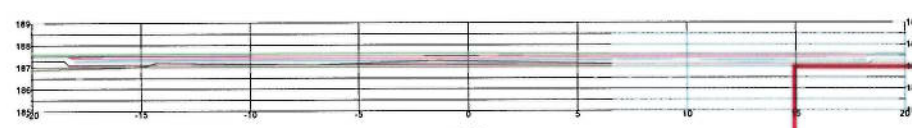

0 + 020 Tank 6



0 + 020 Tank 5

- Asbuilt Tank 5 Pedestal
- Asbuilt Type 6 100mm
- Asbuilt Insulation 100mm
- Asbuilt Type 6 100mm
- Asbuilt Type 5 176mm
- Asbuilt Subgrade
- Subgrade Design
- Original Ground

**NUNA**  
NUNA EAST LTD  
AS-BUILT DRAWING

I HEREBY VERIFY THAT THIS DRAWING ACCURATELY REFLECTS THE "AS BUILT" FIELD CONDITION IN CONJUNCTION WITH THE SURVEY AS-BUILT DATA.

AS BUILT BY: ☒ CONSTRUCTION ☐ COMMISSIONING ☐ SUSTAINMENT  
NAME/SIGN: *DAVID L. WILSON* COMPANY: *NUNA*  
DATE OF AS-BUILT: *9/30/19* ☐ CHECK IF NO CHANGE  
CHECKED BY: \_\_\_\_\_  
NAME/SIGN: \_\_\_\_\_ COMPANY: \_\_\_\_\_

NOTES:  
Pedestal Subgrade Prepared based on IFC coordinates for Tanks 5 & 6, for Tank 7 as directed by Hatch  
Ref. drawing H35004-10000-220-272-0012-0001 Rev1 (Rev0 for Tank 7)  
NOTE Red Lines RFI 003 Pt# 705 change to 187.192 & pt # 710 change to 187.111  
Red Lines RFI 0010 Insulation thickness 100mm thus type 5 reduced from 200mm to 176mm  
Red Line References RFI-003, 005, 007, 0010.

Coordinate System:  
UTM Zone 17 North  
Nad 1983 (Canada)  
Geoid HT2\_0  
Base Station: @ ID # Rebar-01  
N 7913406.434  
E 561204.787  
Z 198.991

CLIENT:  
Baffinland Iron Mines Corporation

PROJECT:  
Mary River Expansion Project,  
Baffin Island, Nunavut

PREPARED BY:  
Nuna East Ltd.  
9839 - 31 Avenue  
Edmonton, AB  
T6N 1C5

DRAWN BY:  
mc

**NUNA**


SCALE:  
barscale


DATE:  
Sept, 2019

DRAWING TITLE:  
Mary River Tank Farm  
Pedestal Foundation  
Tanks 5 & Tank 6 & Tank 7  
Insulation Asbuilt

DRAWING NAME (YYMMDD):  
As Built MRTF Pedestal Insulation Tanks 5 & 6 & 7 2019.dwg



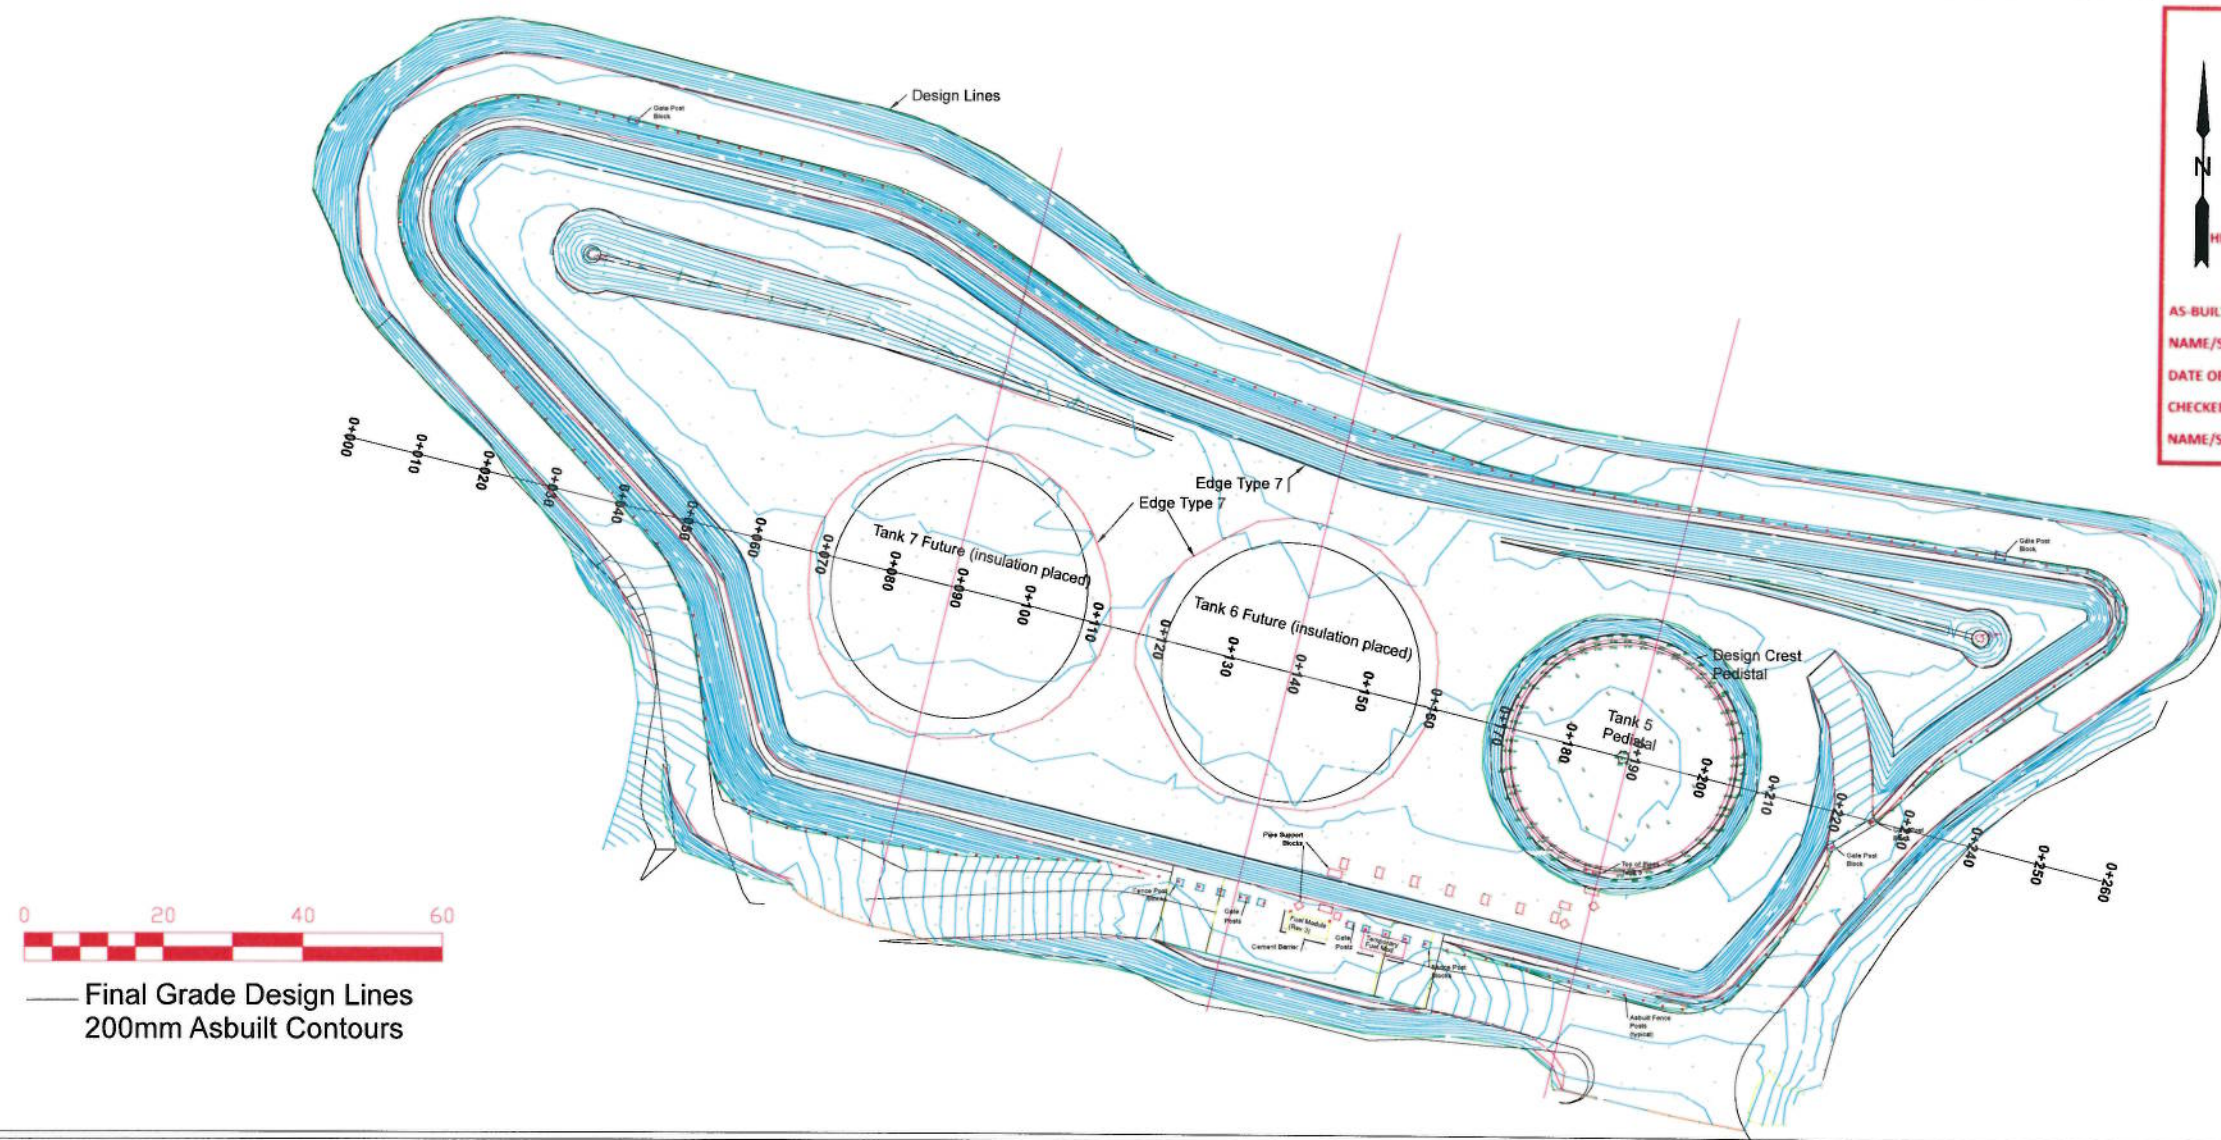




**NUNA**  
NUNA EAST LTD


**AS-BUILT DRAWING**

HEREBY VERIFY THAT THIS DRAWING ACCURATELY REFLECTS THE  
"AS BUILT" FIELD CONDITION IN CONJUNCTION  
WITH THE SURVEY AS-BUILT DATA.



AS-BUILT BY: ☒ CONSTRUCTION ☐ COMMISSIONING ☐ SUSTAINMENT  
NAME/SIGN: [Signature] COMPANY: NUNA  
DATE OF AS-BUILT: 9/30/19 ☐ CHECK IF NO CHANGE  
CHECKED BY: \_\_\_\_\_  
NAME/SIGN: \_\_\_\_\_ COMPANY: \_\_\_\_\_

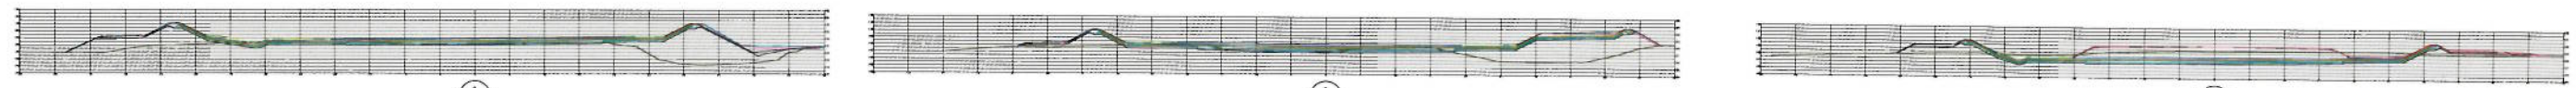


- Subgrade & Final Grade design lines
- Asbuilt Subgrade
- Asbuilt Type 5 Lower Placement
- Asbuilt Type 6 Lower Placement (Liner Surface)
- Asbuilt Type 6 Upper Placement (Liner Cover)
- Asbuilt Type 5 Upper Placement & Access Road Topping
- Asbuilt Type 7 (excluding future tank 6 & 7)
- Asbuilt Tank 5 Pedestal

NOTES:	CLIENT: Baffinland Iron Mines Corporation	PREPARED BY: Nuna East Ltd. 9839 - 31 Avenue Edmonton, AB T6N 1C5		DRAWING TITLE: <b>Mary River Tank Farm Final Asbuilt Aug 15, 2019</b>
	PROJECT: Mary River Expansion Project, Baffin Island, Nunavut	DRAWN BY: mc	SCALE: barscale	DATE: Aug 15 2019
				DRAWING NAME (YYMMDD): CC005-0001A-MRTF Final Asbuilt.dwg



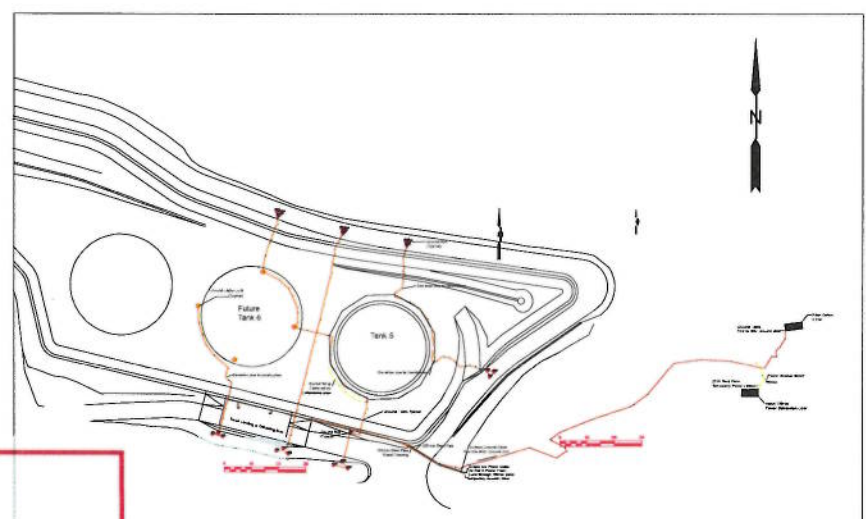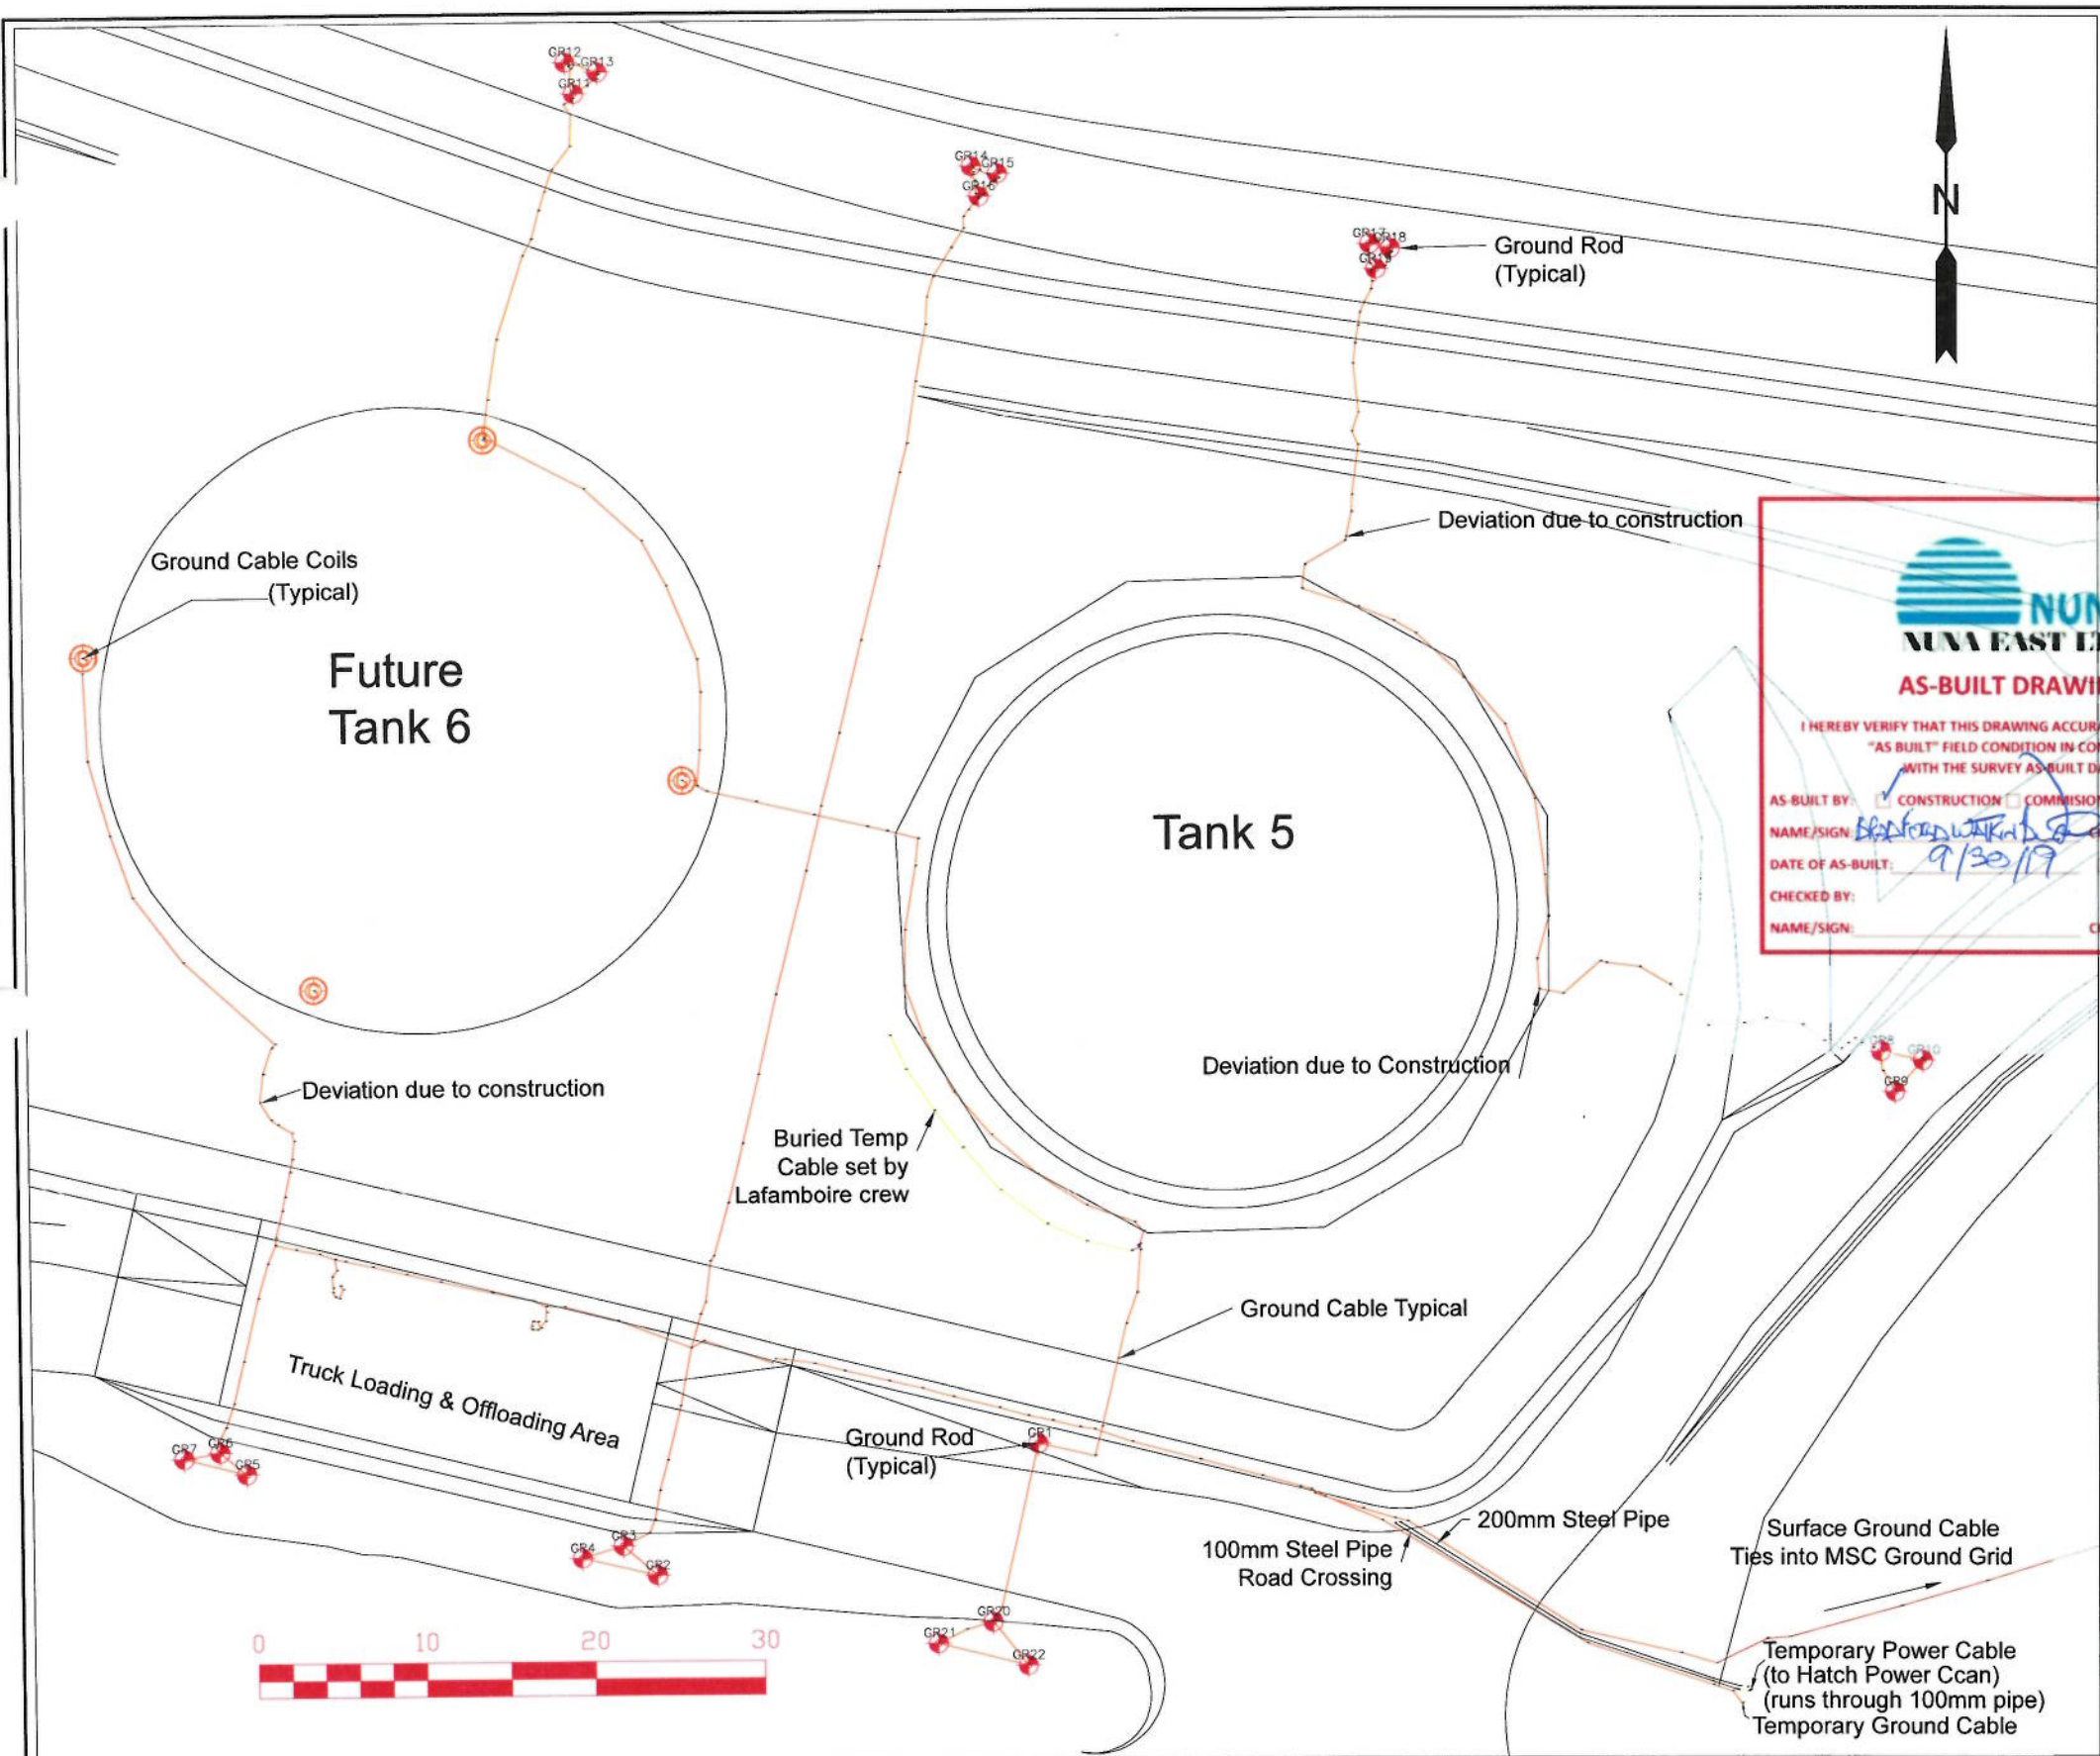



**NUNA EAST LTD**  
**AS-BUILT DRAWING**

I HEREBY VERIFY THAT THIS DRAWING ACCURATELY REFLECTS THE "AS BUILT" FIELD CONDITION IN CONJUNCTION WITH THE SURVEY AS-BUILT DATA.

AS-BUILT BY: ☒ CONSTRUCTION ☐ COMMISSIONING ☐ SUSTAINMENT  
NAME/SIGN: *[Signature]* COMPANY: *NUNA*  
DATE OF AS-BUILT: *9/30/19* ☐ CHECK IF NO CHANGE  
CHECKED BY: \_\_\_\_\_  
NAME/SIGN: \_\_\_\_\_ COMPANY: \_\_\_\_\_

2019 Mary River Tank Farm Grounding Grid:  
Grounding Grid buried inside farm & on surface east of steel pipe.  
Ground Cables tie into the MSC Ground Grid at fiber optics Ccan.  
Temporary Power Line runs through the 100mm steel pipe & terminates at the Hatch Office Power Distribution Ccan.  
Ground Rods (GR1-GR22) were drilled July 26/19 & Elevations at top of installed ground rods were surveyed.

Rod ID	Northing	Easting	Top of Rod	Descrip
GR1	7913404.06	561117.79	189.48	Top Grou
GR2	7913396.42	561095.15	189.21	Top Grou
GR3	7913398.17	561093.14	190.35	Top Grou
GR4	7913397.45	561090.71	189.67	Top Grou
GR5	7913402.58	561070.87	189.82	Top Grou
GR6	7913403.87	561069.29	190.34	Top Grou
GR7	7913403.52	561067.16	189.75	Top Grou
GR8	7913426.92	561167.92	189.52	Top Grou
GR9	7913424.55	561168.76	189.66	Top Grou
GR10	7913426.39	561170.43	189.74	Top Grou
GR11	7913483.87	561091.10	187.84	Top Grou
GR12	7913485.73	561090.61	187.75	Top Grou
GR13	7913485.14	561092.51	187.79	Top Grou
GR14	7913479.39	561114.48	188.24	Top Grou
GR15	7913478.97	561116.02	188.23	Top Grou
GR16	7913477.62	561114.91	188.30	Top Grou
GR17	7913474.69	561137.94	188.82	Top Grou
GR18	7913474.42	561139.15	188.79	Top Grou
GR19	7913473.20	561138.30	188.74	Top Grou
GR20	7913393.52	561115.01	188.79	Top Grou
GR21	7913392.27	561111.74	188.84	Top Grou
GR22	7913390.96	561117.08	188.81	Top Grou

NOTES:

- Ground Rods drilled & asbuilt July 26, 2019
- xref files: AB 2019 MRTF Ground Rods.xml & .pdf
- CAB 190903 MRTF Tk 5 & 6 Grnd Cables-Rods & Pipe Crossing.csv
- Final Grade Design Lines
- Ground Cable Coils at Future Tank 6
- Ground Rod (Top of Rod)


Coordinate System:  
UTM Zone 17 North  
Nad 1983 (Canada)  
Geoid HT2\_0  
Base Station: @ ID # Rebar-01  
N 7913406.434  
E 561204.787  
Z 198.991

CLIENT:  
Baffinland Iron Mines Corporation

PROJECT:  
Mary River Expansion Project,  
Baffin Island, Nunavut

PREPARED BY:  
Nuna East Ltd.  
9839 - 31 Avenue  
Edmonton, AB  
T6N 1C5

DRAWN BY:  
MC



SCALE:  
barscale

DATE:  
Sept. 3, 2019

DRAWING TITLE:  
**Mary River Tank Farm  
Ground Grid & Rods  
Asbuilt 2019**

DRAWING NAME (YYMMDD):  
CAB 190903 MRTF Tk 5 & 6 Grnd Cables-Rods & Pipe Crossing.dwg



SECTION OF SHELL

LONG. WELD (TYP)

ELEVATION

NAME PLATE DETAIL - TK-005

NAME PLATE DETAIL - TK-006

INSIDE RING

REGISTERED PROFESSIONAL ENGINEER  
M. NAWAR  
N. Nawar, P. Eng.  
June 18, 2018

## MATERIAL SPECIFICATIONS

### GENERAL NOTES

1. ALL METALLS SHALL BE CLEARLY IDENTIFIED AND PROVED WITH TENSILE CERTIFICATES  
2. ALL PLATE 30T-0055 SHALL STRIKE THE CENTERLINE OF THE TANK.  
3. REPAIRS AT NOZZLES LOCATED ON THE SHELL SHALL BE PROVIDED WITH (1) ONE 1/4" x 1/4" T1 NOSE AND SHALL BE AIR TESTED AT 15 PSIG WITH SOAP SOLUTION.  
4. VISUAL EXAMINATION TO API 650 SECTION 8  
a. ALL SELL PLATE BUTT WELDS  
b. ALL PILET WELDS INCLUDING ROOF PLATE WELDS  
c. SELL TO BOTTOM WELDS  
d. 1) NIPAL, WELD PILES, INSIDE AND OUTSIDE  
2) FINISHED JOINT, INSIDE AND OUTSIDE  
e. REWELD OF NON STRUCTURAL SMALL ATTACHMENTS  
5. SURF WITH TANK (BY LAFRAMBOISE GROUP)  
- FOUR (4) ONE SHAND AND 4.75 WELD / 45181, 150mm [6"] WATER GRAIN CUT VALVES  
IS DESCRIBED IN DRAWING JC-70241-16-38  
- ONE (1) ONLY SHAND AND 4.75 WELD / 45181, 150mm [6"] GAUGE HATCH  
6. SURF WITH TANK (BY HANFMAN GROUP) (10)  
- ONE (1) ONLY DOWNS VALVE LEVER (4), AS DESCRIBED ON DRAWING JC-70241-16-38  
7. REWORKING THIS SHELL MANWAY COVERS, FLANGES AND CORNERS & TOP FLANGES (IN & OUT) SHALL BE 049.21 NOTCH LONGITUDINAL CUT AT 45° (45°) AND FINE GRAY PRACTICE, EXCEPT THAT THE AVERAGE CORNERS & NOTCH LONGITUDINAL VALUES OF 3 SPECTRUMS SHALL NOT BE LESS THAN 41 FOR 16x40mm, 28.1 FOR 40 < 1/4" x 40mm AND 31.1 FOR 45 < 1/4" x 40mm. NO MORE THAN ONE SPECTRUM VALUE SHALL BE LESS THAN THE SPECIFIED MAXIMUM VALUE

AS BUILT AS BUILT


**Laframboise**  
Group Inc.

1397 Rosemount Ave., Cornwall, ONT. K6L 3E5  
TEL: (613) 933-8564 FAX: (613) 933-9310


CLIENT/SR:	BAFFINLAND IRON MINES CORP	CONTRACT NO.:	70942
PROJECT:	MARY ANNE PROJECT - ERP PROJECT NO. 353004		
TITLE:	15,000,000 L ARCTIC DISSOL STORAGE TANKS GENERAL ARRANGEMENT		
TANK NO.:	TX-005 & TX-006		
DRAWN BY: V.N.	DRAWING NO.		REV
DATE: May 22, 2018			
SCALE: AS NOTED	C-70942-LG-31		1
CHECK'D BY: V.N.			




VACUUM BOX TEST  
71032-002

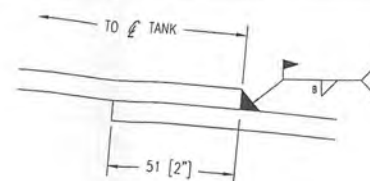


SECTION A-A  
WELD FOR FLOOR

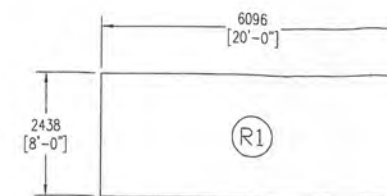


(42) PL. 8mm THK. x 8'-0" x 20'-0" lg.

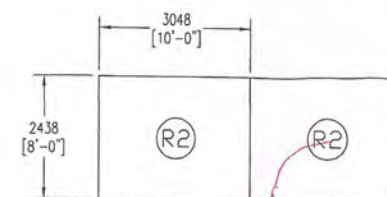


(1) PL. 8mm THK. x 8'-0" x 20'-0" lg.

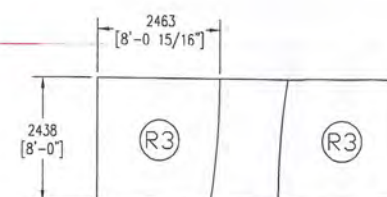


(1) PL, 8mm THK. x 8'-0" x 20'-0" lg.

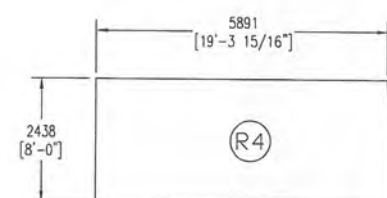


(2) PL. 8mm THK. x 8'-0" x 20'-0" lg.

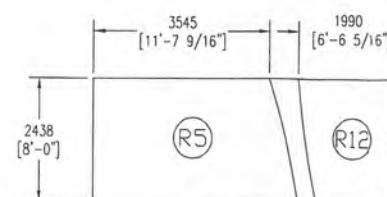


(4) PL. 8mm THK. x 8'-0" x 20'-0" lg.

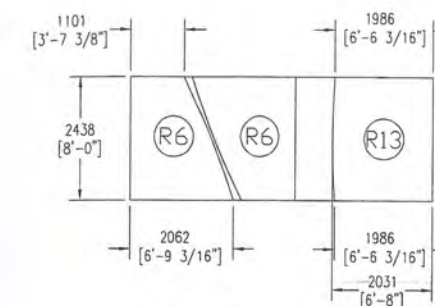


(2) PL. 8mm THK. x 8'-0" x 20'-0" lg.

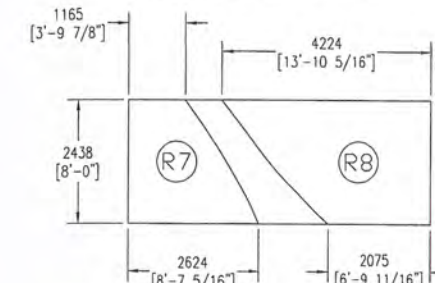

(4) PL, 8mm THK, x 8'-0" x 20'-0" lg.

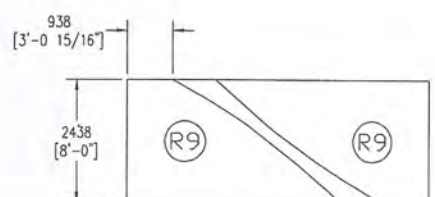

(2) PL. 8mm THK. x 8'-0" x 20'-0" lg.

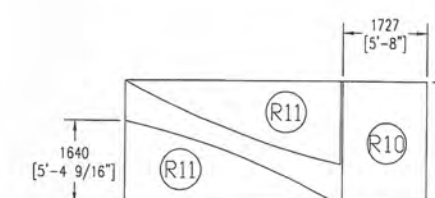

(2) PL. 8mm THK. x 8'-0" x 20'-0" lg.

## AS BUILT

TOTAL PLATES REQ'D  
(60) PL. 8mm x 8'-0" x 20'-0" lg.  
MAT'L: G40.21M GRADE 260WT CAT.4  
KILLED AND FINE GRAIN PRACTICE

AS BUILT



1397 Rosemount Ave., Cornwall, ONT. K6J

CUSTOMER:	BAFFINLAND IRON MINES CORP.	CONTRACT NO.:	30042
-----------	--------------------------------	---------------	-------


PROJECT:	MARY RIVER PROJECT - ERP PROJECT NO. H353004
----------	---

TITLE: 15,000,000 L ARCTIC DIESEL STORAGE TANKS  
ROOF PLATE LAYOUT

TANK NO.: -		
DRAWN BY: M.H.	DRAWING NO.	

DATE: May 22, 2018	C-70942-LG-52
SCALE: AS NOTED	

CHK'D BY: M.N.	
----------------	--

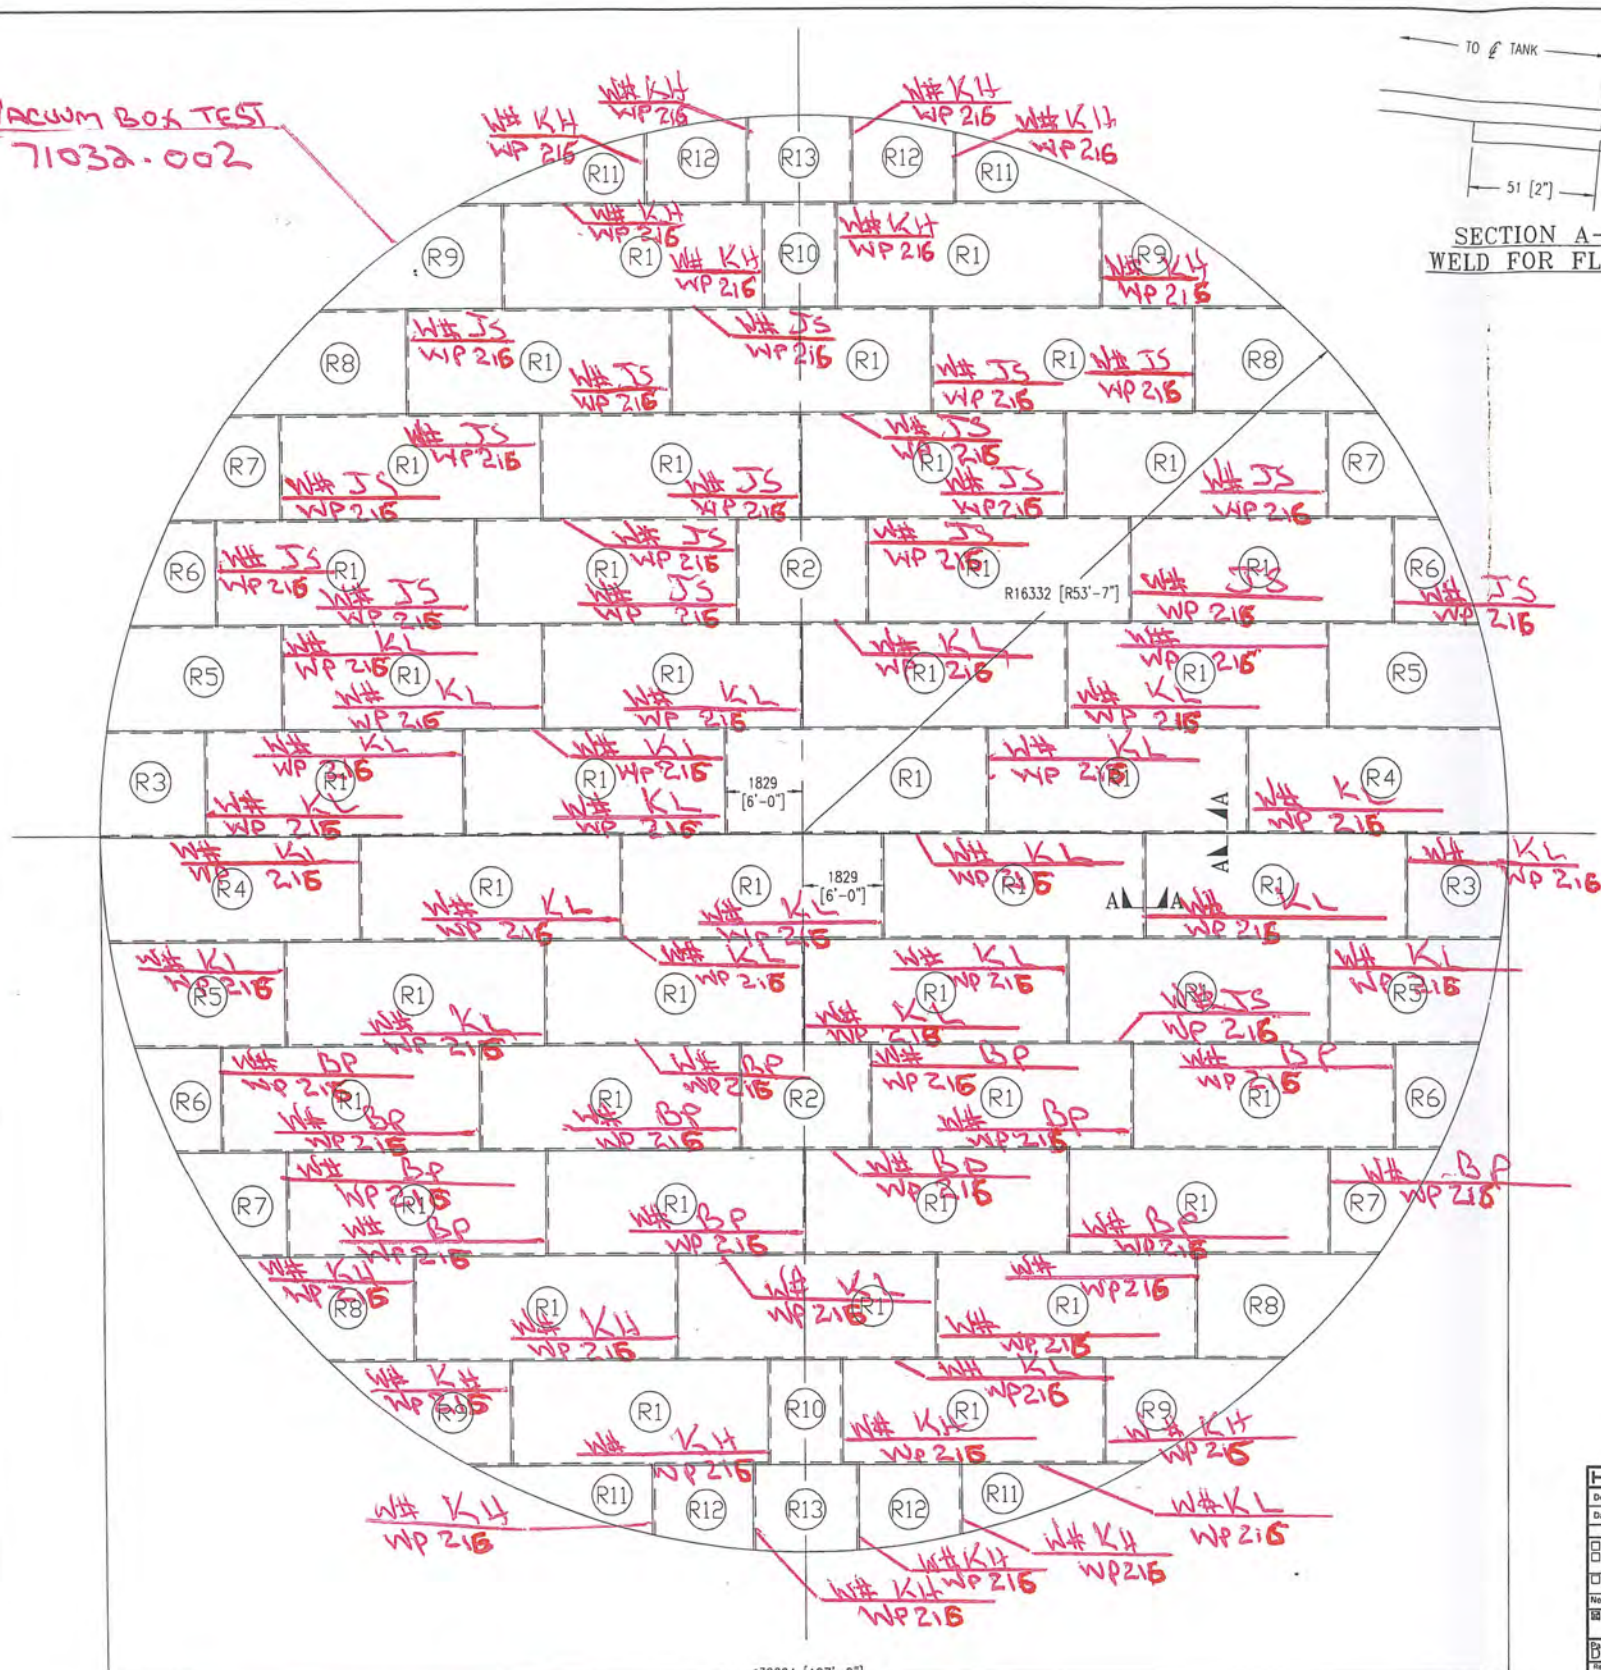

### ROOF PLATE LAYOUT

JASON SEGUIN JS  
KEVIN HARQUAIL KH  
KEVIN LEBUE KL  
DAVE MCLAREN DM  
BRADON POIRICA BP





BSE-WF-216

<b>HATCH</b> Vendor/Contractor Document Review		
Doc Number	E353004-TM091-240-720-021	SUB 01
Date Received		
Review Grade		Next Submittal Status
<input type="checkbox"/> C1 - Proceed in next submission & status	<input type="checkbox"/> Confirmed	
<input type="checkbox"/> C2 - Proceed with exceptions AS noted in next submission & status	<input type="checkbox"/> As-Built	
<input type="checkbox"/> C3 - Do not proceed. Reverts as noted & re-submitted	<input type="checkbox"/> Internal Review	
Next Submittal Status	<input type="checkbox"/> Confirmed <input type="checkbox"/> As-Built	
<input checked="" type="checkbox"/> C4 - No further submission required - Complete (Indicates status below)		
<input type="checkbox"/> Confirmed <input type="checkbox"/> Final <input type="checkbox"/> Cancelled <input type="checkbox"/> Superseded		
Package Engineer: Nanci Zandbergen Date: 1-June-2018		
Reviewed and approved for printing by me (I am a "Print" Approver). Approving the Engineer does not mean that the information contained in the drawing is correct. It only means that I am approving the quality of the drawing for the project design. I agree to disavow all claims with respect to the drawing.		

0	ISSUED FOR APPROVAL		J.C.	D.H.	May 23/1
REV	REVISION	DESCRIPTION	RY	APR/Y	DATE


THIS DOCUMENT, INCLUDING DATA, AND DESIGN, IS THE  
PROPERTY OF LAFRAMBOISE GROUP LTD IT IS  
NOT TO BE COPIED, REPRODUCED OR ITS CONTENTS DIVULGED  
IN PART OR IN WHOLE, WITHOUT THE WRITTEN PERMISSION  
OF LAFRAMBOISE GROUP LTD.

TOLERANCES	
UNLESS OTHERWISE NOTED	
INCHES	METRIC—mm
UNDER 12" ± 0.063"	UNDER 300 ± 1.5
12" TO 120" ± 0.125"	300 TO 3000 ± 3.1
121" TO 240" ± 0.187"	3001 TO 6000 ± 4.7
OVER 240" ± 0.250"	OVER 6000 ± 6.35
ANGULAR ± 0.5°	ANGULAR ± 0.5°
NOT EXCEEDING 0.060"	NOT EXCEEDING 1.5mm
PER 12"	PER 300mm
SURFACE FINISH: (Ra)	SURFACE FINISH: (Ra)
N7=63 N8=125 N9=250	N7=1.6 N8=3.2 N9=6.3

QTY. REQ'D.= (2) TWO
REF. --
--
<p align="center"><u>STANDARD SYMBOLS</u></p> <p>  - DENOTES NOZZLE No.   - DENOTES PART No.   - DENOTES REVISION No.   - DENOTES WELD No. </p> <p> RT - DENOTES RADIOGRAPHY  UT - DENOTES ULTRA-SONIC  PT - DENOTES LIQUID PENETRANT </p>

	
1397 Rosemount Ave., Cornwall, ONT. K6J 3E5 TEL: (613) 933-6664 FAX: (613) 933-9910	
CUSTOMER:	BAFFINLAND IRON MINES CORP.
CONTRACT NO.:	70942
PROJECT:	MARY RIVER PROJECT - ERP PROJECT NO. HJ353004
TITLE:	15,000,000 L ARCTIC DIESEL STORAGE TANKS ROOF PLATE LAYOUT
TANK NO. :-	
DRAWN BY: M.H.	DRAWING NO.
DATE: May 22, 2018	
SCALE: AS NOTED	C-70942-LG-52
CHK'D BY: M.N.	




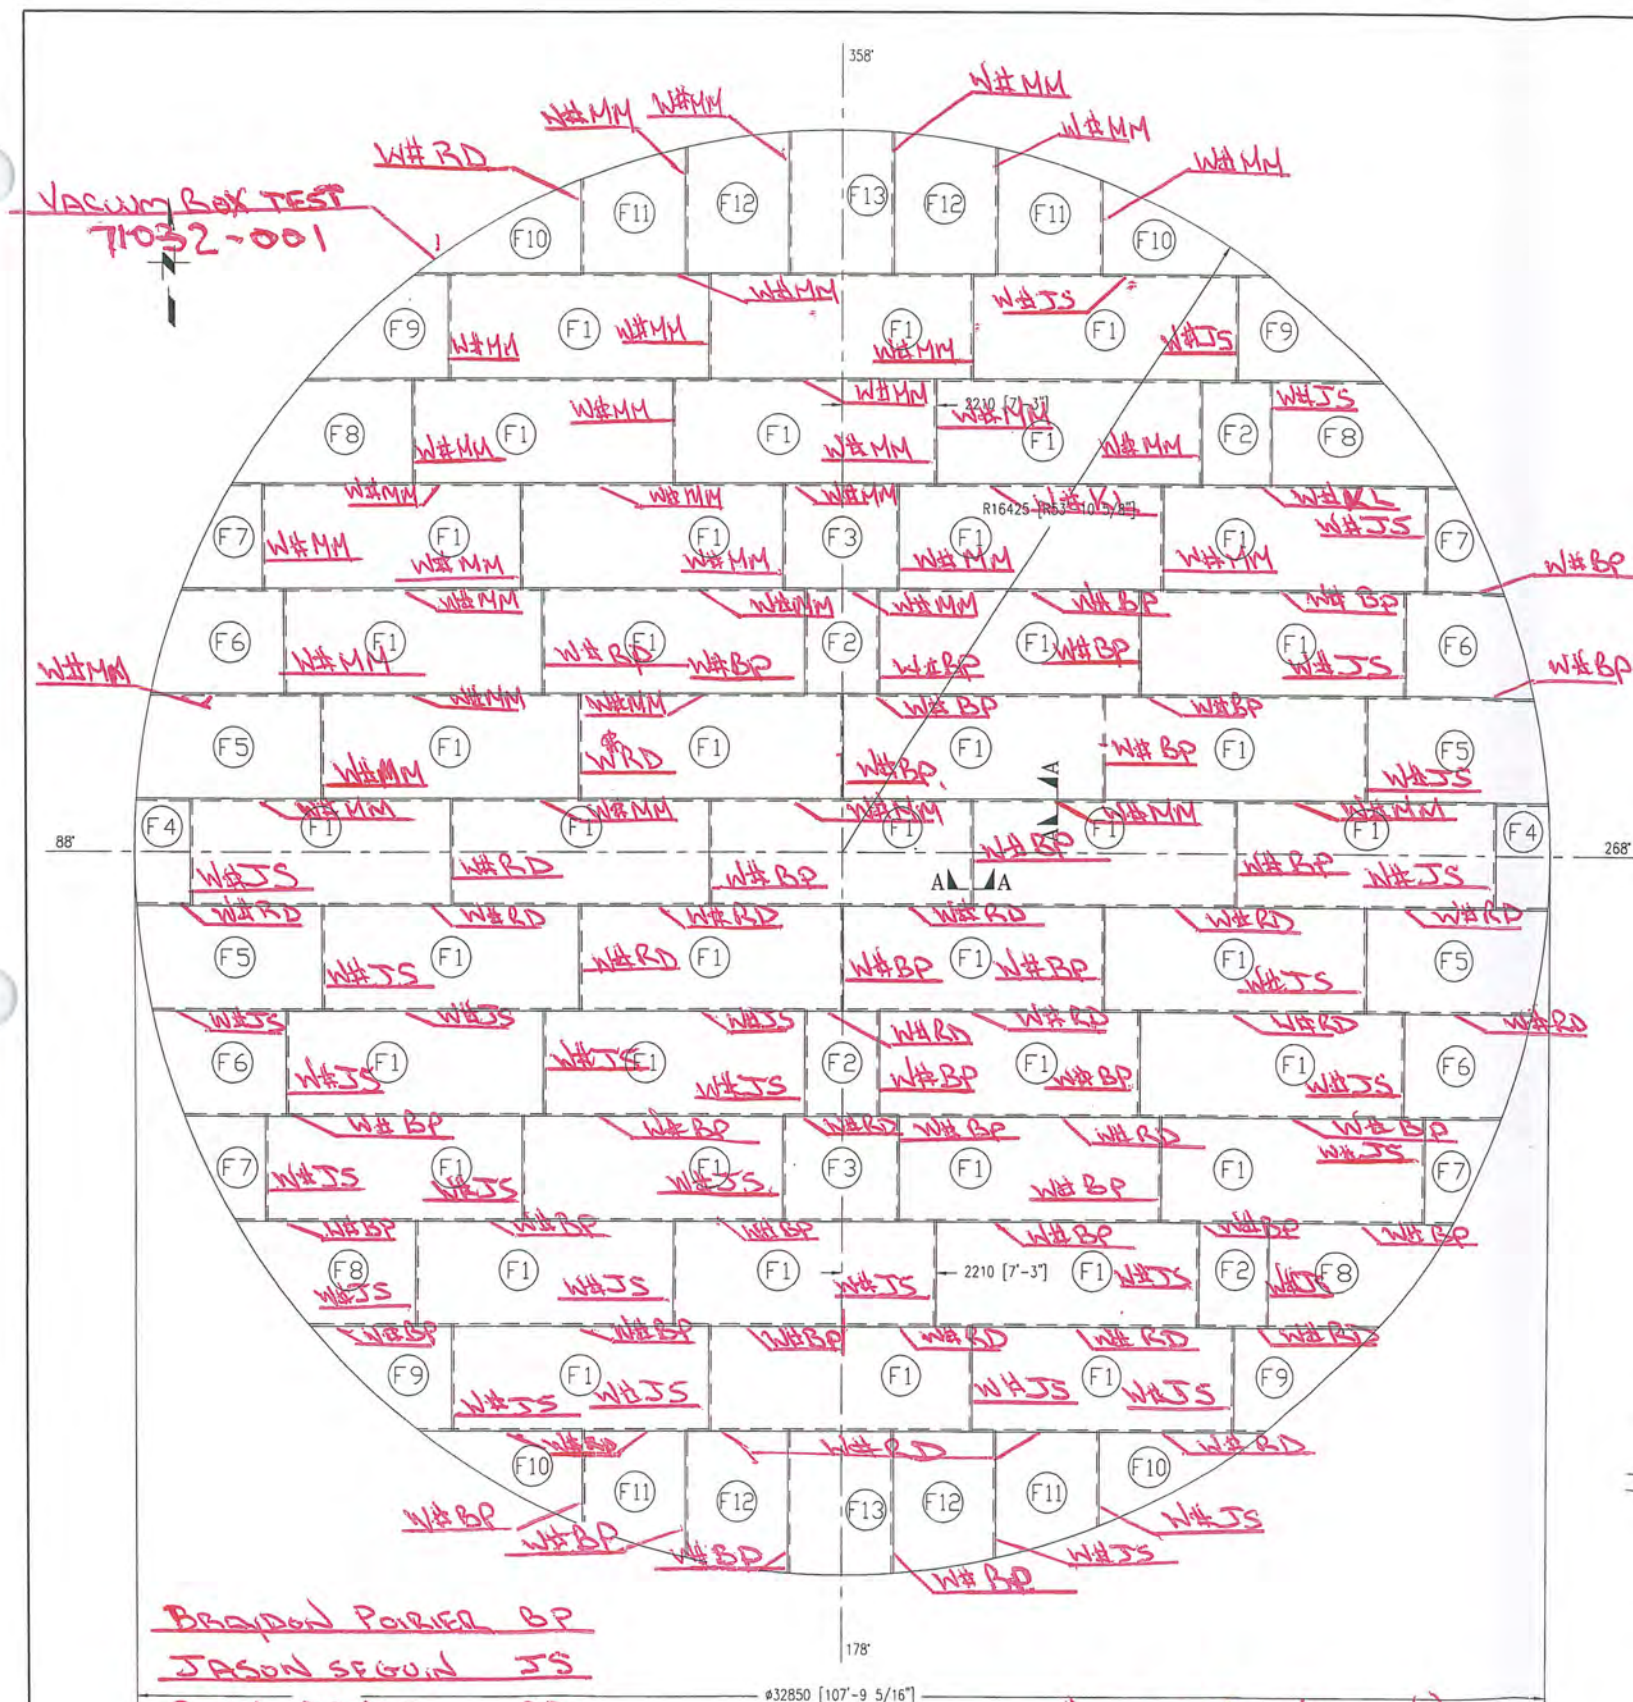

BRADON POIRIER BP  
 JASON SEGUND JS  
 RYAN DAIGLE RD  
 KEVIN LEGUE KL  
 MURRAY MCLAREN MM

FLOOR PLATE LAYOUT


W# BSF-216 (SMAW)

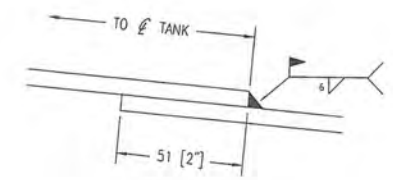

SECTION A-A  
WELD FOR FLOOR

REV	ISSUED FOR APPROVAL	REVISION DESCRIPTION	J.C.	D.H.	DATE
0	ISSUED FOR APPROVAL				May 23/18
REV			BY	APPROV	DATE

THIS DOCUMENT, INCLUDING DATA, AND DESIGN, IS THE PROPERTY OF LAFRAMBOISE GROUP LTD. IT IS NOT TO BE COPIED, REPRODUCED OR ITS CONTENTS DIVULGED IN PART OR IN WHOLE, WITHOUT THE WRITTEN PERMISSION OF LAFRAMBOISE GROUP LTD.

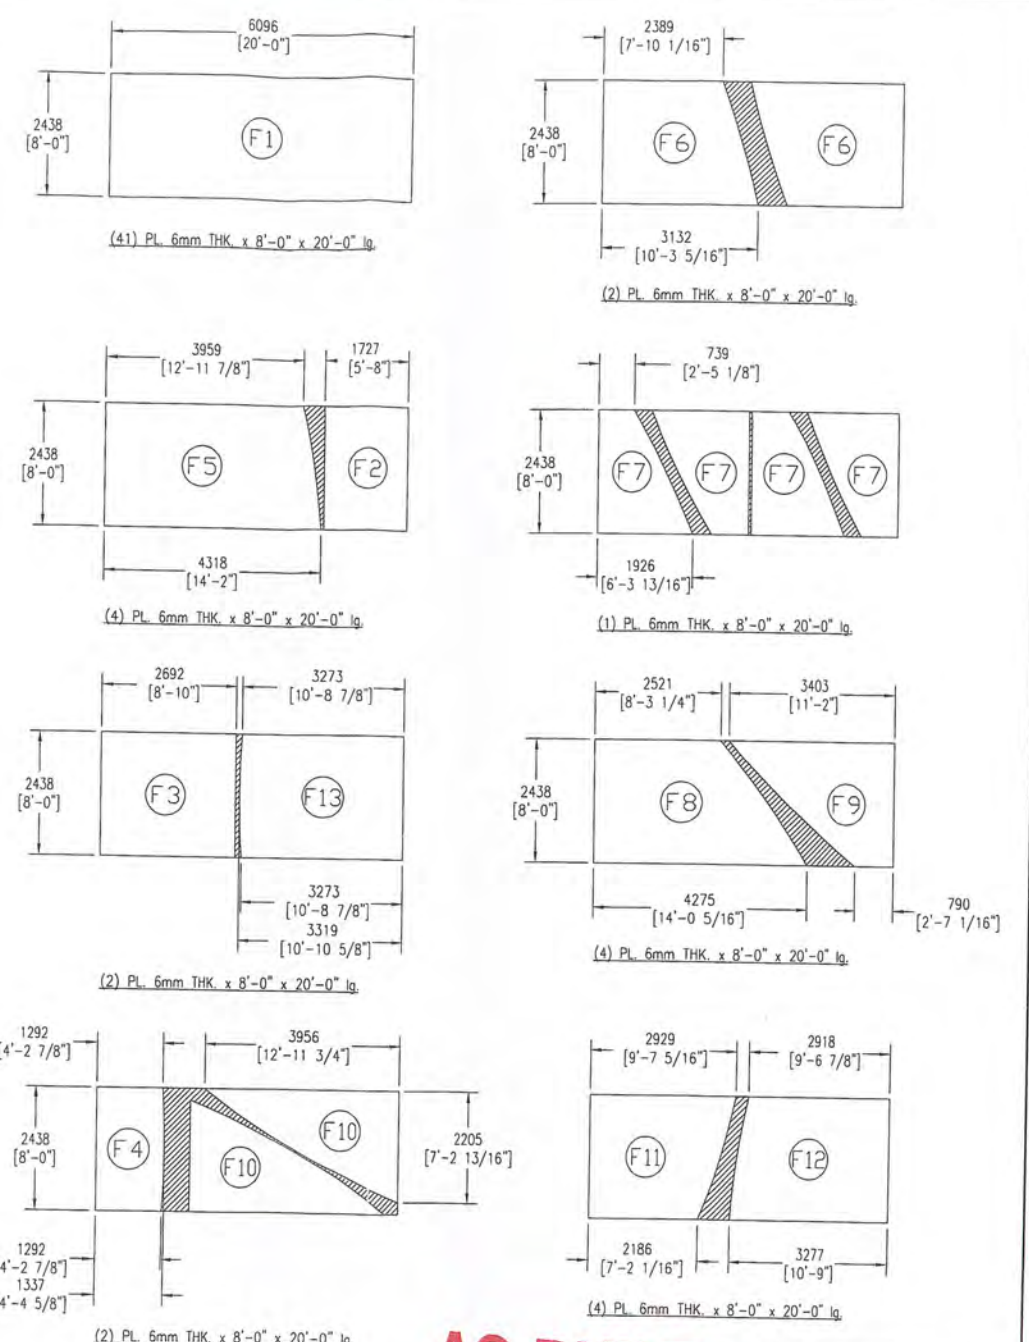

AS BUILT


TOTAL PLATES REQ'D  
 (60) PL. 6mm x 8'-0\"/>

HATCH Vendor/Contractor Document Review	
Doc Number	E353004-TM001-240-270-0020
Date Received	
Review Grade	Next Submittal Status
<input type="checkbox"/> C1 - Proceed to next submittal & status	<input type="checkbox"/> Certified
<input type="checkbox"/> C2 - Proceed with exceptions as noted to next submittal & status	<input type="checkbox"/> As-Built
<input type="checkbox"/> C3 - Do not proceed. Review as noted & resubmit	<input type="checkbox"/> Internal Review
<input type="checkbox"/> C4 - No further submission required. Complete (unless status change)	<input type="checkbox"/> Certified/As-Built
Next Submittal Date:	<input type="checkbox"/> Certified Final <input type="checkbox"/> Final <input type="checkbox"/> Cancelled <input type="checkbox"/> Superseded
Package Engineer: <u>Nomok/Issued and done</u>	1-June-2018


AS BUILT

<b>Laframboise Group Ltd.</b> 1397 Rosemount Ave., Cornwall, ONT, K6J 3E5 TEL: (613) 933-6664 FAX: (613) 933-9910	
CUSTOMER: BAFFINLAND IRON MINES CORP. PROJECT: MARY RIVER PROJECT - ERP PROJECT NO. H353004 TITLE: 15,000,000 L ARCTIC DIESEL STORAGE TANKS ORIENTATION, NOZZLES DESCRIPTION	CONTRACT NO.: 70942 TANK NO.: DRAWN BY: M.H. DATE: May 22, 2018 SCALE: AS NOTED CHK'D BY: M.N.
QTY. REQ'D = (2) TWO REF. - TOLERANCES UNLESS OTHERWISE NOTED INCHES UNDER 12" ± 0.063" 12" TO 120" ± 0.125" 121" TO 240" ± 0.187" OVER 240" ± 0.250" ANGULAR ± 0.5° NOT EXCEEDING 0.060" PER 12" SURFACE FINISH: (Ra) N7=63 N8=125 N9=250	STANDARD SYMBOLS ○ - DENOTES NOZZLE No. △ - DENOTES PART No. □ - DENOTES REVISION No. ◻ - DENOTES WELD No. RT - DENOTES RADIOGRAPHY UT - DENOTES ULTRA-SONIC PT - DENOTES LIQUID PENETRANT METRIC-mm UNDER 300 ± 1.5 300 TO 3000 ± 3.1 3001 TO 6000 ± 4.7 OVER 6000 ± 6.35 ANGULAR ± 0.5° NOT EXCEEDING 1.5mm PER 300mm SURFACE FINISH: (Ra) N7=1.6 N8=3.2 N9=6.4




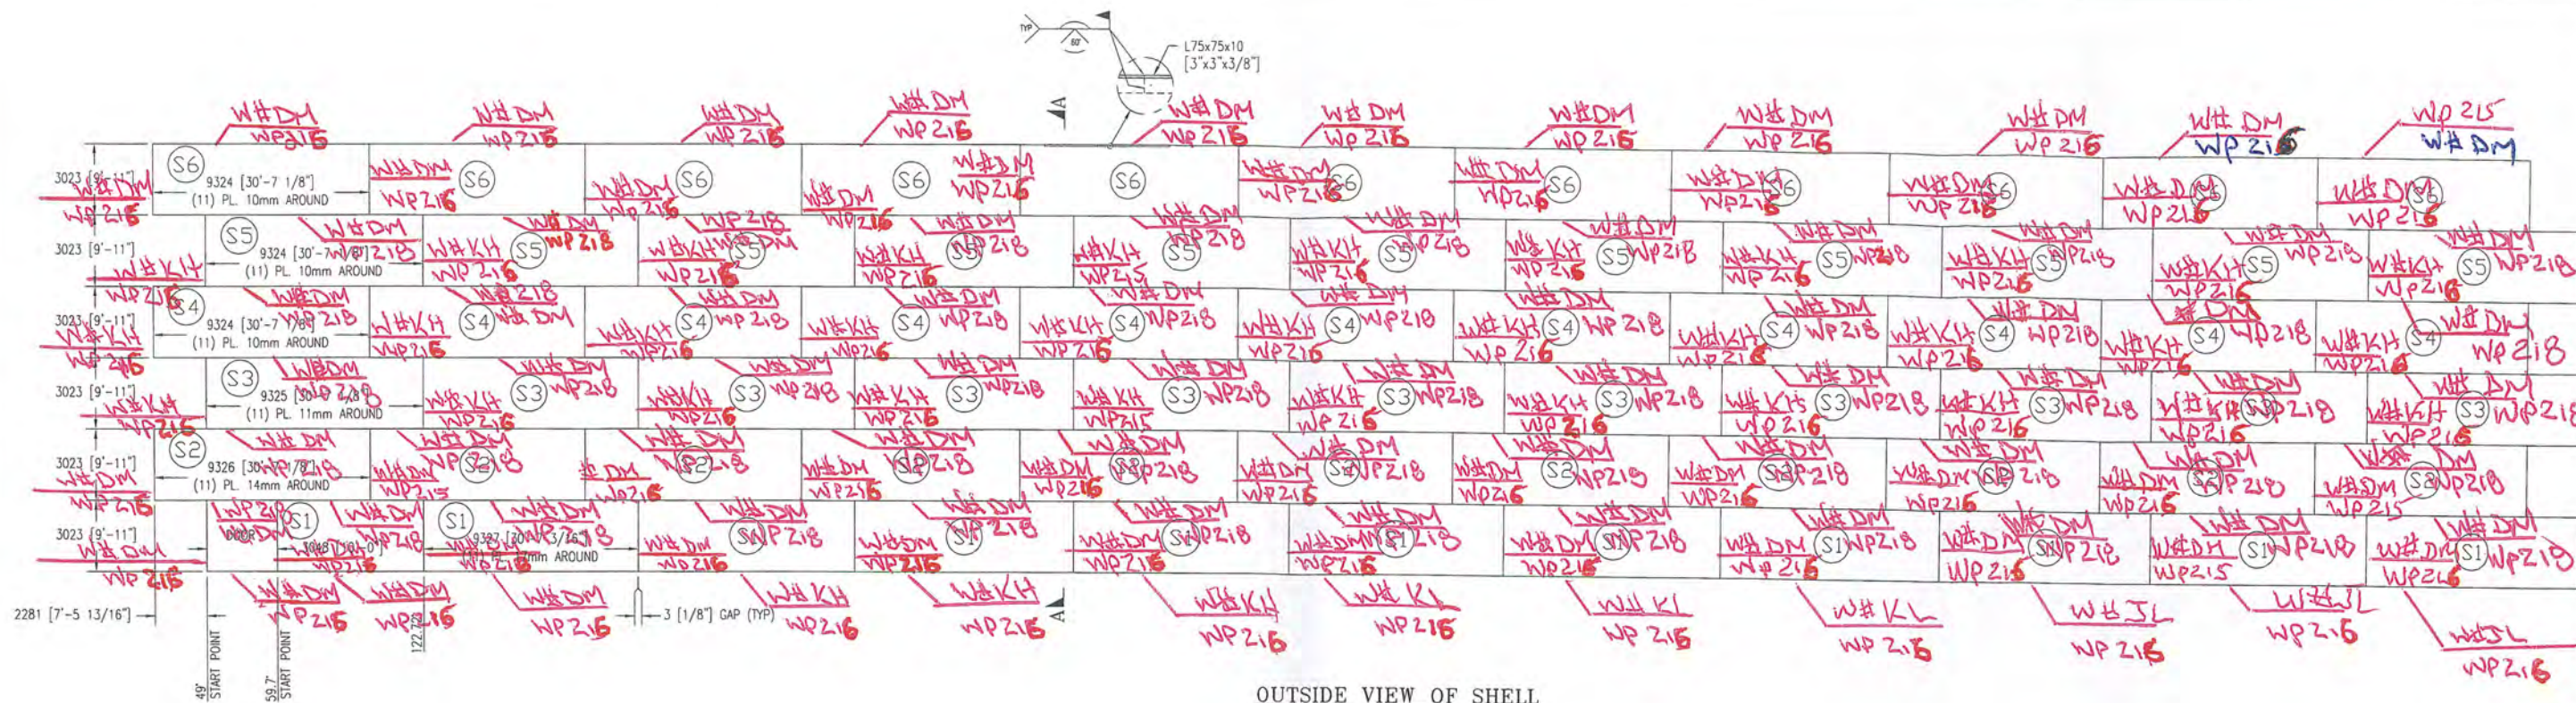


OUTSIDE VIEW OF SHELL

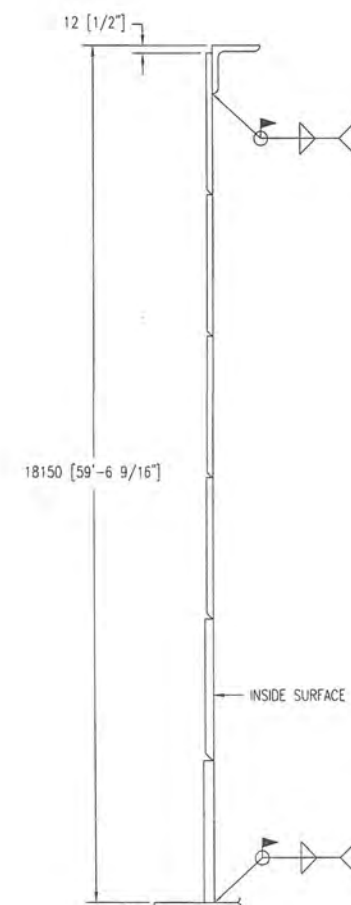

SECTION A-A

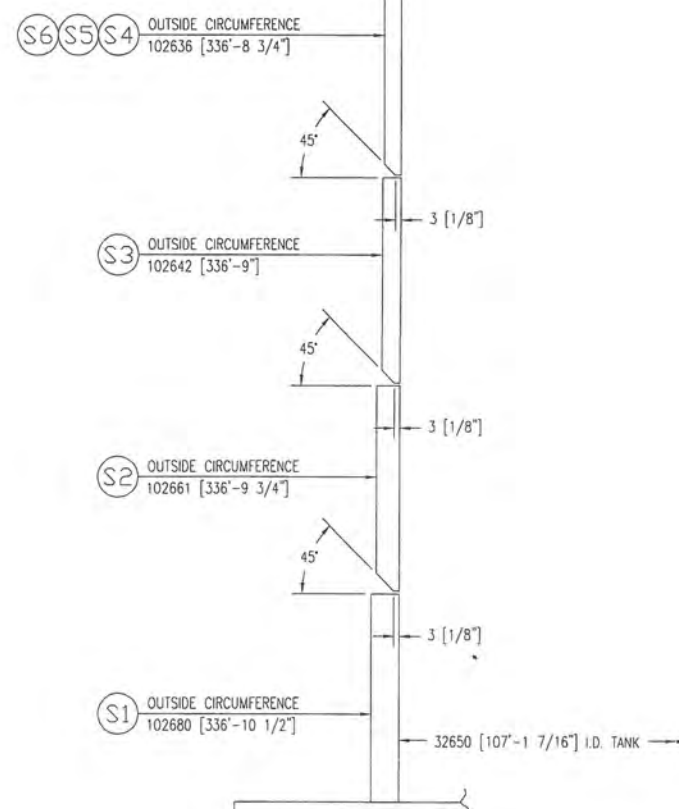

HORIZONTAL JOINT PREPARATION

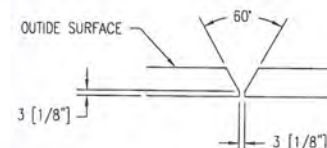

VERTICAL JOINT PREPARATION

BSF - WP 218  
BSF - WP 216


DANE MCLAREN DM  
KEVIN HARGRAVE KH  
JAMES LEGUE JL

HATCH Vendor/Contractor Document Review			
Doc Number	E353004-TM001-240-270-0022	SUB	01
Date Received			
Review Grade		New Submittal Status	
<input type="checkbox"/> C1 - Proceed to next submission & status		<input type="checkbox"/> Certified	
<input type="checkbox"/> C2 - Proceed with exceptions as noted to next submission & status		<input type="checkbox"/> As-Built	
<input type="checkbox"/> C3 - Do not proceed. Revise as noted & resubmit		<input type="checkbox"/> Internal Review	
Next Submittal Date:		<input type="checkbox"/> Certified/As-Built	
C4 - No further submission required - Complete (select status below)			
<input type="checkbox"/> Certified Final	<input type="checkbox"/> Final	<input type="checkbox"/> Cancelled	<input type="checkbox"/> Superseded
Package Engineer: Name, Title, and date			
D. Fraser 1-June-2018			

TOTAL PLATES REQ'D  
(11) PL. 17mm x 120" x 368" lg.  
(11) PL. 14mm x 120" x 368" lg.  
(11) PL. 11mm x 120" x 368" lg.  
(33) PL. 10mm x 120" x 368" lg.  
MAT'L: G40.21M GRADE 260WT CAT.4  
KILLED AND FINE GRAIN PRACTICE

**AS BUILT**

**AS BUILT**

						QTY. REQ'D = (2) TWO		<div> 1397 Rosemount Ave., Cornwall, ONT. K6J 3E5 TEL: (613) 933-6664 FAX: (613) 933-9910</div>	
						REF. -			
				TOLERANCES		STANDARD SYMBOLS ○ - DENOTES NOZZLE No. ○ - DENOTES PART No. △ - DENOTES REVISION No. □ - DENOTES WELD No.  RT - DENOTES RADIOGRAPHY UT - DENOTES ULTRA-SONIC PT - DENOTES LIQUID PENETRANT		CUSTOMER: BAFFINLAND IRON MINES CORP. CONTRACT NO.: 70942  PROJECT: MARY RIVER PROJECT - ERP PROJECT NO. H353004  TITLE: 15,000,000 L ARCTIC DIESEL STORAGE TANKS SHELL PLATES LAYOUT  TANK NO.: -  DRAWN BY: M.H. DRAWING NO. C-70942-LG-53 DATE: May 22, 2018 SCALE: AS NOTED CHK'D BY: M.N.	
				UNLESS OTHERWISE NOTED					
				INCHES		METRIC-mm			
				UNDER 12" ± 0.063" 12" TO 120" ± 0.125" 121" TO 240" ± 0.187" OVER 240" ± 0.250"		UNDER 300 ± 1.5 300 TO 3000 ± 3.1 3001 TO 6000 ± 4.7 OVER 6000 ± 6.35			
				ANGULAR ± 0.5° NOT EXCEEDING 0.060° PER 12" SURFACE FINISH: (Ra) N7=63 N8=125 N9=250		ANGULAR ± 0.5° NOT EXCEEDING 1.5mm PER 300mm SURFACE FINISH: (Ra) N7=1.6 N8=3.2 N9=6.4			
THIS DOCUMENT, INCLUDING DATA, AND DESIGN, IS THE PROPERTY OF LAFRAMBOISE GROUP LTD. IT IS NOT TO BE COPIED, REPRODUCED OR ITS CONTENTS DIVULGED IN PART OR IN WHOLE, WITHOUT THE WRITTEN PERMISSION OF LAFRAMBOISE GROUP LTD.									
0 ISSUED FOR APPROVAL J.C. D.H. May 23/18									
REV REVISION DESCRIPTION BY APPROVED DATE									







# **Appendix B**

## **Earthworks and Secondary Containment**

**E353004-CC005-130-066-0004 Mine Site Tank Farm**

The above report includes the following sections as submitted by Nuna East Ltd:

- Section 1: Completion of Construction Declaration/Transfer of Care, Custody & Control Forms
- Section 2: Inspection and Test Plan
- Section 3: Redline Drawings
- Section 4: Survey
- Section 5: Sieve Analysis / Aggregate Statements of Compliance
- Section 6: Request for Information
- Section 7: Non-Conformance Reports
- Section 8: Communications : ECNs, SIs, CVRs & Emails
- Section 9 : Land Disturbance Forms
- Section 10 : Quality Control Reports
- Section 11 ; Sub-Contractor Reports / QC Turnover Packages
- Section 12: Signature Log
- Section 13: Work plan
- Section 14: Walkdown
- Section 15: Deficiency / Punchlist Record
- Section 16: Construction Photographs
- Section 17: Acceptance of Completion of Construction Declaration
- Section 18: QA/QC Documentation Turnover Review and Release



# **Appendix C**

## **Tank 005**

**E353004-TM001-130-067-0008 TK 005 Arctic Fuel Diesel History Document**

The above tank data book typically includes the following sections as submitted by Groupe Laframboise Ltee:

- Section 1: Manufacturer's Certification
- Section 2: Inspection and Test Plan
- Section 3: Tank Strapping (Calibration)
- Section 4: TK-005 NDE (UT/MT Inspection)
- Section 5: Vacuum box Testing
- Section 6: Repad Pressure Test Records
- Section 7: Mapped Drawings/As Built
- Section 8: Weld Procedures/Welder Qualifications

## **Appendix D**

### **Contact Information as per Components 1 and 2 of the Commercial Lease Requirement**

---

Baffinland Iron Mines LP - Mary River Expansion Project  
Construction Summary Report: Mary River Tank Farm (2019) - April 7, 2020

Company	Address	Contact Numbers
Hatch (Global Corporate Office) (EPCM Contractor)	Sheridan Science & Technology Park 2800 Speakman Drive Mississauga, Ontario L5K 2R7 Canada	Tel: 1-905-855-7600 Fax: 1-905-855-8270
Nuna East Limited	9839 – 31 Avenue NW Edmonton, Alberta T6N 1C5 Canada	Tel: 1-780-434-9114 Fax: 1-780-434-7758
Laframboise Group	1397 Rosemount Ave. Cornwall, Ontario K6J 3E5 Canada	Tel: 1-613-933-6664, Ext. 313 Fax: 1-613-933-9910

Role	Name	Email
Preparer of Report	Glen Peace, P.Eng.	<a href="mailto:glen.peace@hatch.com">glen.peace@hatch.com</a>
Responsible for Construction	Marlon Coakley	<a href="mailto:marlon.coakley@hatch.com">marlon.coakley@hatch.com</a>
Baffinland Representative	Christopher Murray	<a href="mailto:Christopher.murray@baffinland.com">Christopher.murray@baffinland.com</a>



## **Appendix E**

### **Map to Show Construction in Relation to Lease Boundaries and Water Bodies**





SAVED: C:\Users\katie.mcguire\Documents\4 - Maps\Reporting\CSR\Mine Site Tank Farm\BIM\_Fig 1 MineSite TankFarm.mxd, 06-Apr-20



# **Appendix F**

## **CCME Code Compliance Review**

Part	Section	Reference	Requirement	Comment
Part 1: Application and Definitions	Not Applicable.	Not Applicable.	Not Applicable.	Not applicable.
Part 2: Registration and Approval of Storage Tank Systems	2.2 Registration of Existing Storage Tank Systems	2.2.1	The owner of an existing storage tank system shall register all storage tanks of the system with the authority having jurisdiction in a manner and timeframe prescribed by the authority having jurisdiction.	Not applicable (new system). See 2.4.1 and 2.4.2 below.
Part 2: Registration and Approval of Storage Tank Systems	2.2 Registration of Existing Storage Tank Systems	2.2.2	Registration of an existing storage tank system shall be conducted by completing and filing a registration form in a manner specified by the authority having jurisdiction. (See Appendix C)	Not applicable, new installation
Part 2: Registration and Approval of Storage Tank Systems	2.2 Registration of Existing Storage Tank Systems	2.2.3	The owner of an existing storage tank system shall identify registered tanks in a manner and time frame specified by the authority having jurisdiction.	Not applicable, new installation
Part 2: Registration and Approval of Storage Tank Systems	2.2 Registration of Existing Storage Tank Systems	2.2.4	The authority having jurisdiction may deem the age of an existing storage tank system to be unknown unless the owner provides the authority having jurisdiction with either the date of installation and/or the date of manufacture.	Not applicable; this is a new installation
Part 2: Registration and Approval of Storage Tank Systems	2.3 Approval of Storage Tank Systems	2.3.1	No person shall construct or cause to construct, install, <i>alter</i> , or operate a <i>storage tank system</i> unless all required permits and approvals have been obtained from the <i>authority having jurisdiction</i> .	Complies; permit for the tank construction and containment dyke was obtained from the Nunavut Water Board and the Qikiqtani Inuit Association. Requirements to operate a storage tank system are being confirmed with the Fire Marshal and will be met as required by the Fire Marshal.
Part 2: Registration and Approval of Storage Tank Systems	2.4 Registration of New Storage Tank Systems	2.4.1	The <i>owner</i> of a <i>new storage tank system</i> installed after a date specified by the <i>authority having jurisdiction</i> shall register the <i>storage tank system</i> .	Within Nunavut the authority having jurisdiction is the Fire Marshal (per Appendix C of CCME). Requirements for registration are being confirmed with the Fire Marshal and will be met as required by the Fire Marshal.
Part 2: Registration and Approval of Storage Tank Systems	2.4 Registration of New Storage Tank Systems	2.4.2	The new <i>storage tank system</i> shall be registered by completing and filing a registration form as specified by the <i>authority having jurisdiction</i> .	Within Nunavut the <i>authority having jurisdiction</i> is the Fire Marshal (per Appendix C of CCME). Requirements for registration are being confirmed with the Fire Marshal and will be met as required by the Fire Marshal.
Part 2: Registration and Approval of Storage Tank Systems	2.4 Registration of New Storage Tank Systems	2.4.3	The <i>owner</i> of a <i>new storage tank system</i> shall identify registered tanks in a manner specified by the <i>authority having jurisdiction</i> .	Within Nunavut the authority having jurisdiction is the Fire Marshal (per Appendix C of CCME). Requirements for registration are being confirmed with the Fire Marshal and will be met as required by the Fire Marshal.
Part 2: Registration and Approval of Storage Tank Systems	2.5 Product Supply and Registration	2.5.1	After a date specified by the <i>authority having jurisdiction</i> , no person shall transfer or cause to be transferred <i>petroleum</i> or <i>allied petroleum products</i> to a <i>storage tank system</i> unless the <i>storage tank system</i> has been registered with the <i>authority having jurisdiction</i> .	See 2.4.1, 2.4.2 and 2.4.3 above.
Part 3: Design and Installation of Aboveground Storage Tank Systems	3.2 General Requirements	3.2.1	Except as provided in this Part, the design, fabrication and installation of an <i>aboveground storage tank system</i> shall be in conformance with the NFCC.	The new tank farm components have been installed in conformance with Section 4 of the NFCC.
Part 3: Design and Installation of Aboveground Storage Tank Systems	3.2 General Requirements	3.2.2	Except as provided in this Part, the design and installation of an <i>aboveground storage tank system</i> connected to an oil-burning appliance and equipment that comes within the scope of CAN/CSA-B139-00, "Installation Code for Oil Burning Equipment" shall be in conformance with that Code.	Not applicable; the system is not connected to an oil-burning appliance or equipment.
Part 3: Design and Installation of Aboveground Storage Tank Systems	3.2 General Requirements	3.2.3	An <i>aboveground storage tank</i> , components, and accessories, for which there is a recognized standard, shall be <i>approved</i> only for the uses indicated under the standard.	All components, accessories and trim comply to this section.
Part 3: Design and Installation of Aboveground Storage Tank Systems	3.2 General Requirements	3.2.4	A company or individual that is authorized by the <i>authority having jurisdiction</i> shall verify that the design and installation of an <i>aboveground storage tank system</i> meets the requirements of this Code or other requirements as specified by the <i>authority having jurisdiction</i> .	Hatch has reviewed the as-builts, as constructed status of the facility and confirms it meets the applicable requirements of this code.
Part 3: Design and Installation of Aboveground Storage Tank Systems	3.2 General Requirements	3.2.5	An <i>aboveground storage tank system</i> shall be installed by a company or individual that is authorized by the <i>authority having jurisdiction</i> .	Hatch is registered to practice engineering in Nunavut and has completed the design, managed the construction and reviewed all as-built documents pertaining to this tank system.
Part 3: Design and Installation of Aboveground Storage Tank Systems	3.2 General Requirements	3.2.6	An <i>aboveground storage tank</i> shall be equipped to control emissions of volatile organic compounds in conformance with CCME PN 1180, "Environmental Guideline for Controlling Emissions of Volatile Organic Compounds from Aboveground Storage Tanks". (See Appendix B, note B.3.2.6)	Not applicable; stored fuel has vapour pressure less than 10kPa. Arctic Grade Diesel vapour pressure is 1kPa@20C per MSDS.
Part 3: Design and Installation of Aboveground Storage Tank Systems	3.2 General Requirements	3.2.7(1)	The <i>owner</i> of an <i>aboveground storage tank system</i> shall provide an as-built drawing to the <i>authority having jurisdiction</i> in the manner and time frame as specified by the <i>authority having jurisdiction</i> .	As-built drawings form part of this report.
Part 3: Design and Installation of Aboveground Storage Tank Systems	3.2 General Requirements	3.2.7(2)	As-built drawings for an aboveground storage tank system shall include, as a minimum: (a) the outline of all storage tanks; (b) the centerline of all piping or piping groups; (c) the centerline of all underground electrical power and monitor sensor conduit; (d) building foundation outlines; (e) secondary containment systems; and (f) property lines.	As-built drawings forming part of this report meet the minimum requirements as stated in this section.

Part	Section	Reference	Requirement	Comment
Part 3: Design and Installation of Aboveground Storage Tank Systems	3.2 General Requirements	3.2.8(1)	No person shall install an aboveground storage tank system unless: (a) required permits or approvals have been obtained from the authority having jurisdiction; (b) plans, drawings and specifications of the system or equipment have been examined by the authority having jurisdiction; and (c) the plans, drawings and specifications referred to in Clause (b) bear the stamp and signature of a professional engineer licensed to practice in the province/territory.	(a) Permit for the tank construction and containment dyke was obtained from the Nunavut Water Board and the Qikiqtani Inuit Association. (b) Drawings were submitted to the above authorities. (c) Submitted issued for construction (IFC) drawings to the authorities bear the stamp and signatures of Registered Professional Engineers.
Part 3: Design and Installation of Aboveground Storage Tank Systems	3.2 General Requirements	3.2.9	An <i>aboveground storage tank system</i> shall be designed and installed in accordance with the manufacturer's instructions, the appropriate standards, and this Code.	The above ground tanks have been constructed in conformance with API 650. The secondary containment has been constructed in conformance with this code and the NFCC.
Part 3: Design and Installation of Aboveground Storage Tank Systems	3.3 Field-erected Storage Tank Systems	3.3.1(1)	A field-erected storage tank system shall: (a) have corrosion protection in conformance with Section 3.8; (b) have a secondary containment system in conformance with Section 3.9; (c) have leak detection in conformance with Part 6; (d) have containment sumps, as applicable; (e) be provided with overfill protection: (i) for pipeline delivery, in the form of an alarm system that will automatically alert pipeline or terminal personnel so that action can be taken to prevent the storage tank from being overfilled; (ii) for truck, rail, ship, or barge delivery, in the form of a visual and audible alarm system for detecting a high level that will activate and alert personnel in enough time to terminate the flow of the product to the storage tank and prevent an overfill (See Appendix B, note B.3.3.1(1)(e)(ii)); or (iii) in conformance with API RP 2350-96, "Overfill Protection for Storage Tanks in Petroleum Facilities"; and (f) have piping in conformance with Part 5, as applicable.	(a) There are no underground steel piping or tanks in this facility. The use of secondary containment liner and low corrosion rates preclude the use of corrosion protection (CP) on the tank floor. (b) Conforms with Section 3.9. (c) Conforms, see Section 6 of this table. (d) Not applicable. (e) i) Not applicable. ii) Not applicable. iii) Conforms. Existing design includes a radar gauge and local display. Facility is classified as Category 1 under API 2350. A Category 1 facility shall be operated as a fully-attended facility for receipts with manual monitoring continuously during receipt. (f) Conforms.
Part 3: Design and Installation of Aboveground Storage Tank Systems	3.3 Field-erected Storage Tank Systems	3.3.2	If vapour balancing or vapour recovery systems are required, they shall be designed and built in conformance with CCME PN 1057, "Environmental Code of Practice for Vapour Recovery in Gasoline Distribution Networks".	Not applicable.
Part 3: Design and Installation of Aboveground Storage Tank Systems	3.4 Shop-fabricated Storage Tank Systems	3.4.1(1)	A shop-fabricated storage tank system shall: (a) have corrosion protection in conformance with Section 3.8; (b) have a secondary containment system in conformance with Section 3.9; (c) have leak detection in conformance with Part 6; (d) have containment sumps, as applicable; (e) except as specified in Sentence 3.4.1(2), be provided with overfill protection: (i) compatible with the intended method of filling; (ii) designed, built, and approved in conformance with ORD-C58.15- 1992, "Overfill Protection Devices for Flammable Liquid Storage Tanks," which will prevent filling the tank beyond 95% of the tank's capacity or activate an audible or combined audible/visual alarm at a product level of 90% of the tank's capacity; and (iii) where a high-level alarm system is used, with audible and visual alarms located where personnel are constantly on duty during the product transfer operation and can promptly stop or divert delivery to the tank; and (f) have piping in conformance with Part 5, as applicable.	Not applicable; tank systems are field-erected.
Part 3: Design and Installation of Aboveground Storage Tank Systems	3.4 Shop-fabricated Storage Tank Systems	3.4.1(2)	A shop-fabricated <i>storage tank</i> system having a capacity of less than 5 000 L may be provided with overfill protection in the form of visual monitoring and gauging of the level in the <i>storage tank system</i> by trained employees in constant attendance throughout the transfer operation and who are located so as to be able to promptly shut down the flow, or communicate immediately with the person controlling the delivery so that the flow can be shut down promptly.	Not applicable; tank systems are field-erected.
Part 3: Design and Installation of Aboveground Storage Tank Systems	3.4 Shop-fabricated Storage Tank Systems	3.4.2	A horizontal <i>storage tank</i> shall be supported above grade level.	Not applicable; tank systems do not include horizontal storage tanks.
Part 3: Design and Installation of Aboveground Storage Tank Systems	3.4 Shop-fabricated Storage Tank Systems	3.4.3	Where there is a dispenser, <i>leak detection</i> for the dispenser and related components shall be in conformance with Part 6.	Conforms; visual leak detection. See 6.7.2(1) Table 4 and Table 6.
Part 3: Design and Installation of Aboveground Storage Tank Systems	3.5 Aboveground Storage Tank Systems for Storing Used Oil	Not Applicable.	Not Applicable.	Not applicable.



Part	Section	Reference	Requirement	Comment
Part 3: Design and Installation of Aboveground Storage Tank Systems	3.6 Design Standards	3.6.1(1)	Based on the design, an aboveground storage tank shall be designed, built, and approved in conformance with the following, as applicable: a) API Std 650-98, "Welded Steel Tanks for Oil Storage"; b) ULC-S601-2000, "Aboveground Horizontal Shop Fabricated Steel Tanks"; c) CAN/ULC-S602-1992, "Aboveground Steel Tanks for Fuel Oil and Lubricating Oil"; d) ULC-S630-2000, "Aboveground Vertical Shop Fabricated Steel Tanks"; e) CAN/ULC-S643-2000, "Aboveground Shop Fabricated Steel Utility Tanks"; f) ULC-S652-1993, "Tank Assemblies for Collection of Used Oil"; g) ULC-S653-1994, "Contained Aboveground Steel Tank Assemblies"; h) ORD-C142.5-1992, "Aboveground Concrete Encased Steel Tank Assemblies"; i) ORD-C142.18-1995, "Aboveground Rectangular Steel Tanks"; j) ORD-C142.21-1995, "Aboveground Used Oil Systems"; k) ORD-C142.22-1995, "Contained Aboveground Vertical Steel Tank Assemblies"; or l) ORD-C142.23-1991, "Aboveground Waste Oil Tanks".	The tanks have been designed and constructed in conformance with API 650 - 12th Edition.
Part 3: Design and Installation of Aboveground Storage Tank Systems	3.6 Design Standards	3.6.2	An <i>overflow protection device</i> shall be designed, built, and <i>approved</i> in conformance with ORD-C58.15-1992, "Overflow Protection Devices for Flammable Liquid Storage Tanks".	Not applicable; see 3.3.1(1)(e)(iii). All product transfer at the Mary Rive Mine Site occurs by fuel truck delivery.
Part 3: Design and Installation of Aboveground Storage Tank Systems	3.6 Design Standards	3.6.3	A <i>containment sump</i> shall be designed, built, and <i>approved</i> in conformance with ORDC107.21- 1992, "Under-Dispenser Sumps".	Not applicable; tank systems do not include containment sumps.
Part 3: Design and Installation of Aboveground Storage Tank Systems	3.6 Design Standards	3.6.4	A <i>liner</i> shall be designed, built, and <i>approved</i> in conformance with ORD-C58.9- 1997, "Secondary Containment Liners for Underground and Aboveground Tanks".	The secondary containment dyke has been constructed with a Layfield Hazguard 535 synthetic liner installed and tested in conformance with this code and in accordance with manufacturers instructions.
Part 3: Design and Installation of Aboveground Storage Tank Systems	3.6 Design Standards	3.6.5	An <i>aboveground storage tank</i> designed to contain an <i>allied petroleum product</i> shall be designed, built, and <i>approved</i> for use with that product.	Not applicable.
Part 3: Design and Installation of Aboveground Storage Tank Systems	3.6 Design Standards	3.6.6(1)	An aboveground storage tank built in conformance with: (a) API Spec 12B-95, "Bolted Tanks for Storage of Production Liquids"; (b) API Spec 12D-94, "Field Welded Tanks for Storage of Production Liquids"; or (c) API Spec 12F-94, "Shop Welded Tanks for Storage of Production Liquids" shall be used only for the storage of production petroleum and allied petroleum products.	Not applicable.
Part 3: Design and Installation of Aboveground Storage Tank Systems	3.7 Repair, Alteration, Reconstruction, and Relocation	3.7.1(1)	The repair, alteration, reconstruction, or relocation of an aboveground storage tank system shall be done in conformance with the technical requirements of, as applicable: (a) ULC-S601(A)-2001, "Shop Refurbishing of Aboveground Horizontal Shop Fabricated Steel Tanks"; (b) ULC-S630(A)-2001, "Shop Refurbishing Aboveground Vertical Shop Fabricated Steel Tanks"; (c) API Std 653-01, "Tank Inspection, Repair, Alteration, and Reconstruction"; (d) STI SP001-00, "Standard for Inspection of In-service Shop Fabricated Aboveground Tanks for the Storage of Flammable and Combustible Liquids"; or (e) the special acceptance procedures of ULC or API.	Not applicable; new system.
Part 3: Design and Installation of Aboveground Storage Tank Systems	3.7 Repair, Alteration, Reconstruction, and Relocation	3.7.2	The owner of an aboveground storage tank system shall provide a revised as-built drawing in conformance with Sentence 3.2.7(2) to the authority having jurisdiction in a time frame specified by the authority having jurisdiction whenever new construction, alteration, or site upgrade occurs.	As-built drawings form part of this report.
Part 3: Design and Installation of Aboveground Storage Tank Systems	3.8 Corrosion Protection of Aboveground Steel Storage Tank Systems	3.8.1(1)	When cathodic protection is used, it shall be designed by a corrosion expert (See Appendix B, note B.3.8.1(1)) and be in conformance with: (a) API RP 651-97, "Cathodic Protection of Aboveground Petroleum Storage Tanks"; (b) API Std 653-01, "Tank Inspection, Repair, Alteration, and Reconstruction"; (c) NACE RP0193-2001, "External Cathodic Protection of On-Grade Carbon Steel Storage Tank Bottoms"; or (d) STI R893-89, "Recommended Practice for External Corrosion Protection of Shop Fabricated Aboveground Tank Floors."	Not applicable; see 3.3.1(1)(a) above.
Part 3: Design and Installation of Aboveground Storage Tank Systems	3.8 Corrosion Protection of Aboveground Steel Storage Tank Systems	3.8.2(1)	Atmospheric corrosion of an aboveground storage tank system shall be controlled by: (a) a protective coating applied in conformance with the coating manufacturer's instructions; (b) a corrosion control program in accordance with API Std 653-01, "Tank Inspection, Repair, Alteration, and Reconstruction"; or (c) the use of a non-corroding material in its construction.	Conforms to (b). Due to there being low corrosion rates in this environment, no corrosion protection was utilized in the design. In the future all testing and repair will be done to API std. 653-01.

Part	Section	Reference	Requirement	Comment
Part 3: Design and Installation of Aboveground Storage Tank Systems	3.9 Secondary Containment Requirements	3.9.1(1)	Subject to Sentences (2) and (3), a secondary containment system for an aboveground storage tank shall: (1) for a storage tank system that consists of a single storage tank, have a volumetric capacity of not less than 110% of the capacity of the tank; or (2) for a storage tank system that consists of more than one storage tank, have a volumetric capacity of not less than the sum of: (a) the capacity of the largest storage tank located in the contained space; and (b) 10% of the greater of: (i) the capacity specified in Clause (a); or (ii) the aggregate capacity of all other storage tanks located in the contained space.	(1) Conforms.
Part 3: Design and Installation of Aboveground Storage Tank Systems	3.9 Secondary Containment Requirements	3.9.1(2)	A secondary containment system for a shop fabricated storage tank shall be designed, built, and approved in conformance with: (a) ULC-S653-1994, "Contained Aboveground Steel Tank Assemblies"; (b) ULC-S655-1998, "Aboveground Protected Tank Assemblies"; (c) ORD-C142.5-1992, "Aboveground Concrete Encased Steel Aboveground Tank Assemblies"; or (d) a recognized standard for double-wall tanks.	Not applicable
Part 3: Design and Installation of Aboveground Storage Tank Systems	3.9 Secondary Containment Requirements	3.9.1(3)	A secondary containment system for a field erected aboveground storage tank shall be: (a) a single-wall and single-bottom storage tank placed entirely within a dyked area, with an impermeable barrier in the floor of the containment area and in the dyke walls; (b) a single-wall, double-bottom storage tank placed entirely within a dyked area, with an impermeable barrier in the floor of the containment area and in the dyke walls, sealed to the perimeter of the storage tank or pad when the liner is not installed under the tank; (c) a double-wall storage tank for a storage tank with a capacity of 50 000 L or less; or (d) a double-wall storage tank placed entirely within a dyked area, with an impermeable barrier in the floor of the containment area and in the dyke walls, for a storage tank with a capacity of more than 50 000 L.	Construction conforms to 3.9.1(3)a) A synthetic membrane liner has been installed in the granular construction of the dyke.
Part 3: Design and Installation of Aboveground Storage Tank Systems	3.9 Secondary Containment Requirements	3.9.2(1)	Except as provided in Sentence (2), a secondary containment impermeable barrier shall be: (a) designed, built, and approved in conformance with: (i) ORD-C58.9-1997, "Secondary Containment Liners for Underground and Aboveground Tanks"; or (ii) ORD-C142.20-1995, "Aboveground Secondary Containment Tanks"; and (b) installed so that: (i) the liner is sealed to the perimeter of the storage tank or pad when the liner is not installed under the tank; (ii) the liner extends to the top of the dyke wall; (iii) the liner is covered with a noncombustible material of such nature and thickness that it will not fail when the secondary containment is exposed to fire; and (iv) liners that are intended to be exposed in service are listed for aboveground (exposed) use.	The liner for this facility is in conformance with ORD-C58.9-1997, the liner extends to the top of the dyke wall and is placed entirely under the tank floor. The liner is covered with a minimum of 300mm of granular material and placed between layers of geotextile and sand protection.
Part 3: Design and Installation of Aboveground Storage Tank Systems	3.9 Secondary Containment Requirements	3.9.2(2)	A secondary containment impermeable barrier that does not conform to Sentence (1) shall: (a) use material compatible with the product being stored and acceptable to the authority having jurisdiction (See Appendix B, note 3.9.2(2)(a)); and (b) be designed, constructed, and maintained to ensure a maximum hydraulic conductivity of $1 \times 10^{-6}$ cm/s.	Not applicable.
Part 3: Design and Installation of Aboveground Storage Tank Systems	3.9 Secondary Containment Requirements	3.9.3(1)	Liner penetrations shall be located at the high point or in a raised part of the dyke floor. (See Appendix B, note B.3.9.3(1))	No liner penetrations were incorporated into the construction of the dyke.
Part 3: Design and Installation of Aboveground Storage Tank Systems	3.9 Secondary Containment Requirements	3.9.3(2)	All liner penetrations shall be sealed.	Conforms; see 3.9.3(1) above.
Part 3: Design and Installation of Aboveground Storage Tank Systems	3.9 Secondary Containment Requirements	3.9.4	Monitoring of the <i>interstitial space</i> of the <i>secondary containment</i> system shall be provided in conformance with Part 6 of this Code.	Conforms.
Part 3: Design and Installation of Aboveground Storage Tank Systems	3.10 Spill Containment and Runoff Collection	3.10.1	Spills, overfills, and storm water from product transfer areas shall be contained, treated and disposed of in conformance with the applicable provincial or territorial regulations, guidelines or policies.	The fuel transfer area is incorporated in the design of the secondary containment such that all run-off is collected into the containment area.
Part 3: Design and Installation of Aboveground Storage Tank Systems	3.10 Spill Containment and Runoff Collection	3.10.2	Containment area floors within dykes shall slope away from the tank base towards a sump at a slope greater than 1%.	Dyke floor slope is a minimum of 1% from the tank to collection sumps.



Part	Section	Reference	Requirement	Comment
Part 3: Design and Installation of Aboveground Storage Tank Systems	3.10 Spill Containment and Runoff Collection	3.10.3(1)	An oil-water separator used to treat storm water runoff, overfills, or a spill from the product transfer area shall be sized for a minimum hydraulic flow rate of a ten year return, one hour storm event, with the one hour rainfall intensity data obtained for the nearest weather station, and: (a) be designed, built, and approved in conformance with ULC-S656-2000, "Oil-Water Separators"; or (b) conform to the following: (i) be designed to produce a discharge of water that does not contain more than 15 mg/L of free oil and grease as measured by the partition-gravimetric method or other protocol as defined by the authority having jurisdiction ; (ii) be designed for an insoluble-in-water oil with a specific gravity of 0.875 ±0.025; and (iii) be designed based on the hydraulic retention time required to separate oil with a particle droplet size of 60 microns from storm water.	An OWS was purchased as a mobile unit sized and conforming to this section for the tank farm facility.
Part 4: Design and Installation of Underground Storage Tank Systems	Not Applicable.	Not Applicable.	Not Applicable.	Not applicable.
Part 5: Design and Installation of New Piping Systems	5.2 General Requirements	5.2.1(1)	Piping materials shall, as applicable, be designed, built, and approved in conformance with the following: (a) ASTM A 53, "Pipe, Steel, Black and Hot-Dipped, Zinc-Coated, Welded and Seamless"; (b) CAN/CSA Z245.1-98, "Steel Line Pipe"; (c) CAN/ULC-S633-1999, "Flexible Underground Hose Connectors"; (d) ORD-C107.7-1993, "Glass-Fibre Reinforced Plastic Pipe and Fittings"; (e) ORD-C107.4-1992, "Ducted Flexible Underground Piping Systems"; (f) ORD-C107.14-1992, "Non-Metallic Pipe and Fittings"; or (g)ORD-C536-1998, "Flexible Metallic Hose".	Conforms.
Part 5: Design and Installation of New Piping Systems	5.2 General Requirements	5.2.2	Except as provided in this Part, the design and installation of <i>piping</i> shall be in conformance with the NFCC.	Conforms.
Part 5: Design and Installation of New Piping Systems	5.2 General Requirements	5.2.3	Except as provided in this Part, the design and installation of <i>piping</i> connected to an oil-burning appliance and equipment that comes within the scope of CSA Standard B139, "Installation Code for Oil Burning Equipment" shall be in conformance with that Code.	Not applicable.
Part 5: Design and Installation of New Piping Systems	5.2 General Requirements	5.2.4	<i>Piping</i> material shall be installed and maintained in accordance with an <i>approved</i> standard, code, or in a manner acceptable to the <i>authority having jurisdiction</i> .	Conforms.
Part 5: Design and Installation of New Piping Systems	5.2 General Requirements	5.2.5	Single-wall <i>piping</i> shall not have buried or concealed mechanical joints. (See Appendix B, note B.5.2.5)	No buried piping; not applicable.
Part 5: Design and Installation of New Piping Systems	5.2 General Requirements	5.2.6	<i>Leak detection</i> testing and monitoring of <i>piping</i> shall be in conformance with Part 6.	Visual leak detection on piping; conforms.
Part 5: Design and Installation of New Piping Systems	5.2 General Requirements	5.2.7	A thermal relief valve shall <i>discharge</i> into the low pressure side of the <i>piping</i> .	Conforms.
Part 5: Design and Installation of New Piping Systems	5.2 General Requirements	5.2.8(1)	<i>Piping</i> located below the maximum product level in a tank shall be provided with a means to prevent the release of liquid from the tank by syphon flow.	Inlet valving to the tank has check and gate valves installed on the tank inlet nozzle.
Part 5: Design and Installation of New Piping Systems	5.2 General Requirements	5.2.8(2)	Except as provided in Sentence 5.2.8(3), a manual shut-off valve shall be lockable or have a method of locking.	Conforms.
Part 5: Design and Installation of New Piping Systems	5.2 General Requirements	5.2.8(3)	A manual shut-off valve on the <i>piping</i> connecting a <i>storage tank</i> and a heating appliance or a stationary combustion engine does not need to be lockable or have a method of locking.	Not applicable.
Part 5: Design and Installation of New Piping Systems	5.3 Product Transfer	5.3.1	The fill pipe on a <i>storage tank</i> with a capacity of 5 000 L or more shall be equipped for the attachment of a liquid and vapour-tight connection at the time of filling and shall be sealed with a liquid- and vapour-tight cap when not in use.	All piping systems are sealed on the inlet and outlet connection ends with liquid and vapour tight cap and connections; conforms.
Part 5: Design and Installation of New Piping Systems	5.3 Product Transfer	5.3.2	The suction tube of a <i>used oil</i> tank shall be equipped for the attachment of a liquid-tight fitting and shall be sealed with a liquid-tight cap when not in use.	Not applicable.
Part 5: Design and Installation of New Piping Systems	5.4 Design Standard for Underground Piping Systems	Not Applicable.	Not Applicable.	Not applicable.
Part 5: Design and Installation of New Piping Systems	5.5 Installation	5.5.1	Piping shall be installed by a company or individual that is authorized by the authority having jurisdiction.	Piping was installed by Certified Contractor with Certified Welders and procedure for same.
Part 5: Design and Installation of New Piping Systems	5.5 Installation	5.5.2	Piping shall be located and maintained to permit the eventual removal of the piping when the storage tank system is permanently withdrawn from service.	Conforms.
Part 5: Design and Installation of New Piping Systems	5.5 Installation	5.5.3	Piping shall be located in a manner that will prevent allowable design stress from being exceeded.	Piping is designed and constructed in conformance with B31.3 - Process Piping; conforms.

Part	Section	Reference	Requirement	Comment
Part 5: Design and Installation of New Piping Systems	5.5 Installation	5.5.4	Piping located aboveground shall be protected from physical damage due to impact.	Conforms.
Part 6: Monitoring and Leak Detection of Storage Tank Systems	6.2 General Requirements	6.2.1(1)	A storage tank system shall be tested for leaks in conformance with Sections 6.2 and 6.3: (a) at the time of final installation: (i) for an underground storage tank system, final installation shall be when final surface materials have been installed and prior to being put into service; or (ii) for an aboveground storage tank system, final installation shall be before the storage tank system is put into service; and (b) whenever a leak is suspected in the primary or secondary containment of the storage tanks, piping, containment sumps or related components.	Tanks have been tested in conformance with API 650 and 653. Additional Radiographic testing has been performed in lieu of hydrostatic tank testing.
Part 6: Monitoring and Leak Detection of Storage Tank Systems	6.2 General Requirements	6.2.2	A line-leak detector shall be designed, built, and approved in conformance with ORDC107.12- 1992, "Line Leak Detection Devices for Flammable Liquid Piping."	Not applicable; not a pressure system and all piping is above grade and visible to detect leaks. Visual leak detection; see 6.7.2(1) Table 4 and Table 6.
Part 6: Monitoring and Leak Detection of Storage Tank Systems	6.2 General Requirements	6.2.3	Manual or electronic dip or inventory reconciliation shall be in conformance with Section 8.3.	Refer to 8.5.3(2). Fuel dipping and inventory reconciliation follows the Baffinland BAF-PH1-310-PRO-0001 Fuel Dipping/ Tank Farm Inspection document in Appendix J of this report.
Part 6: Monitoring and Leak Detection of Storage Tank Systems	6.2 General Requirements	6.2.4(1)	Statistical inventory reconciliation shall be in conformance with: (a) EPA/530/UST-90/007, "Standard Test Procedures for Evaluating Leak Detection Methods: Statistical Inventory Reconciliation Methods"; and (b) EPA 510-B-95-009, "Statistical Inventory Reconciliation."	Refer to 8.5.3(2). Fuel dipping and inventory reconciliation follows the Baffinland BAF-PH1-310-PRO-0001 Fuel Dipping/ Tank Farm Inspection document in Appendix J of this report.
Part 6: Monitoring and Leak Detection of Storage Tank Systems	6.2 General Requirements	6.2.5	An automatic tank gauge system with a precision leak detection capability shall be designed, built, and approved in conformance with ORD-C58.12-1992, "Leak Detection Devices (Volumetric Type) for Underground Storage Tanks".	Not applicable; tank systems are aboveground.
Part 6: Monitoring and Leak Detection of Storage Tank Systems	6.2 General Requirements	6.2.6	A continuous in-tank leak detection system shall conform to good engineering practice and shall meet the requirements of a precision leak detection test. (See Appendix B, Note B6.2.6.)	Not applicable; continuous in-tank leak detection is not required, visual leak detection is used per 6.7.2(1) Table 4 and Table 6. The system includes a fuel management system to collect tank inventory and fuel delivery transaction data to provide an inventory reconciliation, though the fuel management system is not considered to be continuous in-tank leak detection.
Part 6: Monitoring and Leak Detection of Storage Tank Systems	6.2 General Requirements	6.2.7(1)	High-technology secondary containment monitoring shall continuously monitor the interstitial space and include the use of an automatic device designed, built, and approved in conformance with: (a) ORD-58.12-1992, "Leak Detection Devices (Volumetric Type) for Underground Storage Tanks", or (b) ORD-58.14-1992, "Leak Detection Devices (Non-volumetric Type) for Underground Storage Tanks".	Not applicable; tank systems are aboveground.
Part 6: Monitoring and Leak Detection of Storage Tank Systems	6.2 General Requirements	6.2.8	Visual leak detection procedures shall be performed in conformance with Sentence 8.4.1(3).	Conforms. See BAF-PH1-310-PRO-0001 Fuel Dipping/ Tank Farm Inspection (2014) and BAF-PH1-830-P16-0008 Environmental Protection Plan (2014).
Part 6: Monitoring and Leak Detection of Storage Tank Systems	6.2 General Requirements	6.2.9(1)	A pressure liquid media leak detection test shall be in conformance with the requirements of a precision leak detection test and: (a) the test device shall be third-party performance certified; and (b) testing technicians shall be trained in the care and use of the test device	Not applicable as spools were tested prior to construction of piping systems.
Part 6: Monitoring and Leak Detection of Storage Tank Systems	6.2 General Requirements	6.2.10(1)	A static liquid media leak detection test shall be in conformance with the following requirements: (a) leak rate shall not exceed 0.38 L/h; (b) the duration of the test shall be a minimum of 1 hour; (c) there shall be no visual evidence of a leak; and (d) the test fluid shall exceed the elevation of piping and electrical conduit openings installed in sumps at the time of the leak detection test.	Not applicable as spools were tested prior to construction of piping systems.



Part	Section	Reference	Requirement	Comment
Part 6: Monitoring and Leak Detection of Storage Tank Systems	6.2 General Requirements	6.2.11(1)	A high-pressure inert gas or vacuum leak detection test for piping shall be in conformance with the following procedures, as applicable: (a) a high-pressure decline test using an inert gas or a vacuum test may be used as a leak detection test for piping systems that are in use and that have a volume of less than 1,000 L; (b) whenever permitted by the equipment design and installation, product contained in the piping system shall be drained prior to conducting the high-pressure inert gas or vacuum test procedure; (c) pumps, dispensers or other auxiliary equipment connected to the piping that cannot be subjected to the pressure of the test shall be isolated from the test procedures to prevent equipment damage; (d) a test pressure or vacuum shall, as applicable: (i) be more than 350 kPa (gauge) or 1.5 times the maximum operating pressure, whichever is greater; (ii) not exceed 700 kPa (gauge), except when the piping system is designed for such pressures; and (iii) not exceed the equipment manufacturer's design limitations. (e) stabilization is required after pressurization or vacuum is achieved; (f) a piping system with a volume of less than or equal to 500 L shall have the pressure or vacuum maintained for a period of at least 60 min after stabilization; (g) a piping system with a volume of greater than 500 L but less than or equal to 1,000 L shall have the test pressure or vacuum maintained for a period of at least two hours after stabilization; (h) a piping system with a volume greater than 1000 L shall be tested using a procedure acceptable to the authority having jurisdiction (See Appendix B, Note B6.2.11 (1) (h); and (i) a piping system shall be considered to be leaking when pressure variations that occur after stabilization and within the test time period are greater than two percent of the test pressure or vacuum.	All piping has been tested in conformance with B31.3 - Process Piping; conforms.
Part 6: Monitoring and Leak Detection of Storage Tank Systems	6.2 General Requirements	6.2.12(1)	A low-pressure inert gas or vacuum leak detection test for piping shall be conducted in conformance with the following procedures, as applicable: (a) a low-pressure decline test using an inert gas or a vacuum test may be used to conduct a leak detection test on the secondary containment of double-wall tanks and double-wall pipe; (b) product contained in the secondary containment system shall be drained prior to conducting the low-pressure decline or vacuum test procedure; (c) a test pressure or vacuum shall, as applicable: (i) be between 20 kPa and 35 kPa; and (ii) not exceed the equipment manufacturer's design limitations; (d) stabilization is required after pressurization or vacuum is achieved; (e) secondary containment shall have the test pressure or vacuum maintained for a period of at least two hours after stabilization; and (f) a piping system shall be considered to be leaking when pressure variations that occur after stabilization and within the test time period are greater than two percent of the test pressure or vacuum.	All piping has been tested in conformance with B31.3 - Process Piping; conforms.
Part 6: Monitoring and Leak Detection of Storage Tank Systems	6.2 General Requirements	6.2.13(1)	A precision leak detection test shall be in conformance with (See Appendix B, note B.6.2.13(1)): (a) ORD-C58.12-1992, "Leak Detection Devices (Volumetric Type) for Underground Storage Tanks;" or (b) ORD-58.14-1992, "Leak Detection Devices (Non-volumetric Type) for Underground Tanks."	Not applicable; tank systems are aboveground.
Part 6: Monitoring and Leak Detection of Storage Tank Systems	6.3 Leak Detection Interlocks and Alarms	6.3.1(1)	Subject to Sentence (2), an automatic leak detection device, including a high-technology secondary containment monitoring device and precision line leak detection device, shall be electrically interlocked in such a manner that: (a) when the automatic leak detection device is activated, product flow shall be shut off; and (b) except for on-site maintenance activities, when the automatic leak detection device is turned off or bypassed for more than one minute, product flow shall be terminated.	Not applicable; see 6.7.2(1) Table 4 and Table 6.
Part 6: Monitoring and Leak Detection of Storage Tank Systems	6.3 Leak Detection Interlocks and Alarms	6.3.1(2)	When an electrical interlock as specified in Sentence (1) is not possible, the authority having jurisdiction shall be notified whenever the leak detection device or method indicates a leak. (See Appendix B, note B.6.3.1(2))	Complies.
Part 6: Monitoring and Leak Detection of Storage Tank Systems	6.3 Leak Detection Interlocks and Alarms	6.3.2	A suction pump shall be equipped with a single check valve installed directly below the suction pump and piping shall slope so the contents of the pipe will drain back to the storage tank if the suction is broken.	Not applicable.
Part 6: Monitoring and Leak Detection of Storage Tank Systems	6.3 Leak Detection Interlocks and Alarms	6.3.3	A leak detection alarm shall be located where the staff routinely work and in a place where such alarms can be readily heard and seen.	Not applicable; see 6.7.2(1) Table 4 and Table 6.
Part 6: Monitoring and Leak Detection of Storage Tank Systems	6.4 Monitoring Wells	Not Applicable.	Not Applicable.	Not applicable; systems do not include monitoring wells.
Part 6: Monitoring and Leak Detection of Storage Tank Systems	6.5 Groundwater Monitoring Wells	Not Applicable.	Not Applicable.	Not applicable; systems do not include groundwater monitoring wells.
Part 6: Monitoring and Leak Detection of Storage Tank Systems	6.6 Vapour Monitoring Wells	Not Applicable.	Not Applicable.	Not applicable; systems do not include vapour monitoring wells.
Part 6: Monitoring and Leak Detection of Storage Tank Systems	6.7 Frequency and Method	6.7.1	The reference letters in Table 2 represent the leak detection and monitoring methods specified in Tables 3 through 9.	Used to complete answers below for 6.7 Frequency and Method.

Part	Section	Reference	Requirement	Comment
Part 6: Monitoring and Leak Detection of Storage Tank Systems	6.7 Frequency and Method	6.7.2(1)	Tables 3 through 9 specify the frequencies and methods of leak detection and monitoring that shall be used upon installation and, as applicable (See Appendix B, note B.6.7.2(1)); (a) for in-service monitoring; (b) for periodic leak detection testing; or (c) if a leak is suspected.	(a) Conforms; (b) Conforms; (c) Not applicable.
Part 6: Monitoring and Leak Detection of Storage Tank Systems	6.7 Frequency and Method	Table 4	Aboveground Storage Tanks: (a) Containment type; (b) Final installation leak detection; (c) In-service monitoring; (d) Periodic leak detection; (e) Leak suspected.	(a) API standard 650-98 (within approved secondary containment); (b) API 650 Standard; (c) Inventory Reconciliation (IR), Visual Leak Detection (VLD); (d) API 653; (e) API 653.
Part 6: Monitoring and Leak Detection of Storage Tank Systems	6.7 Frequency and Method	Table 6	Aboveground Piping: (a) Containment type; (b) Final installation leak detection; (c) In-service monitoring; (d) Periodic leak detection; (e) Leak suspected.	(a) All types; (b) High Pressure Inert gas or vacuum leak detection test (HPVLDT); (c) VLD; (d) Not required; (e) HPVLDT.
Part 7: Upgrading of Existing Storage Tank Systems	7.2 General Requirements	7.2.1	No person shall upgrade, or cause to be upgraded, an existing storage tank system unless approval has been obtained from the authority having jurisdiction.	Conforms.
Part 7: Upgrading of Existing Storage Tank Systems	7.2 General Requirements	7.2.2(1)	Where an existing storage tank system is upgraded to be in conformance with this Code, the owner shall provide a revised as-built drawing to the authority having jurisdiction in the manner and time frame as specified by the authority having jurisdiction.	Not applicable.
Part 7: Upgrading of Existing Storage Tank Systems	7.2 General Requirements	7.2.2(2)	A revised as-built drawing shall be in conformance with Sentence 3.2.7(2) or 4.2.8(2), as applicable.	As-built drawings form part of this report.
Part 7: Upgrading of Existing Storage Tank Systems	7.2 General Requirements	7.2.3	A partially buried storage tank is considered neither an aboveground nor underground storage tank and shall be withdrawn from service and removed in conformance with Part 9 within two years of the effective date of this Code.	Not applicable; system does not have a "partially buried storage tank".
Part 7: Upgrading of Existing Storage Tank Systems	7.3 Aboveground Storage Tank Systems	7.3.1	An existing aboveground storage tank system not in conformance with Section 3.6 shall be withdrawn from service and removed in conformance with Part 9 within two years of the effective date of this Code.	Not applicable.
Part 7: Upgrading of Existing Storage Tank Systems	7.3 Aboveground Storage Tank Systems	7.3.2(1)	Where underground piping connected to an aboveground storage tank has corrosion protection in conformance with Section 4.5 at the effective date of this Code, the piping may continue in service.	Not applicable.
Part 7: Upgrading of Existing Storage Tank Systems	7.3 Aboveground Storage Tank Systems	7.3.2(2)	Where underground piping connected to an aboveground storage tank does not have corrosion protection in conformance with Section 4.5 at the effective date of this Code: (a) the piping must be withdrawn from service and removed in conformance with Part 9 within two years of the effective date of this Code; or (b) best management practices shall be implemented within two years of the effective date of this Code in conformance with: i) API Std 2610-94, "Design, Construction, Operation, Maintenance and Inspection of Terminal and Tank Facilities"; and ii) API 570-98, "Piping Inspection Code: Inspection, Repair, Alteration, and Retesting of In-Service Piping Systems".	Not applicable.
Part 7: Upgrading of Existing Storage Tank Systems	7.3 Aboveground Storage Tank Systems	7.3.3(1)	Except as specified in Sentence (2), an aboveground storage tank system shall be upgraded within two years of the effective date of this Code to include, as applicable: (a) liquid and vapour-tight connections, caps and adapters for a storage tank with a capacity of 5 000 L or more; (b) overfill protection in conformance with Article 3.6.2 for a storage tank with a capacity of 5 000 L or more; (c) underground piping in conformance with Section 5.4; (d) dispenser sumps in conformance with Article 3.6.3, where an underground piping run terminates under a dispenser; and (e) secondary containment in conformance with Section 3.9 and Sentences 7.3.4(1) and (2).	Not applicable
Part 7: Upgrading of Existing Storage Tank Systems	7.3 Aboveground Storage Tank Systems	7.3.3(2)	Where secondary containment is not upgraded as provided in Clause (1)(e), an annual precision leak detection test shall be performed.	Not applicable



Part	Section	Reference	Requirement	Comment
Part 7: Upgrading of Existing Storage Tank Systems	7.3 Aboveground Storage Tank Systems	7.3.4(1)	Except as provided in Sentence (2), an existing field-erected aboveground storage tank not upgraded to be in conformance with Section 3.3 shall be withdrawn from service and removed in conformance with Part 9 within five years of the effective date of this Code.	Not applicable.
Part 7: Upgrading of Existing Storage Tank Systems	7.3 Aboveground Storage Tank Systems	7.3.4(2)	Where authorized by the authority having jurisdiction, an existing field-erected aboveground storage tank may be exempt from adding an impermeable barrier under the tank to meet the secondary containment requirements of Section 3.9 provided that within two years of the effective date of this Code: (a) best management practices are followed in conformance with API Std 653-01, "Tank Inspection, Repair, Alteration, and Reconstruction"; or (b) if inspection requires replacing or lining the tank bottom, then 3.9.2(1)(b) shall apply (See Appendix B, note B.7.3.4(2)(b)).	Not applicable.
Part 7: Upgrading of Existing Storage Tank Systems	7.3 Aboveground Storage Tank Systems	7.3.4(3)	In the event that a storage tank owner chooses the exemption provided in Clause 7.3.4(2)(b) and the storage tank bottom or shell becomes perforated, then all other storage tanks with equal or more years of similar service at that site that are being managed under API Std 653-01, "Tank Inspection, Repair, Alteration, and Reconstruction", shall be: (a) inspected within one year; or (b) re-evaluated within the time frame specified by the new corrosion rate.	Not applicable.
Part 7: Upgrading of Existing Storage Tank Systems	7.3 Aboveground Storage Tank Systems	7.3.5	An existing aboveground storage tank not upgraded with spill containment and runoff collection in conformance with Section 3.10 shall be withdrawn from service and removed in conformance with Part 9 within five years of the effective date of this Code.	Not applicable.
Part 7: Upgrading of Existing Storage Tank Systems	7.3 Aboveground Storage Tank Systems	7.3.6	An existing shop fabricated aboveground storage tank system not upgraded to be in conformance with Sections 3.4, 3.5, and this Section shall be withdrawn from service and removed in conformance with Part 9 within two years of the effective date of this Code.	Not applicable.
Part 7: Upgrading of Existing Storage Tank Systems	7.4 Underground Storage Tank Systems	Not Applicable.	Not Applicable.	Not applicable.
Part 8: Operation and Maintenance	Not applicable for Construction.	Not applicable for Construction.	Not applicable for Construction.	Current operational control documents and SOPs for Baffinland relating to the fuel tank system equipment include: BAF-PH1-310-PRO-0001 Fuel Dipping/ Tank Farm Inspection BAF-PH1-830-P16-0007 Emergency Response Plan BAF-PH1-830-P16-0036 Spill Contingency Plan Operator checklists are found in Section 3 of document BAF-PH1-830-P16-0008 Environmental Protection Plan for fuel handling activities. These documents are referenced to address Baffinland's requirements relating to Part 8 of the CCME code compliance. In an effort to address requirements relating to additional fuel tank system equipment and requirements associated with the CCME code not currently captured within these referenced documents, operational control documents will undergo revision as required.
Part 9: Withdrawal from Service of Storage Tank Systems	Not Applicable.	Not Applicable.	Not Applicable.	Not applicable.

## **Appendix G**

### **Geotechnical Investigation and Geotechnical Inspections**

#### **2018 Mine Site Geotechnical Investigation Report H353004-10000-229-230-0006**