

APPENDIX C.1.2

Camp Lake Sediment and Erosion Control Measures As Built Documentation



February 14, 2020

Assol Kubeisinova Technical Advisor, NWB P.O. Box 119 Gjoa Haven, NU X0B 1J0

RE: As Built Documentation Submission

Camp Lake Sediment and Erosion Control Measures

Mary River Project - Type 'A' Water Licence 2AM-MRY1325 - Amend. No. 1

On behalf of Baffinland Iron Mines Corporation (Baffinland), please find attached submission of as-built documentation for the Camp Lake Sediment and Erosion Control Measures, provided at the direction of the Crown Indigenous Relations and Northern Affairs Canada (CIRNAC) Water Resources Officer.

The Camp Lake Sediment and Erosion Control Measures were implemented to address sedimentation observed in the vicinity of the Camp Lake water jetty. This structure was constructed consistent with the approved Surface Water and Aquatic Ecosystems Management Plan (SWAEMP) as an emergency mitigation measure in response to an observed sedimentation event and subsequent sedimentation events at this location. Due to the nature of the construction and urgency of implementation, no Issued for Construction drawings were submitted to the Nunavut Water Board (NWB), nor were they deemed required to be submitted.

These structures have been added to the bi-annual Geotechnical Report submitted to the NWB, which confirms the integrity of the structure. At the direction of the Water Resources Officer, Baffinland has prepared as-built documentation for these structures to verify its construction. Baffinland notes that due to the nature of the construction as an emergency measure, Baffinland will not provide as-built documentation for sediment and erosion control measures implemented under the SWAEMP, unless directed to do so by the NWB or CIRNAC.

Should you have any questions or concerns regarding this submission, please contact myself to discuss.

Regards,

Christopher Murray

Environmental & Regulatory Compliance Manager

Attachments:

Attachment 1: Camp Lake Sedimentation and Erosion Control As-Built


Cc: Karén Kharatyan (Nunavut Water Board)

Chris Spencer, Jared Ottenhof (Qikiqtani Inuit Association)

Johnathan Mesher, Justin Hack, Bridget Campbell, Godwin Okonkwo (Crown-Indigenous Relations and Northern Affairs Canada) Megan-Lord Hoyle, Lou Kamermans, Timothy Ray Sewell, Shawn Stevens, Connor Devereaux, Amanda McKenzie (Baffinland)

Attachment No. 1

Camp Lake Sedimentation and Erosion Control As-Built

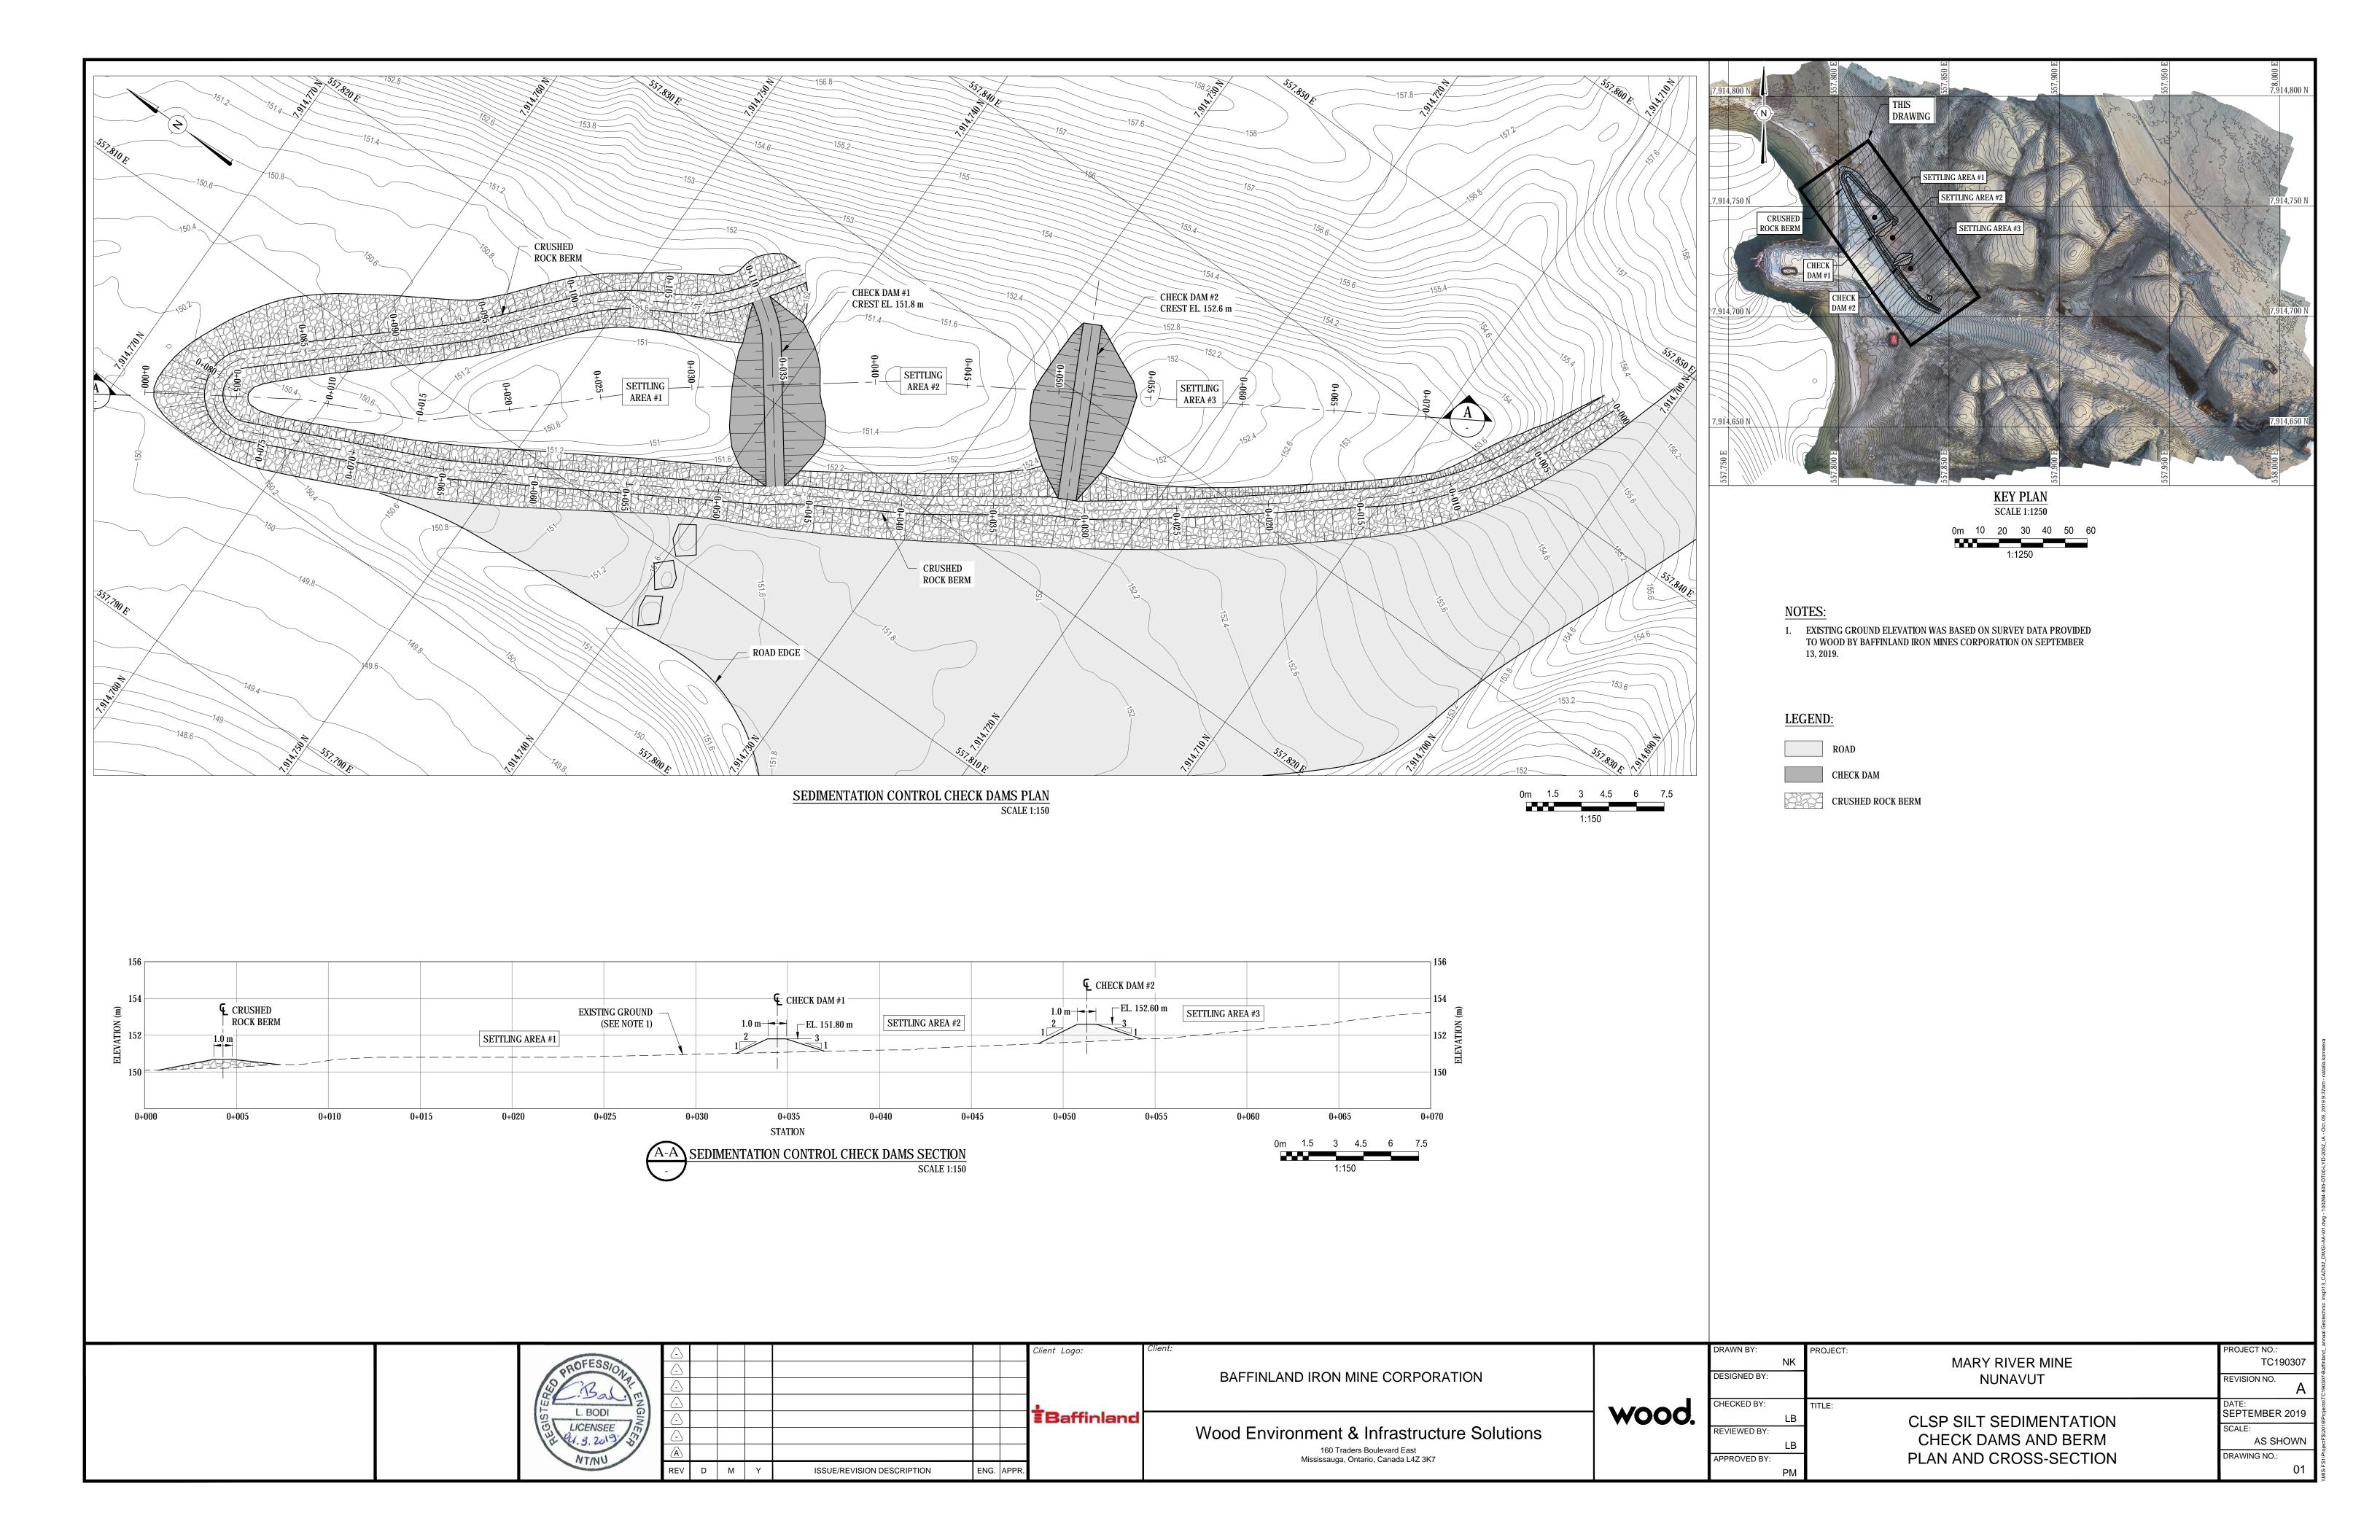



APPENDIX C.1.3

Milne Port Fuel Module - As-Built

