


CL1 DIV 2 AREA

BLDS ARE ALL 40' HC


HATCH		VENDOR DATA REVIEW	
Doc Number	E349000-PM009-50-042-0001	Sub	05
Date Received			
Review Grade		Next Submittal Status	
☐ C1 - Proceed to next submission & status		☐ Internal Review	
☐ C2 - Proceed with exceptions as noted to next submission & status		☐ Certified Final	
☐ C3 - Do not proceed, revise as noted & resubmit		☐ Final	
		☐ As-Built	
		Next Submittal Date:	
No further submission required - Complete	☐		
☐ C4 - No further submission required - Cancelled			
No further submission required - Superseded	☐		
Package Coordinator: Name, signature and Date:			
REVIEWED ONLY FOR GENERAL CONFORMITY WITH THE SPECIFICATIONS. ACCEPTANCE BY THE ENGINEER DOES NOT WARRANT OR REPRESENT THAT THE INFORMATION CONTAINED ON THIS DRAWING/DOCUMENT IS EITHER ACCURATE OR COMPLETE. THE SOLE RESPONSIBILITY FOR CORRECT DESIGN, DETAILS & DIMENSIONS SHALL REMAIN WITH THE PARTY SUBMITTING THE DRAWING/DOCUMENT.			

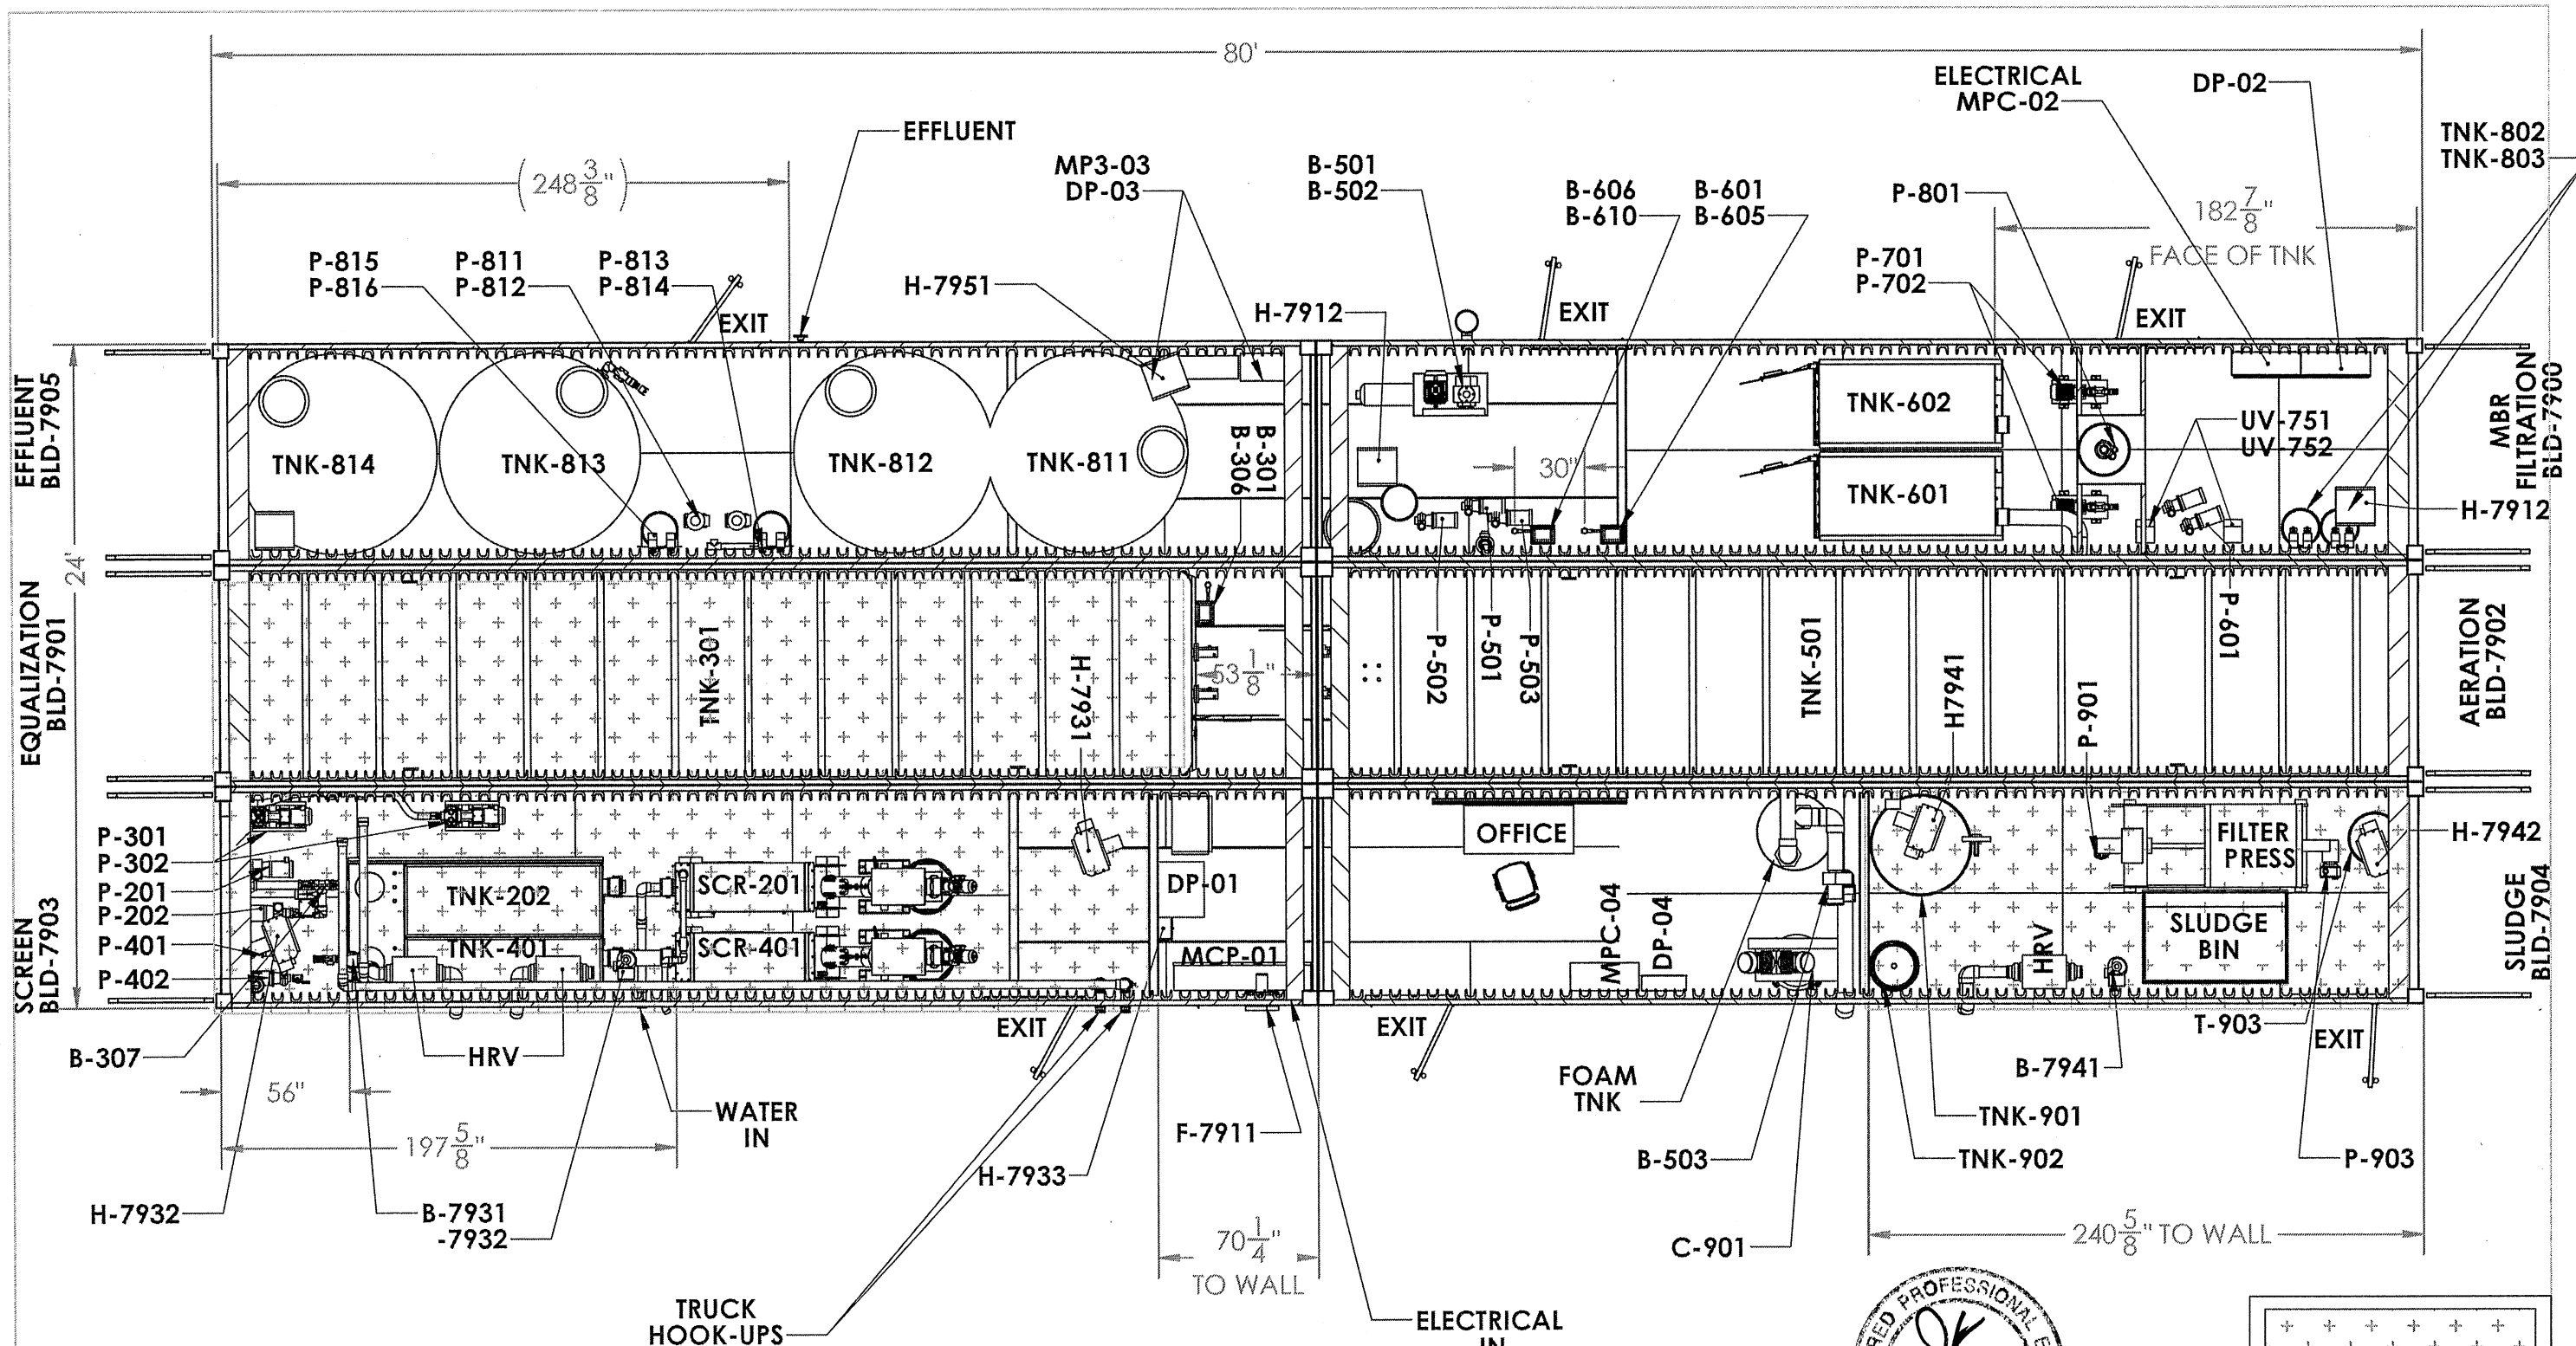

GENERAL TOLERANCES
 .XX ± 1/8"
 .XXX ± 1/16"
 UNLESS OTHERWISE SPECIFIED
 DIMENSIONS ARE IN INCHES
 THIS INFORMATION IS THE PROPERTY OF newterra
 AND CANNOT BE REUSED OR REPRODUCED WITHOUT
 WRITTEN CONSENT.

LEVEL	DATE	BY	REVISION
C-01	20/06/13	JDD	ADD FIRE ALARM BOX SHEET #2
C	18/06/13	JDD	AS BUILT
B	02/05/13	JDD	FOR PRODUCTION
A-01	23/04/13	JDD	FOR REVIEW
A	28/03/13	JDD	FOR REVIEW

DWG. NO.	E349000-PM-009-50-042-0001	PROJECT NUMBER:	300106
TITLE:	SITE LAYOUT	DRAWN BY:	JDD
CUSTOMER:	BAFFINLAND MARY RIVER	DATE:	28/03/13
		SHEET 1 OF 7	

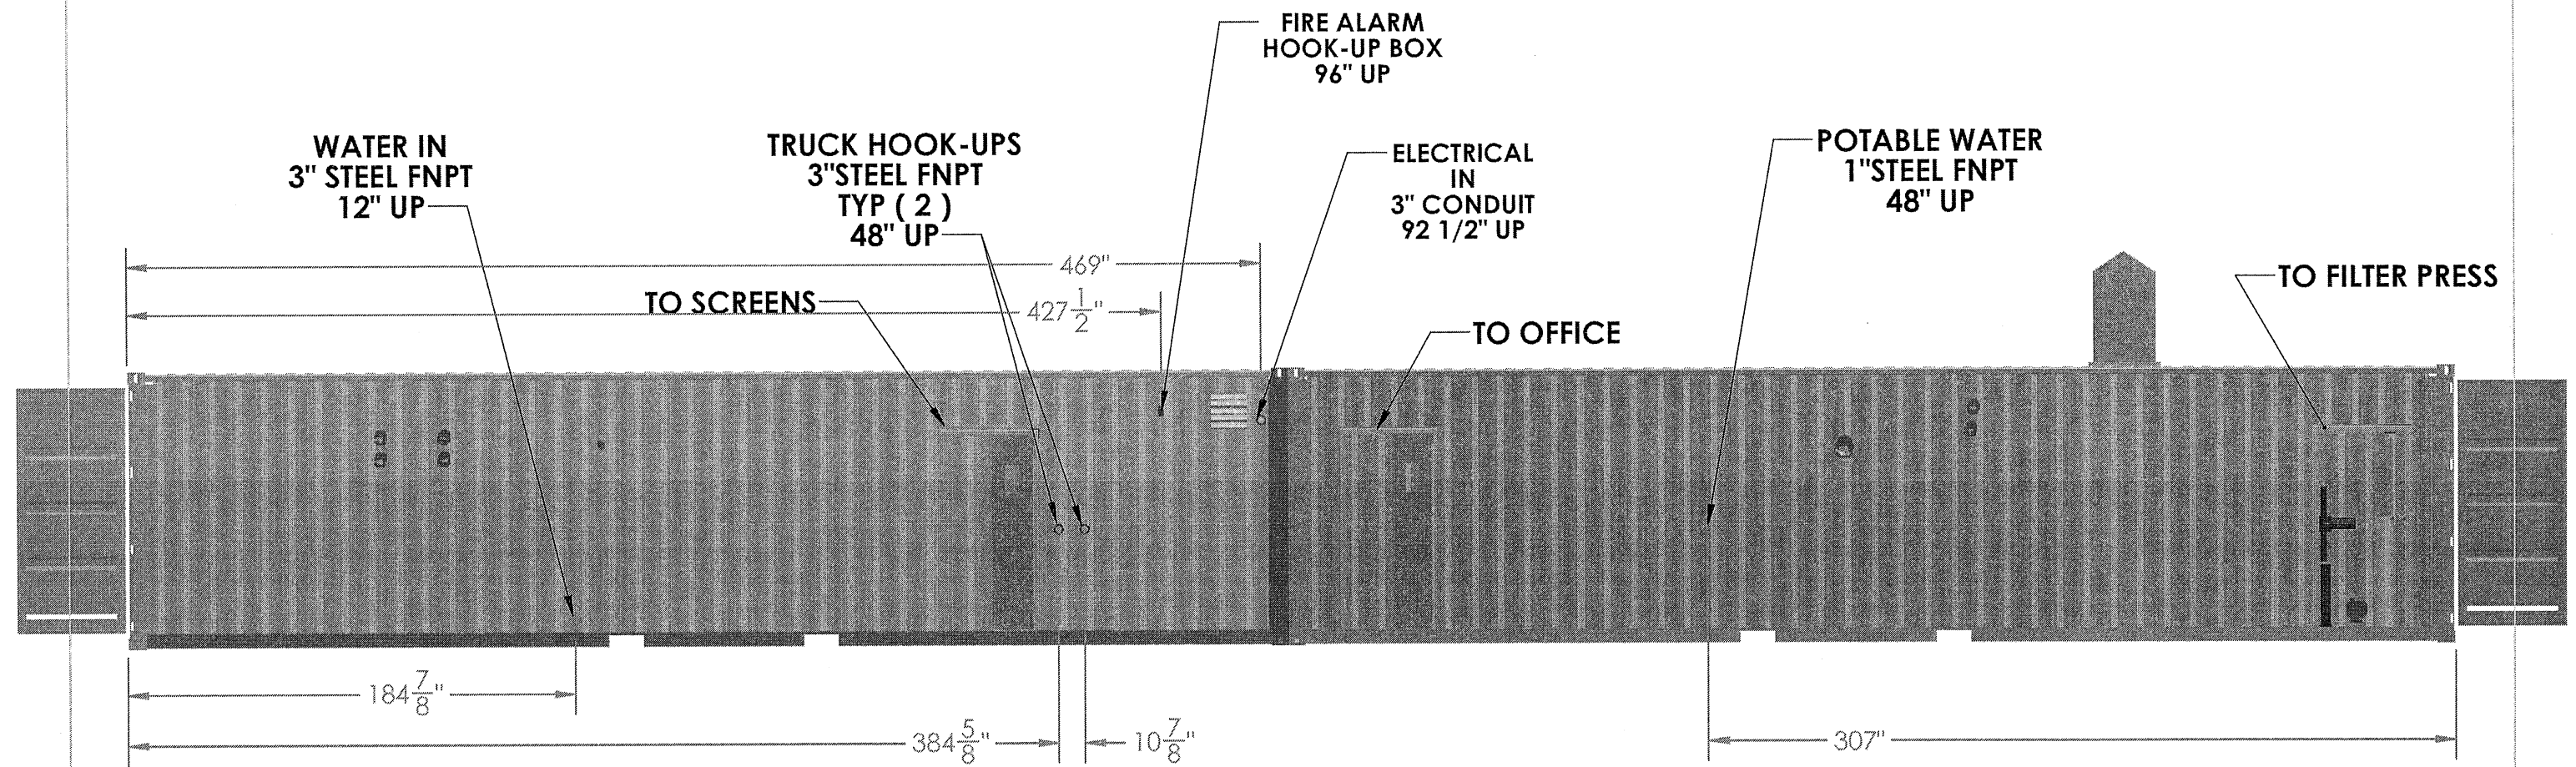

BLD-7903

BLD-7904



BLDS ARE ALL 40' HC




GENERAL TOLERANCES
 .XX ± 1/8"
 .XXX ± 1/16"
 UNLESS OTHERWISE SPECIFIED
 DIMENSIONS ARE IN INCHES

THIS INFORMATION IS THE PROPERTY OF newterra
 AND CANNOT BE REUSED OR REPRODUCED WITHOUT
 WRITTEN CONSENT.

LEVEL	DATE	BY	REVISION
C-01	20/06/13	JDD	ADD FIRE ALARM BOX SHEET #2
C	18/06/13	JDD	AS BUILT
B	02/05/13	JDD	FOR PRODUCTION
A-01	23/04/13	JDD	FOR REVIEW
A	28/03/13	JDD	FOR REVIEW

DWG. NO:	E349000-PM-009-50-042-0001	PROJECT NUMBER:	300106
TITLE:	SITE LAYOUT	SUPPLIER:	
CUSTOMER:	BAFFINLAND MARY RIVER	DRAWN BY:	JDD
		DATE:	28/03/13
			SHEET 2 OF 7

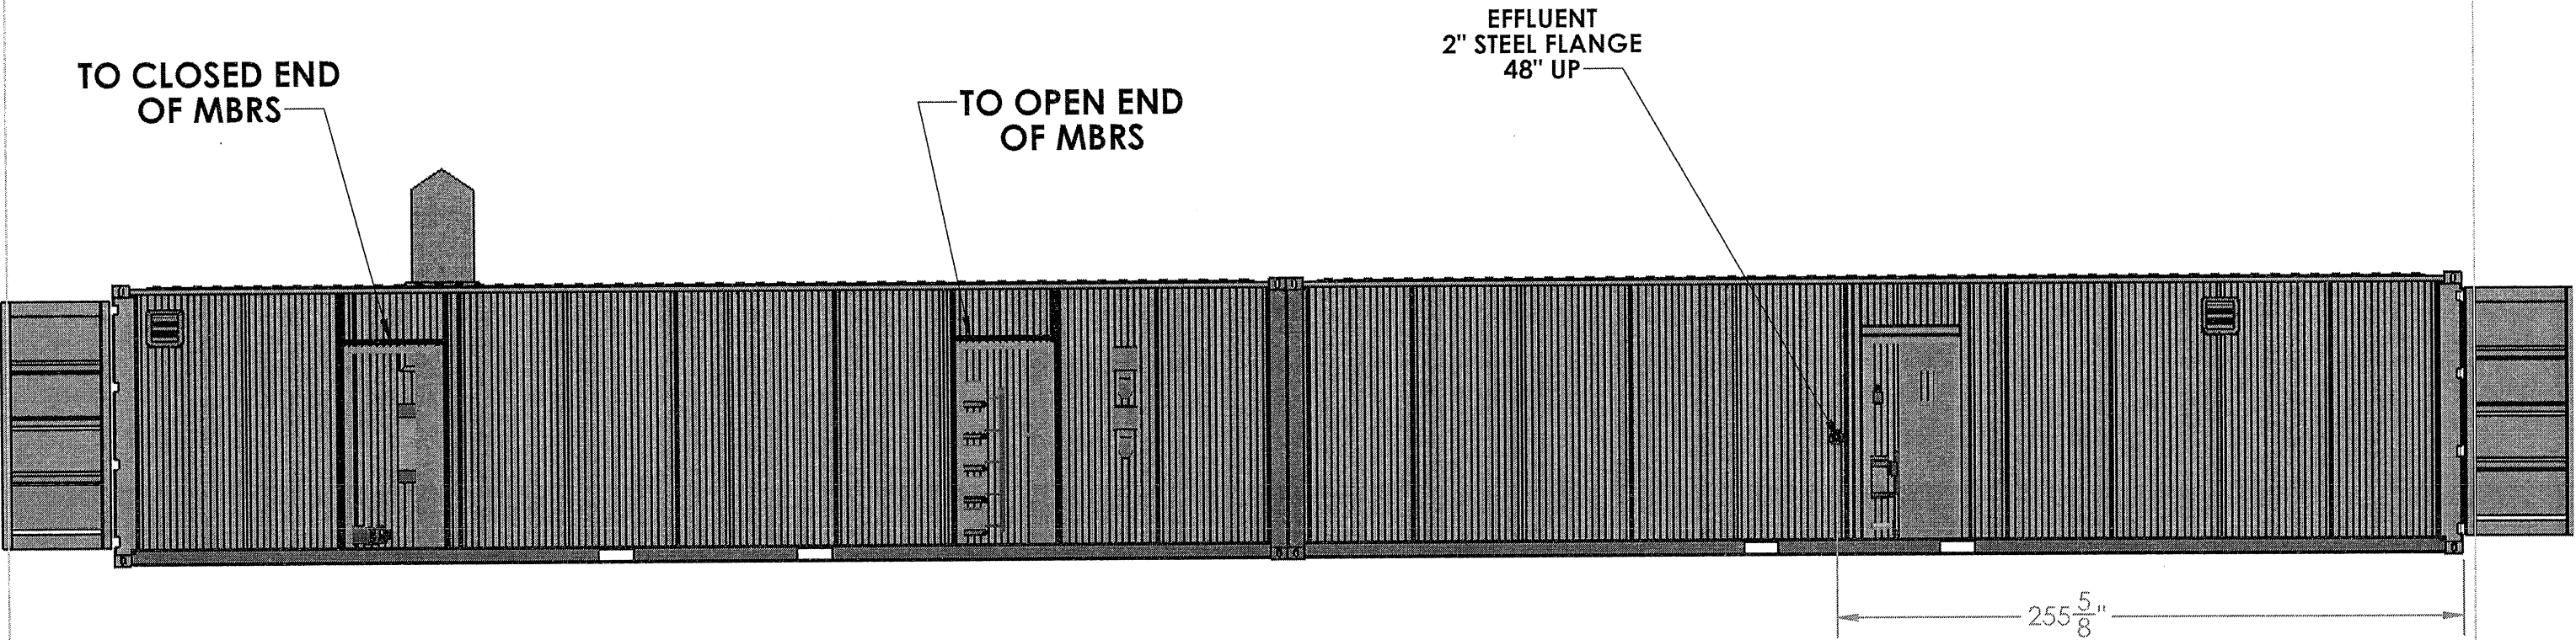

BLD-7905

BLD-7900



BLDS ARE ALL 40' HC



newterra

THIS INFORMATION IS THE PROPERTY OF newterra
AND CANNOT BE REUSED OR REPRODUCED WITHOUT
WRITTEN CONSENT

GENERAL TOLERANCES


.XX ± 1/8"

.XXX ± 1/6"

UNLESS OTHERWISE SPECIFIED
DIMENSIONS ARE IN INCHES

LEVEL	DATE	BY	REVISION
C	18/06/13	JDD	AS BUILT
B	02/05/13	JDD	FOR PRODUCTION
A-01	23/04/13	JDD	FOR REVIEW
A	28/03/13	JDD	FOR REVIEW

DWG. NO:	E349000-PM-009-50-042-0001	PROJECT NUMBER:	300106
TITLE:	SITE LAYOUT	SUPPLIER:	
CUSTOMER:	BAFFINLAND MARY RIVER	DRAWN BY:	JDD
		DATE:	28/03/13
			SHEET 3 OF 7

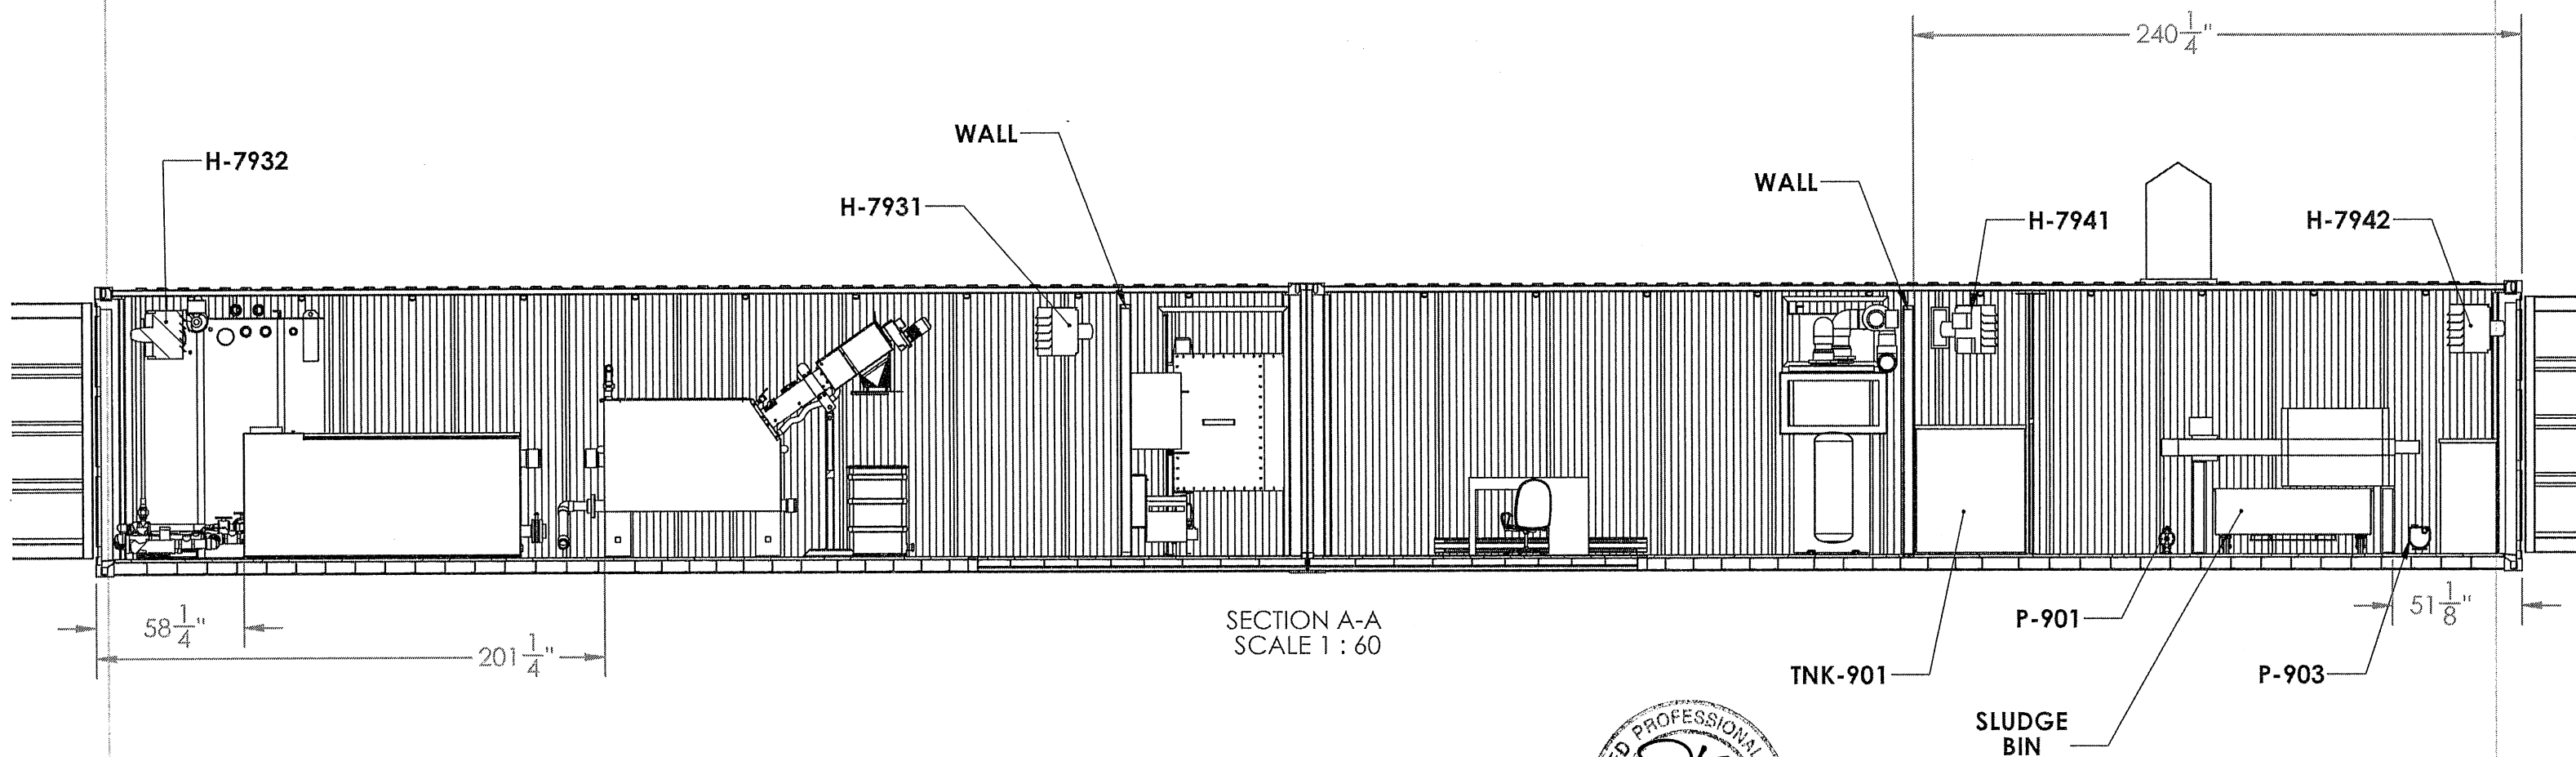



BLDS ARE ALL 40' HC



GENERAL TOLERANCES
 .XX $\pm \frac{1}{8}$ "
 .XXX $\pm \frac{1}{16}$ "
 UNLESS OTHERWISE SPECIFIED
 DIMENSIONS ARE IN INCHES
 THIS INFORMATION IS THE PROPERTY OF newterra
 AND CANNOT BE REUSED OR REPRODUCED WITHOUT
 WRITTEN CONSENT.

LEVEL	DATE	BY	REVISION
C	18/06/13	JDD	AS BUILT
B	02/05/13	JDD	FOR PRODUCTION
A-01	23/04/13	JDD	FOR REVIEW
A	28/03/13	JDD	FOR REVIEW

DWG. NO:	E349000-PM-009-50-042-0001	PROJECT NUMBER:	300106
TITLE:	SITE LAYOUT	SUPPLIER:	
CUSTOMER:	BAFFINLAND MARY RIVER	DRAWN BY:	JDD
		DATE:	28/03/13
			SHEET 4 OF 7

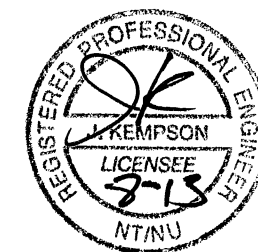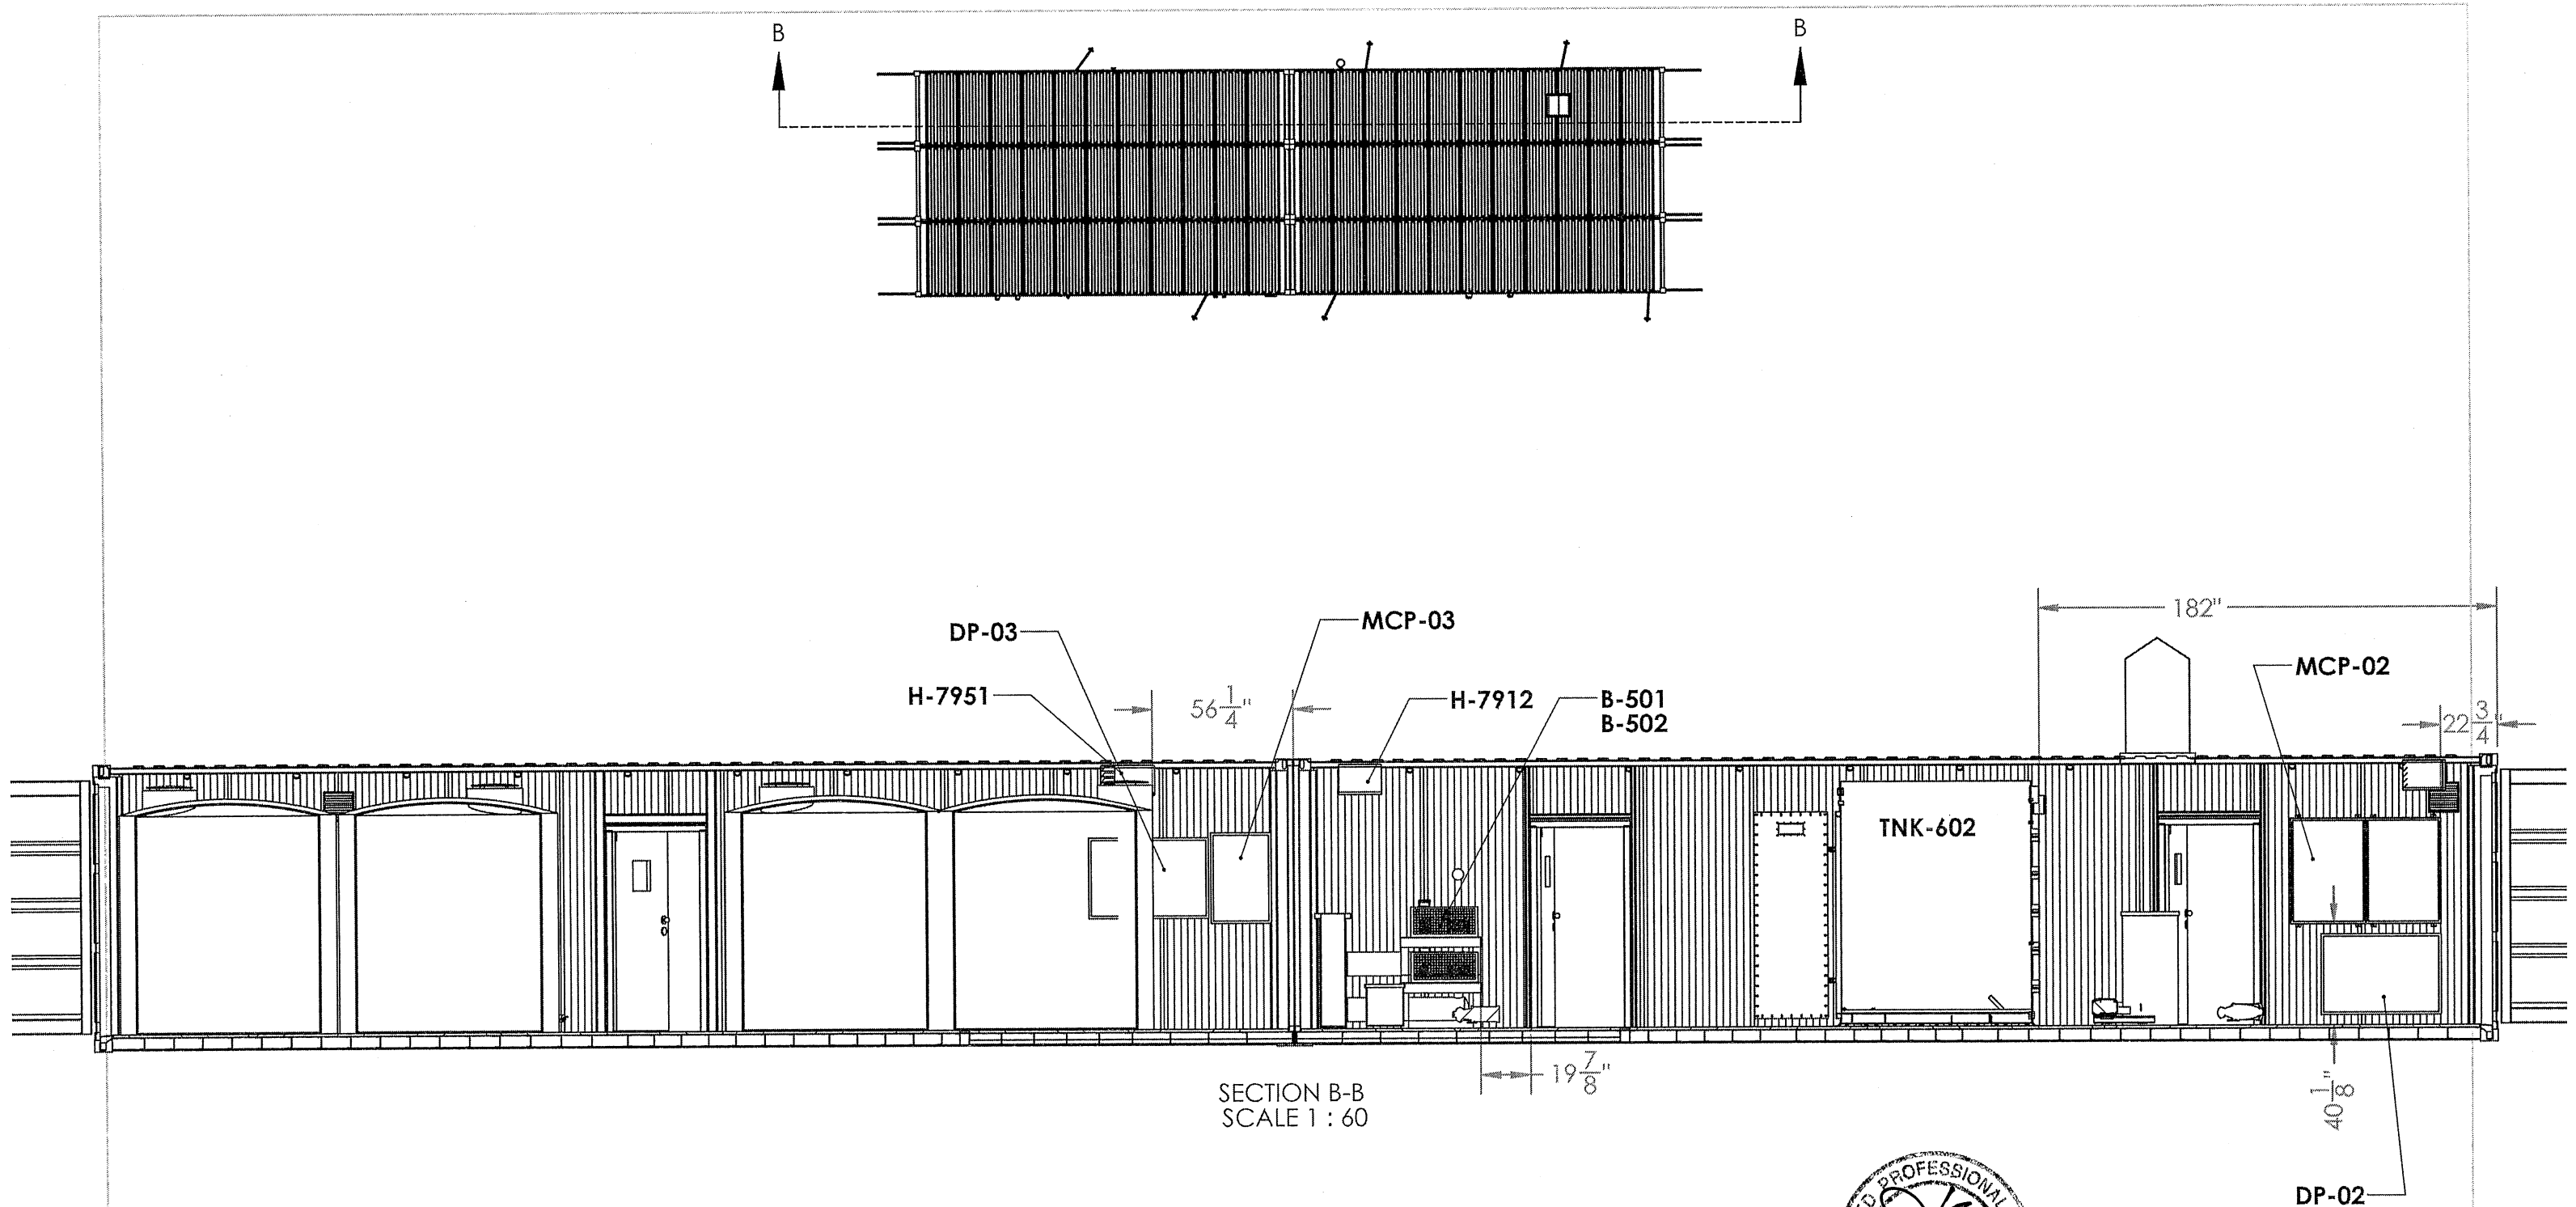




BLDS ARE ALL 40' HC



GENERAL TOLERANCES
 .XX ± 1/8"
 .XXX ± 1/16"
 UNLESS OTHERWISE SPECIFIED
 DIMENSIONS ARE IN INCHES
 THIS INFORMATION IS THE PROPERTY OF newterra
 AND CANNOT BE REUSED OR REPRODUCED WITHOUT
 WRITTEN CONSENT.

LEVEL	DATE	BY	REVISION
C	18/16/13	JDD	AS BUILT
B	02/05/13	JDD	FOR PRODUCTION
A-01	23/04/13	JDD	FOR REVIEW
A	28/03/13	JDD	FOR REVIEW

DWG. NO:	E349000-PM-009-50-042-0001	PROJECT NUMBER:	300106
TITLE:	SITE LAYOUT	SUPPLIER:	
CUSTOMER:	BAFFINLAND MARY RIVER	DRAWN BY:	JDD
		DATE:	28/03/13
		SHEET	5 OF 7

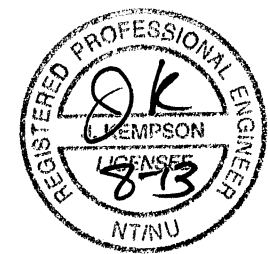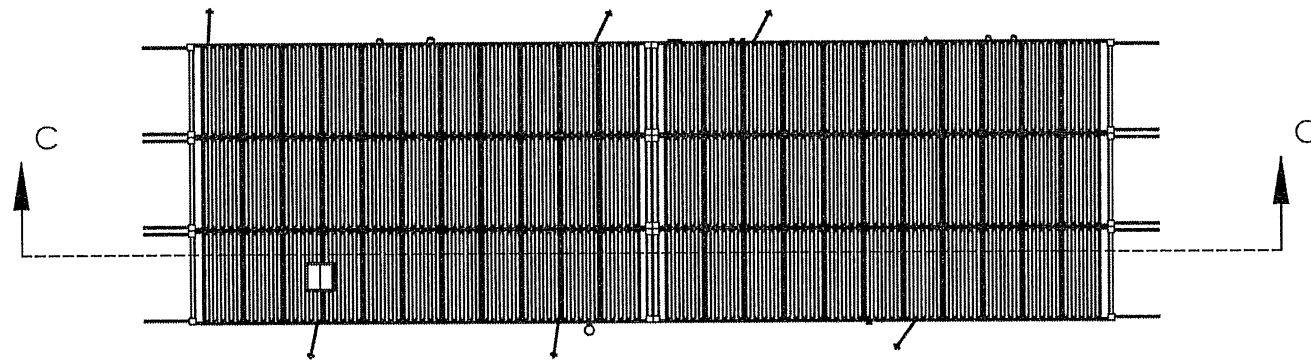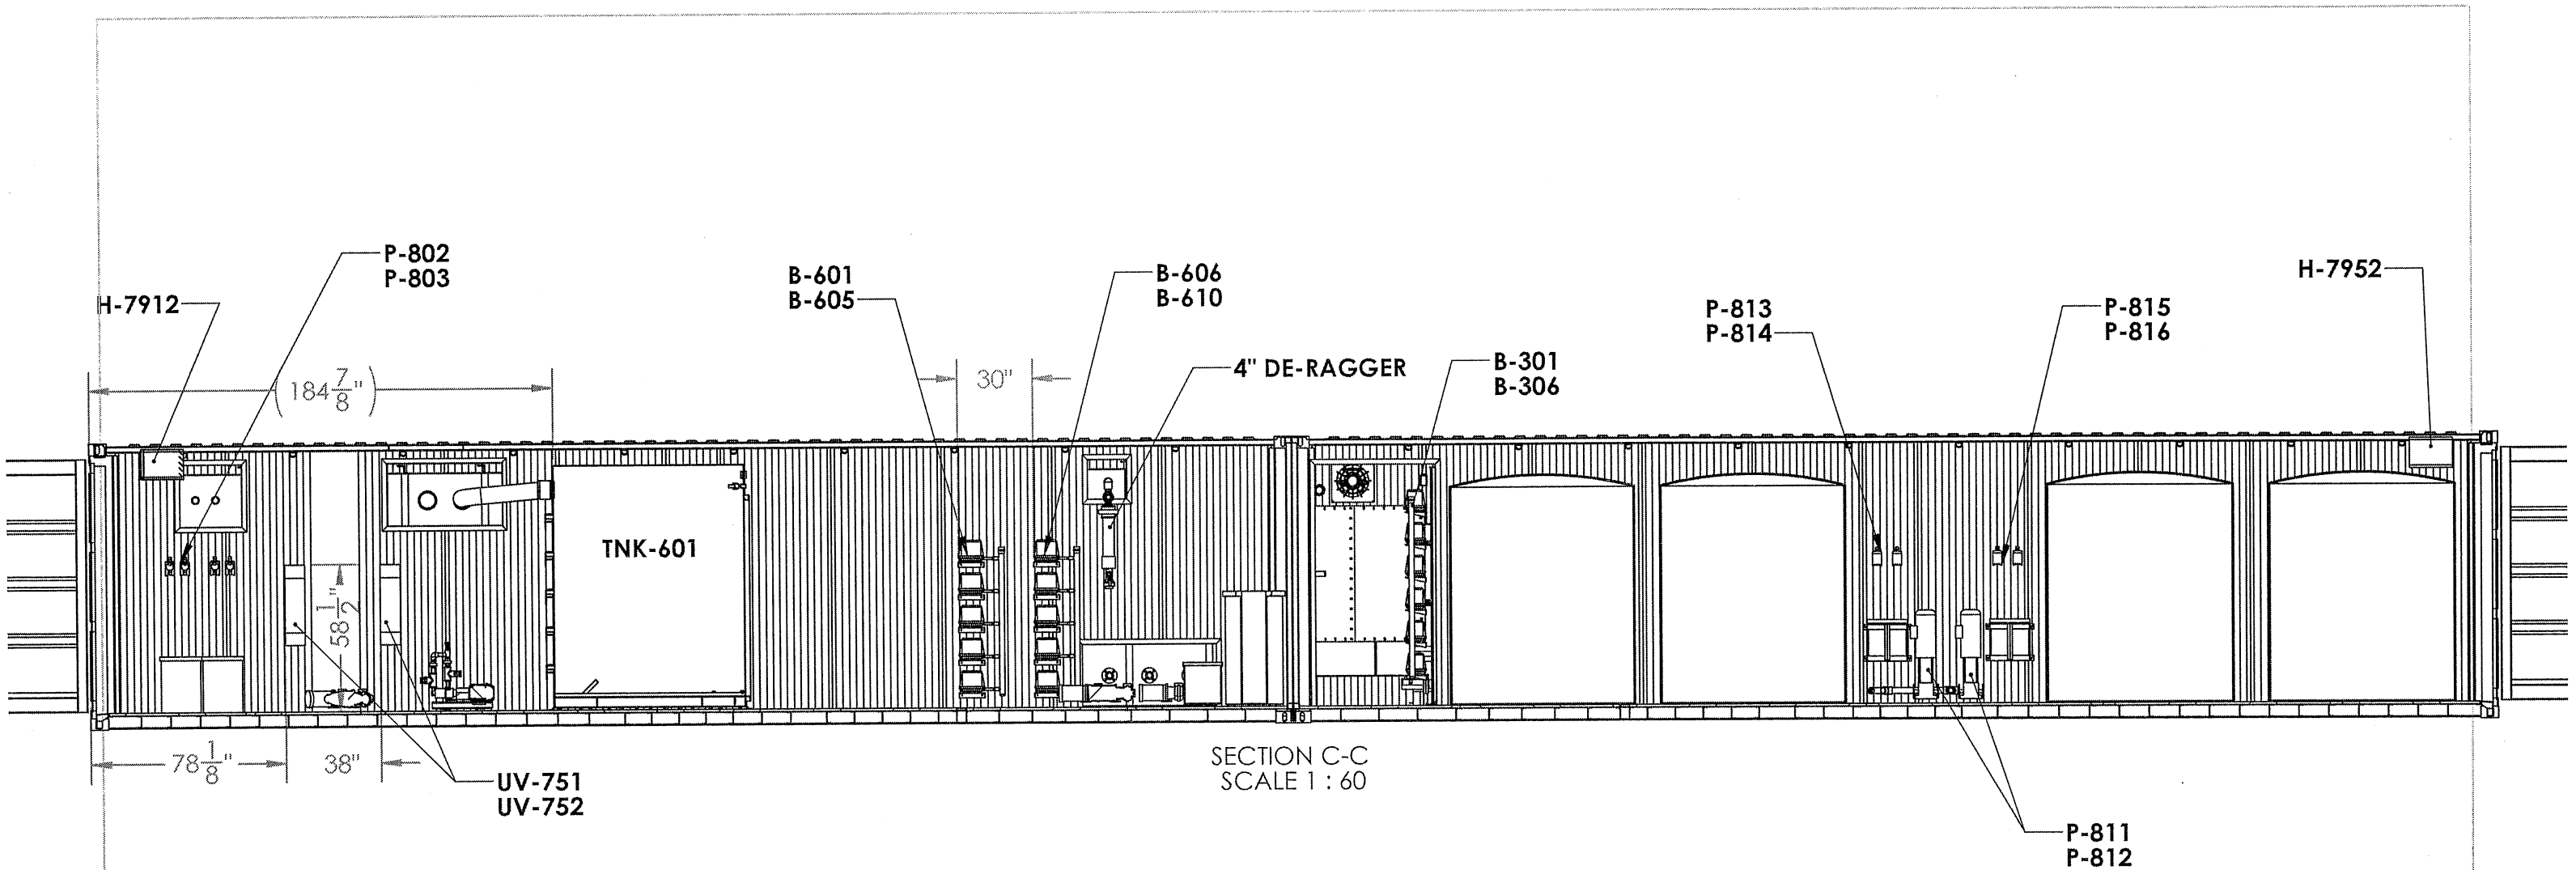

BLDS ARE ALL 40' HC



THIS INFORMATION IS THE PROPERTY OF newterra
AND CANNOT BE REUSED OR REPRODUCED WITHOUT
WRITTEN CONSENT.




GENERAL TOLERANCES

.XX ± 1/8"

.XXX ± 1/16"

UNLESS OTHERWISE SPECIFIED
DIMENSIONS ARE IN INCHES

DWG. NO: E349000-PM-009-50-042-0001			PROJECT NUMBER: 300106	
TITLE: SITE LAYOUT			SHEET 6 OF 7	
CUSTOMER: BAFFINLAND MARY RIVER			DRAWN BY: JDD	
			DATE: 28/03/13	
C	18/06/13	JDD AS BUILT		
B	02/05/13	JDD FOR PRODUCTION		
A-01	23/04/13	JDD FOR REVIEW		
A	28/03/13	JDD FOR REVIEW		
LEVEL	DATE	BY	REVISION	

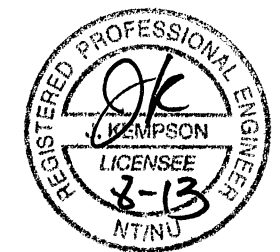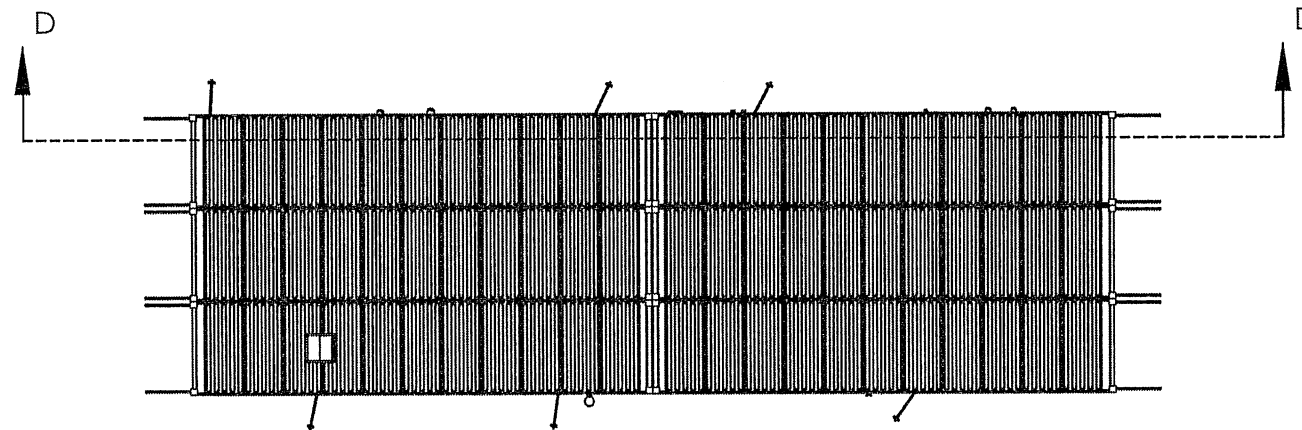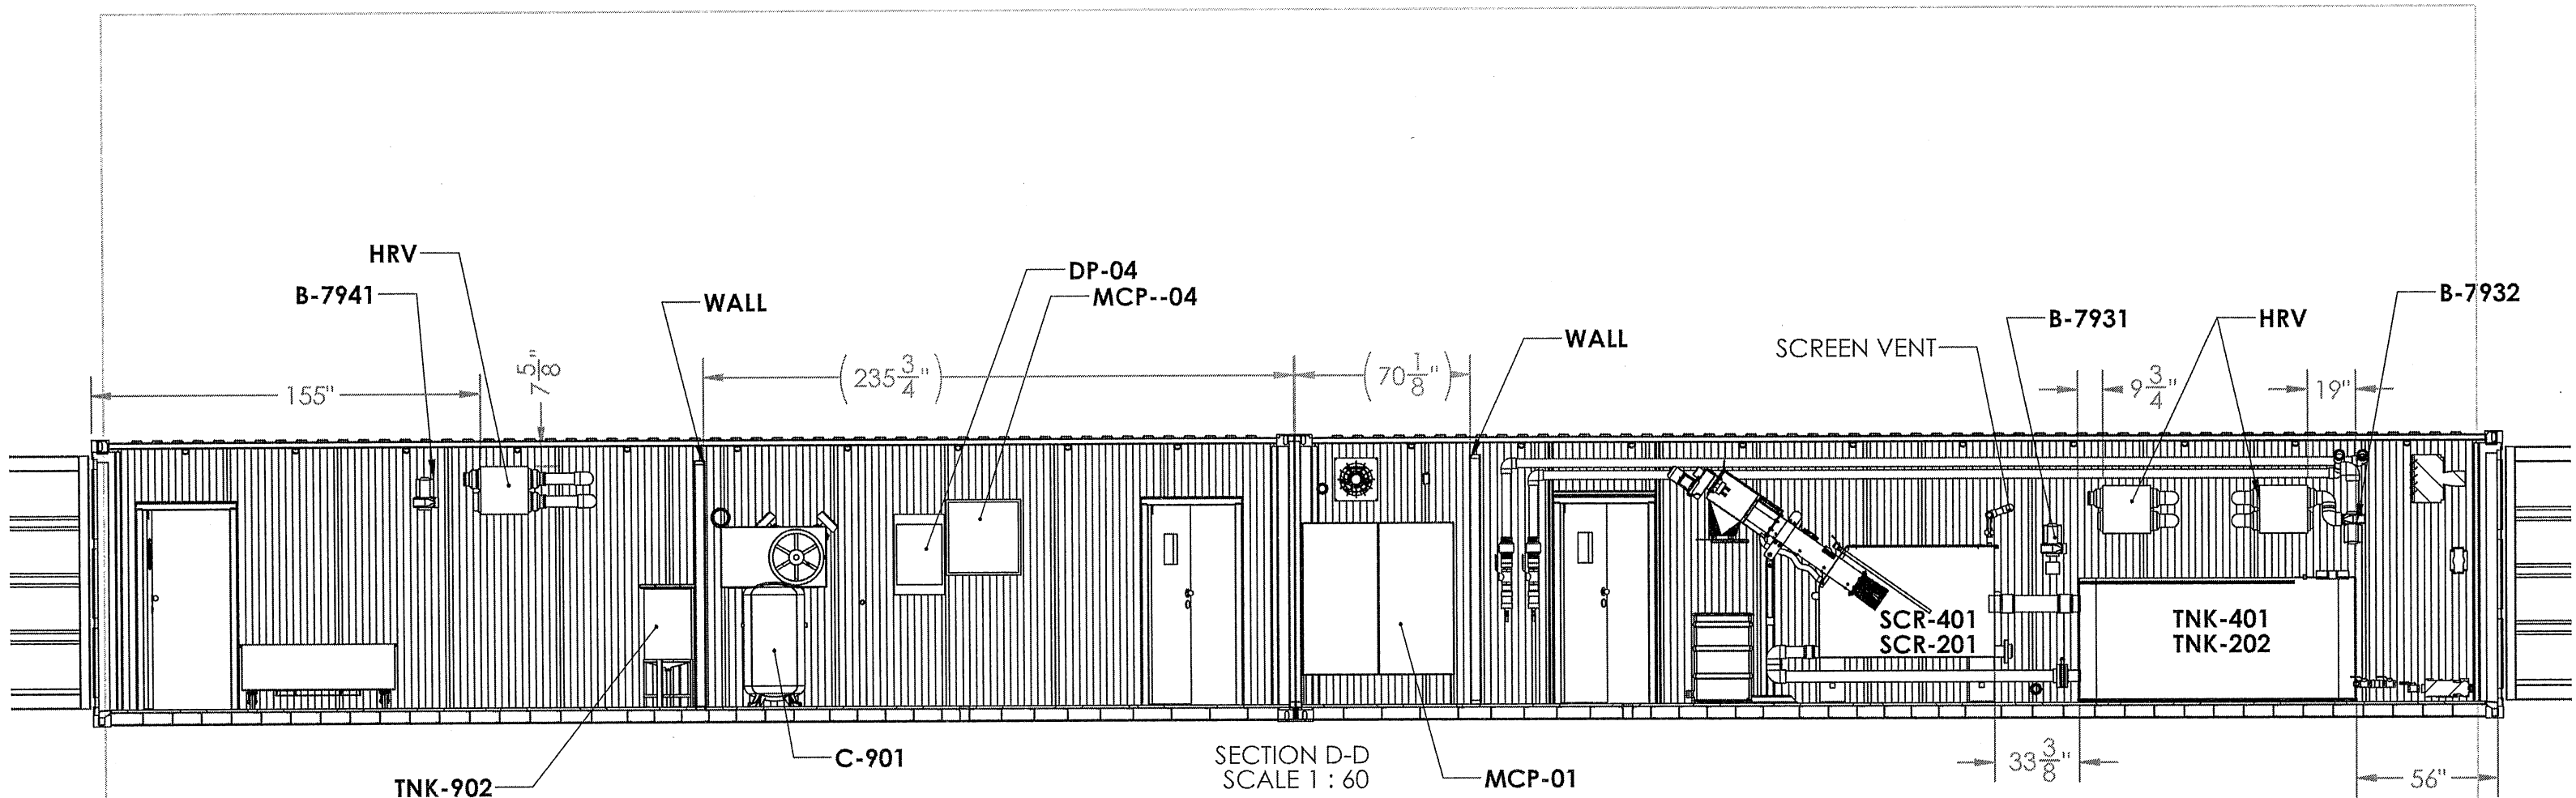

BLDS ARE ALL 40' HC



GENERAL TOLERANCES
 .XX ± 1/8"
 .XXX ± 1/16"
 UNLESS OTHERWISE SPECIFIED
 DIMENSIONS ARE IN INCHES
 THIS INFORMATION IS THE PROPERTY OF newterra
 AND CANNOT BE REUSED OR REPRODUCED WITHOUT
 WRITTEN CONSENT.

LEVEL	DATE	BY	REVISION
C	18/06/13	JDD	AS BUILT
B	02/05/13	JDD	FOR PRODUCTION
A-01	23/04/13	JDD	FOR REVIEW
A	28/03/13	JDD	FOR REVIEW

DWG. NO:	E349000-PM-009-50-042-0001	PROJECT NUMBER:	300106
TITLE:	SITE LAYOUT	SUPPLIER:	
CUSTOMER:	BAFFINLAND MARY RIVER	DRAWN BY:	JDD
		DATE:	28/03/13
		SHEET	7 OF 7