
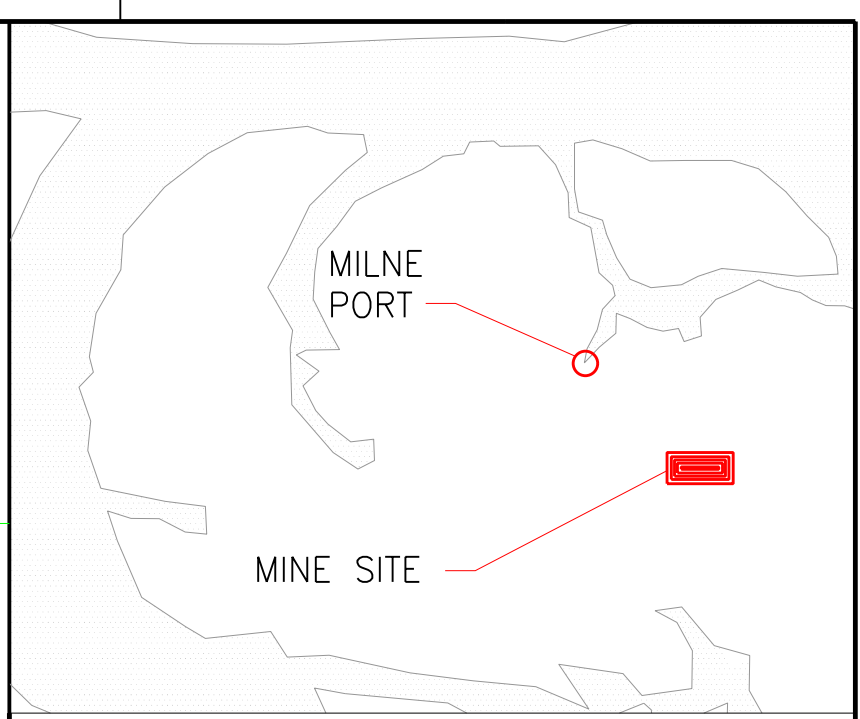


	Spill Contingency Plan	Issue Date: March 07, 2016 Revision: 2	
	Environment	Document #: BAF-PH1-830-P16-0036	

Appendix B - Emergency Spill Kit Supplies and Locations and Emergency Response Truck Inventory

The information contained herein is proprietary to Baffinland Iron Mines Corporation and is used solely for the purpose for which it is supplied. It shall not be disclosed in whole or in part, to any other party, without the express permission in writing by Baffinland Iron Mines Corporation.

Note: This is an UNCONTROLLED COPY. All staff members are responsible to ensure the latest revision is used.

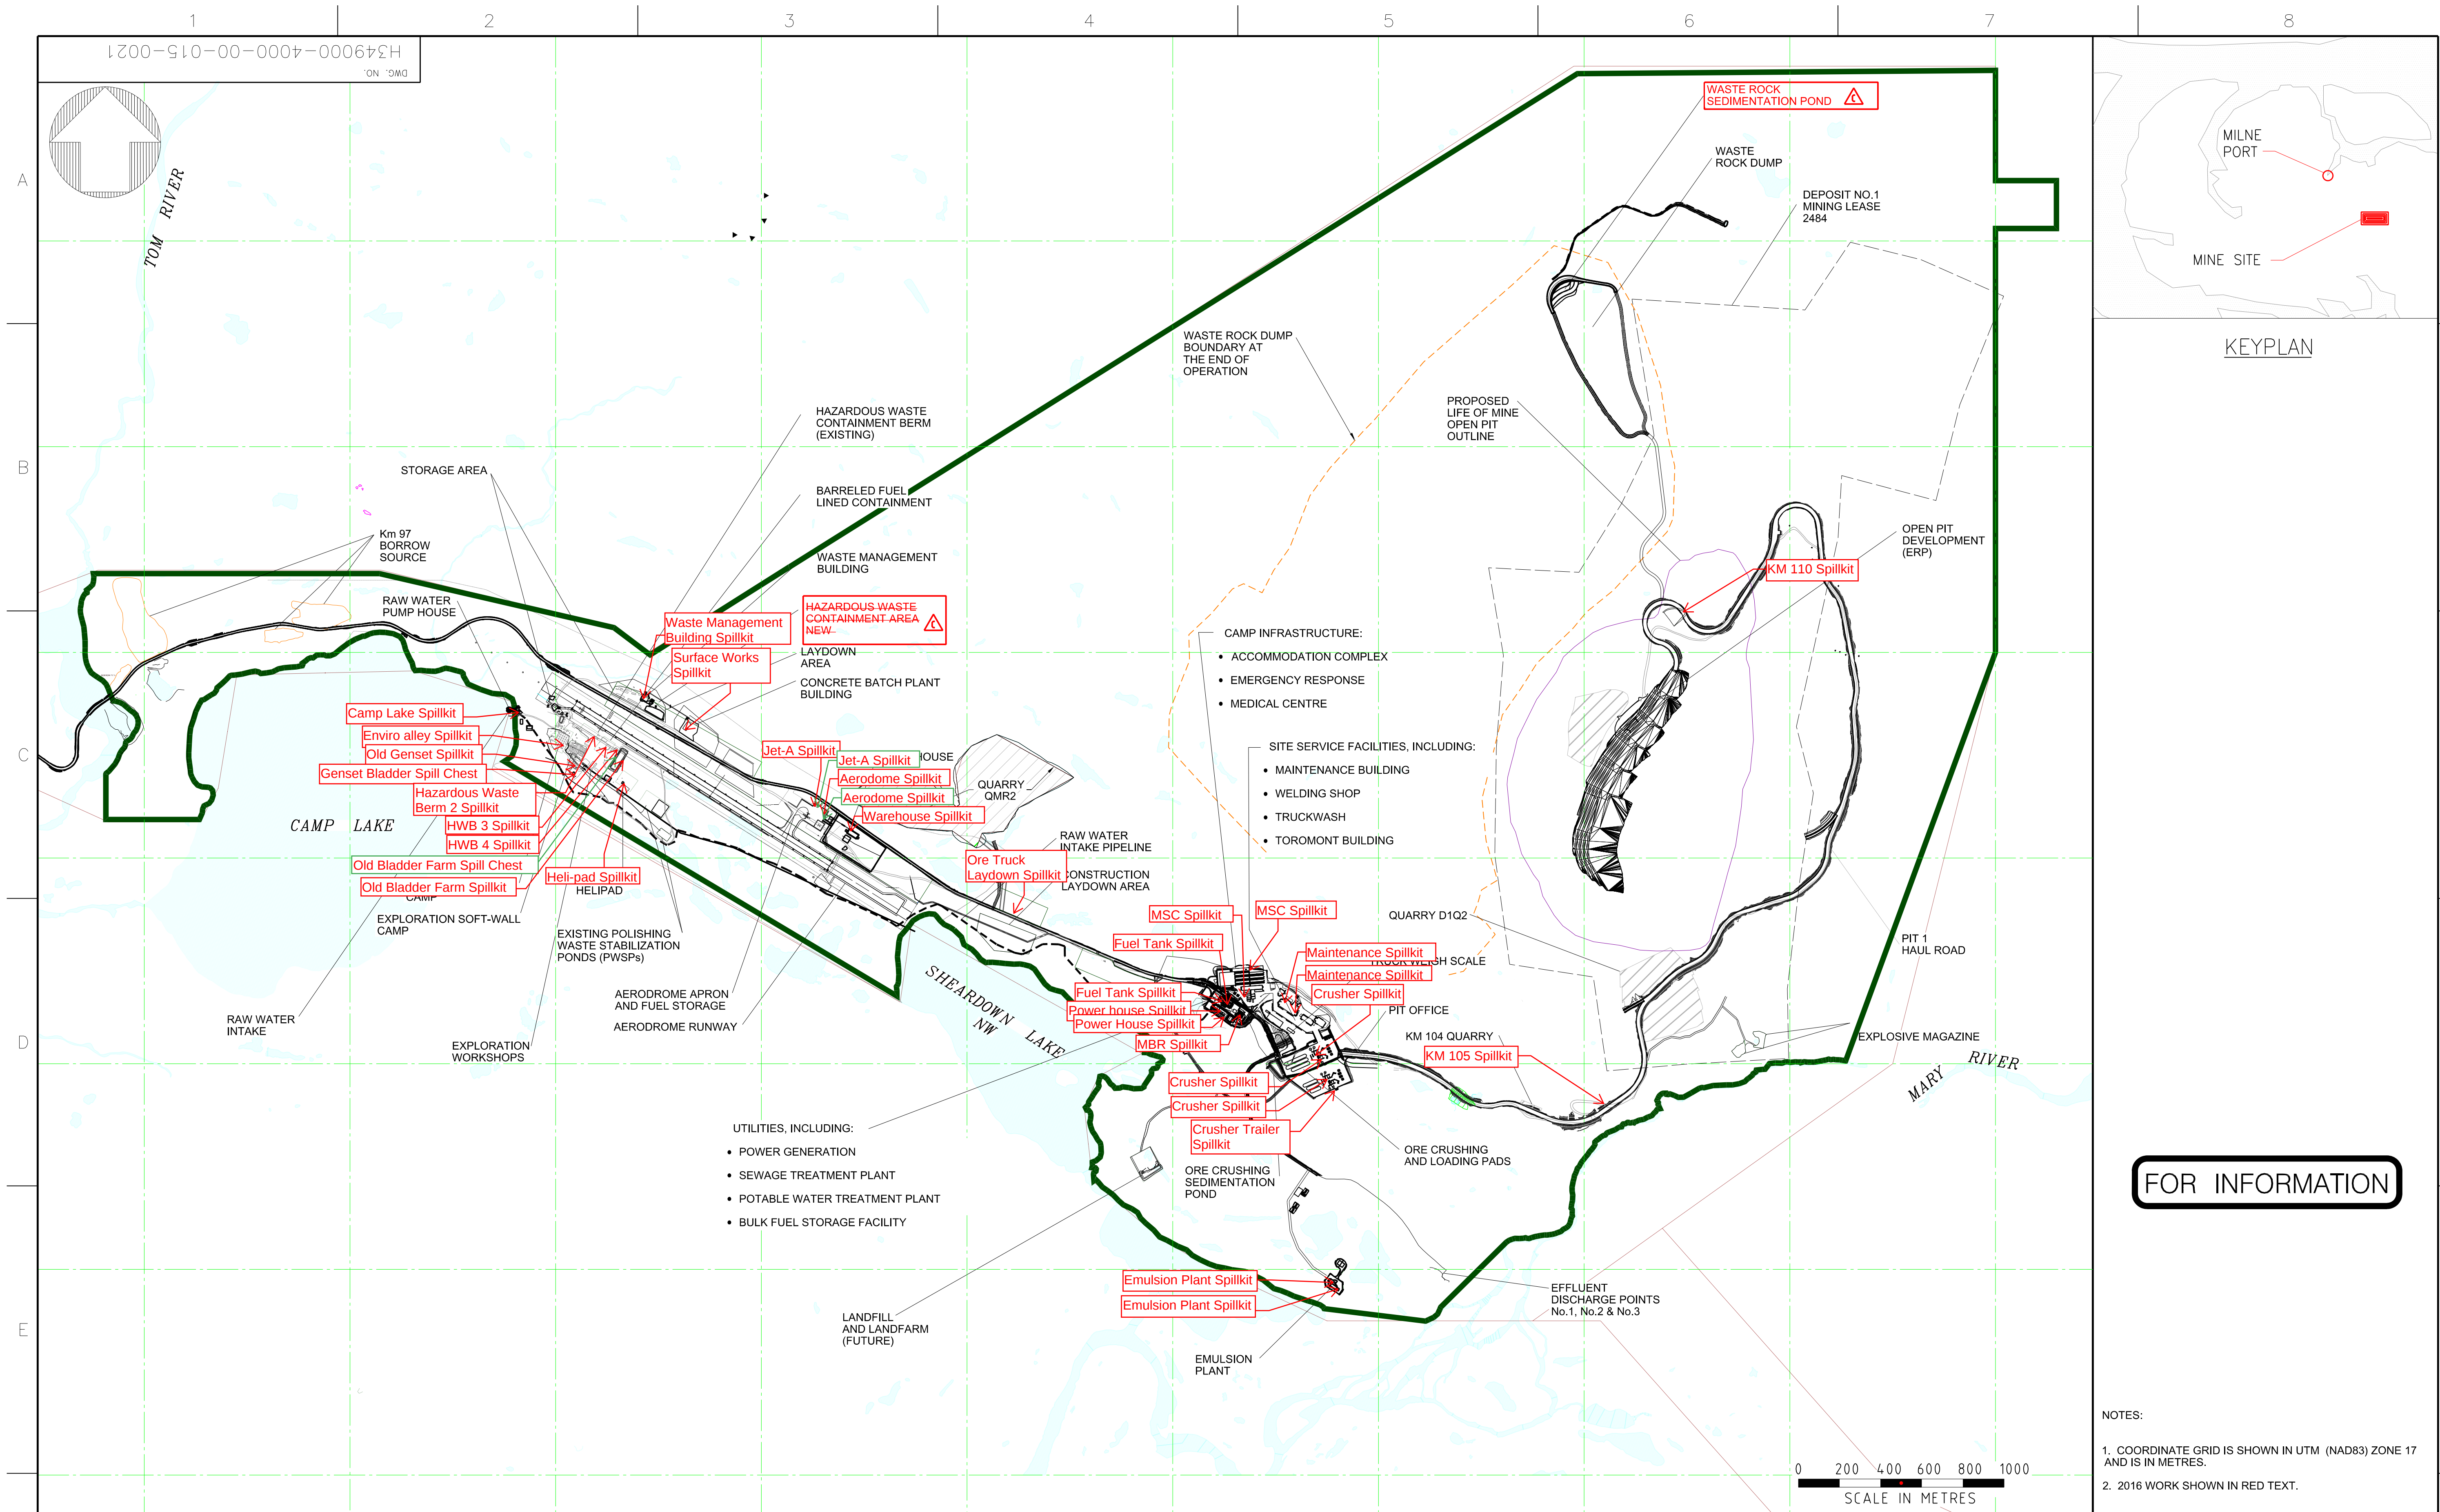

FOR INFORMATION

NOTES:
1. COORDINATE GRID IS SHOWN IN UTM (NAD83) ZONE 17 AND IS IN METRES.
2. 2016 WORK SHOWN IN RED TEXT.

LEGEND:

	WATER		BORROW AREA		RIVER/STREAM/DRAINAGE		COMMERCIAL LEASE
	QUARRY		ROAD		RAW WATER INTAKE PIPELINE		PROJECT DEVELOPMENT AREA

DESIGNED BY C. LEISTNER DATE 2014-10-21		DRAWN BY J. BAJAGIC DATE 2014-10-21	
CHECKED BY S. POTTER DATE 2014-10-21		DISCIP. ENGR. A. GRZEGORCZYK DATE 2014-10-21	
PROJ. DES. COORD. T. THERTELL DATE 2014-10-21		PROJ. ENGR. J. CLELAND DATE 2014-10-21	
PROJ. MGR. J. CLELAND DATE 2014-10-21		SCALE 1:15000 OR AS NOTED	
ISSUE AUTHORIZATION		DWG. NO. H349000-4000-00-015-0021	
REV. ISSUE FOR AUTH. BY DATE		ORIGINAL SHEET SIZE: ISO A1 (841 x 594)	
C	ISSUED FOR USE	M.B. J.B.	2015-10-15
B	ISSUED FOR USE	S.M. T.M.	2014-12-10
A	ISSUED FOR USE	C.L. A.G.	2014-10-31



HATCH

Baffinland

MARY RIVER PROJECT


MINE SITE
INFRASTRUCTURE FOOTPRINT
WORK PLAN 2016

00045702
3/20/2015 9:49:01 AM
c:\p\projectwise\ba045702\pw_idc_data\source\mrs88660\H349000-4000-00-015-0021.dgn

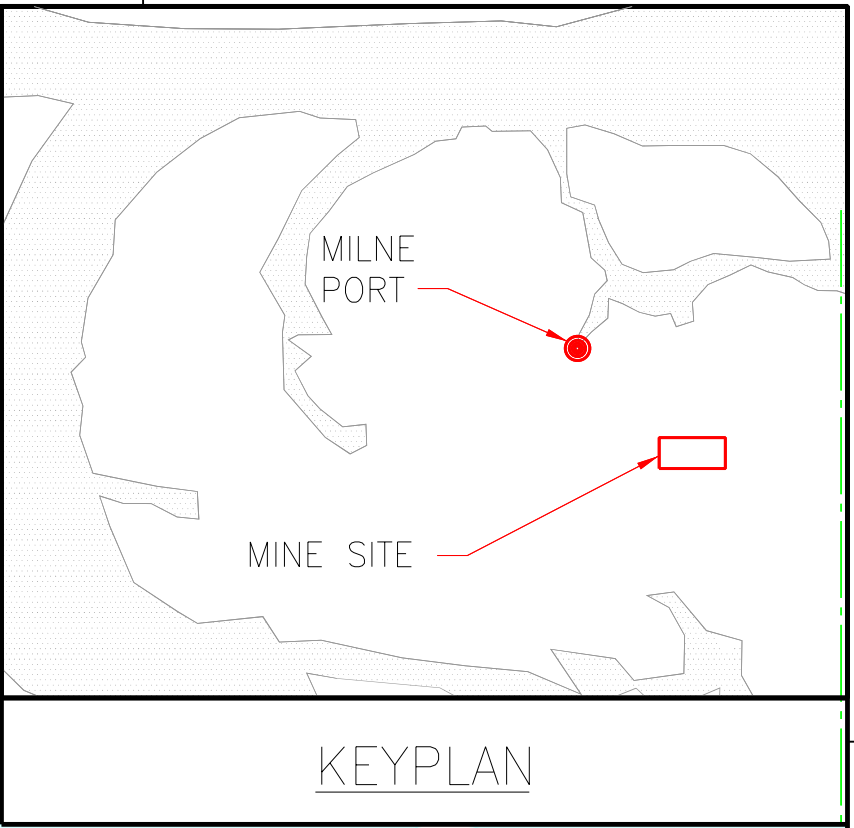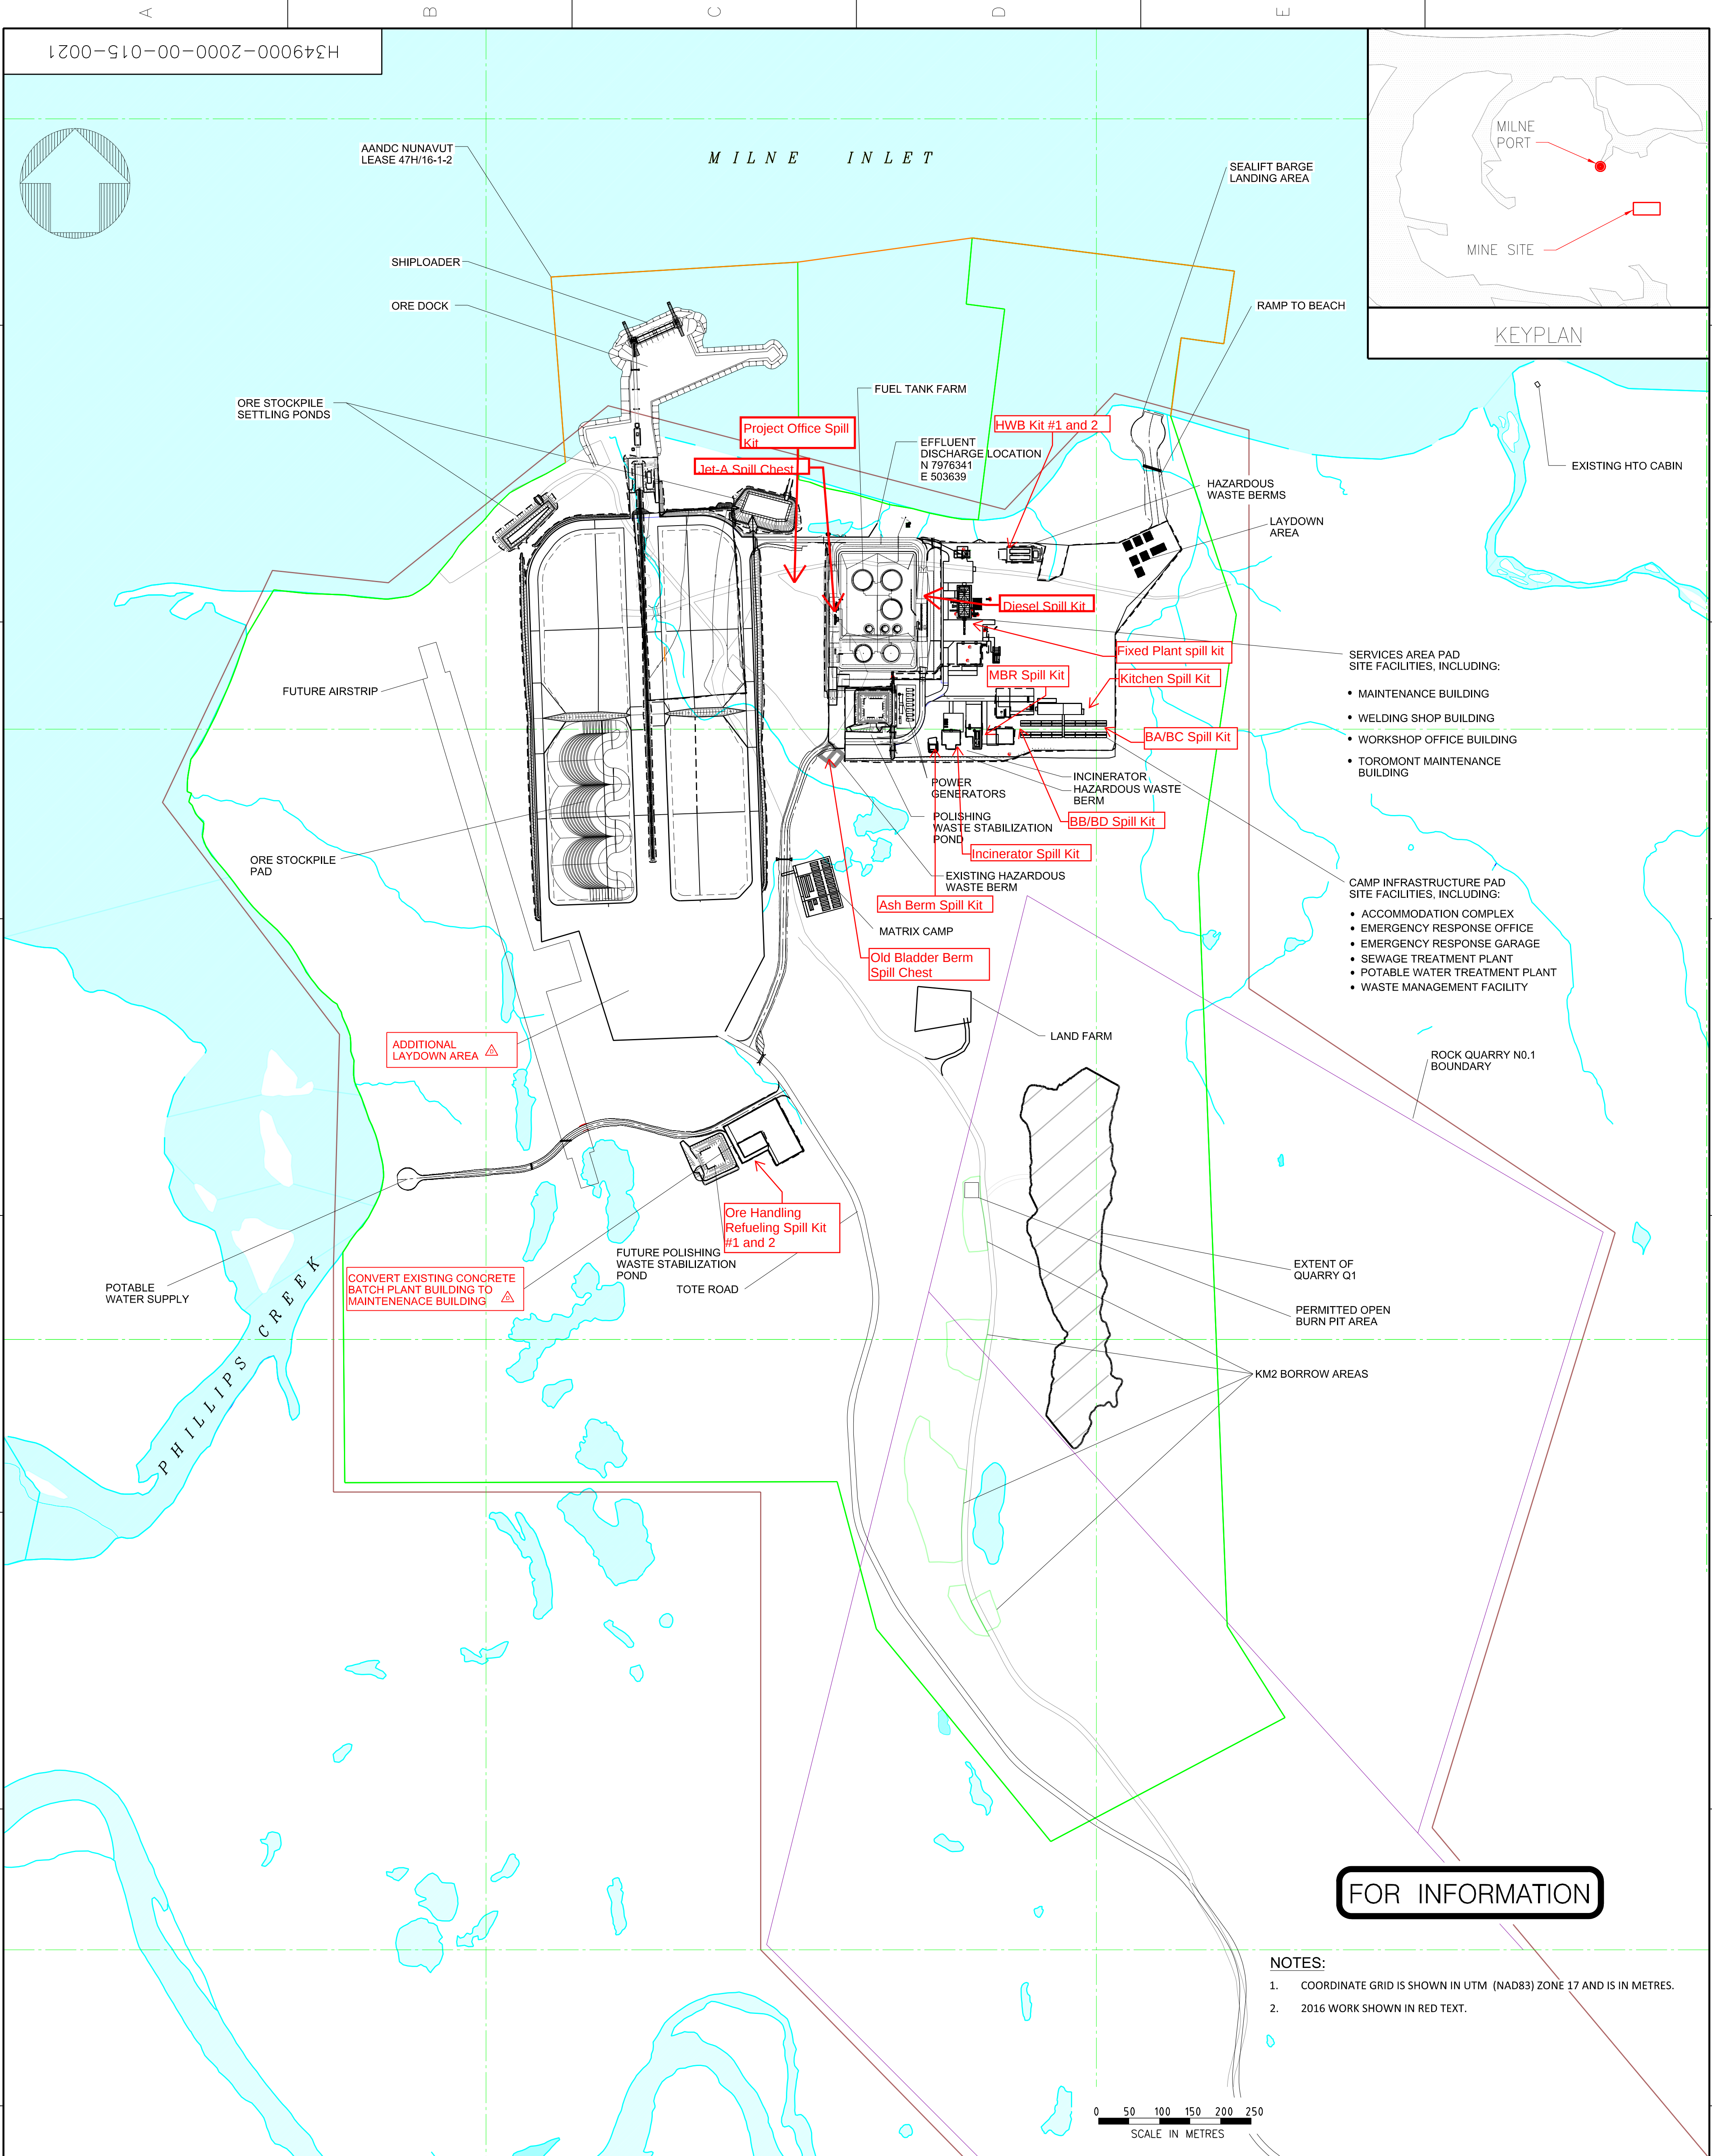

FOR INFORMATION

- NOTES:
- COORDINATE GRID IS SHOWN IN UTM (NAD83) ZONE 17 AND IS IN METRES.
 - 2016 WORK SHOWN IN RED TEXT.

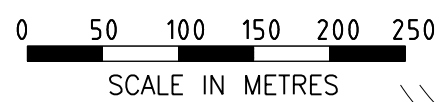

LEGEND:

	RIVER/STREAM/DRAINAGE
	ROAD
	PROJECT DEVELOPMENT AREA
	QUARRY
	BORROW AREAS
	COMMERCIAL LEASE
	AANDC LEASE 47H/16-1-2

DESIGNED BY C. LEISTNER DATE 2014-10-20		DRAWN BY J. BAJAGIC DATE 2014-10-20	
CHECKED BY S. POTTER DATE 2014-10-20		DISCIP. ENGR. A. GRZEGORCZYK DATE 2014-10-20	
PROJ. DES. COORD. T. THERTELL DATE 2014-10-20		PROJ. ENGR. J. CLELAND DATE 2014-06-19	
PROJ. MGR. J. CLELAND DATE 2014-06-19			
REV.	ISSUE FOR	AUTH. BY	DATE
D	ISSUED FOR USE	M.B. J.B.	2015-10-15
C	ISSUE FOR USE	S.M. T.M.	2014-12-10
B	ISSUE FOR USE	C.L. T.M.	2014-10-31
A	ISSUE FOR USE	C.L. A.G.	2014-06-19
ISSUE AUTHORIZATION			

MARY RIVER PROJECT	
MILNE PORT INFRASTRUCTURE FOOTPRINT WORK PLAN 2016	
SCALE 1:5000 OR AS NOTED	DWG. NO. H349000-2000-00-015-0021
REV. D	

APPENDIX B: MRT Emergency Response Truck

Right Side:



Left Side:

