





2" PERMEATE DISCHARGE

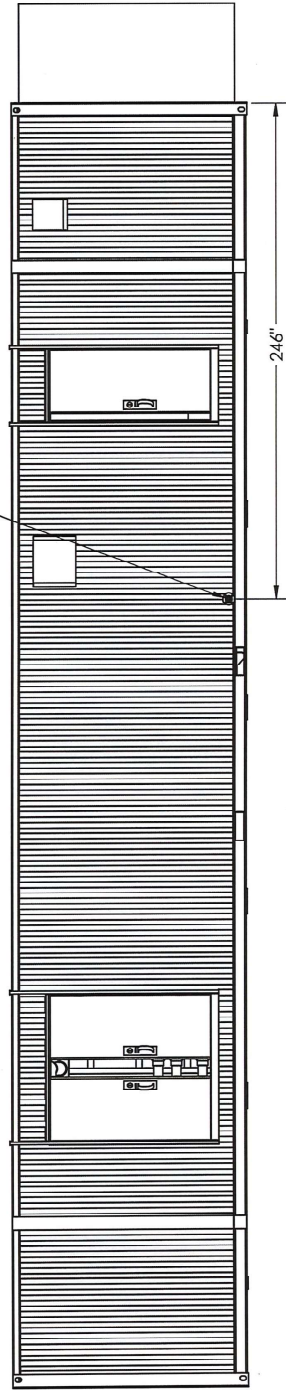


 GENERAL TOLERANCES XX ± 1/8" XX ± 1/16" XX ± 1/32" XX ± 1/64" UNLESS OTHERWISE SPECIFIED DIMENSIONS ARE IN INCHES THE INFORMATION IS THE PROPERTY OF NEWterra AND CANNOT BE REUSED OR REPRODUCED WITHOUT WRITTEN CONSENT.											DWG. NO:	1704432	PROJECT NUMBER		
											TITLE:	SYSTEM LAYOUT			
											CUSTOMER:	AGNICO EAGLE			
											DATE:	05/09/17			
											BY:	GH			
											REVISION:				
											LEVEL/DATE	BY REVISION			
											C1	11/28/17 AH AS BUILT			
											B1	07/06/17 GH FOR PRODUCTION			
											B	09/07/2017 GH FOR PRODUCTION			

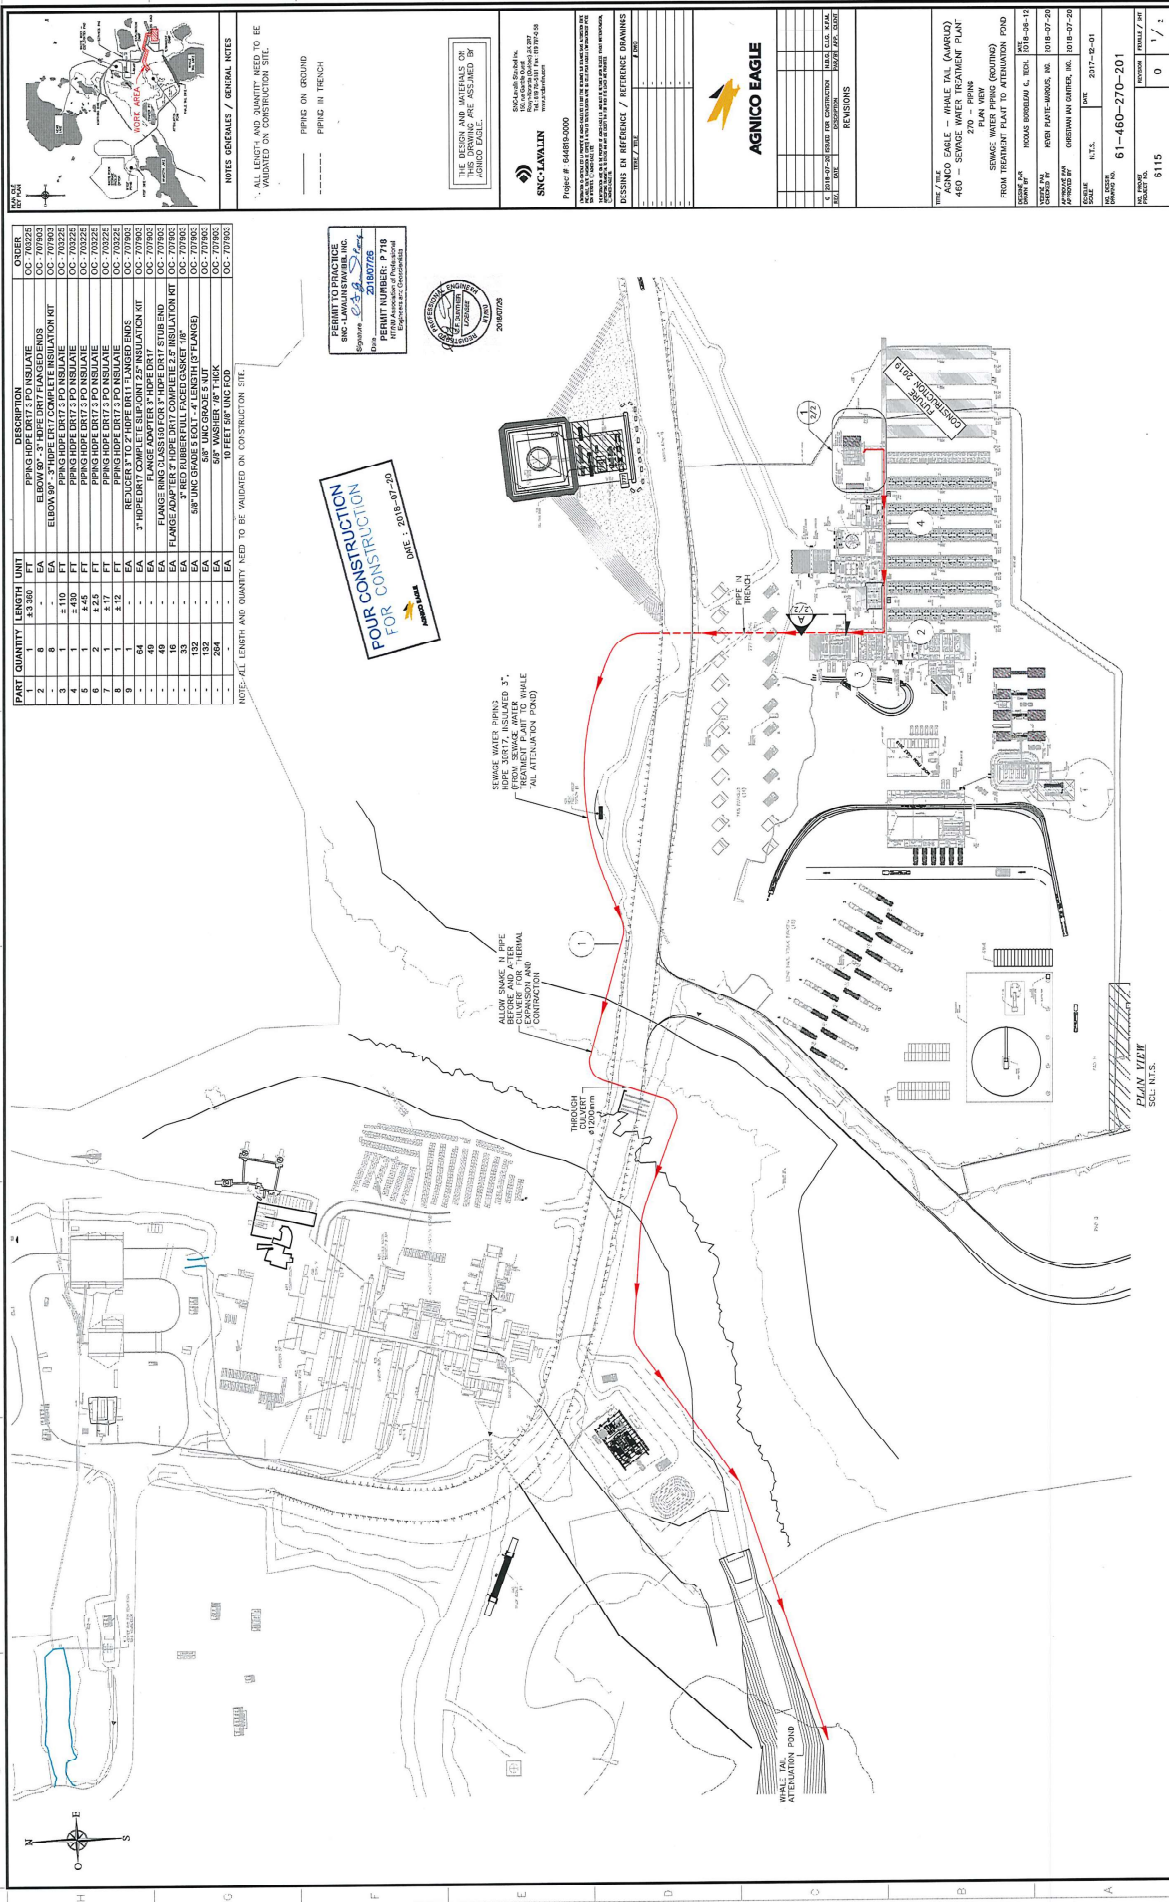

GRAND MULTIPLE / RESERVING GRILL

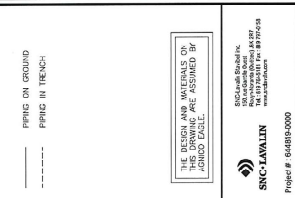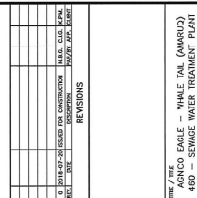[illegible]

270 - PIPING

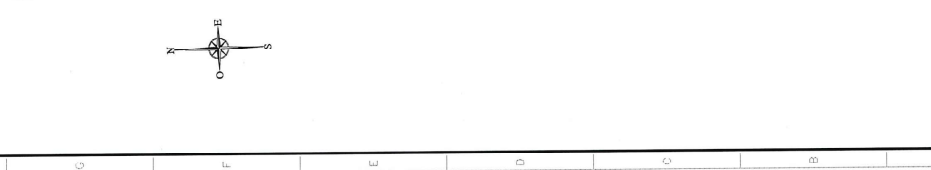

△

100

AC-CART-ARCH D