

APPENDIX

A DRAWINGS



APPENDIX

A-1 *DRAWINGS* *EXPLORATION ROAD*

H

G

F

E

D

C

B

A

H

G

F

E

D


C

B

A

LEGEND

PHASE #1:	SECTION 1 = 16.8 km	<u>VAULT TO ESKER #1 (CH:16+800)</u>
PHASE #2:	SECTION 2 = 8.2 km	<u>ESKER #1 TO ESKER #2 (CH:25+000)</u>
	SECTION 3 = 10 km	<u>ESKER #2 TO (CH:35+000)</u>
	SECTION 4 = 11 km	<u>35+000 TO ESKER #3 (CH:46+000)</u>
	SECTION 5 = 7.7 km	<u>ESKER #3 TO ESKER #4 (CH:53+700)</u>
	SECTION 6 = 6.1 km	<u>ESKER #4 TO ESKER #5 (CH:59+800)</u>
	SECTION 7 = 4.334 km	<u>ESKER #5 TO AMARUQ (CH:64+134)</u>
BRIDGES:	3.6km/DRAWING	#260-#261
	10.7km/DRAWING	#262-#263
	16.0km/DRAWING	#264-#265
	20.0km/DRAWING	#266-#267
	23.9km/DRAWING	#268-#269
	26.1km/DRAWING	#270-#271
	32.3km/DRAWING	#272-#273
	43.5km/DRAWING	#274-#275
	44.8km/DRAWING	#276-#277
QUARRY	SECTION 1 @ 7	

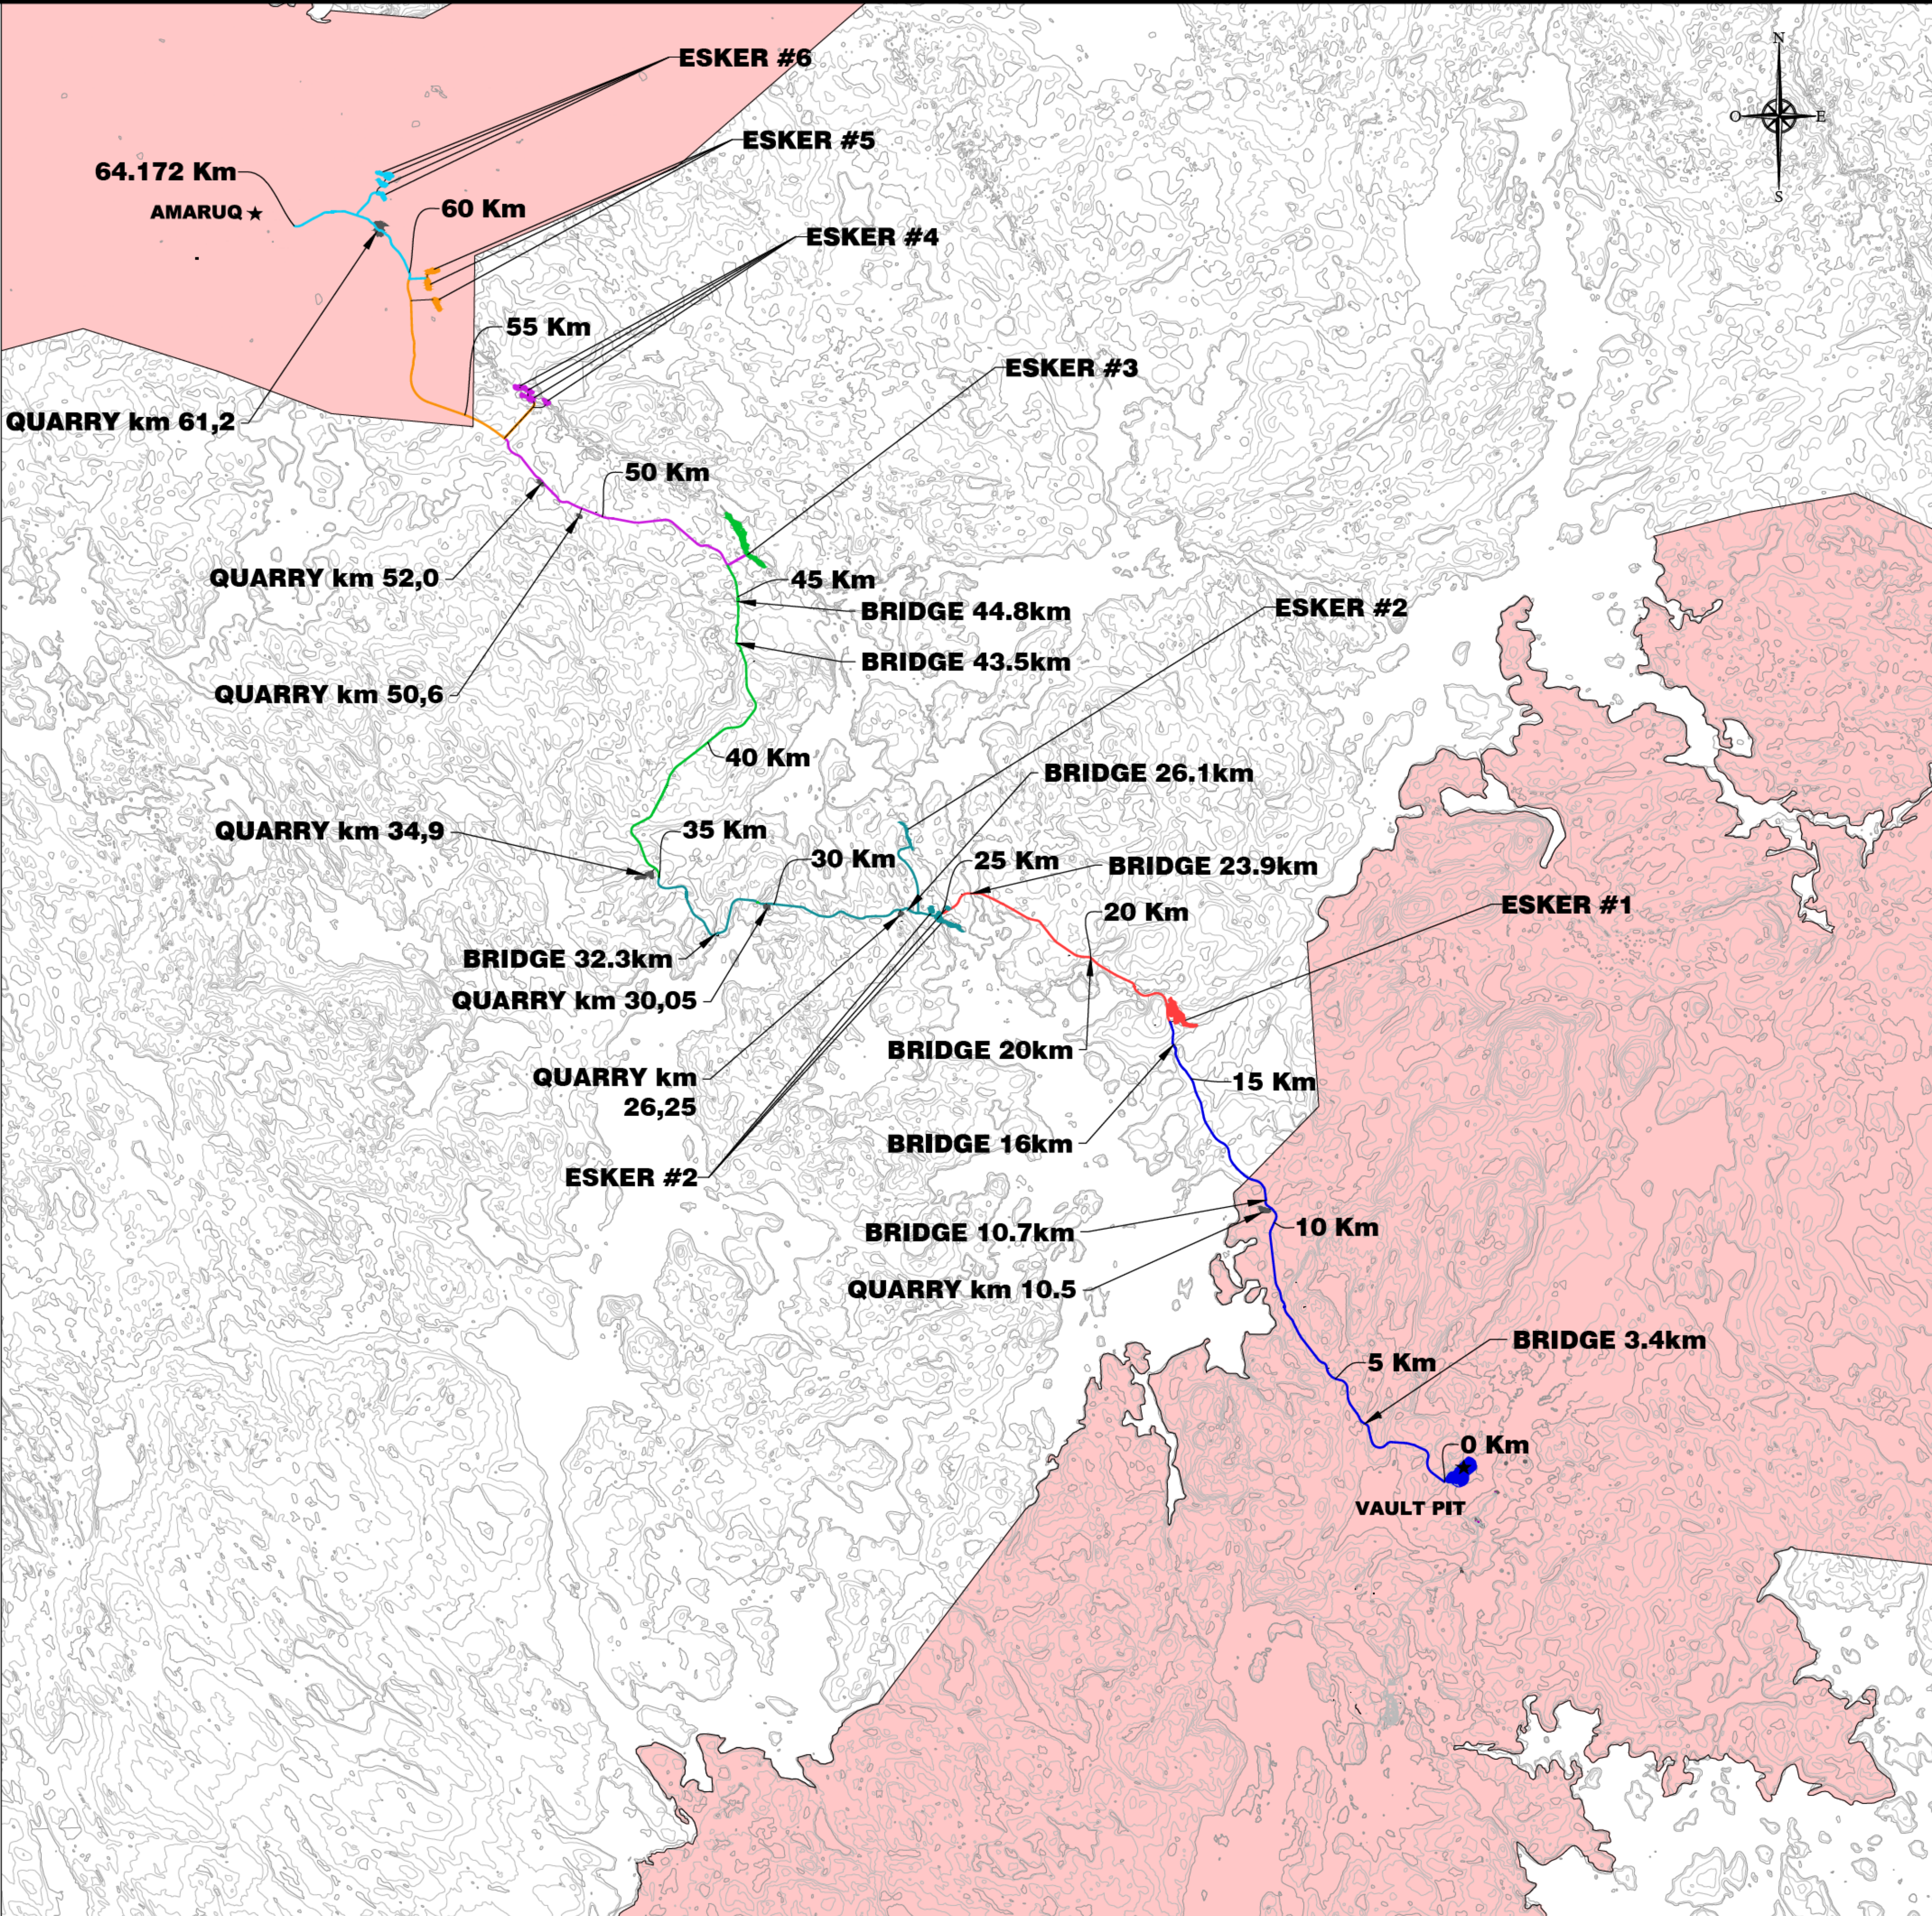

PLAN CLÉ
KEY PLAN



#141-21815-00

NOTE GÉNÉRALE / GENERAL NOTE

UTM ZONE 14 NAD 83 (CSRS)

LEGEND LIMIT	
INUIT OWNED LAND	



L'INFORMATION CONTENUE DANS CE DOCUMENT EST LA PROPRIÉTÉ DE AGNICO EAGLE LTD ET/OU D'UNE ENTREPRISE ASSOCIÉE. Toute réimpression, reproduction ou utilisation non autorisée est strictement interdite. Toute violation de ces droits de propriété intellectuelle sera poursuivie en justice. L'INFORMATION CONTAINED IN THIS DOCUMENT IS THE PROPERTY OF AGNICO EAGLE LTD. AND/OR OF AN ASSOCIATED COMPANY. Any reprinting, reproduction or unauthorized use is strictly prohibited. Any violation of these intellectual property rights will be prosecuted in court.

DESSINS EN RÉFÉRENCE / REFERENCE DRAWINGS

TITRE / TITLE	# DWG



O	2018/03/14	AS BUILT	S.D.	S.D.	J.B.
REV.	DATE	DESCRIPTION	PAR/EN	APP.	CLIENT

REVISIONS

AWR AMARUQ


TITRE / TITLE
AGNICO EAGLE — MEADOWBANK DIVISION
117—ROAD, YARDS, FENCES AND OTHER
230 EARTH WORK
PLAN
ROAD VAULT TO WHALE TAIL PROJECT



DESSINÉ PAR DRAWN BY	SYLVIE DUFOUR	DATE 2018/03/14
VÉRIFIÉ PAR CHECKED BY	ERIC TRUDEL, P.Eng.	2018/03/14
APPROUVÉ PAR APPROVED BY	STEPHAN DUPUIS, P.Eng.	2018/03/14

ÉCHELLE
SCALE: 1 : 100 000 DATE 2018/02/23

NO. DESSIN
DRAWING NO. 61-117-230-200

NO. PROJET PROJECT NO.	REVISION	FEUILLE / SHF
6103	0	1 / 1

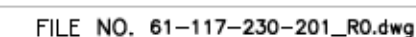

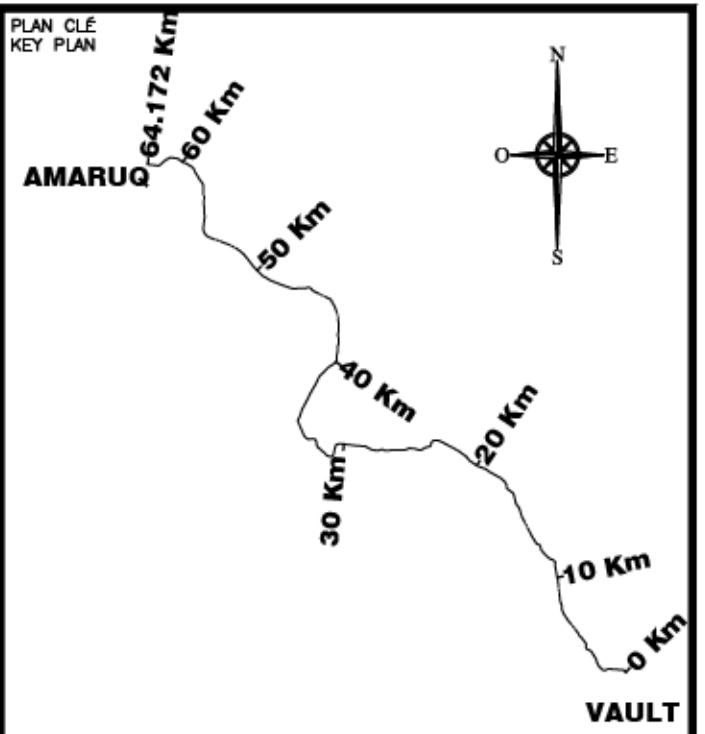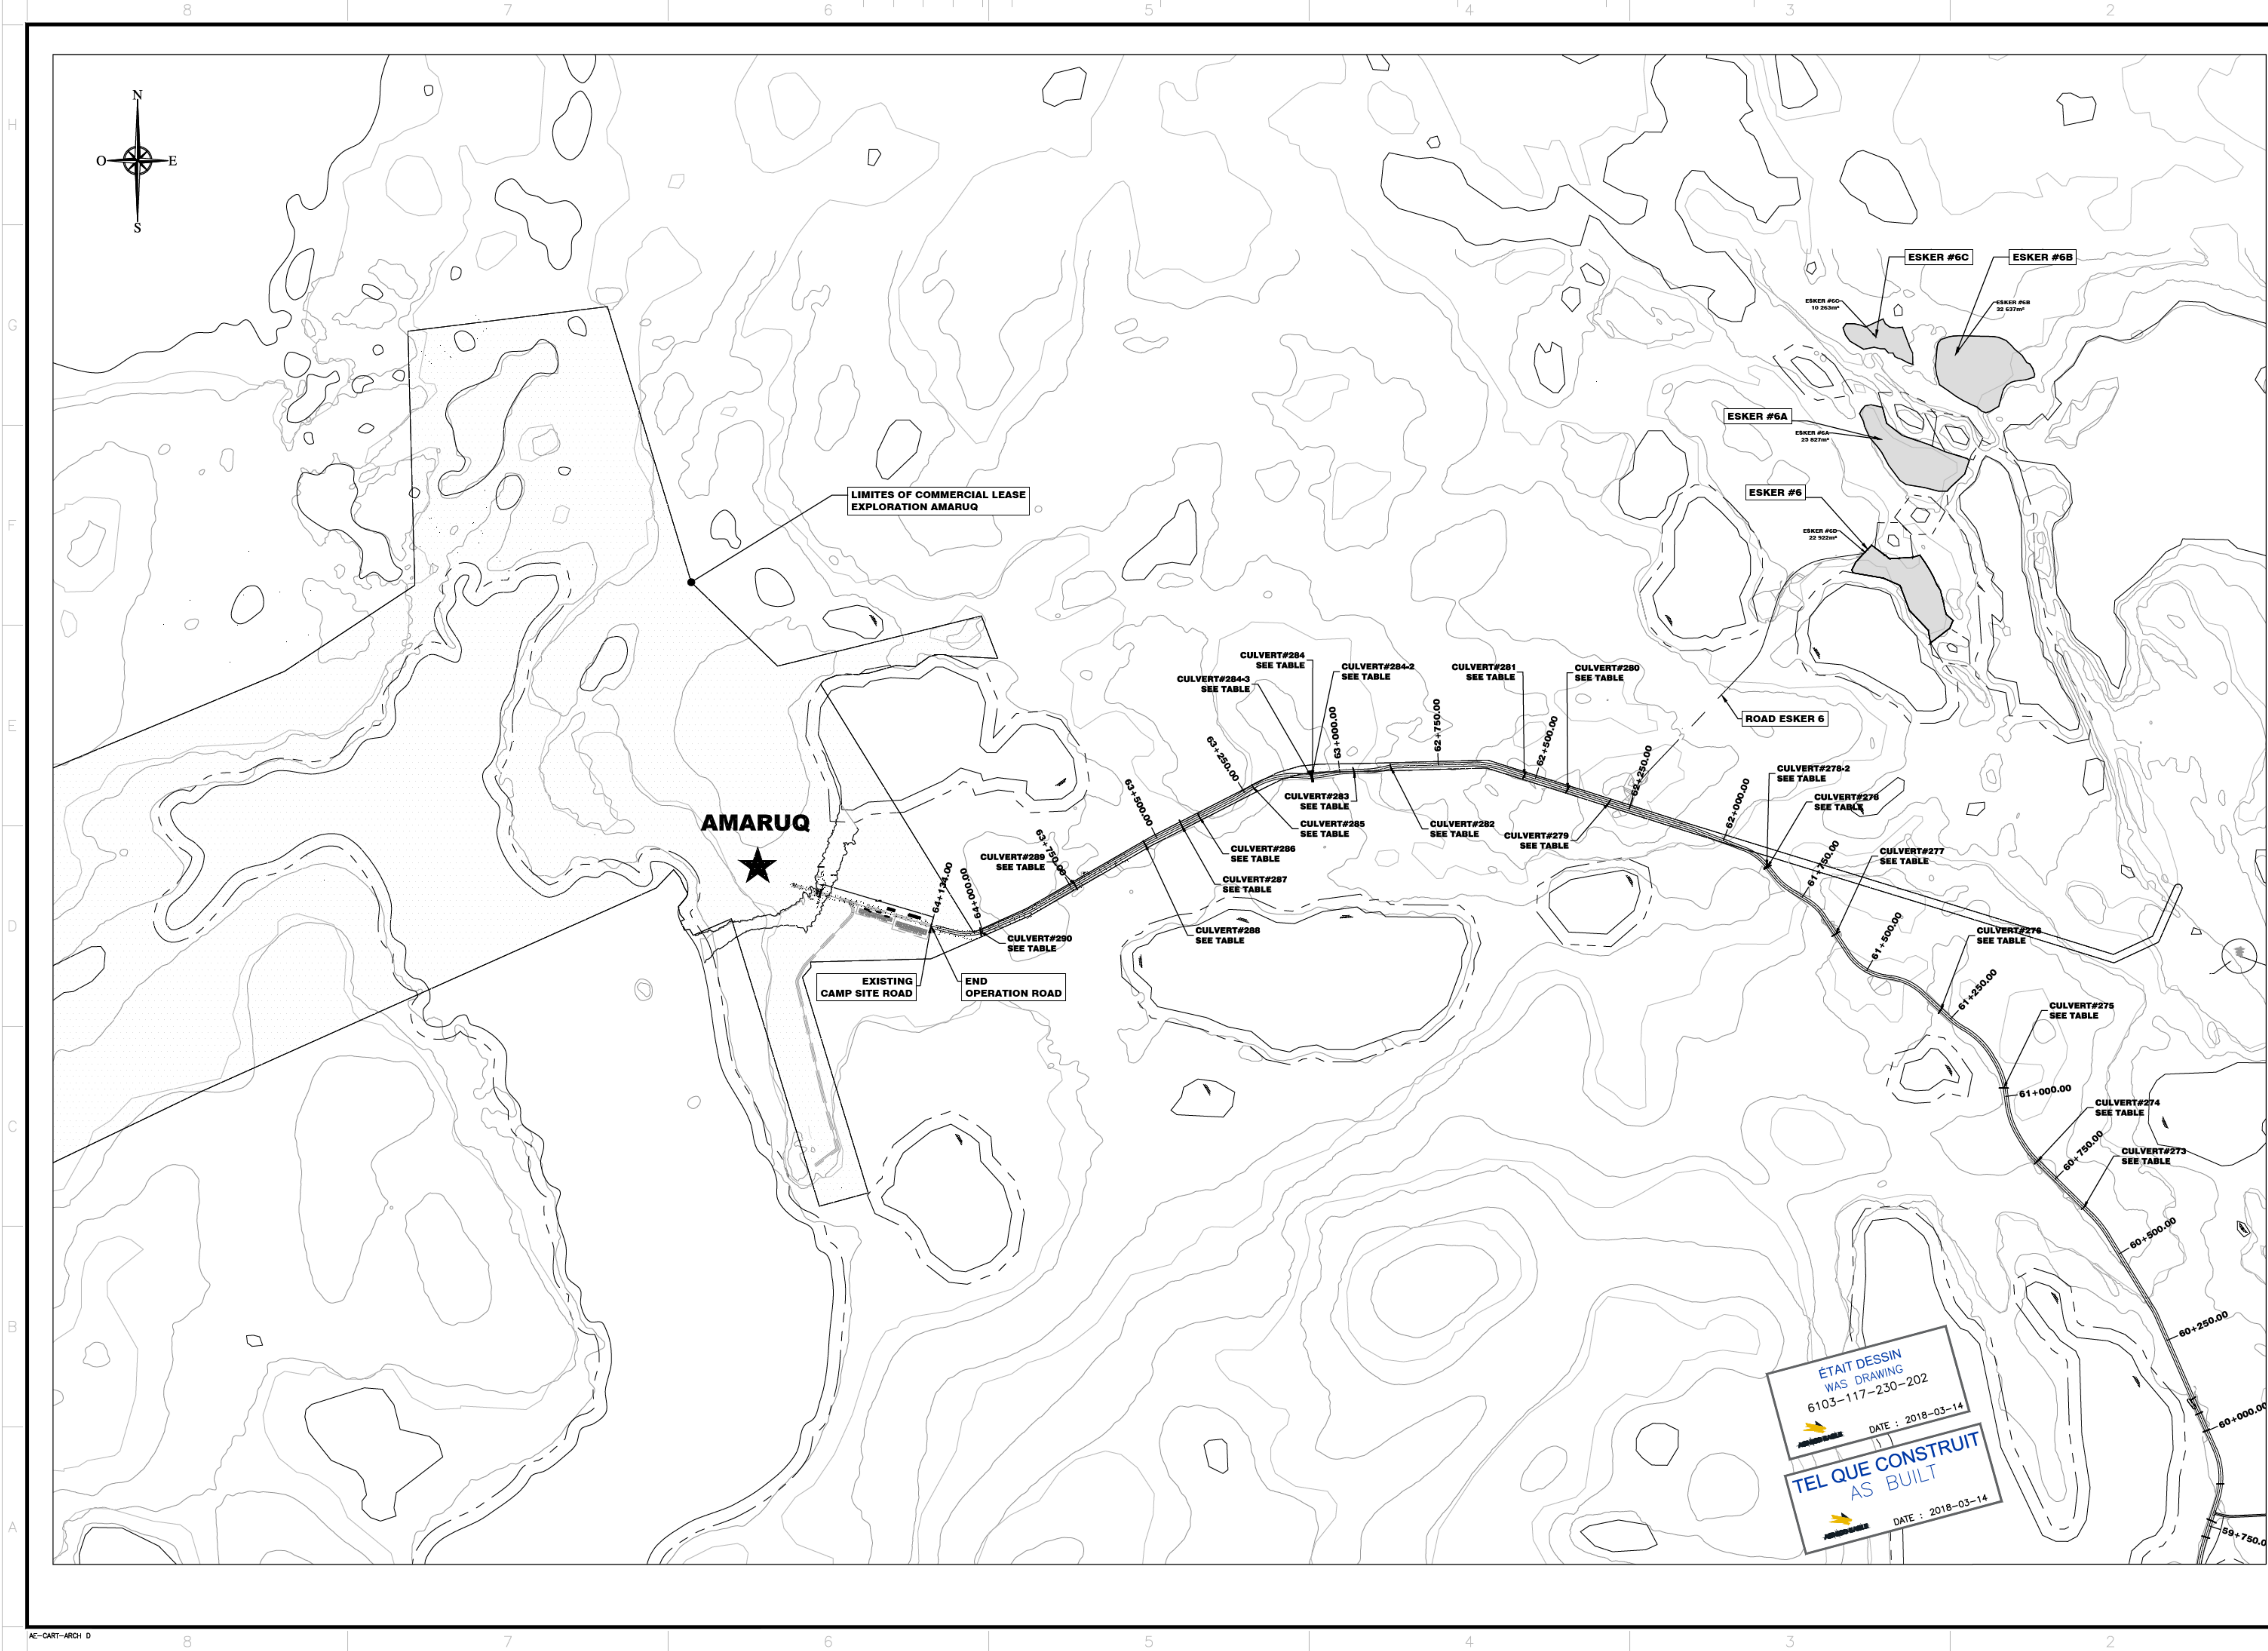

NOTE GÉNÉRALE / GENERAL NOTE
UTM ZONE 14 NAD 83 (CSRS)

LEGEND-PLAN

- TOP OF SLOPE OPERATION ROAD
- TOP OF SLOPE EXPLORATION ROAD
- TOE OF SLOPE OPERATION ROAD
- TOE OF SLOPE EXPLORATION ROAD
- CENTER LINE OPERATION ROAD
- CENTER LINE EXPLORATION ROAD
- CONTOUR
- OFFSET LAKE 31M
- LAKE

WSP

#141-21815-00

INFORMATION CONTAINED ON THIS DRAWING IS THE PROPERTY OF AGNICO EAGLE LTD. IT IS NOT TO BE REPRODUCED, COPIED, OR TRANSMITTED IN ANY FORM OR BY ANY MEANS, WITHOUT THE WRITTEN PERMISSION OF AGNICO EAGLE LTD. THIS DRAWING IS NOT TO BE USED FOR ANY OTHER PROJECT WITHOUT THE WRITTEN PERMISSION OF AGNICO EAGLE LTD.

DESSINS EN RÉFÉRENCE / REFERENCE DRAWINGS	
TITRE / TITLE	# DWG

AGNICO EAGLE

REV.	DATE	DESCRIPTION	PAR/EN	APP.	CLIENT
0	2018/03/14	AS BUILT	S.D.	S.D.	E.T.

REVISIONS	

TITRE / TITLE
AGNICO EAGLE - MEADOWBANK DIVISION
117-ROAD, YARDS, FENCES AND OTHER
230-GENERAL EARTH WORK
PLAN
WHALE TAIL CONNECTION VIEW

DESSINÉ PAR DRAWN BY SYLVIE DUFOUR	DATE 2018/03/14
VÉRIFIÉ PAR CHECKED BY ERIC TRUDEL, P.Eng.	2018/03/14
APPROUVÉ PAR APPROVED BY STEPHAN DUPUIS, P.Eng.	2018/03/14
ÉCHELLE SCALE 1 : 75000	DATE 2018/02/23

NO. DESSIN DRAWING NO. 61-117-230-202	REVISION FEUILLE / SHEET 0 / 1
---	--------------------------------------

ÉTAIT DESSIN
WAS DRAWING
6103-117-230-202
DATE : 2018-03-14

TEL QUE CONSTRUIT
AS BUILT
DATE : 2018-03-14

