




PLAN ESKER 6A, 6B, & 6C ÉCH : 1 :2000

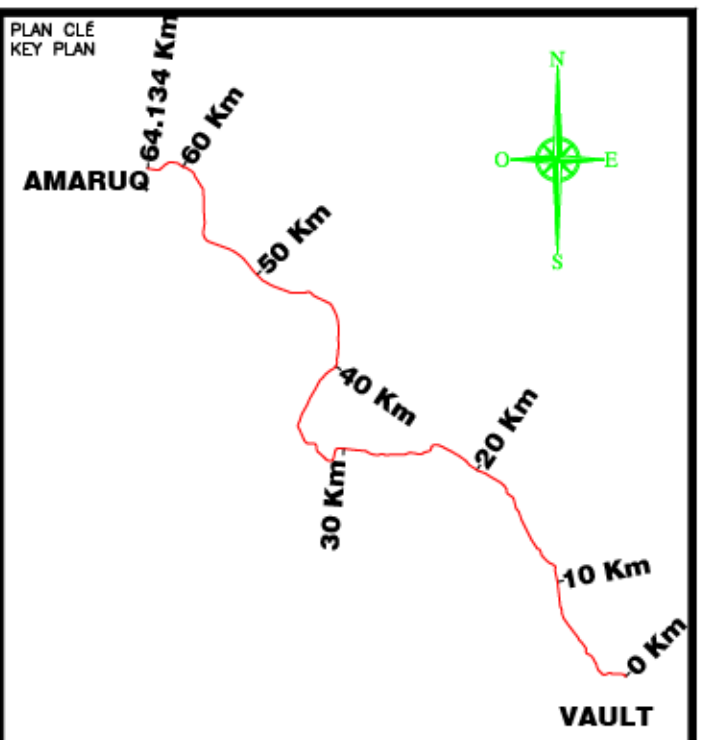

NOTE GÉNÉRALE / GENERAL NOTE

UTM ZONE 14 NAD 83 (CSRS)

LEGEND

ESKER AREA
31m SHORELINE PROTECTION ZONE



REF-WSP: 141-21815-00

INFORMATION IS CONTAINED HEREIN IS THE PROPERTY OF AGNICO EAGLE LTD. IT IS NOT TO BE REPRODUCED OR TRANSMITTED IN ANY FORM OR BY ANY MEANS, WITHOUT THE WRITTEN PERMISSION OF AGNICO EAGLE LTD.

DESIGNS EN RÉFÉRENCE / REFERENCE DRAWINGS

TITLE / TITRE	# DWG



REV.	DATE	DESCRIPTION	PAR/ÉTR.	APP.	CLIENT
0	2018/03/14	AS BUILT	S.D.	S.D.	E.T.

REVISIONS



TITLE / TITRE
AGNICO EAGLE - MEADOWBANK DIVISION
117-ROAD, YARDS, FENCES, AND OTHER
230-GENERAL EARTH WORK
ESKER

DESIGNÉ PAR DRAWN BY	SYLVIE DUFOUR.	DATE 2018/03/14
VÉRIFIÉ PAR CHECKED BY	ÉRIC TRUDEL, P. Eng.	2018/03/14
APPROUVÉ PAR APPROVED BY	STEPHAN DUPUIS, P.Eng.	2018/03/14

ÉCHELLE
SCALE INDICATED DATE 2014/07/07

NO. DESIGN
DRAWING NO. 61-117-230-209

NO. PROJET PROJECT NO.	REVISION	FEUILLE / SHEET
6103	0	1 / 1