


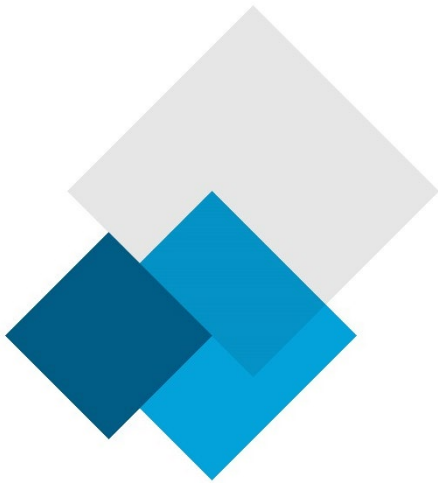

CONSTRUCTION SUMMARY REPORT

Whale Tail Dewatering Phase 2

Agnico Eagle Mines Ltd

Report

6127-648-132-REP-002_R2

February 3, 2021

Authorized Signatory:



2021-02-03

Israël Gagnon, P. Eng., MBA
Mechanical Engineer

EXECUTIVE SUMMARY

SNC-Lavalin Stavibel Inc. was retained by Agnico Eagle Mines Limited to prepare a construction summary (as built) report for dewatering phase pumping system at Amaruq site Whale Tail Gold Project, Nunavut. SNC Lavalin previously prepared the construction drawings and specifications as well as the design report for the Dewatering phase pumping system.

SNC-Lavalin Stavibel Inc. wasn't involved in the construction of the Dewatering phase pumping system, the information presented in this report was provided in part by Agnico Eagle.

The construction of the Dewatering phase pumping system was completed in September 2020. The construction monitoring and quality assurance was managed by Agnico Eagle.

This report summarizes the construction as-built information for the Dewatering phase pumping system.

Revision list

Revision			Pages revised	Comments
#	Par	Date		
0	IG/DB	December 2020	all	For internal review
1	IG	January 2021	all	Comments for approval
2	IG	February 2021	all	Final version

TABLE OF CONTENTS

1. Introduction	2
2. Construction Summary	2
2.1. Site location plan.....	2
2.2. Key personnel	3
2.3. Summary	3
2.4. Dewatering phase 2 Schedule	4
2.5. Mitigation	4
3. Drawings and photographs	4
4. Field decisions	5
5. Construction monitoring	7

Appendices

Appendix A	Final construction drawings
Appendix B	Dewatering phase construction pictures
Appendix C	As-built drawings
Appendix D	Mechanical completion
Appendix E	QA reports

1. Introduction

Agnico Eagle Mines Limited, Meadowbank Division (AEM) is developing the Whale Tail Project, a satellite deposit located on the Amaruq property (Kivalliq Region of Nunavut, Canada). The Whale Tail Project construction is ongoing and commercial production has started in the third quarter of 2019. To continue mining and milling, AEM is proposing to expand the Whale Tail Project by expanding the Whale Tail pit, developing another open pit called the IVR pit and including underground mining operations. As part of the expansion project, new water management and geotechnical infrastructure was put in place where required for surface water management.

Prior to the construction of these new infrastructure, several lakes must be dewatered first. This dewatering phase 2 pumping system construction summary report is submitted as per Water License 2AM-WTP1830, Part D, Item 16.

This report contains the final design and construction drawings, a summary of construction activities including photographic record before, during and after construction. The as-built drawings, detailed explanation of field decision to reflect any deviations from the original construction drawings/plans and how such deviations may affect performance of engineered structures, a discussion of the mitigation measures implemented during construction and its effectiveness are also presented.

2. Construction Summary

2.1. Site location plan

The Whale Tail Project is located in the Kivalliq Region of Nunavut (65°24'25" N, 96°41'50" W). The 99,878-hectare Amaruq property is located on Inuit-owned and federal crown land, approximately 55 km north of the Meadowbank mine. The Meadowbank mine is accessible from Baker Lake, located 70 kilometers to the south. The next figure presents the affected ponds location.



Figure 1 – ponds location

2.2. Key personnel

Company	Role	Responsibility	Key Personnel	Position
Agnico Eagle Mines Ltd	> Owner	> Manage construction activity > QC > Survey	Jessy Gauthier Alex Gélinas	Mechanical Resident
			Sylvain Chartier Serge Racicot	Construction general Supervisor
			Bruno Roy Marc-André Beaudet	Engineering Lead Construction Lead
Agnico Eagle Mines Ltd	> Owner	> QA during construction	Laurier Collette / Claude Gagné / Arnaud Poirier	Geotechnical Engineer / Water & Tailings Specialist / Intern
			Frederick Bolduc	Geotechnical Coordinator
			Yan Côté / Mark Morin	Engineering Superintendent / Engineering General Supervisor
SNC-Lavalin	> Designer	Provide Engineering Report & Construction > As-built	Dan Chen Anh-Long Nguyen	Engineers
ABF Artic Construction	> Contractor	> Carry out construction activity > Supervise work	Francois Caouette Alexandre Coulombe Pepin	Superintendent ABF

2.3. Summary

Dewatering phase 2 works took place from July 11th, 2020 to October 30th, 2020, with the end of pumping work. The following infrastructures (see appendix A for construction drawings) and equipment were installed for the dewatering phase:

- > Waterline 214 Installation, from lake A49 to Whale Tail Attenuation Pond;
- > An access road as well as two ramps for dewatering lakes A47-A, A47-B;
- > Waterline 200 installation, from lake A47 to line 114 at NE-Dike tie-in;
- > An access ramp to dewater lake A49-B;
- > An access road and ramps to dewater lakes A50, A51, as well as lake A-P21;
- > Waterline 210 installation, from Lake A53 to Whale Tail Attenuation Pond;
- > Repurposing Waterline 211 installed for freshet water management to pump water from Lake A53 to Whale Tail South;
- > Waterline 215 installation, to pump from A50 toward Lake A53;
- > Waterline 217 installation, to pump Lake A51 toward A53;
- > Waterline 219 installation, to pump Lake A50, A51 and AP-21 toward A53;
- > Waterline 222 installation, From Lake A-P21 to Lake A53;
- > Waterline, 206 installation from Lake A49A to Lake A47.

2.4. Dewatering phase 2 Schedule

Once lines were installed, pumping work followed this schedule:

Lake A49

- > Lake A49 was pumped to the Water Treatment Plant Attenuation pond using waterline 214 from August 23rd till September 5th.

Lake A49A

- > Lake A49A was pumped to lake A47 from September 10th to October 5th, using line 206.

Lake A47

- > Lake A47 was pumped to the Water Treatment Plant Attenuation pond from August 13th to October 27th, using waterline 200 and 114 (permanent line for Ph2 water management).

Pond A53

- > Pond A53 was pumped to Whale Tail South September 1st to September 14th, using Waterline 211. Then, pond A53 was pumped with Waterline 210 to the Water Treatment Plant Attenuation pond from September 15th to September 27th.

Pond A51

- > Pond A51 was pumped to pond A53 from September 13th to September 18th, using waterline 217 and 219.

Pond A50

- > Pond A50 was pumped to pond A53 from September 13th to September 17th, using waterline 215 and 219;

Pond AP21

- > Pond AP21 was called dry on September 17th, it was pumped to the A53 using waterline 222 and 219;

Pond A52

- > Water from Pond A52 evaporated early in the summer, no pumping was required.

2.5. Mitigation

To minimize TSS reporting to the lakes during access roads and pumping pads construction, ramp and pumping pad sections were built not to expand into lake or pond. In lieu, suction lines were extended to the deepest point, this way no ramp were to be built in the lakes or ponds.

No quarrying activities took place to build the access road. During dewatering, turbid water caused by construction activities was pumped to the WT Attenuation pond for treatment in the WTP. No water was used to manage dust emissions from construction activity.

3. Drawings and photographs

The dewatering phase 2 final construction drawings are available in the Appendix A, construction pictures are available in Appendix B. Appendix C present the dewatering system as-built drawings.

4. Field decisions

It was decided to change the dewatering operation strategy and move one pump from one lake to another rather than using multiple pumps at the same time. As a result, only one pump was installed (instead of three) and the pipe network and routing were simplified accordingly (no tee connections).

Jetty were not lengthened to access the deepest parts of all lakes, instead, the pump suction was lengthened. This was the case for lake A49, A50, A51, A-P21.

Jetty to lake A47-C was not built since the lake was dry by mid July.

The following table presents design changes log that took place during waterline construction of the dewatering pipe network. None of these changes had any impact on the performance of the dewatering system.

Table 1 Design changes log

DESIGN CHANGE LOG				PROJECT: PHASE 2 DEWATERING							
ID	DATE	SUBJECT	ITEM	LOCATION	DRAWING OR SPEC REF.	DESIGN	CHANGE	STATUS	BY	NOTES	
1	11/07/20	Line routing	Line 648-100-WFR-PC11-0214	A47 Area	61-648-270-202-R2	The line is on the side road 7 from A49 Lake to AP5 Road	Line going in the tundra and onto NE Dikes	Approved	AL	Diamond drill campaign, future work for the ring road in the area on the planned route. Staying North of road 7 is a better path to avoid conflict.	
4	18/07/20	Line connection	Lines 648-200-WFR-PC11-0215, -0217, -0218	A50 to A53	61-648-270-202-R2	"Tee" connections	"Flange-Unflange" type connections	Agreed "As is"	LC	Much simpler and consistent with planned dewatering operations	
3	18/07/20	Line diameter	Line 648-100-WFR-HOSE-0222	AP21 to A52	61-648-270-202-R2	4" flexible	8" HDPE	Agreed "As is"	LC	Approved, will get higher flow for quicker dewatering	
5	18/07/20	Line routing	Line 648-100-WFR-HOSE-0222	A52	61-648-270-202-R2	Discharge to A52	Flange directly onto 648-200-WFR-PC11-0219	Approved	LC	Much simpler and consitent with planned dewatering operations	
2	18/07/20	Line type & diameter	Line 648-100-WFR-PC11-0214	From A47 to NE Dike	61-648-270-202-R2	12" Mineflex hose	14" HDPE pipe with reducer to 12" Mineflex	Agreed "As is"	LC		
6	07/08/20	Line routing	Line 648-200-WRF-PC17-0200	A47-A49 area	61-648-270-202-R2	Pipe along road 7.	Line split in two components: 1) Line from A47B to line 0214 Mineflex tie-in on NE dike east leg. 2) Line from A49 going either straight to A47 in the tundra or on NE dike connecting to line 0214 mineflex tie-in	Agreed "As is"	LC		
7	07/08/20	Line routing	Line 648-100-WFR-HOSE-0204, Line 648-100-WFR-PC11-0202, Line 648-100-WFR-HOSE-0206	A47-A49 area	61-648-270-202-R2	Lines planned for minor water transfer	Lines canceled from construction mandate. Line already or soon to be installed by operations.	Agreed "As is"	LC		

5. Construction monitoring

The quality assurance and quality control (QA/QC) program put in place by AEM during the construction of the access road, the pumping pads and installation of the HDPE piping and pumps ensured the following:


- › NPAG rockfill material is properly assessed and identified for use in the construction of the access roads and pumping pads.
- › Ensure proper compaction of the rockfill and granular fill material.
- › Monitor the quantity of NPAG rockfill and granular fill used in the construction.
- › Provide as-built drawings for the access road and pumping pads, including final structural elevations.
- › Identify and place the appropriate diameter and HDPE DR rated pipeline at its proper location on site.
- › Verify qualifications of the field technician assembling the piping.
- › Provide as-built drawings for the piping and pump locations.
- › Identify and ensure that the appropriate diesel pumps are placed in the proper location on site. Ensure that adequate containment of diesel spills is in place.
- › Ensure the water quality monitoring program is in place to monitor TSS and water turbidity.

The deficiency log in Appendix D presents corrections made following lines inspection during the dewatering work. Weekly QA reports can be found in Appendix E, this appendix also include QC, POV and Mechanical completion documents.

Appendix A

Final construction drawings



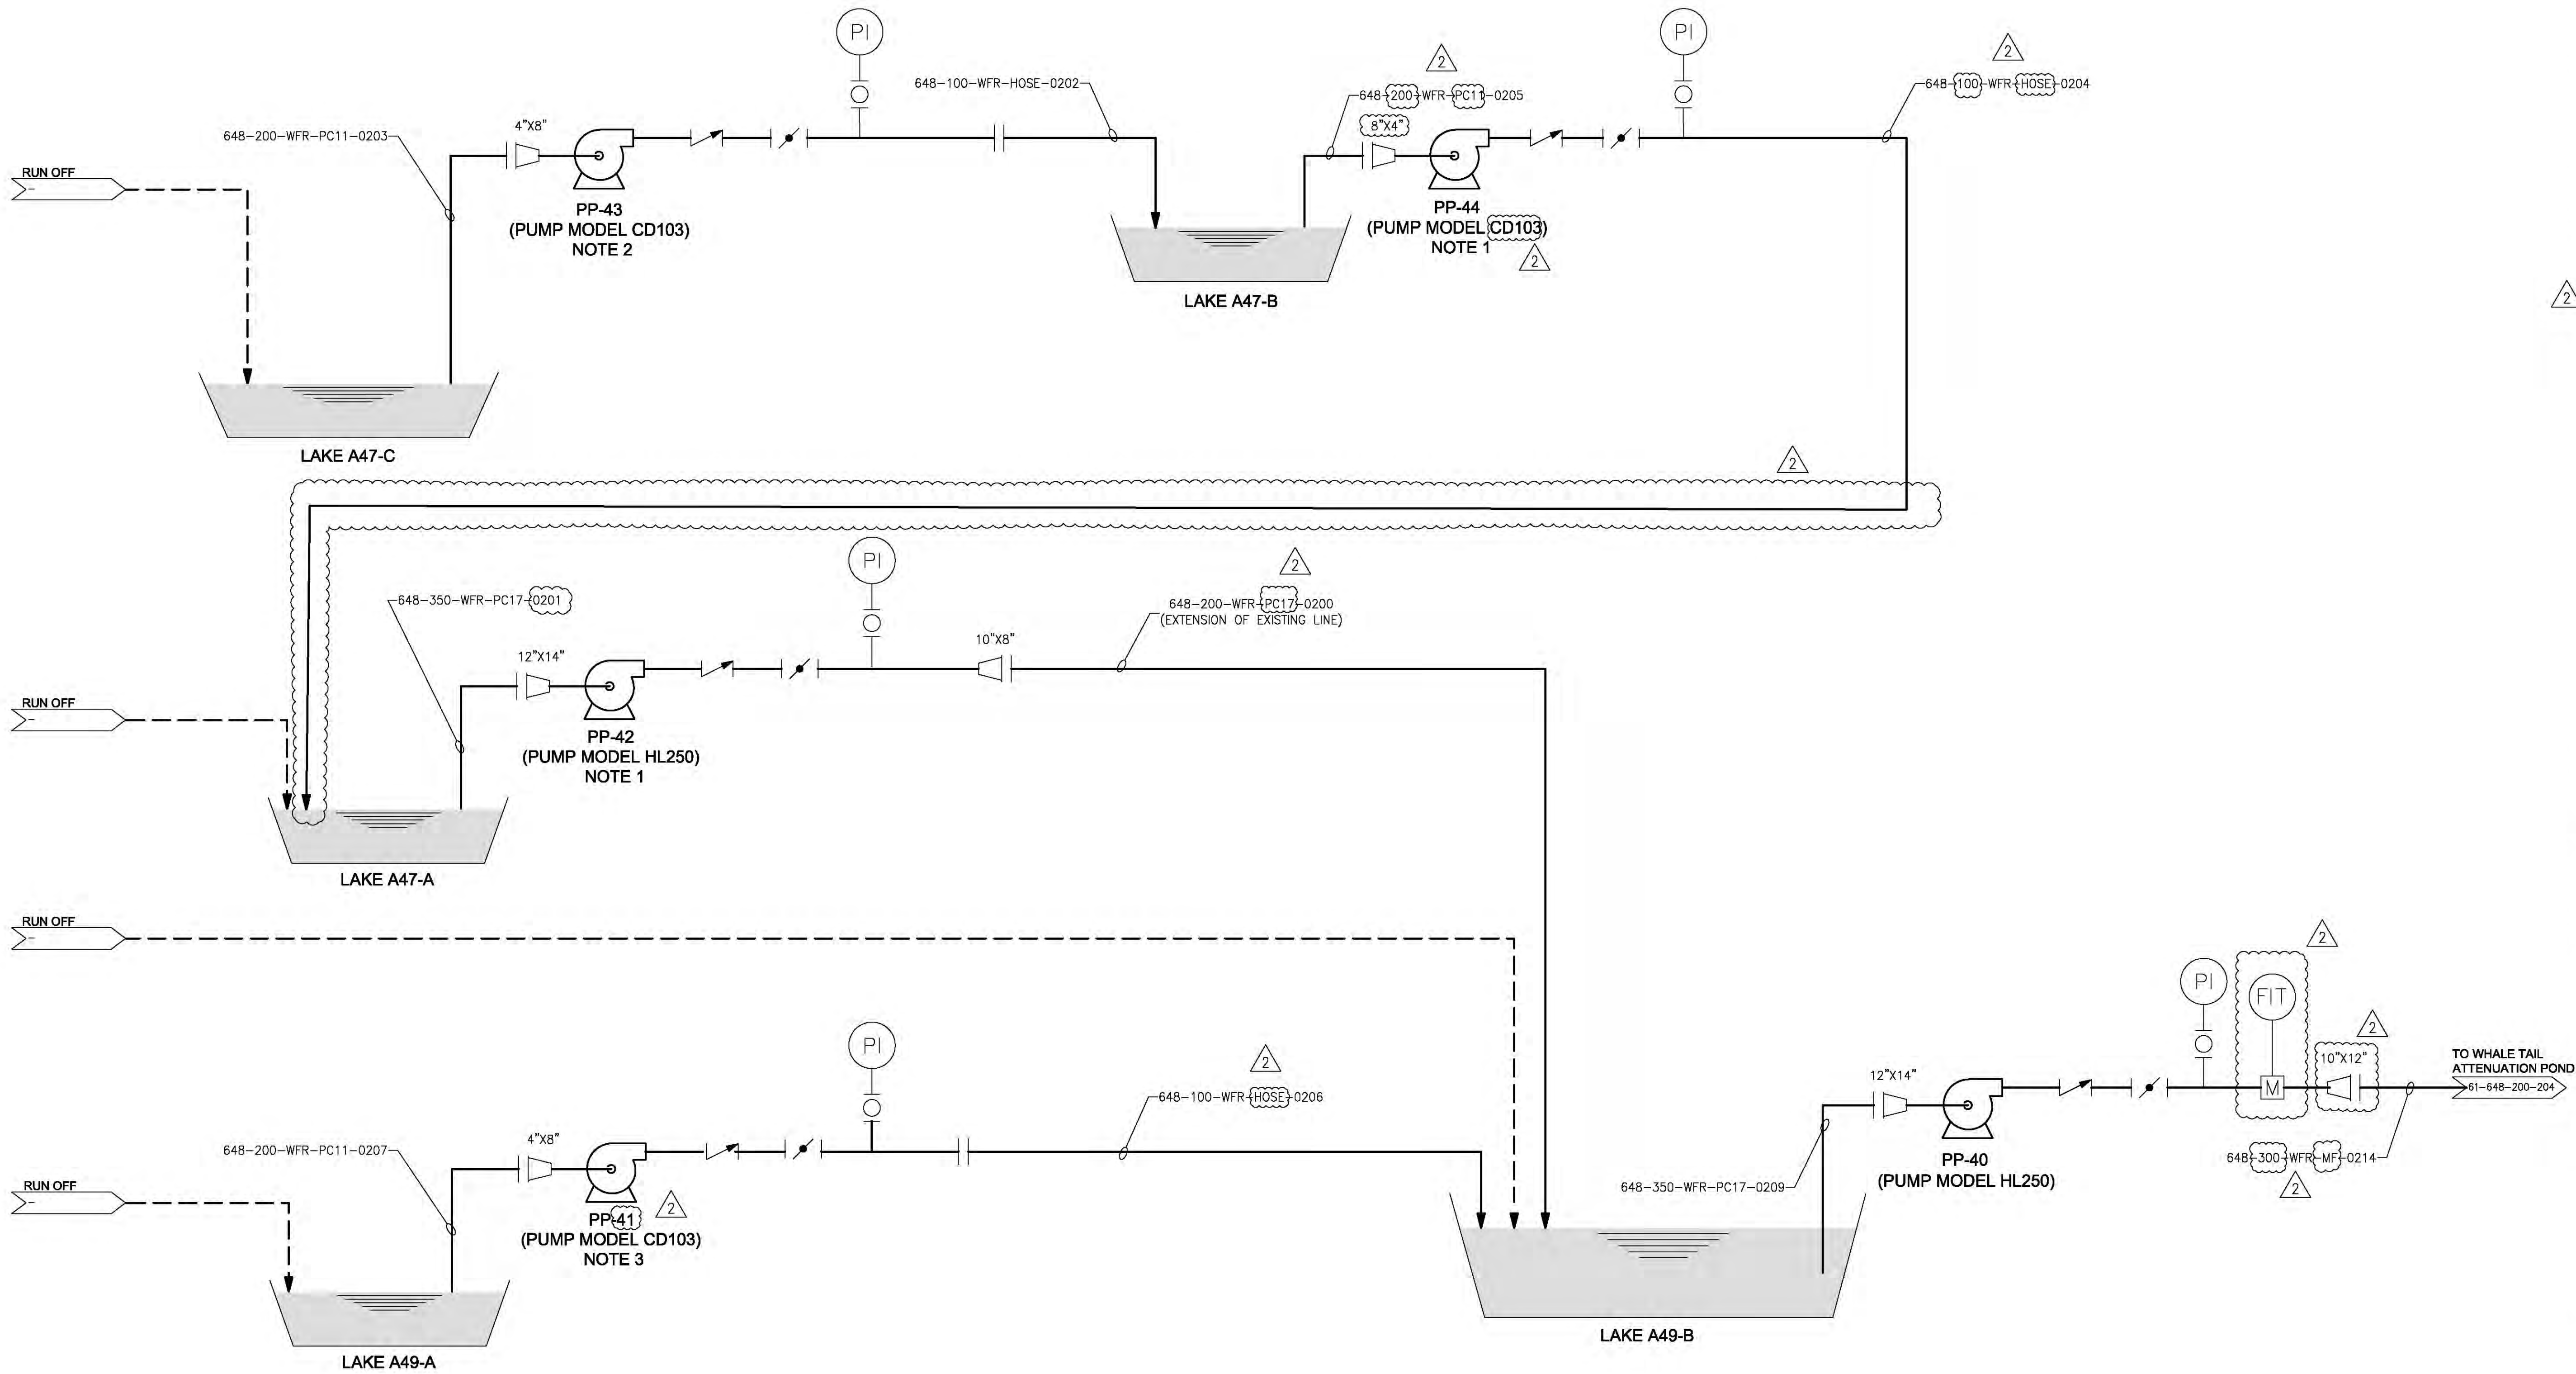

PLAN GLE
KEY PLAN

SNC-LAVALIN
Mining & Metallurgy
5500, des Galeries Blvd., bur. 200, Québec (Québec), Canada G2K 2E2
Telephone: (418) 621-5500, Fax: (418) 621-8887

PROJECT No	SUBDIVISION	SUBJECT	SERIAL	REV.
668284	8000	49, D1	0001	E02

NOTES GÉNÉRALES / GENERAL NOTES

- NOTES :
- DEPENDENT ON THE DEWATERING SEQUENCE, PUMP PP-44 COULD BE RE-USED FOR PUMP PP-43.
 - TO DEWATER LAKE A47-C, TWO CD103 PUMPS ARE REQUIRED TO PROVIDE A TOTAL DEWATERING FLOW RATE OVER 300 M3/H APPROX. TO ENSURE THAT IT OPERATES WITHIN ITS PUMP CURVE. ALTERNATIVELY, A TRASH PUMP COULD BE USED TO DEWATER THIS LAKE IF AVAILABLE.
 - DEWATERING OF LAKE A49-A SHALL OCCUR AFTER DEWATERING OF LAKE A47-C.

LEGEND:

- PRIMARY STREAM
--- INTERMITTENT STREAM
|| FLANGED CONNECTION

CHANGING A PERMIT OR LA PERMISSE EN AJOUTER UN AUTRE NE PEUT ÊTRE FAIT QUE PAR LE DÉTENTEUR DU PERMIS. TOUT CHANGEMENT DOIT ÊTRE NOTIFIÉ À L'AGNICO EAGLE. LE PERMIS NE PEUT ÊTRE MODIFIÉ QUE PAR LE DÉTENTEUR DU PERMIS. TOUT CHANGEMENT DOIT ÊTRE NOTIFIÉ À L'AGNICO EAGLE. LE PERMIS NE PEUT ÊTRE MODIFIÉ QUE PAR LE DÉTENTEUR DU PERMIS. TOUT CHANGEMENT DOIT ÊTRE NOTIFIÉ À L'AGNICO EAGLE.


DESSINS EN RÉFÉRENCE / REFERENCE DRAWINGS

TITLE / TITRE	# DWG



REV.	DATE	DESCRIPTION	ENG/APP.	CLIENT
R2	2020-07-08	ISSUED FOR DESIGN	D.C.	A.L.N.
R1	2020-05-15	ISSUED FOR DESIGN	D.C.	A.L.N.
R0	2020-03-20	ISSUED FOR DESIGN	D.C.	A.L.N.
R0	2020-03-16	ISSUED FOR CLIENT COMMENTS	D.C.	A.L.N.
R0	2020-03-02	ISSUED FOR COMMENTS	D.C.	A.L.N.

REVISIONS

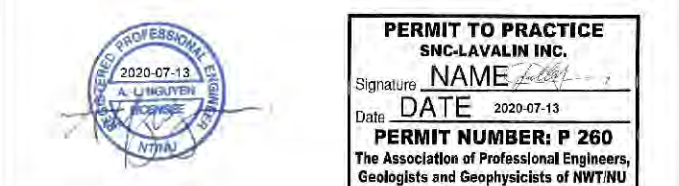

TITLE / TITRE
AGNICO EAGLE - AMARUQ DIVISION
648 - DEWATERING


200 - PROCESS FLOWSHEET
AMARUQ DEWATERING PHASE
LAKES A47 & A49

DESSINÉ PAR DRAWN BY	M. MOVILA	DATE 2020-03-02
VÉRIFIÉ PAR CHECKED BY	D. CHEN	2020-03-02
APPROUVÉ PAR APPROVED BY	A.L. NGUYEN	2020-03-02

ÉCHELLE
SCALE

NO. DESIGN
DRAWING NO. 61-648-200-202

NO. PROJECT PROJECT NO.	REVISION	FEUILLE / SHEET
6127	R2	1 / 1

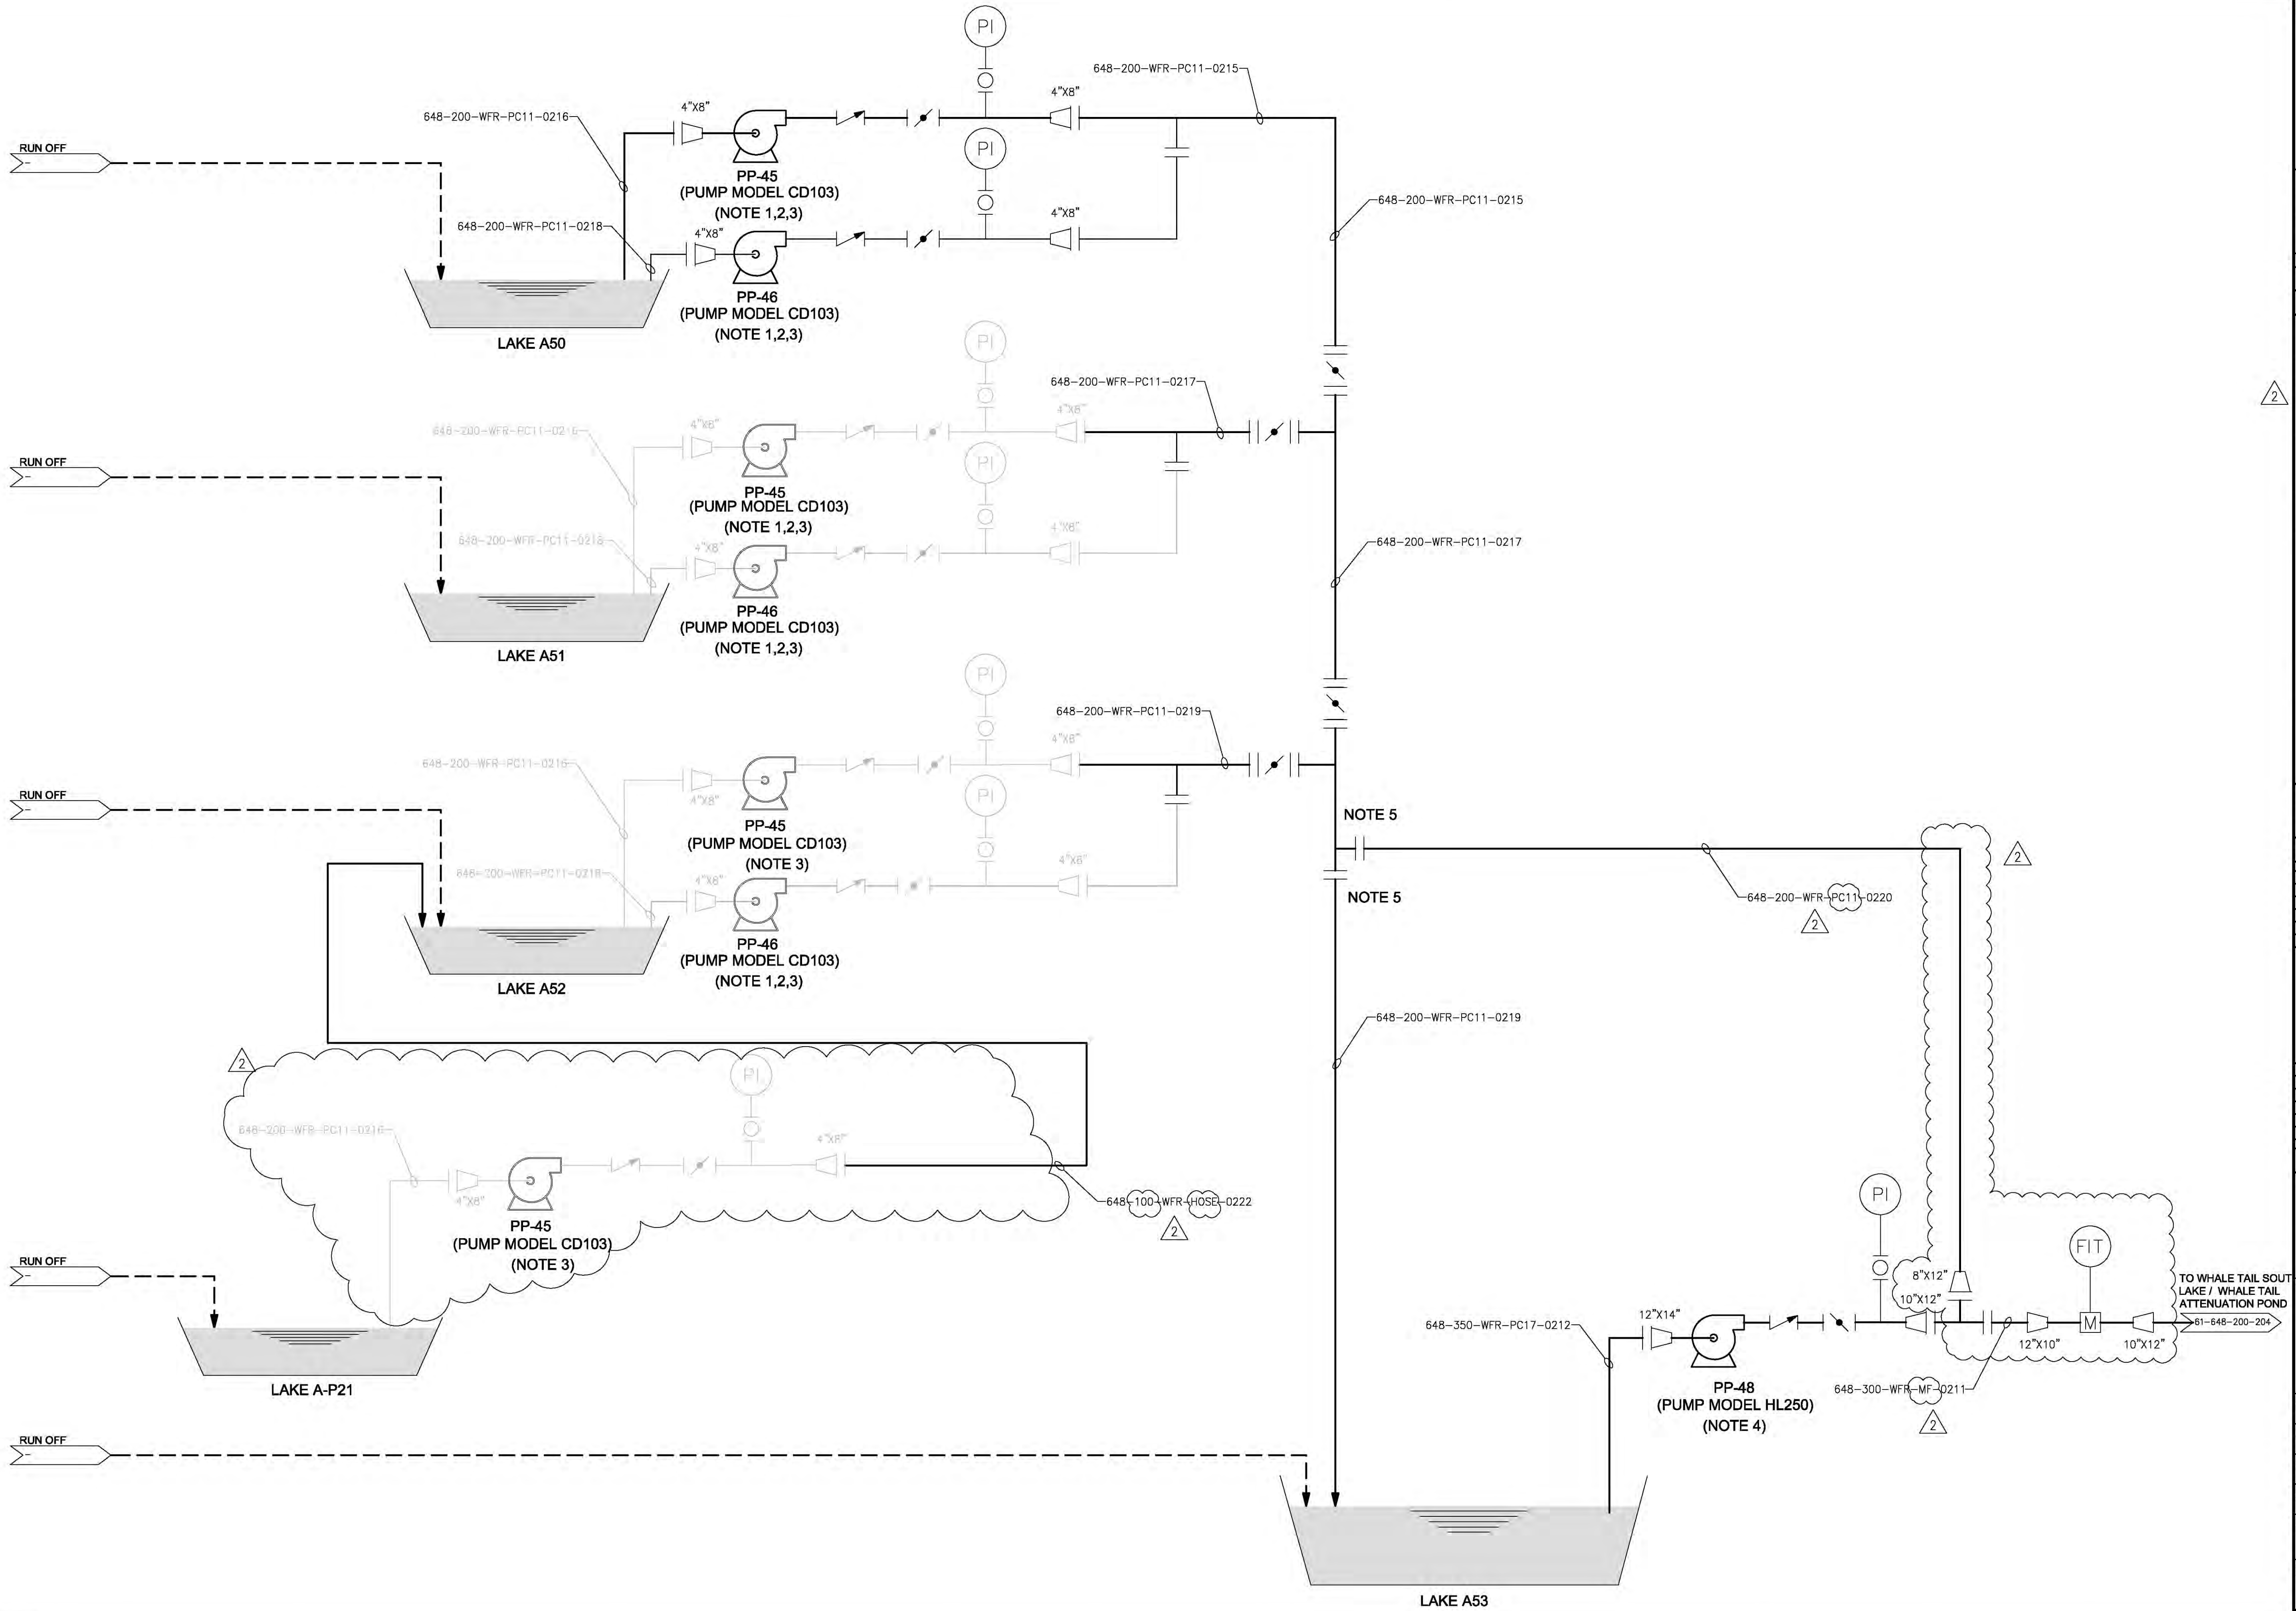

PLAN CLE
KEY PLAN

SNC-LAVALIN
Mining & Metallurgy
5500, des Galeries Blvd., bur. 200, Québec (Québec), Canada G2K 2E2
Telephone: (418) 621-5500, Fax: (418) 621-8887

PROJECT No	SUBDIVISION	SUBJECT	SERIAL	REV.
668284	8000	49, D1	0002	E02

NOTES GÉNÉRALES / GENERAL NOTES

NOTES :

1. PUMP PP45 AND PP46 SHALL BE USED TO DEWATER SEQUENTIALLY LAKE A50, A51 AND A52.
2. TWO CD103 PUMPS ARE REQUIRED TO PROVIDE A TOTAL DEWATERING FLOW RATE OVER 300 M3/H APPROX. TO ENSURE THAT IT OPERATES WITHIN ITS PUMP CURVE.
3. DEPENDING ON THE LAKE DEWATERING SEQUENCE, PUMPS PP41 AND PP43 COULD BE USED TO DEWATER LAKE A50, A51, A52 AND A-P21.
4. DEPENDING ON THE LAKE DEWATERING SEQUENCE, PP40 OR PP44 COULD BE USED TO DEWATER LAKE A53.
5. CONNECTION TO BY-PASS LINES SHALL BE DONE BY FLANGE TO FLANGE DISCONNECTION AND RECONNECTION.

LEGEND:

- PRIMARY STREAM
- INTERMITTENT STREAM
- FLANGED CONNECTION

DESSINS EN RÉFÉRENCE / REFERENCE DRAWINGS

TYPE / TITLE	# DWG

AGNICO EAGLE

REV.	DATE	DESCRIPTION	ENG/APP.	CLIENT
R2	2020-07-08	ISSUED FOR DESIGN	D.C.	A.L.N.
R1	2020-03-16	ISSUED FOR DESIGN	D.C.	A.L.N.
R0	2020-03-20	ISSUED FOR DESIGN	D.C.	A.L.N.
R0	2020-03-08	ISSUED FOR CLIENT COMMENTS	D.C.	A.L.N.
R0	2020-03-02	ISSUED FOR COMMENTS	D.C.	A.L.N.

REVISIONS

PERMIT TO PRACTICE
SNC-LAVALIN INC.
NAME: [Signature]
DATE: 2020-07-13
PERMIT NUMBER: P 260
The Association of Professional Engineers, Geologists and Geophysicists of NWT/NT

TITLE / TITLE
AGNICO EAGLE - AMARUQ DIVISION
648 - DEWATERING

200 - PROCESS FLOWSHEET
AMARUQ DEWATERING PHASE
LAKES A50, A51, A52 & A53

DESIGNÉ PAR DRAWN BY	M. MOVILA	DATE 2020-03-02
VÉRIFIÉ PAR CHECKED BY	D. CHEN	2020-03-02
APPROUVÉ PAR APPROVED BY	A.L. NGUYEN	2020-03-02

**ÉCHELLE
SCALE**

**NO. DESIGN
DRAWING NO.**
61-648-200-203

NO. PROJECT PROJECT NO.	REVISION	FEUILLE / SHEET
6127	R2	1 / 1



SNC • LAVALIN

Mining & Metallurgy
5500, des Galeries Blvd., bur. 200, Quebec (Quebec), Canada G2K 2E2
Telephone: (418) 621-5500, Fax: (418) 621-8887

PROJECT No	SUBDMISION	SUBJECT	SERIAL	REV.
668284	8000	49, D1	0003	E02

NOTES GÉNÉRALES / GENERAL NOTES

NOTES :

1. WHALE TAIL SOUTH LAKE SHALL OVERFLOW TO MAMMOTH LAKE VIA THE SOUTH WHALE TAIL DIVERSION CHANNEL (SWTDC).
2. THIS DRAWING SHOWS ONLY THE TIE-IN POINTS OF THE AMARUQ WTP.
3. CONNECTION TO BY-PASS LINES SHALL BE DONE BY FLANGE TO FLANGE DISCONNECTION AND RECONNECTION.

LEGEND:

——— PRIMARY STREAM
 - - - - INTERMITTENT STREAM
 || FLANGED CONNECTION

THE INFORMATION ON CONTAINER IS THE PROPERTY OF JIMCO GABLE LTD. AND MUST BE RETURNED UPON REQUEST, WITHOUT WRITTEN PERMISSION, ANY COPIES TRANSMITTED TO OTHERS AND ANY USE EXCEPT THAT FOR WHICH IT IS ISSUED ARE PROHIBITED.

© JIMCO GABLE LTD.

DESSINS EN RÉFÉRENCE / REFERENCE DRAWINGS

TITRE / TITLE	# DWG



AGNICO EAGLE

R2	2020-07-09	ISSUED FOR DESIGN	D.C.	A.L.N.	A.L.
R1	2020-05-15	ISSUED FOR DESIGN	D.C.	A.L.N.	A.L.
R0	2020-03-20	ISSUED FOR DESIGN	D.C.	A.L.N.	A.L.
RA	2020-03-06	ISSUED FOR CLIENT COMMENTS	D.C.	A.L.N.	R.B.
RB	2020-03-02	ISSUED FOR COMMENTS	D.C.	A.L.N.	A.L.
REV.	DATE	DESCRIPTION	PAR/BY	APP.	CLIENT

REVISIONS

**PERMIT TO PRACTICE**

SNC-LAVALIN INC.
NAME John

DATE 2020-07-13

PERMIT NUMBER: P 260
Association of Professional Engineers,
Scientists and Geoscientists of NWT (NAGS)

Geologists and Geophysicists of RWTH AACHEN

AMARUQ DIVISION

REWATERING

SS FLOWSHEET

ENTERING PHASE

ND, WT SOUTH LAKE
NORTH LAKE

DATE	
------	--

2020-0

	0000
--	------

	2020=100

2020-0

DATE _____

2020-03-02


200-204

	REVISION	REVIEW
--	----------	--------

REVISION	FEELER
	1

R2	1
----	---

61-648-200-204.dwg

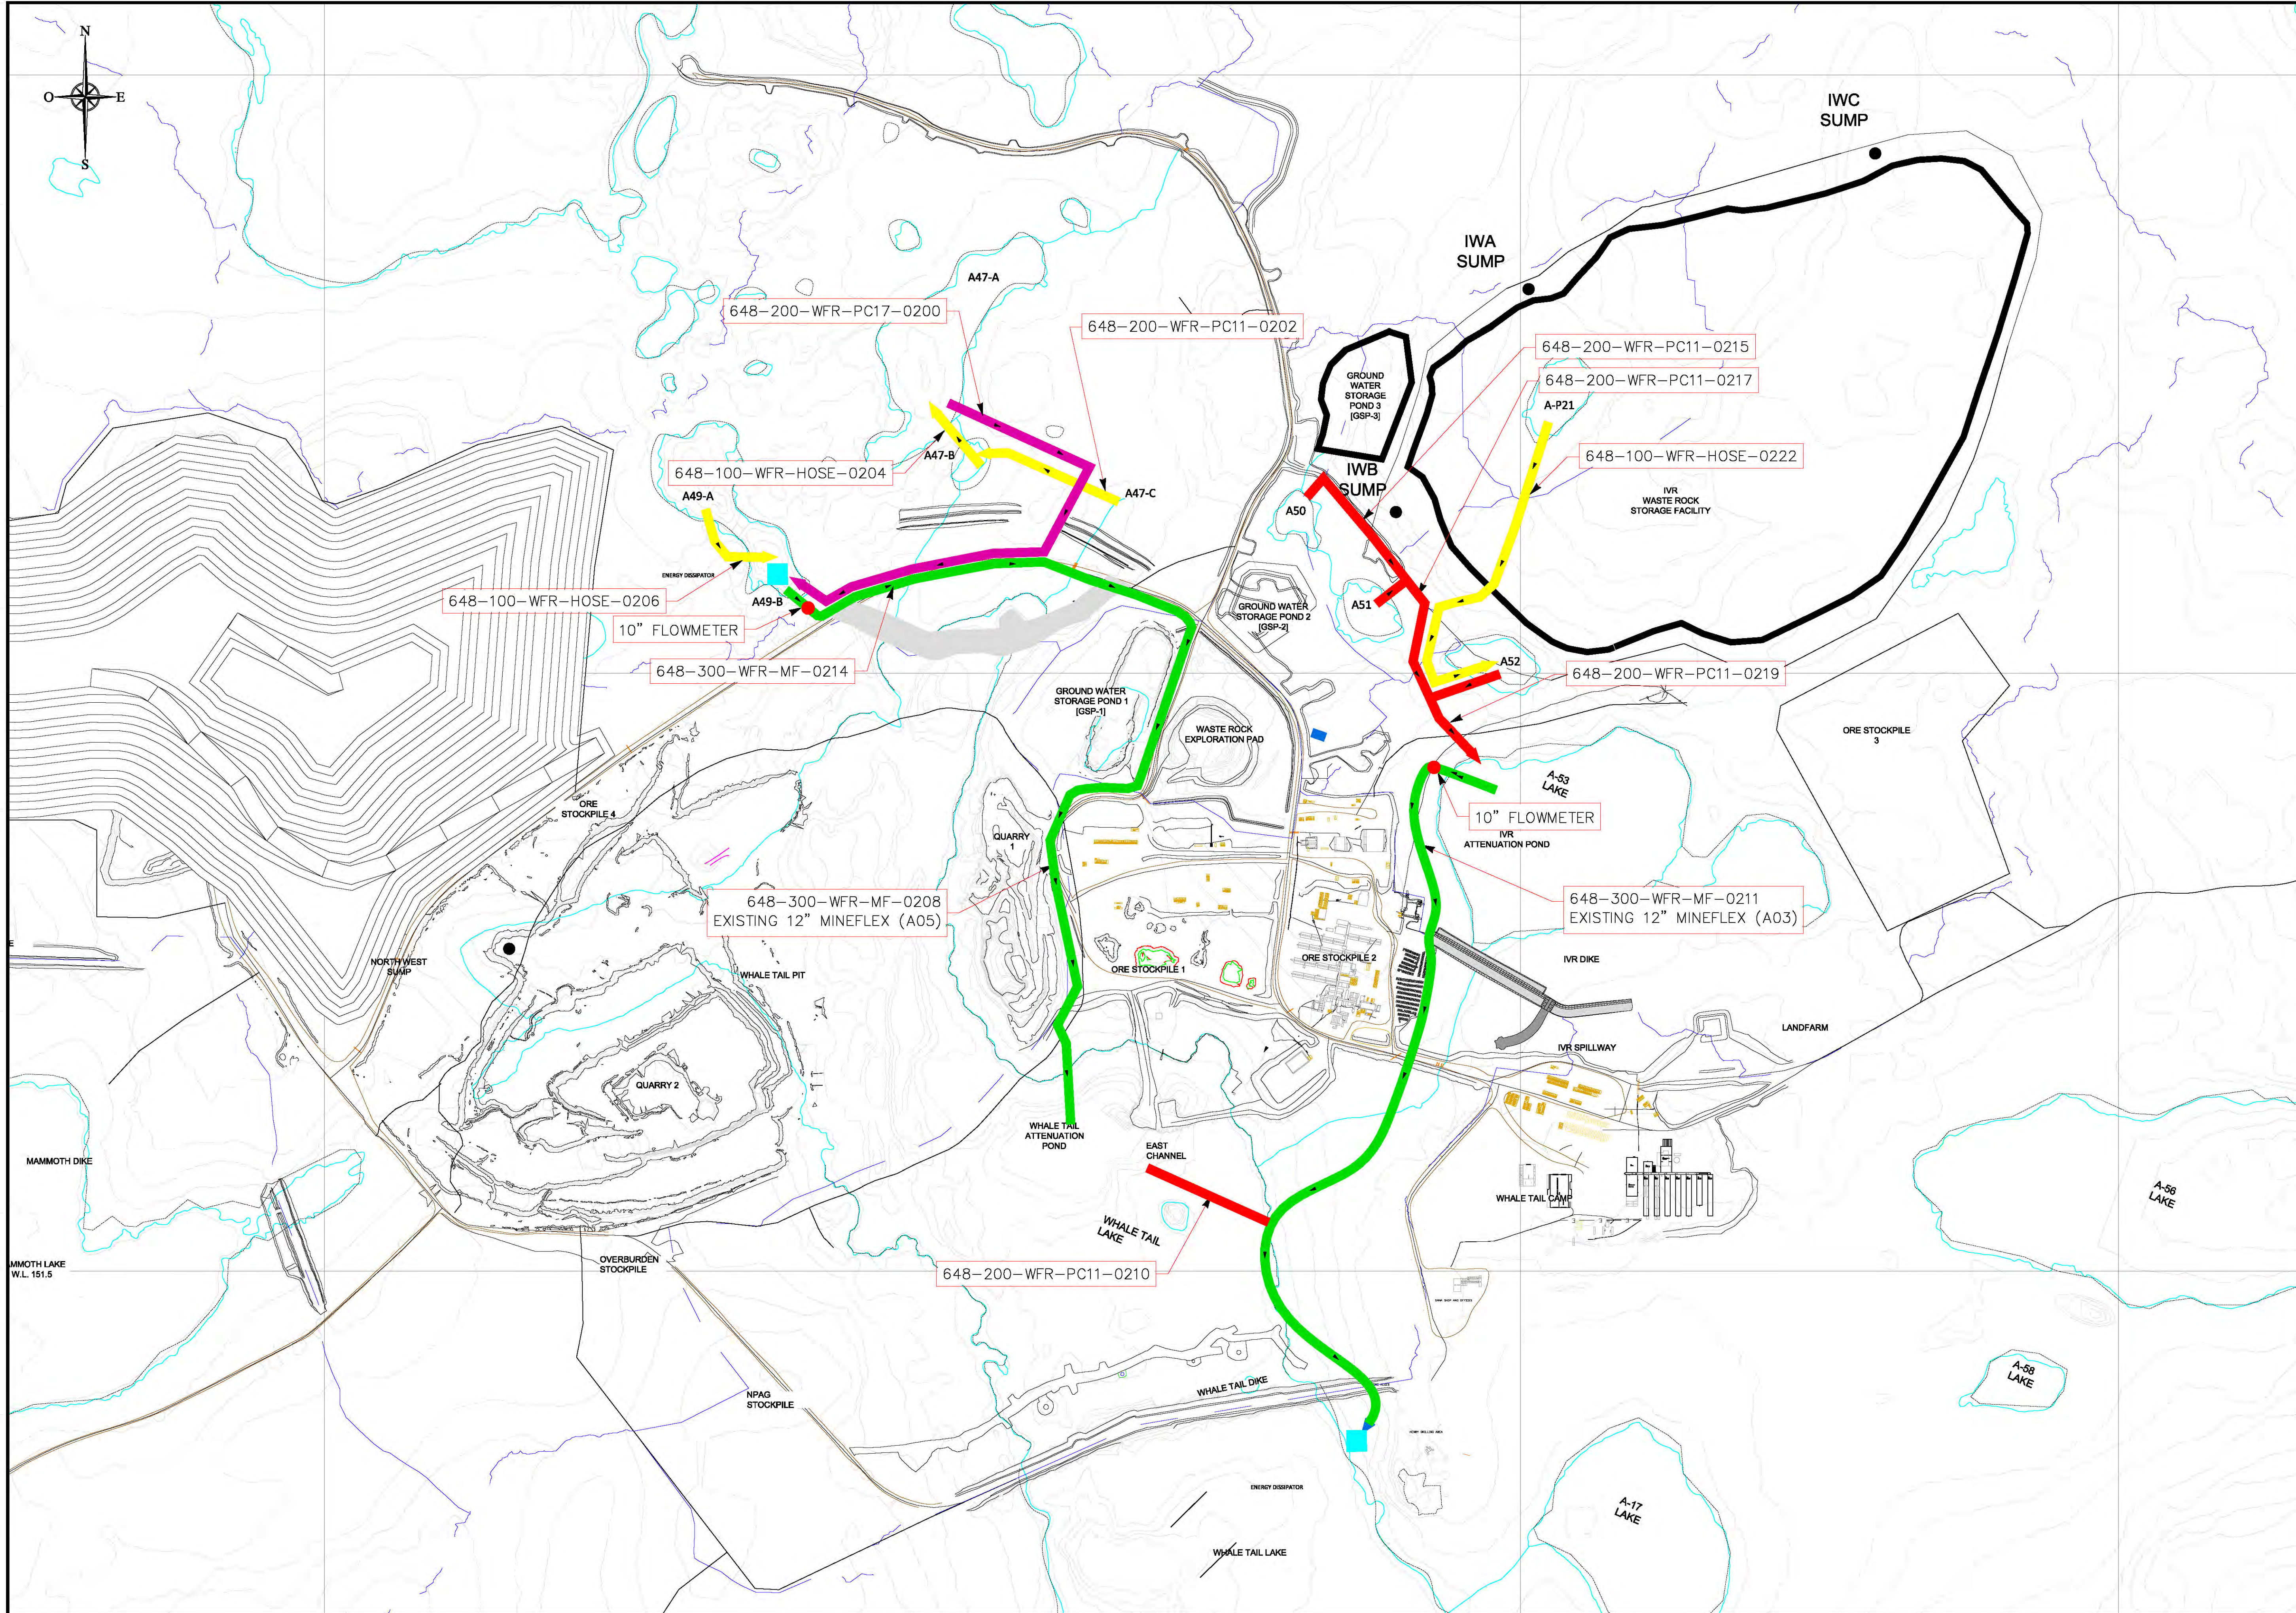

PLAN CLE
KEY PLAN

PROJECT No	SUBDIVISION	SUBJECT	SERIAL	REV.
668284	8000	46 DD	0001	E02

NOTES GÉNÉRALES / GENERAL NOTES

NOTES:

- ONLY PUMP DISCHARGE LINES ARE SHOWN. PUMP SUCTION LINES ARE NOT SHOWN.
- DEPENDING ON THE DEWATERING SEQUENCE, PUMPS AND LINES CAN BE MOVED FROM ONE AREA TO ANOTHER. PIPING ARRANGEMENT SHOWN ON THE LAYOUT CAN BE FIELD ADJUSTED BASED ON SITE CONDITIONS.
- FLOW METER LOCATION IS APPROXIMATE AND CAN BE FIELD ADJUSTED BASED ON SITE CONDITIONS.

LEGEND:

- 4" NON-INSULATED HOSE
- 8" NOMINAL NON-INSULATED (DR11)
- 8" NOMINAL NON-INSULATED (DR17)
- 12" MINEFLEX HOSE
- ENERGY DISSIPATOR

INFORMATION CONTAINED ON THIS DRAWING IS THE PROPERTY OF AGNICO EAGLE LTD. AND THE INFORMATION HAS BEEN PROVIDED FOR YOUR INFORMATION ONLY. NO PART OF THIS DRAWING IS TO BE REPRODUCED OR TRANSMITTED IN ANY FORM OR BY ANY MEANS, ELECTRONIC OR MECHANICAL, WITHOUT PERMISSION IN WRITING FROM AGNICO EAGLE LTD.

DESSINS EN RÉFÉRENCE / REFERENCE DRAWINGS

TITRE / TITLE	# DWG

AGNICO EAGLE

REV.	DATE	DESCRIPTION	PAR/APP.	CLIENT
R2	2020-07-09	ISSUED FOR DESIGN	D.C.	A.L.N.
R1	2020-06-15	ISSUED FOR DESIGN	D.C.	A.L.N.
R0	2020-04-07	ISSUED FOR DESIGN	M.M.	A.L.
RB	2020-03-19	ISSUED FOR CLIENT COMMENTS	M.M.	A.L.N.
RA	2020-03-10	ISSUED FOR INTERNAL COMMENTS	M.M.	A.L.N.

REVISIONS

PERMIT TO PRACTICE
SING-LAVALLÉE INC.
Signature: NAME
DATE: 2020-07-13
PERMIT NUMBER: P 260
The Association of Professional Engineers, Geologists and Geophysicists of NWT

TITRE / TITLE
AGNICO EAGLE - AMARUQ DIVISION
695 - WATER MANAGEMENT
270 - PIPING
PLAN VIEW
AMARUQ DEWATERING PHASE
PIPING LAYOUT

DESSINÉ PAR DRAWN BY	DATE
MARIUS MOVILA	200-03-11




VÉRIFIÉ PAR CHECKED BY	DATE
ANH-LONG NGUYEN	200-03-11

APPROUVÉ PAR APPROVED BY	DATE
ALEXANDRE LAVALLÉE	200-03-11


ÉCHELLE
SCALE AS SHOWN DATE 200-03-11

NO. DESSIN
DRAWING NO. 61-648-270-202

NO. PROJET PROJECT NO.	REVISION	FEUILLE / SHEET
6127	R2	1 / 1

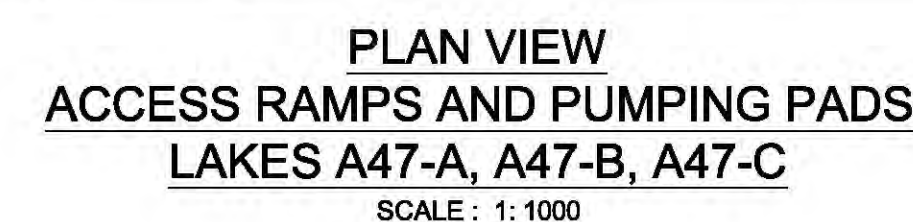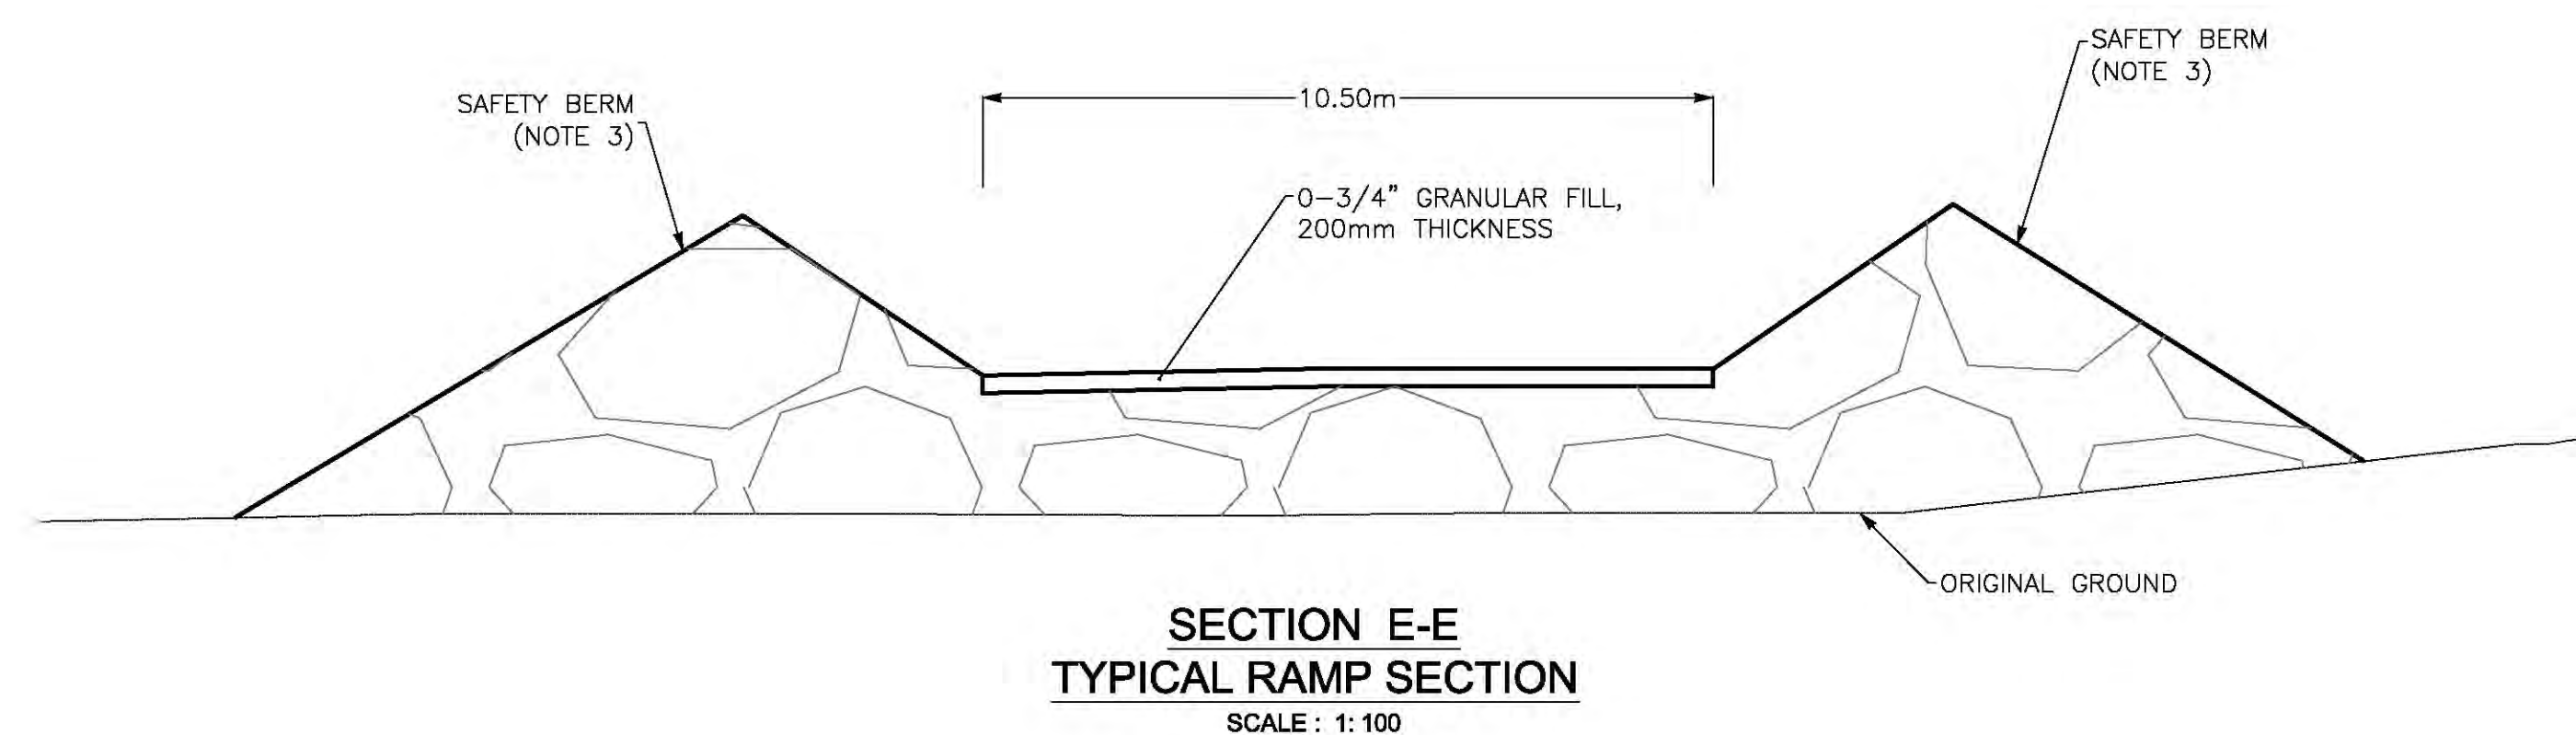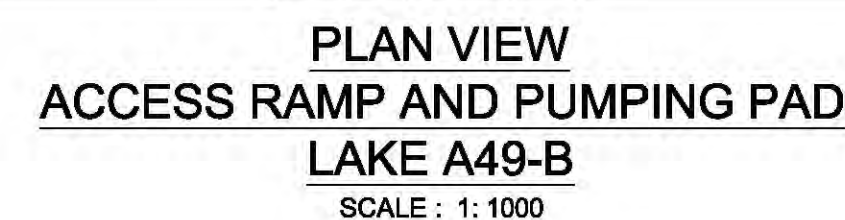

ESTIMATED IN-PLACE QUANTITIES CONSTRUCTION — ACCESS RAMPS AND PADS		
Lake (Access ramp and pad)	Granular fill, 0–3/4" (final grade, thickness 200 mm) (m ³)	Run-of-mine rockfill (0–1000 mm) (m ³)
A49–B	341.8	8945.2
A47–A	935.4	27177.2
A47–B	32.46	2275.7
A47–C	34.5	1082.6

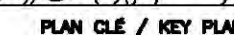

PROJECT No	SUBDIVISION	SUBJECT	SERIAL	RE
668284	8000	4G , DD	0001	EQ

NOTES GÉNÉRALES / GENERAL NOTES

NOTES

1. GROUND TOPOGRAPHY WAS PROVIDED BY AEM.
2. ALL UNITS ARE IN METERS.
3. SAFETY BERMS SHALL BE BASED ON THE MINE ACT REQUIREMENTS.
4. STABILITY OF THE RAMPS TO BE ASSESSED ON DAILY BASIS BY A QUALIFIED GEOTECHNICAL PERSONNEL. DURING CONSTRUCTION, WORK SHALL BE SUSPENDED IF SIGNS OF INSTABILITY ARE OBSERVED.
5. INITIAL ROCK FILL MATERIAL PLACEMENT IN WATER, AGAINST THE NATURAL SOIL OF THE LAKE, MUST BE PLACED USING A SHOVEL.
6. FOR ALL ROCK FILL PLACEMENT OVER WATER, SOME FOUNDATION PREPARATION MIGHT BE NEEDED DEPENDING ON NATURE AND THICKNESS OF SEDIMENT ENCOUNTERED.

LEGEND



THE INFORMATION ON THIS CARD IS THE PROPERTY OF ARCAD EAGLE LTD. AND MUST BE RETURNED UPON REQUEST, WITHOUT WRITTEN PERMISSION, TO THE COMPANY. IF YOU ARE AN ARCAD EAGLE LTD. EMPLOYEE, YOU MUST NOT DISCLOSE THIS INFORMATION TO ANY OTHER PERSON.

DESSINS EN RÉFÉRENCE / REFERENCE DRAWING:

TITRE / TITLE	# DWG



AGNICO EAGLE

RO	2020-05-28	ISSUED FOR CONSTRUCTION	WJ/WC	ALN/HB		
RB	2020-03-30	ISSUED FOR CLIENT COMMENTS	WJ/WC	ALN		
RA	2020-03-23	ISSUED FOR INTERNAL COMMENTS	WJ/WC	ALN		
REV.	DATE	DESCRIPTION	PAR/BY	APP.	CLERK	

REVISIONS



PERMIT TO PRACTIC
SNC-LAVALIN INC.
Signature: NAME *[Signature]*
Date: DATE 2020-05-29
PERMIT NUMBER: P 2
The Association of Professional Eng
Geologists and Geophysicists of NW

TITLE / TITRE

0

648 - DEWATERING

230 - GENERAL EARTHWORKS

PLAN VIEW, PROFILES AND TYPICAL SECTIONS

AMARUQ DEWATERING PHASE


LAKES A47-A, A47-B, A47-C AND A49-B

DESSINÉ PAR DRAWN BY	MARIUS MOVILA	DATE	2020-03-2
VÉRIFIÉ PAR CHECKED BY	DARIUSH RASTGOU/ DAN CHEN		2020-03-2
APPROUVÉ PAR APPROVED BY	ANH-LONG NGUYEN		2020-03-2

ECHAELLE SCALE		AS SHOWN		DATE 2020-03-23			
NO. DESSIN DRAWING NO.				61-648-230-200			
NO. PROJET PROJECT NO.				REVISION		FEUILLE / SH	
				R0		1 / 2	



PLAN VIEW
ACCESS RAMP AND PUMPING PAD
LAKE A50, A51, A52 AND A-P21
SCALE : 1: 1500

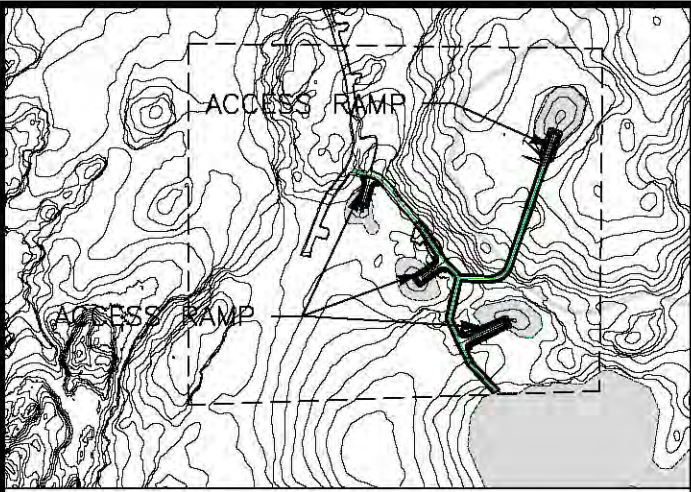

PLAN CLE / KEY PLAN

PROJECT No	SUBDIVISION	SUBJECT	SERIAL	REV.
668284	8000	4G DD	0002	E00

NOTES GÉNÉRALES / GENERAL NOTES

- NOTES
- GROUND TOPOGRAPHY WAS PROVIDED BY AEM.
 - ALL UNITS ARE IN METERS.
 - SAFETY BERMS SHALL BE BASED ON THE MINE ACT REQUIREMENTS.
 - STABILITY OF THE RAMPS TO BE ASSESSED ON A DAILY BASIS BY QUALIFIED GEOTECHNICAL PERSONNEL DURING CONSTRUCTION. WORK SHALL BE SUSPENDED IF SIGNS OF INSTABILITY ARE OBSERVED.
 - ROAD ALIGNMENT IS APPROXIMATE AND SHALL BE ADJUSTED DEPENDING ON FIELD CONDITIONS AND LOCAL TOPOGRAPHY.
 - INITIAL ROCKFILL MATERIAL PLACEMENT IN WATER, AGAINST THE NATURAL SOIL OF THE LAKE, MUST BE PLACED USING A SHOVEL.
 - THE ROAD AND RAMP CONSTRUCTION MATERIAL INSIDE THE FOOTPRINT OF THE FUTURE IWR WRSF SHALL BE EITHER PAG OR NPAG MATERIAL. THE USE OF PAG MATERIAL SHALL START APPROXIMATELY 8 METERS FROM THE TOE OF THE WRSF.
 - WATER LEVEL IN LAKES IS ESTIMATED BASED ON THE TOPOGRAPHY AROUND THE LAKE. THE ELEVATION IS APPROXIMATE AND SHALL BE VERIFIED AT THE SITE BEFORE THE START OF WORK. THE MINIMUM ALLOWABLE DIFFERENCE BETWEEN THE LAKE AND THE ROLLING SURFACE OF THE ROAD SHALL BE 0.5 METER.
 - PROVIDE SEMI-CULVERTS TO PROTECT EXISTING ELECTRICAL CABLES AND WRSF LOCATED AT THIS APPROXIMATE AREA.

LEGEND
RUN-OF-MINE
ROCKFILL 0-1000 MM

INFORMATION IS CONTAINED IN THIS DRAWING IS THE PROPERTY OF AGNICO EAGLE LTD. AND MUST BE RETURNED UPON REQUEST. AGNICO EAGLE LTD. IS NOT RESPONSIBLE FOR THE ACCURACY OF THE INFORMATION PROVIDED BY OTHER SOURCES. THE INFORMATION IS NOT TO BE USED FOR ANY OTHER PURPOSES WITHOUT THE WRITTEN PERMISSION OF AGNICO EAGLE LTD.

DESSINS EN RÉFÉRENCE / REFERENCE DRAWINGS

TITRE / TITLE	# DWG



REV	DATE	DESCRIPTION	PAV/EN	APP	CLIENT
RO	2020-06-12	ISSUED FOR CONSTRUCTION	M/20/NO	AJA/NO	
RB	2020-06-15	ISSUED FOR CLIENT COMMENTS	M/20/NO	AJA/NO	
RA	2020-06-14	ISSUED FOR INTERNAL COMMENTS	M/20/NO	AJA/NO	

REVISIONS


PERMIT TO PRACTICE
Signature: [Signature]
NAME: [Name]
DATE: [Date]
PERMIT NUMBER: P 260
The Association of Professional Engineers, Geologists and Geophysicists of BC (APEGBC)

TITRE / TITLE
AGNICO EAGLE - AMARUQ DIVISION
648 - DEWATERING
230 - GENERAL EARTHWORKS
PLAN VIEW, PROFILES AND TYPICAL SECTIONS
AMARUQ DEWATERING PHASE
LAKES A50, A51, A52 AND A-P21
ACCESS RAMPS AND PUMPING PADS


DESSEINÉ PAR DRAWN BY	MARIUS MOVILA	DATE 2020-03-23
VÉRIFIÉ PAR CHECKED BY	DAN CHEN	2020-03-23
APPROUVÉ PAR APPROVED BY	ANH-LONG NGUYEN	2020-03-23

ÉCHELLE
SCALE: AS SHOWN
DATE: 2020-03-23


NO. DESIGN DRAWING NO.	61-648-230-201
NO. PROJET PROJECT NO.	6127
REVISION	RO
FEUILLE / SHÉ	1 / 2

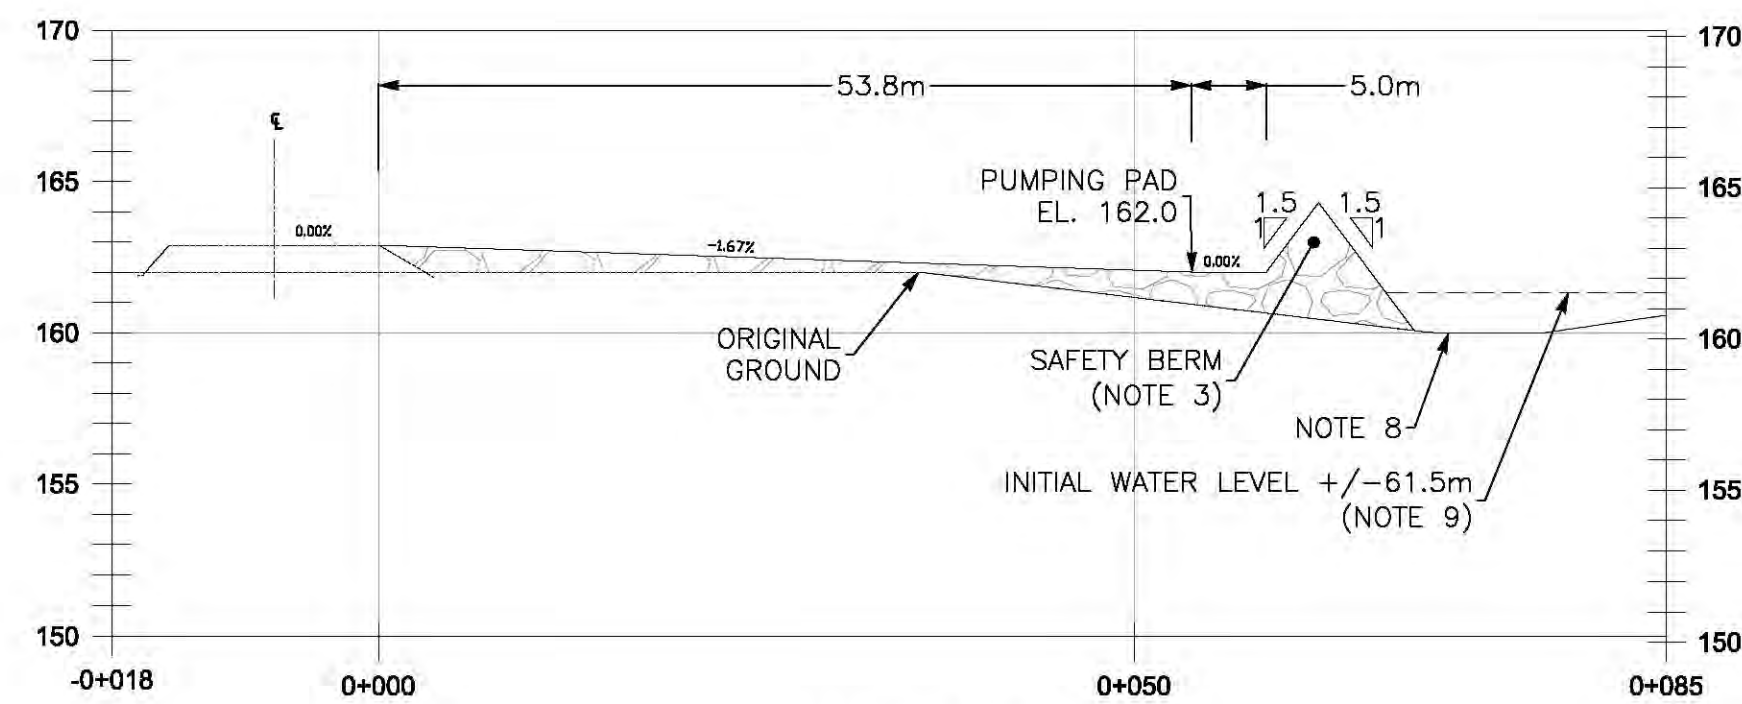


SECTION A-A
PROFILE LAKE A50 RAMP
SCALE : H 1:500
V 1:250

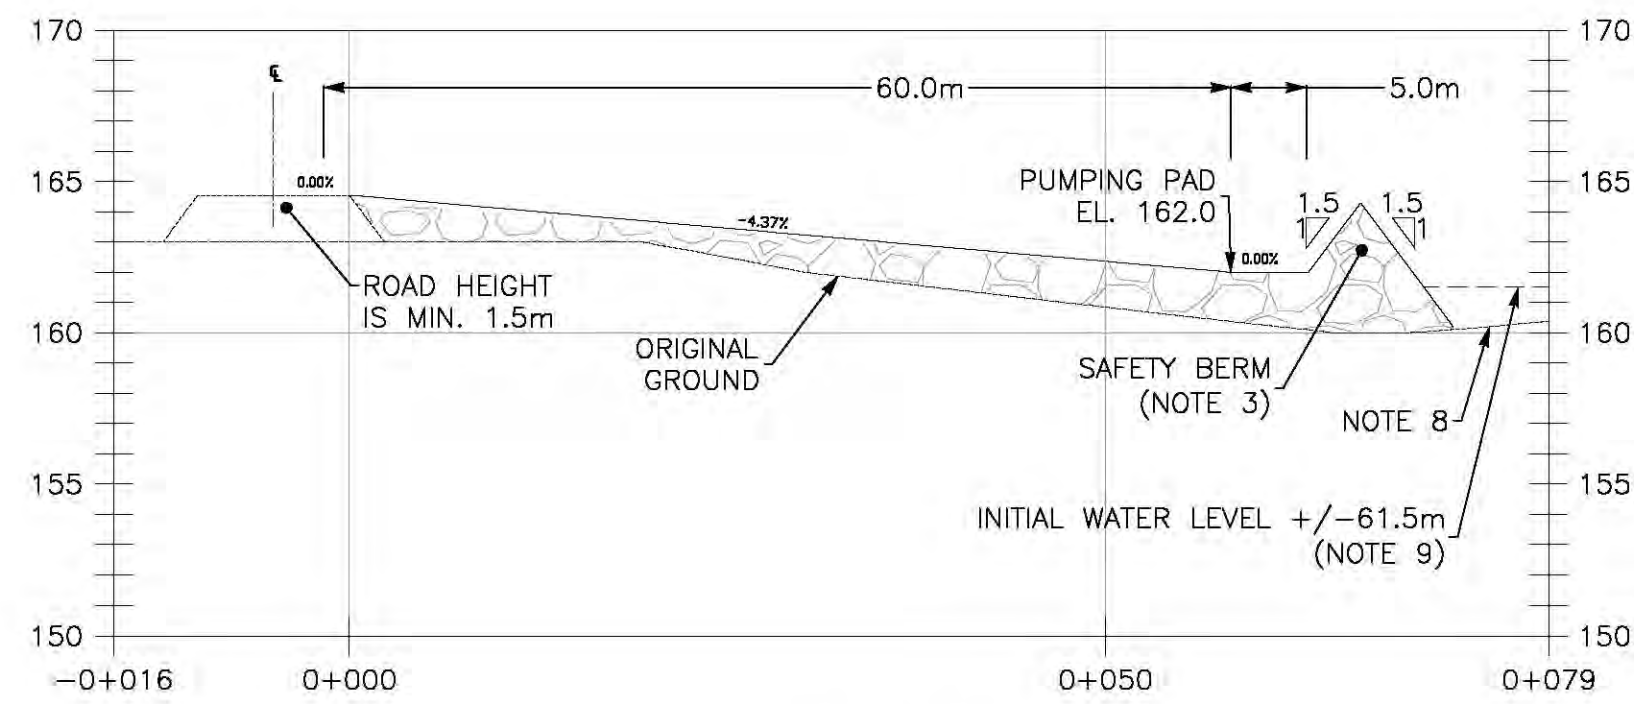


SECTION B-B
PROFILE LAKE A51 RAMP
SCALE : H 1:500
V 1:250

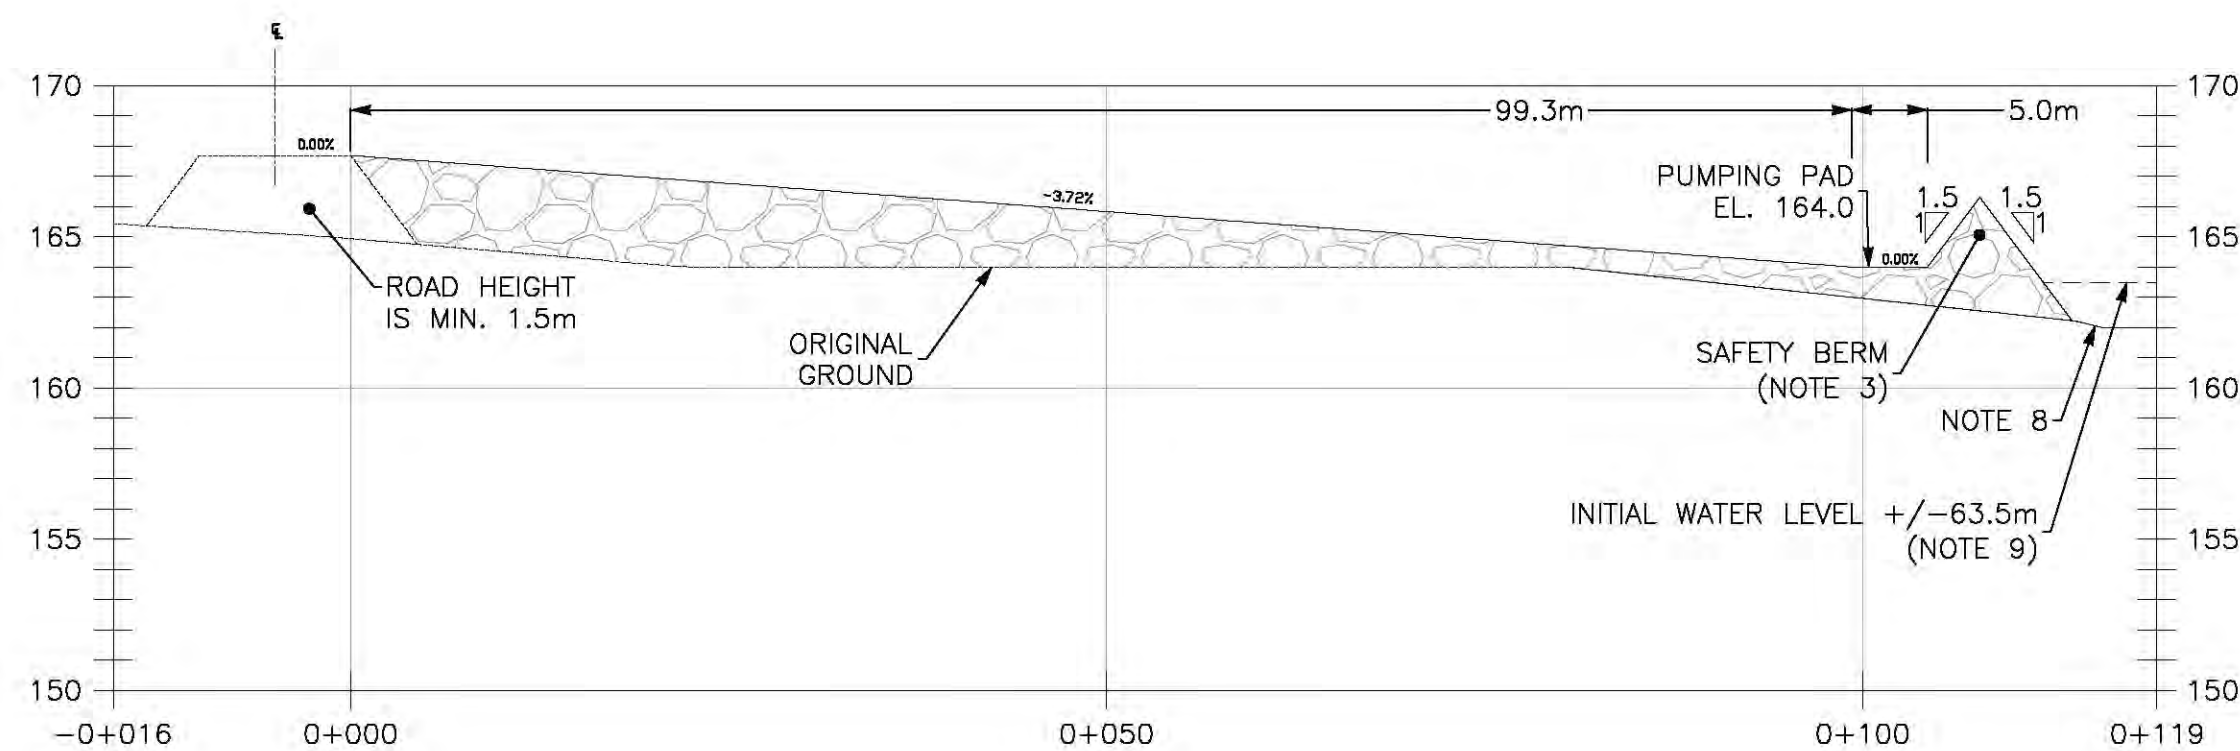


SECTION C-C
PROFILE LAKE A52 RAMP
SCALE : H 1:500
V 1:250

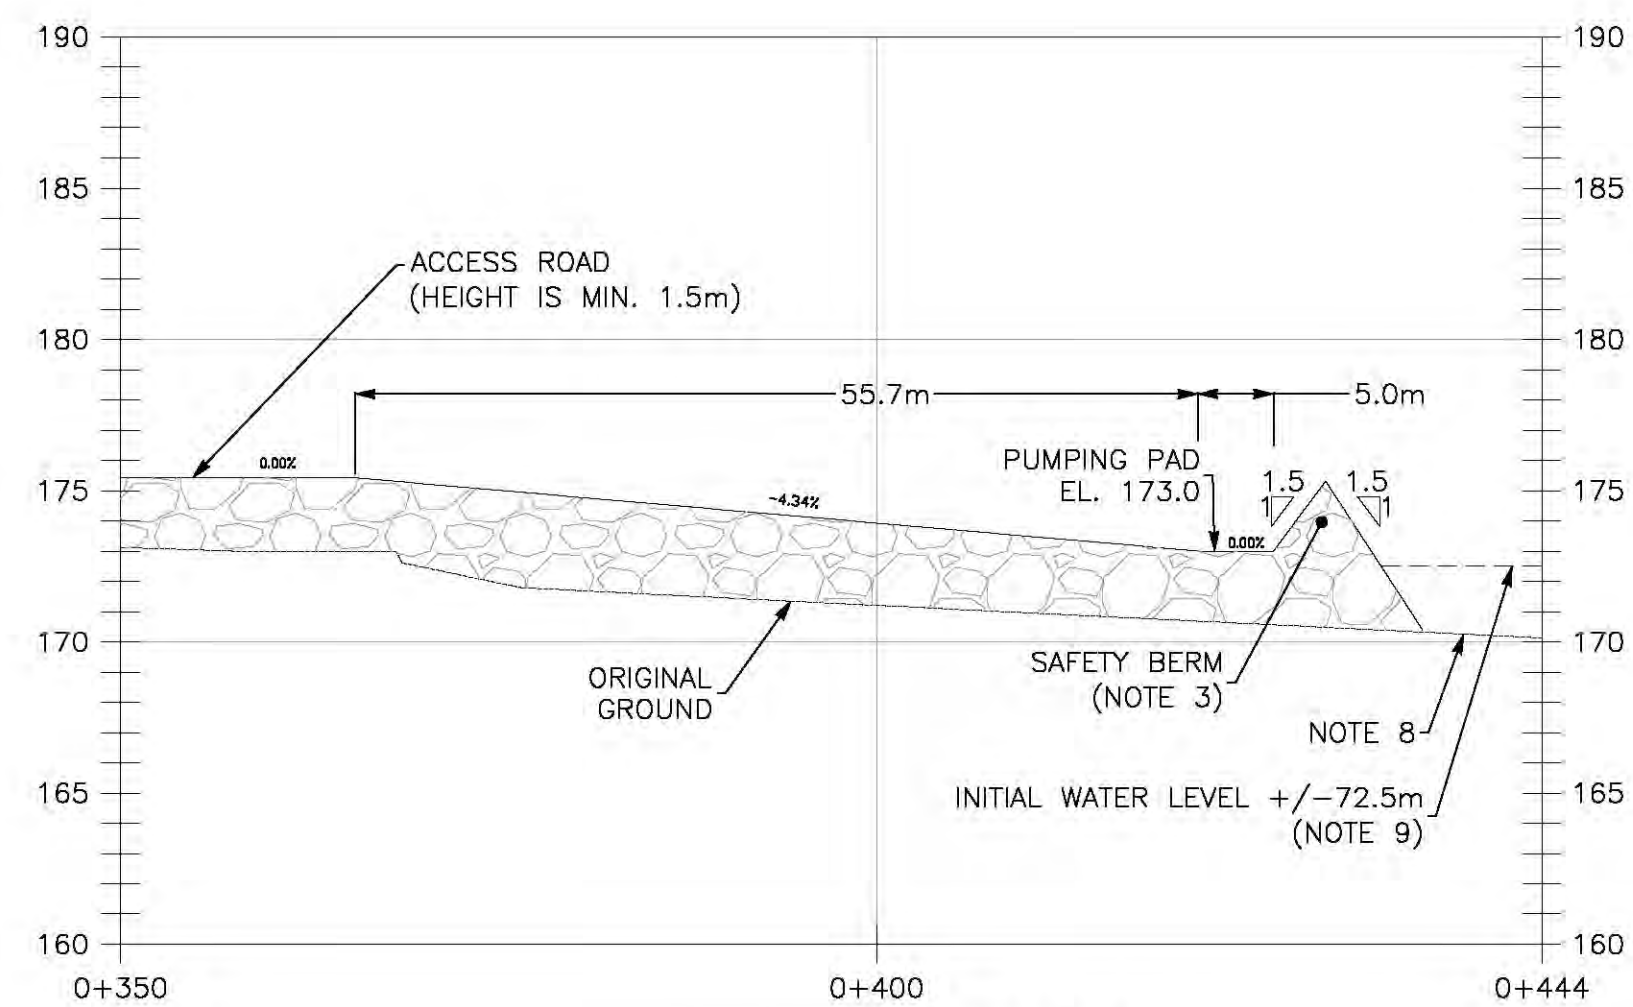

SECTION D-D
PROFILE LAKE A-P21 RAMP
SCALE : H 1:500
V 1:250

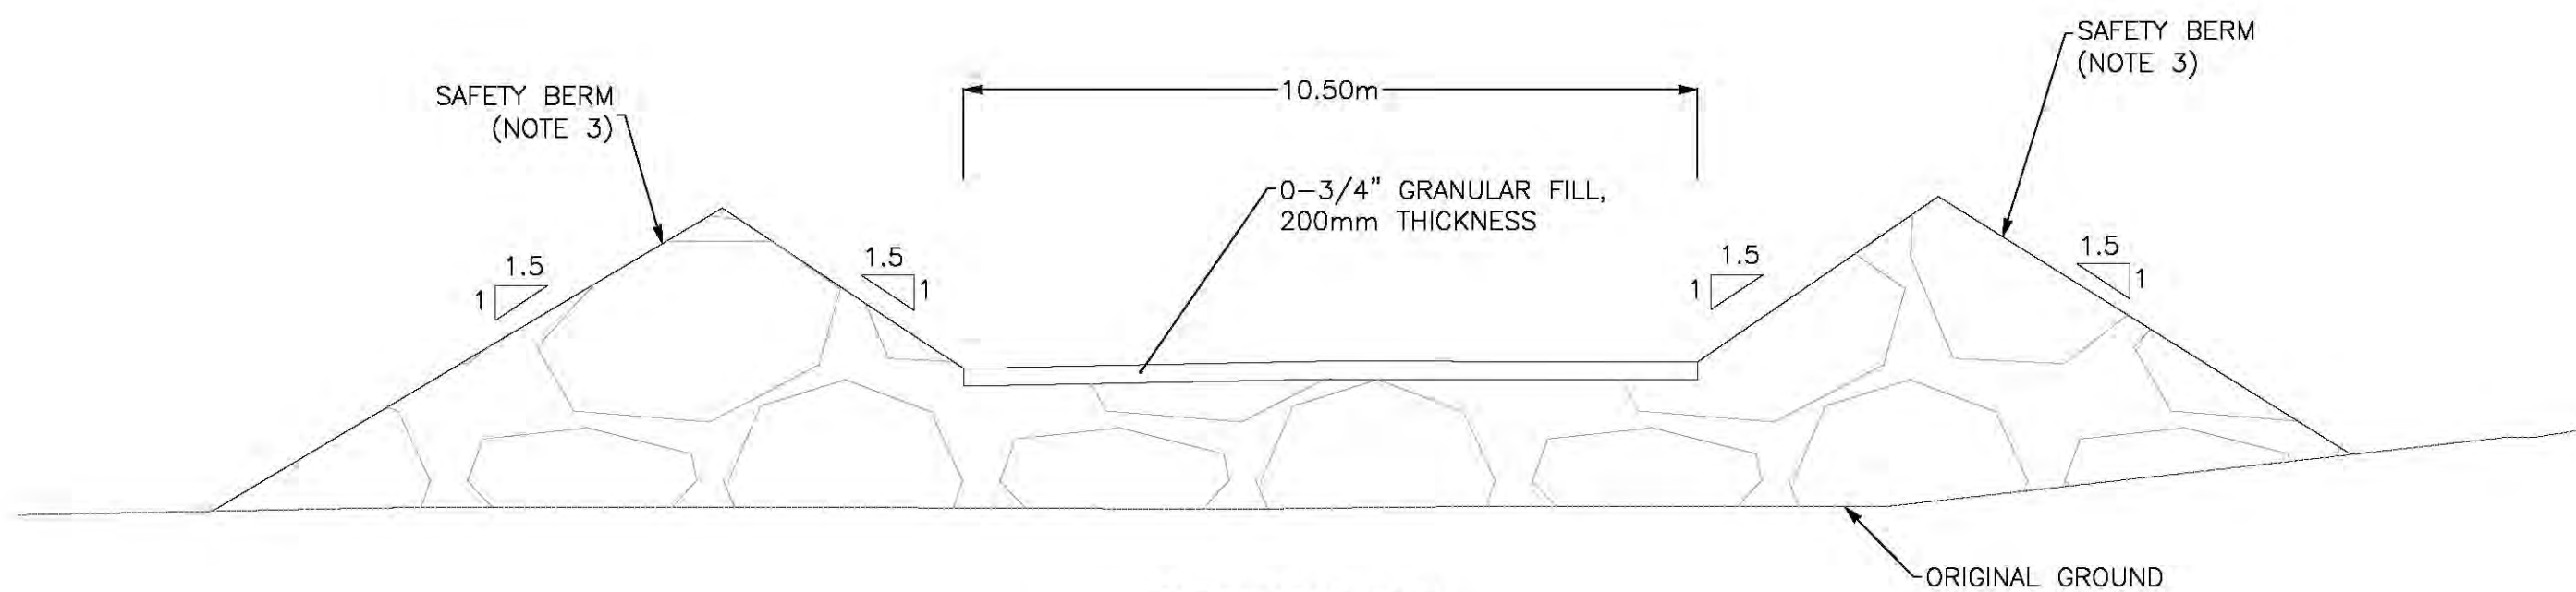

SECTION E-E
TYPICAL RAMP SECTION
SCALE : 1:100

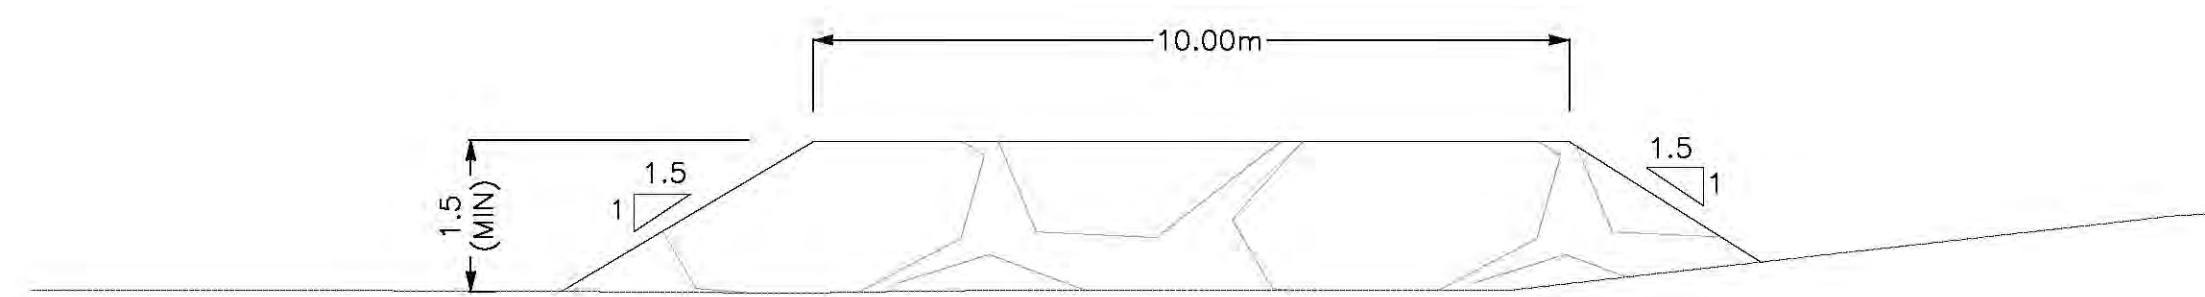

SECTION F-F
TYPICAL ROAD SECTION
SCALE : N.T.S.

ESTIMATED IN-PLACE QUANTITIES CONSTRUCTION - ACCESS RAMPS AND PADS		
Lake (Access ramp and pad)	Granular fill, 0-3/4" (final grade, thickness 200 mm) (m³)	Run-of-mine rockfill (0-1000 mm) (m³)
A50	159.8	2289.7
A51	153.2	3140.6
A52	238.3	7262.9
A-P21	121.9	5536.3

PROJECT No	SUBDIVISION	SUBJECT	SERIAL	REV.
668284	8000	40 DD	0002	E00

NOTES GÉNÉRALES / GENERAL NOTES

- NOTES
- GROUND TOPOGRAPHY WAS PROVIDED BY AEM.
 - ALL UNITS ARE IN METERS.
 - SAFETY BERMS SHALL BE BASED ON THE MINE ACT REQUIREMENTS.
 - STABILITY OF THE RAMPS TO BE ASSESSED ON A DAILY BASIS BY QUALIFIED GEOTECHNICAL PERSONNEL DURING CONSTRUCTION. WORK SHALL BE SUSPENDED IF SIGNS OF INSTABILITY ARE OBSERVED.
 - ROAD ALIGNMENT IS APPROXIMATE AND SHALL BE ADJUSTED DEPENDING ON FIELD CONDITIONS AND LOCAL TOPOGRAPHY.
 - INITIAL ROCKFILL MATERIAL PLACEMENT IN WATER, AGAINST THE NATURAL SOIL OF THE LAKE, MUST BE PLACED USING A SHOVEL.
 - THE ROAD AND RAMP CONSTRUCTION MATERIAL INSIDE THE FOOTPRINT OF THE FUTURE IWR WRSF SHALL BE EITHER PAG OR NPAG MATERIAL. THE USE OF PAG MATERIAL SHALL START APPROXIMATELY 8 METERS FROM THE TOE OF THE WRSF.
 - FOR ALL ROCK FILL PLACEMENT OVER WATER, SOME FOUNDATION PREPARATION MIGHT BE NEEDED DEPENDING ON NATURE AND THICKNESS OF SEDIMENT ENCOUNTERED.
 - WATER LEVEL IN LAKES IS ESTIMATED BASED ON THE TOPOGRAPHY AROUND THE LAKE. THE ELEVATION IS APPROXIMATE AND SHALL BE VERIFIED AT THE SITE BEFORE THE START OF WORK. THE MINIMUM ALLOWABLE DIFFERENCE BETWEEN THE LAKE AND THE ROLLING SURFACE OF THE ROAD SHALL BE 0.5 METER.

LEGEND

RUN-OF-MINE
ROCKFILL 0-1000 MM

INFORMATION CONTAINED HEREIN IS THE PROPERTY OF AGNICO EAGLE LTD. AND IS NOT TO BE REPRODUCED OR TRANSMITTED IN ANY FORM OR BY ANY MEANS, ELECTRONIC OR MECHANICAL, INCLUDING PHOTOCOPYING, RECORDING, OR BY ANY INFORMATION STORAGE AND RETRIEVAL SYSTEM, WITHOUT PERMISSION IN WRITING FROM AGNICO EAGLE LTD.

DESIGNS EN RÉFÉRENCE / REFERENCE DRAWINGS

TITRE / TITLE	# DWG



REV.	DATE	DESCRIPTION	PAR/PRP	APP.	CLIENT
RO	2020-06-12	ISSUED FOR CONSTRUCTION	M/AC/NQ	A/J/RE	
RB	2020-06-15	ISSUED FOR CLIENT COMMENTS	M/AC/NQ	A/J/RE	
RA	2020-06-14	ISSUED FOR INTERNAL COMMENTS	M/AC/NQ	A/J/RE	

REVISIONS









PERMIT TO PRACTICE SICILAVALLIN INC. Signature: NAME DATE: 2020-06-12 2020-06-12 PERMIT NUMBER: P 260 The Association of Professional Engineers, Geologists and Geophysicists of BC (APEGBC)	
---	--

TITRE / TITLE
AGNICO EAGLE - AMARUQ DIVISION
648 - DEWATERING
230 - GENERAL EARTHWORKS
PLAN VIEW, PROFILES AND TYPICAL SECTIONS
AMARUQ DEWATERING PHASE
LAKES A50, A51, A52 AND A-P21
ACCESS RAMPS AND PUMPING PADS

DESIGNER PAR DRAWN BY	MARIUS MOVILA	DATE	2020-03-23
VÉRIFIÉ PAR CHECKED BY	DAN CHEN		2020-03-23
APPROUVÉ PAR APPROVED BY	ANH-LONG NGUYEN		2020-03-23

ÉCHELLE SCALE	AS SHOWN	DATE	2020-03-23
------------------	----------	------	------------

NO. DESSIN DRAWING NO.	61-648-230-201
NO. PROJET PROJECT NO.	6127
REVISION	RO
FEUILLE / SHÉ	2 / 2

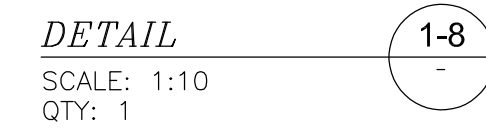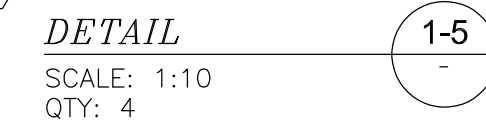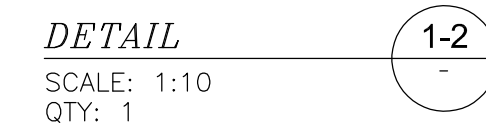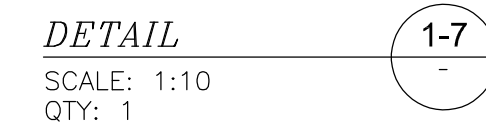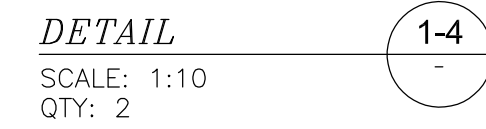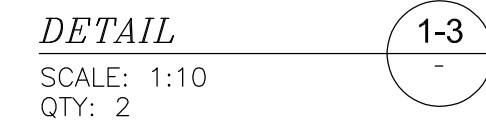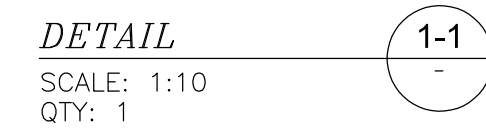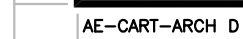

NOTES GÉNÉRALES / GENERAL NOTES

- STRUCTURE : PAINTED STEEL AS PER GENERAL GUIDELINE DESIGN: 6115-000-245-GGD-003.
- WIRE MESH : PREFERRED STAINLESS STEEL UNPAINTED TO LIMIT CLOGGING.

DATE : 2020-03-25

THE INFORMATION CONTAINED HEREIN IS THE PROPERTY OF AGNCO EAGLE LTD. AND MUST BE RETURNED UPON REQUEST. WITHOUT WRITTEN PERMISSION, NO COPIES MAY BE MADE, REPRODUCED, COPIED, OR TRANSMITTED IN ANY FORM OR BY ANY MEANS, ELECTRONIC OR MECHANICAL, INCLUDING PHOTOCOPYING, RECORDING, OR BY ANY INFORMATION STORAGE AND RETRIEVAL SYSTEM. ANY COPIING, TRANSMISSION, TO OTHERS AND ANY USE EXCEPT THAT FOR WHICH IT IS LOANED ARE PROHIBITED.

DESSINS EN RÉFÉRENCE / REFERENCE DRAWINGS

1	2020/03/25	ADDENDUM #1	BL	IG	BR
0	2020/03/23	ISSUED FOR TENDER	BL	IG	BR
REV.	DATE	DESCRIPTION	PAR/BY	APP.	CLIENT

REVISIONS



SNC-Lavalin Stavibel inc.
150, rue Gamble Ouest
Rouyn-Noranda (Québec) J9X 2R7
Tel. : 819 764-5181 Fax : 819 797-0158
www.snc-lavalin.com

Project #: 671087-0000

TITLE / TITLE

AGNICO EAGLE - MEADOWBANK DIVISION
648 - DEWATERING
270 - PIPING
PLAN, ELEVATION & DETAILS
FISH CAGES FOR HL250
DEWATERING PUMPS

DESSINE PAR DRAWN BY	BRUNO LEMIEUX	DATE 2020/03/21
-------------------------	---------------	--------------------

VERIFIÉ PAR CHECKED BY	ISRAËL GAGNON	2020/03/21
APPROUVÉ PAR		

APPROVED FOR APPROVED BY	ISRAËL GAGNON	2020/03/2
ÉCHELLE	DATE	

NO. DESSIN DRAWING NO.	61-648-270-203
---------------------------	----------------

NO. PROJ PROJECT NO.	REVISION	FEUILLE / SHT
	1	1 / 2

Appendix B

Dewatering phase construction pictures






A49 before pumping



A49 access road

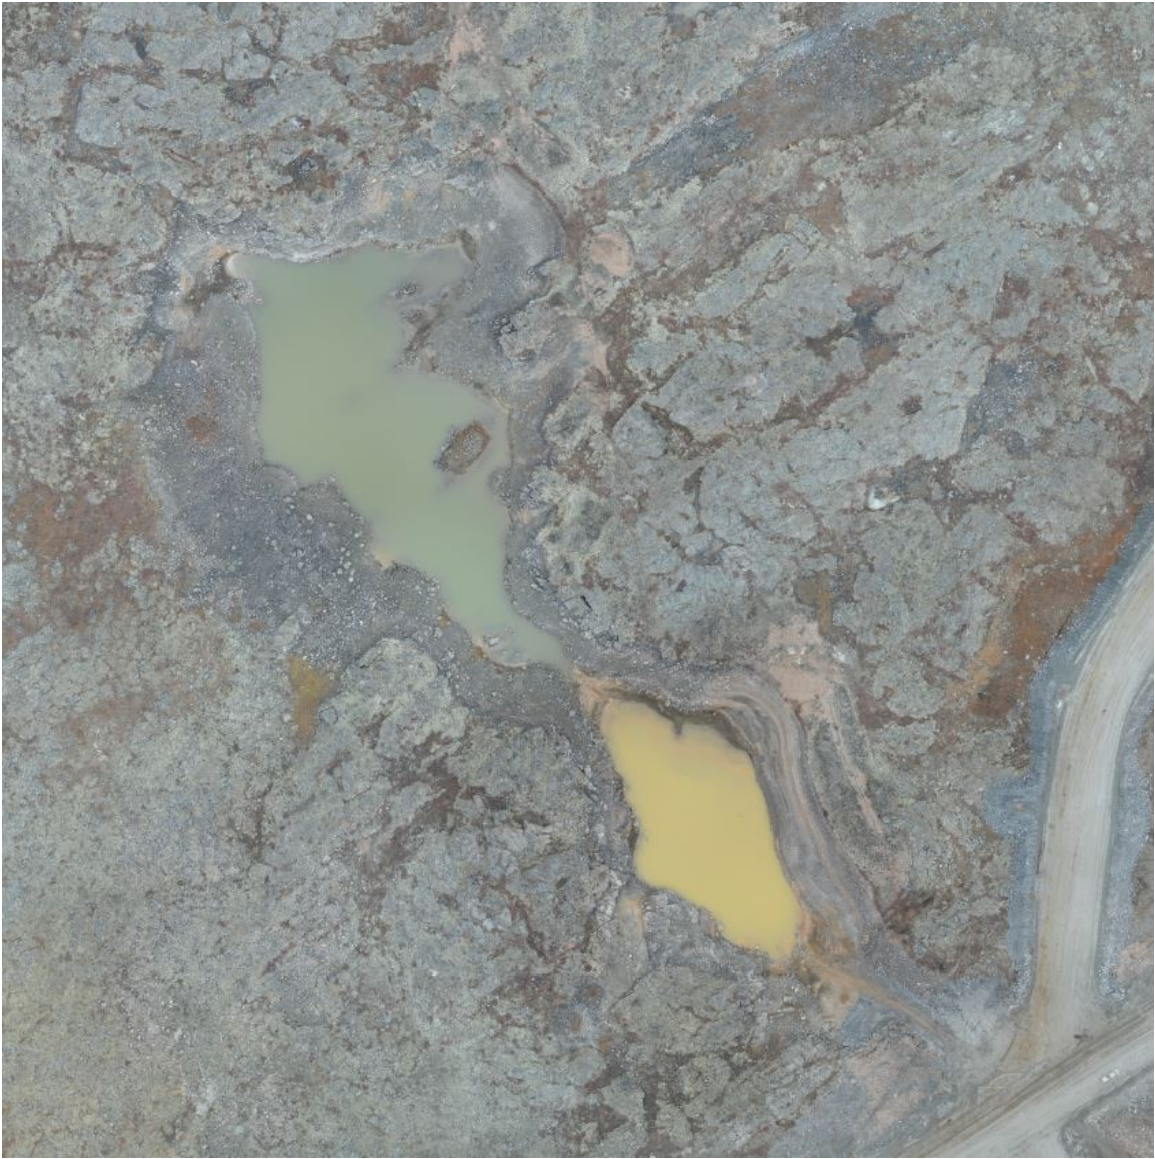

A49 after pumping



A47 before pumping




A47 pump and pad



A47 during pumping



A47 After pumping

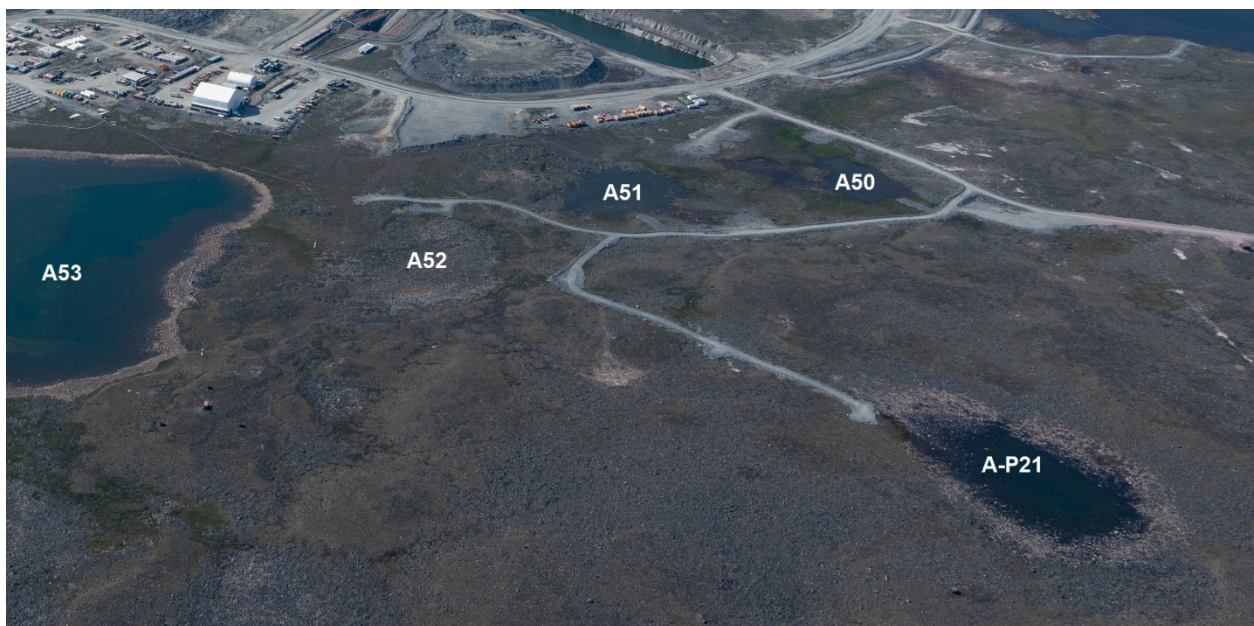

A50, A51, A52, A53, A-P21, before dewatering



A50 access road construction



A50 after dewatering



A-P21 pond before dewatering



A-P21 after pumping



A51 pond after dewatering



A53 pond before dewatering




A53 pond after dewatering

Appendix C

As-built drawings





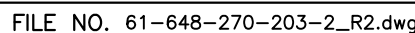

H

G

F

E

D

C

B

A

H

G

F

E

D

C

B

A

RUN OFF



LAKE A47-C




LAKE A47-B

CONNECTED OVER CERTAIN
WATER ELEVATION

SUCCION WAS MOVE
DEPENDING OF THE
ELEVATION OF THE WATER

4"X8"

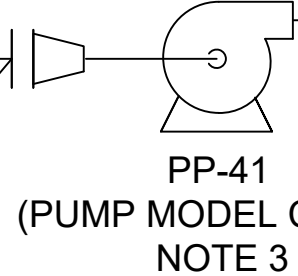

PP-41
(PUMP MODEL CD150)
NOTE 3

LINE WAS CONNECTED AS
THE SUMMARY REPORT


648-200-WFR-PC17-0206

RUN OFF



LAKE A47-A

648-350-WFR-PC17-0201

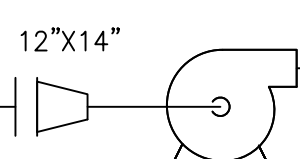

PP-42
(PUMP MODEL HL250)
NOTE 1

10"X8"

648-200-WFR-PC17-0200
(EXTENSION OF EXISTING LINE)

RUN OFF


648-200-WFR-PC11-0207



LAKE A49-A

CONNECTED OVER CERTAIN
WATER ELEVATION

648-350-WFR-PC17-0209

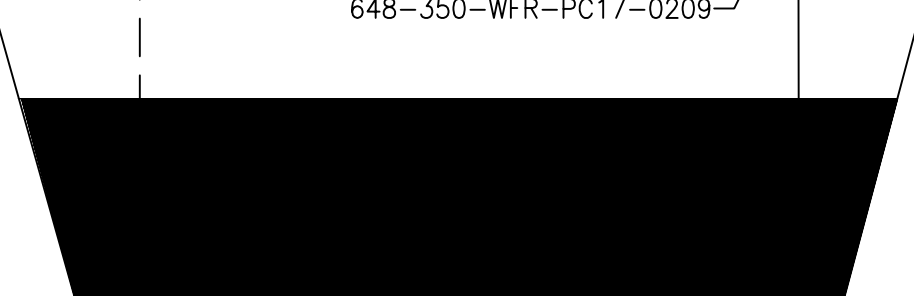

LAKE A49-B

648-200-WFR-MF-0214



10"X12"

TO WHALE TAIL
ATTENUATION POND

648-200-WFR-MF-0214

PLAN CLC
KEY PLAN



SNC • LAVALIN

Mining & Metallurgy
5500, des Galeries Blvd., bur. 200, Québec (Québec), Canada G2K 2E2
Telephone: (418) 691-5500, Fax: (418) 691-5987

PROJECT No	SUBDIVISION	SUBJECT	SERIAL	REV.
668284	8000	49, D1	0001	E02

NOTES GÉNÉRALES / GENERAL NOTES

NOTES :

1. DEPENDING ON THE DEWATERING SEQUENCE, PUMP PP-44 COULD BE RE-USED FOR PUMP PP-41.
2. TO DEWATER LAKE A47-C, TWO CD103 PUMPS ARE REQUIRED TO PROVIDE A TOTAL DEWATERING FLOW RATE OVER 300 M3/H APPROX. TO ENSURE THAT IT OPERATES WITHIN ITS PUMP CURVE. ALTERNATIVELY, A TRASH PUMP COULD BE USED TO DEWATER THIS LAKE IF AVAILABLE.
3. DEWATERING OF LAKE A49-A SHALL OCCUR AFTER DEWATERING OF LAKE A47-C.

LEGEND:

- PRIMARY STREAM
- - - - INTERMITTENT STREAM
- || FLANGED CONNECTION

L'INFORMATION D-CONTENUE EST LA PROPRIÉTÉ DE AGNICO EAGLE LTD ET NE DOIT ÊTRE RETENUE NI COMMUNIQUÉE NI RÉVÉLÉE NI UTILISÉE À D'AUTRE FIN QUE CELLE POUR LAQUELLE L'INFORMATION EST PRÉVUE.
THE INFORMATION HEREIN IS THE PROPERTY OF AGNICO EAGLE LTD. AND MUST BE RETURNED UPON REQUEST WITHOUT WRITTEN PERMISSION.
NO PORTION, WHOLE OR IN PART, MAY BE REPRODUCED OR TRANSMITTED IN ANY FORM OR BY ANY MEANS WITHOUT WRITTEN PERMISSION.
© AGNICO EAGLE LTD.

DESSINS EN RÉFÉRENCE / REFERENCE DRAWINGS

TITRE / TITLE	# DWG



AGNICO EAGLE

R3	2021-01-23	AS BUILT	J.G.	B.R.	F.B.
R2	2020-07-09	ISSUED FOR DESIGN	D.C.	A.L.N.	A.L.
R1	2020-05-15	ISSUED FOR DESIGN	D.C.	A.L.N.	A.L.
R0	2020-03-20	ISSUED FOR DESIGN	D.C.	A.L.N.	A.L.
RB	2020-03-16	ISSUED FOR CLIENT COMMENTS	D.C.	A.L.N.	A.L.
R4	2021-03-02	AS BUILT WITH OP MODIF	J.G.	B.R.	F.B.
REV.	DATE	DESCRIPTION	PAR/REV	APP.	CLIENT

REVISIONS

TITRE / TITLE
AGNICO EAGLE - AMARUQ DIVISION
648 - DEWATERING

200 - PROCESS FLOWSHEET
AMARUQ DEWATERING PHASE
LAKES A47 & A49

DESSINÉ PAR
DRAWN BY M. MOVILA

DATE
2020-03-02

VÉRIFIÉ PAR
CHECKED BY D. CHEN

DATE
2020-03-02

APPROUVÉ PAR
APPROVED BY A.L. NGUYEN

DATE
2020-03-02

ECHELLE
SCALE

DATE
2020-03-02

NO. DESSIN
DRAWING NO. 61-648-200-202

NO. PROJET
PROJECT NO. 6127

REVISION
R4

FEUILLE / SHEET
1 / 1

H

G

F

E

D

C

B

A

H

G

F


E

D

C

B

A

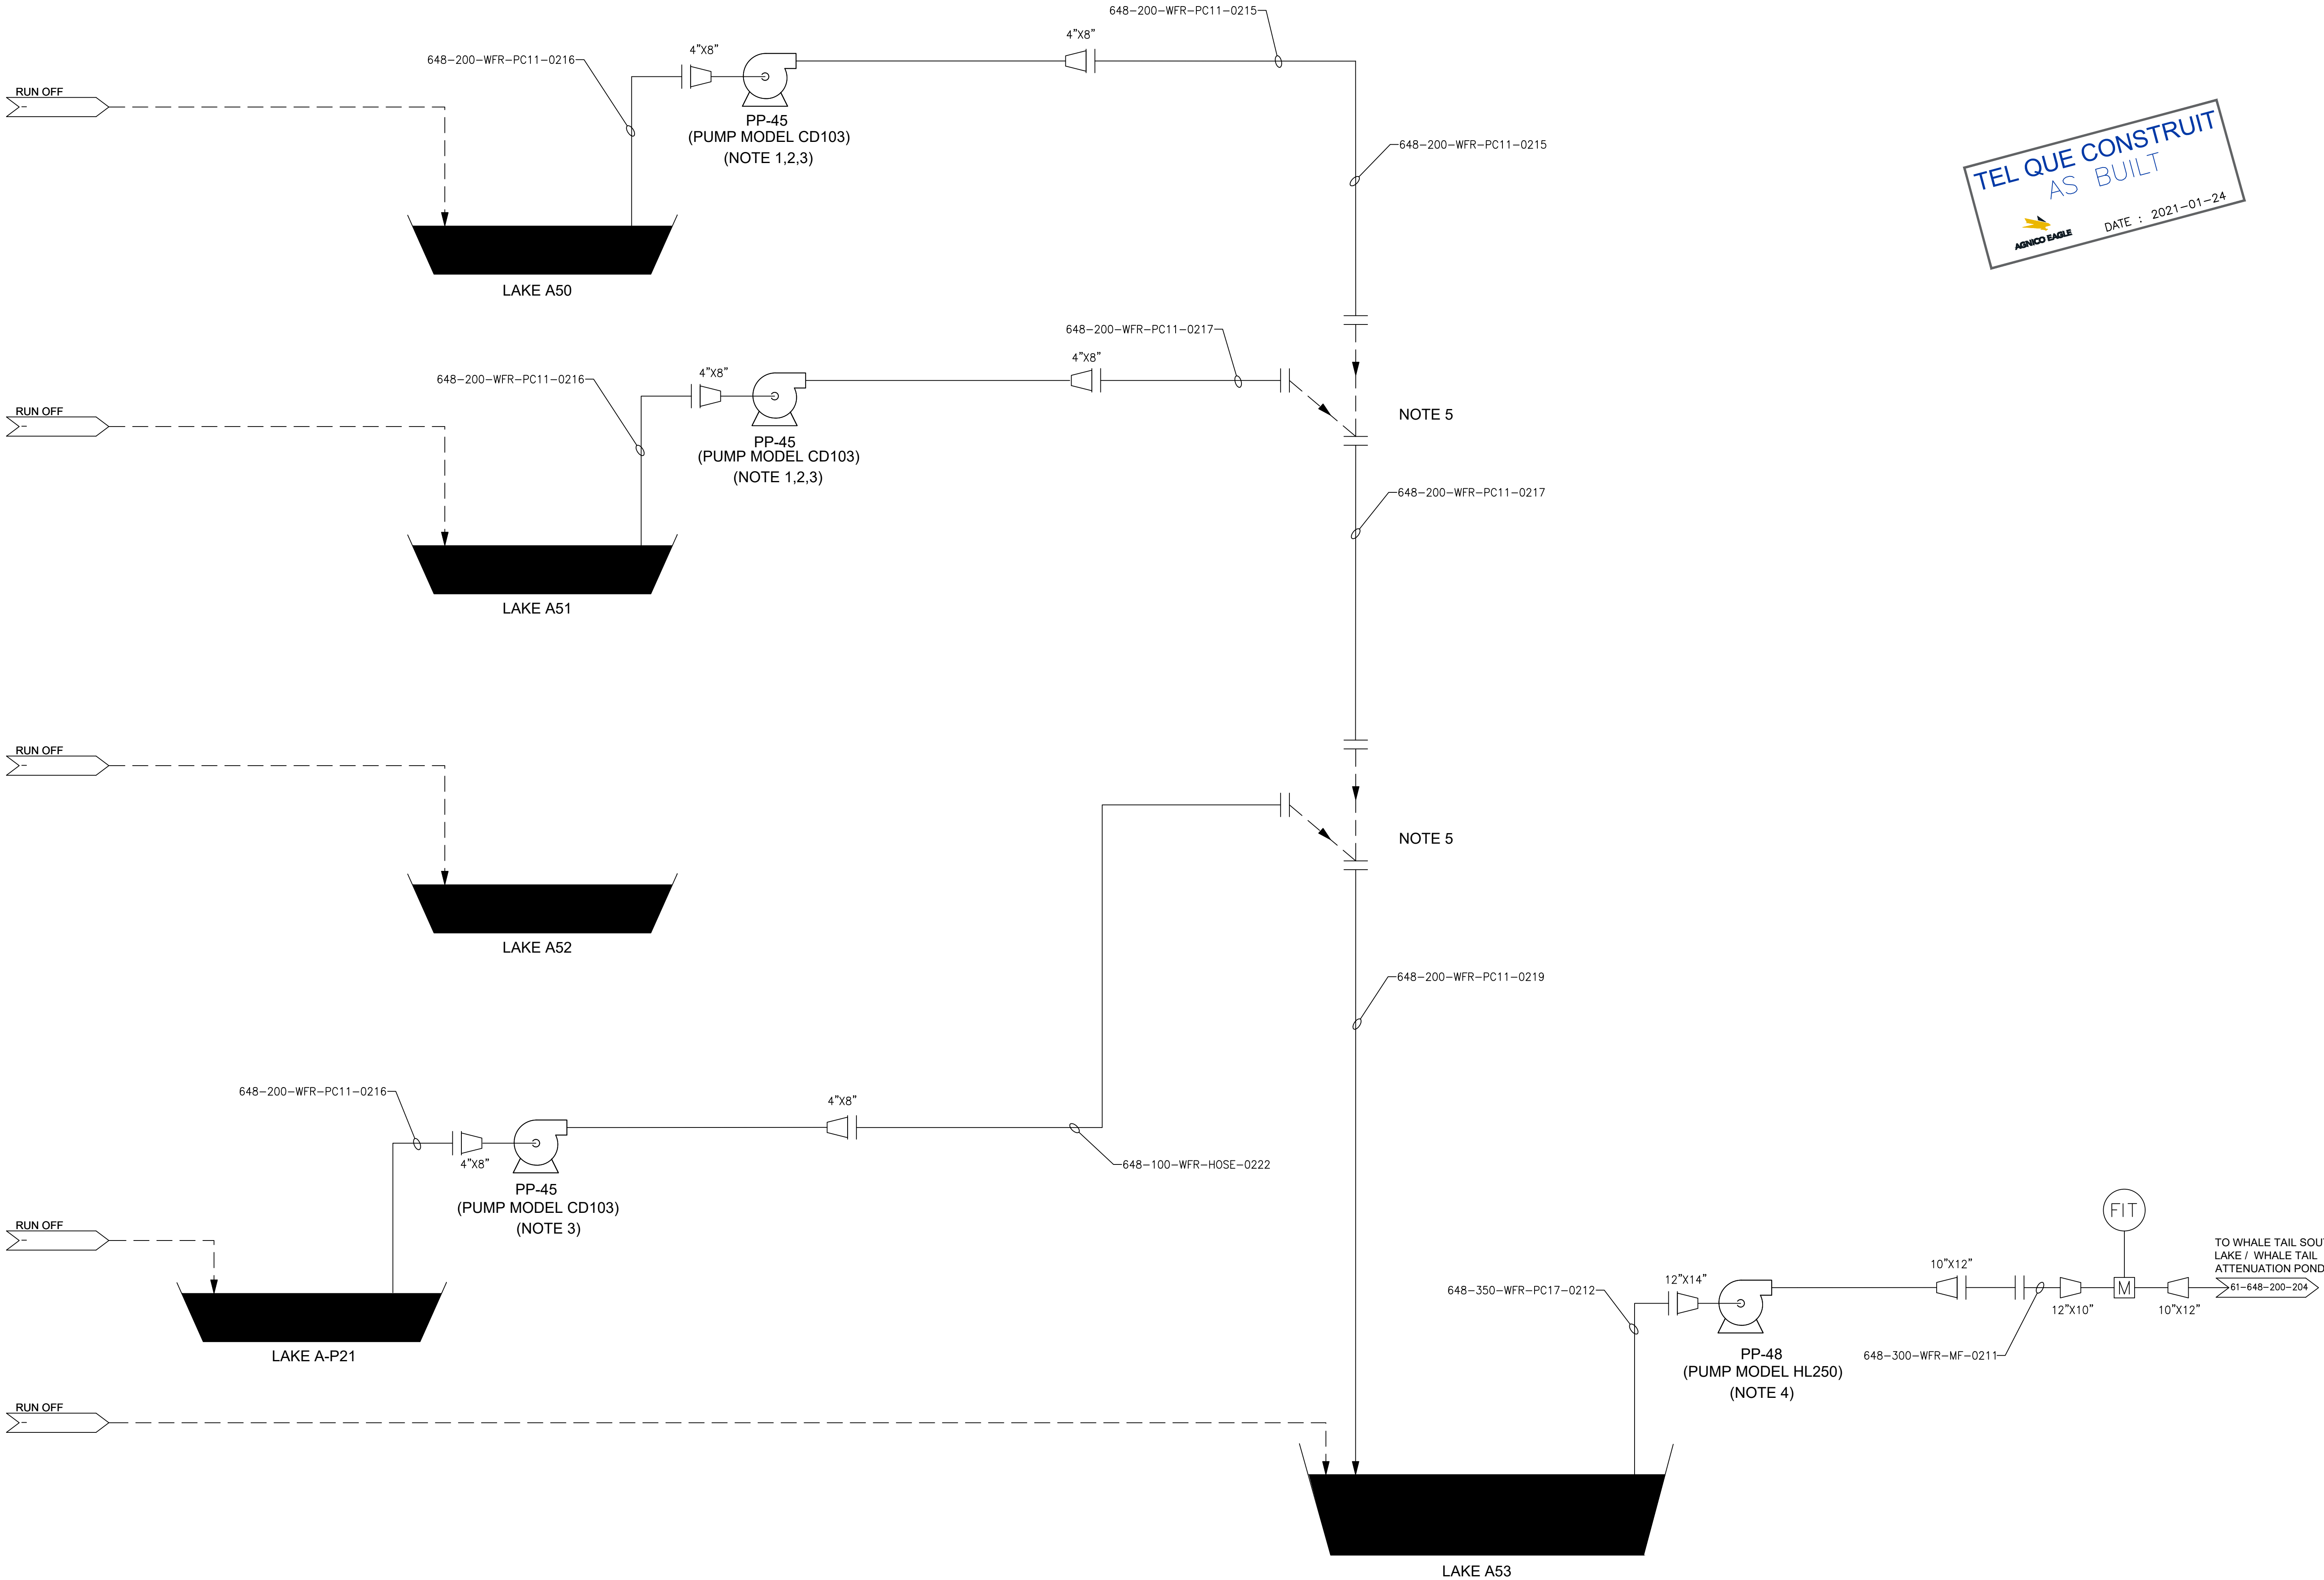

PLAN CLC
KEY PLAN



Mining & Metallurgy
5500, des Galeries Blvd., bur. 200, Québec (Québec), Canada G2K 2E2
Telephone: (418) 691-5500, Fax: (418) 691-6987

PROJECT No	SUBDIVISION	SUBJECT	SERIAL	REV.
668284	8000	49, D1	0002	E02

NOTES GÉNÉRALES / GENERAL NOTES

NOTES :

- PUMP PP45 AND PP46 SHALL BE USED TO DEWATER SEQUENTIALLY LAKE A50, A51 AND A52.
- TWO CD103 PUMPS ARE REQUIRED TO PROVIDE A TOTAL DEWATERING FLOW RATE OVER 300 M3/H APPROX. TO ENSURE THAT IT OPERATES WITHIN ITS PUMP CURVE.
- DEPENDING ON THE LAKE DEWATERING SEQUENCE, PUMPS PP41 AND PP43 COULD BE USED TO DEWATER LAKE A50, A51, A52 AND A-P21.
- DEPENDING ON THE LAKE DEWATERING SEQUENCE, PP40 OR PP44 COULD BE USED TO DEWATER LAKE A53.
- CONNECTION TO BY-PASS LINES SHALL BE DONE BY FLANGE TO FLANGE DISCONNECTION AND RECONNECTION.

LEGEND:

- PRIMARY STREAM
- INTERMITTENT STREAM
- FLANGED CONNECTION

L'INFORMATION D-CONTENUE EST LA PROPRIÉTÉ DE AGNICO EAGLE LTD. ET NE DOIT ÊTRE RETENUE NI COMMUNIQUÉE NI RÉVÉLÉE NI UTILISÉE À D'AUTRE FIN QUE CELLE POUR LAQUELLE L'INFORMATION EST PRÉSENTÉE. TOUTE REPRODUCTION, EN TOUTE LANGUE, EST INTERDITE.

THE INFORMATION HEREIN IS THE PROPERTY OF AGNICO EAGLE LTD. AND MUST BE RETURNED UPON REQUEST WITHOUT WRITTEN PERMISSION. NO COPYING, REPRODUCTION, IN ANY LANGUAGE, IS PERMITTED FOR ANY USE EXCEPT THAT FOR WHICH IT IS LOANED AND PROVIDED.

© AGNICO EAGLE LTD.

DESSINS EN RÉFÉRENCE / REFERENCE DRAWINGS

TITRE / TITLE	# DWG



AGNICO EAGLE

R3	2021-01-23	AS BUILT	J.G.	B.R.	F.B.
R2	2020-07-09	ISSUED FOR DESIGN	D.C.	A.L.N.	A.L.
R1	2020-03-15	ISSUED FOR DESIGN	D.C.	A.L.N.	A.L.
RO	2020-03-20	ISSUED FOR DESIGN	D.C.	A.L.N.	A.L.
RB	2020-03-06	ISSUED FOR CLIENT COMMENTS	D.C.	A.L.N.	A.L.
RA	2020-03-02	ISSUED FOR COMMENTS	D.C.	A.L.N.	A.L.
REV.	DATE	DESCRIPTION	PAR/REV	APP.	CLIENT

REVISIONS

TITRE / TITLE
AGNICO EAGLE - AMARUQ DIVISION
648 - DEWATERING

200 - PROCESS FLOWSHEET
AMARUQ DEWATERING PHASE
LAKES A50, A51, A52 & A53

DESSINÉ PAR DRAWN BY	M. MOVILA	DATE 2020-03-02
VÉRIFIÉ PAR CHECKED BY	D. CHEN	2020-03-02
APPROUVÉ PAR APPROVED BY	A.L. NGUYEN	2020-03-02


ECHELLE
SCALE

DATE
2020-03-02

NO. DESSIN
DRAWING NO.

61-648-200-203

NO. PROJET PROJECT NO.	REVISION	FEUILLE / SHT
6127	R3	1 / 1

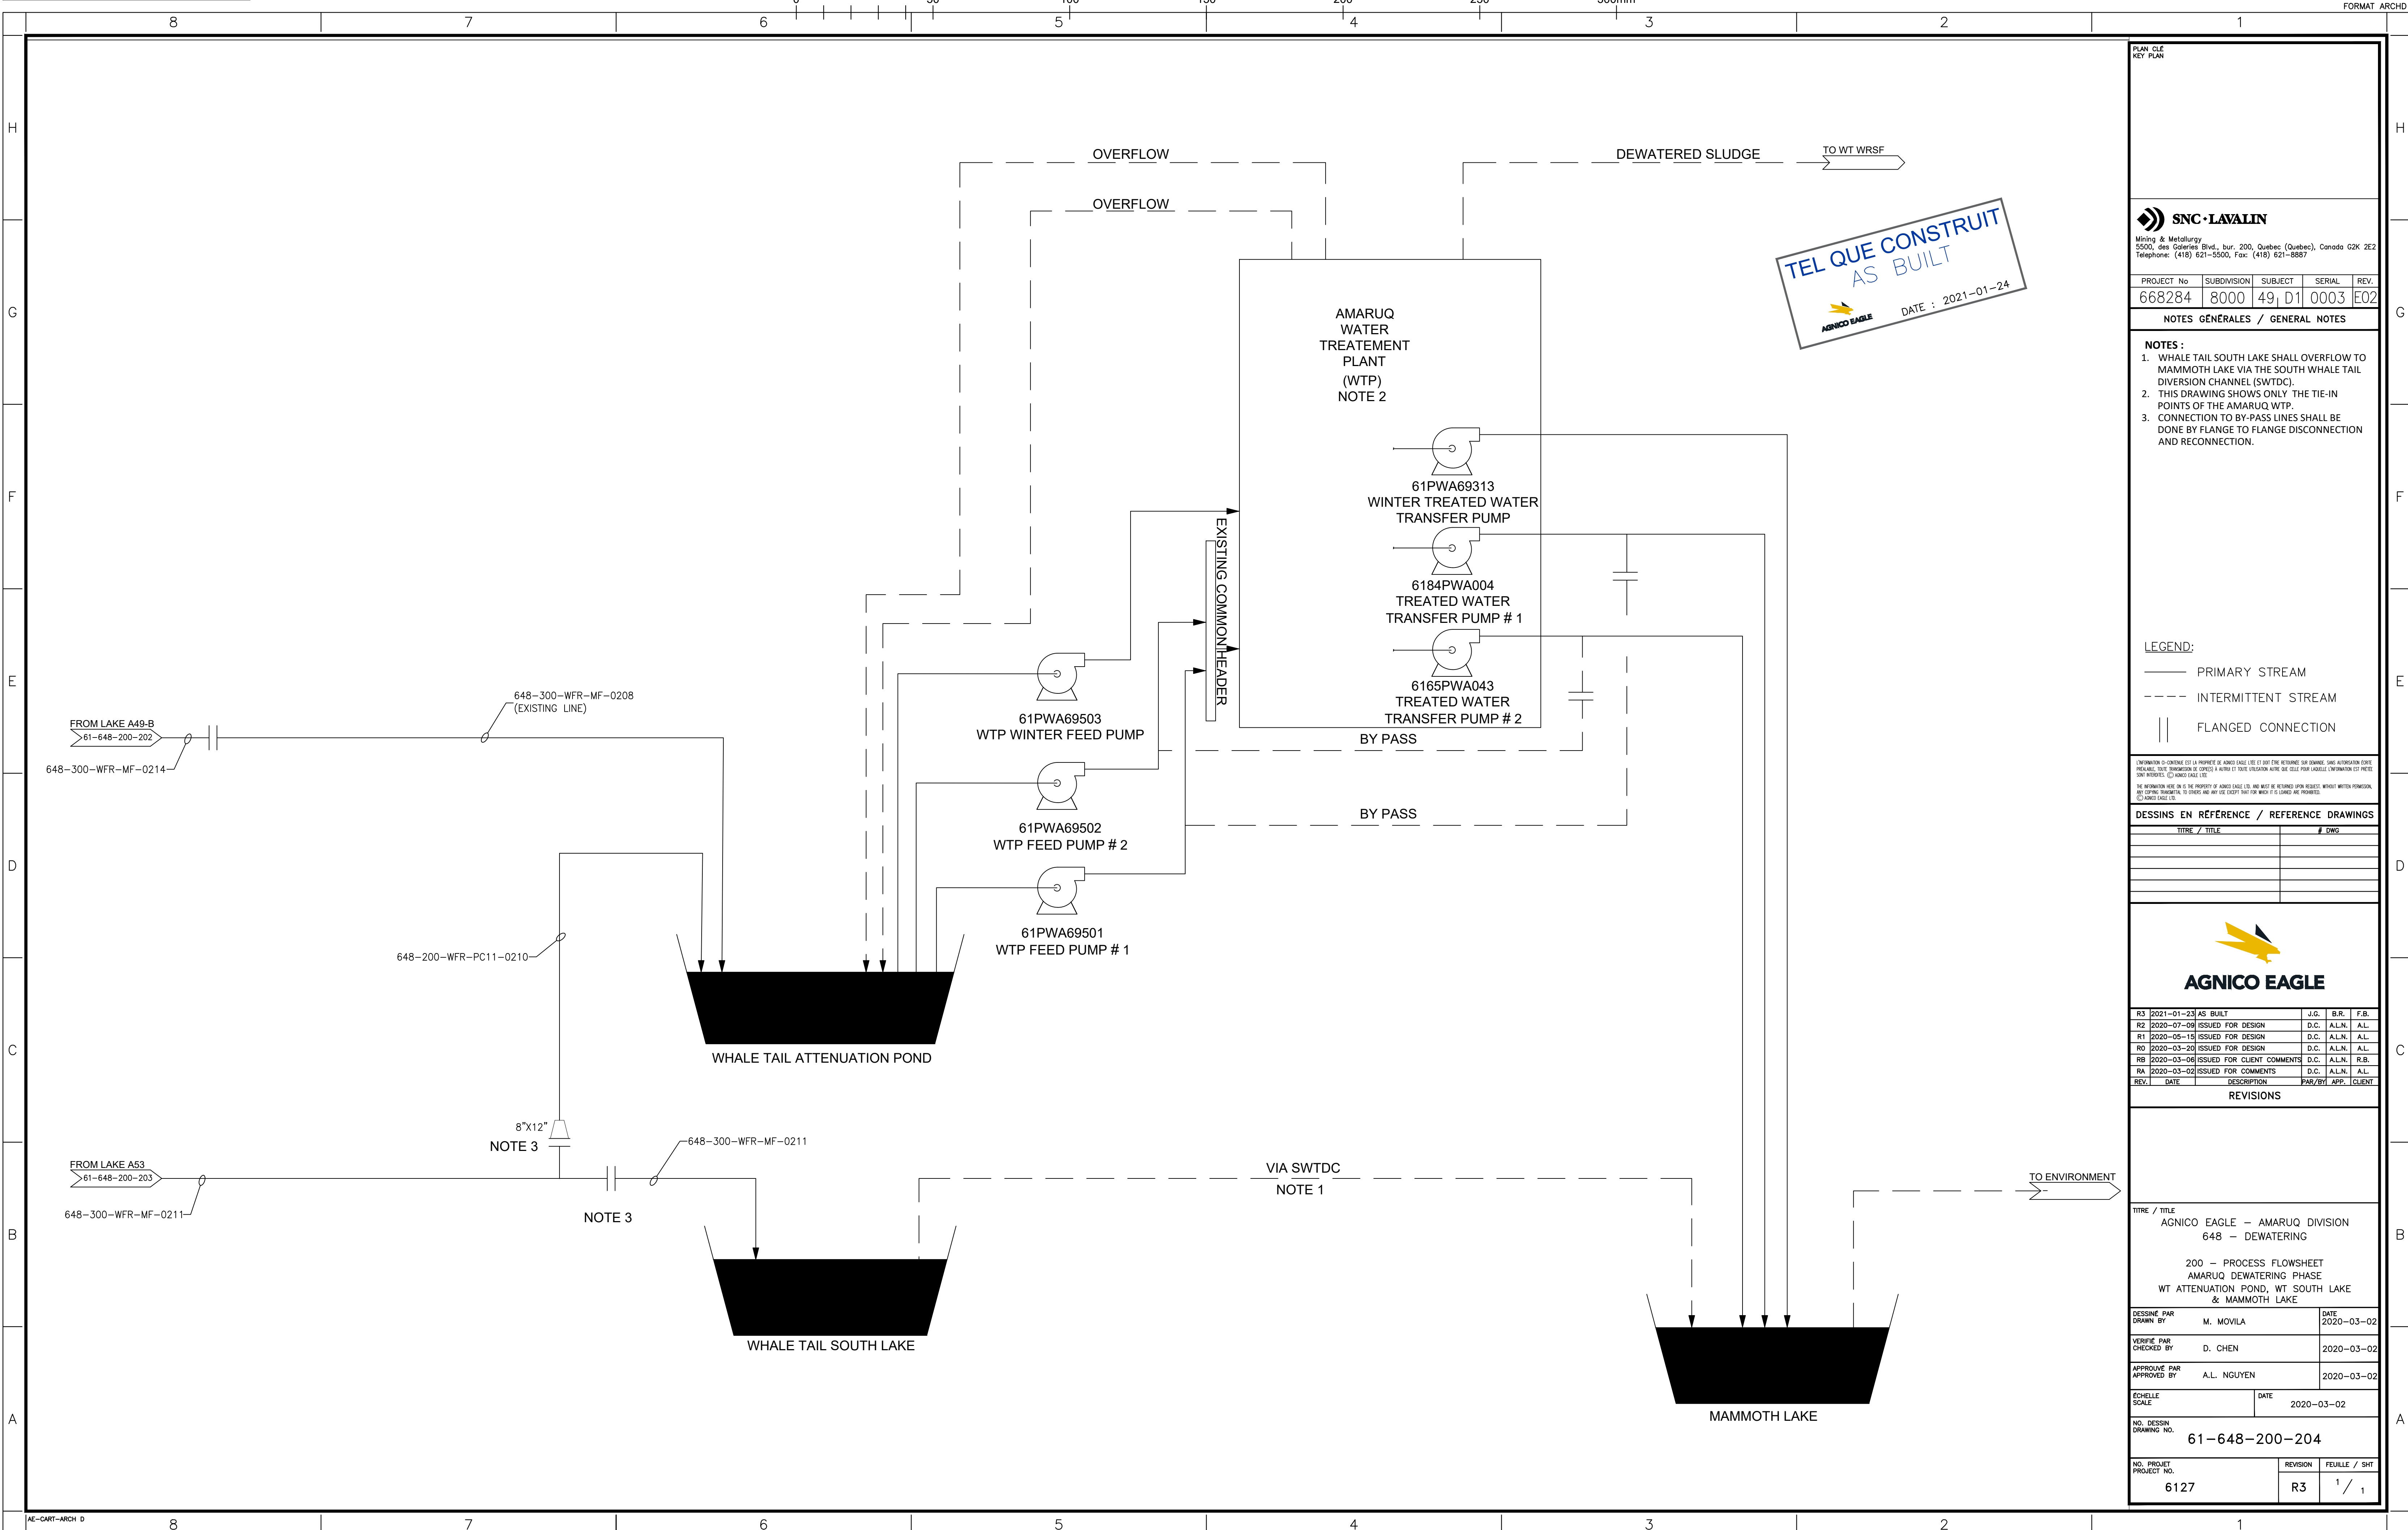

PLAN CLC
KEY PLAN

SNC-LAVALIN
Mining & Metallurgy
5500, des Galeries Blvd., bur. 200, Québec (Québec), Canada G2K 2E2
Telephone: (418) 621-5500, Fax: (418) 621-5597

PROJECT No	SUBDIVISION	SUBJECT	SERIAL	REV.
668284	8000	49, D1	0003	E02

NOTES GÉNÉRALES / GENERAL NOTES

- NOTES :**
- WHALE TAIL SOUTH LAKE SHALL OVERFLOW TO MAMMOTH LAKE VIA THE SOUTH WHALE TAIL DIVERSION CHANNEL (SWTDC).
 - THIS DRAWING SHOWS ONLY THE TIE-IN POINTS OF THE AMARUQ WTP.
 - CONNECTION TO BY-PASS LINES SHALL BE DONE BY FLANGE TO FLANGE DISCONNECTION AND RECONNECTION.

LEGEND:

- PRIMARY STREAM
- INTERMITTENT STREAM
- FLANGED CONNECTION

L'INFORMATION Q-CONTIENUE EST LA PROPRIÉTÉ DE AGNICO EAGLE LTD. ET NE DOIT ÊTRE RETENUE, NI COMMUNIQUÉE, NI REPRODUE, NI UTILISÉE À D'AUTRE FIN QUE CELLE POUR LAQUELLE L'INFORMATION EST PRÉVUE.
L'INFORMATION Q-CONTIENUE EST LA PROPRIÉTÉ DE AGNICO EAGLE LTD. ET NE DOIT ÊTRE RETENUE, NI COMMUNIQUÉE, NI REPRODUE, NI UTILISÉE À D'AUTRE FIN QUE CELLE POUR LAQUELLE L'INFORMATION EST PRÉVUE.

DESSINS EN RÉFÉRENCE / REFERENCE DRAWINGS

TITRE / TITLE	# DWG



AGNICO EAGLE

R3	2021-01-23	AS BUILT	J.G.	B.R.	F.B.
R2	2020-07-09	ISSUED FOR DESIGN	D.C.	A.L.N.	A.L.
R1	2020-05-15	ISSUED FOR DESIGN	D.C.	A.L.N.	A.L.
RO	2020-03-20	ISSUED FOR DESIGN	D.C.	A.L.N.	A.L.
RB	2020-03-06	ISSUED FOR CLIENT COMMENTS	D.C.	A.L.N.	R.B.
RA	2020-03-02	ISSUED FOR COMMENTS	D.C.	A.L.N.	A.L.
REV.	DATE	DESCRIPTION	PAR/BY	APP.	CLIENT

REVISIONS

REVISIONS

TITRE / TITLE
AGNICO EAGLE - AMARUQ DIVISION
648 - DEWATERING

200 - PROCESS FLOWSHEET
AMARUQ DEWATERING PHASE
WT ATTENUATION POND, WT SOUTH LAKE
& MAMMOTH LAKE

DESSINÉ PAR DRAWN BY	M. MOVILA	DATE 2020-03-02
VÉRIFIÉ PAR CHECKED BY	D. CHEN	2020-03-02
APPROUVÉ PAR APPROVED BY	A.L. NGUYEN	2020-03-02




ÉCHELLE
SCALE

DATE 2020-03-02


NO. DESSIN
DRAWING NO.

61-648-200-204

NO. PROJET PROJECT NO.	REVISION	FEUILLE / SHEET
6127	R3	1 / 1

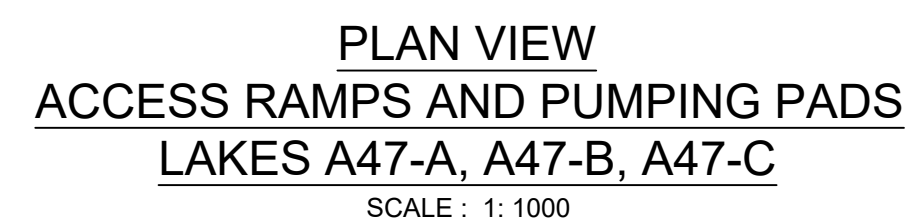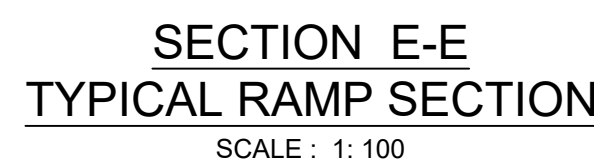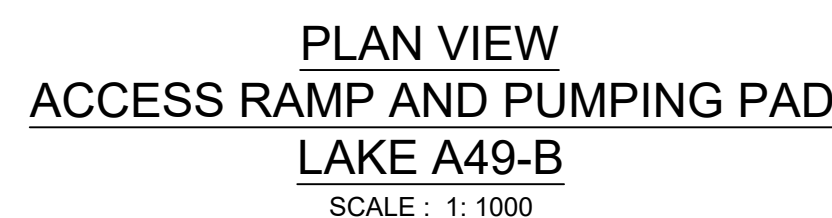

ESTIMATED IN-PLACE QUANTITIES CONSTRUCTION - ACCESS RAMPS AND PADS		
Lake (Access ramp and pad)	Granular fill, 0-3/4" (final grade, thickness 200 mm) (m³)	Run-of-mine rockfill (0-1000 mm) (m³)
A49-B	341.8	8945.2
A47-A	935.4	27177.2
A47-B	32.46	2275.7
A47-C	34.5	1082.6

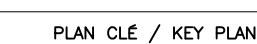NOTES GÉNÉRALES / GENERAL NOTES

NOTES

1. GROUND TOPOGRAPHY WAS PROVIDED BY AEM.
2. ALL UNITS ARE IN METERS.
3. SAFETY BERMS SHALL BE BASED ON THE MINE ACT REQUIREMENTS.
4. STABILITY OF THE RAMPS TO BE ASSESSED ON A DAILY BASIS BY QUALIFIED GEOTECHNICAL PERSONNEL DURING CONSTRUCTION. WORK SHALL BE SUSPENDED IF SIGNS OF INSTABILITY ARE OBSERVED.
5. INITIAL ROCK FILL MATERIAL PLACEMENT IN WATER, AGAINST THE NATURAL SOIL OF THE LAKE, MUST BE PLACED USING A SHOVEL.
6. FOR ALL ROCK FILL PLACEMENT OVER WATER, SOME FOUNDATION PREPARATION MIGHT BE NEEDED DEPENDING ON NATURE AND THICKNESS OF SEDIMENT ENCOUNTERED

LEGEND



RUN-OF-MINE
ROCKFILL 0-1000 MM

L'INFORMATION CI-CONTENUE EST LA PROPRIÉTÉ DE ADMCO EAGLE LTD. ET DOIT ÊTRE RETOURNÉE SUR DEMANDE, SANS AUTORISATION ÉCRITE PRÉALABLE, TOUTE TRANSMISSION DE COPIE(S) À AUTRUI ET TOUTE UTILISATION AUTRE QUE CELLE POUR LAQUELLE L'INFORMATION EST PRÉSENTÉE SONT INTERDITES. © ADMCO EAGLE LTD.

THE INFORMATION HERE ON IS THE PROPERTY OF ADMCO EAGLE LTD. AND MUST BE RETURNED UPON REQUEST, WITHOUT WRITTEN PERMISSION ANY COPYING, TRANSMITTING TO OTHERS AND ANY USE EXCEPT THAT FOR WHICH IT IS LOANED ARE PROHIBITED.

DESSINS EN RÉFÉRENCE / REFERENCE DRAWINGS

TITRE / TITLE	# DWG
---	---
---	---
AGNICO EAGLE

[illegible]

REVISIONS

TITLE / TITLE

0
648 - DEWATERING
230 - GENERAL EARTHWORKS

PLAN VIEW, PROFILES AND TYPICAL SECTIONS
AMARUQ DEWATERING PHASE
LAKES A47-A, A47-B, A47-C AND A47-D
ACCESS RAMPS AND PUMPING PLANTS

DESSINÉ PAR DRAWN BY	MARIUS MOVILA	DATE 2020-03-
-------------------------	---------------	------------------


VERIFIE PAR CHECKED BY	DARIUSH RASTGOU/ DAN CHEN	2020-03-
---------------------------	---------------------------	----------

APPROUVÉ PAR APPROVED BY	ANH-LONG NGUYEN	2020-03-
-----------------------------	-----------------	----------

ECHELLE SCALE	AS SHOWN	DATE 2020-03-23
NO. DESSIN		

DRAWING NO. 61-648-230-200

NO. PROJ. PROJECT NO.	REVISION	FEUILLE / SH
	R1	1 / 2

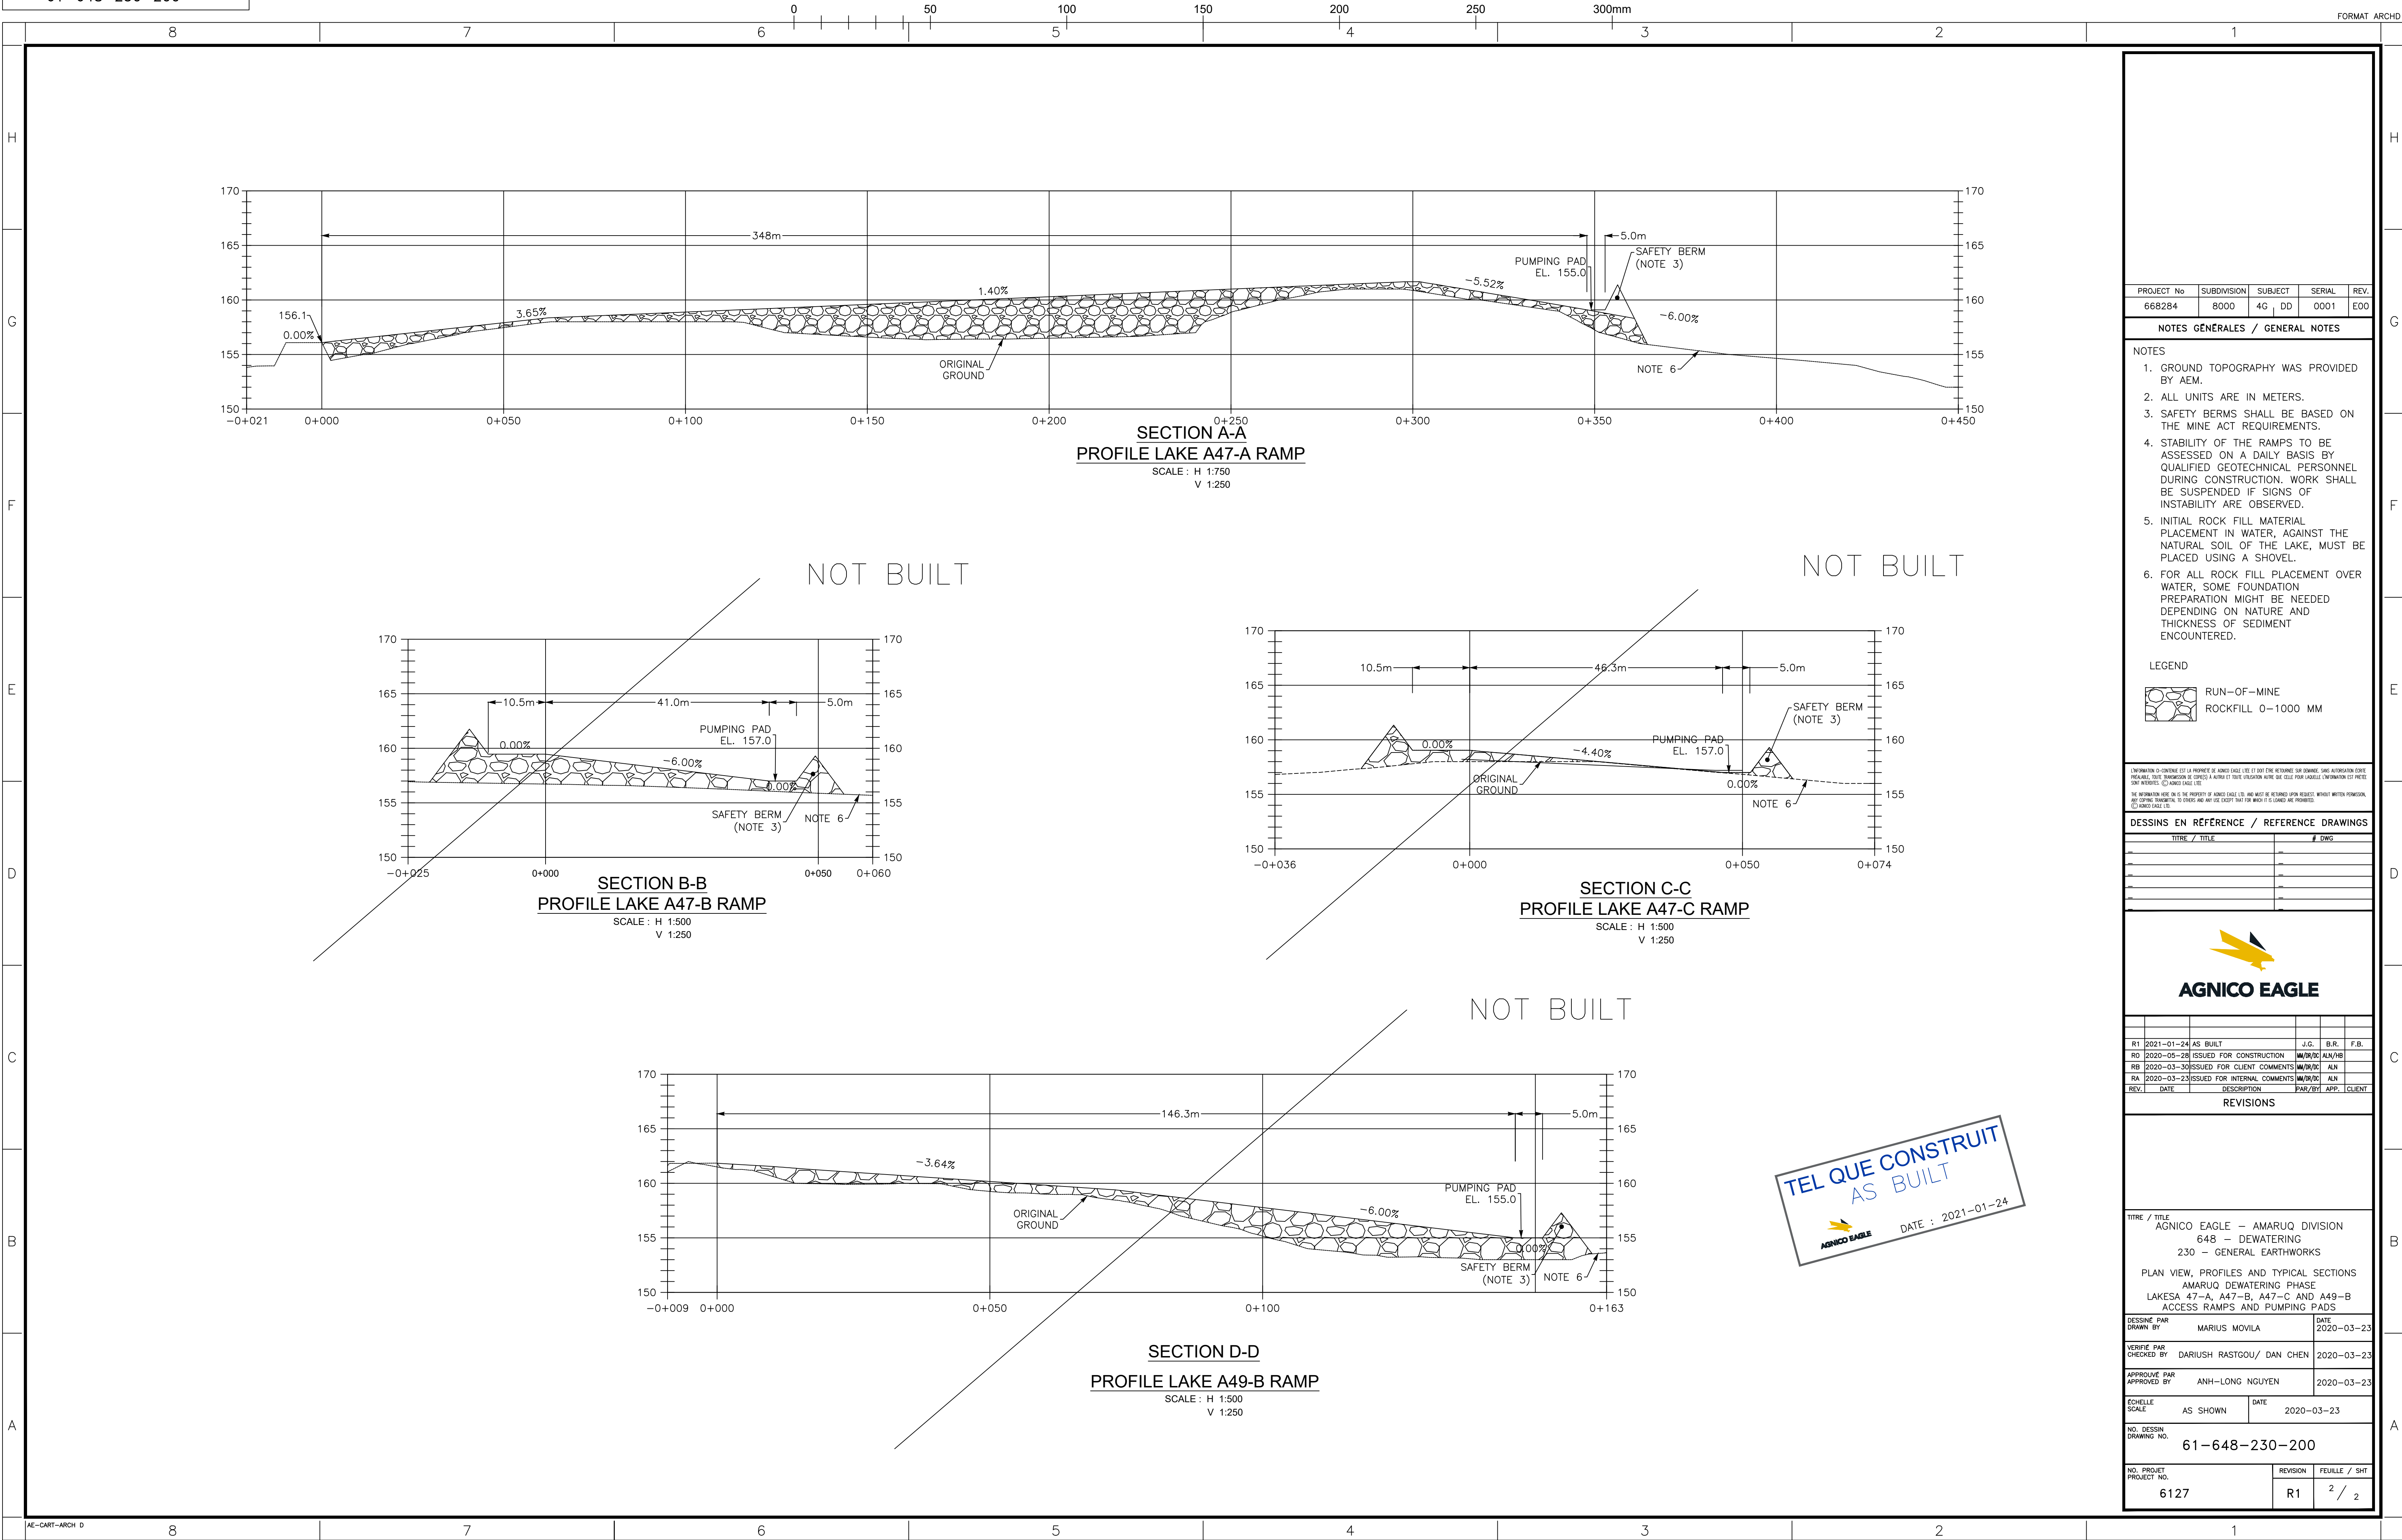


PROJECT No	SUBDIVISION	SUBJECT	SERIAL	REV.
668284	8000	4G DD	0001	E00

NOTES GÉNÉRALES / GENERAL NOTES

NOTES

- GROUND TOPOGRAPHY WAS PROVIDED BY AEM.
- ALL UNITS ARE IN METERS.
- SAFETY BERMS SHALL BE BASED ON THE MINE ACT REQUIREMENTS.
- STABILITY OF THE RAMPS TO BE ASSESSED ON A DAILY BASIS BY QUALIFIED GEOTECHNICAL PERSONNEL DURING CONSTRUCTION. WORK SHALL BE SUSPENDED IF SIGNS OF INSTABILITY ARE OBSERVED.
- INITIAL ROCK FILL MATERIAL PLACEMENT IN WATER, AGAINST THE NATURAL SOIL OF THE LAKE, MUST BE PLACED USING A SHOVEL.
- FOR ALL ROCK FILL PLACEMENT OVER WATER, SOME FOUNDATION PREPARATION MIGHT BE NEEDED DEPENDING ON NATURE AND THICKNESS OF SEDIMENT ENCOUNTERED.

LEGEND

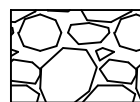

INFORMATION IS CONTAINED HEREIN IS THE PROPERTY OF AGNICO EAGLE LTD. AND MUST BE RETURNED UPON REQUEST WITHOUT WRITTEN PERMISSION. ANY COPIES, REPRODUCTIONS OR OTHER USES WITHOUT WRITTEN PERMISSION ARE STRICTLY PROHIBITED. IT IS THE USER'S RESPONSIBILITY TO OBTAIN AND USE THE DATA FOR WHICH IT IS LOANED AND PROVIDED.

DESSINS EN RÉFÉRENCE / REFERENCE DRAWINGS

TITRE / TITLE	# DWG



REV.	DATE	DESCRIPTION	PAR/BY	APP.	CLIENT
R1	2021-01-24	AS BUILT	J.G.	B.R.	F.B.
R0	2020-05-28	ISSUED FOR CONSTRUCTION	MM/RJC	ALN/HB	
RB	2020-03-30	ISSUED FOR CLIENT COMMENTS	MM/RJC	ALN	
RA	2020-03-23	ISSUED FOR INTERNAL COMMENTS	MM/RJC	ALN	

REVISIONS


TITRE / TITLE
AGNICO EAGLE - AMARUQ DIVISION
648 - DEWATERING
230 - GENERAL EARTHWORKS
PLAN VIEW, PROFILES AND TYPICAL SECTIONS
AMARUQ DEWATERING PHASE
LAKESA 47-A, A47-B, A47-C AND A49-B
ACCESS RAMPS AND PUMPING PADS

DESSINÉ PAR DRAWN BY	MARIUS MOVILA	DATE 2020-03-23
VÉRIFIÉ PAR CHECKED BY	DARIUSH RASTGOU/ DAN CHEN	2020-03-23
APPROUVÉ PAR APPROVED BY	ANH-LONG NGUYEN	2020-03-23


ÉCHELLE SCALE	AS SHOWN	DATE 2020-03-23
------------------	----------	--------------------

NO. DESSIN
DRAWING NO.
61-648-230-200

NO. PROJET PROJECT NO.	REVISION	FEUILLE / SHEET
6127	R1	2 / 2

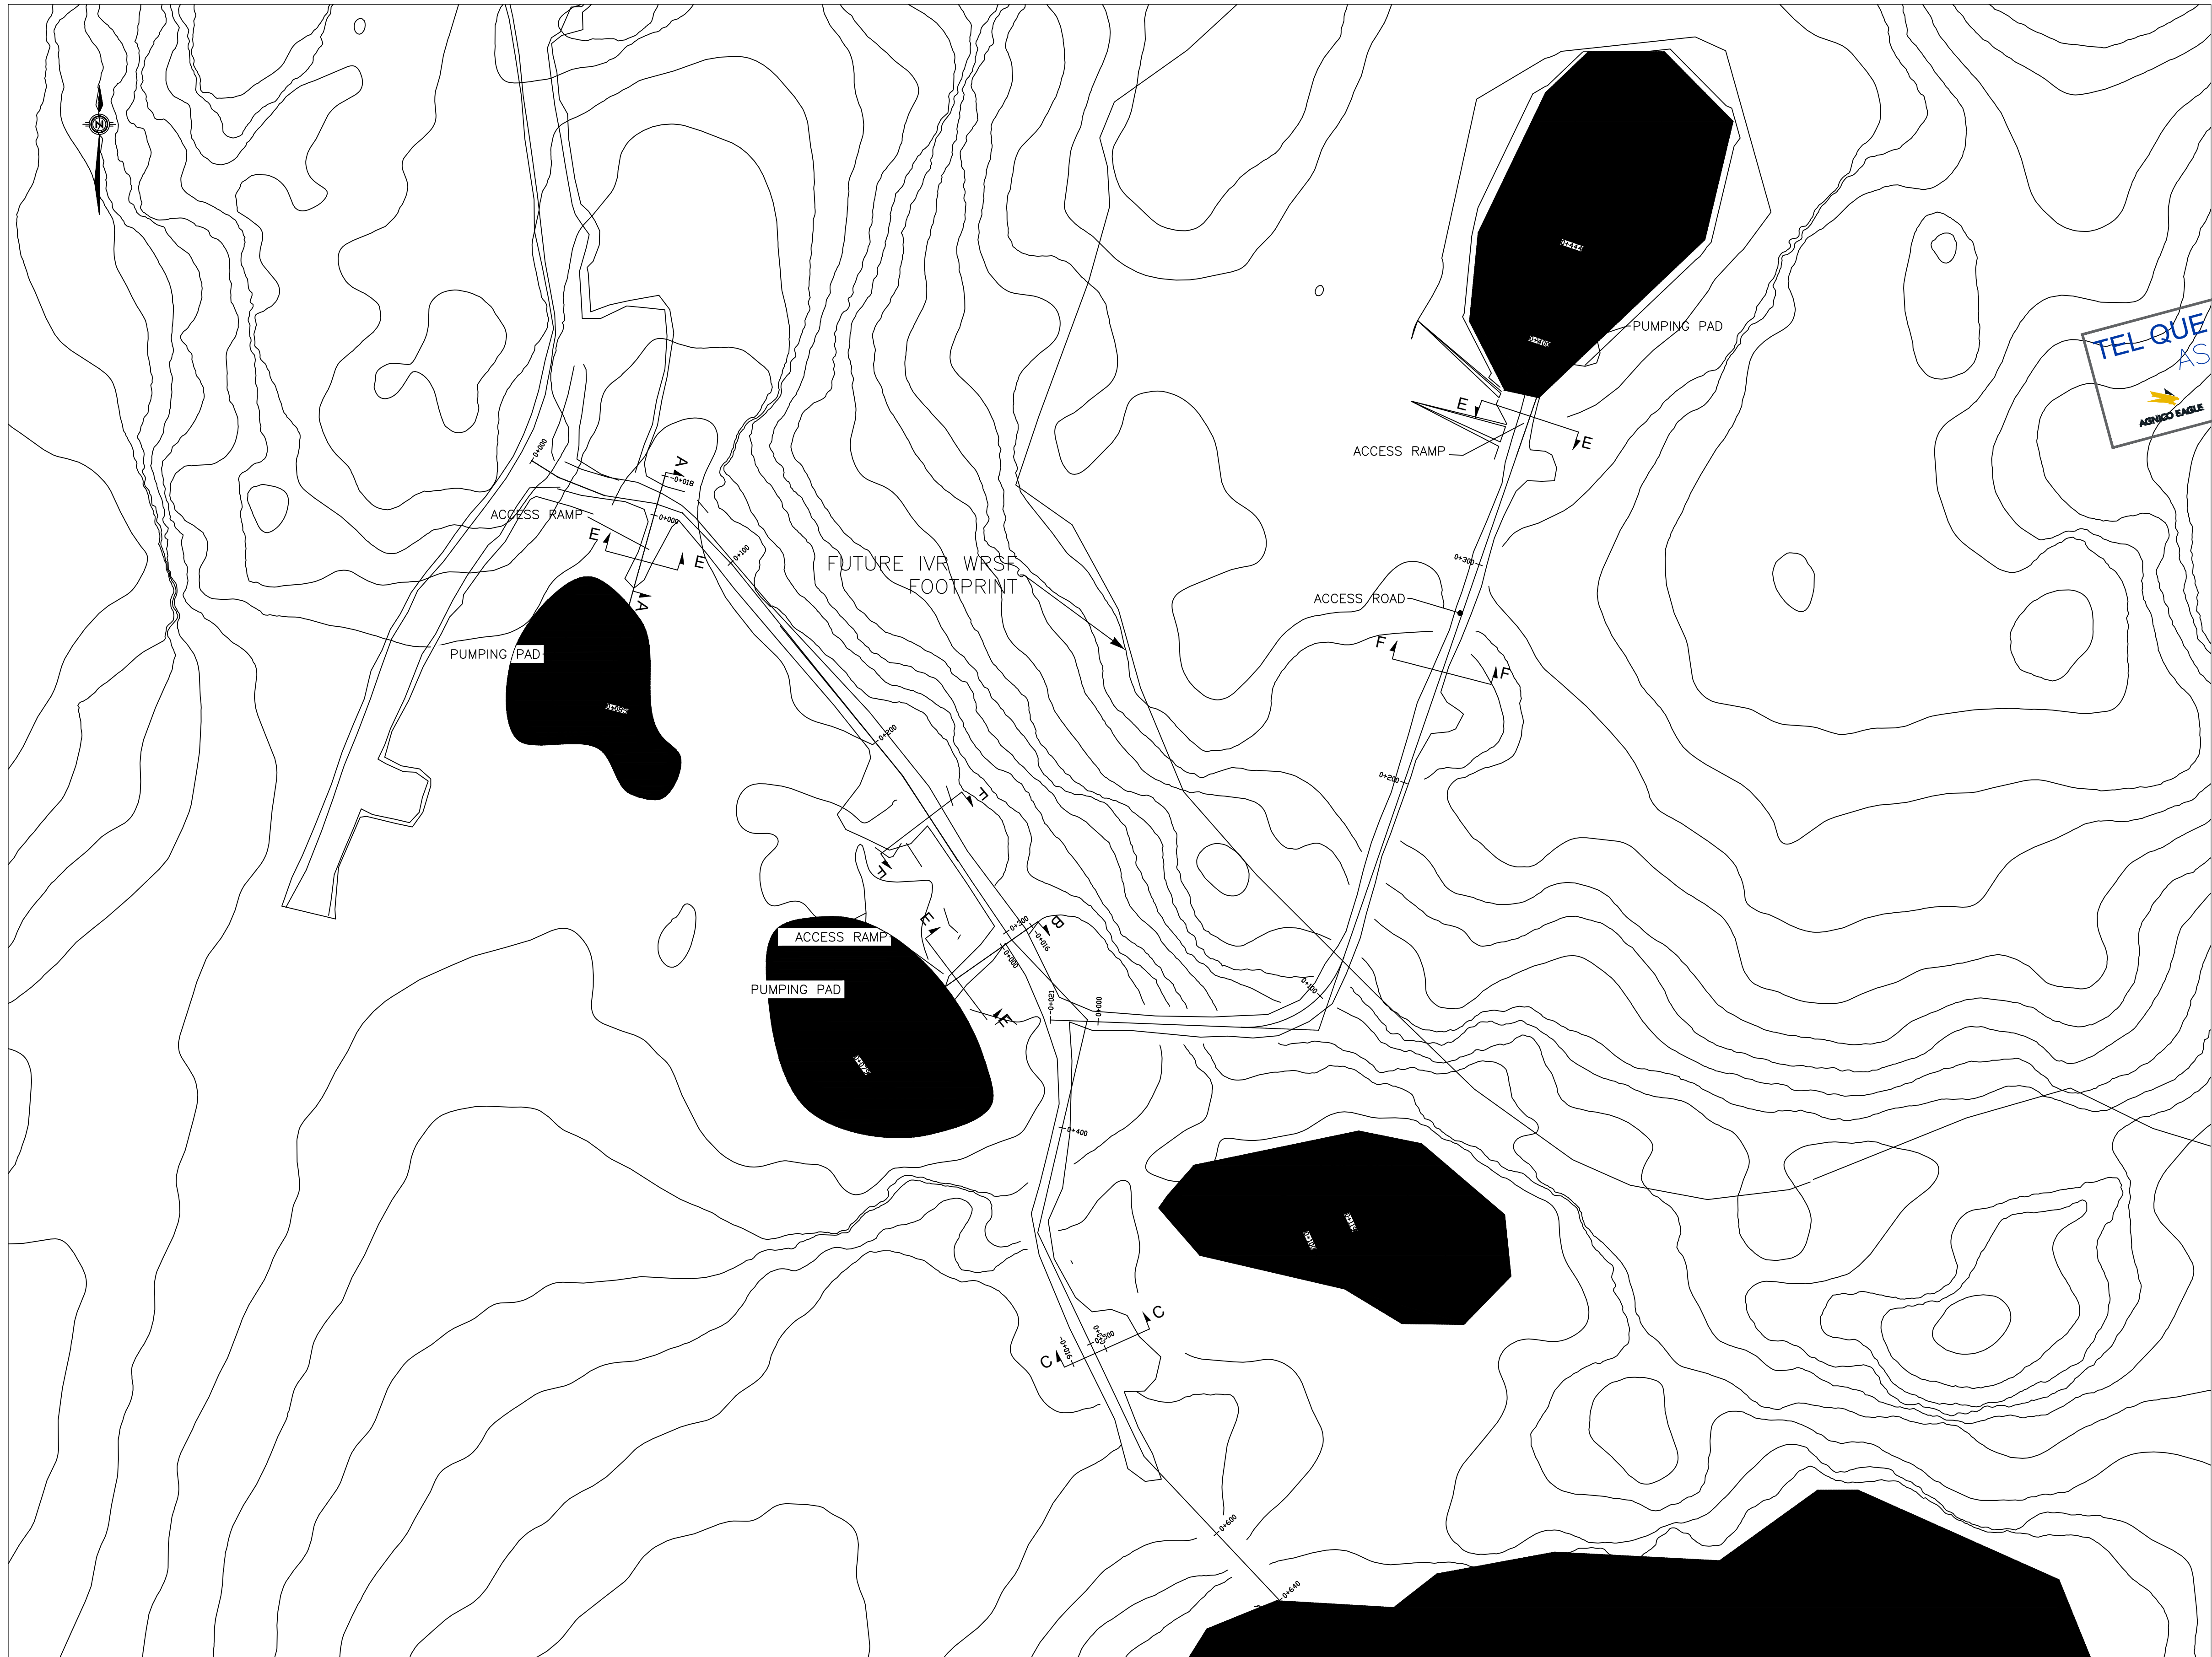

PLAN VIEW
ACCESS RAMP AND PUMPING PAD
LAKE A50, A51, A52 AND A-P21
SCALE : 1:1500

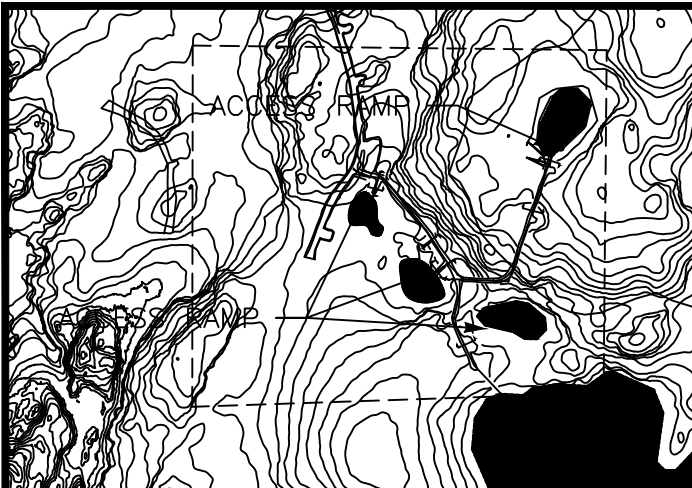

PROJECT No	SUBDIVISION	SUBJECT	SERIAL	REV.
668284	8000	4G, DD	0002	E00

NOTES GÉNÉRALES / GENERAL NOTES

- NOTES
- GROUND TOPOGRAPHY WAS PROVIDED BY ACM.
 - ALL UNITS ARE IN METERS.
 - SAFETY BERM SHALL BE BASED ON THE MINE ACT REQUIREMENTS.
 - STABILITY OF THE RAMPS TO BE ASSESSED ON A DAILY BASIS BY QUALIFIED GEOTECHNICAL PERSONNEL DURING CONSTRUCTION. WORK SHALL BE SUSPENDED IF SIGNS OF INSTABILITY ARE OBSERVED.
 - ROAD ALIGNMENT IS APPROXIMATE AND SHALL BE ADJUSTED DEPENDING ON FIELD CONDITIONS AND LOCAL TOPOGRAPHY.
 - INITIAL ROCKFILL MATERIAL PLACEMENT IN WATER, AGAINST THE NATURAL SOIL OF THE LAKE, MUST BE PLACED USING A SHOVEL.
 - THE ROAD AND RAMP CONSTRUCTION MATERIAL INSIDE THE FOOTPRINT OF THE FUTURE IVR WRSF SHALL BE EITHER PAG OR NPAG MATERIAL. THE USE OF PAG MATERIAL SHALL START APPROXIMATELY 8 METERS FROM THE TOE OF THE WRSF.
 - WATER LEVEL IN LAKES IS ESTIMATED BASED ON THE TOPOGRAPHY AROUND THE LAKE. THE ELEVATION IS APPROXIMATE AND SHALL BE VERIFIED AT THE SITE BEFORE THE START OF WORK. THE MINIMUM ALLOWABLE DIFFERENCE BETWEEN THE LAKE AND THE ROLLING SURFACE OF THE ROAD SHALL BE 0.5 METER.
 - PROVIDE SEMI-CULVERTS TO PROTECT EXISTING ELECTRICAL CABLES AND WIRES LOCATED AT THIS APPROXIMATE AREA.

LEGEND
RUN-OF-MINE
ROCKFILL 0-1000 MM

L'INFORMATION CI-CONTENUE EST LA PROPRIÉTÉ DE AGNICO EAGLE LTD. ET DOIT ÊTRE RETENUE SANS RÉPONSE, SANS ASSURANCE, SANS GARANTIE, SANS ENGAGEMENT DE CORRECTIF À L'AVANCE ET SANS TOUTE AUTRE INFORMATION QUE CELLE FOURNIE PAR L'AGNICO EAGLE LTD. EN RÉPONSE À LA DEMANDE.

THE INFORMATION HEREIN IS THE PROPERTY OF AGNICO EAGLE LTD. AND MUST BE RETAINED WITHOUT RESPONSE, WITHOUT WARRANTY, WITHOUT GUARANTEE, WITHOUT COMMITMENT TO CORRECTIVE ACTION IN ADVANCE AND WITHOUT ANY OTHER INFORMATION THAT IS PROVIDED BY AGNICO EAGLE LTD. IN RESPONSE TO THE REQUEST.

DESSINS EN RÉFÉRENCE / REFERENCE DRAWINGS

TITLE / TITRE	# DWG



REV.	DATE	DESCRIPTION	PAR/APP.	CLIENT
R1	2021-01-24	AS BUILT	J.G.	B.R.
RO	2020-06-10	ISSUED FOR CONSTRUCTION	MU/CKNG	ALN/AB
RB	2020-05-15	ISSUED FOR CLIENT COMMENTS	MU/CKNG	ALN/AB
RA	2020-05-14	ISSUED FOR INTERNAL COMMENTS	MU/CKNG	ALN/AB

REVISIONS


TITRE / TITLE
AGNICO EAGLE - AMARUO DIVISION
648 - DEWATERING
230 - GENERAL EARTHWORKS
PLAN VIEW, PROFILES AND TYPICAL SECTIONS
AMARUO DEWATERING PHASE
LAKES A50, A51, A52 AND A-P21
ACCESS RAMPS AND PUMPING PADS

DESSINÉ PAR DRAWN BY	MARIUS MOVILA	DATE 2020-03-23
VÉRIFIÉ PAR CHECKED BY	DAN CHEN	2020-03-23
APPROUVÉ PAR APPROVED BY	ANH-LONG NGUYEN	2020-03-23


ÉCHELLE SCALE	AS SHOWN	DATE 2020-03-23
------------------	----------	--------------------

NO. DESSIN
DRAWING NO.
61-648-230-201


NO. PROJET PROJECT NO.	REVISION	FEUILLE / SHEET
6127	R1	1 / 2

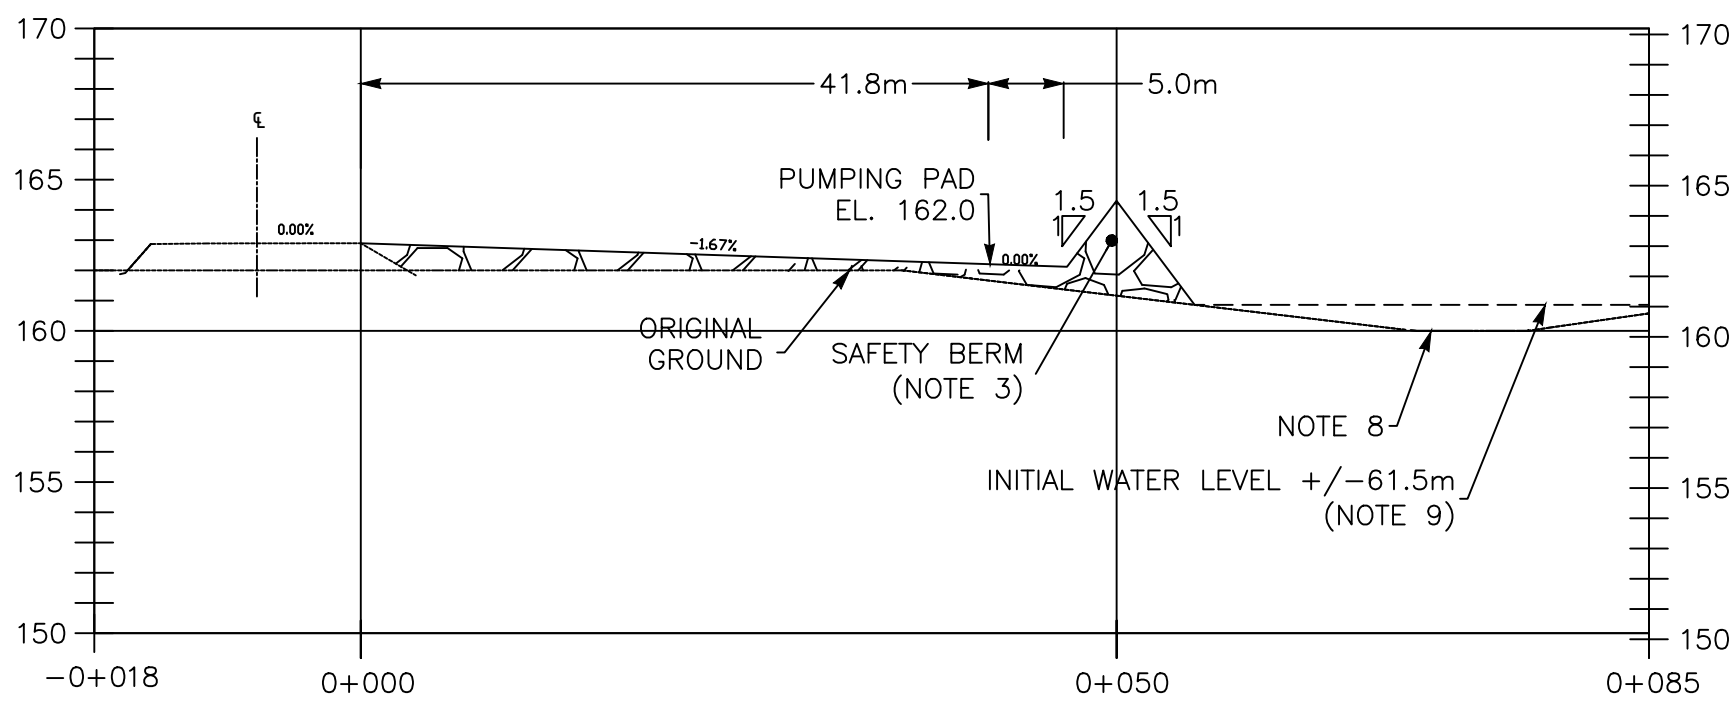


SECTION A-A
PROFILE LAKE A50 RAMP
SCALE : H 1:500
V 1:250

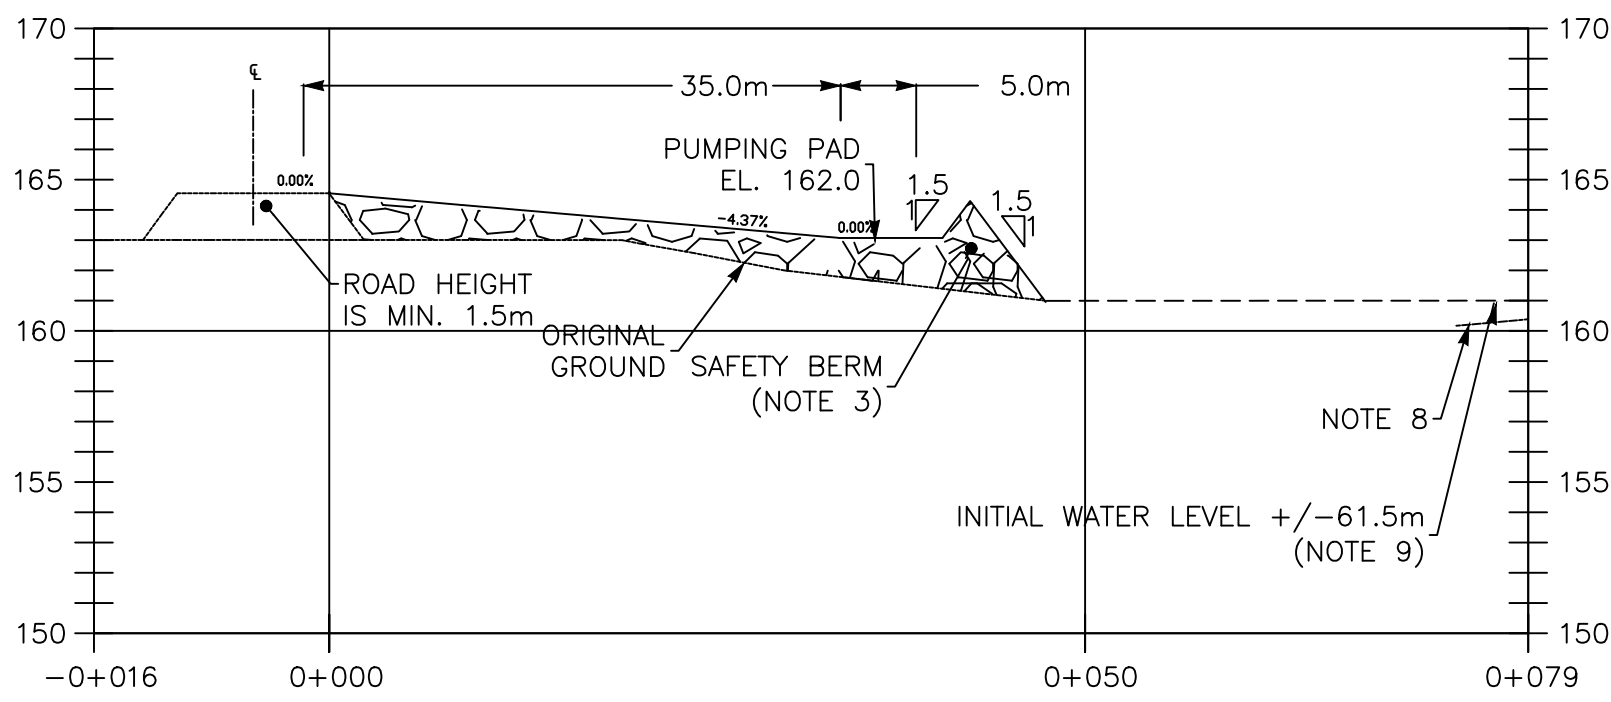


SECTION B-B
PROFILE LAKE A51 RAMP
SCALE : H 1:500
V 1:250

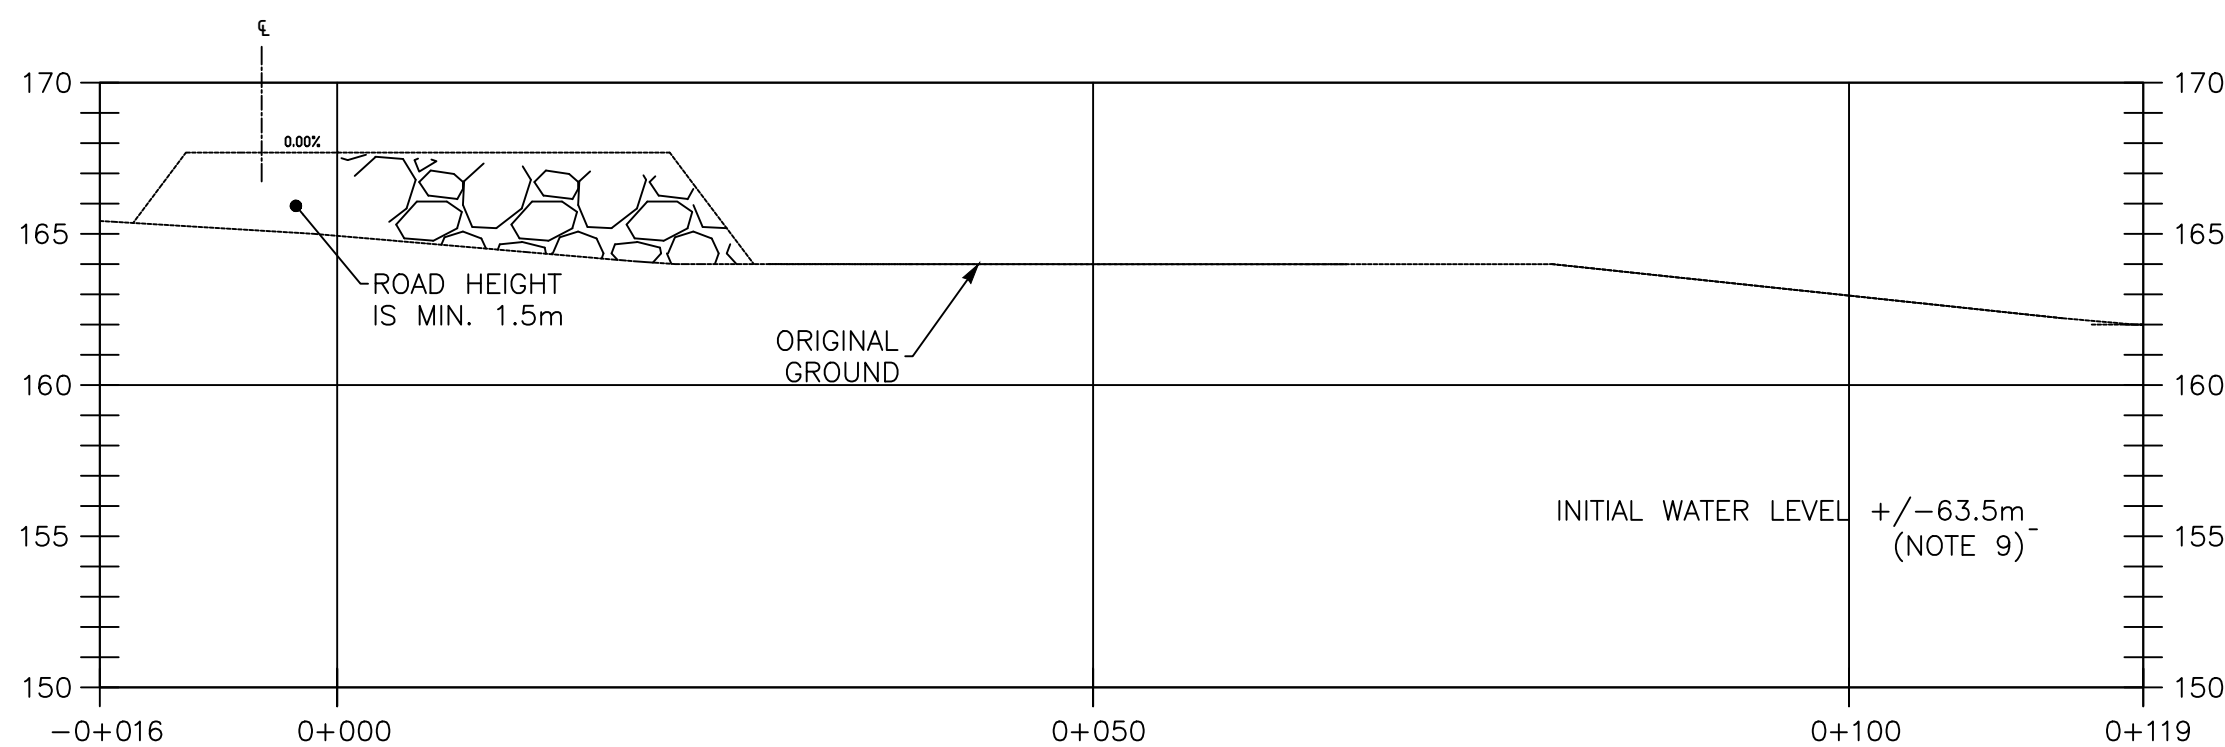


SECTION C-C
PROFILE LAKE A52 RAMP
SCALE : H 1:500
V 1:250

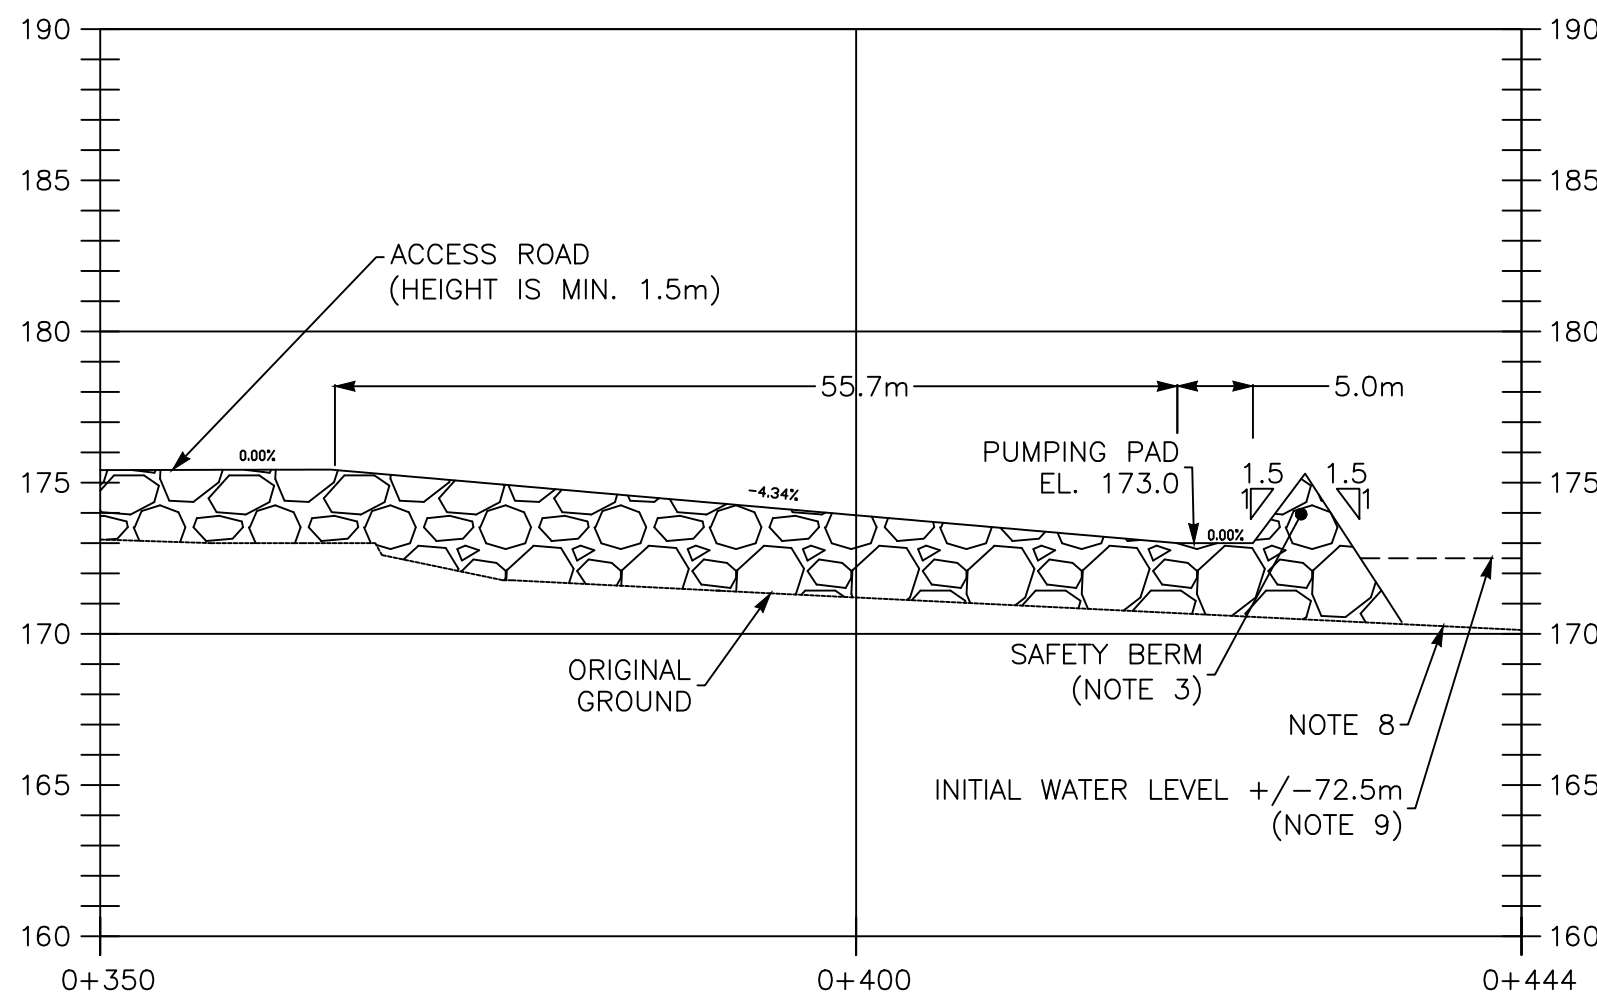

SECTION D-D
PROFILE LAKE A-P21 RAMP
SCALE : H 1:500
V 1:250

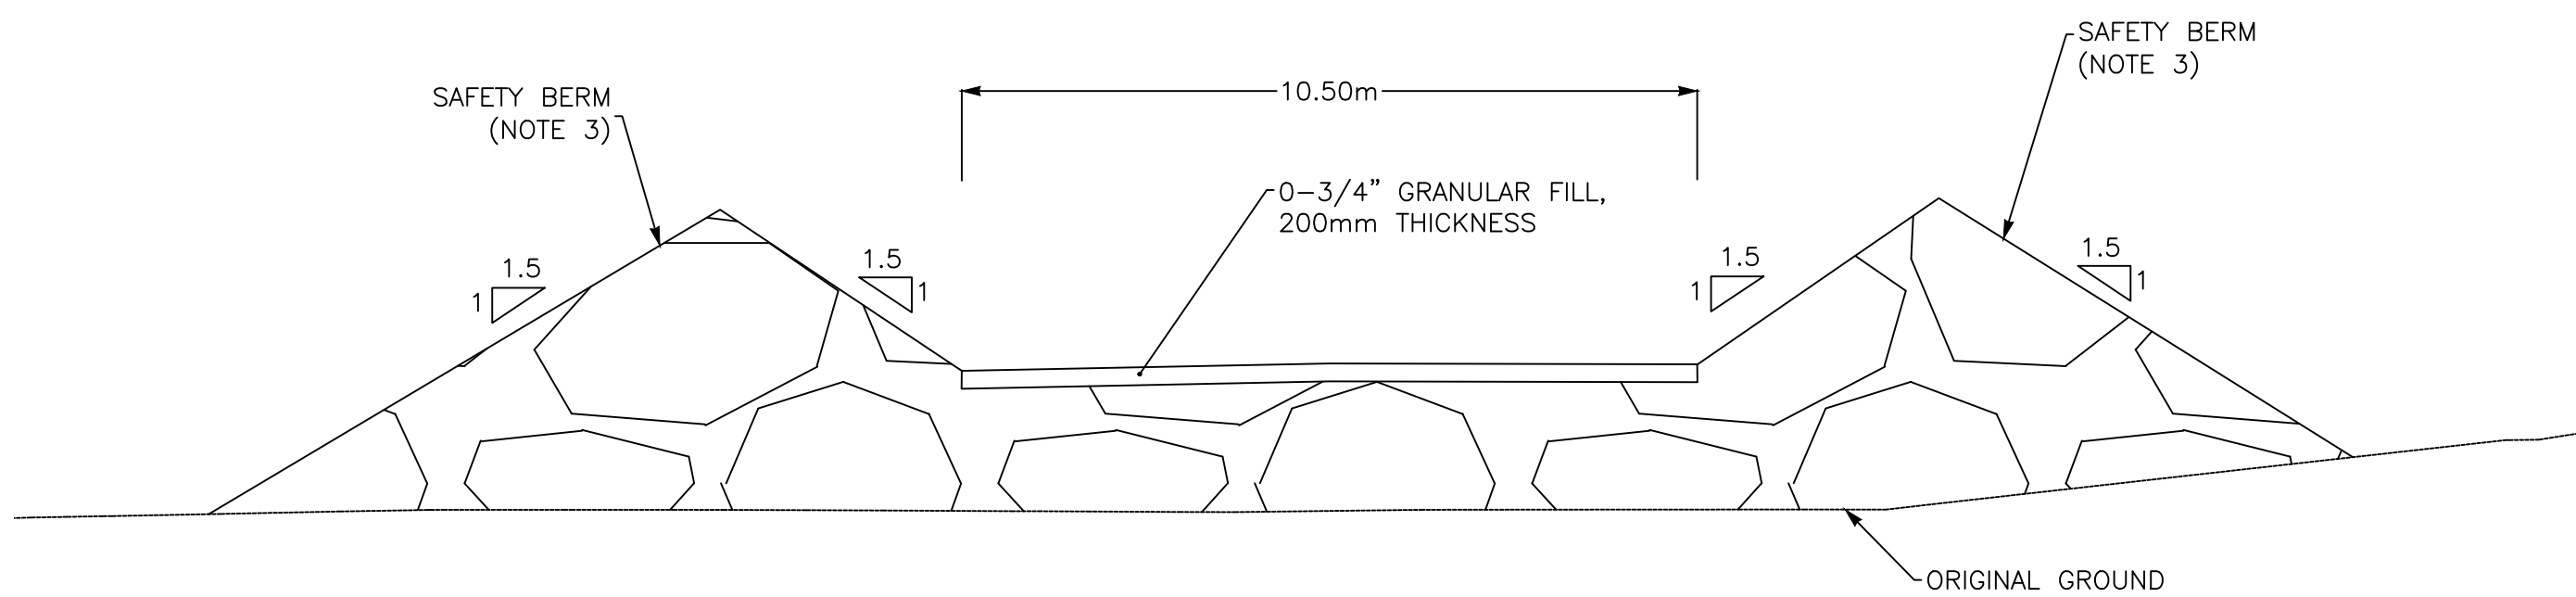

SECTION E-E
TYPICAL RAMP SECTION
SCALE : 1: 100

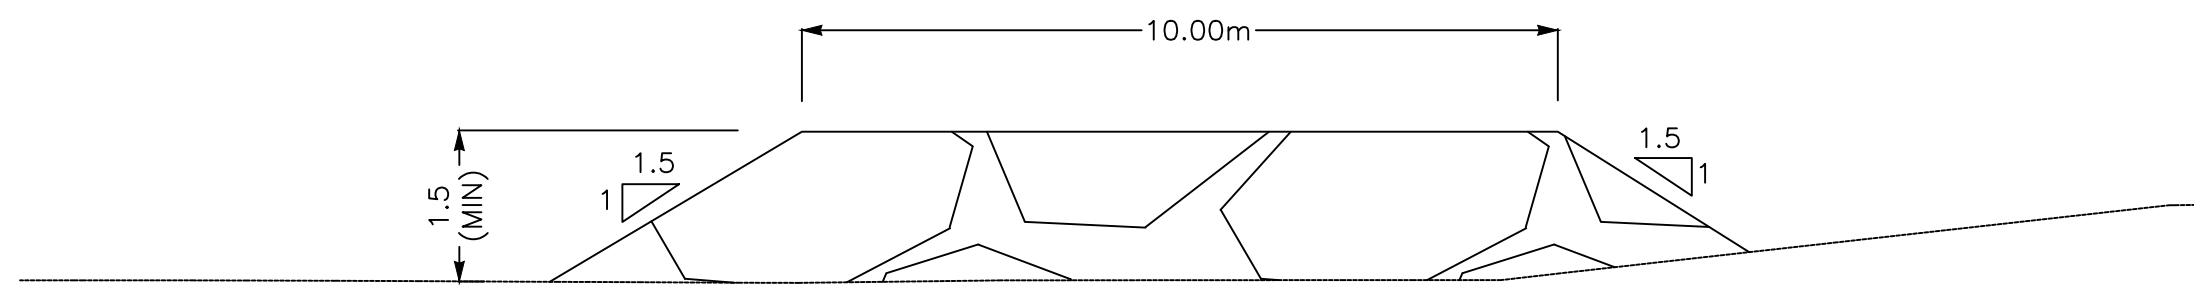

SECTION F-F
TYPICAL ROAD SECTION
SCALE : N.T.S.

TEL QUE CONSTRUIT
AS BUILT
AGNICO EAGLE
DATE : 2021-01-24

ESTIMATED IN-PLACE QUANTITIES CONSTRUCTION - ACCESS RAMPS AND PADS		
Lake (Access ramp and pad)	Granular fill, 0-3/4" (final grade, thickness 200 mm) (m³)	Run-of-mine rockfill (0-1000 mm) (m³)
A50	159.8	2289.7
A51	153.2	3140.6
A52	238.3	7262.9
A-P21	121.9	5536.3

PROJECT No	SUBDIVISION	SUBJECT	SERIAL	REV.
668284	8000	4G, DD	0002	E00

NOTES GÉNÉRALES / GENERAL NOTES

- NOTES
- GROUND TOPOGRAPHY WAS PROVIDED BY AEM.
 - ALL UNITS ARE IN METERS.
 - SAFETY BERMS SHALL BE BASED ON THE MINE ACT REQUIREMENTS.
 - STABILITY OF THE RAMPS TO BE ASSESSED ON A DAILY BASIS BY QUALIFIED GEOTECHNICAL PERSONNEL DURING CONSTRUCTION WORK SHALL BE SUSPENDED IF SIGNS OF INSTABILITY ARE OBSERVED.
 - ROAD ALIGNMENT IS APPROXIMATE AND SHALL BE ADJUSTED DEPENDING ON FIELD CONDITIONS AND LOCAL TOPOGRAPHY.
 - INITIAL ROCKFILL MATERIAL PLACEMENT IN WATER, AGAINST THE NATURAL SOIL OF THE LAKE, MUST BE PLACED USING A SHOVEL.
 - THE ROAD AND RAMP CONSTRUCTION MATERIAL INSIDE THE FOOTPRINT OF THE FUTURE IWR WRSF SHALL BE EITHER PAG OR NPAG MATERIAL. THE USE OF PAG MATERIAL SHALL START APPROXIMATELY 8 METERS FROM THE TOE OF THE WRSF.
 - FOR ALL ROCK FILL PLACEMENT OVER WATER, SOME FOUNDATION PREPARATION MIGHT BE NEEDED DEPENDING ON NATURE AND THICKNESS OF SEDIMENT ENCOUNTERED.
 - WATER LEVEL IN LAKES IS ESTIMATED BASED ON THE TOPOGRAPHY AROUND THE LAKE. THE ELEVATION IS APPROXIMATE AND SHALL BE VERIFIED AT THE SITE BEFORE THE START OF WORK. THE MINIMUM ALLOWABLE DIFFERENCE BETWEEN THE LAKE AND THE ROLLING SURFACE OF THE ROAD SHALL BE 0.5 METER.

LEGEND
RUN-OF-MINE
ROCKFILL 0-1000 MM

INFORMATION D-CONTENEUR EST LA PROPRIÉTÉ DE AGNICO EAGLE LTD. ET NE DOIT ÊTRE RÉVÉLÉE À UN TIERCE. AGNICO EAGLE LTD. DÉCLARE, SANS GARANTIE, QUE LES INFORMATIONS SONT PRÉCISES. AGNICO EAGLE LTD. DÉCLARE, SANS GARANTIE, QUE LES INFORMATIONS SONT PRÉCISES. AGNICO EAGLE LTD. DÉCLARE, SANS GARANTIE, QUE LES INFORMATIONS SONT PRÉCISES.

DESSINS EN RÉFÉRENCE / REFERENCE DRAWINGS

TITRE / TITLE	# DWG



REV.	DATE	DESCRIPTION	PAR/APP.	CLIENT
R1	2021-01-24	AS BUILT	J.G.	B.R. F.B.
RD	2020-06-10	ISSUED FOR CONSTRUCTION	M/OC/NO	ALH/AB
RB	2020-05-15	ISSUED FOR CLIENT COMMENTS	M/OC/NO	ALH/AB
RA	2020-05-14	ISSUED FOR INTERNAL COMMENTS	M/OC/NO	ALH/AB

REVISIONS


TITRE / TITLE
AGNICO EAGLE - AMARUQ DIVISION
648 - DEWATERING
230 - GENERAL EARTHWORKS
PLAN VIEW, PROFILES AND TYPICAL SECTIONS
AMARUQ DEWATERING PHASE
LAKES A50, A51, A52 AND A-P21
ACCESS RAMPS AND PUMPING PADS

DESSINÉ PAR DRAWING BY	MARIUS MOVILA	DATE 2020-03-23
VÉRIFIÉ PAR CHECKED BY	DAN CHEN	2020-03-23
APPROUVÉ PAR APPROVED BY	ANH-LONG NGUYEN	2020-03-23

ÉCHELLE
SCALE AS SHOWN DATE 2020-03-23

NO. DESSIN
DRAWING NO. 61-648-230-201

NO. PROJET PROJECT NO.	REVISION	FEUILLE / SHEET
6127	R1	2 / 2

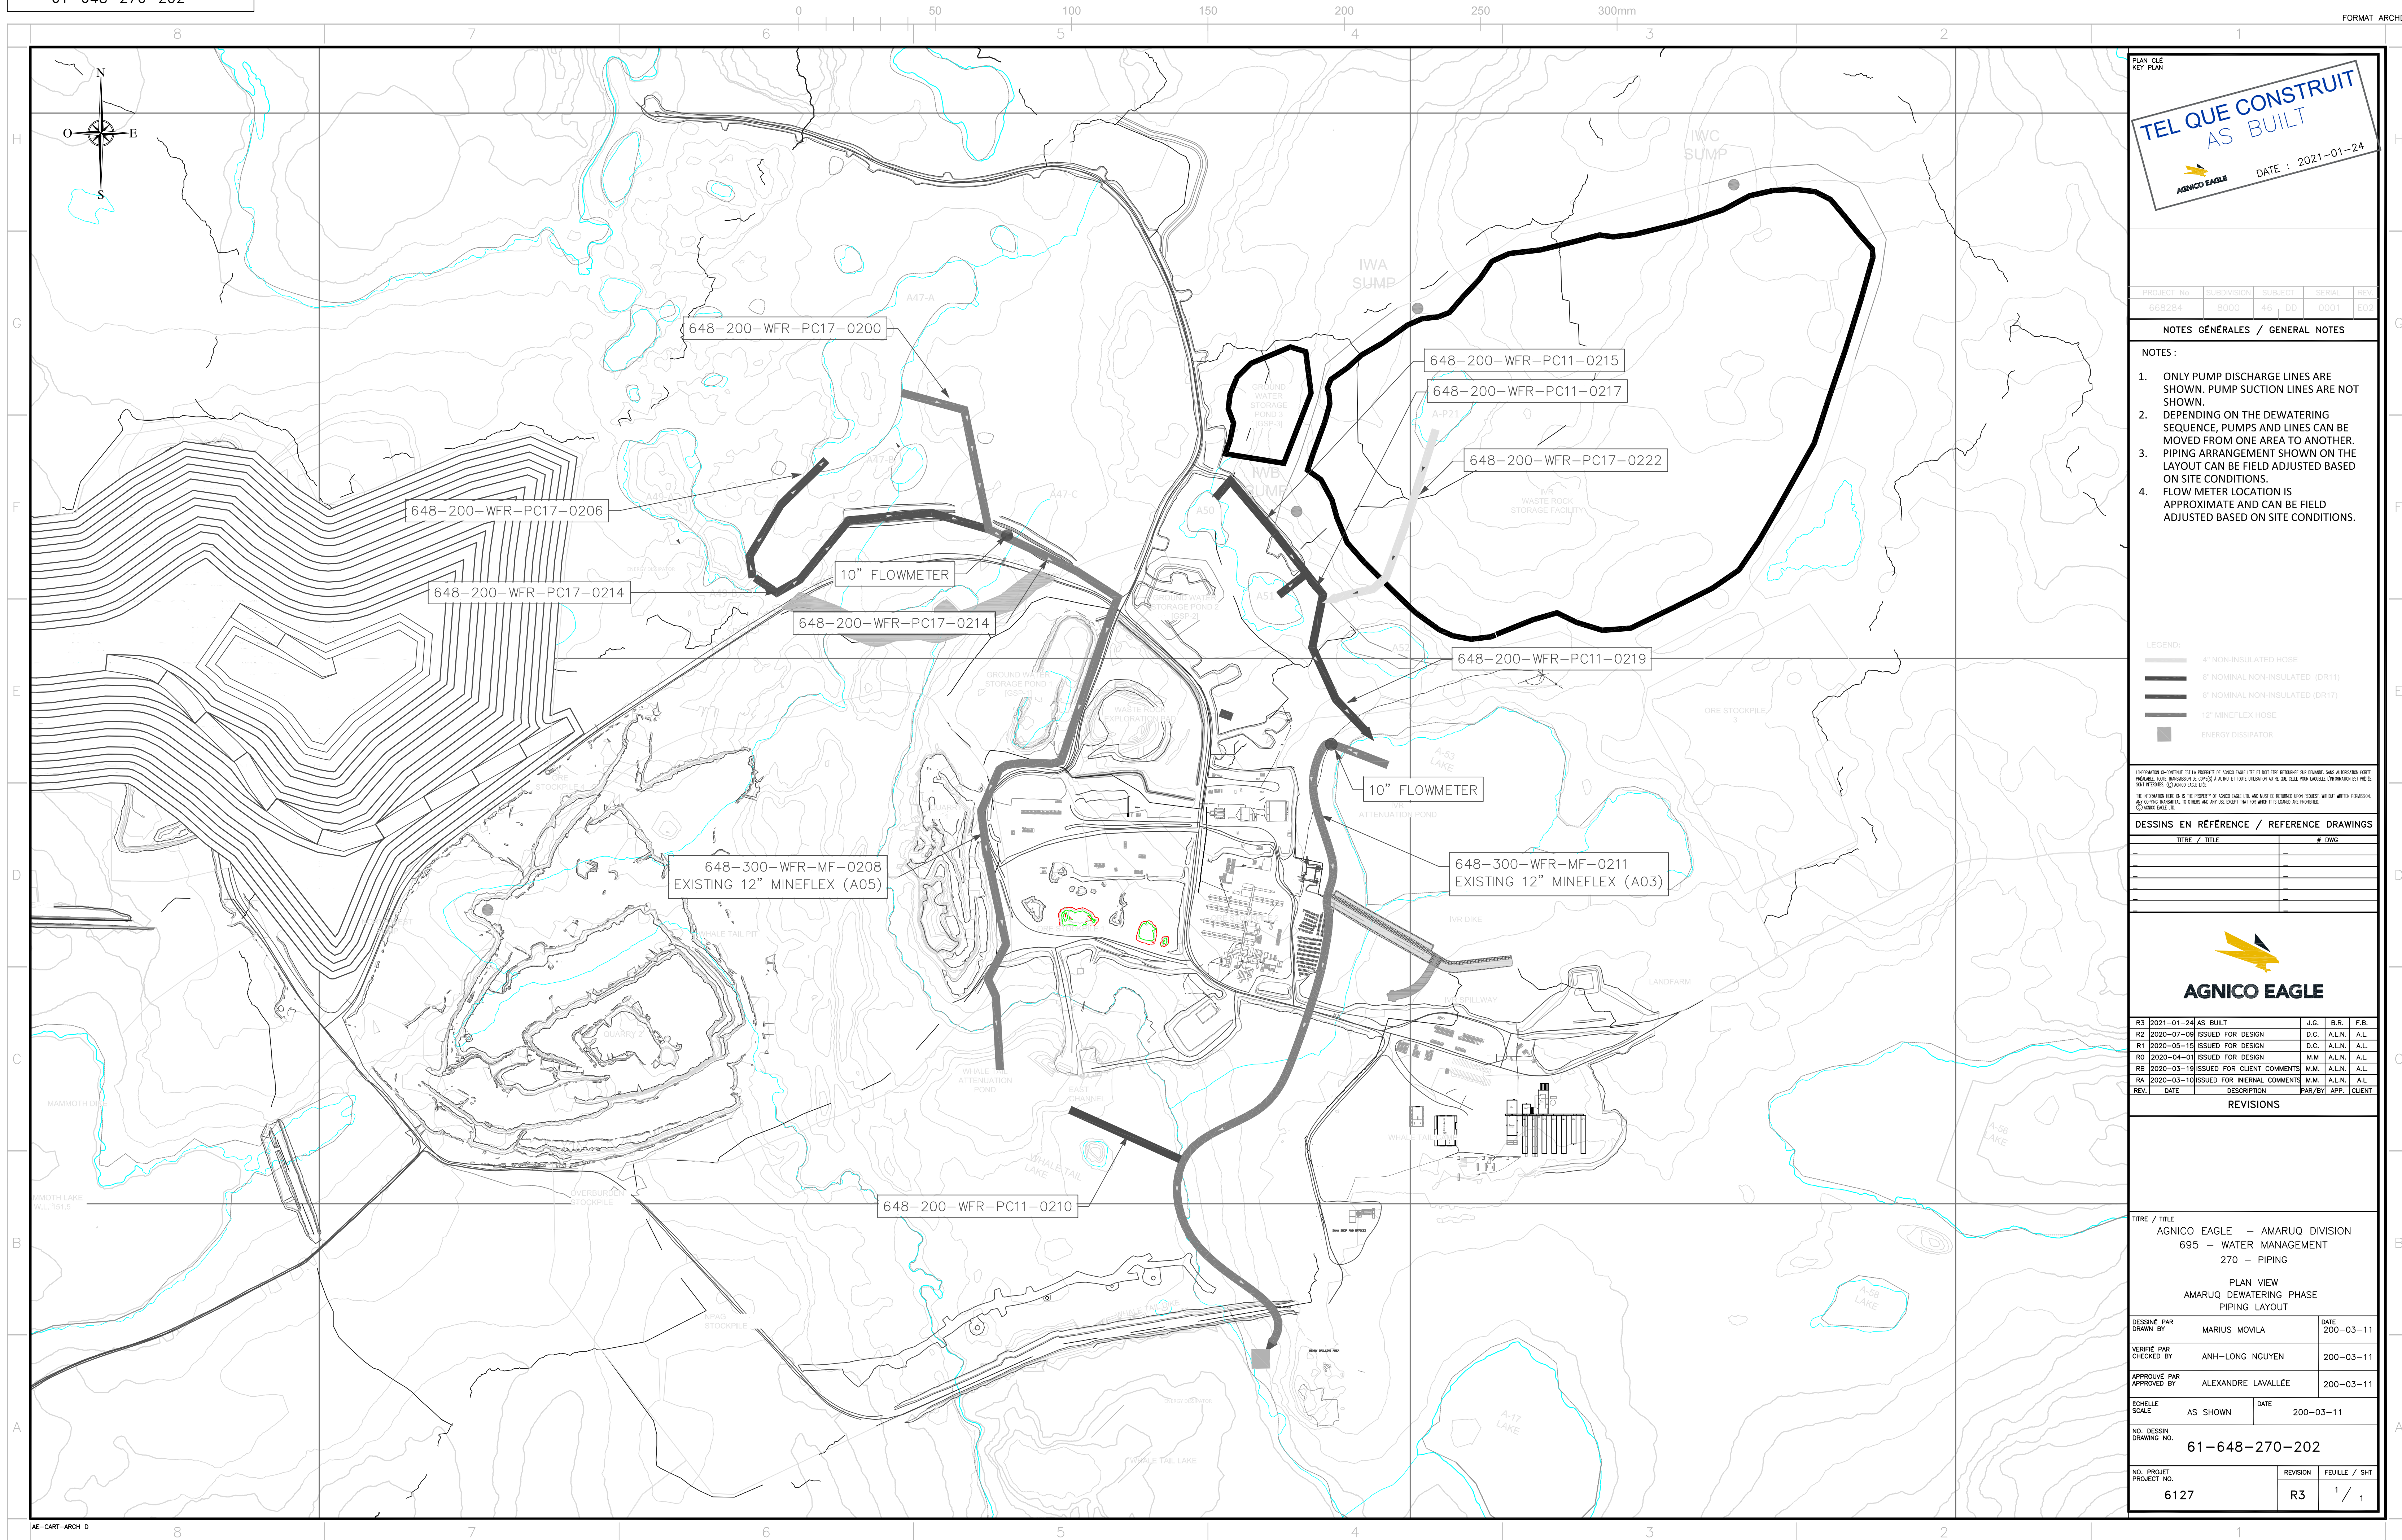

Appendix D

Mechanical completion





AGNICO EAGLE

FEUILLE DE VÉRIFICATION / INSPECTION SHEET

Tuyauterie / Piping

Secteur / Sector :	648	Préparé par / Prepared by :	Jessy gauthier
Équipement / Equipment:	648-200-WFR-PC17-0200	Date :	P&ID # 61-648-200-202
Sous-Équipement / Sub-Equip. :		No. Formulaire / Form No. :	MEC-POV-018

INSPECTION VISUELLE (VPO) / VISUAL INSPECTION (POV)

- | | | |
|------|---|---|
| 1.01 | Vérification des tags de couleur, toutes du bon type / Tags verification, all of correct type | ☒ |
| 1.02 | Cadenassage et inspection sécuritaire / Pad locking and secure inspection conditions | ☒ |
| 1.03 | Installation selon dessins / Installation as per erection drawings | ☒ No Gasket |
| 1.04 | Structures et reforts complet et bien boulonnés / Support structures complete and bolted | ☒ |
| 1.05 | Sécuriser le périmètre avec les rubans de sécurité / Secure perimeter with ribbon | ☒ |
| 2.02 | Secteur de tuyauterie isolé aux bons endroits / Blanks installed at the correct locations | ☒ |
| 2.03 | Équipements isolés de la tuyauterie / Equipment isolated from piping | ☒ |
| 2.04 | Supports à ressorts bloqués / Spring supports blocked | ☒ |
| 2.05 | Filtres temporaires installés / Temporary strainers installed | ☒ |
| 2.06 | Valves anti-retour maintenues en positions ouvertes / Check valves locked open | ☒ |
| 2.07 | Drains et événements installés / Drains and vents installed | ☒ |
| 2.08 | Dispositif d'expansion thermique en place / Thermal expansion system installed | ☒ |
| 2.09 | Lavage initial des lignes et vidange faite / Initial flushing and cleaning done | ☒ |

TESTS (TPO) / TESTS (POT)

- | | | |
|------|--|--------------------------|
| 3.01 | Est-ce que les autorités locales doivent assister au test? / Are local authority required to witness test? | |
| 3.02 | Oui (nom) / Yes (name) | ☐ |
| 3.03 | Non / No | ☐ |
| 3.04 | Pompe/compresseur de test et manomètres / Test pump/compressor and gauges installed | ☐ |
| 3.05 | Remplir la ligne / Line filled | ☐ |
| 3.06 | Purger l'air de la ligne / Air purged from line | ☐ |
| 3.07 | Fermer les événements / Vents closed | ☐ |
| 3.08 | Fluide de test à moins de 50°C / Test fluid at less than 50°C | ☐ |
| 3.09 | Test de pression complété / Pressure test completed | ☐ |
| 3.10 | Ligne lavée et vidée / Line flushed and cleaned | ☐ |
| 3.11 | Vidanger les points bas dans la ligne / Empty low points of line | ☐ |
| 3.12 | Retirer les disques d'isolation de tuyauterie / Remove piping blanks and plugs | ☐ |
| 3.13 | Équipements et valves reconnectés / Equipments and valves reconnected | ☐ |
| 3.14 | Stériliser / Sterilization | ☐ |
| 3.15 | Décapage et passivation (acier inoxydable) / Pickling and passivation (Stainless steel) | ☐ |
- Partial Service Test J.G. OK

Formulaire / Form MEC-POV-019

SIGNATURES (VPO) / SIGNATURES (POV)

Exécutant Construction / Construction Performer

Date: _____

Exécutant Commissioning / Comm. Performer

Date: _____

Jessy Gauthier

TESTS (TPO) / TESTS (POT)

4.01	Essais en pleine charge / Full load trials	Date (DD/MM/YY)	
4.02	Identification installée sur les tuyaux / Piping identification installed		☐
4.03	Actionner les valves / Operate valves		☐
4.04	Valider la direction fluides selon l'identification / Check flow direction according to markings		☒
4.05	Ajuster les valves / Adjust valves		☐
4.06	Aucunes fuites à la pression d'opération / No leakage at operating pressure		☒
4.07	Opération du système correcte / System operating correctly		☒
4.08	Vidanger la tuyauterie / Flush out line		☐
4.09	Filtres temporaires retirés / Temporary strainers removed		☐
4.10	Isolation de la tuyauterie installée et conforme aux spécifications / Piping insulation installed as per specifications		
	Épaisseur d'isolation / Insulation thickness		☐
	Type d'isolant utilisé / Insulation type installed		☐
	Type de recouvrement d'isolant utilisé / Insulation jacketing type installed		☐
	Validation de la compatibilité de l'isolant spécifié avec le procédé / Validate insulation compatibility with process		☐

DOCUMENTATION / DOCUMENTATION

5.01	Dessins certifiés reçus du fournisseur / Vendor certified drawings received	☐
5.02	Manuels d'instructions reçus du fournisseur / Vendor instruction manuals received	☐
5.03	Certificat de conformité obtenu des autorités locales / Local authority certificate obtained	☐

6.00

REMARQUES / REMARKS

No leak on the partial line (system modified).

Suite au verso / Continuation on back



Suite feuille suivante / Continuation on next sheet



SIGNATURES (TPO) / SIGNATURES (POT)

Exécutant Commissioning / Comm. performer	Date: _____	Responsable AEM / AEM Responsible	Date: _____
			

Étiquettes & cadenas changés / Tags & padlocks changed	1			
☐	2	M.G.	Information isolation et autres corrections	1/25/2019
Initialiser ce que vous avez fait / Initial things you have done	3			
	No	Par/By	Revision	Date

AEM

Rév.:02



AGNICO EAGLE

FEUILLE DE VÉRIFICATION / INSPECTION SHEET

Tuyauterie / Piping

Secteur / Sector : 648

Préparé par / Prepared by :

Jessy gauthier

Équipement / Equipment: 648-300-WFR-MF-0208

Date :

P&ID # 61-648-200-202

Sous-Équipement / Sub-Equip. :

No. Formulaire / Form No. :

MEC-POV-018

INSPECTION VISUELLE (VPO) / VISUAL INSPECTION (POV)

1.01	Vérification des tags de couleur, toutes du bon type / Tags verification, all of correct type	☐
1.02	Cadenassage et inspection sécuritaire / Pad locking and secure inspection conditions	☐
1.03	Installation selon dessins / Installation as per erection drawings	☒ No Gasket
1.04	Structures et reforts complet et bien boulonnés / Support structures complete and bolted	☒
1.05	Sécuriser le périmètre avec les rubans de sécurité / Secure perimeter with ribbon	☐
2.02	Secteur de tuyauterie isolé aux bons endroits / Blanks installed at the correct locations	☒
2.03	Équipements isolés de la tuyauterie / Equipment isolated from piping	☒
2.04	Supports à ressorts bloqués / Spring supports blocked	☐
2.05	Filtres temporaires installés / Temporary strainers installed	☐
2.06	Valves anti-retour maintenues en positions ouvertes / Check valves locked open	☐
2.07	Drains et événements installés / Drains and vents installed	☐
2.08	Dispositif d'expansion thermique en place / Thermal expansion system installed	☐
2.09	Lavage initial des lignes et vidange faite / Initial flushing and cleaning done	☐

TESTS (TPO) / TESTS (POT)

3.01	Est-ce que les autorités locales doivent assister au test? / Are local authority required to witness test?	
3.02	Oui (nom) / Yes (name)	☐
3.03	Non / No	☐
3.04	Pompe/compresseur de test et manomètres / Test pump/compressor and gauges installed	☐
3.05	Remplir la ligne / Line filled	☐
3.06	Purger l'air de la ligne / Air purged from line	☐
3.07	Fermer les événements / Vents closed	☐
3.08	Fluide de test à moins de 50°C / Test fluid at less than 50°C	☐
3.09	Test de pression complété / Pressure test completed	☐
3.10	Ligne lavée et vidée / Line flushed and cleaned	☐
3.11	Vidanger les points bas dans la ligne / Empty low points of line	☐
3.12	Retirer les disques d'isolation de tuyauterie / Remove piping blanks and plugs	☐
3.13	Équipements et valves reconnectés / Equipments and valves reconnected	☐
3.14	Stériliser / Sterilization	☐
3.15	Décapage et passivation (acier inoxydable) / Pickling and passivation (Stainless steel)	☐

Service test J.G.
OK

Formulaire / Form MEC-POV-019

SIGNATURES (VPO) / SIGNATURES (POV)

Exécutant Construction / Construction Performer

Date: _____

Exécutant Commissioning / Comm. Performer

Date: _____

Jessy Gauthier

TESTS (TPO) / TESTS (POT)

4.01	Essais en pleine charge / Full load trials	Date (DD/MM/YY)
4.02	Identification installée sur les tuyaux / Piping identification installed	☐
4.03	Actionner les valves / Operate valves	☐
4.04	Valider la direction fluides selon l'identification / Check flow direction according to markings	☒
4.05	Ajuster les valves / Adjust valves	☐
4.06	Aucunes fuites à la pression d'opération / No leakage at operating pressure	☒
4.07	Opération du système correcte / System operating correctly	☒
4.08	Vidanger la tuyauterie / Flush out line	☐
4.09	Filtres temporaires retirés / Temporary strainers removed	☐
4.10	Isolation de la tuyauterie installée et conforme aux spécifications / Piping insulation installed as per specifications	
	Épaisseur d'isolation / Insulation thickness	☐
	Type d'isolant utilisé / Insulation type installed	☐
	Type de recouvrement d'isolant utilisé / Insulation jacketing type installed	☐
	Validation de la compatibilité de l'isolant spécifié avec le procédé / Validate insulation compatibility with process	☐

DOCUMENTATION / DOCUMENTATION

5.01	Dessins certifiés reçus du fournisseur / Vendor certified drawings received	☐
5.02	Manuels d'instructions reçus du fournisseur / Vendor instruction manuals received	☐
5.03	Certificat de conformité obtenu des autorités locales / Local authority certificate obtained	☐

6.00 REMARQUES / REMARKS

No leak

Suite au verso / Continuation on back



Suite feuille suivante / Continuation on next sheet



SIGNATURES (TPO) / SIGNATURES (POT)

Exécutant Commissioning / Comm. performer

Date: _____

Jessy Gauthier

Responsable AEM / AEM Responsible

Date: _____

Jessy Gauthier

Étiquettes & cadenas changés / Tags & padlocks changed



Initialer ce que vous avez fait / Initial things you have done

1			
2	M.G.	Information isolation et autres corrections	1/25/2019
3			
No	Par/By	Revision	Date

AEM

Rév.:02



AGNICO EAGLE

FEUILLE DE VÉRIFICATION / INSPECTION SHEET

Tuyauterie / Piping

Secteur / Sector :	648	Préparé par / Prepared by :	Jessy gauthier
Équipement / Equipment:	648-300-WFR-MF-214	Date :	P&ID # 61-648-200-202
Sous-Équipement / Sub-Equip. :		No. Formulaire / Form No. :	MEC-POV-018

INSPECTION VISUELLE (VPO) / VISUAL INSPECTION (POV)

- | | | |
|------|---|---|
| 1.01 | Vérification des tags de couleur, toutes du bon type / Tags verification, all of correct type | ☒ |
| 1.02 | Cadenassage et inspection sécuritaire / Pad locking and secure inspection conditions | ☒ |
| 1.03 | Installation selon dessins / Installation as per erection drawings | ☒ No Gasket |
| 1.04 | Structures et reforts complet et bien boulonnés / Support structures complete and bolted | ☒ |
| 1.05 | Sécuriser le périmètre avec les rubans de sécurité / Secure perimeter with ribbon | ☒ |
| 2.02 | Secteur de tuyauterie isolé aux bons endroits / Blanks installed at the correct locations | ☒ |
| 2.03 | Équipements isolés de la tuyauterie / Equipment isolated from piping | ☒ |
| 2.04 | Supports à ressorts bloqués / Spring supports blocked | ☒ |
| 2.05 | Filtres temporaires installés / Temporary strainers installed | ☒ |
| 2.06 | Valves anti-retour maintenues en positions ouvertes / Check valves locked open | ☒ |
| 2.07 | Drains et événements installés / Drains and vents installed | ☒ |
| 2.08 | Dispositif d'expansion thermique en place / Thermal expansion system installed | ☒ |
| 2.09 | Lavage initial des lignes et vidange faite / Initial flushing and cleaning done | ☒ |

TESTS (TPO) / TESTS (POT)

- | | | |
|------|--|--------------------------|
| 3.01 | Est-ce que les autorités locales doivent assister au test? / Are local authority required to witness test? | ☐ |
| 3.02 | Oui (nom) / Yes (name) | ☐ |
| 3.03 | Non / No | ☐ |
| 3.04 | Pompe/compresseur de test et manomètres / Test pump/compressor and gauges installed | ☐ |
| 3.05 | Remplir la ligne / Line filled | ☐ |
| 3.06 | Purger l'air de la ligne / Air purged from line | ☐ |
| 3.07 | Fermer les événements / Vents closed | ☐ |
| 3.08 | Fluide de test à moins de 50°C / Test fluid at less than 50°C | ☐ |
| 3.09 | Test de pression complété / Pressure test completed | ☐ |
| 3.10 | Ligne lavée et vidée / Line flushed and cleaned | ☐ |
| 3.11 | Vidanger les points bas dans la ligne / Empty low points of line | ☐ |
| 3.12 | Retirer les disques d'isolation de tuyauterie / Remove piping blanks and plugs | ☐ |
| 3.13 | Équipements et valves reconnectés / Equipments and valves reconnected | ☐ |
| 3.14 | Stériliser / Sterilization | ☐ |
| 3.15 | Décapage et passivation (acier inoxydable) / Pickling and passivation (Stainless steel) | ☐ |
- Partial Service test J.G. OK

Formulaire / Form MEC-POV-019

SIGNATURES (VPO) / SIGNATURES (POV)

Exécutant Construction / Construction Performer

Date: _____

Exécutant Commissioning / Comm. Performer

Date: _____

Jessy Gauthier

TESTS (TPO) / TESTS (POT)

4.01	Essais en pleine charge / <i>Full load trials</i>	Date (DD/MM/YY)	
4.02	Identification installée sur les tuyaux / <i>Piping identification installed</i>		☒
4.03	Actionner les valves / <i>Operate valves</i>		☒
4.04	Valider la direction fluides selon l'identification / <i>Check flow direction according to markings</i>		☒
4.05	Ajuster les valves / <i>Adjust valves</i>		☒
4.06	Aucunes fuites à la pression d'opération / <i>No leakage at operating pressure</i>		☒
4.07	Opération du système correcte / <i>System operating correctly</i>		☒
4.08	Vidanger la tuyauterie / <i>Flush out line</i>		☒
4.09	Filtres temporaires retirés / <i>Temporary strainers removed</i>		☒
4.10	Isolation de la tuyauterie installée et conforme aux spécifications / <i>Piping insulation installed as per specifications</i>		
	Épaisseur d'isolation / <i>Insulation thickness</i>		☒
	Type d'isolant utilisé / <i>Insulation type installed</i>		☒
	Type de recouvrement d'isolant utilisé / <i>Insulation jacketing type installed</i>		☒
	Validation de la compatibilité de l'isolant spécifié avec le procédé / <i>Validate insulation compatibility with process</i>		☒

DOCUMENTATION / DOCUMENTATION

5.01	Dessins certifiés reçus du fournisseur / <i>Vendor certified drawings received</i>	☒
5.02	Manuels d'instructions reçus du fournisseur / <i>Vendor instruction manuals received</i>	☒
5.03	Certificat de conformité obtenu des autorités locales / <i>Local authority certificate obtained</i>	☒

6.00 REMARQUES / REMARKS

No leak on modified line

Suite au verso / *Continuation on back*



Suite feuille suivante / *Continuation on next sheet*


SIGNATURES (TPO) / SIGNATURES (POT)

Exécutant Commissioning / *Comm. performer*

Date: _____

Jessy Gauthier

Responsable AEM / *AEM Responsible*

Date: _____

Jessy Gauthier

Étiquettes & cadenas changés / *Tags & padlocks changed*



Initialer ce que vous avez fait / *Initial things you have done*

1			
2	M.G.	Information isolation et autres corrections	1/25/2019
3			
No	Par/By	Revision	Date

AEM

Rév.:02

AREA # :

648

Description:

Dewatering line (accelerated)

1. MECHANICAL COMPLETION DECLARATION

We confirm that the area listed above that we have jointly inspected has been tested and critical defects have been resolved. The remaining defects are recorded in the deficiency form (attached). This facility is mechanically completed and ready for commissioning in accordance with AEM Project rules.

Name	Position	Signature	Date
Pierre Gauthier	AEM Commissioning responsible	Pierre Gauthier Digitally signed by Pierre Gauthier DN: cn=Pierre Gauthier Date: 2020.09.03 09:38:35 -05'00'	
Marc-André Beaudet	AEM Construction responsible	Marc-Andre Beaudet Digitally signed by Marc-Andre Beaudet Date: 2020.09.09 17:11:54 -04'00'	
Jessy Gauthier	AEM Construction POV responsible	Jessy Gauthier Digitally signed by Jessy Gauthier Date: 2020.09.03 10:08:27 -05'00'	

2. ACCEPTANCE OF THE FINAL TEST COMPLETION

We acknowledge the completion of the Electro/Mechanical installation of the Area or sub-system and the commitment of the construction team to complete the deficiencies list within the respect of the scope of work. I agree that the Sub-System is safe to initiate the commissioning phase.

Name	AEM Project Position	Signature	Date
Marc-André Beaudet	AEM Construction responsible	Marc-Andre Beaudet Digitally signed by Marc-Andre Beaudet Date: 2020.09.09 14:15:01 -04'00'	
Pierre Gauthier	AEM Commissioning responsible	Pierre Gauthier Digitally signed by Pierre Gauthier DN: cn=Pierre Gauthier Date: 2020.09.03 09:40:37 -05'00'	
Guillaume Gemme	AEM Operation responsible	Guillaume Gemme Signature numérique de Guillaume Gemme DN : cn=Guillaume Gemme Date : 2020.09.13 18:42:26 -05'00'	

3. WALK-DOWN PARTICIPATION

See below the name of participant during the Walk-Down of the area, system or sub-system.

Name	AEM Project Position
Jessy Gauthier	Construction Engineer resident
Laurier Colette	Geotechnical Engineer
Guillaume Baril	Geotechnical Technicien
Michael Beaulieu	E&I Supervisor

4. DEFECT SUMMARY LIST

Defect Discipline Codes		Defect Category Codes		Defect Priority Codes	
P	Piping	A	Safety or critical to operation	1	Complete before Pre-Commissioning starts
C	Civil/Structural	B	Included in the construction package, not completed	2	Complete before Cold Commissioning starts
M	Mechanical	C	Included in the construction package, need to be reviewed by engineering	3	Complete before Hot Commissioning starts
E	Electrical	D	Not included in the construction package	4	Complete before starts-up
I	Instrument & Control	M	Modification requested by the operation department	5	Complete before Hand Over
				6	Complete after Hand Over

No.	Discipline	Category	Priority	Description of Problem	Solution to be Used	Resp.	Target Date	Task Complete Accepted By	Date
1	P	B	3	Finish connexion line 214	Move freshet to dewatering	Const			
2	P	B	3	Line 0210 on a electrical cable near WTP	Lift the line 0210	Const			
3	P	B	3	Missing bolt on valve at Tee 0211 & 0210	Install missing bolt	Const			
4	P	B	3	Missing suction on A-50	Install when needed	Const			
5	P	B	3	Missing suction on A-51	Install when needed	Const			
6	P	B	3	Missing suction on AP-21	Inatall when needed	Const			
7	C	B	3	Jetty to short	Extend the jetty and piping	Const			
8	P	B	3	Connect piping 0222 to 0219	When pumping is needed	Const			
9	I	B	3	Missing paletteweel on discharge 0219	Install palett weel	Const			

3. WALK-DOWN PARTICIPATION

See below the name of participant during the Walk-Down of the area, system or sub-system.

Name	AEM Project Position
Jessy Gauthier	Construction Engineer resident
Laurier Colette	Geotechnical Engineer
Guillaume Baril	Geotechnical Technicien
Michael Beaulieu	E&I Supervisor

4. DEFECT SUMMARY LIST

Defect Discipline Codes		Defect Category Codes		Defect Priority Codes	
P	Piping	A	Safety or critical to operation	1	Complete before Pre-Commissioning starts
C	Civil/Structural	B	Included in the construction package, not completed	2	Complete before Cold Commissioning starts
M	Mechanical	C	Included in the construction package, need to be reviewed by engineering	3	Complete before Hot Commissioning starts
E	Electrical	D	Not included in the construction package	4	Complete before starts-up
I	Instrument & Control	M	Modification requested by the operation department	5	Complete before Hand Over
				6	Complete after Hand Over

No.	Discipline	Category	Priority	Description of Problem	Solution to be Used	Resp.	Target Date	Task Complete Accepted By	Date
1	P	B	3	Finish connexion line 214	Move freshet to dewatering	Const			
2	P	B	3	Line 0210 on a electrical cable near WTP	Lift the line 0210	Const			
3	P	B	3	Missing bolt on valve at Tee 0211 & 0210	Install missing bolt	Const			
4	P	B	3	Missing suction on A-50	Install when needed	Const			
5	P	B	3	Missing suction on A-51	Install when needed	Const			
6	P	B	3	Missing suction on AP-21	Inatall when needed	Const			
7	C	B	3	Jetty to short	Extend the jetty and piping	Const			
8	P	B	3	Connect piping 0222 to 0219	When pumping is needed	Const			
9	I	B	3	Missing paletteweel on discharge 0219	Install palett weel	Const			

All item on this list were completed prior of the lake dewatering

Appendix E

QA reports



11-07-2020

2:00 PM

4:00 PM

Claude Gagné, Guillaume Baril

Visit date

Time (Start/End)

Prepared by

Weather: ☒ Sunny ☐ Cloudy ☐ Rain ☐ Storm

Wind: ☐ None ☒ Light ☐ Moderate ☐ Strong Temperature: 20 °C

Comments:

Appendix: ☐ Yes ☐ No Pictures: ☒ Yes ☐ No

SAFETY REMARKS

ACTIVITIES PERFORMED BY AEM QA REPRESENTATIVE

Activities	Approximate location	Visual observation during field visit
Pipe installation	On NE Dike Line PC11-0214	Good installation of the pipe. Proper handling to avoid damaging the pipe.
Pipe inspection	Line 648-200-WFR-PC11-0214	• Connection between a Mineflex hose and an HDPE with incorrect bolt length. Extra washer to compensate to a lack of thread. (Photo 1) • The line is crossing two existing lines at AP-5 on an uneven ground. To prevent any damage to the existent pipe elevate the new pipe. (Photo 2) • Pipe insulation damaged with the culvert during installation. Hard to tell if there is any damage to the pipe inside the culvert. (Photo 3) • Half of the bolts was installed on the Mineflex connection. (Photo 4)

ADDITIONNAL COMMENTS:

- Ensure to install all MTO.

SPECIFIC ELEMENTS VERIFIED

Elements	Location	Scope and comments

QA DAILY NOTES

The line 648-200-WFR-PC11-0214 was installed on NE dikes and cross road 7 at Nemo road intersection instead of in front of A-49 (Photo 5). The crossing is an HDPE pipe buried under the road. Test will be made to determine if the pipe is in good shape.

Issued by AEM QA
Representative :

Claude Gagné
Signature

11-07-2020
Date

PHOTOS/PICTURES



Photo 1. Mineflex hose connection with multiple washer, North of the culvert of AP-5



Photo 2. Pipe crossing two smaller pipes, AP-5



Photo 3. Pipe insulation damaged with the culvert, AP-5



Photo 4. Missing bolts at a Mineflex connection, beside the pit ramp culvert

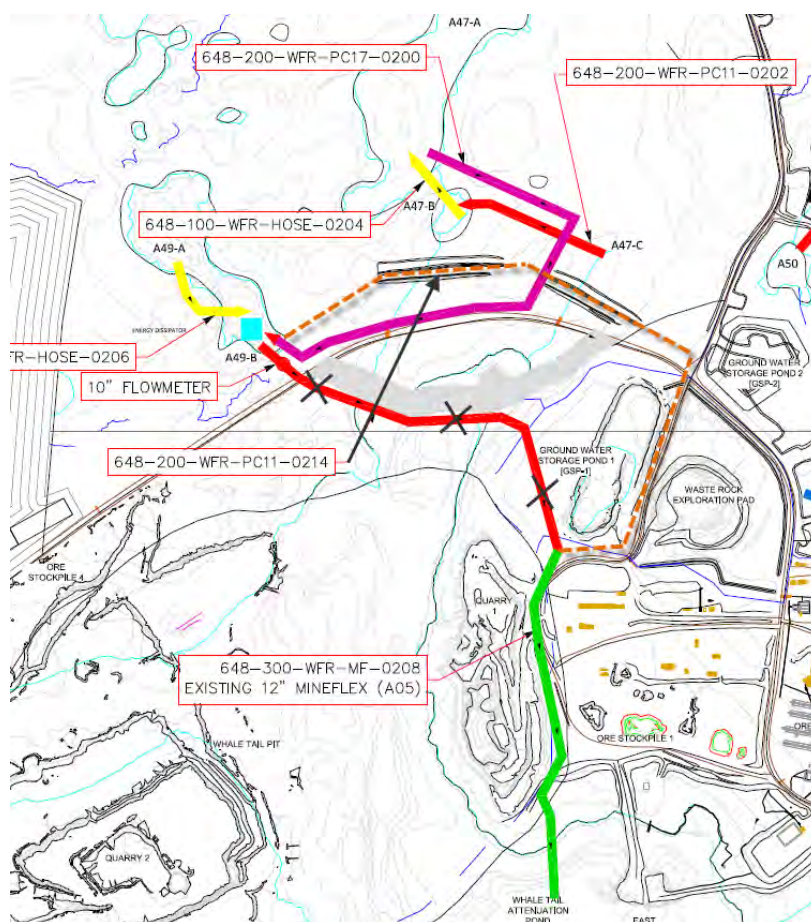


Photo 5. Actual route of the pipe 648-200-WFR-PC11-2014



AGNICO EAGLE

QA INSPECTION REPORT DEWATERING PHASE 2

12-07-2020	2:00 PM	3:00 PM	Claude Gagné
Visit date	Time (Start/End)		Prepared by

Weather: ☒ Sunny ☐ Cloudy ☐ Rain ☐ Storm

Wind: ☐ None ☐ Light ☒ Moderate ☐ Strong Temperature: 20 °C

Comments: _____

Appendix: ☐ Yes ☐ No Pictures: ☒ Yes ☐ No

SAFETY REMARKS

ACTIVITIES PERFORMED BY AEM QA REPRESENTATIVE

Activities	Approximate location	Visual observation during field visit
Pipe inspection	Line 648-200-WFR-PC17-0200	- Utilization of 8" insulated instead of 8" non-insulated - Flange connection at every 6 section of 50'
Pipe inspection	648-200-WFR-PC11-0214 Middle of NE Dike	Old instrument hole in the pipe (Photo 1)

ADDITIONNAL COMMENTS:

- Replace or repair the section with the hole.

SPECIFIC ELEMENTS VERIFIED

Elements	Location	Scope and comments

QA DAILY NOTES

Phase 1 pipes for A-49 and A-47 were reinstalled.

Issued by AEM QA
Representative :

Claude Gagné
Signature

12-07-2020
Date

PHOTOS/PICTURES



Photo 1. Instrument hole in the line 648-200-WFR-PC11-0214, NE Dike



Photo 2. Line PC17-0200 and PC11-0214 from left to right, NE Dike



AGNICO EAGLE

QA INSPECTION REPORT DEWATERING PHASE 2

13-07-2020	10:30 PM	12:00 PM	Claude Gagné
Visit date	Time (Start/End)		Prepared by

Weather: ☒ Sunny ☐ Cloudy ☐ Rain ☐ Storm

Wind: ☐ None ☐ Light ☒ Moderate ☐ Strong Temperature: 14 °C

Comments: _____

Appendix: ☐ Yes ☐ No Pictures: ☒ Yes ☐ No

SAFETY REMARKS

ACTIVITIES PERFORMED BY AEM QA REPRESENTATIVE

Activities	Approximate location	Visual observation during field visit
Fusion	Fusion Pad	• Good alignment of the pipe before fusion • Proper cleaning inside and outside of the pipe • Proper double roll-back bead after fusion

ADDITIONNAL COMMENTS:

- Avoid any rough handling of the pipe for an additional 30 minutes after cooling (e.g. let the pipe fall from the pipe support)
- Workers use a smartphone app from the manufacturer of the fusion machine to know the fusion parameters to use depending on the pipe according to ASTM F2620

SPECIFIC ELEMENTS VERIFIED

Elements	Location	Scope and comments
Fusion	Fusion Pad	Absence of register of fusion parameters (heat temperature, soak time, cooling time)

QA DAILY NOTES

Issued by AEM QA
Representative :

Claude Jagné
Signature

13-07-2020
Date

PHOTOS/PICTURES



Photo 1. Ongoing fusion on old 8" DR11 Pipe, Fusion Pad

Period: 2020-07-14 to 2020-07-18 Laurier Collette
Report Prepared by

Visit date:	time (Start/End)		QA Rep.	Weather	Wind conditions	Temperature
2020-07-17	2PM	5PM	LC, FB	Sunny	Strong	15
2020-07-18	1PM	3PM	LC	Sunny	Light	15

Comments: No QC activities/records for the period

Appendix: ☐ Yes ☐ No Pictures: ☒ Yes ☐ No

SAFETY REMARKS

Nothing to report

SUMMARY OF CONSTRUCTION ACTIVITIES

- Line installation A49 (Peanut lake) to Attenuation pond (MineFlex or 14")
- Re-install 8" A49 to A47
- Re-install line from A47 to tundra (Mineflex)
- Instal line A47A to A49
- Access road AP-21
- Piping A50-51-52
- Piping AP21
- Pipe fusion

ACTIVITIES PERFORMED BY AEM QA REPRESENTATIVE

Periodic QA inspections performed by the QA Representative to monitor the construction activities, progress and QC program.

Activities	Approximate location	Visual observation during field visit
Fusion spot check	South Ring Road Fusion Pad	• Good alignment of the pipe before fusion • Proper cleaning inside and outside of the pipe • Proper double roll-back bead after fusion • Fusion parameters are verified but are not recorded
Pipe visual inspection	A51-52-53, AP21	• Piping flanged every 300ft • No gasket on almost all flange assemblies
Culvert visual inspection	Road 7 by AP5	• About 1ft of unburied corrugated culvert at both end

ADDITIONNAL COMMENTS:

- No QC activities/ not documented, for this period
- Workers use a smartphone app from the manufacturer of the fusion machine to know the fusion parameters to use depending on the pipe according to ASTM F2620

SPECIFIC ELEMENTS VERIFIED

Elements	Location	Scope and comments
Fusion	Fusion Pad	Fusion parameters (heat temperature, soak time, cooling time) are not recorded
Piping	Line #0215, #0217, #0222,	No gasket on flanged connections
Piping	Line #0214	14" HDPE from A49 to NE dike east leg rather than Mine flex
Piping	Line #0200	Pipe section to be installed by Lake A47A (see photo #3)
Culvert	Road 7 by AP5	

QA NOTES

Some pipes have a lot of wear on them. This item is not covered in the Specifications



Discussed with AEM Construction Representative:

Jessy Gauthier

2020-07-18 4:20 PM

Cons. Rep.

Date & Time

Issued by AEM QA
Representative :


Signature

2020-07-19

Date

PHOTOS/PICTURES



Photo 1. Culvert crossing ring road by AP5



Photo 2. Fusion spot check



Photo 3. Line #0200 by A47-A lake



Photo 4. Flanged assembly without gasket



Photo 5. 12" MineFlex Line 0214 (NE Dike – East Leg)



Photo 6. 14" HDPE line 0214 (NE Dike – West Leg)

Period: 2020-07-19 to 2020-07-25 Claude Gagné
Report Prepared by

Visit date:	time (Start/End)		QA Rep.	Weather	Wind conditions	Temperature
2020-07-19	10AM	11AM	LC	Sunny	Light	15
2020-07-20			LC	Sunny	Light	15
2020-07-24			CG	Sunny	Light	20
2020-07-25			CG	Cloudy	Moderate	15

Comments: No QC activities/records for the period

Appendix: ☐ Yes ☐ No Pictures: ☒ Yes ☐ No

SAFETY REMARKS

Nothing to report

SUMMARY OF CONSTRUCTION ACTIVITIES

- Pipe Fusion
- Installation of 648-200-WFR-PC11-0210 (Line to Att. Pond from A53 tie-in)
- Finalization of piping A50-51-52

ACTIVITIES PERFORMED BY AEM QA REPRESENTATIVE

Periodic QA inspections performed by the QA Representative to monitor the construction activities, progress and QC program.

Activities	Approximate location	Visual observation during field visit
Fusion spot check	South Ring Road Fusion Pad	• Good alignment of the pipe before fusion • Proper cleaning inside and outside of the pipe • Proper double roll-back bead after fusion • Fusion parameters are verified but are not recorded
Pipe visual inspection	A47, A49	• No gasket on almost all flange assemblies
Pipe visual inspection	A50-51-52, A-P21	• During operation the pipe must be flanged and unflanged to change from pond to pond • No gasket on almost all flange assemblies

ADDITIONNAL COMMENTS:

- No QC activities/ not documented, for this period
- Workers use a smartphone app from the manufacturer of the fusion machine to know the fusion parameters to use depending on the pipe according to ASTM F2620

SPECIFIC ELEMENTS VERIFIED

Elements	Location	Scope and comments
Piping	Line #0211	Installation of a Y on the suction. Will be remove. (Photo 1)
Flange connection	Line #0217	No gasket on flange assemblie (Photo 3)

QA NOTES

Some pipes have a lot of wear on them. This item is not covered in the Specifications

After discussion with AEM Construction, there will be no hydrostatic leak test on any line for the dewatering.

Gasket on flange assemblie will be installed only if the pipe is permanent.

☒
Discussed with AEM Construction Representative:

Alex Gelinas

Cons. Rep.

2020-07-27 2:00 PM

Date & Time

Issued by AEM QA Representative :

Claude Gagné

Signature

2020-07-30

Date

PHOTOS/PICTURES



Photo 1. Y on the suction of the Line #0211



Photo 2. Finalization of the discharge of the Line #0217



Photo 3. Flange connection Line #0217

Period: 2020-08-01 to 2020-08-08
Laurier Collette
Report Prepared by

Visit date:	time (Start/End)		QA Rep.	Weather	Wind conditions	Temperature
2020-08-01	10AM	11AM	CG	Sunny	Light	20
2020-08-06	11AM	12AM	LC	Overcast	None	15
2020-08-08	4PM	5PM	LC	Sunny	Light	20

Comments: No QC records for the period

Appendix: ☐ Yes ☐ No Pictures: ☒ Yes ☐ No

SAFETY REMARKS

Nothing to report

SUMMARY OF CONSTRUCTION ACTIVITIES

- Pipe Fusion
- Pipe installation

ACTIVITIES PERFORMED BY AEM QA REPRESENTATIVE

Periodic QA inspections performed by the QA Representative to monitor the construction activities, progress and QC program.

Activities	Approximate location	Visual observation during field visit
Fusion spot check	South Ring Road Fusion Pad	• Good alignment of the pipe before fusion • Proper cleaning inside and outside of the pipe • Proper double roll-back bead after fusion
Pipe visual inspection	A52-A53	• Mix of insulated and non-insulated pipe • Some flanged connections without gasket • 8" to 14" reducer at pipe line discharge
		•

ADDITIONNAL COMMENTS:

- QC not documented, for this period
-

SPECIFIC ELEMENTS VERIFIED

Elements	Location	Scope and comments
Line 0219	Between A52 & A53	Some flanged connections without gasket

QA NOTES

Missing gaskets previously discussed with construction (refer to 2020-07-25 QA report)

☐ Discussed with AEM Construction Representative:

Cons. Rep.

Date & Time

Issued by AEM QA Representative :

Signature

2020-08-09

Date

PHOTOS/PICTURES



Photo 1. Pipe fusion on 14" DR17 (Blue line)



Photo 2. Pipe alignment for



Photo 3. Flange connection Line #0219



Photo 4. Discharge end Line #0219



Photo 4. Line #0219 towards A53 lake

Period: 2020-08-09 to 2020-08-15 Laurier Collette
Report Prepared by

Visit date:	time (Start/End)		QA Rep.	Weather	Wind conditions	Temperature
2020-08-12	10AM	12PM	LC/GB	Sunny	Light	20
2020-08-15	2PM	3PM	GB	Overcast	Light	15

Comments: No QC records for the period

Appendix: ☐ Yes ☐ No Pictures: ☒ Yes ☐ No

SAFETY REMARKS

Nothing to report

SUMMARY OF CONSTRUCTION ACTIVITIES

- Pipe walkdown with construction representative & E&I

ACTIVITIES PERFORMED BY AEM QA REPRESENTATIVE

Periodic QA inspections performed by the QA Representative to monitor the construction activities, progress and QC program.

Activities	Approximate location	Visual observation during field visit
Pipe walkdown	A47 to attenuation pond	• Hole in pipe from former paddlewheel flowmeter • No gasket on flanged connections • Loose bolt on flanged connexion – All other flanges properly bolted • Mineflex twist and bends • Missing mineflex length near Quarry 1 (about 200ft) – section have been installed afterwards • Line is 8" from A47 to NE Dike and then goes to 14" HDPE & 12" Mineflex • Mineflex squeezed between ground and HDPE 8" pipe • Presence of water in the 12" mineflex section
Pipe walkdown	A53 to attenuation pond	• Bad pipe alignment at fusion connection (line 210) • Pipe running on electrical cable (line 210) • Improper/insufficient bolting at valve connections (line 210 & 211 tie-in)

Pipe walkdown	A50,A51 & AP21 to IVR att. pond	• Piping in bad condition (old pipe) • No gasket on flanged connections • 2 washers per bolt, all bolts are present and tight • A53 discharge is directly on the shore • Pump and suction at A50 still missing, to be installed shortly • New access road to att. Pond is being built. • A52 is already dewatered, the pipe hasn't been installed
ADDITIONNAL COMMENTS: • QC not documented, for this period • Fish-out is completed in A49 (Aug. 15 2020)		

SPECIFIC ELEMENTS VERIFIED

Elements	Location	Scope and comments
Line 200/208	From A47 to attenuation pond	More work was required prior to starting pumping
Line 211/210	From A53 to attenuation pond	Corrective work to be done prior to using the line
Line 215	From A50 to attenuation pond	Pump and suction to be installed shortly
Line 217	From A51 to attenuation pond	Pump and suction from A50 to be transferred when A50 is dewatered
Line 222	From AP21 to A52	Pad to AP21 needs to be extended since the water dropped

QA NOTES**Line 200/208:**

Critical corrections to be done prior to starting the line for the first time have been performed by E&I & construction on 2020-08-12/2020-08-13

Commissioning of the line occurred during the day of 2020-08-13. Leaks have been detected. Damaged pipe have been replaced. The line is now operational.

Line 215/217/219 :

Some pipes are in bad shape (item not covered in the specifications), and also without on flanged connections (item already discussed)

No VPO forms received from QC/Construction at the time of issuing this QA report

☒ Discussed with AEM Construction Representative:	Jessy Gauthier	During walkdown inspections
	Cons. Rep.	Date & Time

Issued by AEM QA Representative :


Signature

2020-08-17

Date

PHOTOS/PICTURES



1.1 Holes underneath saddle for former paddlewheel



1.2 Bend



1.3 Pipe complete twist



1.4 bend



1.5 Reducer 14"x12" at mineflex connection



1.6 Mineflex upstream of ring road crossing – squeezed by 8" HDPE pipe

Photo set #1. Line #200 & 208



2.1 bad pipe alignment at fusion joint



2.2 bad pipe alignment at fusion joint



2.3 Pipe laying over electrical cable



2.4 Insufficient bolting at valve connections



2.5 Tie-in line 210x211

Photo set #2. Line 210 & 211



3.1 A50 pumping station, pump and suction to be installed



3.2 Flange properly bolted, without gasket
Pipe showing damage



3.3 A53 discharge point



3.4 Acces road to AP-21, pad to be extended



3.5 intersection line 200-214

Period: 2020-09-13 to 2020-09-19 Arnaud Poirier, Claude Gagné
Report Prepared by

Visit date:	time (Start/End)		QA Rep.	Weather	Wind conditions	Temperature
2020-09-14	7:00	8:00	AP/LC	Overcast	Light	0
2020-09-15	10:00	11:30	AP	Sunny and cloudy	heavy	-3
2020-09-16	13:30	14:30	AP	Overcast	Light	-2
2020-09-18	12:30	13:30	CG	Sunny	Light	0

Comments:

Appendix: ☐ Yes ☐ No Pictures: ☒ Yes ☐ No

SAFETY REMARKS

Nothing to report

SUMMARY OF CONSTRUCTION ACTIVITIES

- Pipe inspection following the activation of the two pumps dewatering the lakes A-50 and A-51

ACTIVITIES PERFORMED BY AEM QA REPRESENTATIVE

Periodic QA inspections performed by the QA Representative to monitor the construction activities, progress and QC program.

Activities	Approximate location	Visual observation during field visit
Dewatering pipe inspection	Lake A-50 and A-51	• The dewatering of the lake A-50 and A-51 is ongoing. • Gaskets missing on multiple flanges. • The pipe used for the dewatering of lake A-50 is cracked and leaking. • The pipe used for the dewatering of lake A-51 is cracked and leaking. • Both pumps are activated and pumping the two lakes in lake A-53. • One flange is leaking on the pipe used for the dewatering of lake A-50

ADDITIONNAL COMMENTS:

- The bad pipe conditions was already reported in previous QA reports.
- The missing gaskets of the flanges were already reported in previous QA reports.

SPECIFIC ELEMENTS VERIFIED

Elements	Location	Scope and comments

QA NOTES

Lines pumping A-50 and A-51:

The cracked pipes were replaced and the pumping is now continuing free of leaks

The faulty flange problem was addressed and the flange is now functioning correctly

AP-21 line was used to pump A-50 and A-51 in parallel

Gaskets are still missing on the flanges

☒ Discussed with AEM Construction Representative: Alex Gelinas | 2020/09/20 9:00
Cons. Rep. Date & Time

Issued by AEM QA
Representative :

Claude Gagné
Signature

2020/09/20
Date

PHOTOS/PICTURES



1.1 Pipe cracked between lake A-50 and lake A-53



1.2 Pipe cracked between lake A-51 and lake A-53



1.3 Lake A-51 discharging in lake A-53



1.4 Flange leaking near lake A-50



1.3 Lake A-50 being dewatered.

Photo set #1. Line used for the dewatering of the lakes A-50 and A-51