

PROJENET BETA 4
 FLOWMATE & PRESSURE = 40 GPH @ 10 FT
 HORSEPOWER = 1/4 HP
 VOLTAGE & PHASE = 240V, 3 PH, TFC, CL 1 DW 1
 FULL-LOAD AMPS = 1.2 A



PRICE PUMP RC-250
 FLOWMATE & PRESSURE = 40 GPH @ 10 FT
 HORSEPOWER = 1/4 HP
 VOLTAGE & PHASE = 240V, 3 PH, TFC, CL 1 DW 1
 FULL-LOAD AMPS = 1.2 A

OUTLET DUCKBILL
 FLOWMATE & PRESSURE = 400 W
 HORSEPOWER = 1/4 HP
 VOLTAGE & PHASE = 240V, 3 PH, TFC, CL 1 DW 1
 FULL-LOAD AMPS = 1.2 A

CINCINNATI LHM
 FLOWMATE & PRESSURE = 400 W
 HORSEPOWER = 1/4 HP
 VOLTAGE & PHASE = 240V, 3 PH, TFC, CL 1 DW 1
 FULL-LOAD AMPS = 1.2 A

CALORTEC CIT 3300/2/7003
 FLOWMATE & PRESSURE = 400 W
 HORSEPOWER = 1/4 HP
 VOLTAGE & PHASE = 240V, 3 PH, TFC, CL 1 DW 1
 FULL-LOAD AMPS = 1.2 A

PRICE PUMP RC-100
 FLOWMATE & PRESSURE = 40 GPH @ 10 FT
 HORSEPOWER = 1/4 HP
 VOLTAGE & PHASE = 240V, 3 PH, TFC, CL 1 DW 1
 FULL-LOAD AMPS = 1.2 A

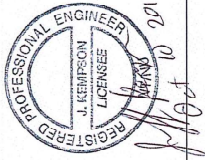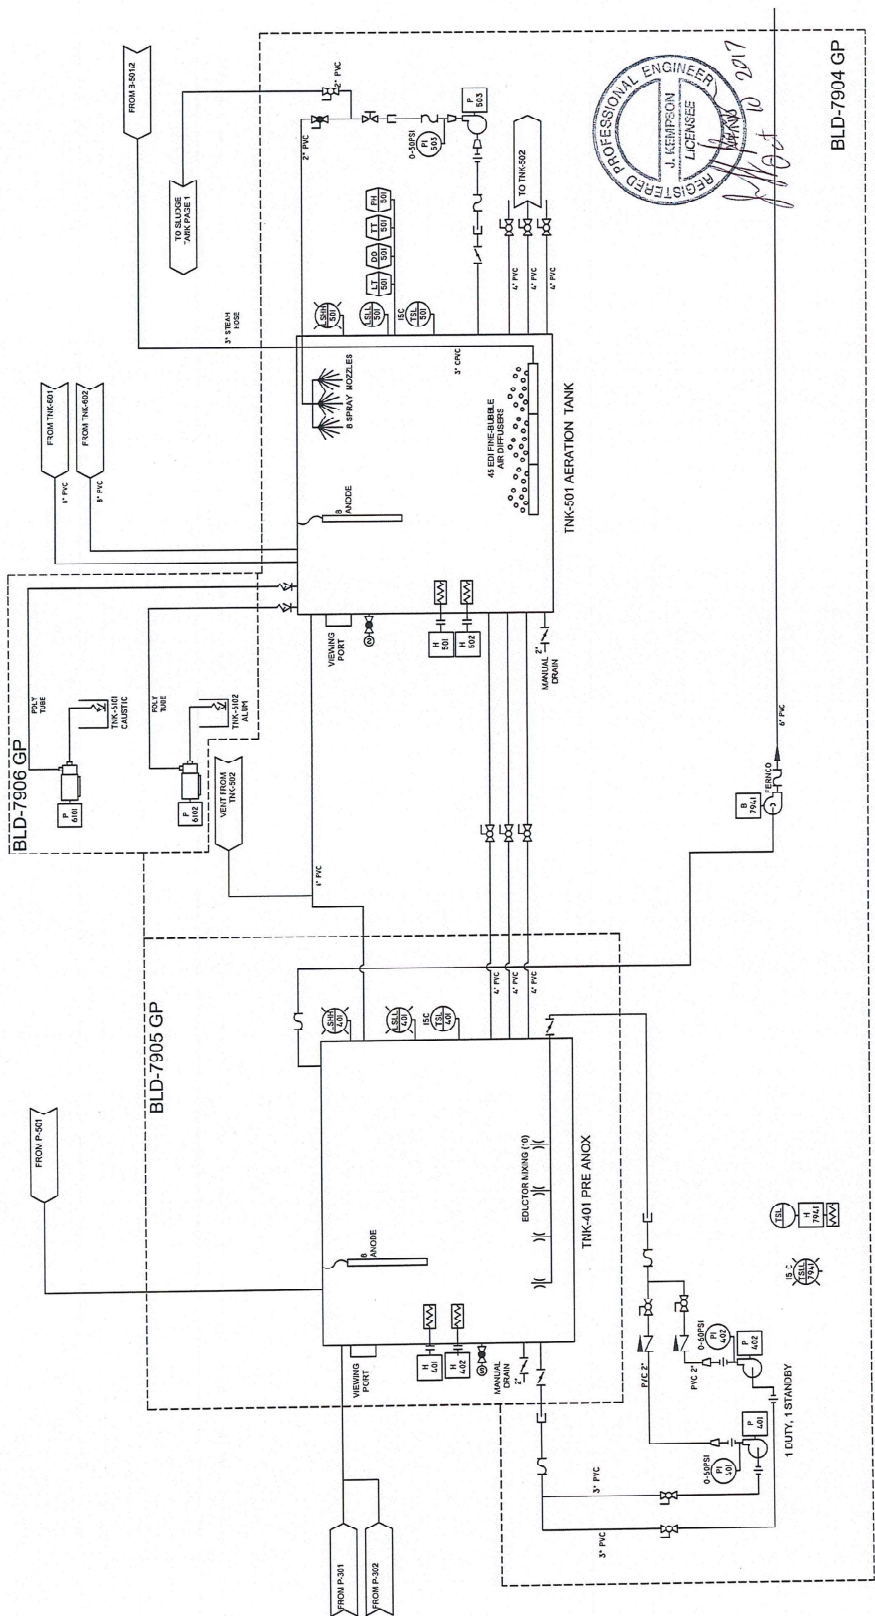

NOTES	 newterra		PHONE: (800) 420-1066 www.newterra.com		D	T-401 MK PIPE SIZE	101017 JJK	PROJECT NUMBER		1704432	CUSTOMER		AGNICO EAGLE MINE			
					C	AS-BUILT	130617 JJK	TITLE AND LOCATION								
					B	PRODUCTION	060617 JJK	P&ID								
					A2	SUBMITTAL REVISIONS	280617 JJK	AMARUQ MINE								
					A	SUBMITTAL	230617 JJK									
					LEVEL		REVISION		DRAWN BY		DATE	CHECKED BY		DATE	APPROVED BY	

