
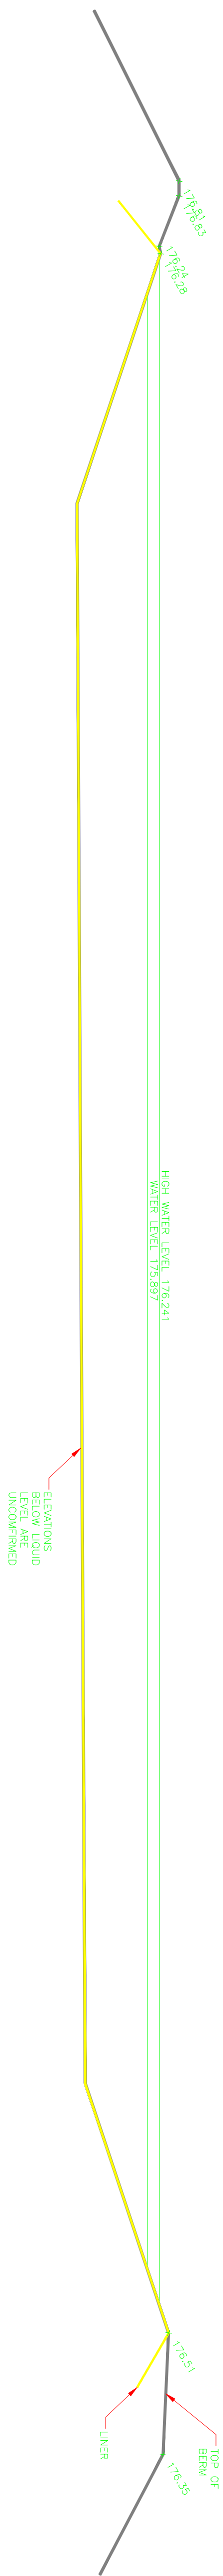


PWSP #1 AS BUILT PLAN VIEW

1:250

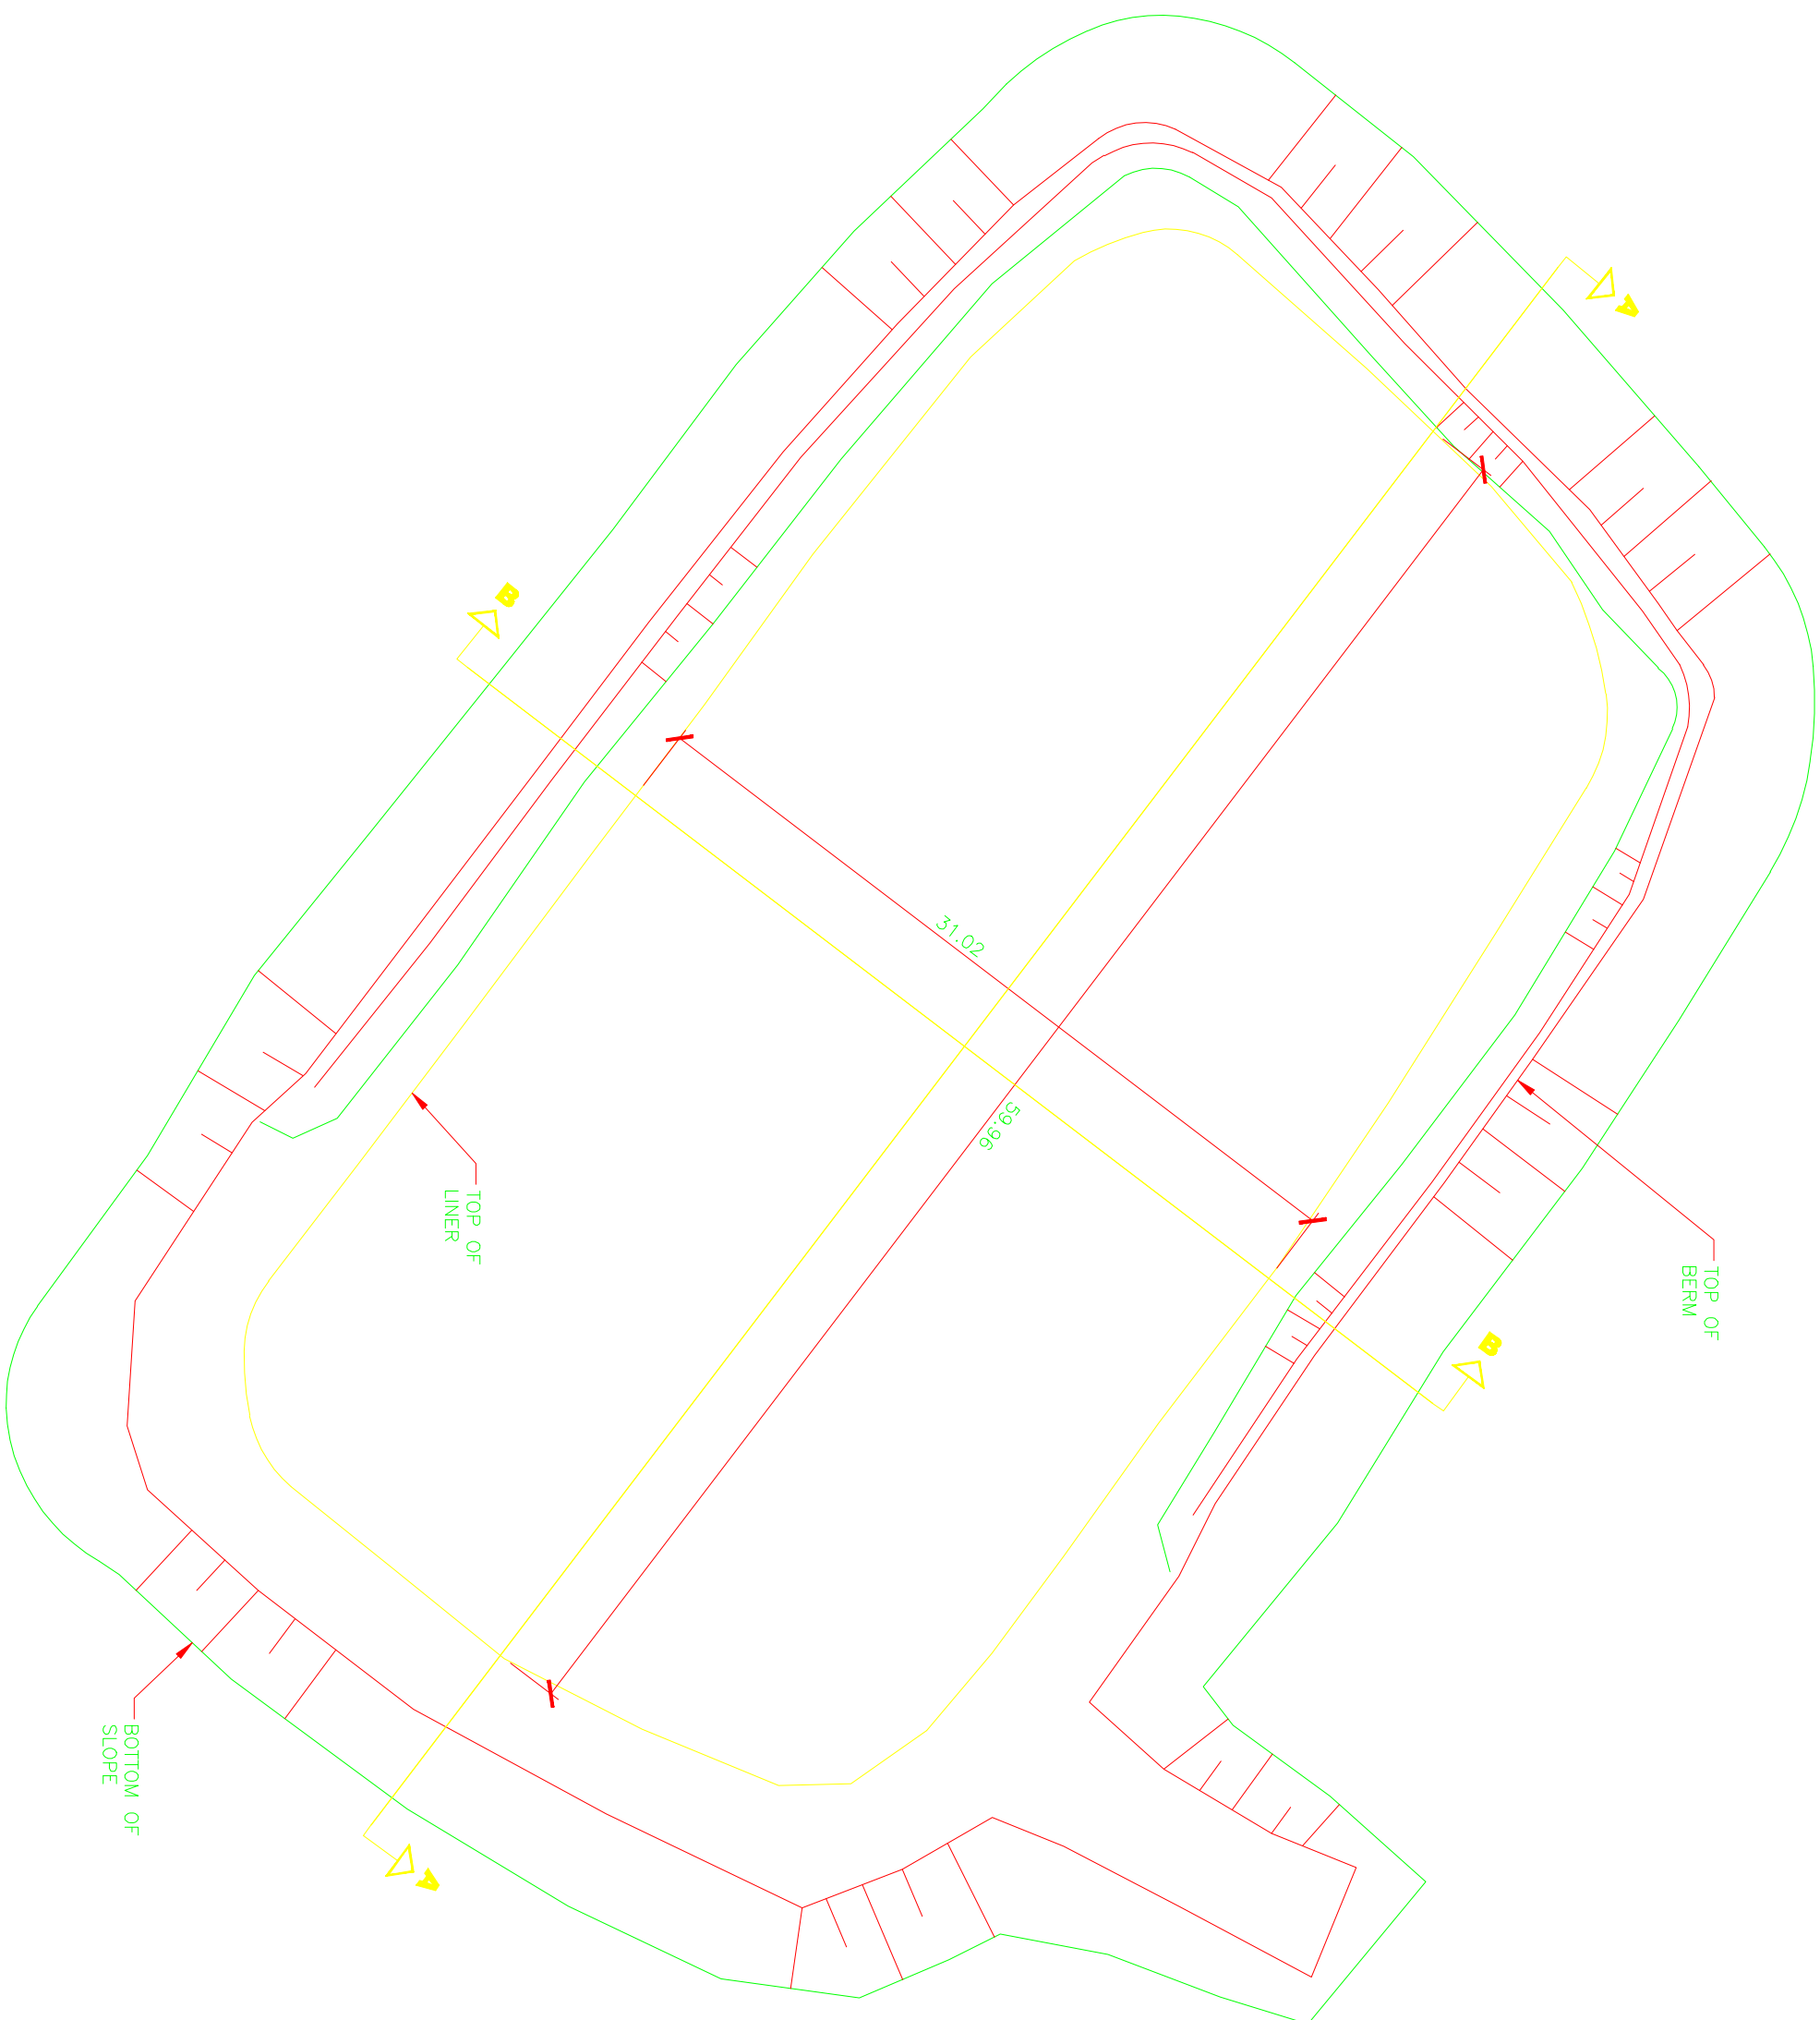


PWSP SECTION

1:100

A

C302

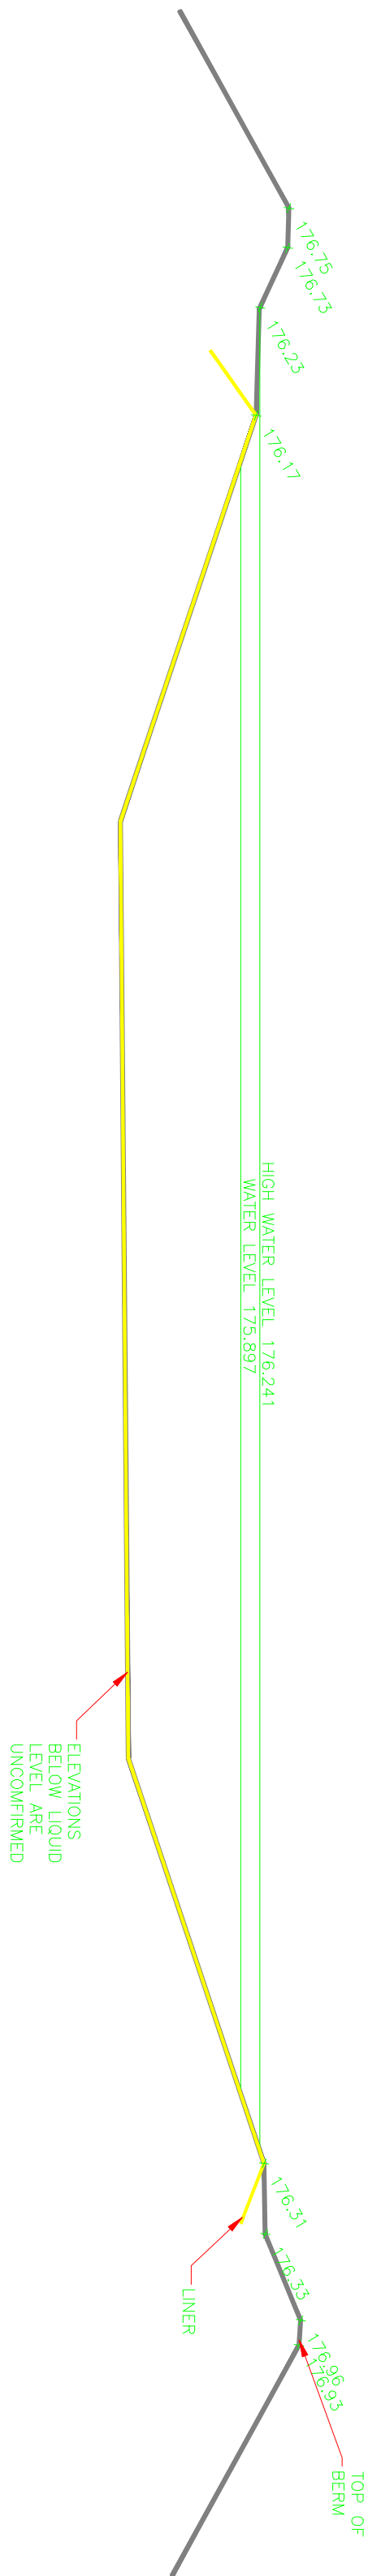

PWSP SECTION

1:100

B


C302

This Drawing is an instrument of service and shall remain the property of GENIVAR. It may not be reproduced or copied in any form. It shall not be used for the construction, engagement or alteration of any project without the written consent and authorization of the CONSULTANTS.

Contractors shall verify and be responsible for all dimensions and conditions on the job and report any discrepancies to the Consultant before proceeding with the work.

Drawings shall not be scaled.

Description	Date	No.
Revisions and Issues		

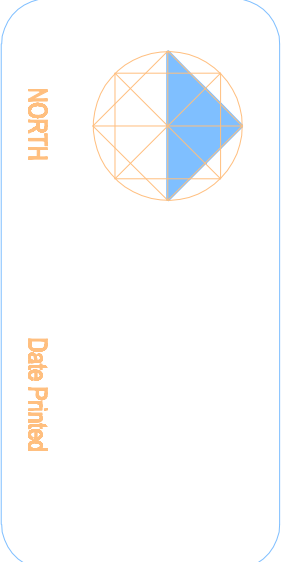

GENIVAR
804 Hunting Street Suite
P.O. Box 100
Thunder Bay, Ontario P7B 1K5
Canada
Tel: 807-346-4411
Fax: 807-346-4412
www.genivar.com

ARCHITECT
STRUCTURAL/CIVIL

MECHANICAL
ELECTRICAL

PROJECT
MARY RIVER PWSP #1
PLAN AND SECTIONS

Project
MARY RIVER PROJECT
BAIFINLAND IRON
MINES CORPORATION
NUNAVUT

Drawing
AS CONSTRUCTED
MARY RIVER PWSP #1
PLAN AND SECTIONS

Date	CAD File Number
MARCH 2009	REPORT/MARYRIVER/MS
Scale	Job Number
AS NOTED	
Drawn	Drawing Number
AS	09-058
Checked	
AS	
Approved	
	005