


This Drawing is an instrument of service and shall remain the property of GENIVAR. It may not be reproduced or copied in any form. It shall not be used for any purpose other than the specific design of a building other than the said project without the authorization of the CONSULTANTS.

Contractors shall verify and be responsible for all dimensions and quantities shown on this drawing. Any discrepancies shall be reported to the Consultant before proceeding with the work.

Drawings shall not be scaled.

2nd Pond	Nov 4, 08	1
Description	Date	No.
Revisions and Issues		

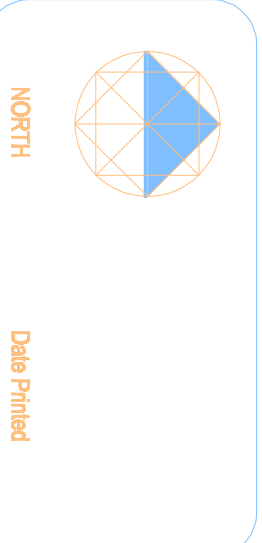

GENIVAR
Société par Actions
Simplifiée
Capital Social: 100 000 000
Siège Social: 100 000 000
Téléphone: 02 20 20 20 20
Fax: 02 20 20 20 20
Email: info@genivar.com

ARCHITECT
STRUCTURAL/CIVIL

MECHANICAL
ELECTRICAL

Project
MARY RIVER PROJECT
BAFFINLAND IRON
MINES CORPORATION
BAFFIN ISLAND
NUUNAVUT

Drawing
AS CONSTRUCTED
MARY RIVER PWSP2 & PWSP3
PLAN AND SECTIONS

Date	MARCH 2009	CADD File Number	FECKIMM/P/00000000
Scale	AS NOTED	Job Number	09-058
Drawn	SSSO		
Checked	MX	Drawing Number	006
Approved	MX		

