


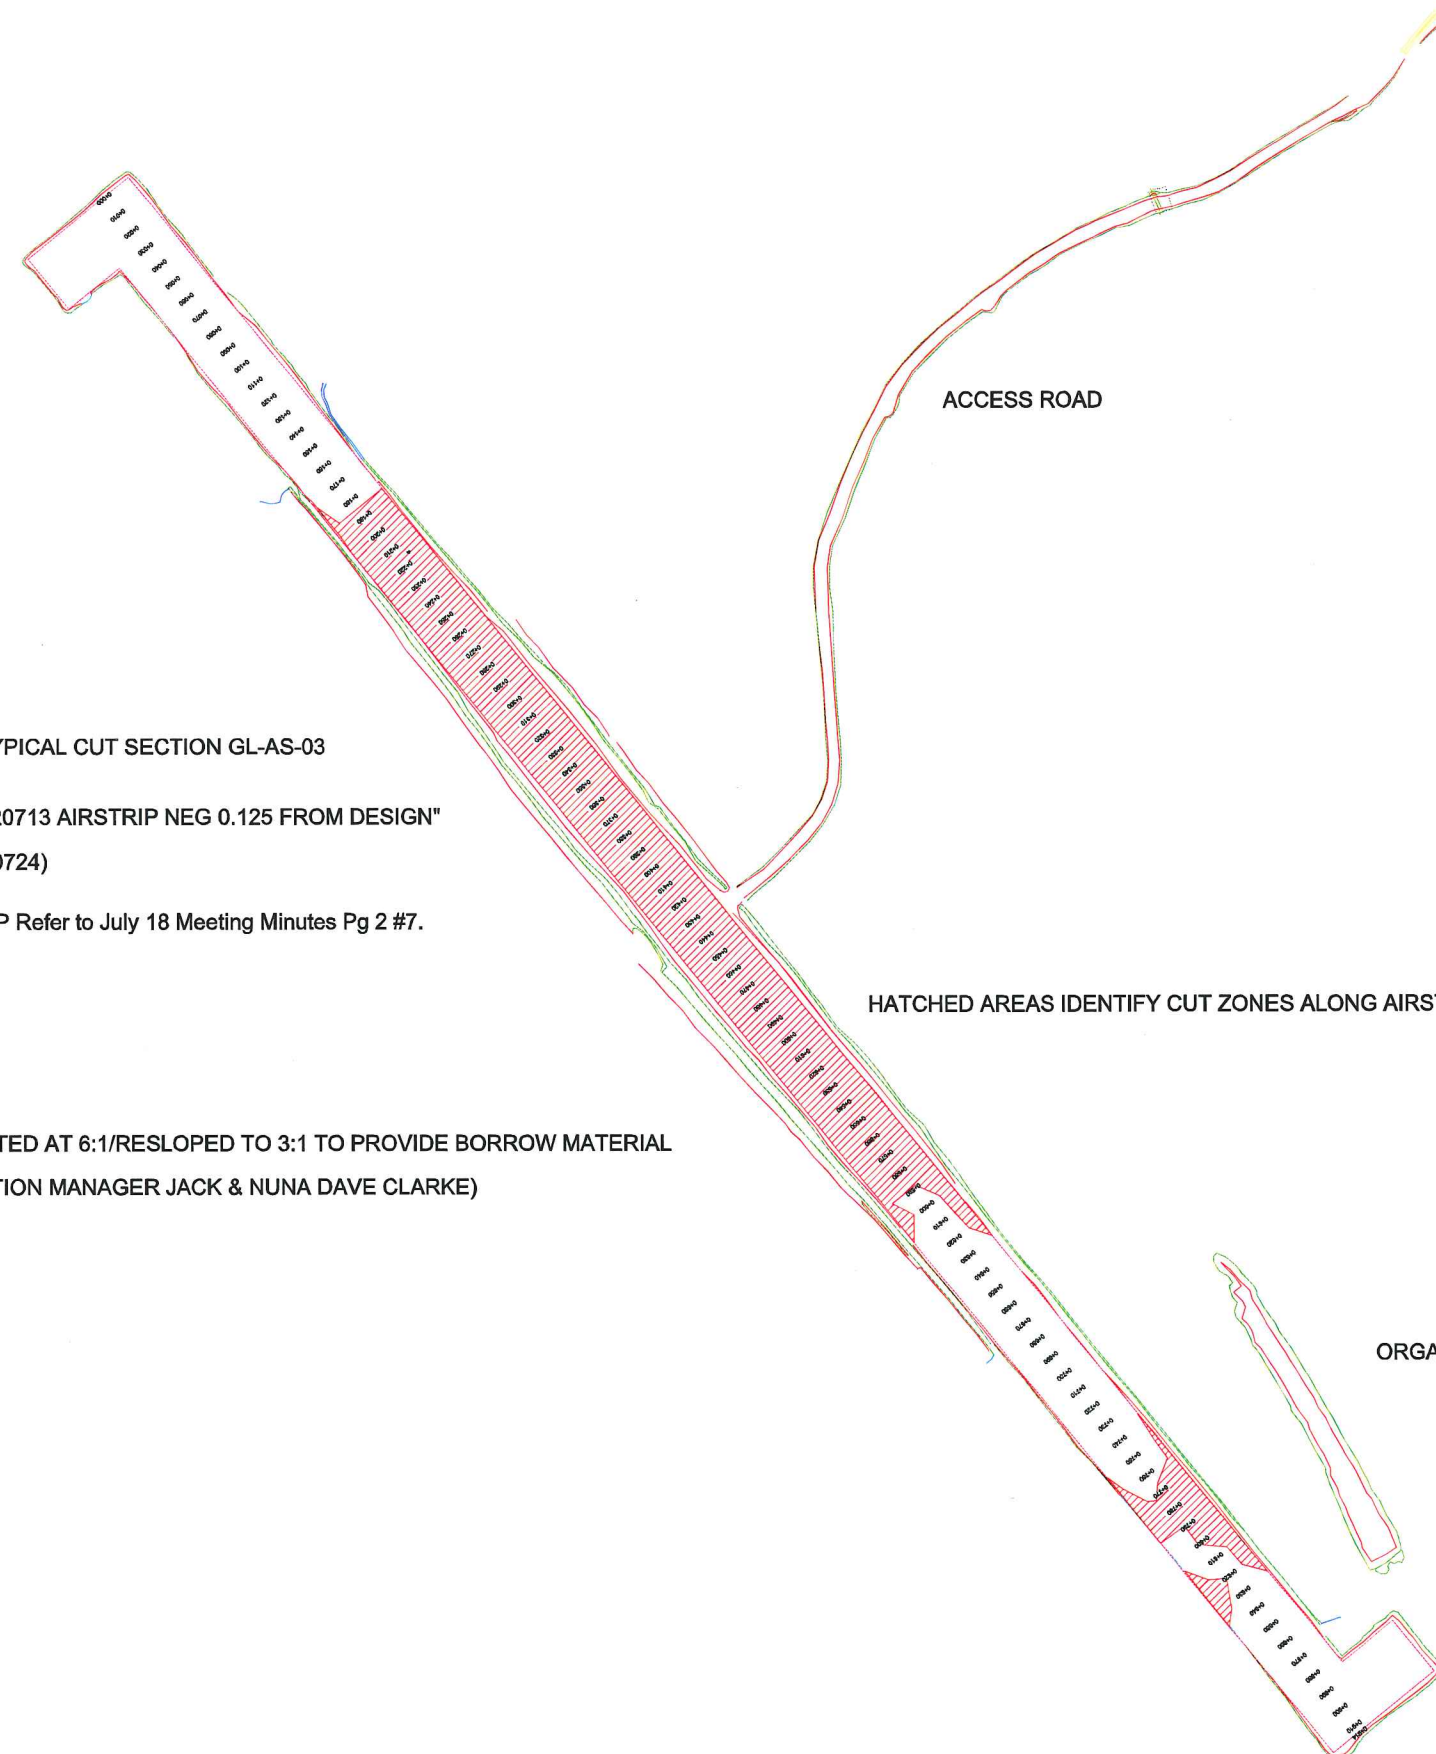

DITCH CUTS & BACKSLOPES FROM 0+000 TO 0+420 STAKED TO TYPICAL CUT SECTION GL-AS-03

SLOPE STAKES WERE BASED ON FILE PROVIDED BY NUNA "DE 120713 AIRSTRIP NEG 0.125 FROM DESIGN"

(See attached excel file "Compare SRK GL-AS-07 RevA vs Nuna CL 120724)

LAYOUT FILE REMODELED TO REFLECT -2% CROWN ON AIRSTRIP Refer to July 18 Meeting Minutes Pg 2 #7.

HATCHED AREAS IDENTIFY CUT ZONES ALONG AIRSTRIP RUNWAY


0+440-0+670 DITCH CREST LOCATED AT 6:1/RESLOPED TO 3:1 TO PROVIDE BORROW MATERIAL

(AS INSTRUCTED BY CONSTRUCTION MANAGER JACK & NUNA DAVE CLARKE)

ORGANICS STOCKPILE


  
*T.A. Morrison*  
26/12/13 FIG.1

|                                                                                                                                                                                                            |                                                                     |                                                                                      |                                                                                       |                        |                                                                    |                                                       |
|------------------------------------------------------------------------------------------------------------------------------------------------------------------------------------------------------------|---------------------------------------------------------------------|--------------------------------------------------------------------------------------|---------------------------------------------------------------------------------------|------------------------|--------------------------------------------------------------------|-------------------------------------------------------|
| NOTES:<br>HATCH-CUT ZONES ALONG AIRSTRIP RUNWAY<br>CUTS - RED<br>FILLS - BLUE<br>GRADE - GREEN<br>GREEN POLYLINE=TOES OF DITCH & FILL<br>OUTSIDE RED POLYLINE = CRESTS OF CUT SLOPE & EDGE AIRSTRIP/APRONS | CLIENT:<br>SABINA GOLD & SILVER CORP.<br>BACK RIVER-GOOSE LAKE CAMP | PREPARED BY:<br>NUNA Contracting Ltd.<br>9839 - 31 Avenue<br>Edmonton, AB<br>T6N 1C5 |  |                        | AIRSTRIP CONSTRUCTION                                              |                                                       |
|                                                                                                                                                                                                            | PROJECT:<br>AIRSTRIP Project, GOOSE LAKE<br>Nunavut                 | DRAWN BY:<br>MC                                                                      | SCALE:<br>NTS                                                                         | DATE:<br>Jan. 26, 2013 | STATUS MAP AUG. 12, 2012<br>TOTAL CUTS ALONG AIRSTRIP &<br>DITCHES |                                                       |
|                                                                                                                                                                                                            |                                                                     |                                                                                      |                                                                                       |                        |                                                                    | DRAWING NAME (YYMMDD):<br>SM 120812 AS GOOSE LAKE.dwg |

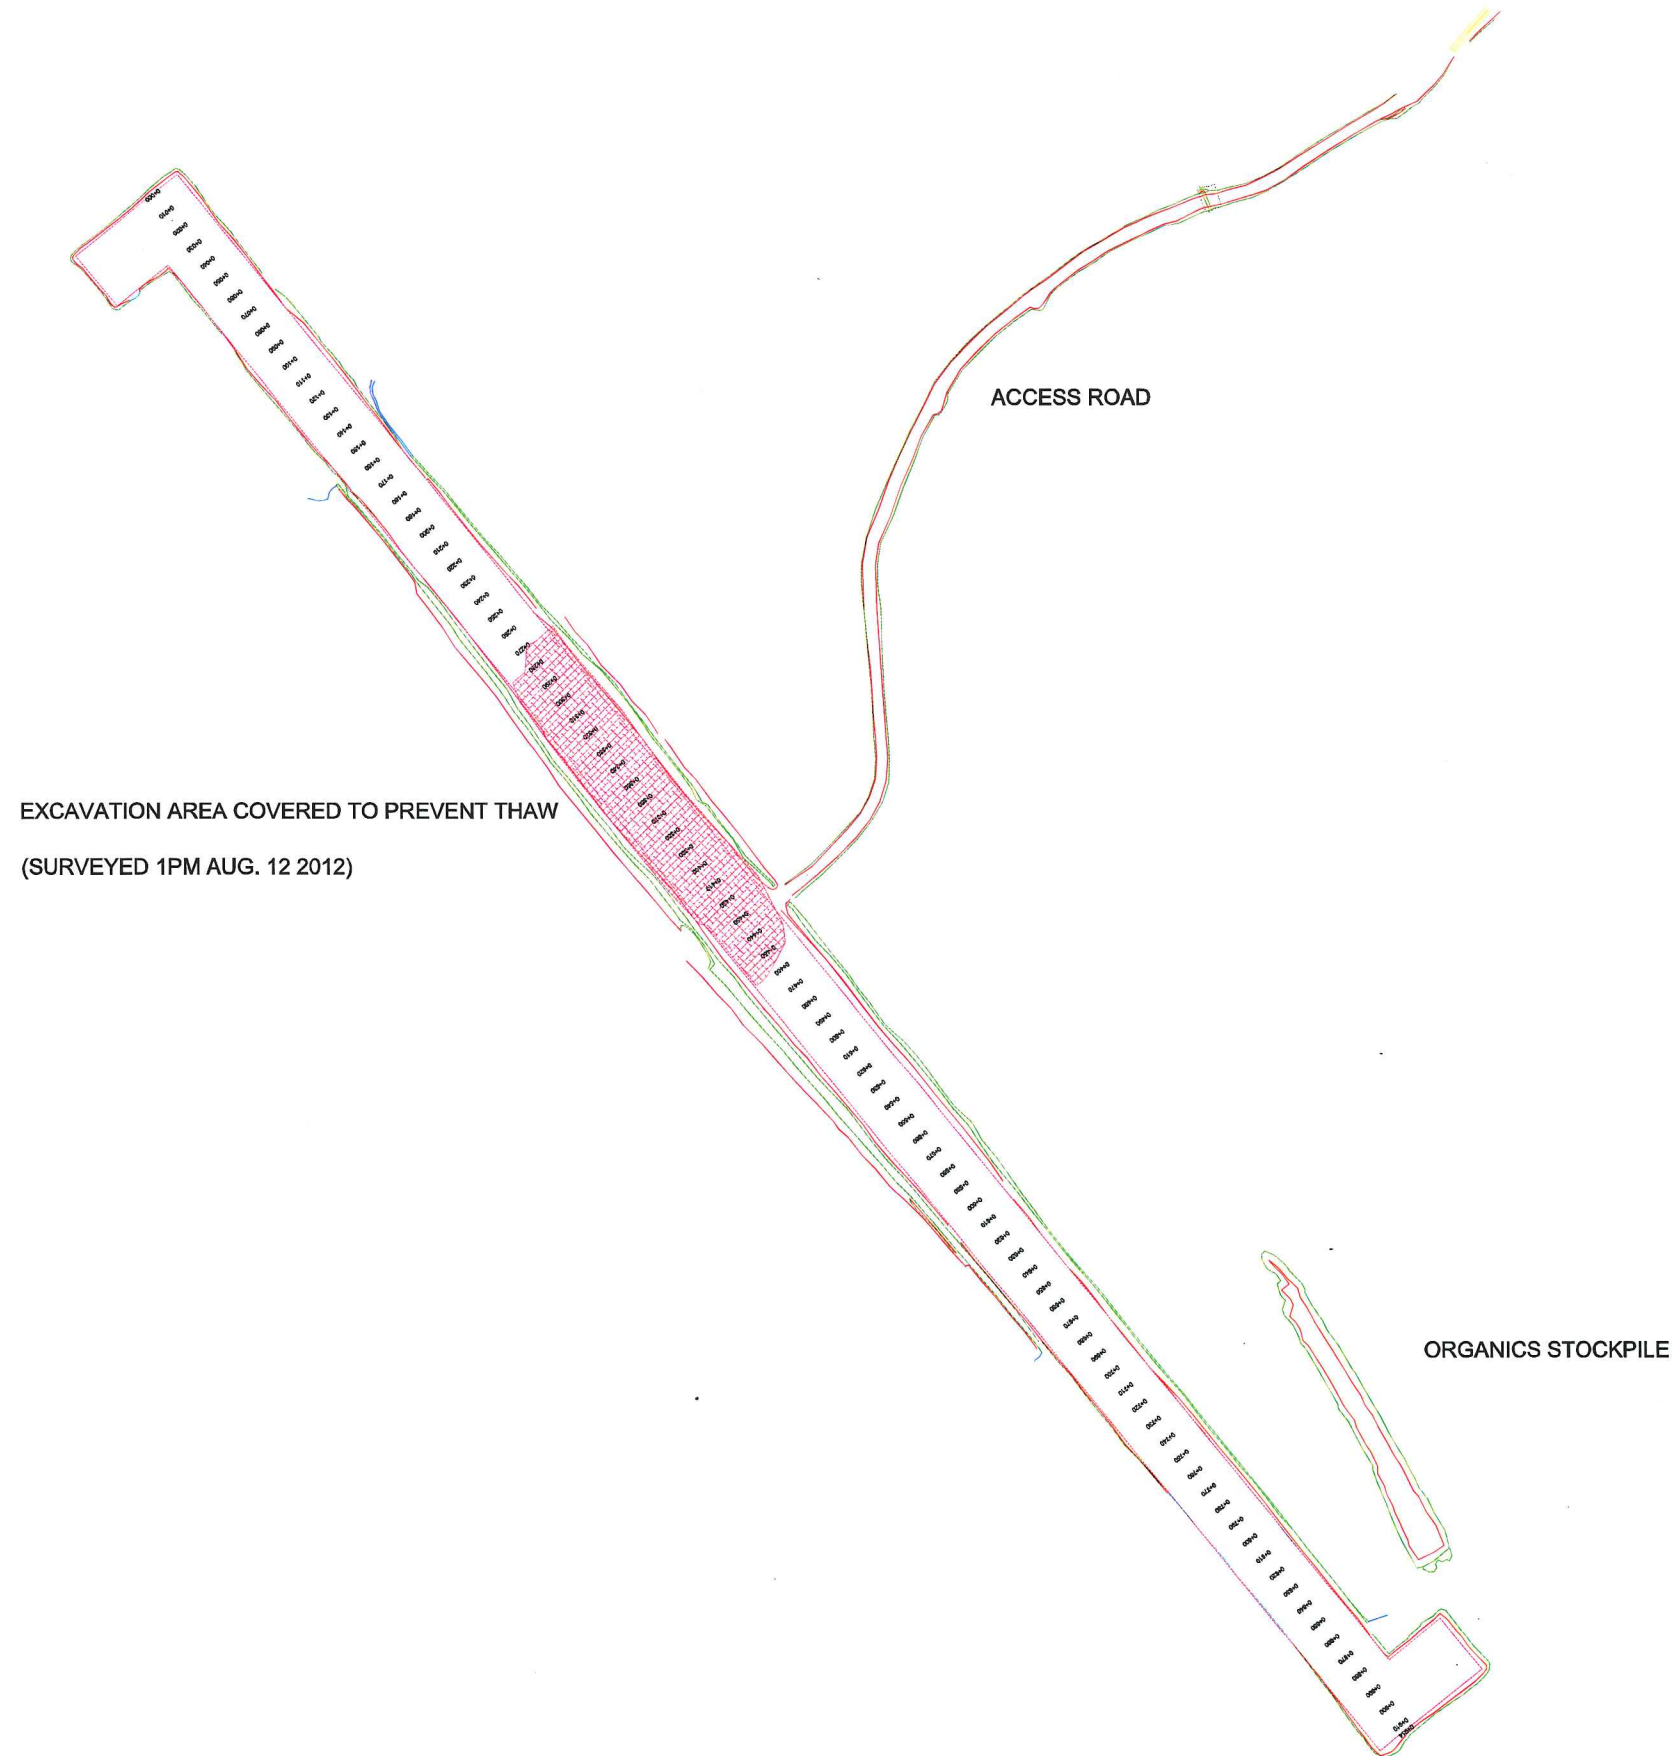

*T.A. Morrison*  
26/8/13 FIG 2

|                                                                                                                                                                                                                                                   |                                                                     |                                                                                      |                                                                                       |                        |                                                                        |                                                       |
|---------------------------------------------------------------------------------------------------------------------------------------------------------------------------------------------------------------------------------------------------|---------------------------------------------------------------------|--------------------------------------------------------------------------------------|---------------------------------------------------------------------------------------|------------------------|------------------------------------------------------------------------|-------------------------------------------------------|
| NOTES:<br>HATCH-AREA COVERED WITH LOCAL MATERIAL TO PREVENT THAW (NEEDS TO BE REMOVED)<br>CUTS - RED<br>FILLS - BLUE<br>GRADE - GREEN<br>GREEN POLYLINE=TOES OF DITCH & FILL<br>OUTSIDE RED POLYLINE = CRESTS OF CUT SLOPE & EDGE AIRSTRIP/APRONS | CLIENT:<br>SABINA GOLD & SILVER CORP.<br>BACK RIVER-GOOSE LAKE CAMP | PREPARED BY:<br>NUNA Contracting Ltd.<br>9839 - 31 Avenue<br>Edmonton, AB<br>T6N 1C5 |  |                        | AIRSTRIP CONSTRUCTION                                                  |                                                       |
|                                                                                                                                                                                                                                                   | PROJECT:<br>AIRSTRIP Project, GOOSE LAKE<br>Nunavut                 | DRAWN BY:<br>MC                                                                      | SCALE:<br>NTS                                                                         | DATE:<br>Jan. 26, 2013 | STATUS MAP AUG. 12, 2012<br>EXCAVATION ZONE COVERED TO<br>PREVENT THAW |                                                       |
|                                                                                                                                                                                                                                                   |                                                                     |                                                                                      |                                                                                       |                        |                                                                        | DRAWING NAME (YYMMDD):<br>SM 120812 AS GOOSE LAKE.dwg |

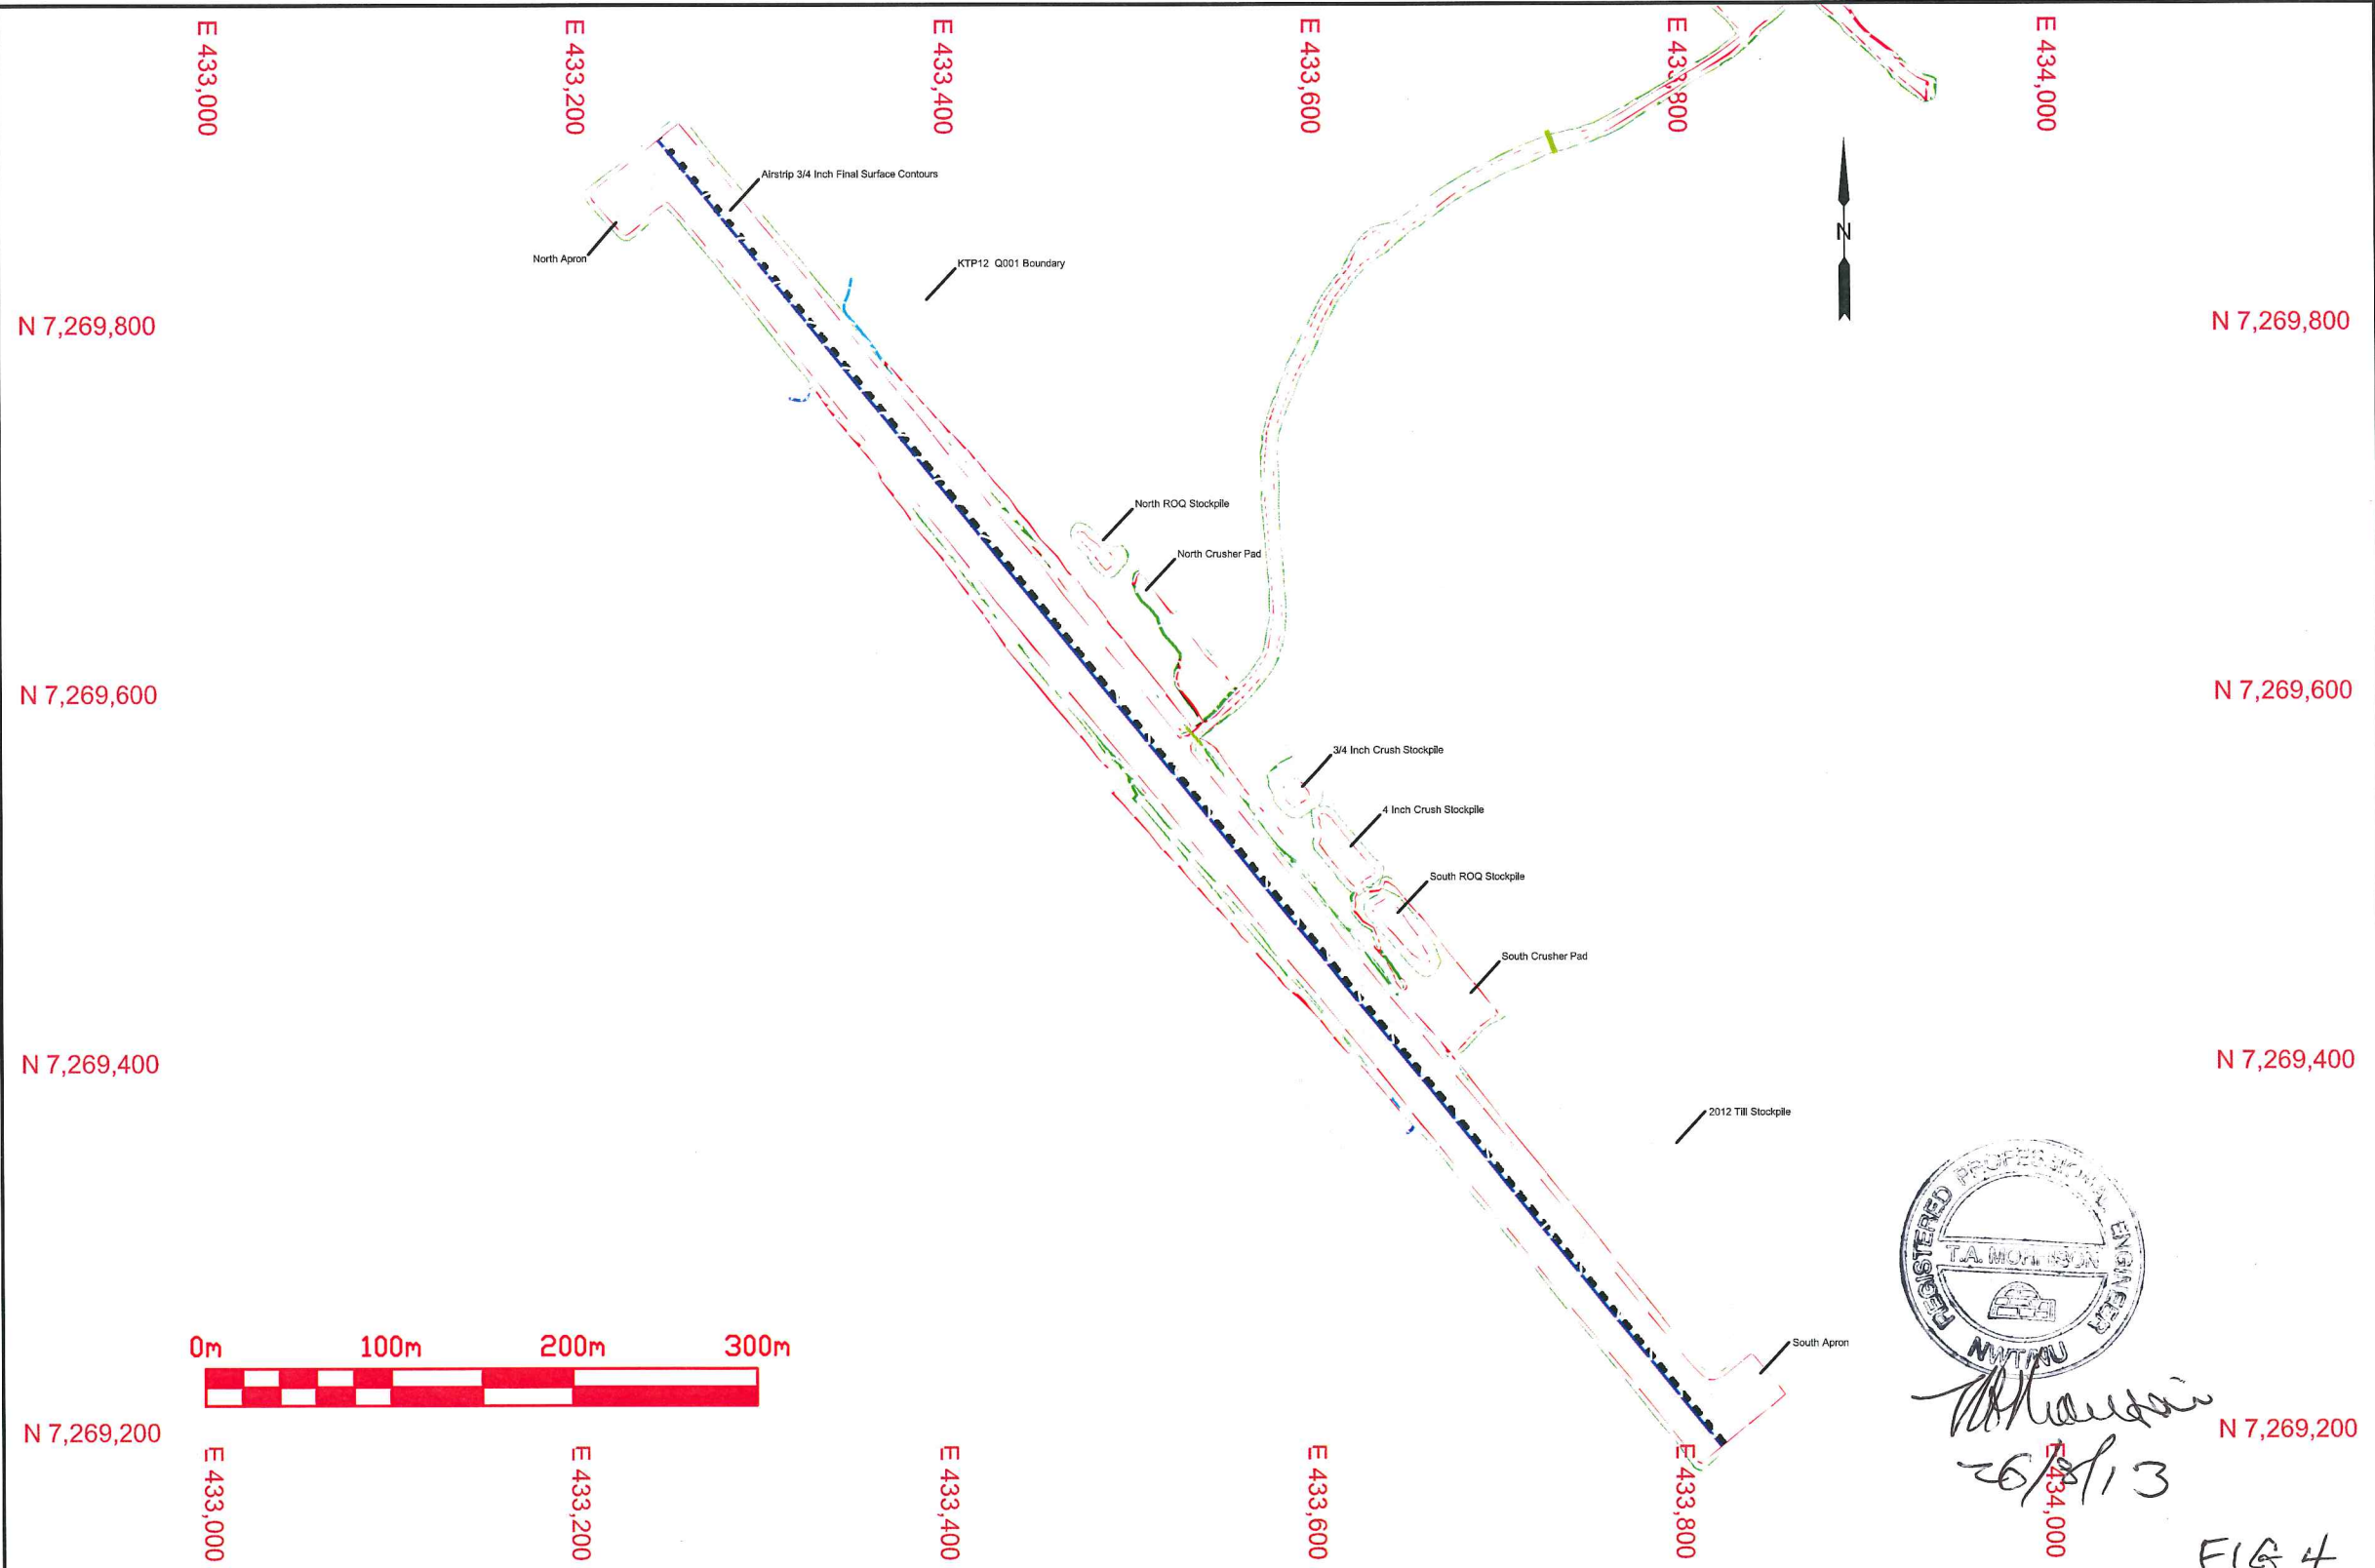

NOTES:  
X-Ref. Sheet AB ECM Volume Summary May 26 2013  
Asbuilt contour Interval 200mm  
Stockpiles surveyed May 22, 2013

CLIENT:  
**SABINA GOLD & SILVER CORP.**  
Back River Project

PROJECT:  
Goose Lake Airstrip, Goose Lake,  
Nunavut

PREPARED BY:  
NUNA Contracting Ltd.  
9839 - 31 Avenue  
Edmonton, AB  
T6N 1C5

DRAWN BY:  
mc




SCALE:  
1:5000

DATE:  
May 26, 2013


All Weather Airstrip Construction  
DRAWING TITLE:  
**Goose Lake Airstrip  
Final Asbuilt Surface & Stockpiles**

DRAWING NAME (YYMMDD):  
CAB 130523 AS Goose Lake.dwg




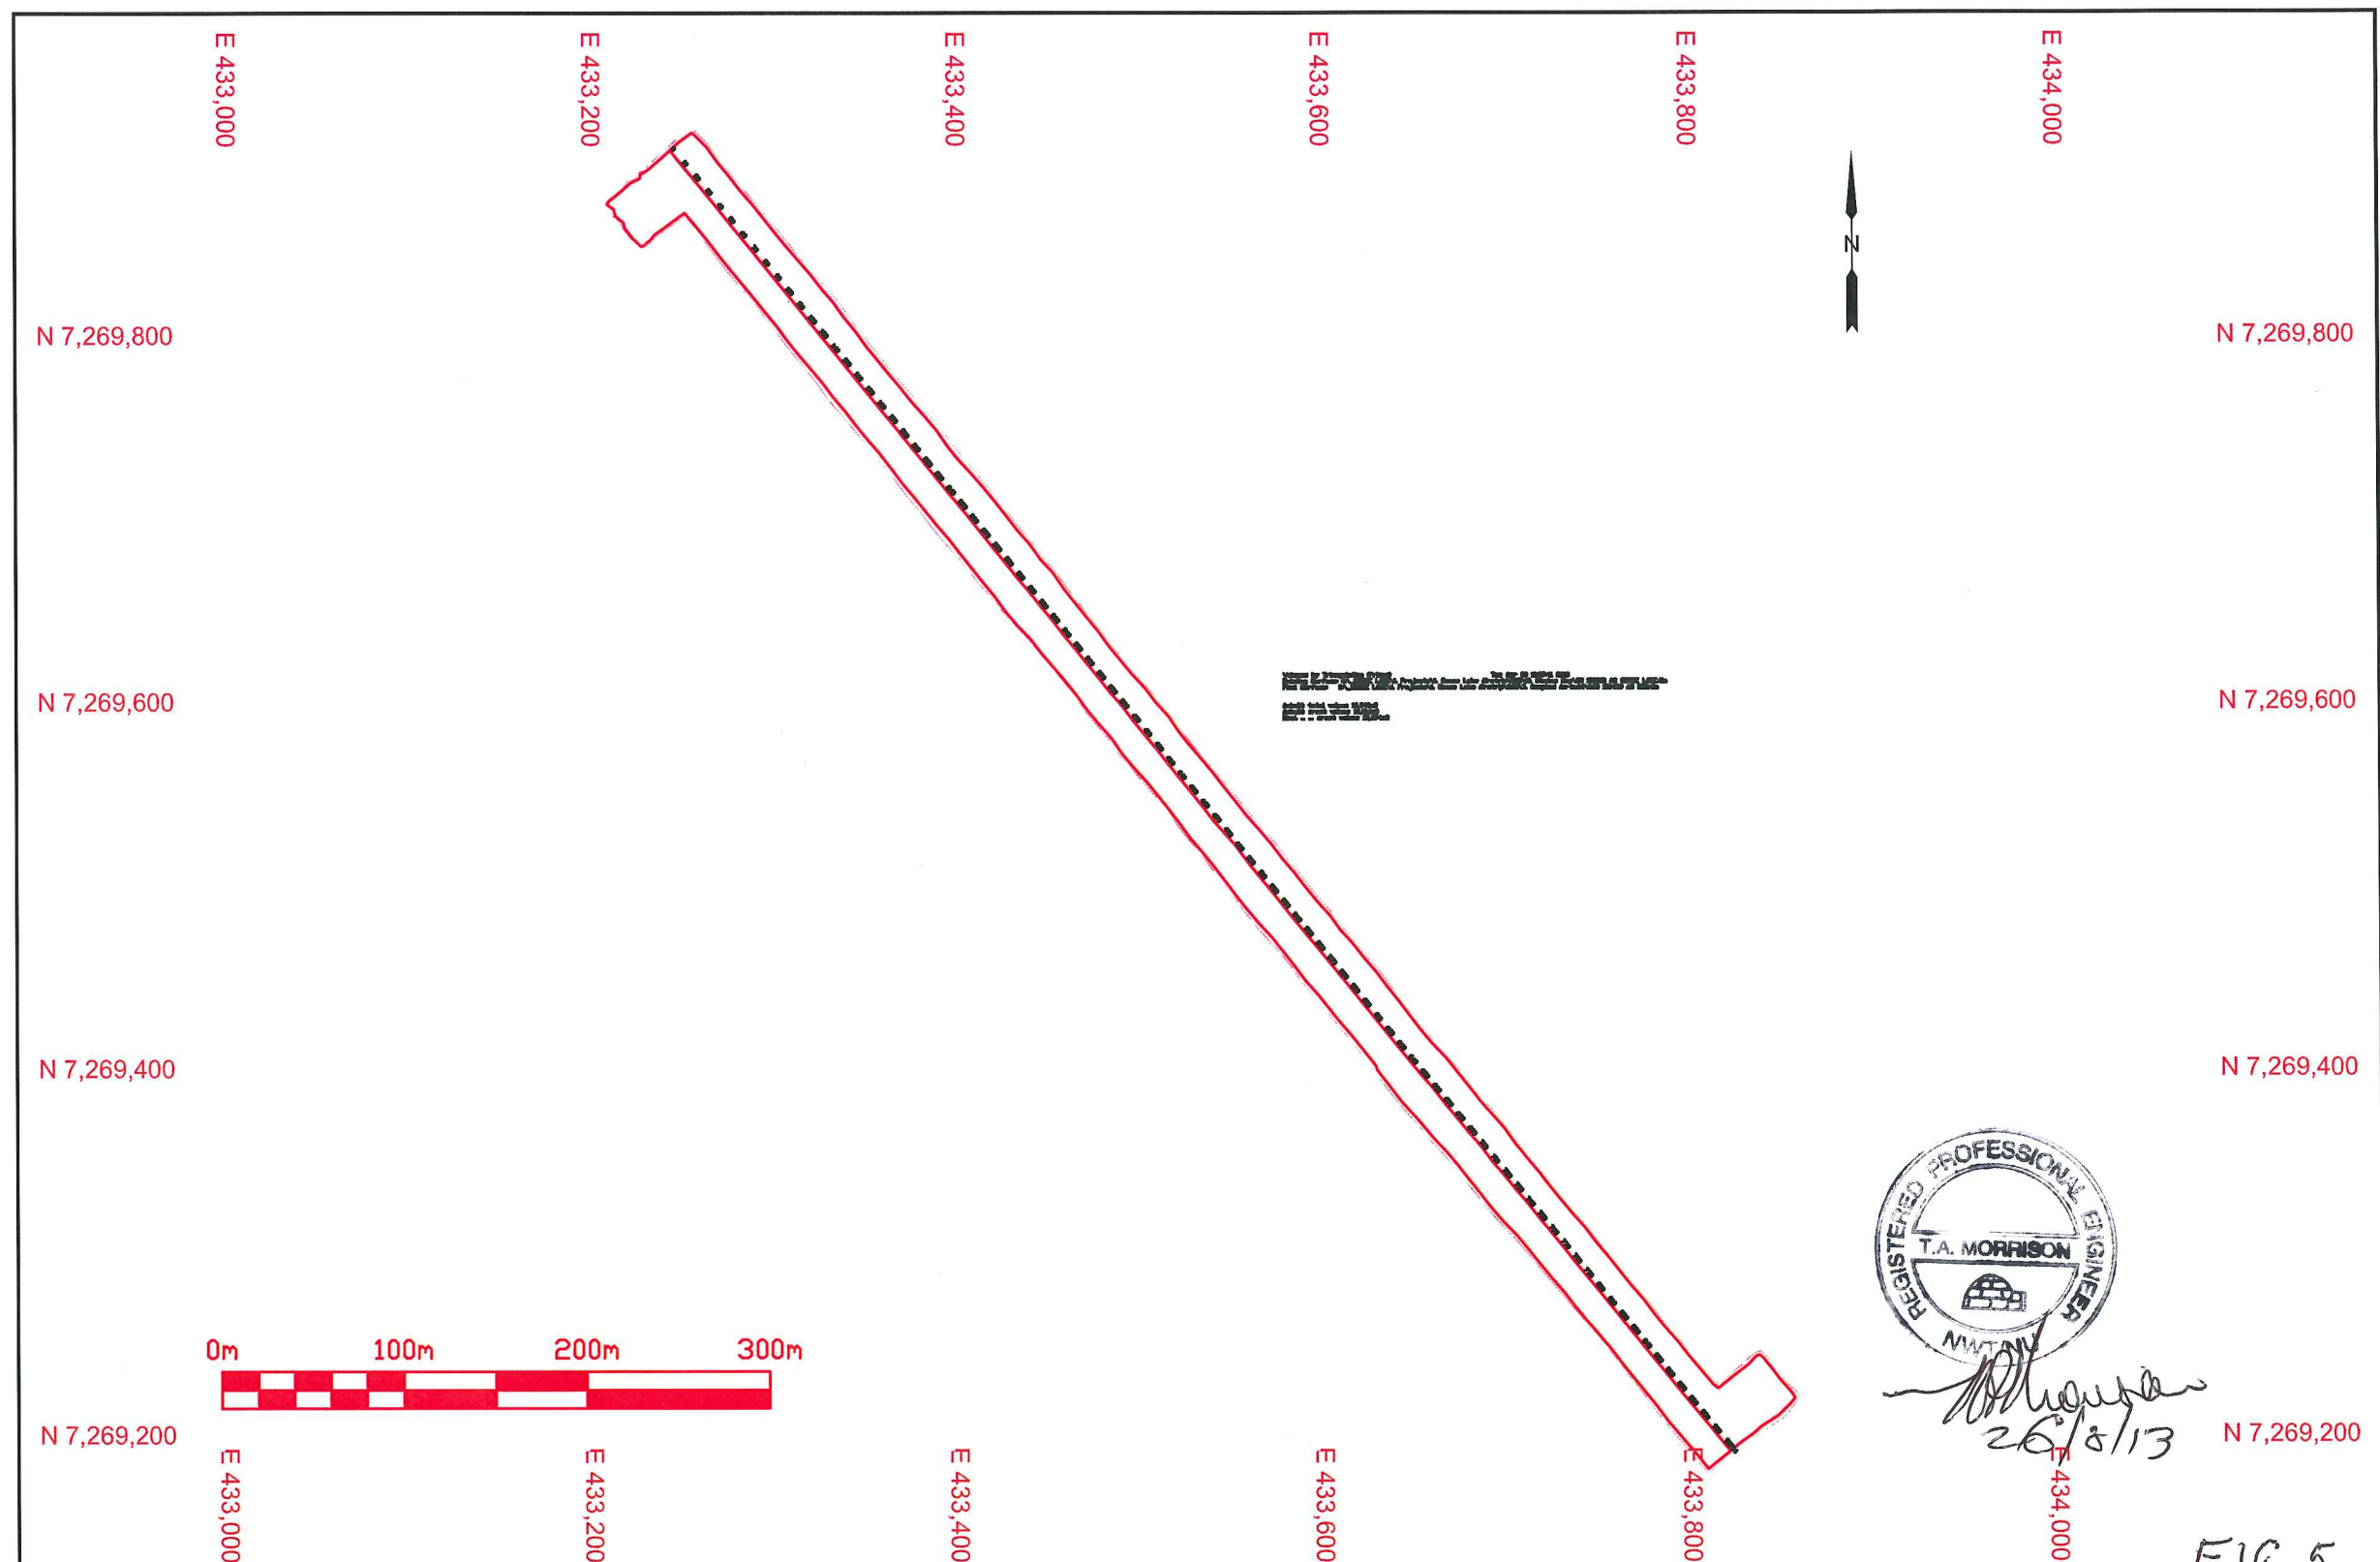

|                                                                                               |                                                             |                                                                                          |                                                 |                                   |                                                                                |
|-----------------------------------------------------------------------------------------------|-------------------------------------------------------------|------------------------------------------------------------------------------------------|-------------------------------------------------|-----------------------------------|--------------------------------------------------------------------------------|
| NOTES:<br><br>X-Ref Sheet AB ECM Volume Summary May 26 2013<br>Asbuilt Contour Interval 200mm | CLIENT:<br><br>SABINA GOLD & SILVER CORP.                   | PREPARED BY:<br><br>NUNA Contracting Ltd.<br>9839 - 31 Avenue<br>Edmonton, AB<br>T6N 1C5 |                                                 | ALL WEATHER AIRSTRIP CONSTRUCTION |                                                                                |
|                                                                                               | PROJECT:<br><br>Goose Lake Airstrip, Goose Lake,<br>Nunavut | DRAWN BY:<br><br>mc                                                                      | SCALE:<br><br>1:5000                            | DATE:<br><br>May 26, 2013         | DRAWING TITLE:<br><br>GOOSE LAKE AIRSTRIP<br>ROQ Asbuilt Surface Apr. 29, 2013 |
|                                                                                               |                                                             |                                                                                          | DRAWING NAME (YYMMDD):<br>CAB 130429 AS ROQ.dwg |                                   |                                                                                |

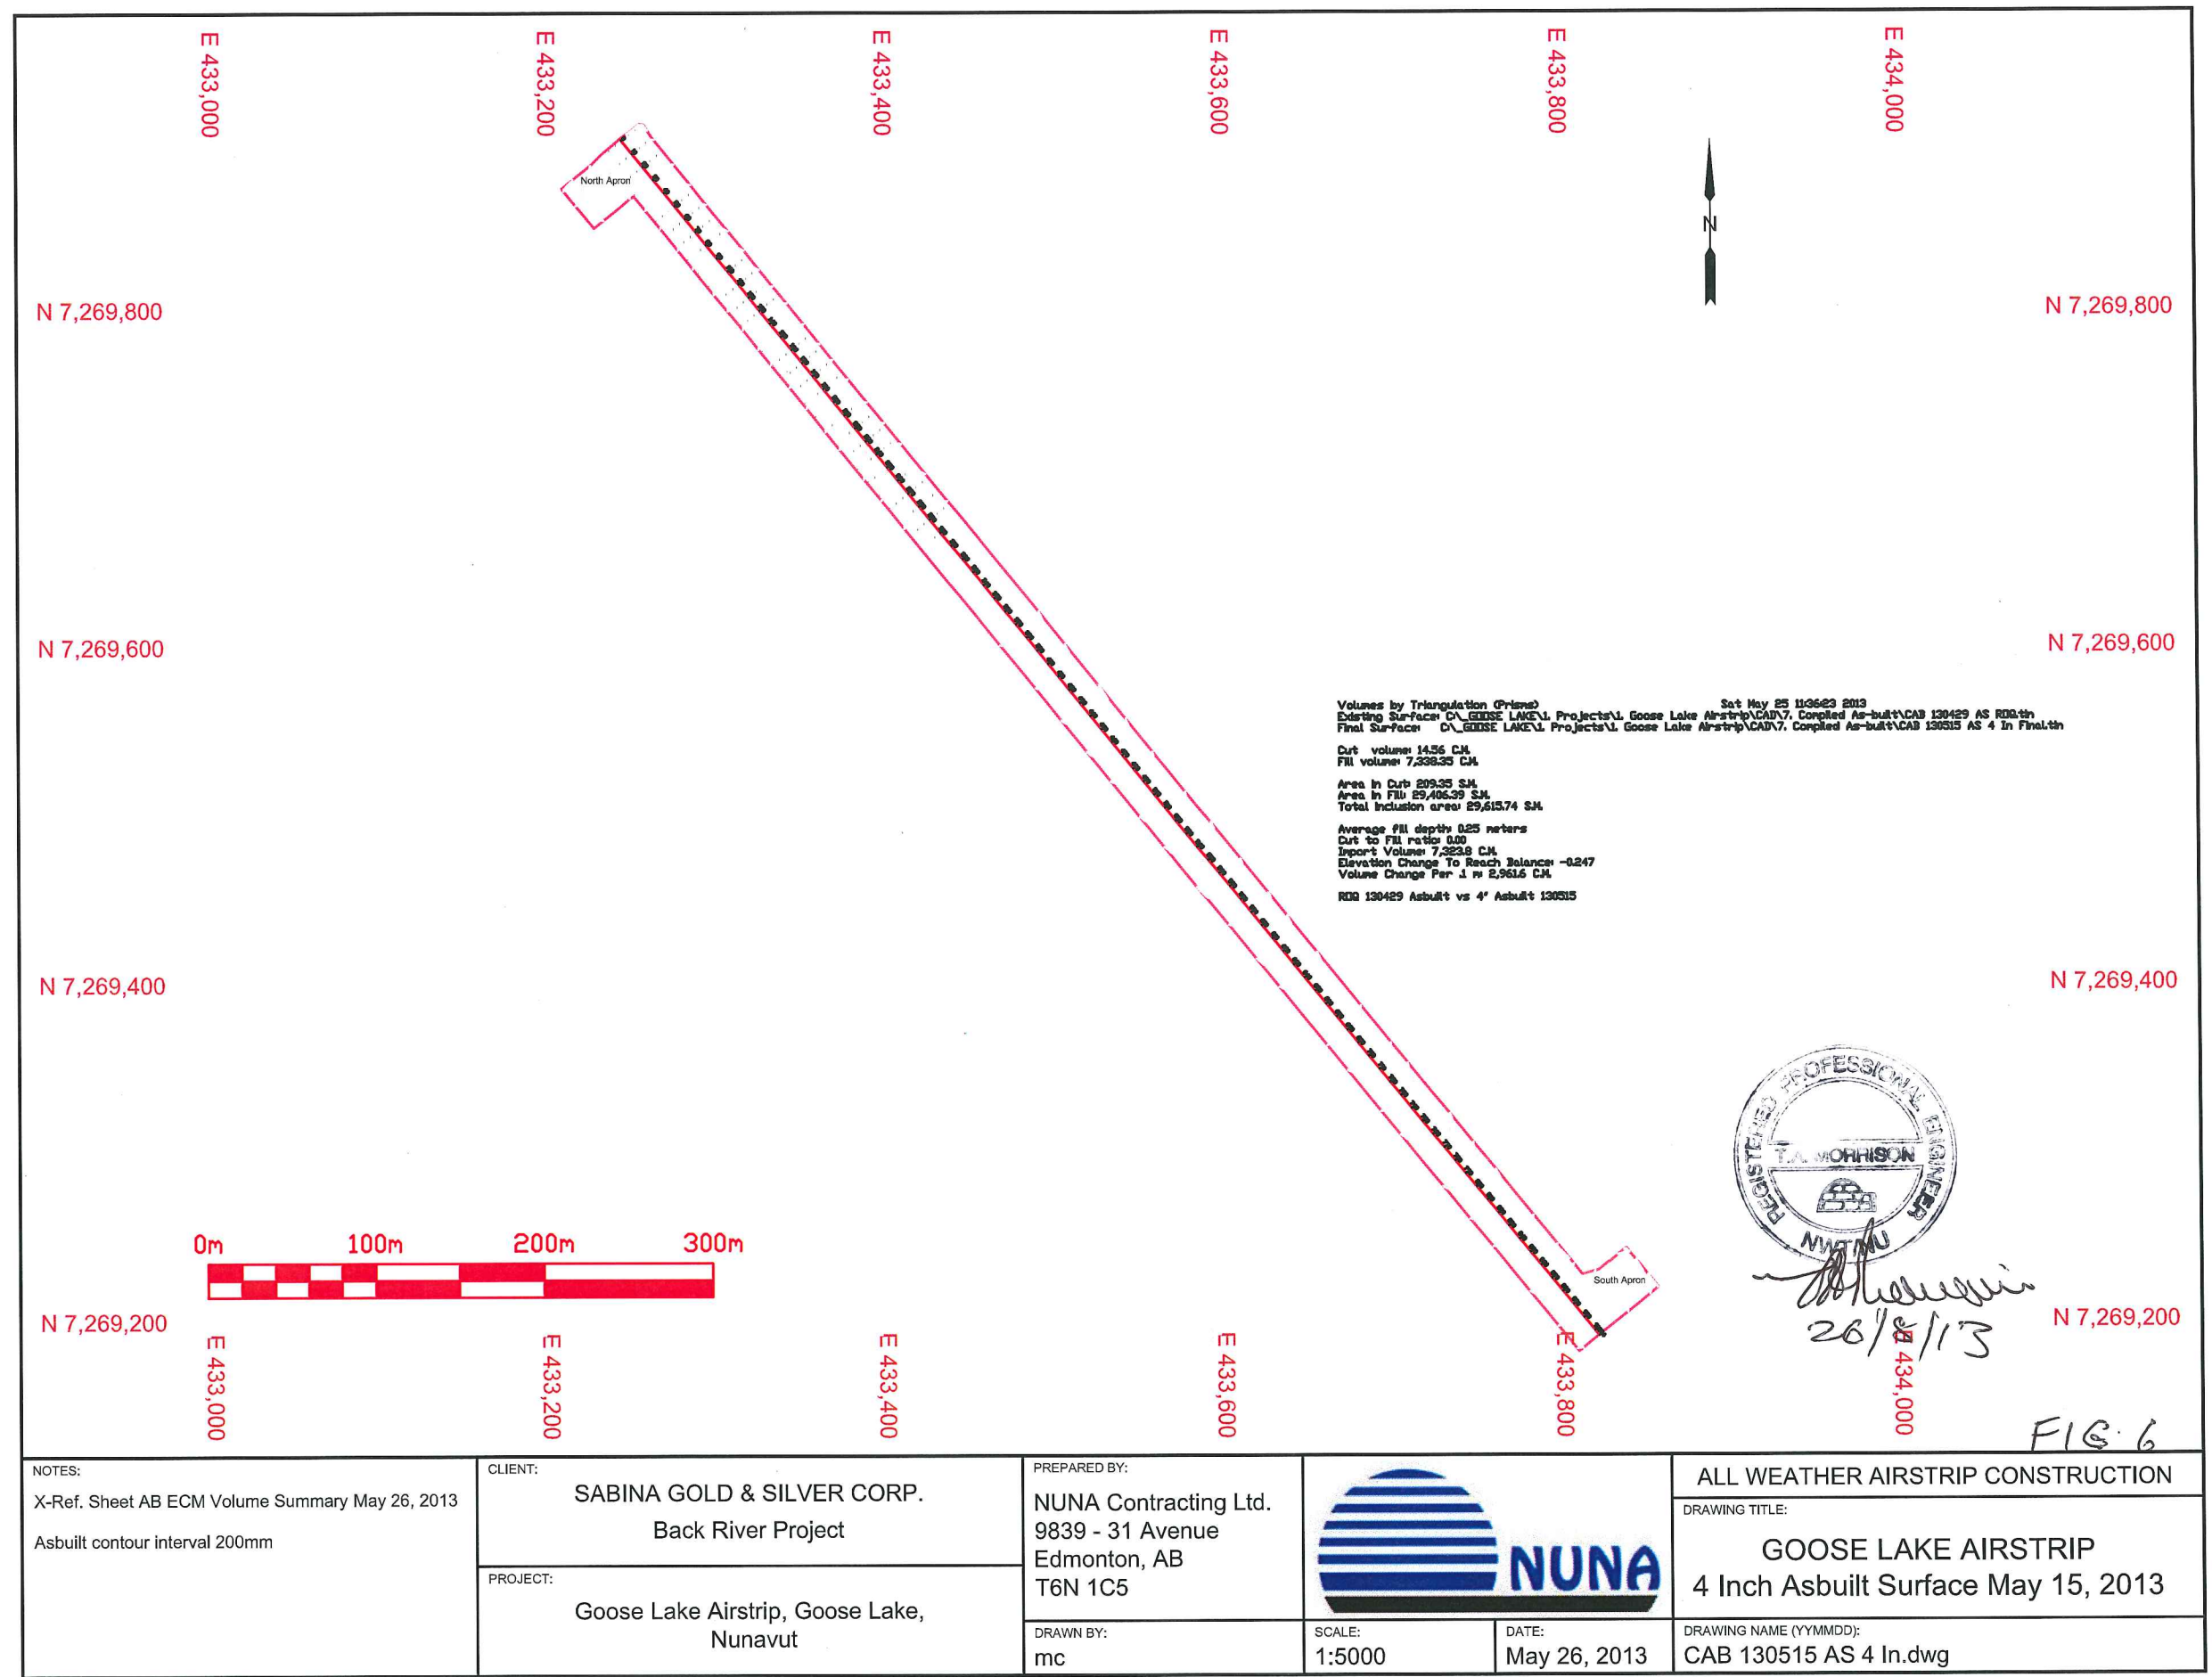

|                                                                                             |                                                             |                                                                                      |                                                                                       |                                                                              |                                                  |
|---------------------------------------------------------------------------------------------|-------------------------------------------------------------|--------------------------------------------------------------------------------------|---------------------------------------------------------------------------------------|------------------------------------------------------------------------------|--------------------------------------------------|
| NOTES:<br>X-Ref. Sheet AB ECM Volume Summary May 26, 2013<br>Asbuilt contour interval 200mm | CLIENT:<br>SABINA GOLD & SILVER CORP.<br>Back River Project | PREPARED BY:<br>NUNA Contracting Ltd.<br>9839 - 31 Avenue<br>Edmonton, AB<br>T6N 1C5 |  | ALL WEATHER AIRSTRIP CONSTRUCTION                                            |                                                  |
|                                                                                             | PROJECT:<br>Goose Lake Airstrip, Goose Lake,<br>Nunavut     |                                                                                      |                                                                                       | DRAWING TITLE:<br>GOOSE LAKE AIRSTRIP<br>4 Inch Asbuilt Surface May 15, 2013 | DRAWING NAME (YYMMDD):<br>CAB 130515 AS 4 In.dwg |
|                                                                                             |                                                             | DRAWN BY:<br>mc                                                                      | SCALE:<br>1:5000                                                                      | DATE:<br>May 26, 2013                                                        |                                                  |

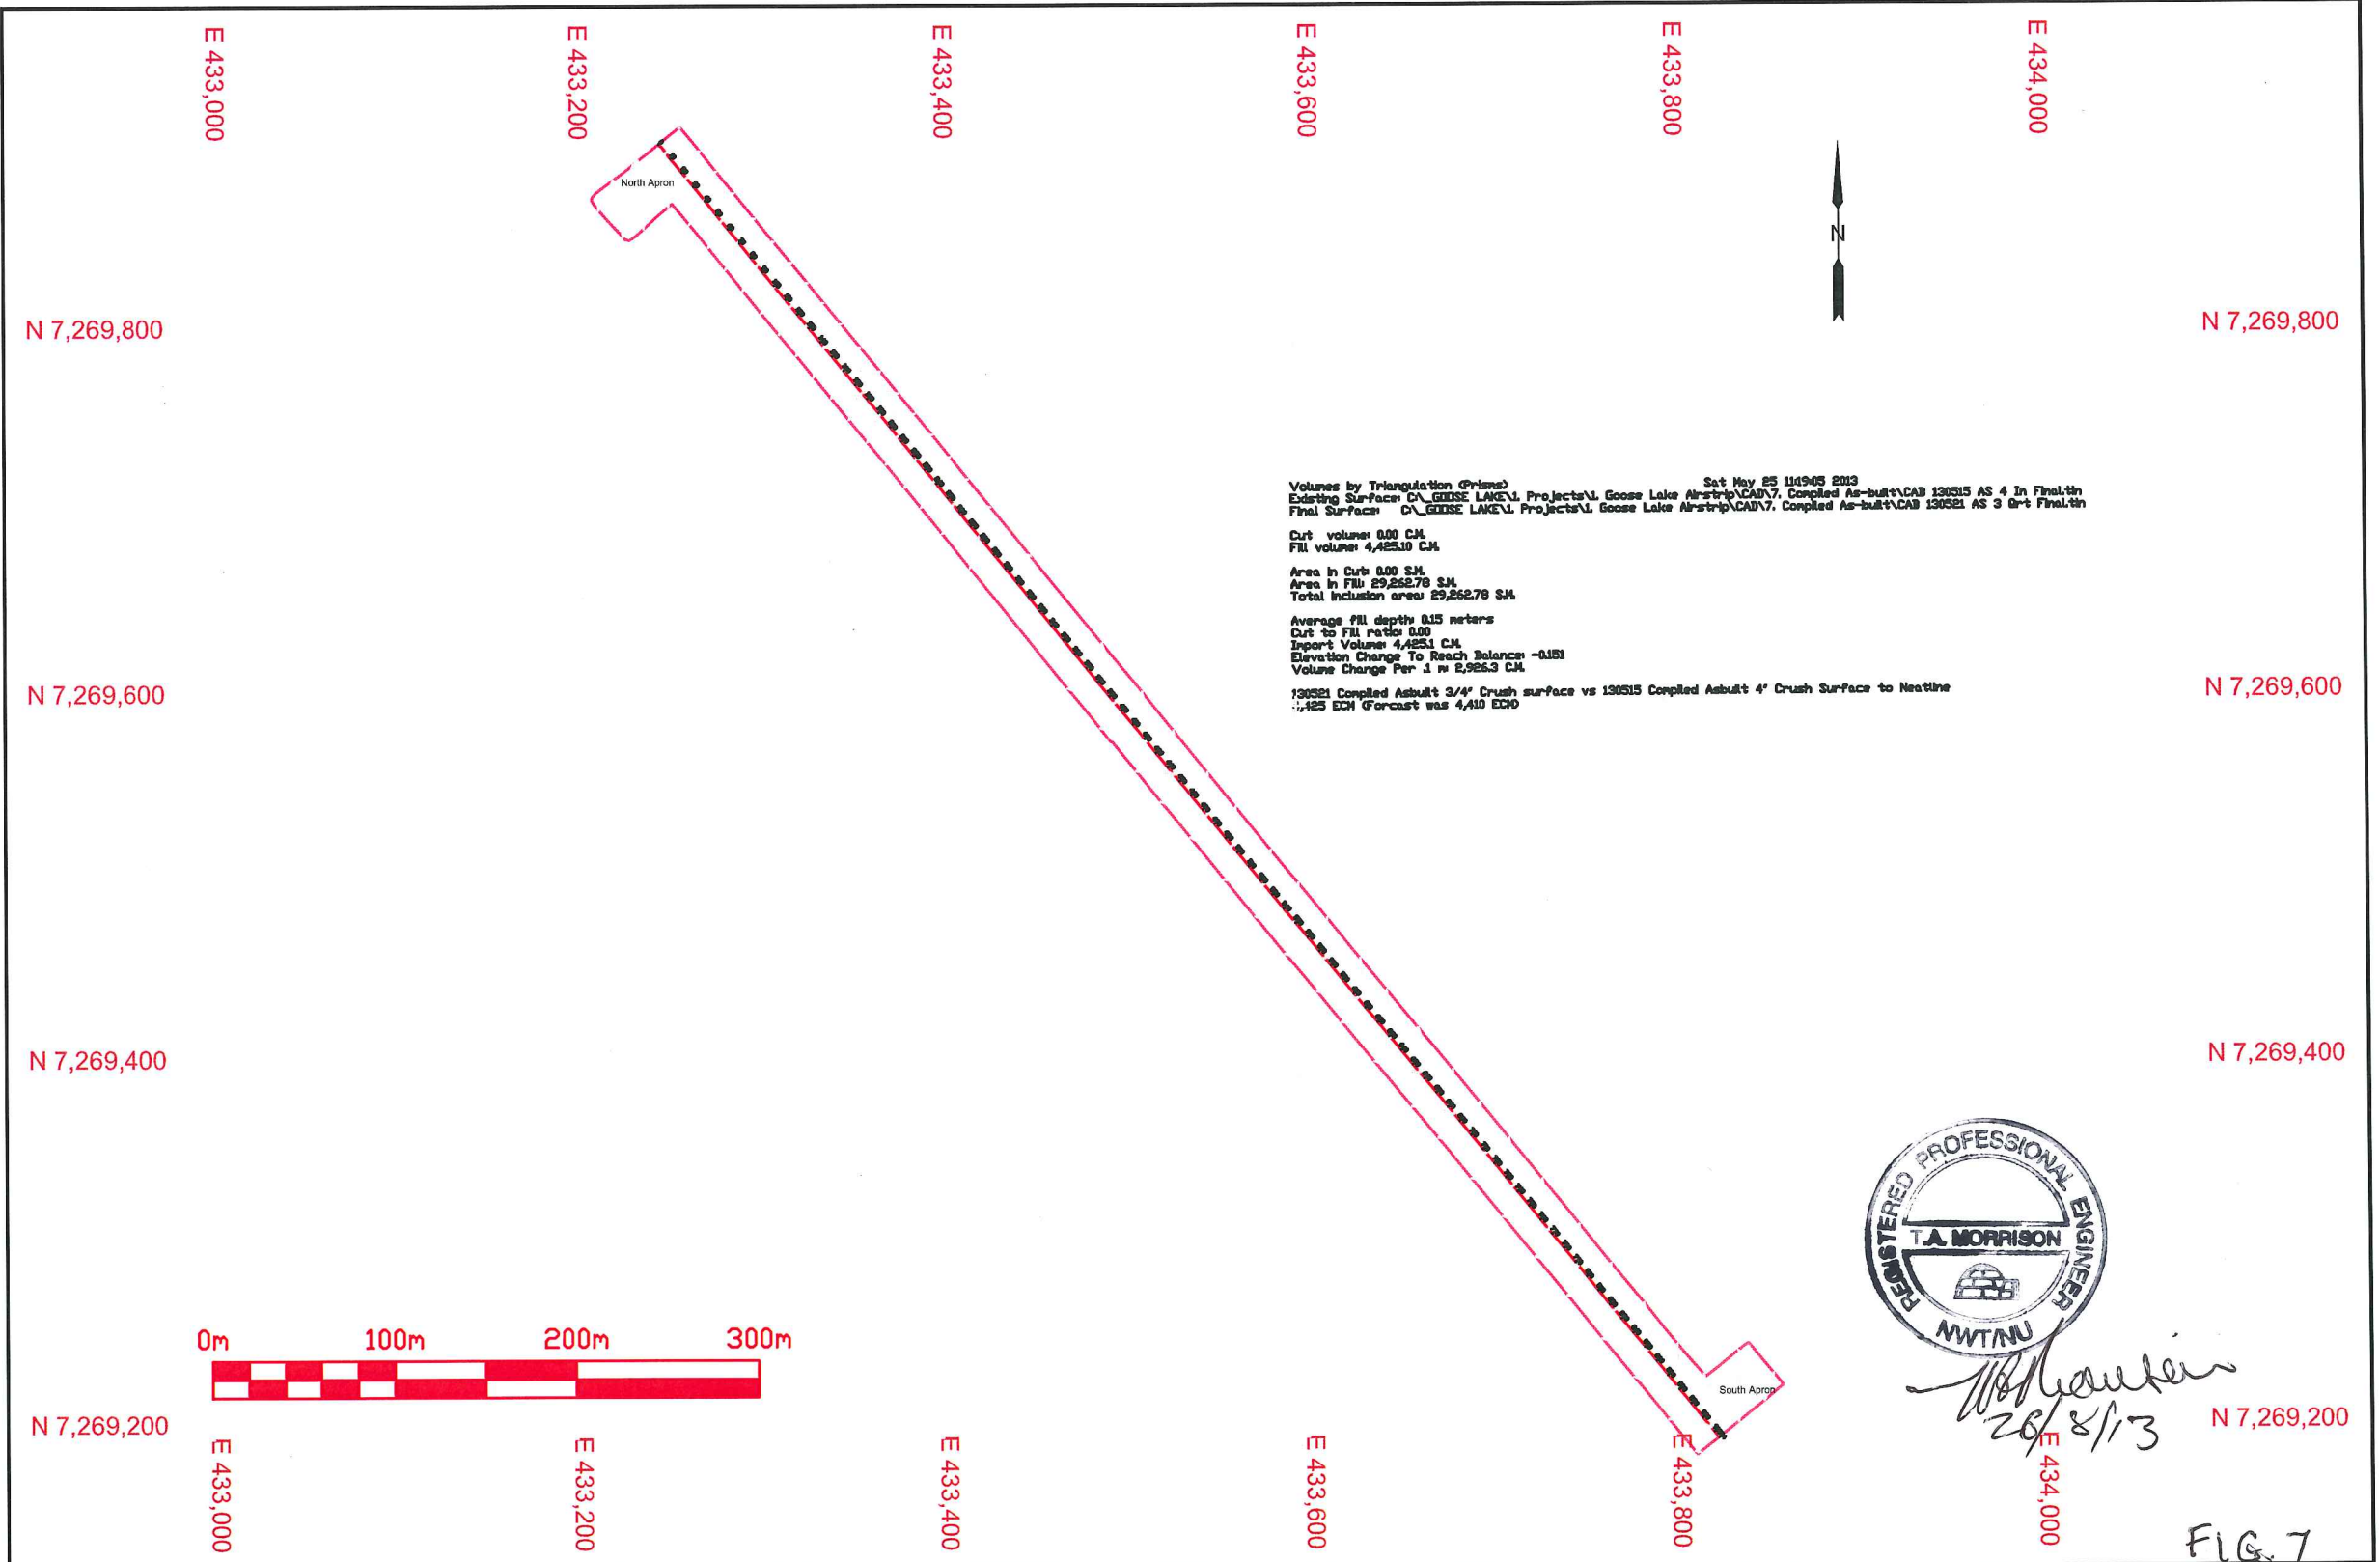

NOTES:

X-Ref. Sheet AB ECM Volume Summary May 26, 2013  
As built contour interval 200mm

CLIENT:

SABINA GOLD & SILVER CORP.  
Back River Project

PROJECT:

Goose Lake Airstrip, Goose Lake,  
Nunavut

PREPARED BY:

NUNA Contracting Ltd.  
9839 - 31 Avenue  
Edmonton, AB  
T6N 1C5

DRAWN BY:  
mc



SCALE:  
1:5000

DATE:  
May 26, 2013

All Weather Airstrip Construction


DRAWING TITLE:

Goose Lake Airstrip  
3/4 Quarter Inch Crush Surface

DRAWING NAME (YYMMDD):

CAB 130521 AS 3 Qrt Final.dwg



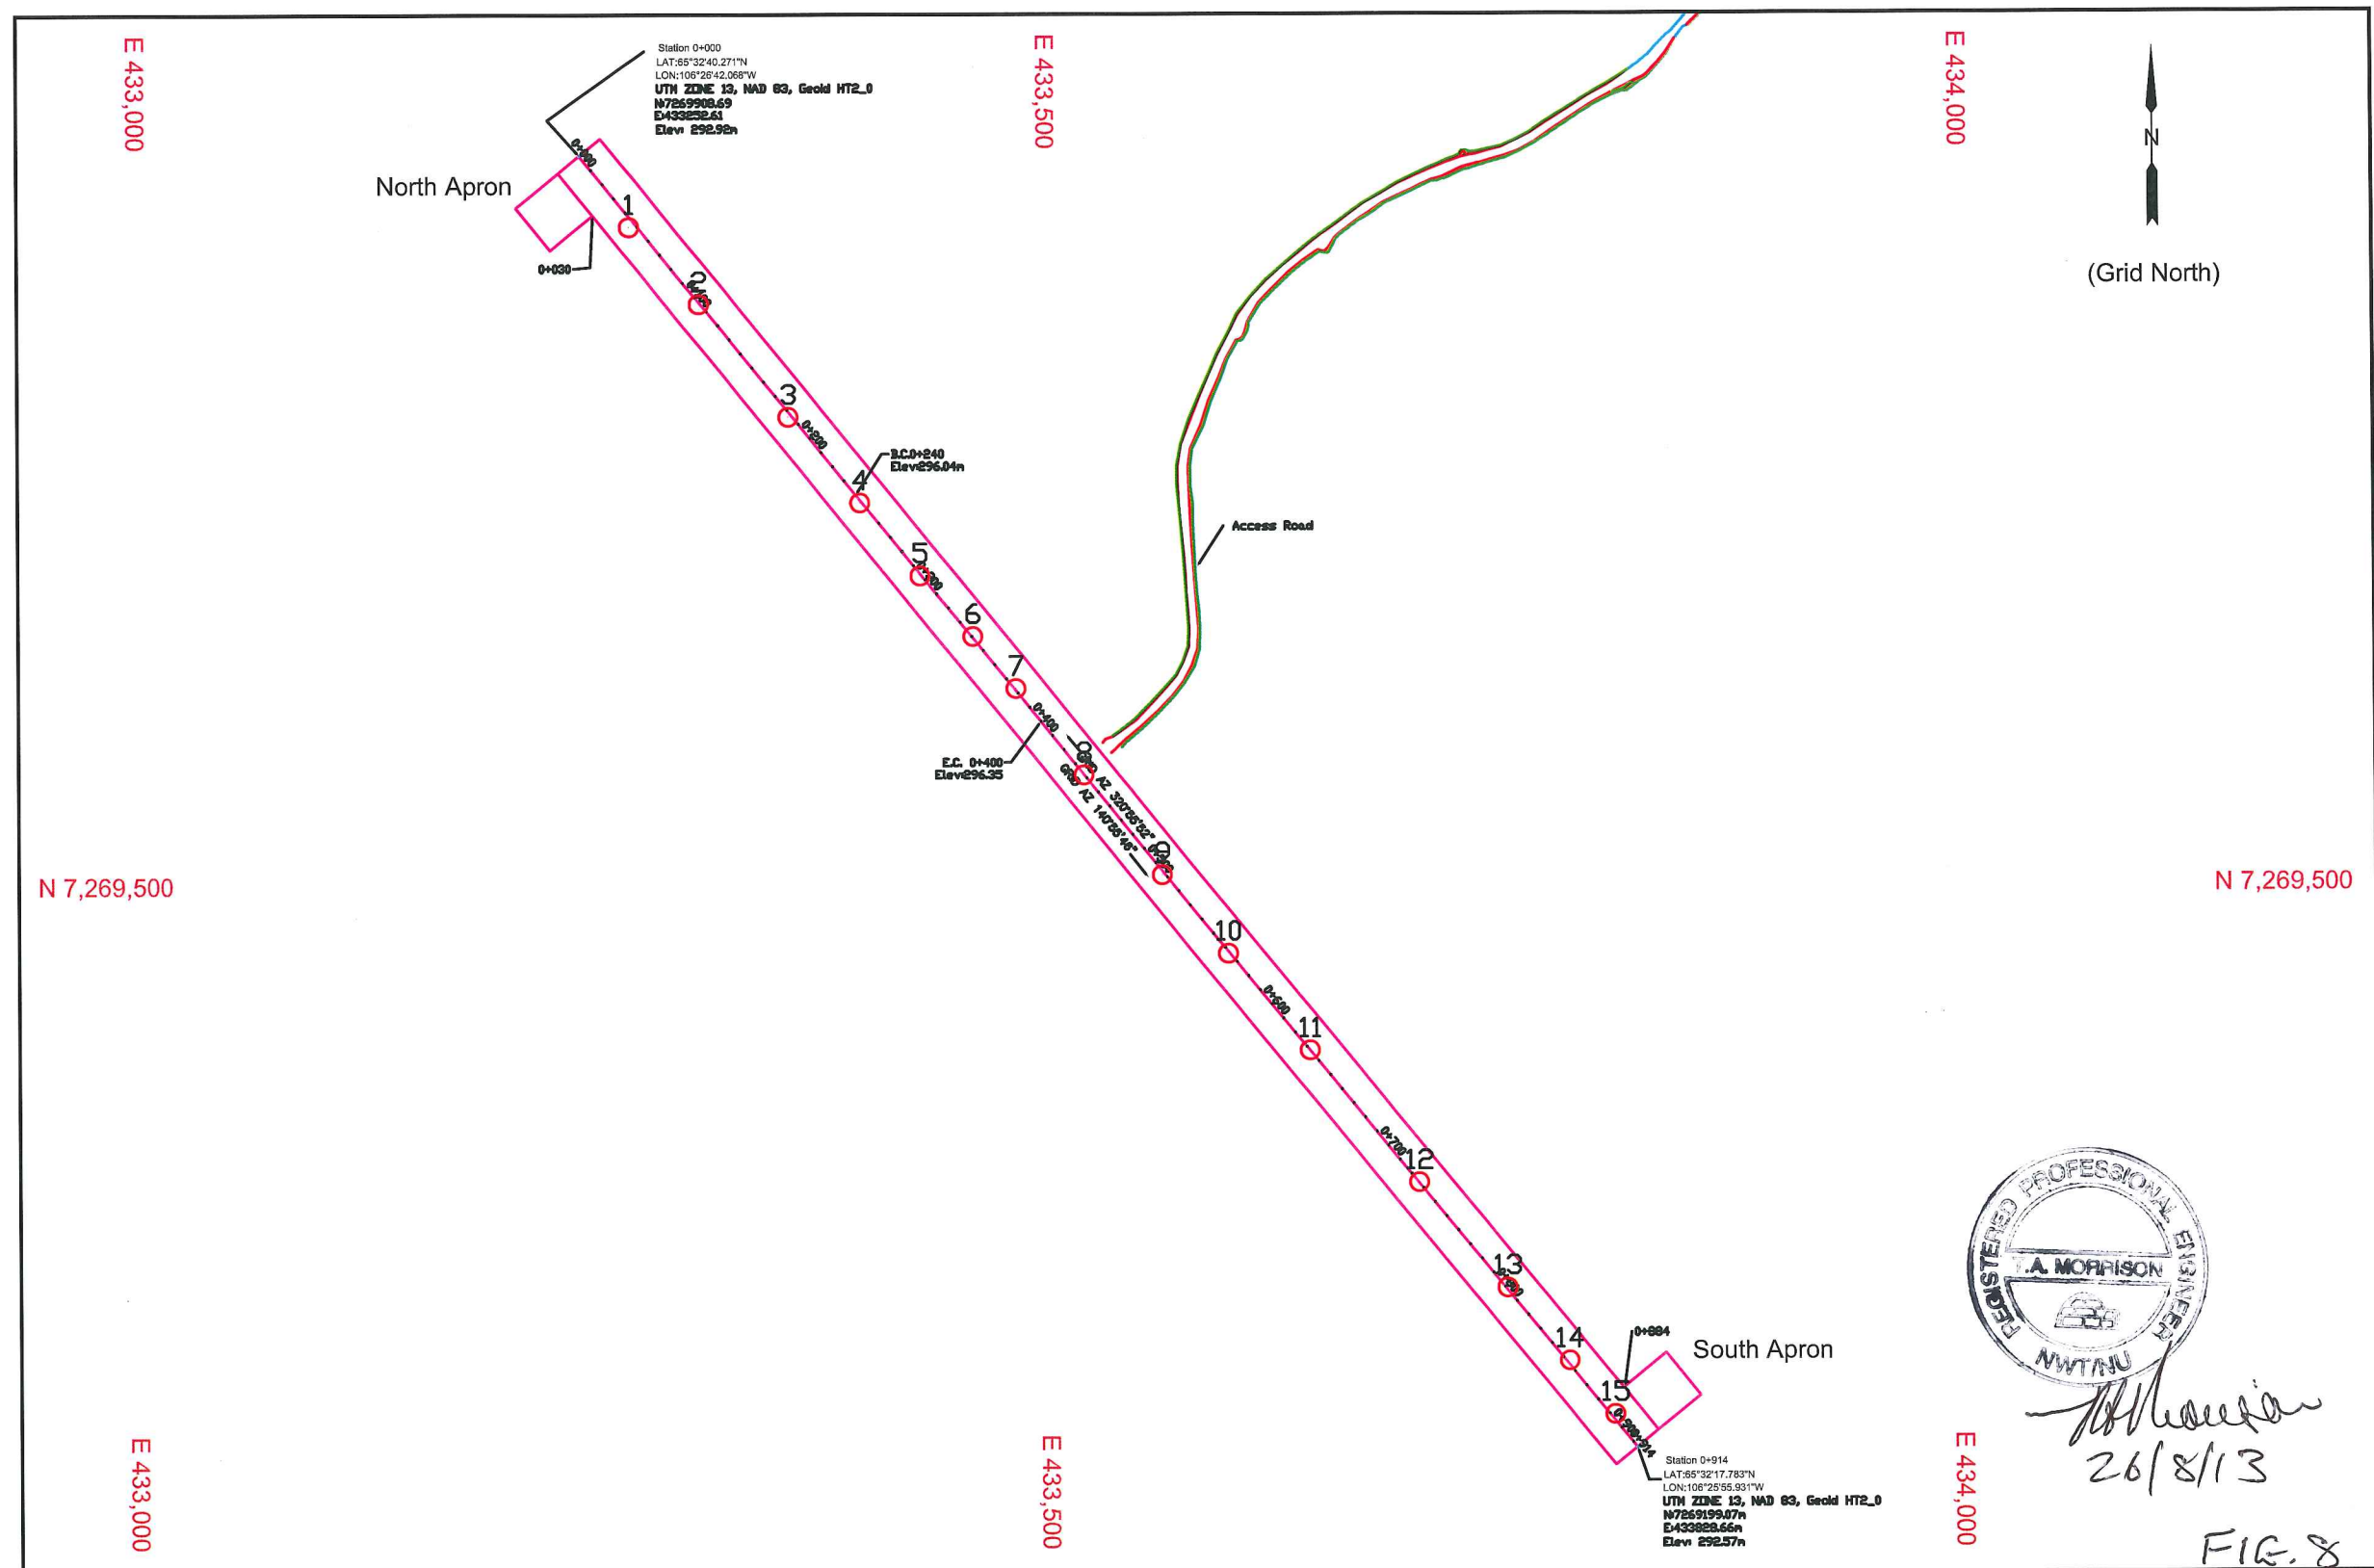

*A. Morrison*  
26/8/13

FIG. 8

|                                                                                                                                                                                                                    |                                                             |                                                                                      |                                                                                       |                                   |                                                                                                  |
|--------------------------------------------------------------------------------------------------------------------------------------------------------------------------------------------------------------------|-------------------------------------------------------------|--------------------------------------------------------------------------------------|---------------------------------------------------------------------------------------|-----------------------------------|--------------------------------------------------------------------------------------------------|
| NOTES:<br>Airstrip dimensions: 30m x 914m<br>Apron dimensions: 30m x 30m<br>UTM Grid Coordinates Zone 13<br>Nad 83<br>Geoid HT2_0 Elevations<br>Layout from Sabina Design<br>Updated Airstrip design 2013 March 28 | CLIENT:<br>SABINA GOLD & SILVER CORP.<br>Back River Project | PREPARED BY:<br>NUNA Contracting Ltd.<br>9839 - 31 Avenue<br>Edmonton, AB<br>T6N 1C5 |  | All Weather Airstrip Construction |                                                                                                  |
|                                                                                                                                                                                                                    | PROJECT:<br>Goose Lake Airstrip, Goose Lake,<br>Nunavut     | DRAWN BY:<br>mc                                                                      | SCALE:<br>1:5000                                                                      | DATE:<br>May 20, 2013             | DRAWING TITLE:<br>Goose Lake Airstrip<br>GL Airstrip Compaction Test<br>Coordinates May 20, 2013 |
|                                                                                                                                                                                                                    |                                                             |                                                                                      | DRAWING NAME (YYMMDD):<br>AB 130520 AS Compaction Testing.dwg                         |                                   |                                                                                                  |





