



Appendix A: 2016 Work Plan Site Layouts

H349000-2000-00-015-0021	Milne Port – Infrastructure Footprint – Work Plan 2016
H349000-4000-00-015-0021	Mine Site – Infrastructure Footprint – Work Plan 2016

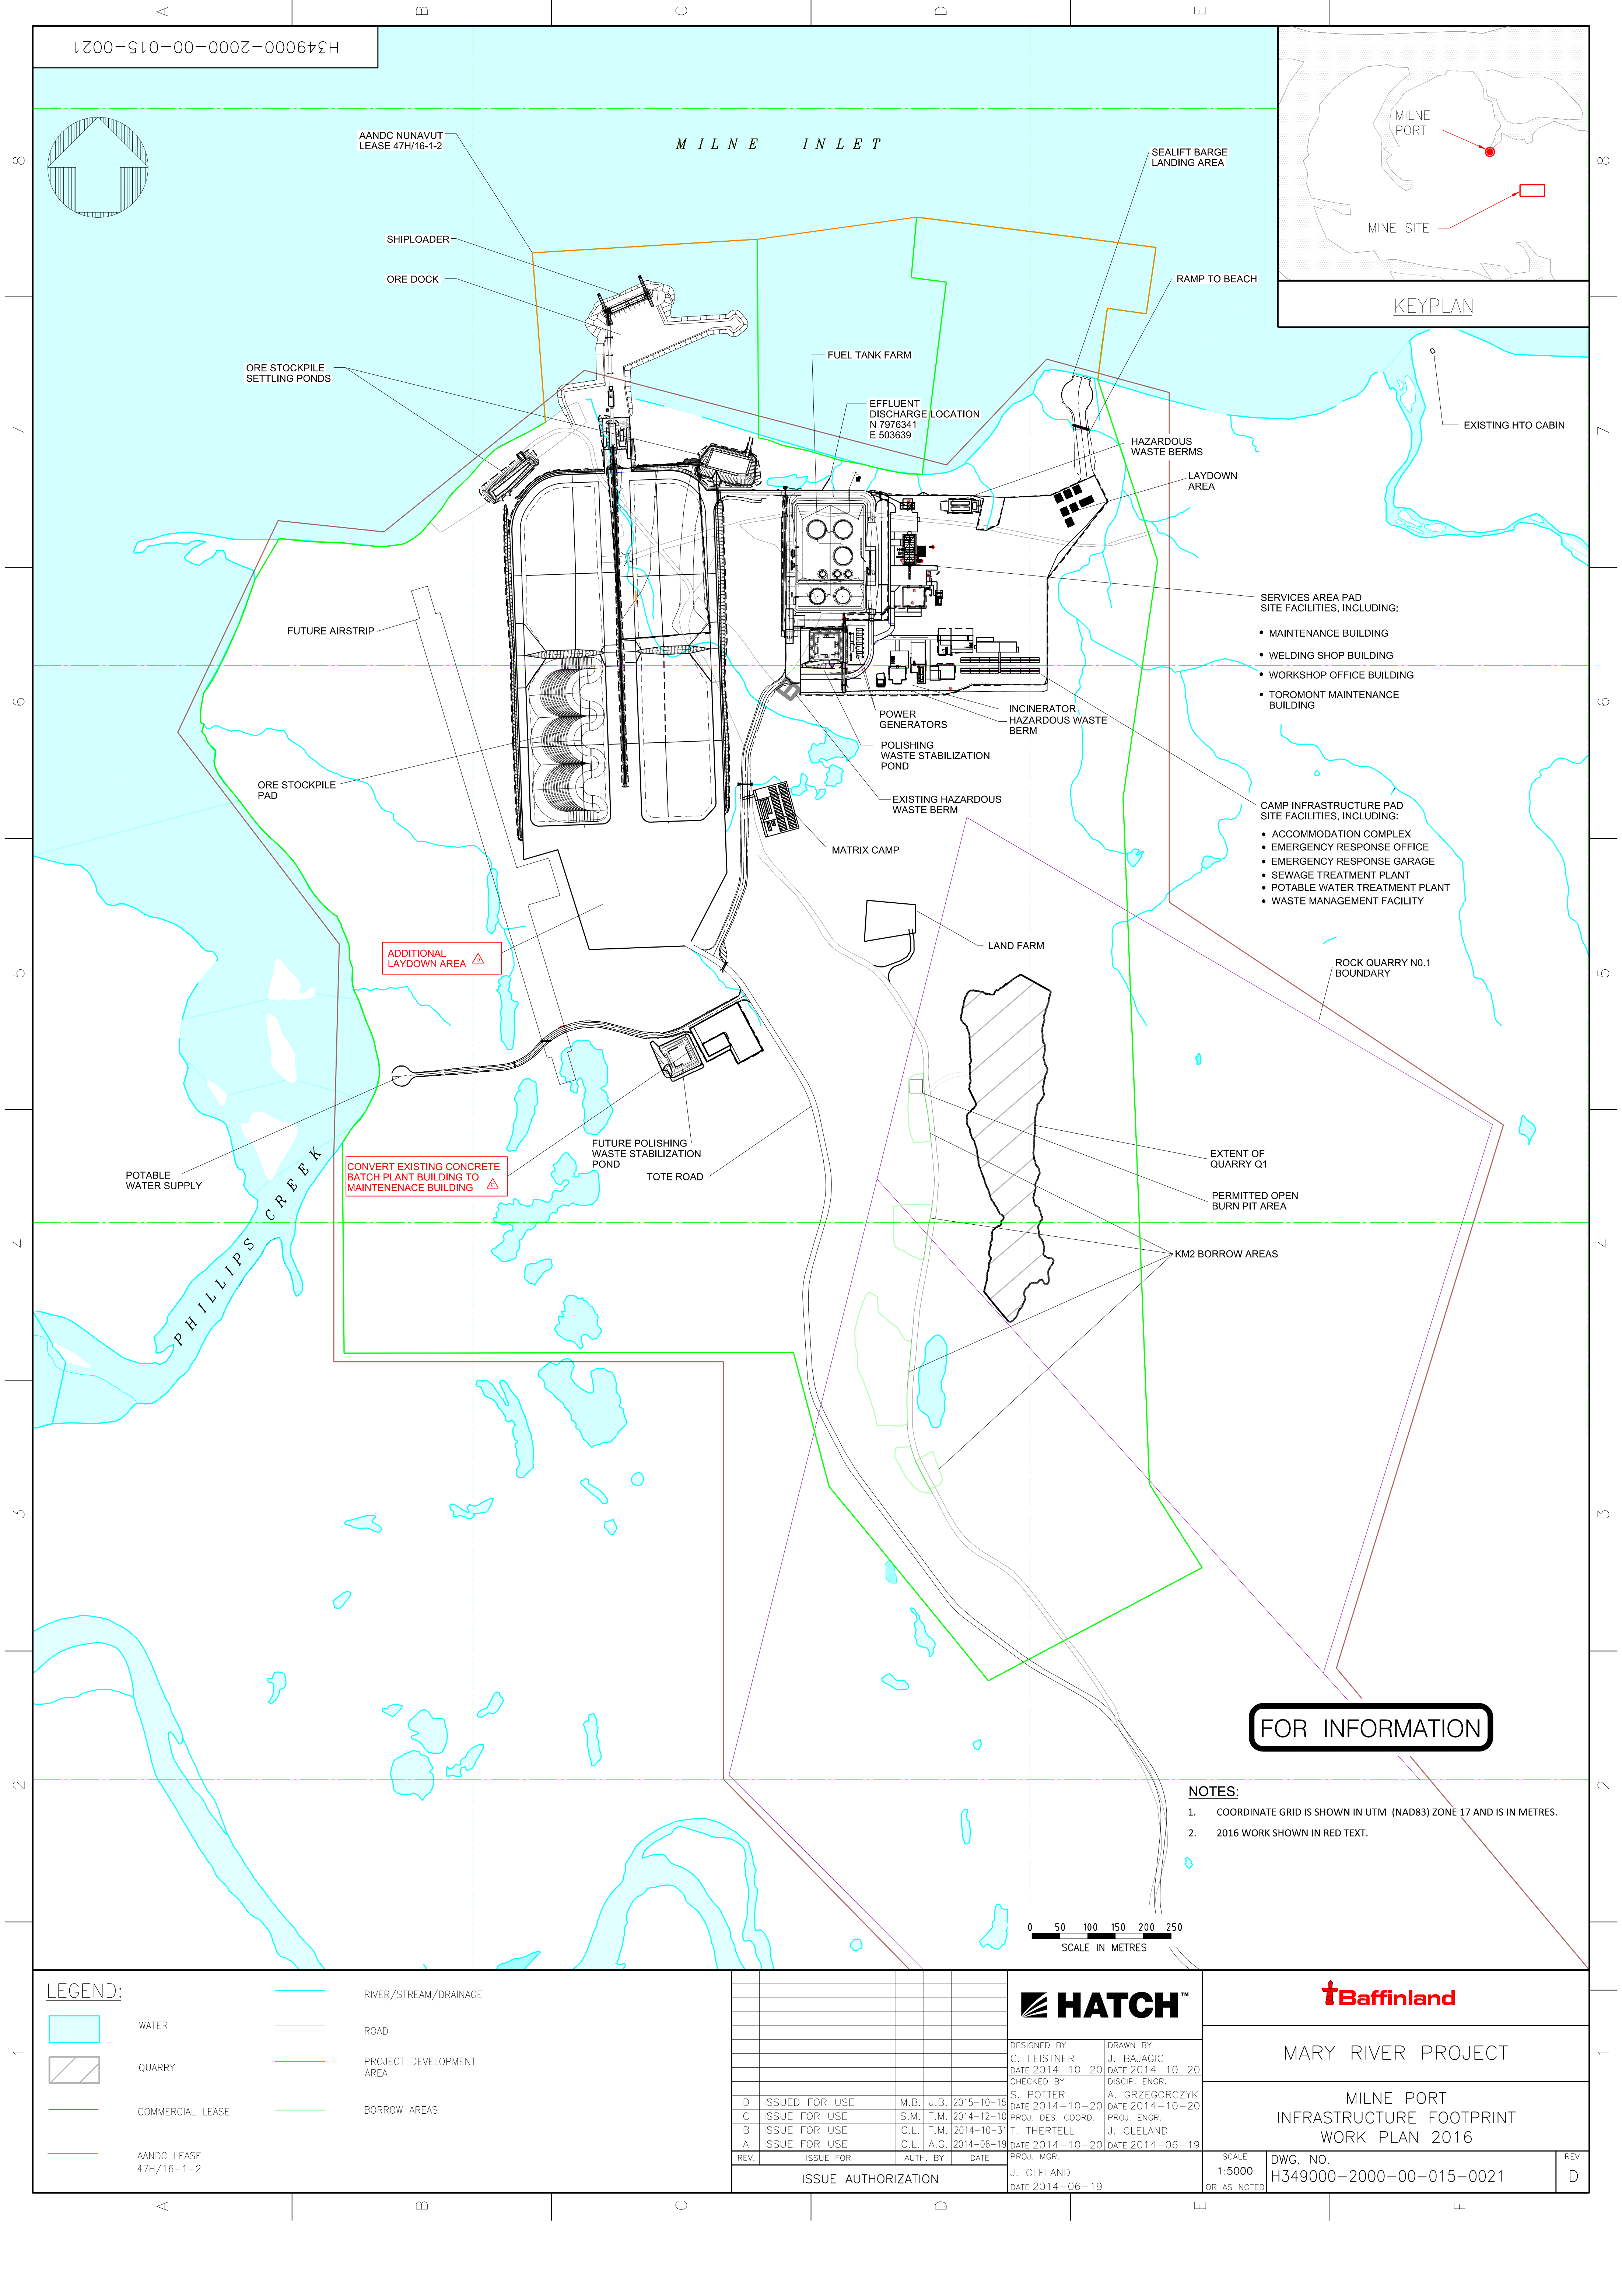

FOR INFORMATION

- NOTES:
- 1. COORDINATE GRID IS SHOWN IN UTM (NAD83) ZONE 17 AND IS IN METRES.
 - 2. 2016 WORK SHOWN IN RED TEXT.

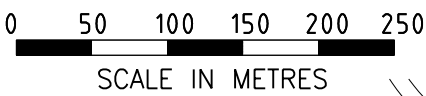

LEGEND:

	RIVER/STREAM/DRAINAGE
	ROAD
	PROJECT DEVELOPMENT AREA
	BORROW AREAS
	QUARRY
	COMMERCIAL LEASE
	AANDC LEASE 47H/16-1-2
	WATER



DESIGNED BY C. LEISTNER DATE 2014-10-20		DRAWN BY J. BAJAGIC DATE 2014-10-20	
CHECKED BY S. POTTER DATE 2014-10-20		DISCIP. ENGR. A. GRZEGORCZYK DATE 2014-10-20	
PROJ. DES. COORD. T. THERTELL DATE 2014-10-20		PROJ. ENGR. J. CLELAND DATE 2014-06-19	
PROJ. MGR. J. CLELAND DATE 2014-06-19			
REV.	ISSUE FOR	AUTH. BY	DATE
D	ISSUED FOR USE	M.B. J.B.	2015-10-15
C	ISSUE FOR USE	S.M. T.M.	2014-12-10
B	ISSUE FOR USE	C.L. T.M.	2014-10-31
A	ISSUE FOR USE	C.L. A.G.	2014-06-19
ISSUE AUTHORIZATION			



MARY RIVER PROJECT

MILNE PORT
INFRASTRUCTURE FOOTPRINT
WORK PLAN 2016

SCALE 1:5000 OR AS NOTED	DWG. NO. H349000-2000-00-015-0021	REV. D
--------------------------------	--------------------------------------	-----------

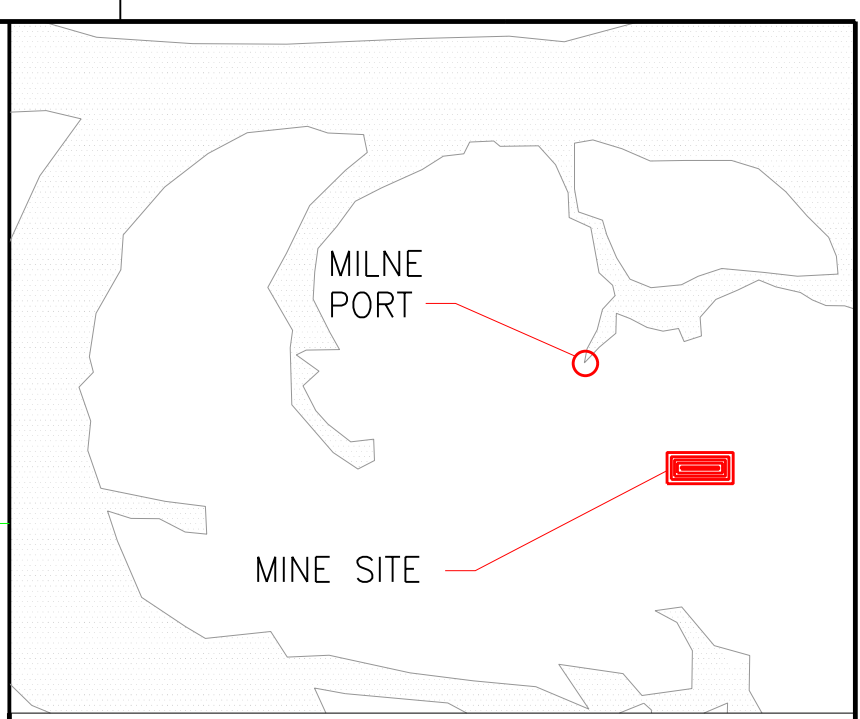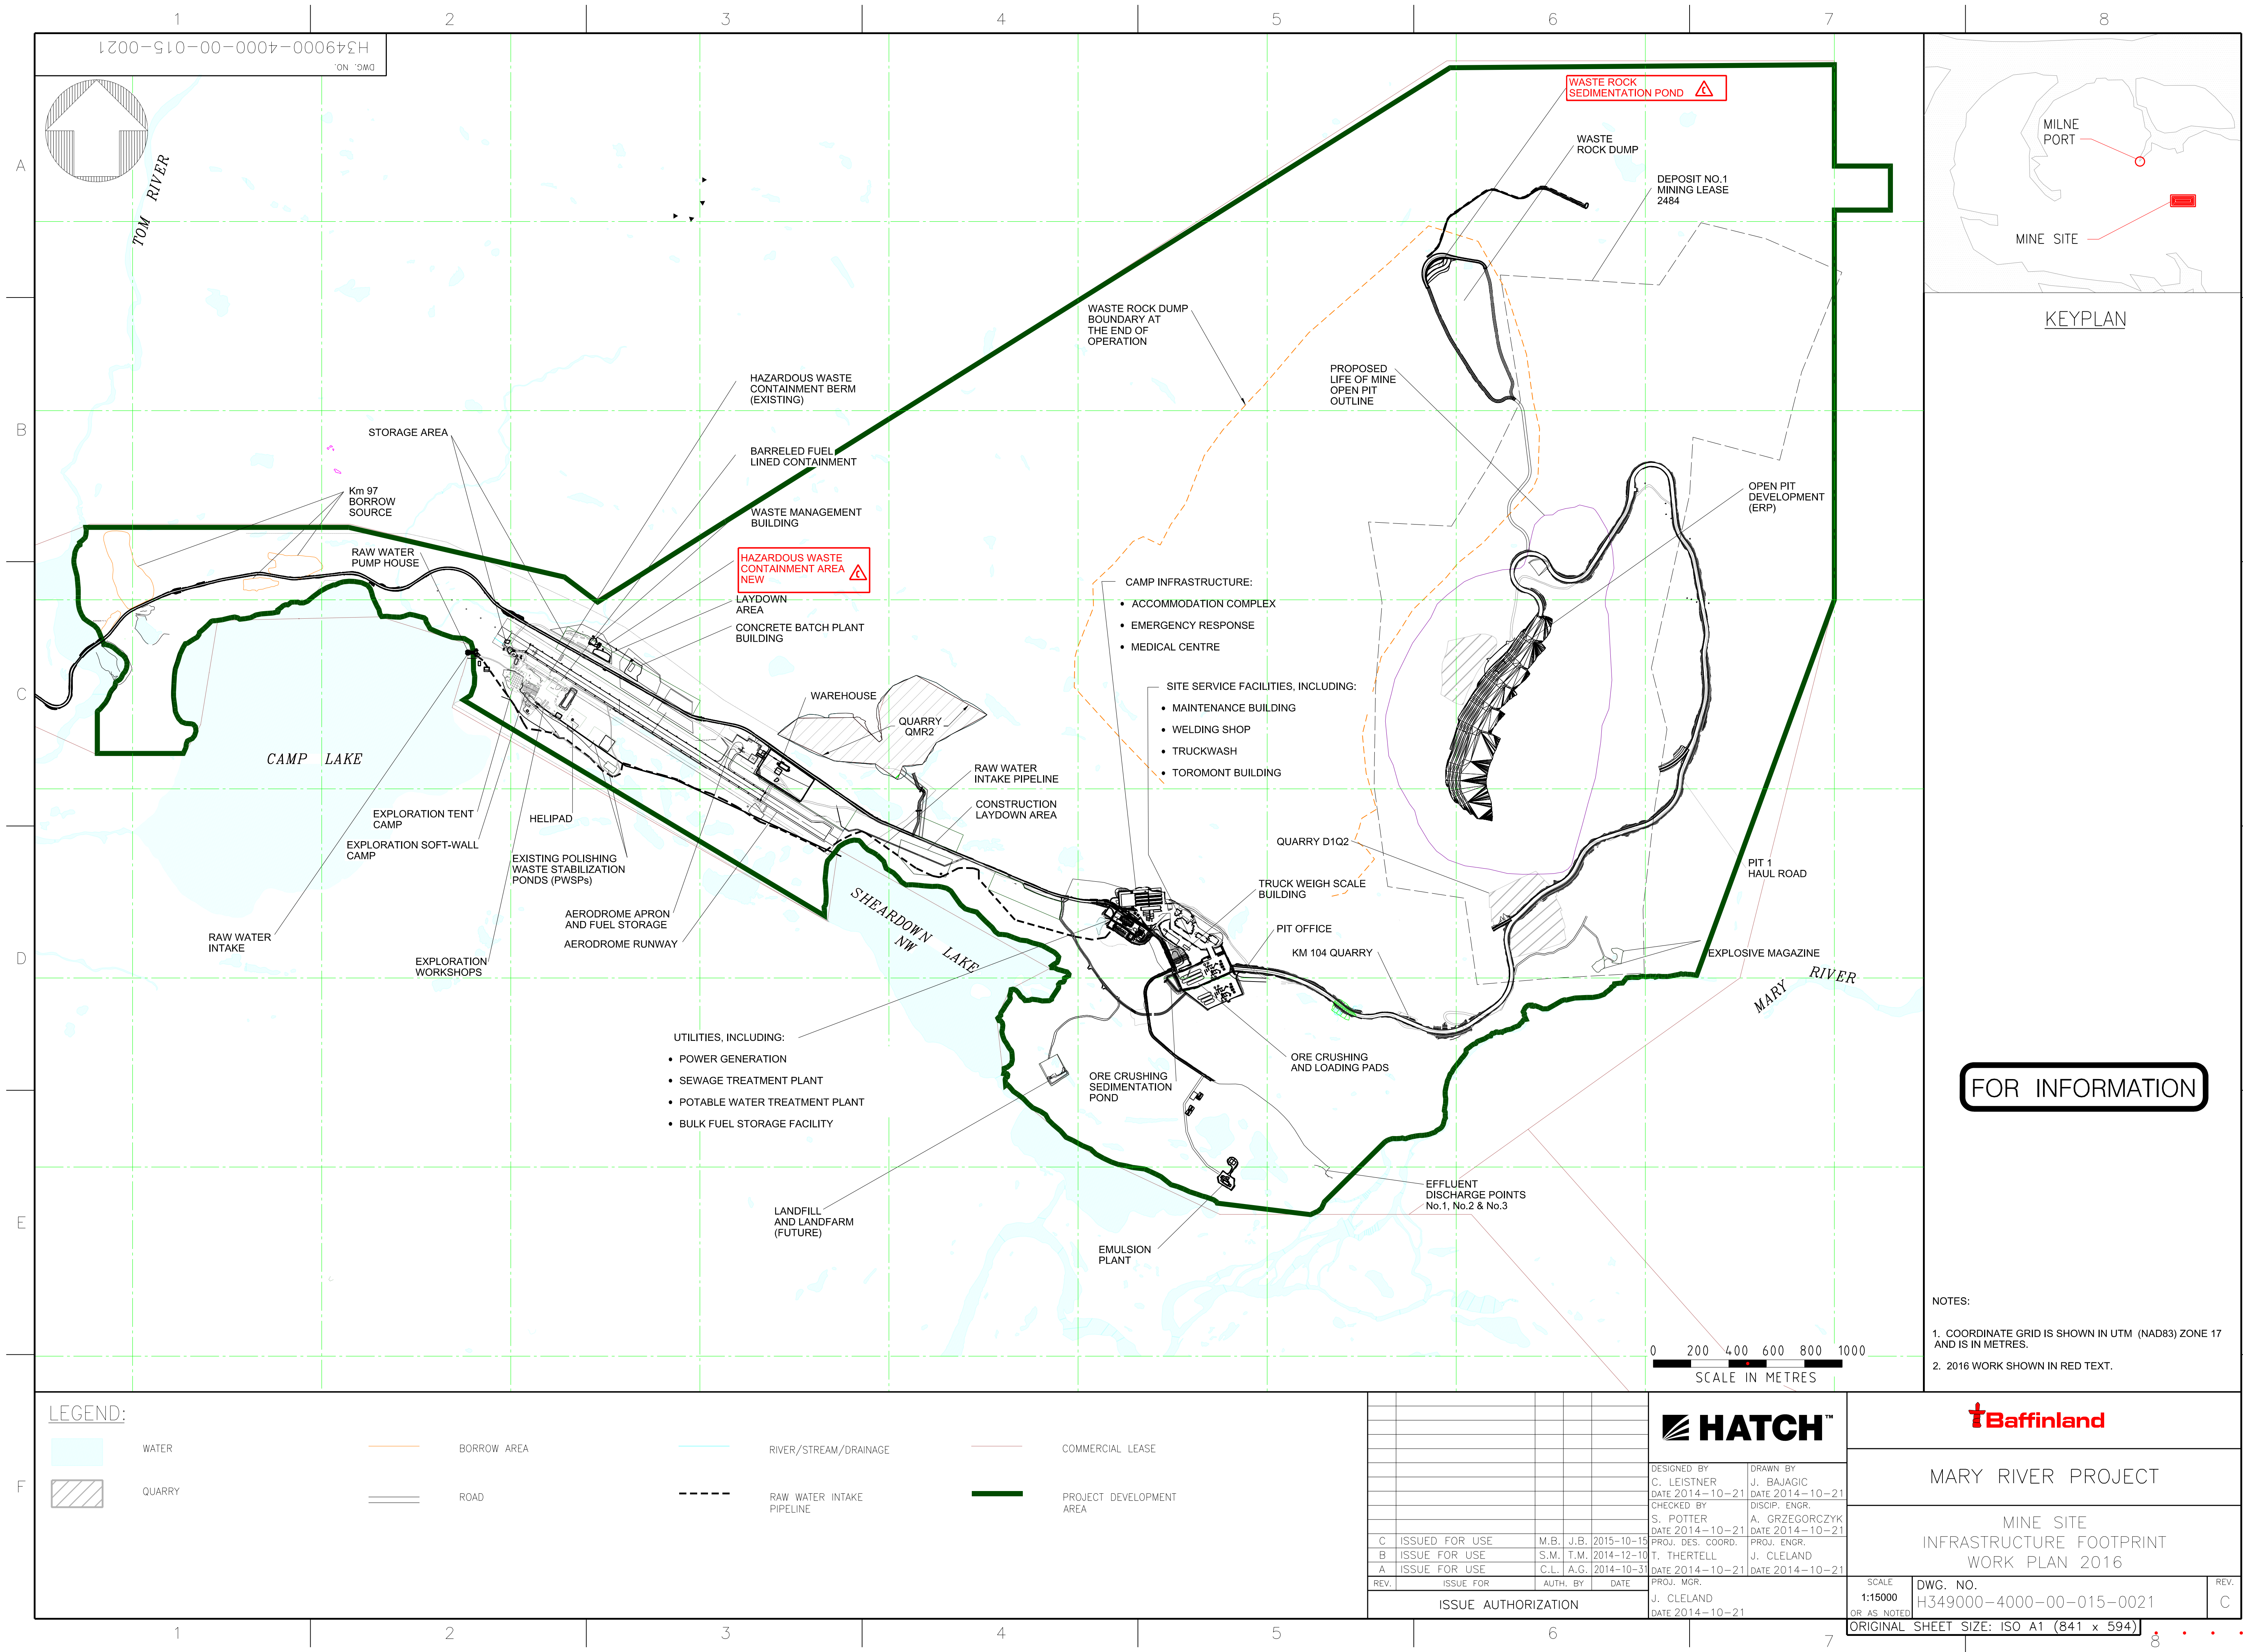

FOR INFORMATION

NOTES:
1. COORDINATE GRID IS SHOWN IN UTM (NAD83) ZONE 17 AND IS IN METRES.
2. 2016 WORK SHOWN IN RED TEXT.

LEGEND:

- | | | | | | | | |
|--|--------|--|-------------|--|---------------------------|--|--------------------------|
| | WATER | | BORROW AREA | | RIVER/STREAM/DRAINAGE | | COMMERCIAL LEASE |
| | QUARRY | | ROAD | | RAW WATER INTAKE PIPELINE | | PROJECT DEVELOPMENT AREA |



MARY RIVER PROJECT

MINE SITE
INFRASTRUCTURE FOOTPRINT
WORK PLAN 2016

REV.	ISSUE FOR	AUTH.	BY	DATE
C	ISSUED FOR USE	M.B.	J.B.	2015-10-15
B	ISSUE FOR USE	S.M.	T.M.	2014-12-10
A	ISSUE FOR USE	C.L.	A.G.	2014-10-31

DESIGNED BY C. LEISTNER DATE 2014-10-21	DRAWN BY J. BAJAGIC DATE 2014-10-21
CHECKED BY S. POTTER DATE 2014-10-21	DISCIP. ENGR. A. GRZEGORCZYK DATE 2014-10-21
PROJ. DES. COORD. T. THERTELL DATE 2014-10-21	PROJ. ENGR. J. CLELAND DATE 2014-10-21
PROJ. MGR. J. CLELAND DATE 2014-10-21	

SCALE 1:15000 OR AS NOTED	DWG. NO. H349000-4000-00-015-0021	REV. C
---------------------------------	--------------------------------------	-----------

ORIGINAL SHEET SIZE: ISO A1 (841 x 594)