


MECHANICAL PLUMBING — MEZZANINE FLOOR PLAN

1:50

NOTE:
NO PLUMBING MODIFICATIONS
REQUIRED ON SECOND FLOOR LEVEL.

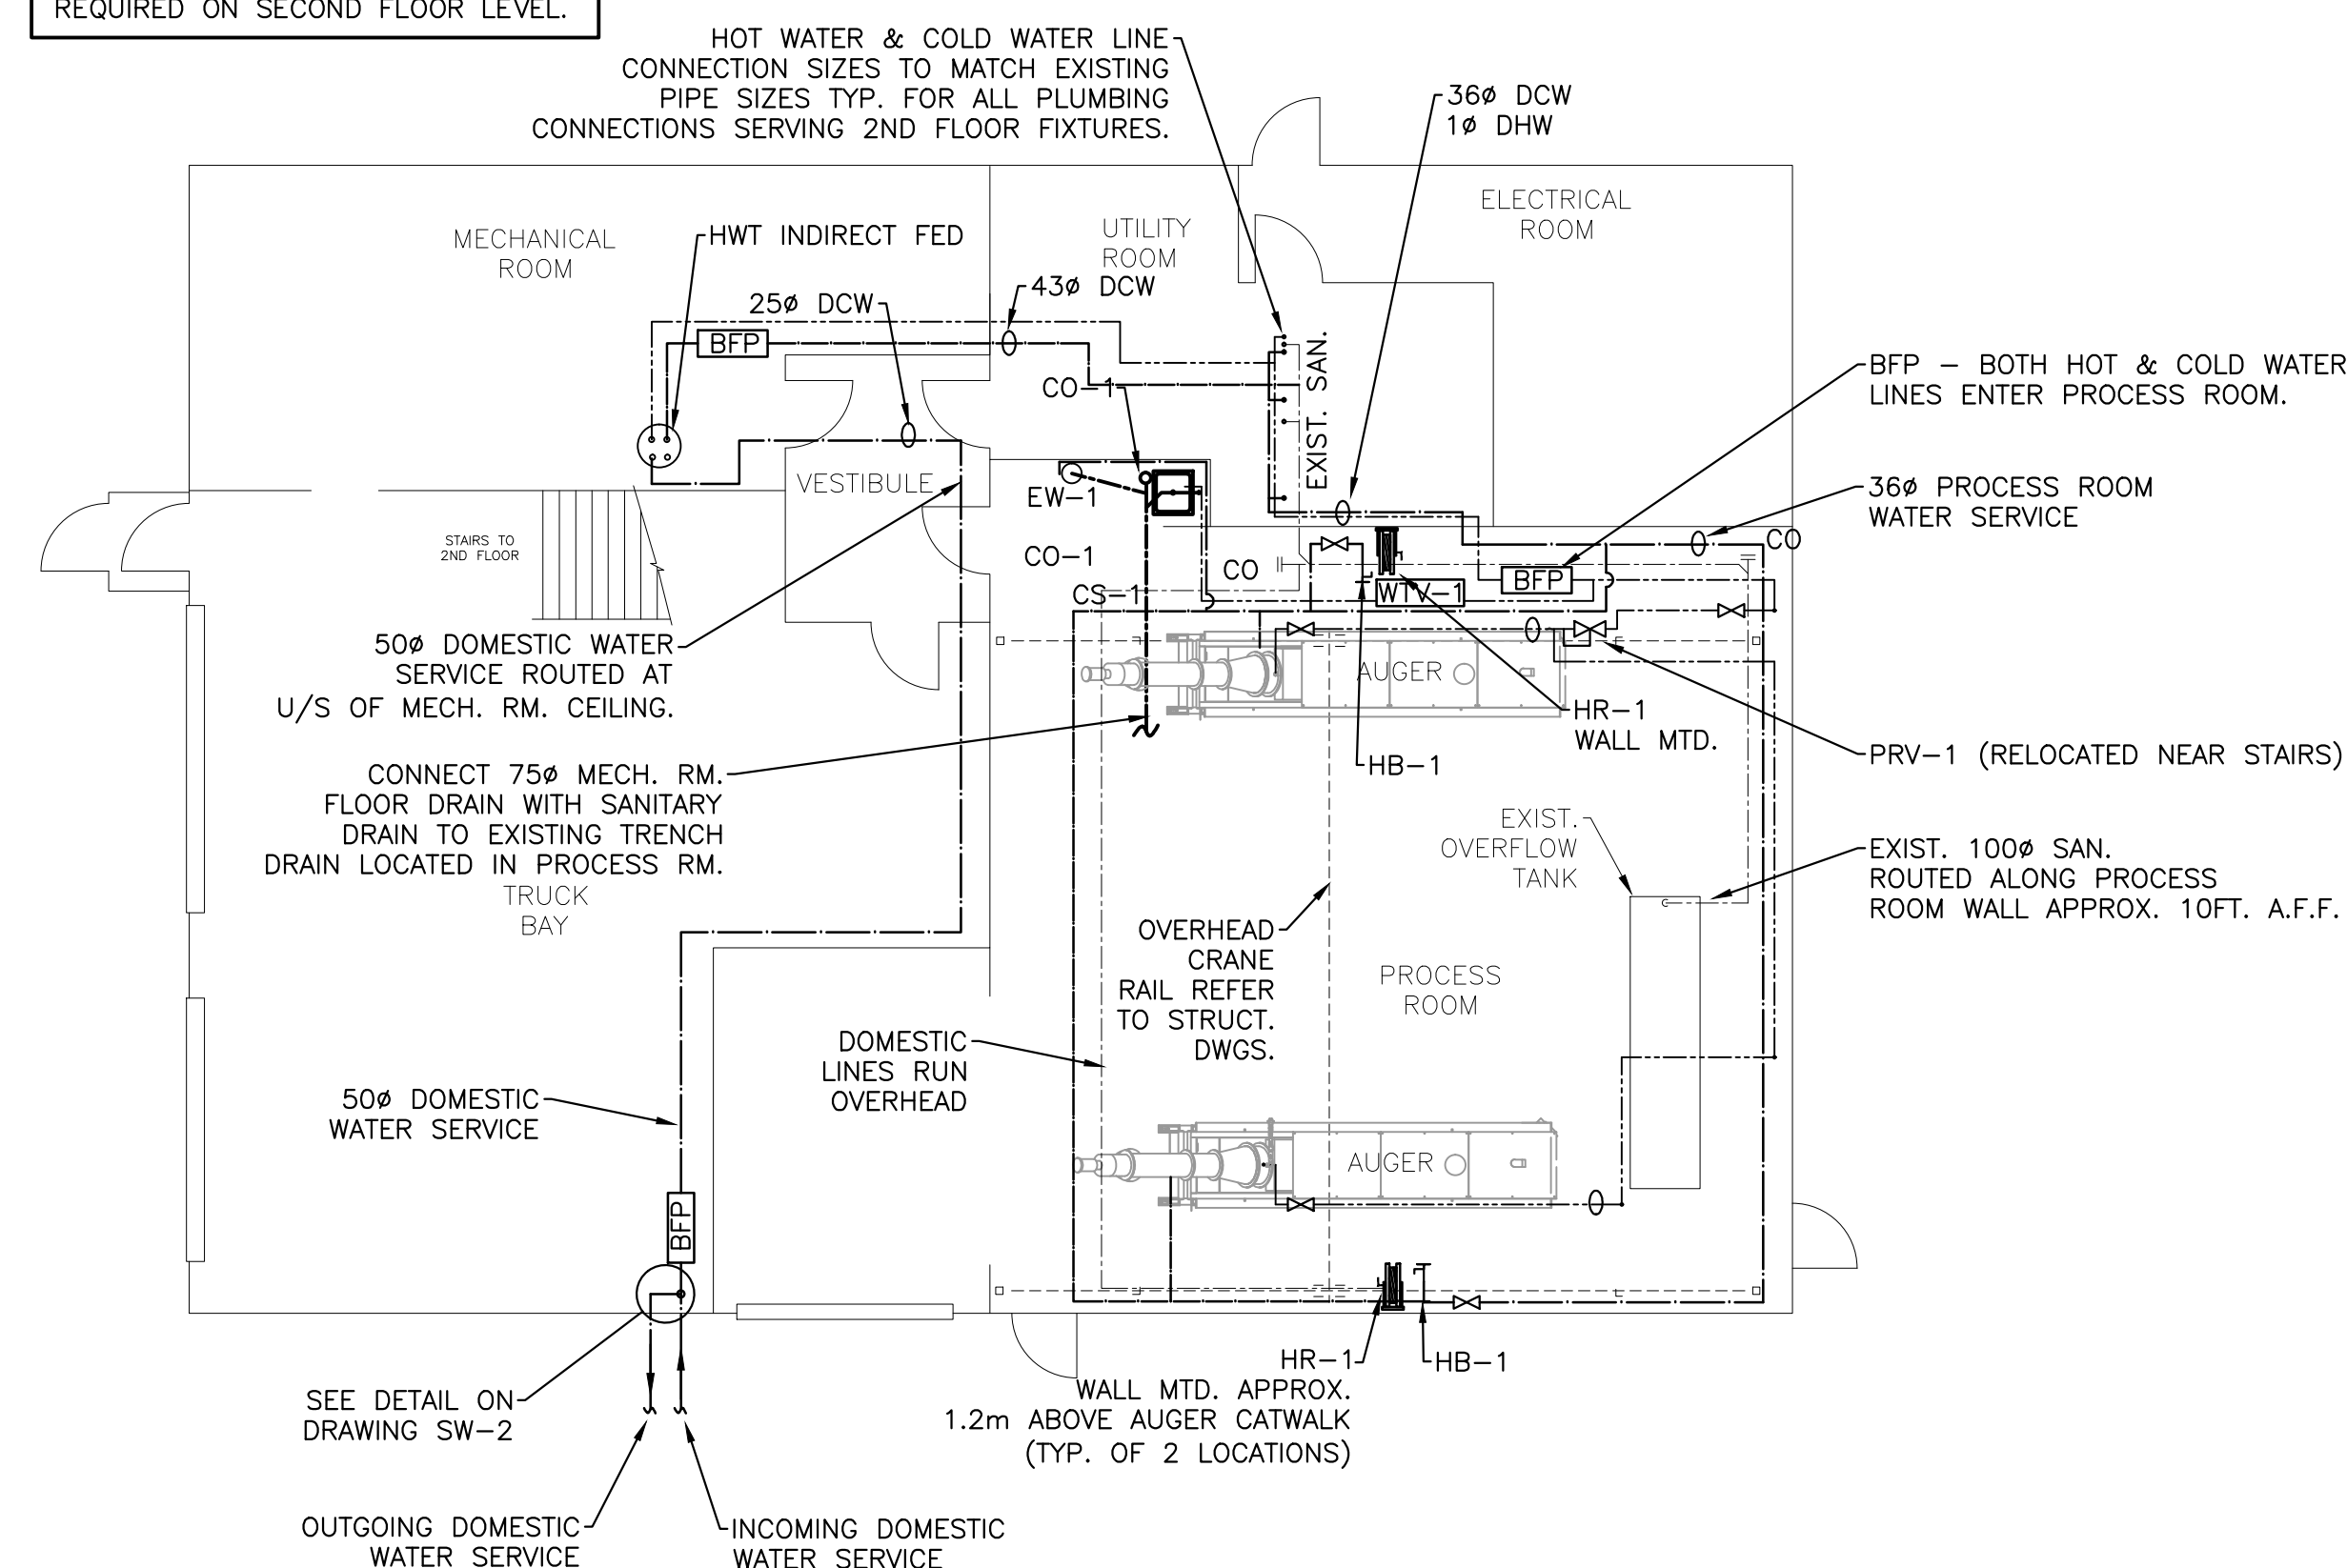

PLUMBING SCHEMATIC

N.T.S.

MECHANICAL PLUMBING SCHEMATIC LEGEND	
	ISOLATION VALVE
	HOSE BIBB
	HOSE REEL
	BACKFLOW PREVENTER
	WATER TEMPERING VALVE
	DOMESTIC COLD WATER
	DOMESTIC HOT WATER
	PRV (SET @ 30PSI)

1. This drawing is the exclusive property of Nuna Burnside and the reproduction of any part without prior written consent of this office is strictly prohibited.

2. The contractor shall verify all dimensions, levels, and datums on site and report any discrepancies or omissions to this office prior to construction.

3. This drawing is to be read and understood in conjunction with all other plans and documents applicable to this project.

4. Do not scale the drawings.

Issue / Revision	Date
1 ISSUED FOR TENDER	FEBRUARY 2013
2 REVISED AS PER ADDENDUM 1 TO 4 AND ISSUED FOR CONSTRUCTION	APRIL 2013
3 AS-BUILT	AUGUST 2015

AS-BUILT DRAWING

AS-BUILT INFORMATION PROVIDED BY THE GENERAL CONTRACTOR:

KUDLIK CONSTRUCTION LTD.
IGALUIT, NUNAVUT

ORIGINAL
STAMPED
BY

G. POPOWICH
05/27/13

BURNSIDE

Nuna Burnside Engineering & Environmental LTD.
106B Scurfield Blvd., Winnipeg, Manitoba
telephone (204) 949-7110 fax (204) 949-7111
web www.neeganburnside.com

Client


GOVERNMENT OF NUNAVUT
COMMUNITY & GOVERNMENT
SERVICES

RANKIN INLET
SEWAGE TREATMENT PLANT

Drawing Title


SECOND FLOOR
MECHANICAL
PLUMBING LAYOUT AND
PLUMBING SCHEMATIC







Drawn By A.H.	Checked By D.Mack.	Drawing No.
Scale AS NOTED	Project No. 300031281	M-12

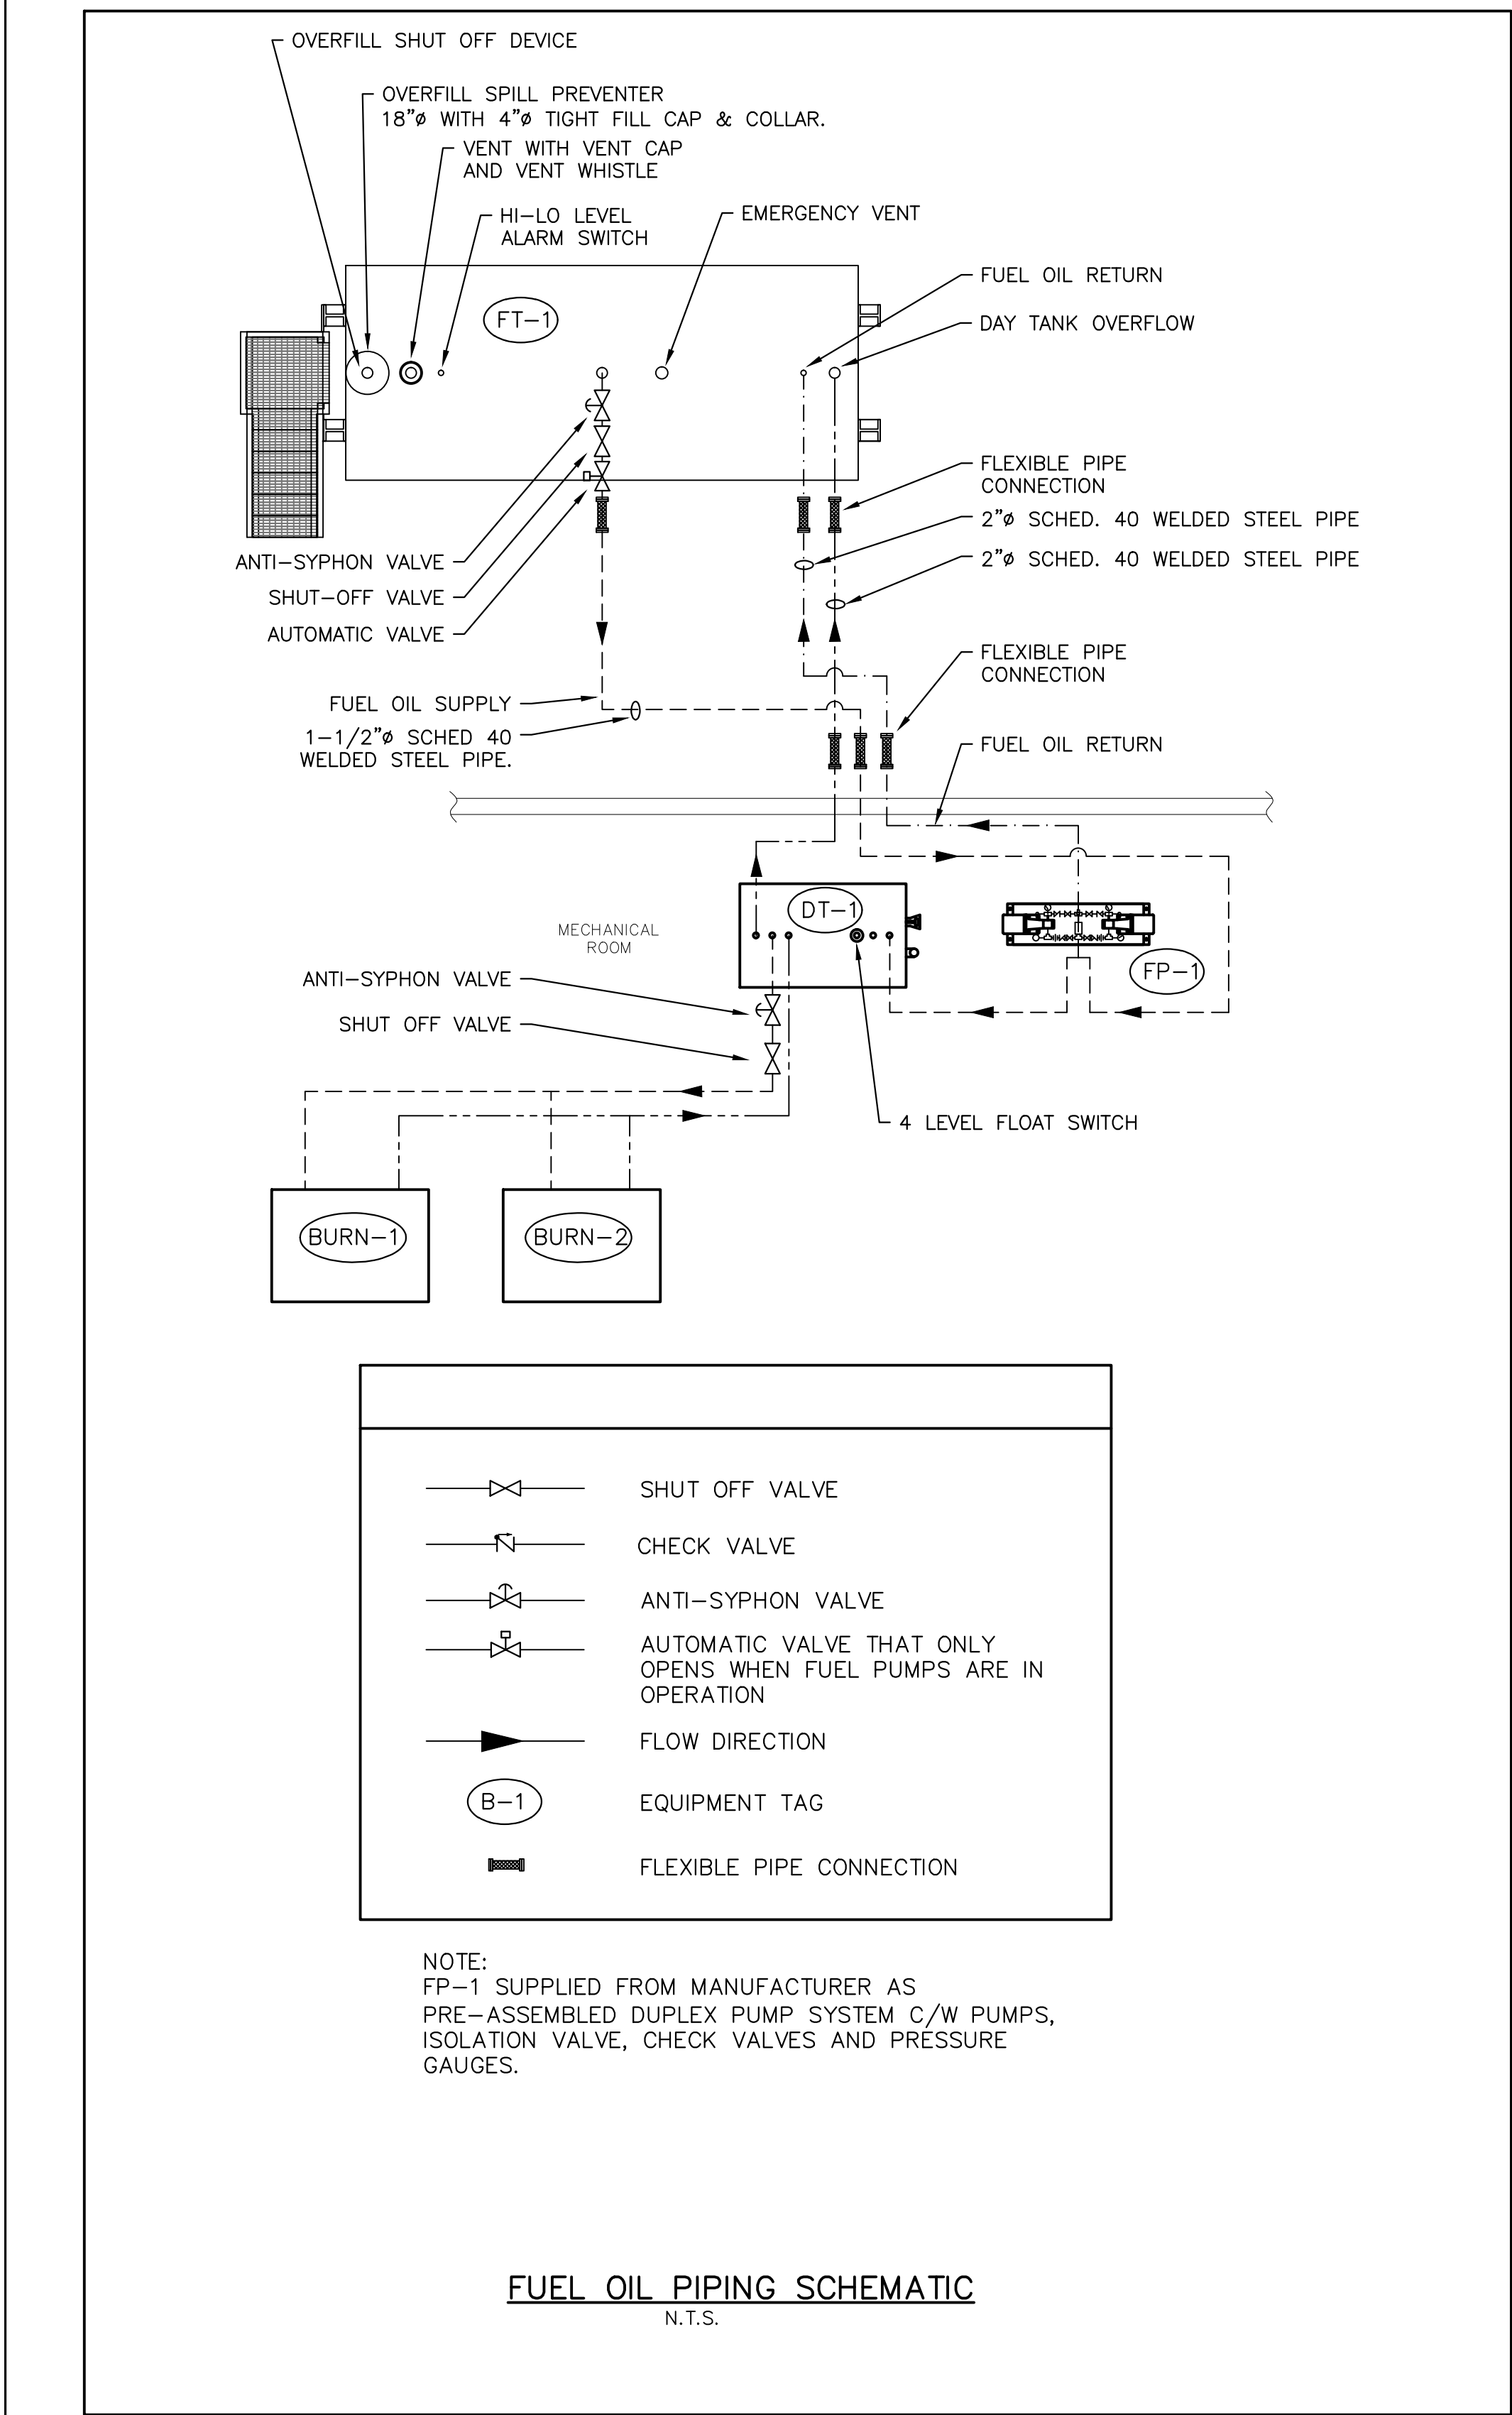

CONTROLS SCHEDULE			
TAG	DESCRIPTION	CONTROL DESCRIPTION	WWSD
B-1, BRN-1	HYDRONIC BURNER-BOILER #1	CONTROLLED BY INTEGRAL BOILER / BURNER CONTROLS IN SERIES WITH TEKMAR 274 CONTROL. TEKMAR CONTROL TO PROVIDE LEAD - LAG ALTERNATING OPERATION OF BOILERS, BURNERS AND CIRC. PUMPS CP-1 & CP-2. TEKMAR 274 CONTROL TO PROVIDE WWSD FUNCTION AND BOILER CONTROL FOR DHW HEATING AND CIRC. PUMPS CP-4. BOILER TO BE OPERATED IN "ON - OFF" MODE.	NO
B-2, BRN-2	HYDRONIC BURNER-BOILER #2	CONTROLLED BY INTEGRAL BOILER / BURNER CONTROLS IN SERIES WITH TEKMAR 274 CONTROL. TEKMAR CONTROL TO PROVIDE LEAD - LAG ALTERNATING OPERATION OF BOILERS, BURNERS AND CIRC. PUMPS CP-1 & CP-2. TEKMAR 274 CONTROL TO PROVIDE WWSD FUNCTION AND BOILER CONTROL FOR DHW HEATING AND CIRC. PUMPS CP-4. BOILER TO BE OPERATED IN "ON - OFF" MODE.	NO
GF-1	GLYCOL FEEDER #1	UNIT HAS INTEGRAL CONTROL WHICH SENSES PRESSURE IN HYDRONIC PIPING AND WHEN PRESSURE DROPS BELOW SET POINT STARTS PUMP TO PUMP GLYCOL INTO HYDRONIC PIPING UNTIL PRESSURE IN SYSTEM REACHES SHUT OFF PRESSURE AT WHICH POINT PUMP SHUTS DOWN.	YES
CP-1, CP-2	MAIN BOILER CIRCULATING PUMPS #1 & #2	CONTROLLED BY INTEGRAL BOILER CONTROLS IN SERIES WITH TEKMAR 274 CONTROL. TEKMAR CONTROL TO PROVIDE LEAD - LAG ALTERNATING OPERATION OF BOILERS, BURNERS AND CIRC. PUMPS CP-1 & CP-2. TEKMAR 274 CONTROL TO PROVIDE WWSD FUNCTION AND BOILER CONTROL FOR DHW HEATING.	NO
CP-3	CIRC. PUMP #3 EXISTING DHW THRU HX TO TANK.	AQUASTAT IN TANK PROVIDES SIGNAL TO TEKMAR 274 BOILER CONTROL. TEKMAR 274 CONTROLS CIRCULATOR CP-3 THROUGH THE HIGH LIMIT AQUASTAT SO IF THE HIGH LIMIT IS TRIPPED, PUMP CP-3 DOES NOT START. WWSD FUNCTION PROVIDED BY TEKMAR 274 CONTROL.	NO
CP-4	CIRC. PUMP #4 EXISTING GLYCOL THRU HX FROM BOILERS	AQUASTAT IN TANK PROVIDES SIGNAL TO TEKMAR 274 BOILER CONTROL. TEKMAR 274 CONTROLS CIRCULATOR CP-4 THROUGH THE HIGH LIMIT AQUASTAT SO IF THE HIGH LIMIT IS TRIPPED, PUMP CP-4 DOES NOT START. WWSD FUNCTION PROVIDED BY TEKMAR 274 CONTROL.	NO
CP-5	CIRC. PUMP #5 GLYCOL TO ALL UNIT HEATERS	WWSD FUNCTION PROVIDED BY TEKMAR 150 CONTROL, OTHERWISE RUNS CONTINUOUSLY.	YES
CP-6	CIRC. PUMP #6 GLYCOL TO FC-1	WWSD FUNCTION PROVIDED BY TEKMAR 150 CONTROL. EXIT AIR TEMPERATURE CONTROLLED BY SENSOR MOUNTED TO EXIT DUCTWORK OF FC-1. TEKMAR 361 CONTROL TO ACCEPT SENSOR INPUT AND PROVIDE VARIABLE SPEED OPERATION OF CIRCULATION PUMP.	YES
CP-7	CIRC. PUMP #7 GLYCOL TO FC-2	WWSD FUNCTION PROVIDED BY TEKMAR 150 CONTROL. EXIT AIR TEMPERATURE CONTROLLED BY SENSOR MOUNTED TO EXIT DUCTWORK OF FC-2. TEKMAR 361 CONTROL TO ACCEPT SENSOR INPUT AND PROVIDE VARIABLE SPEED OPERATION OF CIRCULATION PUMP.	YES
CP-8, CP-9	CIRC. PUMP #8 & #9 GLYCOL TO FC-3 & FC-4 RESPECTIVELY	CP-8 & CP-9 ARE REDUNDANT CIRCULATORS PROVIDING MAKE UP AIR TO VESTIBULE. UNITS NEED TO BE PROVIDED WITH AIR FLOW AND WATER FLOW SWITCHES AND CONTROLLED SO THAT A FAILURE OF EITHER AIR FLOW OR WATER FLOW OR BOTH IN THE LEAD FAN OR CIRCULATOR CAUSES THE LAG CIRCULATOR AND FAN TO BE ENERGISED. WWSD FUNCTION PROVIDED BY TEKMAR 150 CONTROL. EXIT AIR TEMPERATURE CONTROLLED THERMOSTAT MOUNTED IN ROOM. T'STAT SIGNAL TO TEKMAR 361 WHICH PROVIDES VARIABLE SPEED OPERATION OF CIRCULATOR PUMP.	YES
CP-10	CIRC. PUMP #10 GLYCOL TO FC-5	WWSD FUNCTION PROVIDED BY TEKMAR 150 CONTROL. EXIT AIR TEMPERATURE CONTROLLED BY SENSOR MOUNTED TO EXIT DUCTWORK OF FC-5. TEKMAR 361 CONTROL TO ACCEPT SENSOR INPUT AND TO PROVIDE VARIABLE SPEED OPERATION OF CIRCULATION PUMP.	YES
CP-11	CIRC. PUMP #11 GLYCOL TO ALL BASEBOARD FIN TUBE HEATERS.	WWSD FUNCTION PROVIDED BY TEKMAR 150 CONTROL, OTHERWISE RUNS CONTINUOUSLY. EXIT AIR TEMPERATURE CONTROLLED BY MECHANICAL THERMOSTATS ON EACH BASEBOARD UNIT.	YES
FC-1	FAN COIL #1 FOR PROCESS ROOM EXPLOSION PROOF	TWO SPEED OPERATION PROVIDED BY VFD INSTALLED OUTSIDE CLASSIFIED SPACE. WWSD SIGNAL PROVIDED BY TEKMAR 150 CONTROL AND USED TO CONTROL UNIT SO THAT WHEN WWSD ACTIVE (SUMMERTIME) FAN OPERATES AT HIGH SPEED. WHEN WWSD INACTIVE (WINTERTIME), FAN OPERATES AT LOW SPEED. VFD TO BE ONE OF THE UNITS SUBMITTED BY HTS	YES
FC-2	FAN COIL #2 FOR TRUCK BAY	FAN OPERATES CONTINUOUSLY EXCEPT WHEN BEING SERVICED.	NO
FC-3	FAN COIL #3 FOR VESTIBULE (REDUNDANT WITH FC #4). CONSISTS OF FAN FN-3 AND IN DUCT HYDRONIC HEATING COIL. SEE FAN FN-3 FOR CONTROL DESCRIPTION	SEE FN-3 FOR CONTROL DETAILS.	NO
FC-4	FAN COIL #4 FOR VESTIBULE (REDUNDANT WITH FC #3). CONSISTS OF FAN FN-4 AND IN DUCT HYDRONIC HEATING COIL. SEE FAN FN-4 FOR CONTROL DESCRIPTION	SEE FN-4 FOR CONTROL DETAILS.	NO
FC-5	FAN COIL #5 FOR MAKE UP AIR FOR VARIOUS SPACES.	FAN OPERATES CONTINUOUSLY EXCEPT WHEN BEING SERVICED.	NO
HUH-1	PROCESS ROOM HYDRONIC UNIT HEATER #1 EXPLOSION PROOF.	FAN CONTROLLED ALONG WITH FANS OF HUH-2, -3, -4 BY EXPLOSION PROOF THERMOSTAT INSTALLED IN PROCESS ROOM.	NO
HUH-2	PROCESS ROOM HYDRONIC UNIT HEATER #2 EXPLOSION PROOF.	FAN CONTROLLED ALONG WITH FANS OF HUH-1, -3, -4 BY EXPLOSION PROOF THERMOSTAT INSTALLED IN PROCESS ROOM.	NO
HUH-3	PROCESS ROOM HYDRONIC UNIT HEATER #3 EXPLOSION PROOF.	FAN CONTROLLED ALONG WITH FANS OF HUH-1, -2, -4 BY EXPLOSION PROOF THERMOSTAT INSTALLED IN PROCESS ROOM.	NO
HUH-4	PROCESS ROOM HYDRONIC UNIT HEATER #4 EXPLOSION PROOF.	FAN CONTROLLED ALONG WITH FANS OF HUH-1, -2, -3 BY EXPLOSION PROOF THERMOSTAT INSTALLED IN PROCESS ROOM.	NO
HUH-5	TRUCK BAY HYDRONIC UNIT HEATER #5.	FAN CONTROLLED ALONG WITH FANS OF HUH-6, -7, -8, -9 & -13 BY THERMOSTAT INSTALLED IN TRUCK BAY.	NO
HUH-6	TRUCK BAY HYDRONIC UNIT HEATER #6.	FAN CONTROLLED ALONG WITH FANS OF HUH-5, -7, -8, -9 & -13 BY THERMOSTAT INSTALLED IN TRUCK BAY.	NO
HUH-7	TRUCK BAY HYDRONIC UNIT HEATER #7.	FAN CONTROLLED ALONG WITH FANS OF HUH-5, -6, -8, -9 & -13 BY THERMOSTAT INSTALLED IN TRUCK BAY.	NO
HUH-8	TRUCK BAY HYDRONIC UNIT HEATER #8.	FAN CONTROLLED ALONG WITH FANS OF HUH-5, -6, -7, -9 & -13 BY THERMOSTAT INSTALLED IN TRUCK BAY.	NO
HUH-9	TRUCK BAY HYDRONIC UNIT HEATER #9.	FAN CONTROLLED ALONG WITH FANS OF HUH-5, -6, -7, -8 & -13 BY THERMOSTAT INSTALLED IN TRUCK BAY.	NO

CONTROLS SCHEDULE			
TAG	DESCRIPTION	CONTROL DESCRIPTION	WWSD
HUH-10	1ST FLOOR ELECT. ROOM HYDRONIC UNIT HEATER #10. EXISTING.	NEED INFORMATION ON EXISTING CONTROLS. OTHERWISE FAN CONTROLLED BY THERMOSTAT INSTALLED IN ROOM.	NO
HUH-11	2ND FLOOR ELECT. ROOM HYDRONIC UNIT HEATER #11. EXISTING.	NEED INFORMATION ON EXISTING CONTROLS. OTHERWISE FAN CONTROLLED BY THERMOSTAT INSTALLED IN ROOM.	NO
HUH-12	1ST FLOOR MECH. ROOM HYDRONIC UNIT HEATER #12. EXISTING.	NEED INFORMATION ON EXISTING CONTROLS. OTHERWISE FAN CONTROLLED BY THERMOSTAT INSTALLED IN ROOM.	NO
HUH-13	TRUCK BAY HYDRONIC UNIT HEATER #9.	FAN CONTROLLED ALONG WITH FANS OF HUH-5, -6, -7, -8 & -9 BY THERMOSTAT INSTALLED IN TRUCK BAY.	NO
FN-1	HIGH RATE SUPPLY FAN - EXPLOSION PROOF - PROCESS ROOM.	FAN ENERGISED ON DETECTION OF FLAMMABLE / NOXIOUS GASSES BY GAS DETECTORS OR BY SWITCH AT ENTRANCE DOOR TO PROCESS ROOM. IF SPACE TEMPERATURE DROPS BELOW 40°F, FAN SHUT OFF BY EXPLOSION PROOF FREEZESTAT UNTIL SPACE TEMPERATURE IS ABOVE 60°F. IF FLAMMABLE / NOXIOUS GAS STILL DETECTED OR SWITCH AT DOOR STILL "ON", FAN SHOULD RE-ENERGIZE WHEN SPACE TEMPERATURE REACHES 60°F. CYCLE ABOVE TO REPEAT UNTIL FLAMMABLE / NOXIOUS GAS NO LONGER DETECTED, AND SWITCH AT DOOR IS "OFF" WHEN FAN SHOULD BE SWITCHED OFF.	NO
FN-2	WALL MOUNTED EXHAUST FAN - EXPLOSION PROOF. PROCESS ROOM.	FAN IS TO BE INTERLOCKED TO FAN FN-1 SO WHEN FAN FN-1 IS ENERGISED, FAN FN-2 IS ALSO ENERGISED.	NO
FN-3	CABINET CEILING FAN - VESTIBULE ROOM EXHAUST. REDUNDANT WITH FN-4.	FN-3 & FN-4 ARE REDUNDANT FANS EXHAUSTING MAKE UP AIR FROM THE VESTIBULE. UNITS NEED TO BE PROVIDED WITH AIR FLOW AND WATER FLOW SWITCHES AND CONTROLLED SO THAT A FAILURE OF EITHER AIR FLOW OR WATER FLOW OR BOTH IN THE LEAD FAN OR CIRCULATOR CAUSES THE LAG CIRCULATOR AND FAN TO BE ENERGISED AND VICE VERSA. SEE ALSO CP-8 & CP-9.	NO
FN-4	CABINET CEILING FAN - VESTIBULE ROOM EXHAUST. REDUNDANT WITH FN-3.	FN-3 & FN-4 ARE REDUNDANT FANS EXHAUSTING MAKE UP AIR FROM THE VESTIBULE. UNITS NEED TO BE PROVIDED WITH AIR FLOW AND WATER FLOW SWITCHES AND CONTROLLED SO THAT A FAILURE OF EITHER AIR FLOW OR WATER FLOW OR BOTH IN THE LEAD FAN OR CIRCULATOR CAUSES THE LAG CIRCULATOR AND FAN TO BE ENERGISED AND VICE VERSA. SEE ALSO CP-8 & CP-9.	NO
FN-5	CABINET CEILING FAN - 1ST. FLOOR ELECT. ROOM EXHAUST.	FAN TO BE INTERLOCKED TO FAN IN FC-5. WHEN FC-5 FAN IS ENERGISED, FN-5 TO BE ENERGISED.	NO
FN-6	CABINET CEILING FAN - MEZZANINE ROOM EXHAUST.	FAN TO BE INTERLOCKED TO FAN IN FC-5. WHEN FC-5 FAN IS ENERGISED, FN-6 TO BE ENERGISED.	NO
FN-7	CABINET CEILING FAN - MECH. ROOM EXHAUST.	FAN TO BE INTERLOCKED TO FAN IN FC-5. WHEN FC-5 FAN IS ENERGISED, FN-7 TO BE ENERGISED.	NO
FN-8	CABINET CEILING FAN - 2ND. FLOOR ELECT. ROOM EXHAUST.	FAN TO BE INTERLOCKED TO FAN IN FC-5. WHEN FC-5 FAN IS ENERGISED, FN-8 TO BE ENERGISED.	NO
FN-9	WALL MOUNTED EXHAUST FAN - TRUCK BAY.	FAN TO BE INTERLOCKED TO FAN IN FC-2. WHEN FC-2 FAN IS ENERGISED, FN-9 TO BE ENERGISED.	NO
FN-10	DELETED	DELETED	
FN-11	CABINET CEILING FAN - WASHROOM EXHAUST. EXISTING??	FAN TO BE INTERLOCKED TO FAN IN FC-5. WHEN FC-5 FAN IS ENERGISED, FN-11 TO BE ENERGISED.	NO
FN-12	PROCESS EXHAUST FAN, HIGH PRESSURE - EXPLOSION PROOF - PROCESS ROOM.	OPERATES CONTINUOUSLY EXCEPT WHEN BEING SERVICED.	NO
FN-13	TWO SPEED WALL FAN, VFD CONTROLLED - EXPLOSION PROOF - PROCESS ROOM.	TWO SPEED OPERATION PROVIDED BY VFD INSTALLED OUTSIDE CLASSIFIED SPACE. WWSD SIGNAL PROVIDED BY TEKMAR 150 CONTROL AND USED TO CONTROL UNIT SO THAT WHEN WWSD ACTIVE (SUMMERTIME) FAN OPERATES AT HIGH SPEED. WHEN WWSD INACTIVE (WINTERTIME), FAN OPERATES AT LOW SPEED. INTERLOCK TO FAN IN FC-1. WHEN FAN IN FC-1 IS AT LOW SPEED, FAN FN-13 SHOULD BE AT LOW SPEED AND WHEN FAN IN FC-1 IS AT HIGH SPEED, FN-13 SHOULD BE AT HIGH SPEED	YES
FP-1	DUPLEX HEATING OIL PUMPING SYSTEM #1.	DUPLEX OIL PUMPING SYSTEM IS PROVIDED WITH INTEGRAL CONTROL SYSTEM. SYSTEM STARTS AND STOPS PUMPING OF OIL BASED ON LEVEL SENSORS INSTALLED IN THE DAY TANK AND THE OUTDOOR STORAGE TANK. A CALL FOR OIL IS INITIATED BY THE PUMP ON LEVEL SENSOR IN THE DAY TANK. THE CONTROL CHECKS TO ENSURE THAT THE LOW OIL ALARM IS NOT ON IN THE STORAGE TANK AND IF IT IS OFF STARTS THE OIL PUMP USING A LEAD-LAG ROTATION TO DETERMINE WHICH PUMP IS USED. IF THE LOW OIL LEVEL ALARM IS SET, THE PUMP IS LOCKED OUT. IF THE PUMP RUNS, THE DAY TANK IS FILLED UNTIL THE PUMP STOP LEVEL SWITCH CLOSES WHICH STOPS THE PUMP. THE DAY TANK IS ALSO EQUIPPED WITH A LOW LEVEL ALARM AND A HIGH LEVEL ALARM WHICH PROVIDE DRY CONTACT CLOSURES FOR THE SCADA SYSTEM. THE OUTDOOR OIL STORAGE TANK IS ALSO PROVIDED WITH LOW OIL LEVEL AND HIGH OIL LEVEL SENSORS WHICH PROVIDE ALARM OUTPUTS TO THE CONTROL SYSTEM AND TO THE SCADA SYSTEM.	NO

1. This drawing is the exclusive property of Nuna Burnside and the reproduction of any part without prior written consent of this office is strictly prohibited. 2. The contractor shall verify all dimensions, levels, and datums on site and report any discrepancies or omissions to this office prior to construction. 3. This drawing is to be read and understood in conjunction with all other plans and documents applicable to this project. 4. Do not scale the drawings.	Issue / Revision		Date	AS-BUILT DRAWING AS-BUILT INFORMATION PROVIDED BY THE GENERAL CONTRACTOR: KUDLUK CONSTRUCTION LTD. IGALUIT, NUNAVUT	<div>ORIGINAL STAMPED BY G. POPOWICH 05/27/13</div>	<div>BURNSIDE Nuna Burnside Engineering & Environmental LTD. 106B Scurfield Blvd., Winnipeg, Manitoba telephone (204) 949-7110 fax (204) 949-7111 web www.neeganburnside.com</div>	Client GOVERNMENT OF NUNAVUT COMMUNITY & GOVERNMENT SERVICES RANKIN INLET SEWAGE TREATMENT PLANT	Drawing Title MECHANICAL FUEL OIL SCHEMATIC & CONTROLS SCHEDULE	
	1	ISSUED FOR TENDER	FEBRUARY 2013						
	2	REVISED AS PER ADDENDUM 1 TO 4 AND ISSUED FOR CONSTRUCTION	APRIL 2013						
	3	AS-BUILT	AUGUST 2015						
					Drawn By A.H.		Checked By D.Mack.	Project No. 300031281	Drawing No. M-13
					Scale AS NOTED				

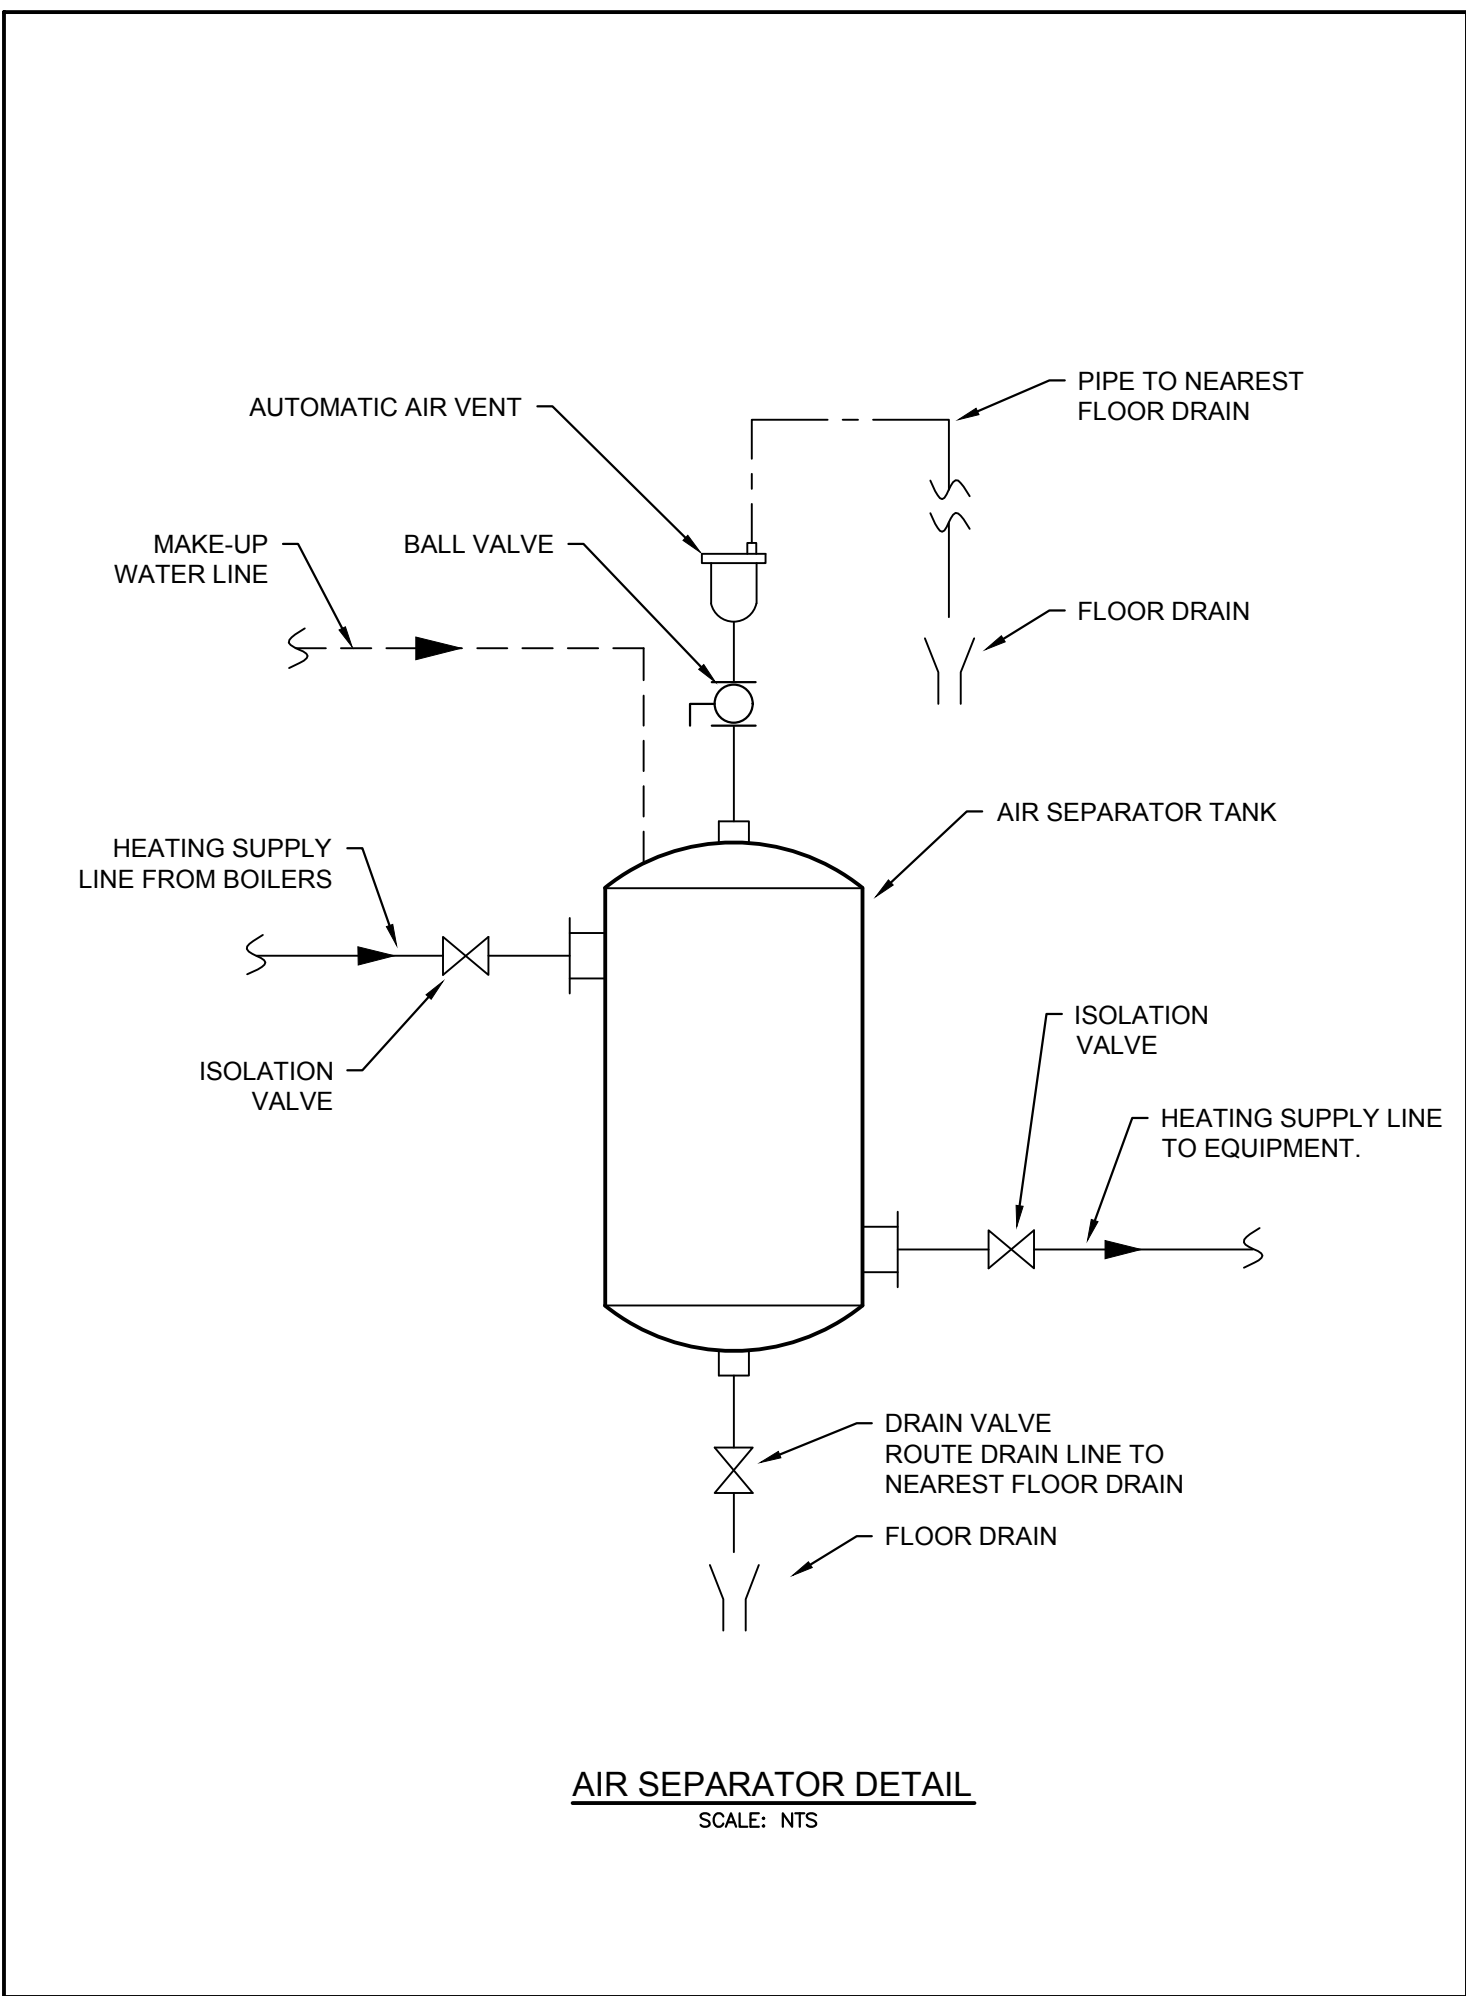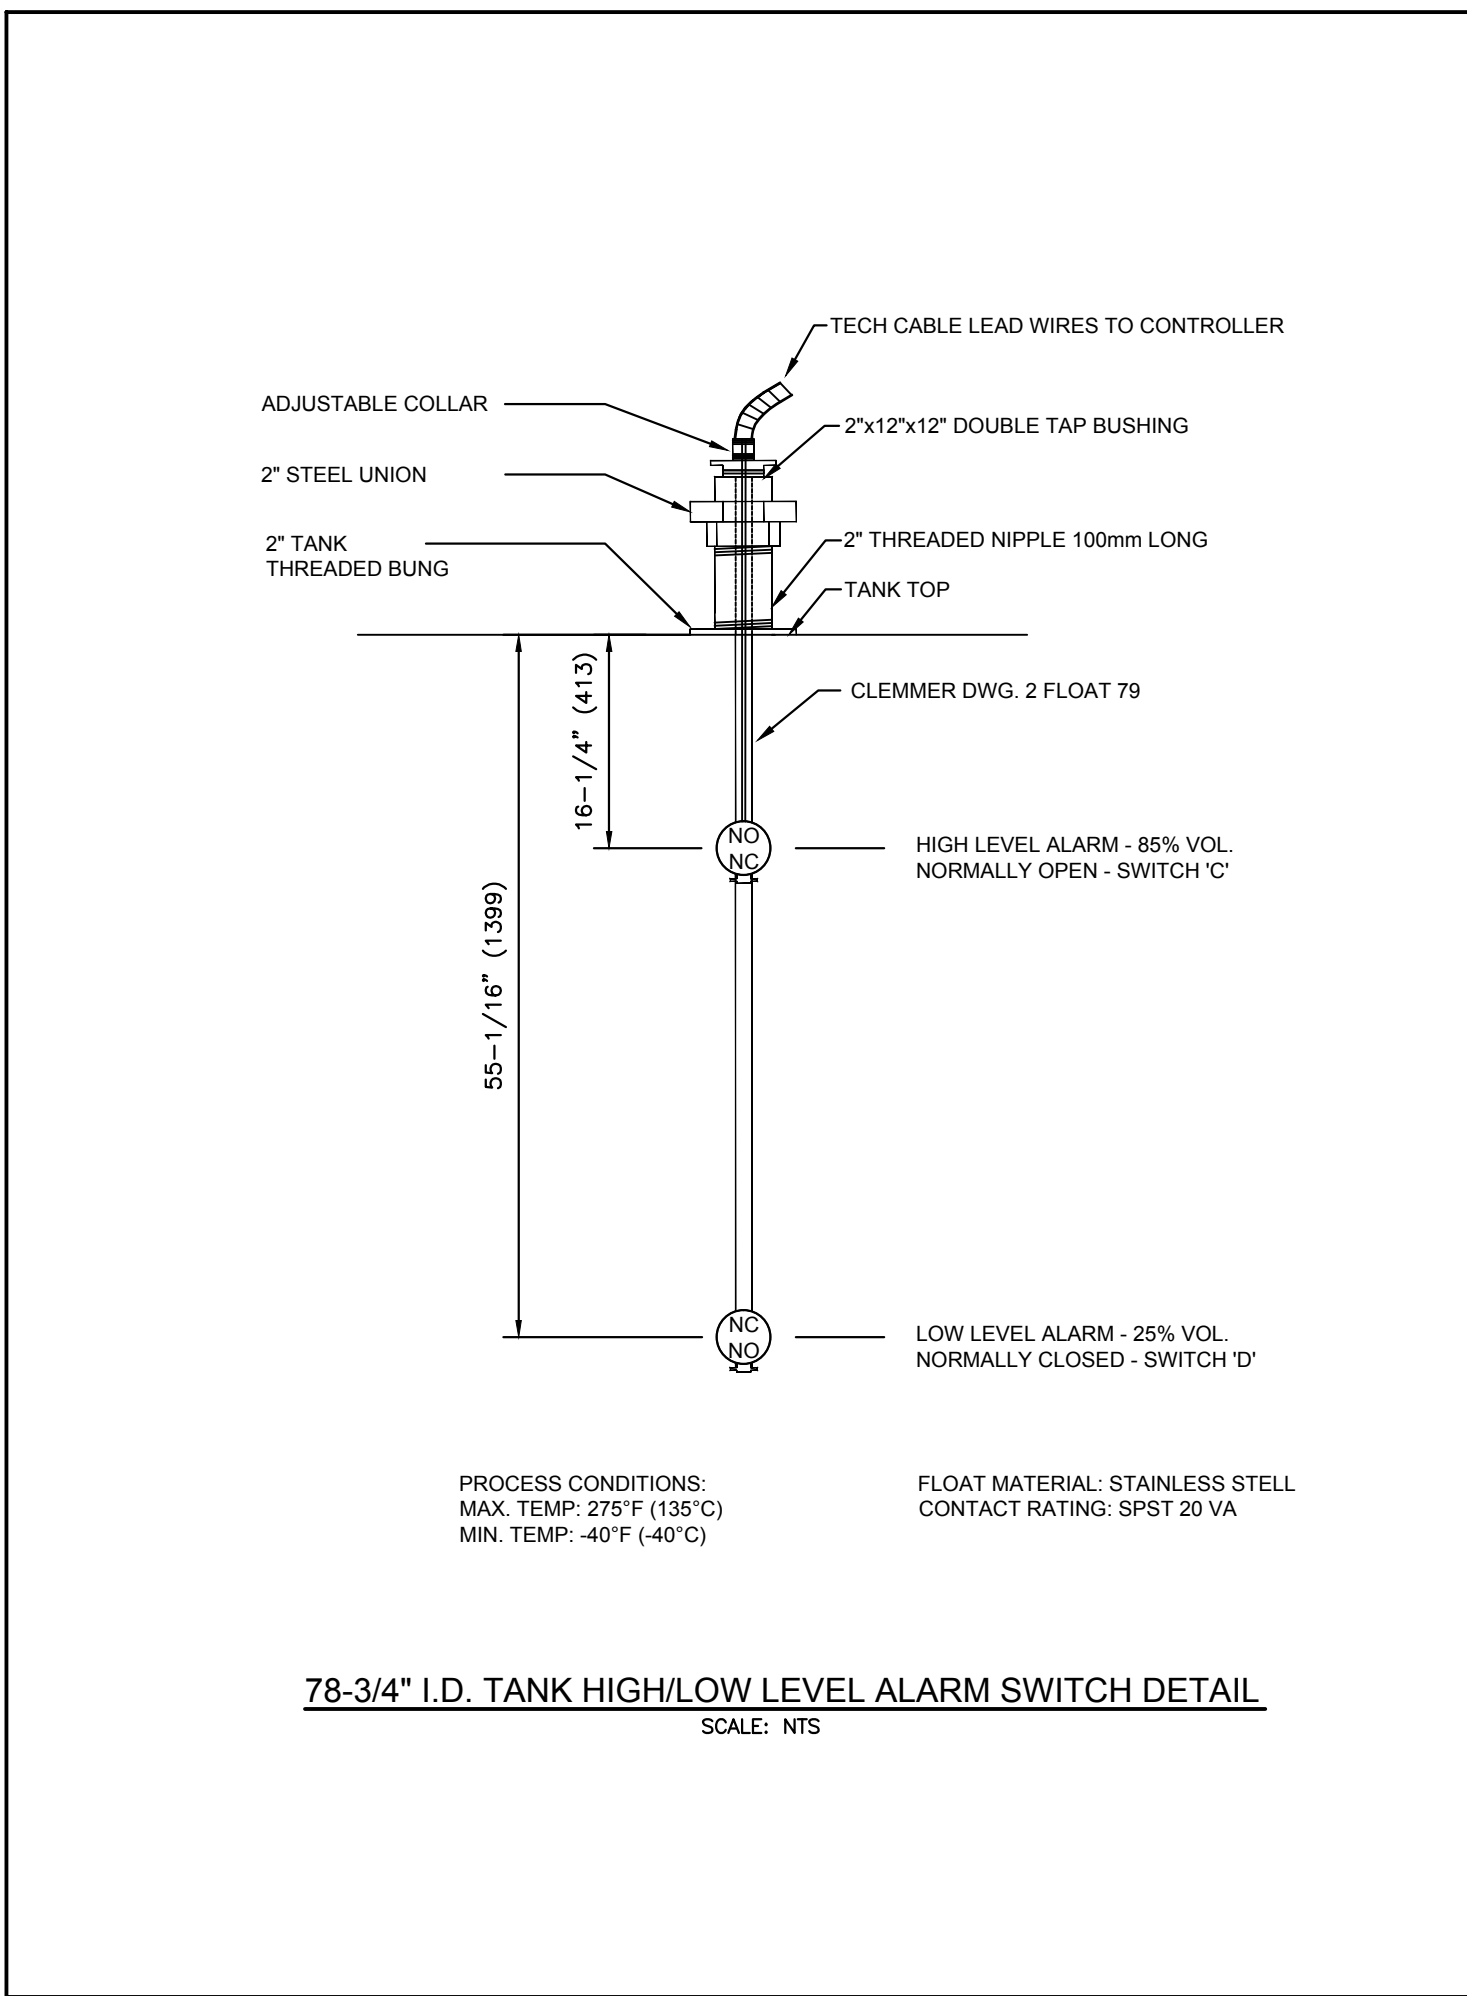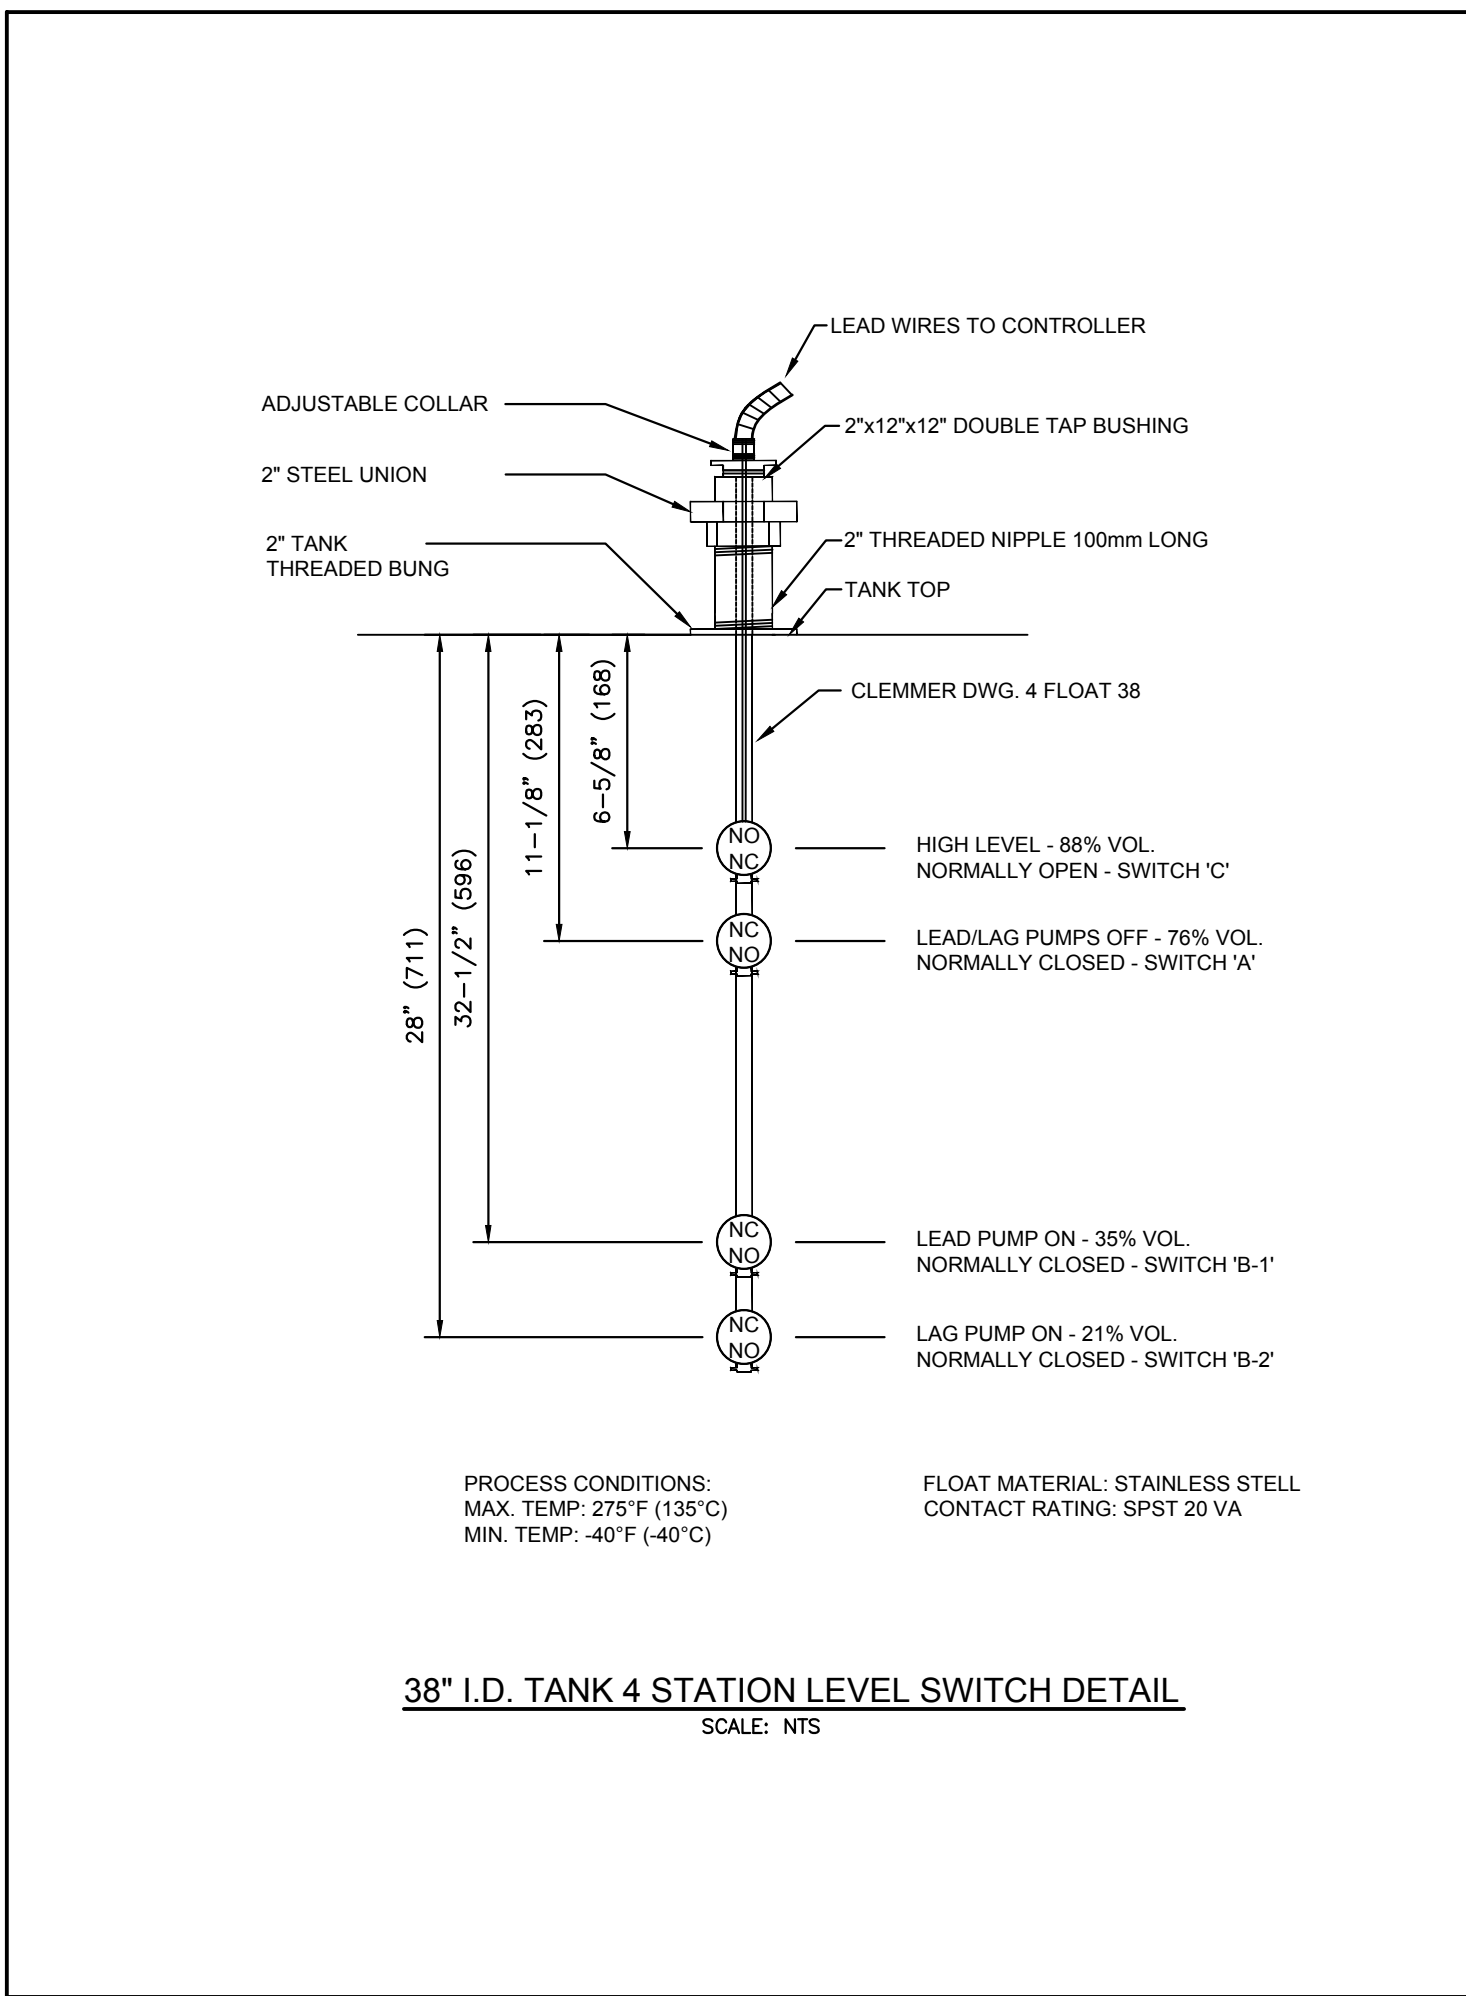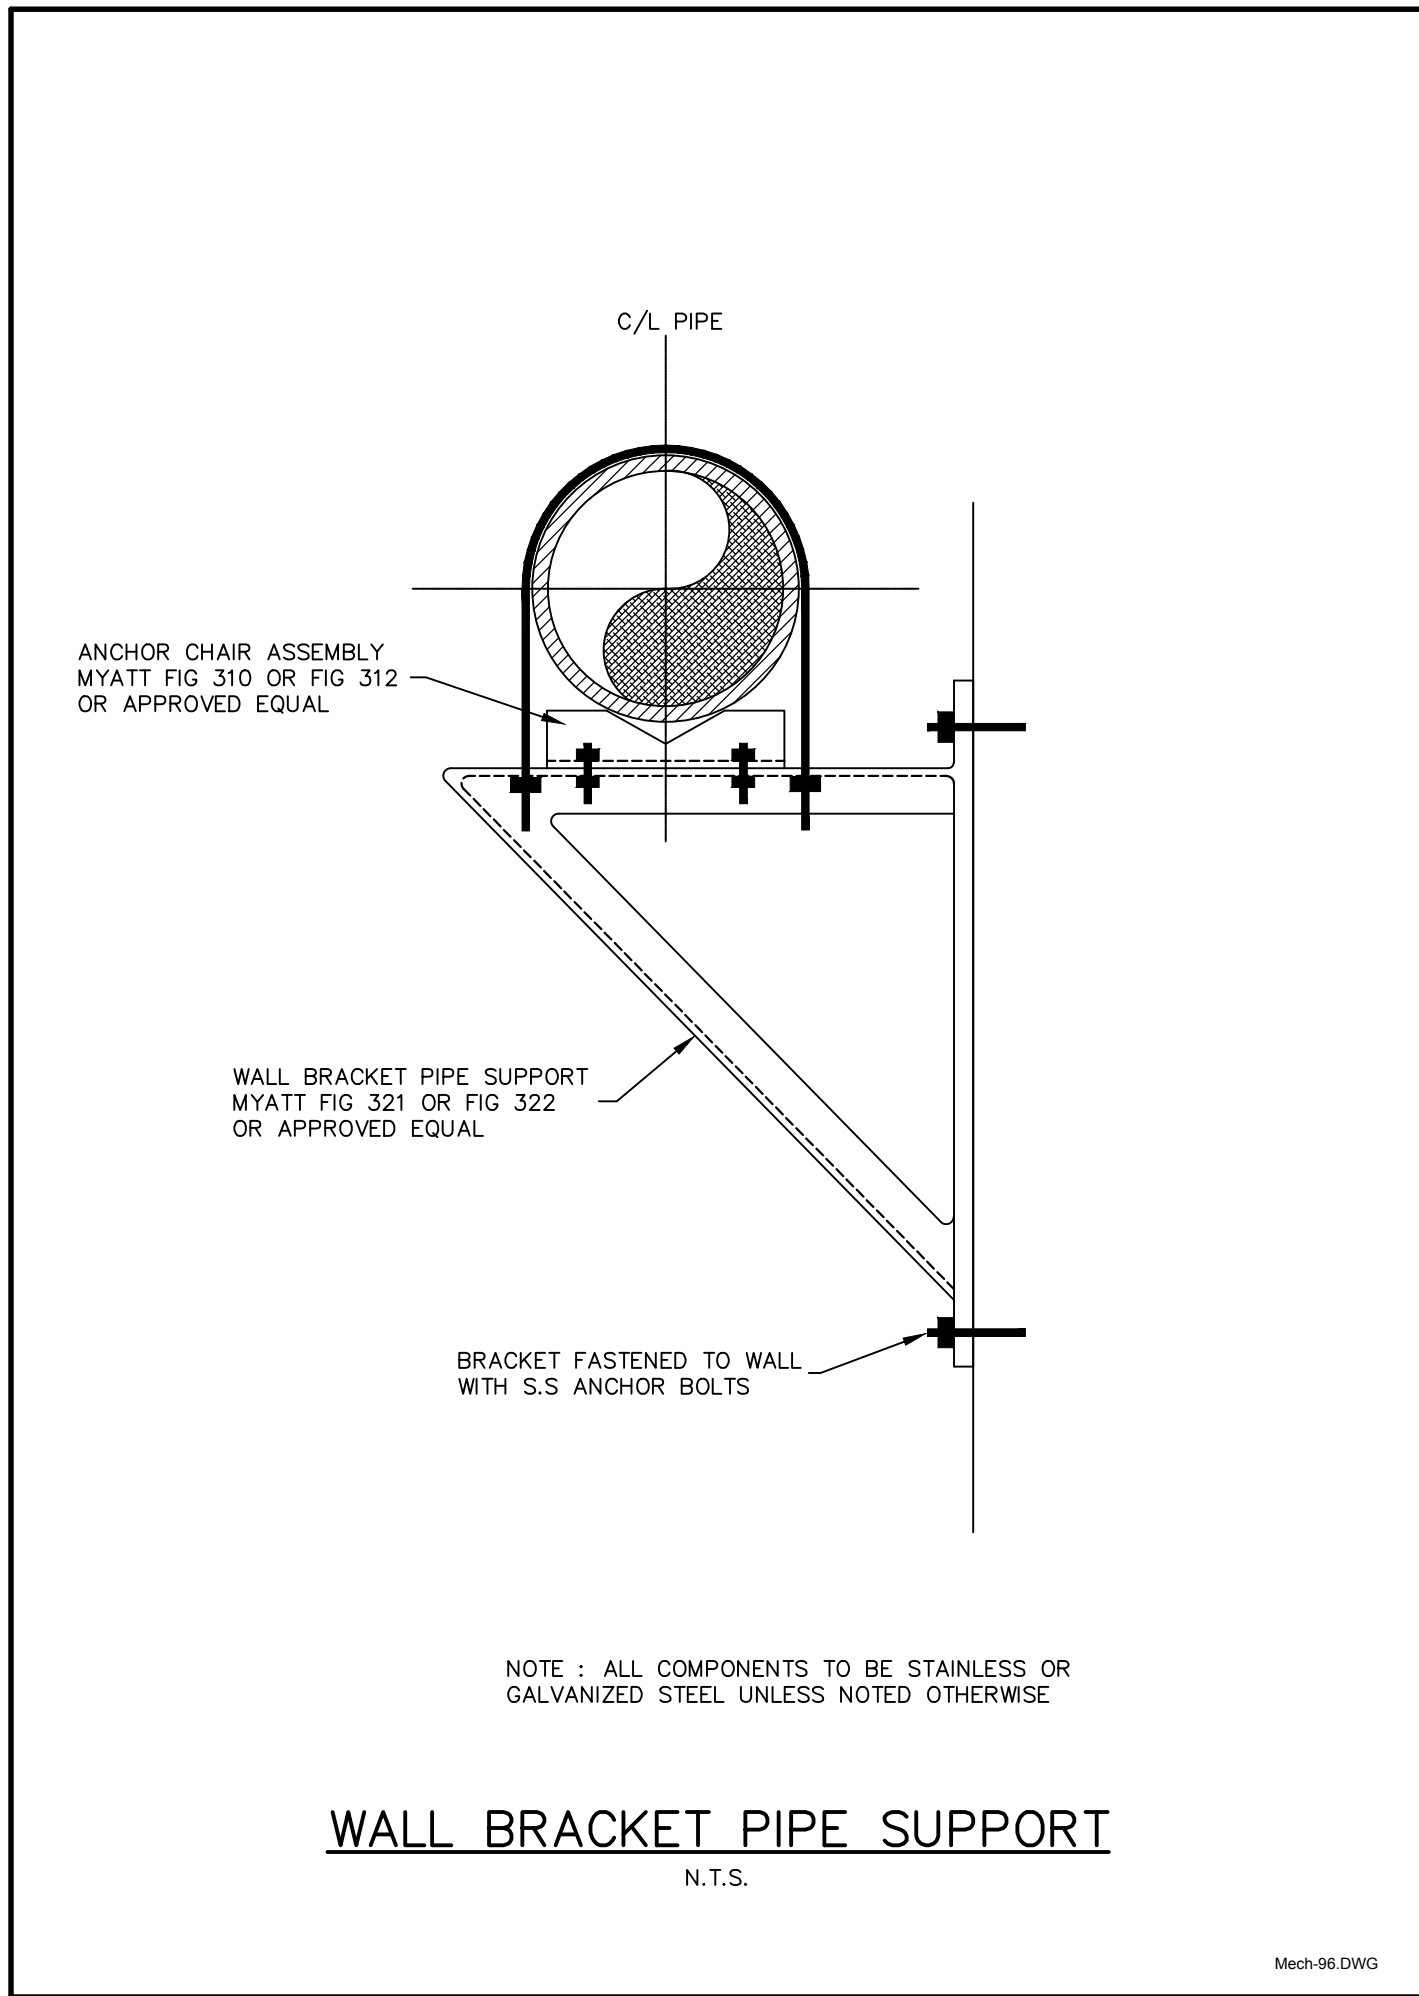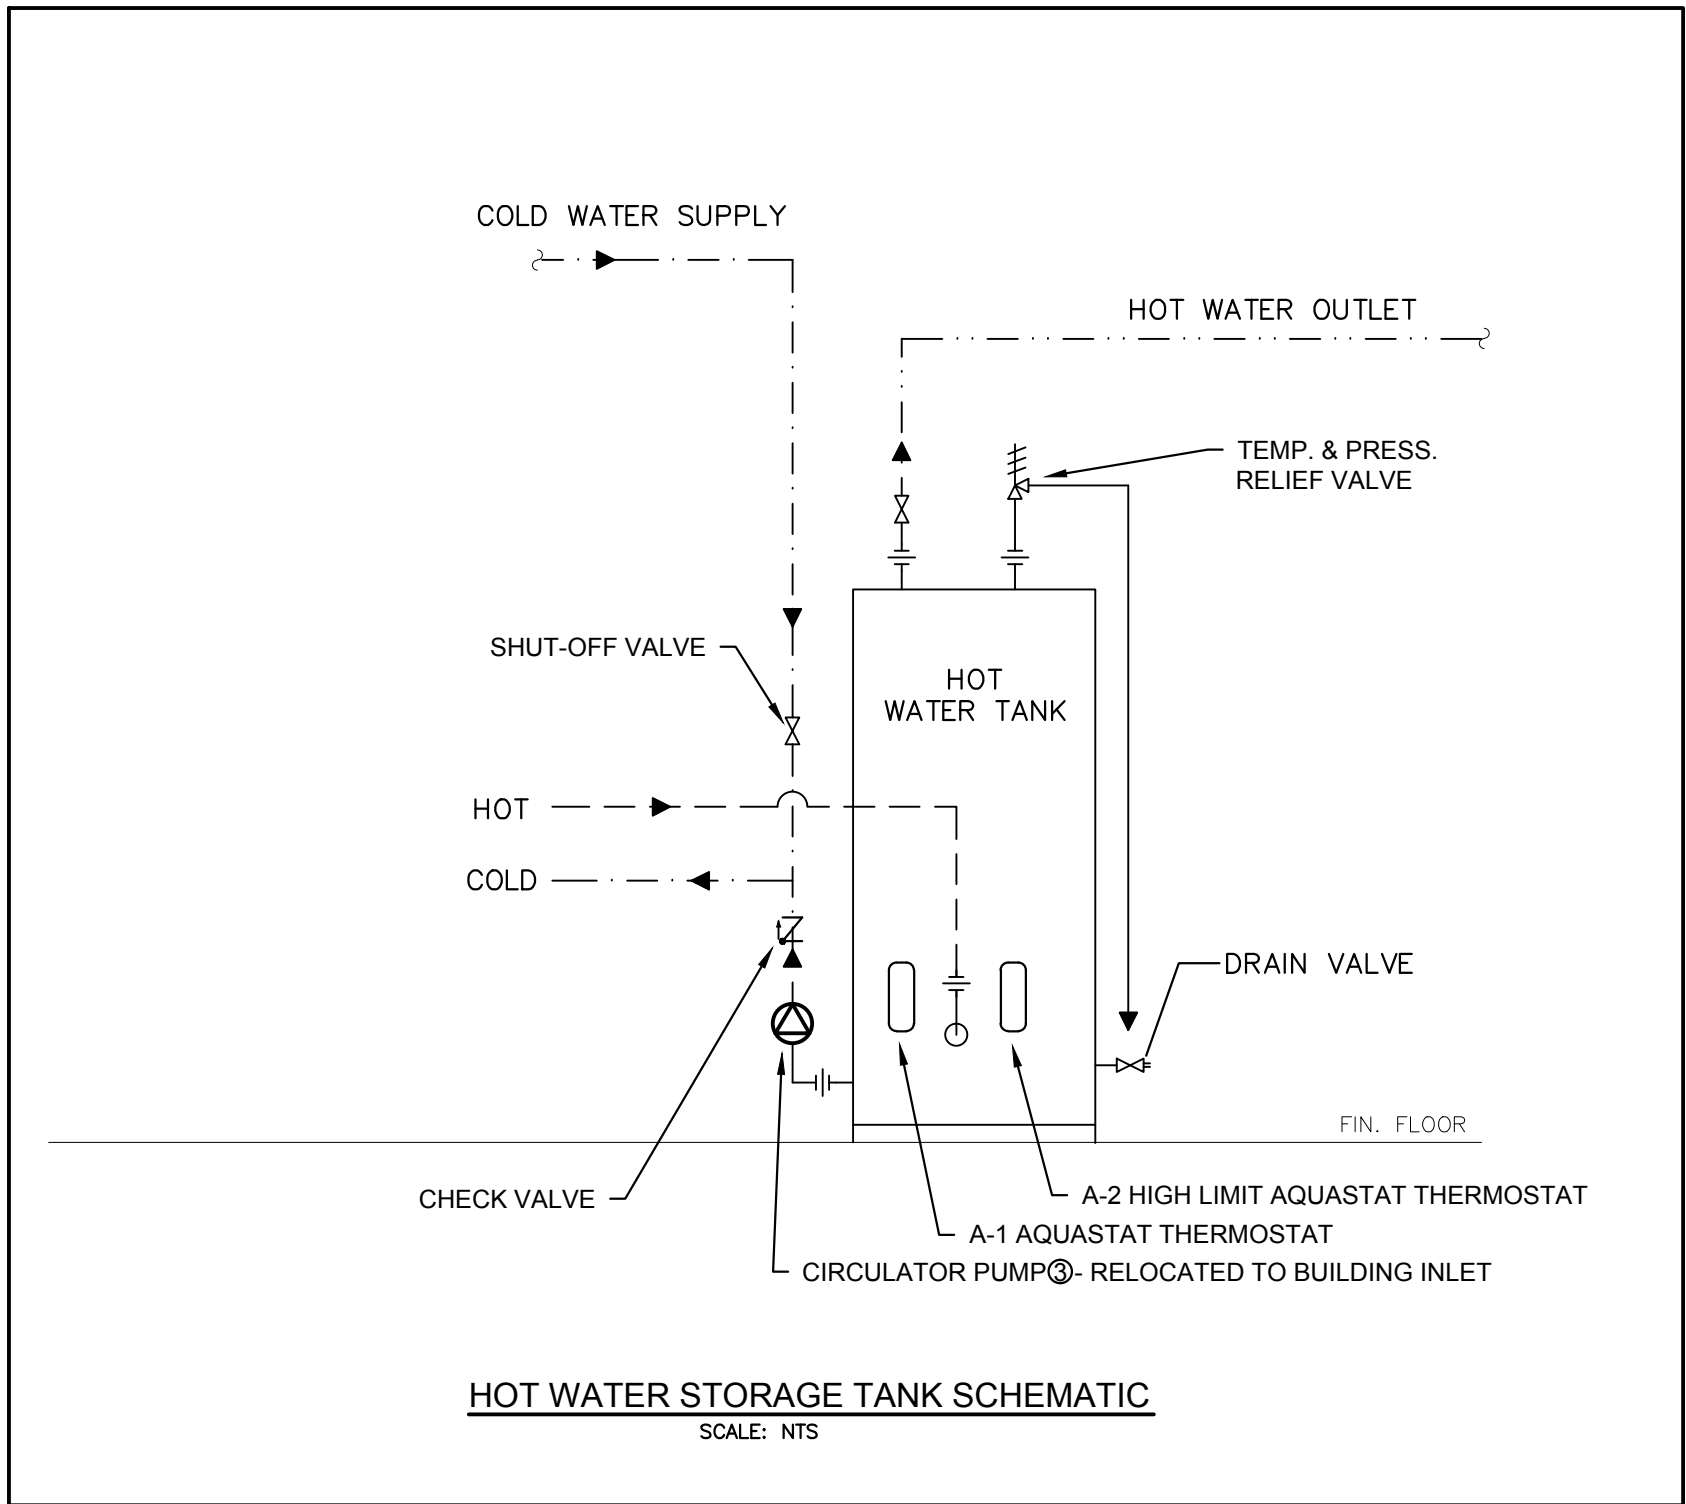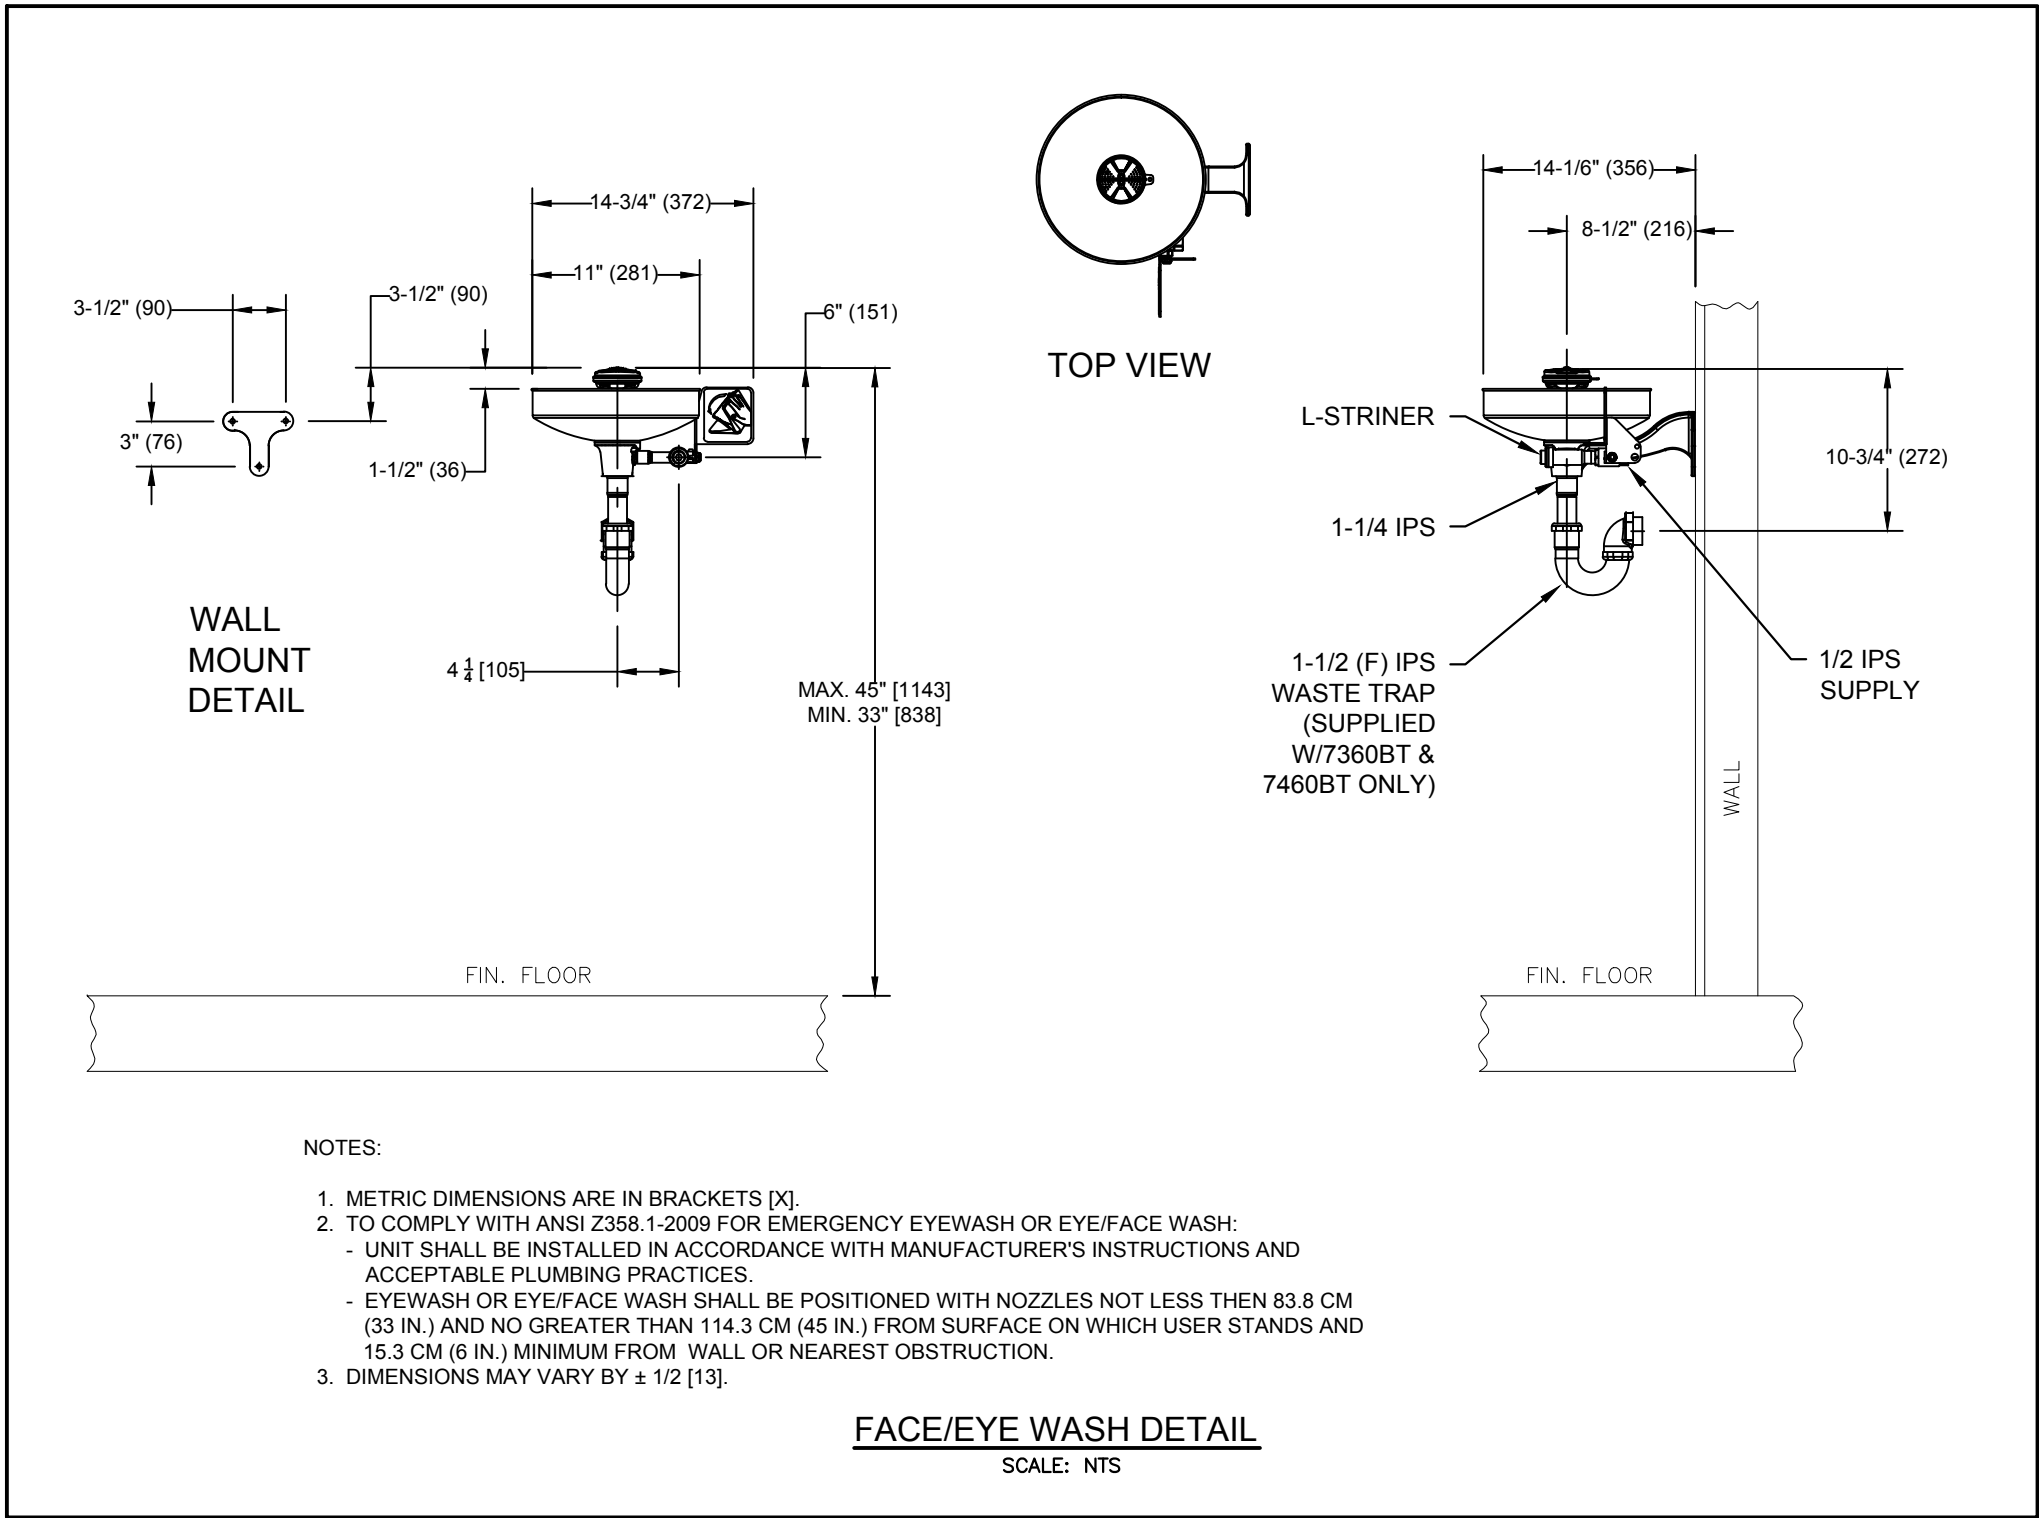

1. This drawing is the exclusive property of Nuna Burnside and the reproduction of any part without prior written consent of this office is strictly prohibited.

2. The contractor shall verify all dimensions, levels, and datums on site and report any discrepancies or omissions to this office prior to construction.

3. This drawing is to be read and understood in conjunction with all other plans and documents applicable to this project.

4. Do not scale the drawings.

Issue / Revision	Date
1 ISSUED FOR TENDER	FEBRUARY 2013
2 REVISED AS PER ADDENDUM 1 TO 4 AND ISSUED FOR CONSTRUCTION	APRIL 2013
3 AS-BUILT	AUGUST 2015

AS-BUILT DRAWING
AS-BUILT INFORMATION PROVIDED BY THE GENERAL CONTRACTOR:
KUDLIK CONSTRUCTION LTD.
IGALUIT, NUNAVUT



BURNSIDE

Nuna Burnside Engineering & Environmental LTD.
106B Scurfield Blvd., Winnipeg, Manitoba
telephone (204) 949-7110 fax (204) 949-7111
web www.neeganburnside.com

Client
GOVERNMENT OF NUNAVUT
COMMUNITY & GOVERNMENT
SERVICES
RANKIN INLET
SEWAGE TREATMENT PLANT

Drawing Title
MECHANICAL
STANDARD DETAILS 2

Drawn By A.H.	Checked By D.Mack.	Drawing No.
Scale NTS	Project No. 300031281	M-14

SINGLE LINE SYMBOLS AND CONTROL DIAGRAMS	
SYMBOL	DESCRIPTION
	CIRCUIT BREAKER, MOULDED CASE WITH THERMAL & MAGNETIC TRIPS
	MOTOR CIRCUIT PROTECTOR (MCP) STYLE BREAKER, WITH MAGNETIC TRIPS ONLY
	NEMA SIZE 1 STARTER WITH THERMAL OVERLOAD TRIP
	VARIABLE FREQUENCY DRIVE, C/W BYPASS MOTOR STARTER/CONTACTOR AND CONTROL TRANSFORMER
	SOLID STATE REDUCE VOLTAGE SOFT STARTER, C/W BYPASS CONTACTOR AND CONTROL TRANSFORMER
	REDUCE VOLTAGE AUTOTRANSFORMER STARTER
	CURRENT TRANSFORMER
	CAPACITOR
	CONTROL POWER TRANSFORMER (CPT)
	FUSE
	FUSIBLE DISCONNECT SWITCH
	NON-FUSIBLE DISCONNECT SWITCH
	DRY-TYPE POWER TRANSFORMER (INDOOR)
	OIL-FILLED POWER TRANSFORMER (OUTDOOR)
	SEAL (EYS) FITTING C/W CHICO POWDER
	MOTOR STARTER (MS) COIL, WITH COIL SUPPRESSOR
	PILOT LIGHT, WHERE "X" INDICATES LENS COLOR: R=RED, W=WHITE, G=GREEN
	PUSH TO TEST STYLE PILOT LIGHT
	ELAPSE TIME METER, IN HOURS
	CONTROL RELAY (# DENOTES RELAY NUMBER)
	TERMINAL BLOCK
	SOLENOID VALVE
	CONTACT, N.O. AND N.C.
	TEMPERATURE SWITCH, N.O AND N.C.
	LIMIT OR POSITION SWITCH, N.O AND N.C.
	PRESSURE SWITCH, N.O AND N.C.
	LEVEL OR FLOAT SWITCH, N.O AND N.C.
	TORQUE SWITCH, N.O AND N.C.
	PUSHBUTTON DEVICE, N.O AND N.C.
	SELECTOR SWITCH, 2-POSITION & 3-POSITION

LIGHTING AND POWER ELECTRICAL SYMBOLS	
SYMBOL	DESCRIPTION
	1'x4' FLUORESCENT LUMINAIRE. "X" DENOTES LUMINAIRE TYPE (REFER TO LUMINAIRE SCHEDULE).
	2'x4' FLUORESCENT LUMINAIRE. "X" DENOTES LUMINAIRE TYPE (REFER TO LUMINAIRE SCHEDULE)
	CEILING MOUNTED LUMINAIRE - "X" DENOTES TYPE
	WALL MOUNTED LUMINAIRE - "X" DENOTES TYPE
	EXIT LIGHT - "X" DENOTES TYPE
	LIGHT SWITCH C/W BACK BOX: - "S2" INDICATES 2-WIRE SWITCH - "S3" INDICATES 3-WIRE SWITCH - "S4" INDICATES 4-WIRE SWITCH - "D" INDICATES DIMMER (SIZE TO SUIT) - "T" INDICATES MANUAL TIMER
	EMERGENCY REMOTE HEADS
	EMERGENCY BATTERY UNIT WITH REMOTE HEADS AND CHARGER (BU#)
	ELECTRICAL PANEL/ENCLOSURE
	DUPLEX RECEPTACLE
	SINGLE RECEPTACLE
	GFI TYPE DUPLEX RECEPTACLE
	SPLIT DUPLEX RECEPTACLE
	DRYER RECEPTACLE
	WELDING RECEPTACLE
	SINGLE PHASE MOTOR
	THREE PHASE MOTOR
	SINGLE PHASE MANUAL STARTER SWITCH WITH LOCK-OFF AND PILOT LIGHT
	MANUAL STARTER SWITCH C/W PILOT LIGHT AND HAND/OFF/AUTO SELECTOR SWITCH
	DISCONNECT SWITCH, UN-FUSED, # DENOTES NUMBER OF POLES
	UNAUTHORIZED ENTRY KEYPAD UNIT
	MAGNETIC REED DOOR SWITCH
	MOTION SENSOR
	SMOKE DETECTOR
	TELEPHONE OUTLET
	JUNCTION BOX
	THERMOSTAT (VENTILATION)
	THERMOSTAT

GENERAL SYMBOLS	
	DETAIL SYMBOL: X = DETAIL NUMBER YZ = DRAWING NUMBER
	SYMBOL INDICATES A DEVICE LOCATION, SEE BELOW (# DENOTES LOCATION NUMBER)
	SYMBOL INDICATES MODIFICATION OR NEW WORK NOTE (# DENOTES NOTE NUMBER)
	MECHANICAL EQUIPMENT TAG

DEVICE LOCATIONS	
	DEVICE LOCATED IN MAIN PLC PANEL IN 2nd FLOOR ELECTRICAL ROOM
	DEVICE LOCATED IN THE FIELD
	DEVICE LOCATED IN MECHANICAL ROOM
	DEVICE LOCATED IN ELECTRICAL ROOM MAIN FLOOR
	DEVICE LOCATED IN ELECTRICAL ROOM 2nd FLOOR

STANDARD ABBREVIATIONS – ELECTRICAL	
ABBREVIATION	DESCRIPTION
A	AMPERES (CONTINUOUS)
AC	ALTERNATING CURRENT
ASYM	ASYMMETRICAL
ATS	AUTOMATIC TRANSFER SWITCH
AUTO	AUTOMATIC
AWG	AMERICAN WIRE GAUGE
BU	BATTERY UNIT (EMERGENCY)
°C	DEGREE CELSIUS
C	CONDUCTOR
CCT	CIRCUIT
CH	COUNTER TOP HEIGHT
CH4	METHANE
CL2	CHLORINE RESIDUAL
CL	CENTERLINE
C/W	COMPLETE WITH
CO2	CARBON DIOXIDE
CPT	CONTROL POWER TRANSFORMER
CSA	CANADIAN STANDARDS ASSOCIATION
CT	CURRENT TRANSFORMER
Cu	COPPER
DC	DIRECT CURRENT
DISC	DISCONNECT
DOx	DISSOLVED OXYGEN
DPDT	DOUBLE POLE DOUBLE THROW
DPST	DOUBLE POLE SINGLE THROW
EEMAC	ELECTRICAL AND ELECTRONIC MANUFACTURERS ASSOCIATION OF CANADA
EP	EXPLOSION PROOF (SUITABLE FOR CLASS I, ZONE 1)
ETM	ELAPSED TIME METER
ESA	ELECTRICAL SAFETY AUTHORITY
GFI	GROUND FAULT INTERRUPTER
GND	GROUND
HOA	HAND-OFF-AUTOMATIC
HP	HORSEPOWER
Hz	HERTZ
IEEE	INSTITUTE OF ELECTRICAL & ELECTRONIC ENGINEERS
INST	INSTANTANEOUS
I/O	INPUT/OUTPUT
ISB	INTRINSIC SAFETY BARRIER
JB	JUNCTION BOX
kAIC	KILO-AMP INTERRUPTING CAPACITY
kVA	KILOVOLTAMPERE
kW	KILOWATT
kWh	KILOWATT HOUR
LA	LIGHTNING ARRESTOR
LEL	LOWER EXPLOSIVE LIMIT
LOR	LOCAL-OFF-REMOTE
LUC	LOCAL UTILITY COMPANY
MAN	MANUAL
MCC	MOTOR CONTROL CENTRE
MH	MANHOLE
mm	MILLIMETER
MLSS	MIXED LIQUOR SUSPENDED SOLIDS
MOT	MOTOR
N	NEUTRAL
NEMA	NATIONAL ELECTRICAL MANUFACTURERS ASSOCIATION
N/A	NON AUTOMATIC
N.O.	NORMALLY OPEN
N.C.	NORMALLY CLOSED
NP	NAMEPLATE
NTS	NOT TO SCALE
O2	OXYGEN (PURITY)
OESC	ONTARIO ELECTRICAL SAFETY CODE
O/H	OVERHEAD
O/L	OVERLOAD
OO	ON-OFF
PB	PUSHBUTTON
PDC	POWER DISTRIBUTION CENTRE
pH	pH CELL
PH. OR Ø	PHASE OR DIAMETER
PLC	PROGRAMMABLE LOGIC CONTROLLER
REM	REMOTE
RGS	RIGID GALVANIZED STEEL
SV	SOLENOID VALVE
SN	SOLID NEUTRAL
SPDT	SINGLE POLE DOUBLE THROW
SPMDD	STANDARD PROCTOR MAXIMUM DRY DENSITY
SPST	SINGLE POLE SINGLE THROW
SW	SWITCH
SYM	SYMMETRICAL
TC	THERMOCOUPLE
TDC	TIME DELAY ON CLOSING
TDDO	TIME DELAY ON DROP-OUT
TDO	TIME DELAY ON OPENING
TDPU	TIME DELAY ON PICK-UP
TURB	TURBIDITY
TYP.	TYPICAL
U/G	UNDERGROUND
VA	VOLT-AMPERE
VFD	VARIABLE FREQUENCY DRIVE
VT	VOLTAGE TRANSFORMER (FORMER PT)
WP	WEATHERPROOF

INSTRUMENTATION IDENTIFICATION LETTERS (ISA)			
FIRST LETTER		SUCCEEDING LETTERS	
MEASURED VARIABLE	MODIFIER	READOUT FUNCTION	OUTPUT/MODIFIER
A ANALYSIS	—	ALARM	—
B BURNER	—	—	—
C CONDUCTIVITY	—	CONTROL	CONTROL
D DENSITY	DIFFERENTIAL	—	—
E VOLTAGE – EMF	—	PRIMARY ELEMENT	—
F FLOW RATE	RATIO	RATIO	—
G STATUS	—	GLASS	—
H HAND – MANUAL	HAND	—	HIGH
I CURRENT	I	INDICATE	—
J POWER	SCAN	—	—
K TIME OR TIME SQ.	—	—	CONTROL STN
L LEVEL	—	LIGHT – PILOT	LOW
M MOISTURE	MOMENTARY	MOMENTARY	MIDDLE OR INTERM
N —	ANNUNCIATION	—	ANNUNCIATION
O —	—	OFFICE	—
P PRESSURE OR VAC.	—	POINT – TEST CONNECTION	—
Q QUANTITY	INTEGRATE	INTEGRATE OR TOTALIZE	—
R RADIATION	—	RECORD OR PRINT	—
S SPEED OR FREQ.	SAFETY	—	SWITCH
T TEMPERATURE	—	—	TRANSMIT
U MULTIFUNCTION	—	MULTIFUNCTION	MULTIFUNCTION
V VIBRATION	—	—	VALVE, DAMPER
W WEIGHT OR FORCE	—	WELL	—
X STATUS	—	—	—
Y EVENT, STATE	—	—	RELAY, COMPUTE
Z POSITION	—	—	DRIVE, ACTUATOR

DRAWING LIST – ELECTRICAL	
E1	ELECTRICAL LEGEND AND DRAWING LIST
E2	PANEL AND LUMINAIRE SCHEDULES
E3	ELECTRICAL SINGLE LINE DIAGRAM
E4	ELEMENTARY CONTROL WIRING DIAGRAMS – SHEET 1
E5	ELEMENTARY CONTROL WIRING DIAGRAMS – SHEET 2
E6	INSTRUMENTATION LOOP WIRING DIAGRAM & ELEMENTARY CONTROL WIRING DIAGRAMS
E7	PLC CONFIGURATION & PANEL LAYOUTS
E8	BUILDING ELECTRICAL EQUIPMENT LAYOUT – REMOVAL
E9	BUILDING ELECTRICAL EQUIPMENT LAYOUT – LIGHTING AND HVAC
E10	BUILDING ELECTRICAL EQUIPMENT LAYOUT – POWER
E11	BUILDING ELECTRICAL EQUIPMENT LAYOUT – INSTRUMENTATION
E12	BUILDING ELECTRICAL EQUIPMENT LAYOUT – MECHANICAL ROOM HVAC LAYOUT

MASTER ELECTRICAL LEGEND
ALL SYMBOLS/DEVICES/ABBREVIATIONS LISTED MAY NOT APPLY

1. This drawing is the exclusive property of Runge & Associates Inc. and the reproduction of any part without prior written consent of this office is strictly prohibited.
2. The contractor shall verify all dimensions, levels, and datums on site and report any discrepancies or omissions to this office prior to construction.
3. This drawing is to be read and understood in conjunction with all other plans and documents applicable to this project.
4. Drawing revision must be note "Issued For Construction" before any work commences

Issue / Revision	Date dd/mm/yyyy
1 ISSUED FOR 66% SUBMISSION	06/09/2012
2 ISSUED FOR 99% SUBMISSION	JANUARY 2013
3 ISSUED FOR TENDER	FEBUARY 2013
4 REVISED AS PER ADDENDUM 1 TO 4 AND ISSUED FOR CONSTRUCTION	APRIL 2013
5 AS BUILT	AUGUST 2015

AS-BUILT DRAWING	
AS-BUILT INFORMATION PROVIDED BY THE GENERAL CONTRACTOR:	
KUDLIK CONSTRUCTION LTD.	
IGALUIT, NUNAVUT	

ORIGINAL STAMPED BY
G.Runge
04/22/13

runge & associates inc. ENGINEERS	12066N
864 Huronterria Street P.O. Box 387 Collingwood, ON, L9Y 3Z7	b: (705) 446-3590 f: (705) 446-3588 www.ralengineers.co


ᑲᓄᓐᑲᓄᓐ BURNSIDE Nuna Burnside Engineering & environmental LTD. 106B Scurfield Blvd., Winnipeg, Manitoba telephone (204) 949-7110 fax (204) 949-7111 web www.neeganburnside.com

Client	GOVERNMENT OF NUNAVUT COMMUNITY & GOVERNMENT SERVICES RANKIN INLET SEWAGE TREATMENT PLANT
--------	--

Drawing Title	ELECTRICAL LEGEND AND DRAWING LIST		
Drawn By T.T.	Checked By S.R.T.	Drawing No. E1	
Scale AS SHOWN	Project No. 300031281		

NEW POWER CABLE SCHEDULE	
PC01	3C#10AWG Cu PLUS #10AWG Cu GROUND, TYPE RW90 IN 27mm \varnothing CONDUIT.
PC02	3C#3/0AWG Cu PLUS #2AWG Cu GROUND, TYPE RW90 IN 53mm \varnothing CONDUIT.
PC03	3C#2AWG Cu PLUS #8AWG Cu GROUND, TYPE RW90 IN 53mm \varnothing CONDUIT.
PC04	3C#12AWG Cu PLUS #12AWG Cu GROUND, TYPE RW90 IN 27mm \varnothing CONDUIT.
PC05	3C#12AWG SHIELDED "VFD" RATED CABLE C/W 3-SYMMETRICALLY CONSTRUCTED GROUND CONDUCTORS IN 27mm \varnothing CONDUIT.
PC06	3C#10AWG Cu PLUS #10AWG Cu GROUND, TYPE RW90 IN 27mm \varnothing CONDUIT.
PC07	3C#10AWG SHIELDED "VFD" RATED CABLE C/W 3-SYMMETRICALLY CONSTRUCTED GROUND CONDUCTORS IN 27mm \varnothing CONDUIT.
PC08	3C#8AWG Cu PLUS #10AWG Cu GROUND, TYPE RW90 IN 53mm \varnothing CONDUIT.

EXISTING POWER CABLE SCHEDULE	
EC01	3C#750MCM Cu PLUS #1/0AWG Cu GROUND, TYPE RW90 IN 103mm \varnothing CONDUIT.
EC02	3C#3AWG Cu PLUS #8AWG Cu GROUND, TYPE RW90 IN 53mm \varnothing CONDUIT.
EC03	3C#750MCM Cu PLUS #1/0AWG Cu GROUND, TYPE RW90 IN 103mm \varnothing CONDUIT.
EC04	3C#750MCM Cu PLUS #1/0AWG Cu GROUND, TYPE RW90 IN 103mm \varnothing CONDUIT.
EC05	3C#750MCM Cu PLUS #1/0AWG Cu GROUND, TYPE RW90 IN 103mm \varnothing CONDUIT.
EC06	3C#8AWG Cu PLUS #10AWG Cu GROUND, TYPE RW90 IN 27mm \varnothing CONDUIT.
EC07	3C#600MCM Cu PLUS #1AWG Cu GROUND, TYPE RW90 IN 103mm \varnothing CONDUIT.
EC08	3C#10AWG Cu PLUS #10AWG Cu GROUND, TYPE RW90 IN 27mm \varnothing CONDUIT.
EC09	3C#12AWG Cu PLUS #12AWG Cu GROUND, TYPE RW90 IN 27mm \varnothing CONDUIT.
EC10	3C#1/0AWG Cu PLUS #6AWG Cu GROUND, TYPE RW90 IN 53mm \varnothing CONDUIT.
EC11	3C#6AWG Cu PLUS #10AWG Cu GROUND, TYPE RW90 IN 53mm \varnothing CONDUIT.

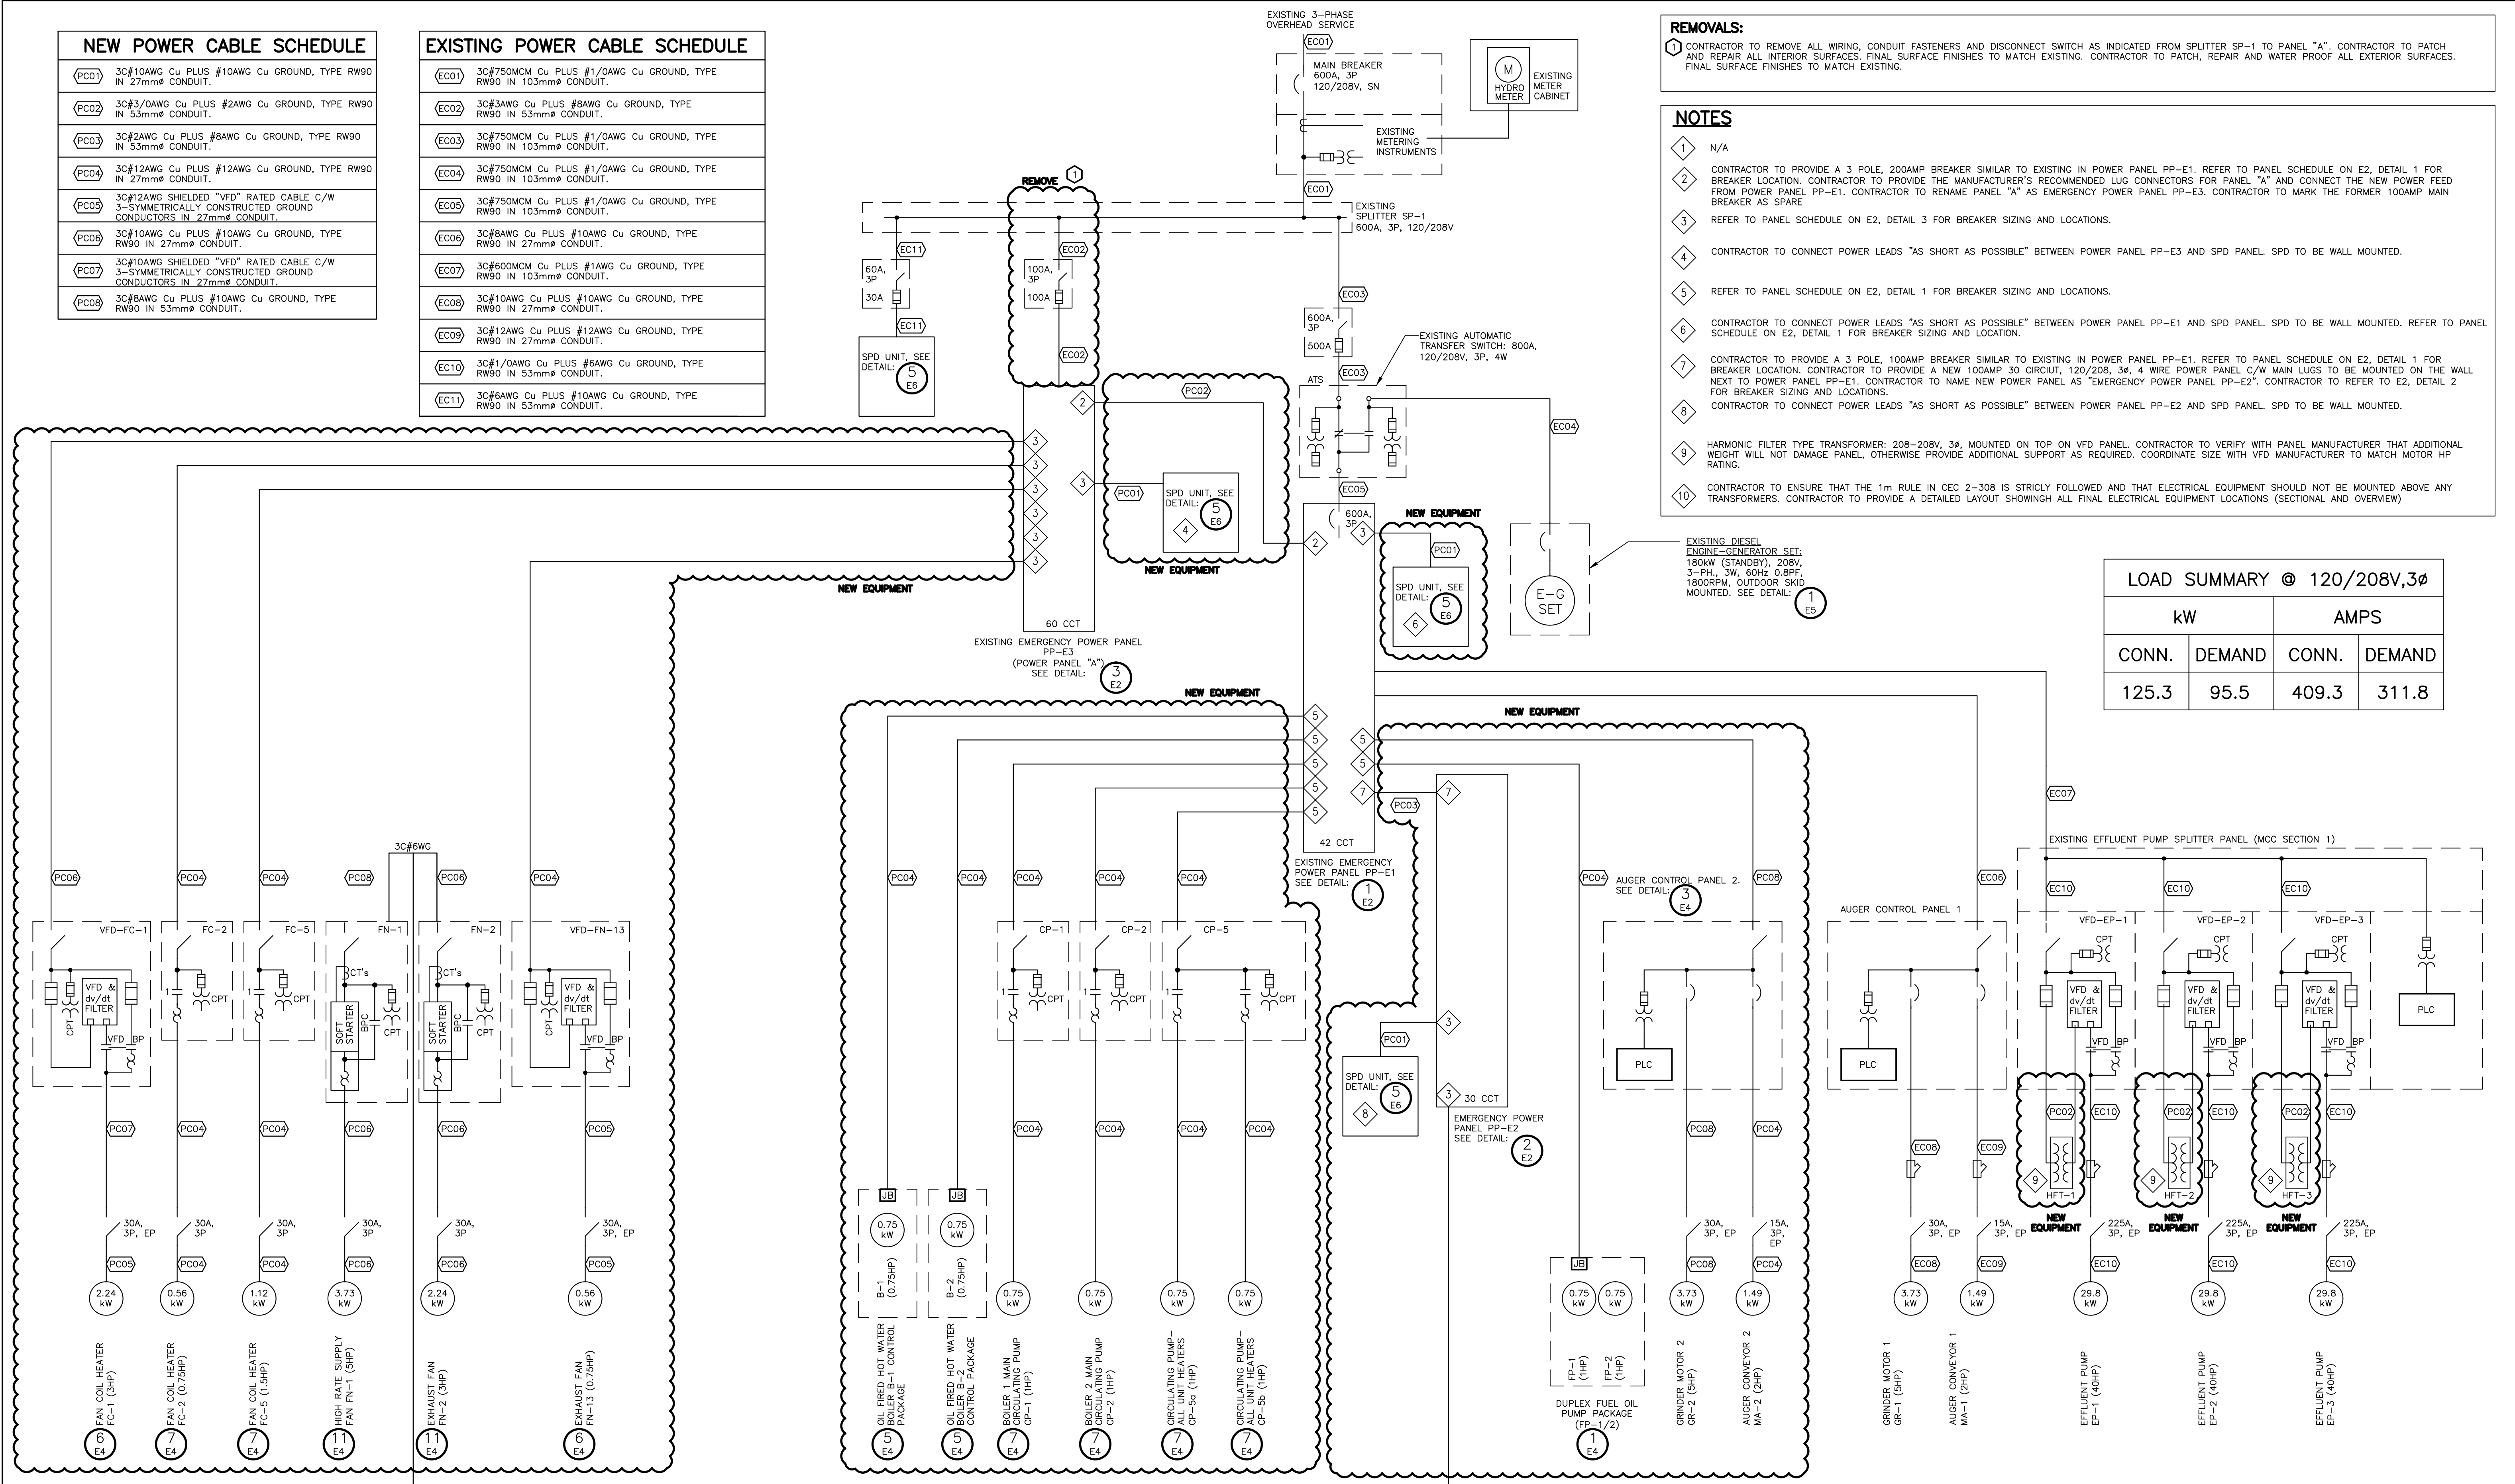

ELECTRICAL SINGLE LINE DIAGRAM

1. This drawing is the exclusive property of Runge & Associates Inc. and the reproduction of any part without prior written consent of this office is strictly prohibited.

2. The contractor shall verify all dimensions, levels, and datums on site and report any discrepancies or omissions to this office prior to construction.

3. This drawing is to be read and understood in conjunction with all other plans and documents applicable to this project.

4. Drawing revision must be noted "Issued For Construction" before any work commences.

Issue / Revision	Date dd/mm/yyyy
1 ISSUED FOR 66% SUBMISSION	06/09/2012
2 ISSUED FOR 99% SUBMISSION	JANUARY 2013
3 ISSUED FOR TENDER	FEBRUARY 2013
4 REVISED AS PER ADDENDUM 1 TO 4 AND ISSUED FOR CONSTRUCTION	APRIL 2013
5 AS BUILT	AUGUST 2015

AS-BUILT DRAWING

AS-BUILT INFORMATION PROVIDED BY THE GENERAL CONTRACTOR:

KUDLIK CONSTRUCTION LTD.

IGALUIT, NUNAVUT

ORIGINAL STAMPED BY

G. Runge

04/22/13

runge

& associates inc. ENGINEERS

864 Huronterria Street
P.O. Box 387
Collingwood, ON, L9Y 3Z7

b: (705) 446-3590
f: (705) 446-3588
www.rungeengineers.ca

BURNSIDE

Nuna Burnside Engineering & environmental LTD.

106B Scurfield Blvd., Winnipeg, Manitoba

telephone (204) 949-7110 fax (204) 949-7111

web www.neeganburnside.com

Client

**GOVERNMENT OF NUNAVUT
COMMUNITY & GOVERNMENT
SERVICES**

RANKIN INLET

SEWAGE TREATMENT PLANT

Drawing Title

**ELECTRICAL SINGLE LINE
DIAGRAM**

Drawn By: T.T. Checked By: S.R.T.

Scale: AS SHOWN Project No: 300031281

Drawing No: E3