

1. GENERAL NOTES

1. CHECK ALL DIMENSIONS ON STRUCTURAL DRAWINGS WITH ALL OTHER CONTRACT DRAWINGS. DIMENSIONS AND ELEVATIONS RELATING TO STRUCTURAL MEMBERS AS SHOWN ON THESE DRAWINGS GOVERN THE STRUCTURAL WORK. REPORT ANY INCONSISTENCIES BEFORE PROCEEDING WITH CONSTRUCTION. DO NOT SCALE THESE DRAWINGS. THE ATTACHED DRAWINGS AND SPECIFICATIONS RELATE ONLY TO THE SCOPE OF WORK AND CONTRACT FOR WHICH NUNA BURNSIDE HAS BEEN RETAINED. THESE DOCUMENTS MAY BE FOR COMPONENTS, OR LIMITED PORTIONS OF, THE TOTAL PROJECT BEING UNDERTAKEN BY THE OWNER AND CONTRACTOR. REVIEW THESE DOCUMENTS IN THE CONTEXT OF THE ENTIRE PROJECT AND ITEMS PRODUCED BY OTHER FIRMS OR DISCIPLINES.
2. THE STRUCTURAL DESIGN IS BASED UPON THE INFORMATION PROVIDED IN THE FOLLOWING REPORTS: AMEC GEOTECHNICAL REPORT XY00756, DATED DECEMBER 2005, AMEC GEOTECHNICAL MEMO XY877, DATED SEPTEMBER 20, 2012.
3. THESE DRAWINGS ARE THE PROPERTY OF NUNA BURNSIDE LTD., ARE PROTECTED BY COPYRIGHT AND ARE NOT TO BE REPRODUCED IN ANY MANNER WITHOUT WRITTEN APPROVAL.
4. THESE DRAWINGS ARE NOT TO BE USED FOR CONSTRUCTION UNLESS NOTED AS ISSUED FOR CONSTRUCTION" AND SIGNED AND SEALED BY A REGISTERED PROFESSIONAL ENGINEER FROM NUNA BURNSIDE LTD.
5. THESE DRAWINGS SHOW THE COMPLETED STRUCTURE FOR ITS INTENDED FINAL USE AND OCCUPANCY AS STATED. THE CONTRACTOR IS RESPONSIBLE FOR SAFETY AND FOR DESIGN, INSTALLATION, AND SUPERVISION OF ALL TEMPORARY BRACING, SHORING AND CONSTRUCTION LOADS AND SUPPORTS. THE CONTRACTOR IS RESPONSIBLE FOR PROTECTING WORK AND MATERIALS FROM HAZARDS AND ENVIRONMENTAL CONDITIONS THAT WOULD BE DETRIMENTAL TO THE FINISHED PRODUCT, CONDITIONS SUCH AS FLOODING, FROST, EXTREME WEATHER, UNEVEN SUPPORTS FOR STORAGE OF FRAGILE MATERIALS. THE CONTRACTOR IS RESPONSIBLE FOR ALL SITE CLEAN UP AND RECYCLING OF WASTE OR UNUSED MATERIALS.
6. STANDARD OR TYPICAL DETAIL SHEETS ON THIS PROJECT SHOW STRUCTURAL INTENT RATHER THAN ACTUAL CONDITIONS FOR THIS PROJECT.
7. ALL DIMENSIONS ARE IN MILLIMETRES UNLESS NOTED. ELEVATIONS ARE IN METRES UNLESS NOTED.
8. THE CONTRACTOR SHALL BE EXPERIENCED IN THE WORK REQUIRED. WORK SHALL BE COMPLETED IN ACCORDANCE WITH ACCEPTED STANDARD PRACTICE OF THE INDUSTRY.
9. THE CONTRACTOR IS REQUIRED TO SCHEDULE ALL INDEPENDENT INSPECTION AND TESTING SERVICE REPORTS TO BE SUBMITTED TO THIS OFFICE FOR REVIEW. THE CONTRACTOR IS TO KEEP THIS OFFICE UPDATED WITH RESPECT TO SITE PROGRESS ON A PERIODIC BASIS, TO ALLOW FOR PERIODIC FIELD REVIEWS BY THE ENGINEER. PROVIDE AT LEAST 5 BUSINESS DAYS MINIMUM NOTICE TO THE ENGINEER FOR ANY REQUIRED SITE VISITS.
10. THE CONTRACTOR SHALL BE RESPONSIBLE TO VERIFY ALL SITE CONDITIONS, UTILITY LOCATIONS, AND REPORT ANY DISCREPANCIES OR UNSATISFACTORY CONDITIONS IMPACTING THE DESIGN, IMMEDIATELY TO THE ENGINEER.
11. SUBMIT ENGINEERED ERECTION DRAWINGS FOR ALL OFF SITE FABRICATED COMPONENTS AND ASSEMBLIES, FOR REVIEW AND COORDINATION OF DESIGN ELEMENTS ONLY BEFORE FABRICATION.
12. CONNECTION DESIGN BETWEEN ALL SIMILAR MATERIALS, SUCH AS STEEL TO STEEL, OR WOOD TO WOOD ARE TO BE DESIGNED BY THE SUPPLIER'S ENGINEER UNLESS NOTED.
13. ALL STRUCTURAL MEMBERS ARE LOADED CONCENTRICALLY AT MEMBER CENTERLINES UNLESS

2. DESIGN CODES AND LOADING

1. THE DESIGN HAS BEEN PREPARED IN ACCORDANCE WITH THE REQUIREMENTS OF THE 2010 NATIONAL BUILDING CODE. THE CONSTRUCTION AND TEMPORARY WORKS MUST ALSO BE IN ACCORDANCE WITH THE OCCUPATIONAL HEALTH AND SAFETY ACT AND REGULATIONS FOR CONSTRUCTION PROJECTS (LATEST EDITIONS), LOCAL REGULATIONS AND BYLAWS.
2. DESIGN STANDARDS
 1. CSA CAN/CSA-086-09 "ENGINEERING DESIGN IN WOOD"
 2. CSA A371-04 "MASONRY CONSTRUCTION FOR BUILDINGS"
 3. CSA S304, 1-04 "DESIGN OF MASONRY STRUCTURES"
 4. CSA CAN/CSA-2531-09 "CONCRETE MATERIALS & METHODS OF CONCRETE CONSTRUCTION"
 5. CSA CAN/CSA-2533-04 "DESIGN OF CONCRETE STRUCTURES"
 6. CSA CAN/CSA-2534-09 "PRECAST CONCRETE - MATERIAL AND CONSTRUCTION"
 7. CSA CAN/CSA-2536-01 "COLD FORMED STEEL DECKING"
 8. CSA CAN/CSA-516-09 "LIMIT STATES DESIGN OF STEEL STRUCTURES"
 9. CANADIAN FOUNDATION ENGINEERING MANUAL 4TH EDITION/2006

ALL LOADS SHOWN ON DRAWINGS ARE UNFACTORED SERVICE LOADS IN KN AND KPA UNLESS OTHERWISE NOTED. DESIGN LOADS: BASED ON 2010 N.B.C. AS NOTED BELOW OR SHOWN ON PLANS.


ALL DESIGN LOADS ARE NOT TO BE EXCEEDED DURING CONSTRUCTION.

LOADS AND EFFECTS

- | | |
|--------------------------------------------------------------------------------------------|----------|
| A) IMPORTANCE CATEGORY (DIV. B, TABLE 4.1.2.1B.) POST DISASTER (SEWAGE TREATMENT FACILITY) | |
| B) DEAD LOADS: | 0.75 KPa |
| ALLOWANCE FOR MECHANICAL AND ELECTRICAL | 0.24 KPa |

MEZZANINE:	
SELF WEIGHT	0.75 KPa
CONCRETE TOPPING 50 mm THICK AVERAGE	1.14 KPa
MISC ELECTRICAL AND MECHANICAL ON UNDERSIDE	0.25 KPa
TOTAL	2.14 KPa

- | | |
|-----------------------------------------------------------------------------|----------|
| C) LIVE LOADS DUE TO USE AND OCCUPANCY (UNLESS CROSSED AND NOTED ON PLANS): | |
| GROUND FLOOR (EXCLUDING TRUCK AREA) | 4.8 KPa |
| EXIT STAIRS AND CORRIDORS | 4.8 KPa |
| MEZZANINE FLOOR | 4.8 KPa |
| TRUCK AREA: | |
| TABLE 4.5.3 (MINIMUM DISTRIBUTED LOAD) | 12.0 KPa |
| TABLE 4.5.10 (MINIMUM CONCENTRATED LOAD) | 54.0 KN |
| IN ADDITION CONSIDERATION HAS BEEN GIVEN FOR THE FOLLOWING VEHICLE: | |
| VAC-CON 3.5 YARD X-230 COMBINATION MACHINE | |
| FRONT AXLE CAPACITY: 10,000 lb (44.5 kN) | |
| REAR AXLE CAPACITY: 17,000 lb (75.6 kN) | |

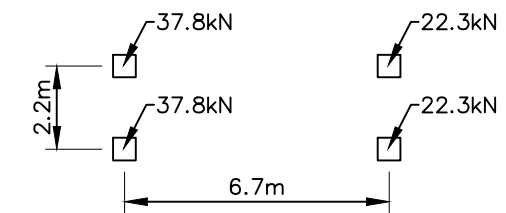

- C.) LOADS DUE TO SNOW, ICE AND RAIN: (POST DISASTER)
 IMPORTANCE FACTOR (Is) (ULS) 1.25 (SLS) .90
 ROOF SPECIFIED SNOW LOAD,
 1/50 GROUND SNOW LOAD (Ss) 3.00 kPa
 1/50 GROUND RAIN LOAD (Sr) .20 kPa
 WIND EXPOSURE FACTOR (Cw) 1.0
 BASIC SNOW LOAD FACTOR (Cb) .8
 (CASE 1): 3.25 kPa
 (CASE 2) UNBALANCED LOADING, FIGURE G-1 NBCC COMMENTARY G): 3.95 kPa

IN ADDITION TO THE BASIC LOADS NOTED, DESIGN RELATED TO THE TRANSMISSION AND SUPPORT OF LOADS FROM THE ROOF SYSTEM MUST CONSIDER THE FOLLOWING:

TRUSS SYSTEMS: THE TRUSS SYSTEM FOR THE EXISTING BUILDING AND PROPOSED ADDITION MUST BE INDEPENDENT. ALLOW FOR FALL PROTECTION LOADS, AND MISC. FRAMING AS NECESSARY TO CREATE ROOF LINES.

- E.) HOIST LOADS:
AS PROVIDED, THE HOIST SYSTEM IS EXPECTED TO EXPERIENCE ONLY ONE OF THE FOLLOWING LOADS @ ANY TIME (UNFACTORED)
MONSTER AUGER: 1480# (6.6kN)
GRINDER: 1250# (5.6kN)
EFFLUENT PUMP MOTOR: 600# (2.7kN)

GENERAL NOTES CONT'D.

- F) LOADS DUE TO WIND: TABLE C-2, DIV. B, 2010 NBCC
IMPORTANCE FACTOR (Iw) (ULS):1.25 (SLS) 0.75
(q) 1/50 HOURLY WIND PRESSURE 0.60 kPa
- G) LOADS DUE TO EARTHQUAKES: TABLE C-2, DIV. B. NBCC 2010
Sa(0.2) = 0.12
Sa(0.5) = 0.056
Sa(1.0) = 0.023
Sa(2.0) = 0.006
- PEAK GROUND ACCELERATION (PGA) 0.059
SITE CLASS: B (ROCK)
Fa = 0.80
Fv = 0.60
Ie = 1.0
IeFaSa (0.2)=0.10
- THE SUPERSTRUCTURE LATERAL RESISTANCE IS BASED UPON A WOOD FRAMED WITH WOOD
BASE PANKING SHEAR WALL SYSTEM. LATERAL LOADS ARE TRANSFERRED TO THE CONCRETE
FOUNDATION THROUGH SHEAR CAPACITY OF ANCHOR BOLTS, AND TRANSFERRED TO THE STEEL
PILE SYSTEM THROUGH SHEAR ANCHORS. (DOWELS)
3. FOUNDATION SYSTEM (LIMIT STATES DESIGN)
(NBC, DIV. B. 4.1.3., 4.2.)
- THE FOUNDATIONS ARE DESIGNED AS ROCK SOCKETED PILES TO BE DRILLED INTO
SOLID ROCK IN ACCORDANCE WITH THE GEOTECHNICAL REPORT AND MEMO NOTED
IN THE GENERAL NOTES.
- FACTORED BEARING RESISTANCE OF PILES MEETING THE RECOMMENDATIONS OF THE GEOTECHNICAL
ENGINEER ARE DESIGNED TO ACHIEVE A BEARING RESISTANCE OF 17,500 kPa OVER THE BASE
OF THE GROUTED PILE.
- FACTORED UPLIFT RESISTANCE OF PILES MEETING THE RECOMMENDATIONS OF THE GEOTECHNICAL
ENGINEER ARE DESIGNED TO ACHIEVE AN UPLIFT RESISTANCE OF 150kPa OVER THE AREA OF CONTACT
WITH THE ROCK.
4. SHOP DRAWINGS

4. SHOP DRAWINGS

1. SUBMIT WHITE PRINTS OF ERECTION PLANS AND SHOP DETAILS OF STRUCTURAL COMPONENTS, FOR REVIEW PRIOR TO FABRICATION. ELECTRONIC VERSIONS WILL BE ACCEPTED IN PDF FILE FORMAT ONLY. REVIEW OF SHOP DRAWINGS IS A PRECAUTION AGAINST OVERSIGHT OR ERROR. IT IS NOT A DETAILED CHECK AND SHALL NOT BE CONSTRUED AS RELIEVING THE CONTRACTOR OF RESPONSIBILITY FOR MAKING THE WORK ACCURATE AND IN CONFORMITY WITH THE CONTRACT DOCUMENTS. MAINTAIN A SET OF REVIEWED DRAWINGS ON SITE. DRAWINGS ARE TO BE SEALED BY A REGISTERED PROFESSIONAL ENGINEER IN THE TERRITORY OF NUNAVUT, FOR THE FOLLOWING SUBMISSIONS: TRUSSES, STRUCTURAL LIGHT STEEL FRAMING, MISC. METALS AND TEMPORARY WORKS.

SUBMISSIONS ARE EXPECTED FOR THE FOLLOWING SPECIFICATION DIVISIONS WHICH DO NOT REQUIRE A SEAL BY A PROFESSIONAL ENGINEER: REINFORCING STEEL FOR CAST IN PLACE CONCRETE AND STRUCTURAL STEEL COMPONENTS .

5. INSPECTION AND TESTING

1. THE ENGINEER AND THE OWNER WILL COORDINATE THE APPOINTMENT AND PAYMENT OF AN INDEPENDENT INSPECTION AND TESTING AGENCY, WHICH IS IN ADDITION TO PERIODIC GENERAL PROJECT REVIEW BY THE ENGINEER. THE COST OF THE INSPECTION SHALL BE PAID BY THE OWNER. WORK WILL BE INSPECTED TO ENSURE CONFORMANCE WITH THE CONTRACT DOCUMENTS. WORK OF THE FOLLOWING DISCIPLINES: CONCRETE, REINFORCED STEEL, STRUCTURAL STEEL, STEEL JOISTS, COLD FORMED STEEL INCLUDING STEEL DECK, LIGHT STEEL FRAMING JOISTS & PRECAST CONCRETE, AND MASONRY REQUIRE INDEPENDENT INSPECTION AND TESTING. WORK SHALL BE SCHEDULED WITH THE CONTRACTOR AND COPIES OF ALL REPORTS FORWARDED TO THE ENGINEER.

FOUNDATION AND STRUCTURAL SLAB

NOTES

1. SEE GENERAL AND CONCRETE NOTES, RELATED DIVISIONS OF THE CONTRACT SPECIFICATIONS AND APPENDED GEOTECHNICAL INFORMATION IN SPECIFICATIONS.
2. THE AREA WITHIN THE BUILDING SHALL BE STRIPPED TO A MINIMUM OF 600MM BELOW FINISHED FLOOR DEPTH. AREAS OF UNSUITABLE FILL OR FROZEN MATERIAL TO BE REMOVED AND REPLACED WITH SUITABLE GRANULAR MATERIAL COMPACTED TO 98% SPGD.
3. AS NOTED ON THE DRAWINGS, ALL CONCRETE IN CONTACT WITH GROUND WILL RECEIVE 100MM OF RIGID INSULATION, FOUNDED ON A GRANULAR 'B' 1300MM WORKING BASE COMPACTED TO 98% SPGD AS A WORKING PAD.
4. REMOVED MATERIAL FROM UNDER THE BUILDING AREA IS NOT TO BE USED WITHIN THE BUILDING AREA, FOR BACKFILLING TRENCHES, OR PITS OR RAISING GRADES OR FOR FILL AGAINST THE BUILDING, UNLESS SPECIFICALLY TESTED AND APPROVED FOR USE BY THE GEOTECHNICAL CONSULTANT.
5. INSTALL HSS PILES AS PER GEOTECHNICAL RECOMMENDATIONS, PLUMB AND TRUE. HSS PILES TO BE EMBEDDED A MINIMUM 2M INTO FRESH ROCK WITH AN ANNULUS OF 50MM MORE THAN SPECIFIED PILE DIAMETER.
6. ANTICIPATED TIMING FOR INSTALLATION IS BETWEEN JANUARY AND APRIL OF THE YEAR TO MAKE USE OF THE ACTIVE LAYER OF MATERIAL BEING FROZEN.
7. INSTALLER TO PROVIDE CASING IN THE EVENT OF POTENTIAL SEQUEL OR SLOUGHING WITHIN THE EXCAVATION. INSTALLER TO CONSIDER THE NEED FOR TREMIE TECHNIQUES FOR GROUT PLACEMENT IF WATER IS FOUND AT THE BASE OF THE EXCAVATION.
8. PLACE NON-SHRINKABLE GROUT SUITABLE FOR THIS USE (SIKA GROUT ARCTIC 100) IN THE SOCKET PORTION OF THE BOREHOLE TO THE TOP OF THE FRESH ROCK ELEVATION IMMEDIATELY AFTER CLEANING THE HOLE.
9. USE CENTRALIZERS DURING PLACEMENT OF THE PILE TO ENSURE CENTERING WITHIN THE BOREHOLE. FILL ANNULAR SPACE AROUND PILE WITH A SAND SLURRY AS PER THE SPECIFICATIONS. THE INTERIOR OF THE PILE WITH DRY DRILL CUTTINGS TO WITHIN 1M OF THE CUTOFF ELEVATION. VERTICAL AXIS OF PLACEMENT MUST BE WITHIN 20MM OF DESIGNED CENTRELINE LOCATION FOR EACH PILE.
10. UPPER 2M OF THE PILES ARE TO BE COATED WITH ARCTIC HEAVY GREASE, THEN WRAPPED WITH TWO LAYERS POLYETHYLENE SHEETS ALSO COATED WITH ARCTIC HEAVY GREASE.
11. PLACE 100MM RIGID INSULATION UNDER ALL PORTIONS OF THE FLOOR SYSTEM; GRADE BEAMS TO BE PLACED WITH MINIMUM 100MM GEOSPAN VOID FORM UNDER THE BEAMS TO PREVENT INFLUENCE FROM POTENTIAL SETTLEMENT OR EXPANSION OF SOILS UNDER THE BEAMS.
12. FOUNDATION DIMENSION, IF SHOWN ON THE STRUCTURAL PLANS, ARE ACTUAL AND ARE TO THE FACE OF FOUNDATION WALLS OR TO THE GRID LINES UNLESS NOTED. REPORT ANY DIMENSIONAL DISCREPANCIES WITH THE ARCHITECTURAL PLANS PRIOR TO PROCEEDING.
13. LOCATIONS OF LAP SPLICES IN GRADE BEAMS MUST BE AS PER PLAN TO ENSURE LOAD TRANSFERENCE.
14. STRUCTURAL SLAB ON GRADE TO BE REINFORCED AS PER PLANS; NOTE THAT THE DIRECTIONS AND PLACEMENT OF THE BARS AS MATS OF STEEL IS CRITICAL TO PROPER TRANSFERENCE OF THE LOADS.

FOUNDATION AND SLAB-ON-GRADE CONT'D.

15. CONCRETE BEAMS TO BE CURED MINIMUM 7 DAYS TO 70% OF CONCRETE STRENGTH PRIOR TO PLACEMENT OF THE SLAB CONCRETE.
16. CONCRETE SLABS TO BE WET CURED FOR A MINIMUM OF 7 DAYS. PROVIDE FINISH AS PER CAST-IN-PLACE CONCRETE NOTES. REFER TO ARCHITECTURAL FOR SPECIAL FINISHES. ALSO REFER TO TYPICAL OR STANDARD DETAIL SHEETS. DO NOT EXCEED MINIMAL WORKMAN LOAD ON SLAB FOR MINIMUM OF 7 DAYS AFTER POUR, ON RECEIPT OF CYLINDER BREAKS SHOWING 70% STRENGTH, 50% OF DESIGN LOAD CAN BE APPLIED TO SLAB. ONCE 28 DAYS FROM POUR AND 100% STRENGTH IS ACHIEVED, FULL LOAD CAN BE APPLIED TO SLAB.
17. PROTECT FOOTINGS, WALLS, SLABS-ON-GRADE AND ADJACENT SOIL AGAINST FREEZING AND FROST ACTION AT ALL TIMES DURING CONSTRUCTION.
17. THE LINE OF SLOPE BETWEEN ADJACENT EXCAVATIONS FOR FOOTINGS OR TRENCHES OR ALONG STEPPED FOOTINGS SHALL NOT EXCEED A RISE OF 7 IN A RUN OF 10. MAXIMUM STEP APPROXIMATELY 600 mm. DO NOT EXCAVATE BELOW THE ELEVATION OF EXISTING FOOTINGS.
18. DO NOT BACKFILL AGAINST WALLS RETAINING EARTH, UNTIL ELEMENTS PROVIDING LATERAL SUPPORT ARE COMPLETED. PLACE BACKFILL SIMULTANEOUSLY ON BOTH SIDES OF OTHER WALLS, OR GRADE BEAMS, BELOW GRADE, WITH A MAXIMUM DIFFERENTIAL OF 600 mm.
19. LOWER INTERIOR WALL, AND CULMUM FOOTINGS WHERE REQUIRED TO SUIT MECHANICAL STORM AND STORM DRAINAGE SYSTEMS AND TO PROVIDE A MINIMUM SLOPE FROM THE UNDERSIDE OF THE ADJACENT FOOTING TO THE BOTTOM OF THE UTILITY EXCAVATION IS 7 VERTICAL TO 10 HORIZONTAL.
20. AN "SD" NOTATION ON THE DRAWING INDICATES THAT THE FOOTING IS TO BE STEPPED DOWN IN THE DIRECTION OF ANY ARROW. AN "SC" NOTATION INDICATES A SAW CUT OR TOOLED JOINT IN THE CONCRETE SLAB. A "CJ" REFERS TO A CONTROL JOINT IN THE MASONRY WALL ABOVE. ALL JOINTS ARE NOT SHOWN ON STRUCTURAL PLANS - COORDINATE REQUIREMENTS WITH THE ARCHITECTURAL DRAWINGS AND SPECS.
21. FOR CONCRETE "HOUSEKEEPING" PADS OR LOCKER BASES, AND ANY OTHER NON-STRUCTURAL CONCRETE PADS, BOLLARDS OR CURBS, REFER TO THE ARCHITECTURAL AND MECHANICAL DRAWINGS FOR COORDINATION.
22. PRIOR TO THE START OF WORK ARRANGE FOR A PROJECT MEETING OF ALL PARTIES ASSOCIATED WITH THE PLACEMENT OF CONCRETE SLABS ON GRADE, PRESIDED BY THE ARCHITECT, WITH THE REPRESENTATIVES OF THE FOLLOWING: THE CONTRACTOR, THE OWNER, CONCRETE SUPPLIER, BACKFILLING AND COMPACTION CONTRACTOR, STRUCTURAL ENGINEER, AND SOIL CONSULTANT. ANY AMBIGUITIES AND DISCREPANCIES IN THIS SECTION SHALL BE REVIEWED TO ENSURE A COMPLETE UNDERSTANDING OF THE REQUIREMENTS AND RESPONSIBILITIES RELATIVE TO THE WORK, MATERIALS AND THEIR HANDLING AND STORAGE, WORK SEQUENCE, QUALITY CONTROL, STAFFING, RESTRICTIONS AND ANY SPECIAL REQUIREMENTS. THE CONTRACTOR SHALL CONDUCT THE CONSTRUCTION SO AS TO FACILITATE COMPLIANCE WITH THE INTENT OF THIS SECTION.

CAST IN PLACE CONCRETE

GENERAL

1. CONFORM TO THE GENERAL REQUIREMENTS AND SPECIAL CONDITIONS CONTAINED IN DIVISION 1 OF THE CONTRACT DOCUMENTS.
2. INCLUDE IN THE WORK OF THIS SECTION ALL CONCRETE INCORPORATED IN THE PROJECT, REFER ALSO TO PRECAST CONCRETE SPECIFICATION, PLAN NOTES, SLAB ON GRADE AND FOUNDATION NOTES, COLUMN, BEAM, WALL, AND SLAB SCHEDULES FOR ADDITIONAL CONCRETE REQUIREMENTS.
3. CONFORM TO CSA - A23.3 SERIES OF STANDARDS, (ACI 318, AND ACI REPORT 350 WHERE APPLICABLE) AND THE RISC MANUAL OF STANDARD PRACTICE (LATEST EDITION) FOR DESIGN, MATERIALS, CONSTRUCTION, CURING, TESTING, TOLERANCES, AND FINISHING OF CONCRETE.
4. INSTALL, OR SUPPLY AND INSTALL, ANCHORAGE, FASTENINGS AND BLOCKING AS REQUIRED, FOR WORK OF OTHER SECTIONS.
5. MATERIALS SHOWN ON THE DRAWINGS OR IN THIS SPECIFICATION ARE TO ESTABLISH THE REQUIRED DEGREE OF QUALITY OR PERFORMANCE. SUBSTITUTION MAY BE PERMITTED UPON PROOF OF EQUIVALENCE. SUBMIT ALL PROPOSALS FOR SUBSTITUTION TO THE CONSULTANT IN WRITING IN ADVANCE OF SHOP DRAWINGS, EACH ITEM SHALL BE CLEARLY IDENTIFIED. DO NOT PROCEED WITH PROPOSAL UNLESS IT IS ACCEPTED IN WRITING BY THE CONSULTANT.
6. SUBMIT BAR LISTS AND PLACING DIAGRAMS TO THE CONSULTANT FOR REVIEW PRIOR TO FABRICATION OF REINFORCING STEEL. DRAW DIAGRAMS TO A SCALE OF NOT LESS THAN 1:50. SHOW ELEVATION, SECTION, WALL, AND MARK NUMBERS ON THE BAR LISTS MUST BE SHOWN ON THE SCALED PLACING DIAGRAMS. SEE THE GENERAL NOTES SECTION FOR SHOP DRAWING REQUIREMENTS.

PRODUCTS

1. MATERIALS:
1. CEMENT GENERAL USE TYPE GU PORTLAND CEMENT TO CSA A3001.
 2. WATER, FINE AGGREGATES, COARSE AGGREGATES: TO CSA-A23.1. MAXIMUM COARSE AGGREGATE, 20 mm DIAMETER UNLESS NOTED FOR FORMED CONCRETE. MAXIMUM COARSE AGGREGATE, 40 mm DIAMETER, FOR LARGE AUGURED PIERs OR JESS CONCRETE.
 3. AIR-ENTRAINING ADMIXTURE: TO ASTM C260.
 4. CHEMICAL ADMIXTURES: TO ASTM C494 AND ASTM C1017.
 5. WATER: WATER FOR CONCRETE. WATER QUALITY PRACTICAL AS APPROVED BY THE ENGINEER. USE A CLEAR LIQUID WATER TO ASTM C-309, TYPE 1. USE SEALTIGHT VOMCO20 BY W.R. MEADOWS OF CANADA LIMITED.
 6. RIGID DISPERSED REINFORCEMENT SPECIFICATION GRADE, STYLE 951 OR 955 BY GREENSTEAK. HYDROPHILIC TYPE WATERSTOP HYDROTITE GUK BY MME MULTIRETHANES.
 7. REINFORCING STEEL: NEW, DEFORMED, BILLET-STEEL BARS TO CSA STANDARD G30.18, GRADE 400R WHERE WELDING BAR BARS IS REQUIRED USE GRADE 400R.
 8. WELDING RODS: NEW MATERIAL SUPPLIED IN FLAT SHEETS, NOT ROLLS, TO CSA G30.5. SIZE AS INDICATED ON PLANS.
 9. PL WOOD FOR FORMWORK: COF EXTERIOR GRADE, TO CSA STANDARD 0121. FOR EXPOSED CONCRETE USE RED WOOD.
 10. SAW-CUT JOINT FILLER: FOR AREAS SUBJECT TO HIGH WHEEL LOADS USE SEMI RIGID EPOXY, FLOURABLE, CONSISTENCY, SUCH AS REZIMELD FLEX BY W.R. MEADOWS. FOR OTHER LOCATIONS USE EPOKALITE TO S.I. BY W.R. MEADOWS OF CANADA.
 11. PREMOULDED JOINT FILLER: CERAMAR FLEXIBLE FOAM BY W.R. MEADOWS.
 12. NON-METALLIC FLOOR SURFACE HARDENER: USE A DRY SHAKE PRODUCT APPLIED IN TWO PASSES (BOKALITE TO S.I. BY W.R. MEADOWS OF CANADA) APPLICATION RATE OF 5-6 kg/ sq. m.
 13. LIQUID DENSIFYING SEALER USE LIQUID- HARD BY W.R. MEADOWS OF CANADA.
 14. ASPHALT IMPREGNATED ISOLATION JOINT MATERIAL MEETING ASTM D 994, FLD. SPEC. HH-F-341 F, 1/2" THICK, 100% SOLIDS BY WEIGHT AND FAA SPEC. ITEM 110-27-27, BY W.R. MEADOWS OF CANADA.
 15. VOID FORMS: GEOSPAN COMPRESSIBLE FILL 50 KPa MAX COMPRESSIVE STRENGTH POLYSTYRENE FOAM BY PLAST-FLAB.
 16. FLOORING: MINIMUM 100mm INSULATION: CLOSED CELL POLYSTYRENE FOAM, STYROFOAM SM, DOW CHEMICAL COMPANY, MINIMUM 30psi COMPRESSIVE STRENGTH.

2. SUPPLY CONCRETE AS PER CSA 2431-09
ALL CONCRETE MIXES CLEARLY IDENTIFY AND CONFIRM THE UNDERSTANDING
OF THE CONCRETE REQUIREMENTS IN WRITING PRIOR TO PRODUCTION FOR ALL MIXES. SUCH A
SUBMISSION SHALL INCLUDE, AS A MINIMUM; THE LOCATION OF EACH MIX DESIGN TO BE USED IN
THE STRUCTURE, THE CEMENT TYPE, ALL SUPPLEMENTARY MATERIALS, CLASS OF EXPOSURE,
COMPRESSIVE STRENGTHS, AGGREGATE SIZE, AND CONCRETE DENSITY.

USE READY MIXED CONCRETE TO MEET MINIMUM 28-DAY COMPRESSIVE STRENGTH OF 25 MPa, (EXCEPT MIXINGS AS NOTED BELOW). USE A WATER-REDUCING CHEMICAL ADMIXTURE FOR ALL CONCRETE. USE AN AIR ENTRAINING ADMIXTURE TO GIVE TOTAL AIR CONTENT CONFORMING TO TABLE 2 AND 4 OF A23.1 09 TO MATCH REQUIRED CONCRETE CLASSIFICATIONS. WATER-CEMENT RATIO SHALL CONFORM TO TABLE 2 OF A23.1 09 UNLESS NOTED OTHERWISE. COORDINATE WITH THE GENERAL CONTRACTOR (AND STEEL FIBRE SUPPLIER AS APPLICABLE) WITH RESPECT TO WORKABILITY ISSUES, AND CONFIRM THE CRITERIA IN THE SUBMISSION (SLUMP, PUMP MIX, DESIGN CONCRETE TEMPERATURE, ETC.).

EXPOSURE CLASS	USE	STRENGTH	W/C RATIO	AIR	MAX AGGREGATE SIZE (mm)	CEMENT CONTENT	(kg/m ³)
—	LEAN MIX OR "UNSHRINKABLE FILL	= 0.4 TO 0.7 MPa	AS REQ'D	—	19	AS REQ'D	AS REQ'D
N	SKIM COATS	= 15 MPa	0.7	—	19	255	80± 25mm
F-1	GRADE BEAMS	= 25 MPa	0.52	5% to 8%	19	340	80± 25mm
N	STRUCTURAL SLABS	= 25 MPa	0.52	5% to 8%	19	340	80± 25mm
F-1	SLABS-ON-GRADE — WALKWAYS — EXTERIOR	= 32 MPa	0.40	5% to 8%	19	355	80± 25mm

CAST IN PLACE CONCRETE CONT'D.

EXECUTION

3. NOTIFY THE ENGINEER 5 WORKING DAYS IN ADVANCE OF PLACING CONCRETE TO PERMIT VIEWING OF REINFORCEMENT AND PLACING OF CONCRETE. ALSO COORDINATE SCHEDULES WITH THE INDEPENDENT INSPECTION AND TESTING COMPANY. DO NOT CLOSE FORMS UNTIL THE REINFORCEMENT HAS BEEN REVIEWED.
2. USE VIBRATORS FOR CONSOLIDATION OF CONCRETE. DO NOT PLACE CONCRETE FOR EXPOSED SLABS IN THE RAIN.
3. USE PLASTIC OR CONCRETE BAR SUPPORTS IN EXPOSED LOCATIONS AND PARKING AREAS. USE CONCRETE BAR SUPPORTS FOR STEEL ABOVE SOFT VOID FORM FILLER MATERIAL. IN OTHER LOCATIONS PROVIDE STEEL CHAIRS OR CONCRETE SPACERS TO MAINTAIN SPECIFIED COVER TO REINFORCING STEEL. UNLESS OTHERWISE NOTED, INTERIOR AREAS 25 mm COVER, EXTERIOR AREAS 40 mm COVER, UNFORMED SURFACES EXPOSED TO SOIL PROVIDE 75 mm COVER.
4. EXPOSED CONCRETE SHALL BE FREE FROM HONEYCOMBING, VOIDS, LOSS OF FINES, VISIBLE FLOW LINES AND COLD JOINTS, CHIPS AND SPALLS. EXPOSED CONCRETE SHALL BE RUBBER SMOOTH USING WATER AND CARBORUNDUM BRICK. PATCH DEFECTS AND THE HOLES. REMOVE FINIS. ALSO REFER TO ARCHITECTURAL SPECIFICATIONS.
5. PLACE 19 mm MINIMUM BEVELS OR CHAMFERS AT ALL EXPOSED CORNERS.
6. MAXIMUM DISTANCE BETWEEN CONSTRUCTION JOINTS ARE:
 1. WALLS AND FRAMED SLABS: 9m, or 18m ALTERNATING WITH CONTROL JOINTS AT SAME SPACING
 2. SLABS—ON—GRADE: 6m, or 18m WITH 5 mm WIDE X ¼ OF SLAB DEPTH (SAW—CUT JOINTS) (T JOINTS) AT 6m CENTRES. FOR SLABS LESS THAN OR EQUAL TO 125 mm THICK REDUCE CONTROL JOINT SPACING TO 4.5m ON CENTRE. ALSO SEE PLANS.
7. LEAVE CHASES AND POCKETS IN WALLS FOR SEATING OF SLABS AND BEAMS.
8. REINFORCE ALL SIDES OF OPENINGS IN CONCRETE WALLS. LENGTH OF BARS EQUAL TO OPENING DIMENSION PLUS 600 mm EACH SIDE. USE 2 — 15M FOR WALL THICKNESS UP TO 200 mm, 2 — 20M FOR WALLS OVER 200 mm UNLESS NOTED. REFER ALSO TO THE STANDARD OR TYPICAL DETAIL SHEETS.
9. UNLESS OTHERWISE SPECIFIED ON THE PLANS, PROVIDE TEMPERATURE REINFORCING FOR FRAMED ONE-WAY SLABS IN ACCORDANCE WITH THE TYPICAL OR STANDARD DETAIL SHEETS.
10. LAP ALL REINFORCING WITH CLASS 'B' SPECIES U/N. ALL STEEL MUST BE ADEQUATELY TIED AND ACCURATELY PLACED PRIOR TO THE COMMENCEMENT OF ANY CONCRETE POUR.
11. PROVIDE CONTINUOUS GALVANIZED VERTICAL DOVETAIL ANCHOR SLOTS AT 600 IN ALL CONCRETE SURFACES WITH BRICK OR STONE VENEER FINISHES AND AT ADJUTING MASONRY WALLS.
12. PROVIDE WATERPROTS IN ALL CONSTRUCTION JOINTS BELOW GRADE (EXCEPT WHERE BACKFILLED BOTH SIDES) UNLESS NOTED OTHERWISE.
13. COORDINATE HOUSE KEEPING PADS, SUMP PITS, LIGHT POLE FOUNDATIONS AND CONDUIT ENCASEMENT WITH THE MECHANICAL, ELECTRICAL AND SITE PLAN DRAWINGS. COORDINATE SLEEVES THROUGH OR UNDER WALLS WITH THE DRAWINGS WHICH SHOW THE APPLICABLE UTILITIES AND PIPING.
14. ELECTRICAL CONDUIT AND PIPING TO BE CAST IN CONCRETE STRUCTURES ARE TO BE COORDINATED WITH THIS OFFICE. NO HORIZONTAL RUNNING CONDUIT IS ALLOWED WITHIN THE WALLS, UNLESS SPECIFIC LOCATIONS ARE APPROVED BY THE ENGINEER.
15. SURFACE FINISHING — PROVIDE FINAL FINISH IN ACCORDANCE WITH PROPOSED USE.

REFER TO ARCHITECTURAL ROOM SCHEDULE:

SKIN COATS, PITS:	SCREEDED AND BULL FLOATED
BASE SLAB FOR TERRAZZO, TILE OR BONDED TOPPING:	SCREEDED, BULL FLOATED AND SCORED WITH WIRE BRUSH
FLOORS WHICH RECEIVE RESILIENT FLOOR OR CARPET, FUTURE FLOORS:	POWERED STEEL TROWEL
INTERIOR EXPOSED SLABS:	POWERED STEEL TROWEL WITH NON-SLIP SWIRLS
EXTERIOR EXPOSED SLABS:	WOOD FLOAT FINISH WITH BROOMING

STAIRS: PROVIDE A SLIP RESISTANT STEEL TROWEL FINISH TO EXPOSED CONCRETE STAIR TREADS AND LANDINGS. (INSTALL CARBORUNDUM STRIPS AT EDGES OF TREADS AND LANDINGS IF SHOWN ON THE DRAWINGS).

16. CONSTRUCT MEMBERS ACCURATELY AND IN ACCORDANCE WITH THE TOLERANCE LIMITS AS SPECIFIED IN CSA A23.1, AND OTHER THEREIN REFERENCED SECTIONS FOR SURFACE TOLERANCES, REINFORCEMENT AND HARDWARE PLACEMENT. REFER TO ARCHITECTURAL PLANS FOR FINISHED DIMENSIONS.
17. COMPLETE FORMWORK IN ACCORDANCE WITH CSA A23.1. SUBMIT COPIES OF ENGINEERED FALSEWORK SHOP DRAWINGS AT LEAST 2 WEEKS IN ADVANCE OF SCHEDULED POUR DATES. ALL FORMWORK CONSTRUCTION AND ALIGNMENT IS TO BE CHECKED PRIOR TO THE COMMENCEMENT OF THE PLACEMENT OF REINFORCING STEEL. FINAL ADJUSTMENTS SHALL BE MADE AFTER ALL STEEL AND HARDWARE PLACEMENT IS COMPLETE.
18. COORDINATE PLACEMENT OF HARDWARE, PIPES AND CONDUIT WITH OTHER TRADES AND THE REINFORCING STEEL PLACEMENT, AND SET IN ACCORDANCE WITH APPROVED PLACING DRAWINGS. CONTACT THE CONSULTANT PRIOR TO THE SCHEDULED POUR DATE IF THERE ARE CONCERNS OR UNCERTAINTIES WITH RESPECT TO THE SIZES, TYPE OR LOCATION OF PLANNED CAST IN MATERIALS.
19. PROTECT FRESH CONCRETE FROM PREMATURE DRYING, SUNSHINE, EXCESSIVELY HOT OR COLD TEMPERATURES AND MECHANICAL INJURY. MAINTAIN AT A RELATIVELY CONSTANT TEMPERATURE FOR AS LONG AS IS REQUIRED FOR HYDRATION OF THE CEMENT AND CURING OF THE CONCRETE. REFER TO CSA A23.1 FOR HOT AND COLD WEATHER CONCRETING PRACTICES. PROVIDE AN OUTLINE OF PROPOSED PROCEDURES AND EQUIPMENT TO THE CONSULTANT PRIOR TO FORMING CONCRETE.
20. PROTECT FRESH CONCRETE FROM COLD TEMPERATURES BELOW 5 DEGREES CELSIUS. PROVIDE TEMPORARY HEAT FOR A MINIMUM OF 3 DAYS TO MAINTAIN A TEMPERATURE OF GREATER THAN 15 DEGREES CELSIUS.
21. WET CURE SLABS FOR 7 DAYS WHEN TEMPERATURES ARE ABOVE FREEZING, OTHERWISE APPLY CURING SEALING COMPOUND. PROVIDE FLOOR SURFACE HARDENER WHERE SPECIFIED AS PER MANUFACTURER'S INSTRUCTIONS.
22. FOR STRUCTURAL SLABS AND BEAMS, MAINTAIN SHORING/RESHORING IN PLACE UNTIL THE CONCRETE HAS REACHED 75% OF THE SPECIFIED DESIGN STRENGTH, 7 DAYS MINIMUM UNLESS NOTED.
23. ALL FOUNDATION INSULATION TO BE PLACED IN ACCORDANCE WITH MANUFACTURER'S INSTRUCTIONS. THAT TOTAL THICKNESS GREATER THAN 50 mm, USE SHEETS WITH A MAXIMUM THICKNESS OF 50 mm AND INSTALL SUCH THAT ALL JOINTS ARE STAGGERED BY AT LEAST 300 mm. PLACE ON SMOOTHERS AND EVEN STRETCH AND PROTECT AGAINST DAMAGE. SEE ARCHITECTURAL SPECIFICATIONS FOR FINISHES AND COORDINATION WITH OTHER NON STRUCTURAL ELEMENTS.

24. INDEPENDENT INSPECTION AND TESTING: THE GENERAL CONTRACTOR AND OWNER WILL COORDINATE THE APPOINTMENT AND COST OF AN INDEPENDENT INSPECTION AND TESTING AGENCY TO UNDERTAKE CONCRETE TESTS. THE COST OF TESTING SHALL BE AS AGREED BY THE GENERAL CONTRACTOR AND OWNER. LABORATORY CURING AND TESTING OF SAMPLES, AND FREQUENCY OF TESTING, WILL BE CARRIED OUT IN ACCORDANCE WITH CSA STANDARDS A23.1AND A23.2 AND TO THE SATISFACTION OF THE ENGINEER. THE CONTRACTOR IS TO COORDINATE SCHEDULES WITH THE TESTING COMPANY.

1. This drawing is the exclusive property of Nuna Burnside and the reproduction of any part without prior written consent of this office is strictly prohibited. 2. The contractor shall verify all dimensions, levels, and datums on site and report any discrepancies or omissions to this office prior to construction. 3. This drawing is to be read and understood in conjunction with all other plans and documents applicable to this project. 4. Do not scale the drawings.	Issue / Revision	Date	AS-BUILT DRAWING AS-BUILT INFORMATION PROVIDED BY THE GENERAL CONTRACTOR: KUDLIK CONSTRUCTION LTD. IQALUIT, NUNAVUT	<div>ORIGINAL STAMPED BY C. W. JONES 04/22/13</div>	<div>BURNSIDE Nuna Burnside Engineering & Environmental LTD. 106B Scurfield Blvd., Winnipeg, Manitoba telephone (204) 949-7110 fax (204) 949-7111 web www.neeganburnside.com</div>	Client GOVERNMENT OF NUNAVUT COMMUNITY & GOVERNMENT SERVICES RANKIN INLET SEWAGE TREATMENT PLANT	Drawing Title STRUCTURAL GENERAL REQUIREMENTS	Drawn By W. WHITEDUCK	Checked By C. JONES	Drawing No. S6				
	1	ISSUED FOR 66% SUBMISSION						NOVEMBER 2012						
	2	ISSUED FOR 99 SUBMISSION						JANUARY 2013						
	3	ISSUED FOR TENDER						FEBRUARY 2013						
	4	REVISED AS PER ADDENDUM 1 TO 4 AND ISSUED FOR CONSTRUCTION						APRIL 2013						
	5	AS-BUILT						AUGUST 2015						

STRUCTURAL STEEL
GENERAL

- CONFORM TO THE GENERAL REQUIREMENTS AND SPECIAL CONDITIONS CONTAINED IN (DIVISION 1) AND GENERAL NOTES. FOLLOW CISC CODE OF STANDARD PRACTICE FOR STRUCTURAL STEEL, UNLESS PROJECT SPECIFICATIONS ARE MORE STRINGENT. THESE NOTES RELATE TO THE ITEMS DESIGNED BY NUNA BURNSIDE.
 - CONFORM TO CSA STANDARDS CSA-S16, CSA-S136, W47.1, W48.1, W48.1, W55.3, W59 AND CSA G40.20 LATEST EDITIONS.
 - MATERIALS SHOWN ON THE DRAWINGS OR IN THIS SPECIFICATION ARE TO ESTABLISH THE REQUIRED DEGREE OF QUALITY OR PERFORMANCE. SUBSTITUTION MAY BE PERMITTED UPON PROOF OF EQUIVALENCE. SUBMIT ALL PROPOSALS FOR SUBSTITUTION TO THE CONSULTANT IN WRITING IN ADVANCE OF SHOP DRAWINGS. EACH ITEM WILL BE CLEARLY IDENTIFIED. DO NOT PROCEED WITH PROPOSAL UNLESS IT IS ACCEPTED IN WRITING BY THE CONSULTANT.
 - TOLERANCES: FABRICATION AND ERECTION TOLERANCES SHALL MEET THE REQUIREMENTS OF CSA STANDARD S16.
 - DEFLECTION REQUIREMENTS: TOTAL DEFLECTION NOT TO EXCEED 1/180 OF THE SPAN, LIVE LOAD DEFLECTION TO 1/360 OF THE SPAN, EXCEPT WHERE SUPPORTING MASONRY INCREASE STIFFNESS TO 1/720 OF THE SPAN.
 - WORK SHALL BE CARRIED OUT BY A MEMBER OF THE CANADIAN INSTITUTE OF STEEL CONSTRUCTION. WELDING SHALL BE PERFORMED BY FIRMS FULLY APPROVED BY THE CANADIAN WELDING BUREAU UNDER THE REQUIREMENTS OF CSA STANDARD W47.1. SUBMIT VERIFICATION DOCUMENTATION BEFORE COMMENCING WORK.
 - DESIGN CONNECTIONS TO CONFORM TO CSA-S16 AND THE CISC HANDBOOK OF STEEL CONSTRUCTION, USING STANDARDIZED CONNECTIONS WHERE POSSIBLE. UNLESS A SPECIFIC FACTORED CONNECTION LOAD IS SHOWN ON THE PLANS, PROVIDE CONNECTION CAPACITIES AS FOLLOWS:

FOR STANDARD BEAM SHEAR CONNECTIONS, DESIGN FOR A SERVICE CAPACITY IN kN EQUAL TO THE BEAM DEPTH IN MM MULTIPLIED BY .5.

DESIGN ALL SPLICES AND CONNECTIONS OF TENSION OR COMPRESSION MEMBERS FOR THEIR FULL CAPACITY, UNLESS FACTORED CONNECTION LOADS ARE SHOWN.

THE MINIMUM WELD SIZE SHALL BE A 5 mm FILLET WELD, AND WHERE INTERMITTENT, 40 mm LONG MINIMUM.
- ARRANGE AND PAY FOR NON-DESTRUCTIVE TESTING OF ALL UNSPECIFIED SPLICES IN COLUMNS, BEAMS AND JOIST COMPONENTS. ALL CONNECTIONS AND DETAILS SHALL BE DESIGNED BY A QUALIFIED REGISTERED PROFESSIONAL ENGINEER LICENSED TO PRACTICE IN NUNAVUT, WHOSE STAMP AND SIGNATURE SHALL BE ON THE SHOP DRAWINGS. AN EXCEPTION IS FOR MISCELLANEOUS STEEL ITEMS WHERE CONNECTIONS ARE DETAILED ON THESE DRAWINGS.
- DESIGN AND PROVIDE BEARING PLATES FOR A MAXIMUM PRESSURE OF 3.5 MPa ON ENGINEERED MASONRY AND 10 MPa ON CONCRETE, BASED ON FACTORED LOADS USING LIMIT STATES DESIGN.
 - SEE GENERAL NOTES SECTION FOR SHOP DRAWING SUBMISSION REQUIREMENTS IN ADDITION TO NOTES ABOVE.
 - VISIT THE SITE TO CONFIRM CONDITIONS AFFECTING THE WORK.

PRODUCTS

- MATERIALS: STRUCTURAL STEEL MATERIALS SHALL CONFORM TO THE FOLLOWING CSA STANDARDS CAN/CSA G40.21 GRADE 350W FOR ALL WIDE FLANGE & HSS SECTIONS, ASTM A500 FOR HSS, 300W FOR ALL OTHER MATERIALS. FOR EXISTING STEEL ON SITE THAT IS BEING MODIFIED OR CONNECTED TO NEW WORK, BASE CONNECTION DESIGNS ON EXISTING GRADES OF CSA G40.21 GRADE 300 W MATERIAL, UNLESS OTHERWISE NOTED.

STEEL JOISTS: CAN/CSA G40.21 Grade 300W and CAN/CSA-S136.
COLD FORMED SHAPES: CAN/CSA S136, minimum thickness 1.2mm.
HIGH STRENGTH BOLTS: to ASTM A325.
ANCHOR RODS: to CAN/CSA Standard G40.21 Grade 300W
TIE RODS: to CAN/CSA Standard G40.21 Grade 300W.
PRIMER PAINT: to CISC/CPMA specification 2.75.
ZINC-RICH SHOP PRIMER PAINT: to CGSB 1.6P-181M.
HOT DIP GALVANIZING: to CSA G164 minimum 610 g/m² coating thickness.
STEEL GRATING: STEEL BARS TO ASTM A1011/A1011M
COMMERCIAL STEEL (TYPE 2) CROSS RODS ASTM A510.
STOVER GRADE C AUTOMATION LOCKNUTS WHERE LOCKNUTS SPECIFIED, OTHERWISE ASTM A325.

- FABRICATION SHALL CONFORM TO CSA STANDARDS CSA-S16, W59 AND W55.3.
- ALL STEEL TO BE CLEANED AND SHOP PRIMED UNLESS NOTED. OMIT PRIMER WHERE SURFACES ARE TO BE COVERED WITH A SPRAYED ON FIRE PROOFING PRODUCT, OR WHERE SURFACES ARE TO BE FIELD WELDED, OR ENCASED IN CONCRETE.
- SHELF ANGLES, HANGERS AND LINTELS IN EXTERIOR WALLS AND EXPOSED EXTERIOR STEEL MEMBERS SHALL BE COMMERCIAL BLAST (MECHANICALLY) CLEANED TO SSPC-SP6. ALL "MILL COATINGS" MUST BE REMOVED BY THE STEEL FABRICATOR. FOR EXTERIOR AND EXPOSED EXTERIOR STEEL THE FINISH IS TO BE HOT DIPPED GALVANIZED. FOR INTERIOR STEEL THE FINISH IS AS PER THE ARCHITECTURAL REQUIREMENTS. REFER TO ARCHITECTURAL SPECIFICATIONS FOR SURFACE PREPARATION OF GALVANIZED MATERIALS PRIOR TO APPLICATION OF FINISHED PAINTING.

EXECUTION

- STORE MATERIALS TO PREVENT DAMAGE AND DISTORTION.
- CHECK SITE CONDITIONS PRIOR TO THE COMMENCEMENT OF STEEL ERECTION, TO ENSURE THAT SUPPORTING CONDITIONS ARE WITHIN SATISFACTORY TOLERANCES (BASE PLATE AND ANCHOR ROD POSITIONS). BRING ALL NON-COMFORMING CONDITIONS TO THE ATTENTION OF THE GENERAL CONTRACTOR FOR RECTIFICATION.
- ERECTION SHALL BE CARRIED OUT BY FORCES OF THE STEEL FABRICATOR. PROVIDE ALL TEMPORARY BRACING TO KEEP THE STRUCTURE STABLE UNTIL THE ENTIRE STRUCTURE IS COMPLETE. PROTECT ALL EXISTING BUILDING COMPONENTS FROM DAMAGE. MAINTAIN SAFE WORKING PRACTICES.
- WHERE MISCELLANEOUS STEEL ITEMS ARE INSTALLED BY OTHERS, SUCH AS BENCH BRACKETS, RAILINGS, STAIRS, PROVIDE ERECTION AND COORDINATION DRAWINGS TO OTHERS IN SUFFICIENT TIME TO ALLOW SETTING OF HARDWARE.
- PROVIDE CONTINUOUS WELDING AT ARCHITECTURALLY EXPOSED JOINTS SUCH AS DOORJAMBS AND HEADS, AND GRIND SMOOTH. REFER ALSO TO ARCHITECTURAL REQUIREMENTS.
- PROVIDE FRAMING FOR ALL OPENINGS IN METAL DECK GREATER THAN 450 MM SQUARE.
- ANCHOR ROOF MEMBERS TO SUPPORTING WALL WITH MINIMUM TWO ANCHOR BOLTS 16 mm DIA. X 400 mm LONG + 50 mm END HOOKS. SET PLATE 25 mm BACK FROM EDGE OF WALL.
- BASE PLATES SUPPORTED DIRECTLY ON GROUT ARE PREFERRED. LEVELING PLATES MAY BE USED, HOWEVER, LARGE LEVELING PLATES CAN ONLY BE USED WHERE THE FABRICATOR PROVIDES DETAILS TO ENSURE THAT THERE ARE NO VOIDS BENEATH THE PLATE, AND DETAILS HOW GAPS BETWEEN THE LEVELING PLATE AND BASE PLATE WILL BE ACCOUNTED FOR/REMEDIED.
- DO NOT MODIFY ANY MEMBERS IN THE FIELD UNLESS CHANGES ARE APPROVED BY THE ENGINEER. THE STEEL SUPPLIER IS TO ISSUE ENGINEERED SKETCHES AS REQUIRED.
- WHERE STEEL GRATING IS REQUIRED, PROVIDE LOCAL BANDING IF BEARING BARS ARE NOTCHED OUT AROUND SUPPORTS AND WHERE BANDING IS CALLED FOR ON PLAN. FASTEN USING GRATEFAST LG037 FASTENER (BY UNISTRUT), 3 PER SHEET AT EACH BEARING LOCATION, SCREW LENGTH TO SUIT GRATING DEPTH.
- FIELD TOUCH UP ALL DAMAGED SURFACES AFTER ERECTION.
- WHEN EVER ITEMS ARE TO BE HUNG FROM OWSJ OR TRUSSES, SECUREMENT SHALL BE FROM THE TOP CHORDS AT PANEL POINTS UNLESS OTHERWISE PERMITTED. ENSURE THAT HANGING LOADS HAVE BEEN ACCOUNTED FOR IN THE DESIGN ALLOWANCE. IF IN DOUBT, CONTACT THE ENGINEER FOR APPROVAL.

STRUCTURAL STEEL CONT'D.
GENERAL

- INDEPENDENT INSPECTION AND TESTING: THE GENERAL CONTRACTOR IN CONSULTATION WITH THE CONSULTANTS WILL APPOINT AN INDEPENDENT INSPECTION AND TESTING AGENCY, CERTIFIED BY THE CANADIAN WELDING BUREAU TO CSA STANDARD W178-1973. THE COST OF INSPECTION SHALL BE COORDINATED BETWEEN THE GENERAL CONTRACTOR AND OWNER. WORK WILL BE INSPECTED IN THE SHOP AND WHEN ERECTED TO DETERMINE CONFORMANCE TO THE DRAWINGS AND SPECIFICATIONS. SEE ALSO THE GENERAL NOTES.
- THE STEEL ERECTOR IS TO RECTIFY DEFICIENCIES NOTED IN ANY INSPECTION REPORTS AS SOON AS POSSIBLE AFTER NOTIFICATION, AND PRIOR TO THE COMMENCEMENT OF WORK OF OTHER TRADES, WHOSE WORK DEPENDS UPON THE INSTALLATION OF THE STRUCTURAL STEEL.
- THE STEEL FABRICATOR IS TO PROVIDE THEIR OWN QUALITY CONTROL MEASURES AND NOT RELY SOLELY ON THE INDEPENDENT INSPECTION REPORTS PROVIDED BY THE OWNER AND GENERAL CONTRACTOR.

WOOD

GENERAL

- CONFORM TO THE GENERAL REQUIREMENTS AND SPECIAL CONDITIONS CONTAINED IN DIVISION 1 AND RELATED SECTIONS OF THE CONTRACT SPECIFICATIONS.
- WHERE OTHERWISE NOT SHOWN ON THE PLANS, MINIMUM CONSTRUCTION IS TO BE IN ACCORDANCE WITH SECTION 9.23 OF THE NBCC FOR WOOD FRAME CONSTRUCTION.

PRODUCTS


- ALL LUMBER TO BE SPF No. 1/2 UNLESS OTHERWISE NOTED.
- LOAD BEARING COLUMNS OF 89x89 OR LARGER DIMENSION MUST BE SPF No. 1 MATERIAL.
- ALL FRAMING LUMBER SHALL CONFORM TO THE REQUIREMENTS OF THE STANDARD GRADING RULES FOR CANADIAN LUMBER OF NATIONAL LUMBER GRADES AUTHORITY (NLGA)
- PRE-ENGINEERED LUMBER INCLUDING WOOD I JOIST SYSTEM TO BE SUBMITTED FOR REVIEW PRIOR TO DELIVERY; ENSURE ALL DESIGNS ARE SEALED BY AN ENGINEER LICENSED IN NUNAVUT; MATERIAL TO BE WEYERHOUSE OR EQUIVALENT.

EXECUTION

- ENGINEER TO UNDERTAKE A FRAMING REVIEW PRIOR TO ENCLOSING OF WALLS; NOTIFY ENGINEER AT START OF CONSTRUCTION AND SCHEDULE REVIEW APPROPRIATELY.
- PROVIDE NUMBER OF PLIES AS INDICATED ON DRAWINGS.
- PLIES OF BUILT UP BEAMS AND COLUMNS SHALL BE SECURED TOGETHER AS PER THE REQUIREMENTS OF 9.23 OF THE NBCC.
- ALL WOOD EXPOSED TO SOIL, CONCRETE OR NOTED ON THE DRAWINGS AS "PT" IS TO BE PRESSURE TREATED. CUT ENDS TO HAVE APPROVED TREATMENT PAINT APPLIED.
- ENSURE FASTENERS AND METAL CONNECTORS IN CONTACT WITH TREATED WOOD PRODUCTS ARE PROTECTED SUFFICIENTLY TO RESIST THE CORROSIVE PROPERTIES OF THE PRESERVATIVE MATERIALS BEING USED. USE HOT DIP GALVANIZED (MINIMUM ZINC COATING OF 600 g/m²) OR STAINLESS STEEL (TYPES 304 OR 316) FASTENERS AND CONNECTORS IN THESE APPLICATIONS.
- ALL PRE-ENGINEERED WOOD ROOF TRUSSES MUST BE DESIGNED FOR THE LOADS NOTED AS A MINIMUM. PROVIDE BRIDGING AND BRACING AS PER FINAL REVIEWED SHOP DRAWINGS.
- PROVIDE UPLIFT CLIPS OR APPROVED ANCHORAGE DEVICES AT THE SUPPORTING WALLS OF ALL TRUSSES, JOISTS, RAFTERS, ETC. THAT HAVE UPLIFT REACTIONS.
- FRAMED WALLS SHALL BE ANCHORED TO THE FOUNDATION WITH A MINIMUM OF 12.7MM ANCHORS AT 1200MM C/C UNLESS OTHERWISE NOTED.

PILES

- REFER TO DRAWINGS, FOUNDATION AND STRUCTURAL SLAB NOTES AND APPENDICED GEOTECHNICAL REPORT FOR RECOMMENDATIONS ON PILE INSTALLATION.
- MATERIAL FOR PILES TO BE NEW HSS SHAPES CONFORMING TO CAN/CSA - G400.21 GRADE 350 W (50ksi) MATERIAL.
- PILE CAP STEEL PLATES TO BE IN ACCORDANCE WITH CAN/CSA - G40.21 GRADE 300 W (43ksi) MATERIAL.

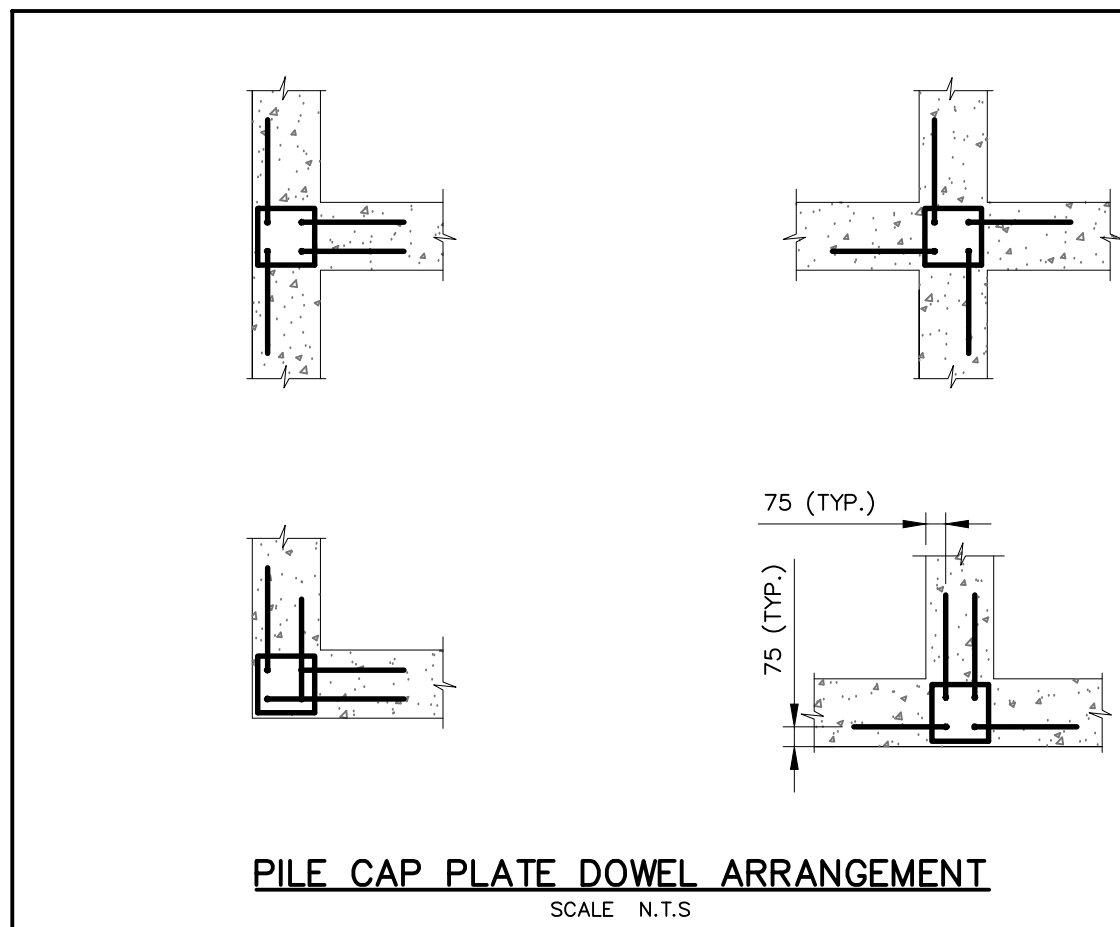



06 17
BRACING OF
SHOP FABRICATED WOOD TRUSSES

2012/06/04

2 of 3


3. DIAGONAL WEB BRACING:

- SPACE 5m o.c. ACROSS BUILDING WIDTH, UNLESS CLOSER SPACING SHOWN ON TRUSS SHOP DWGS.
- BRACING SHOWN BASED ON CUMULATIVE FORCE OF 1% OF COMPRESSION LOAD IN WEB MEMBERS. VERIFY WITH SHOP DRAWINGS.

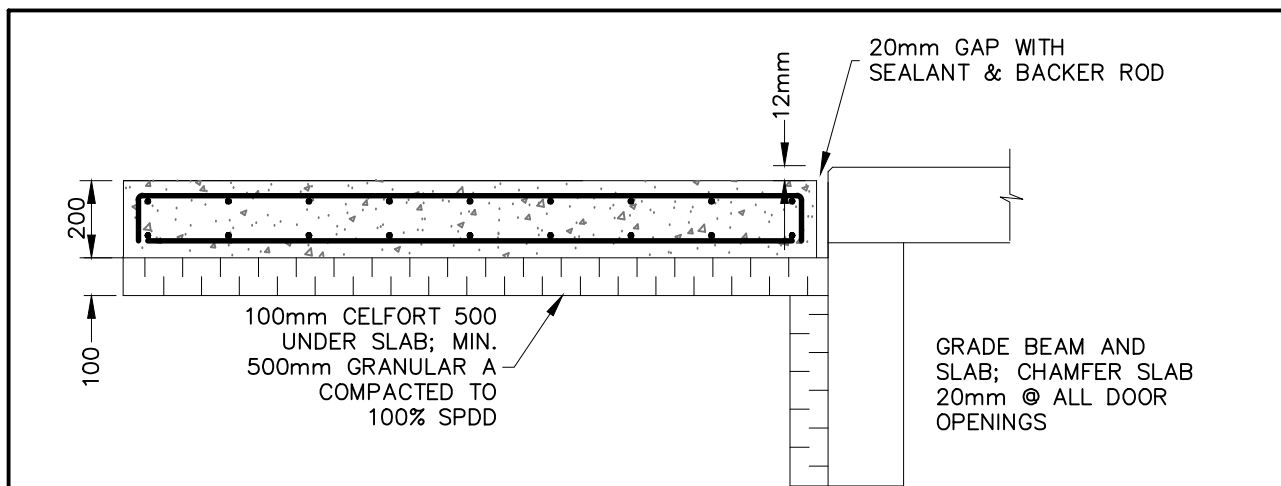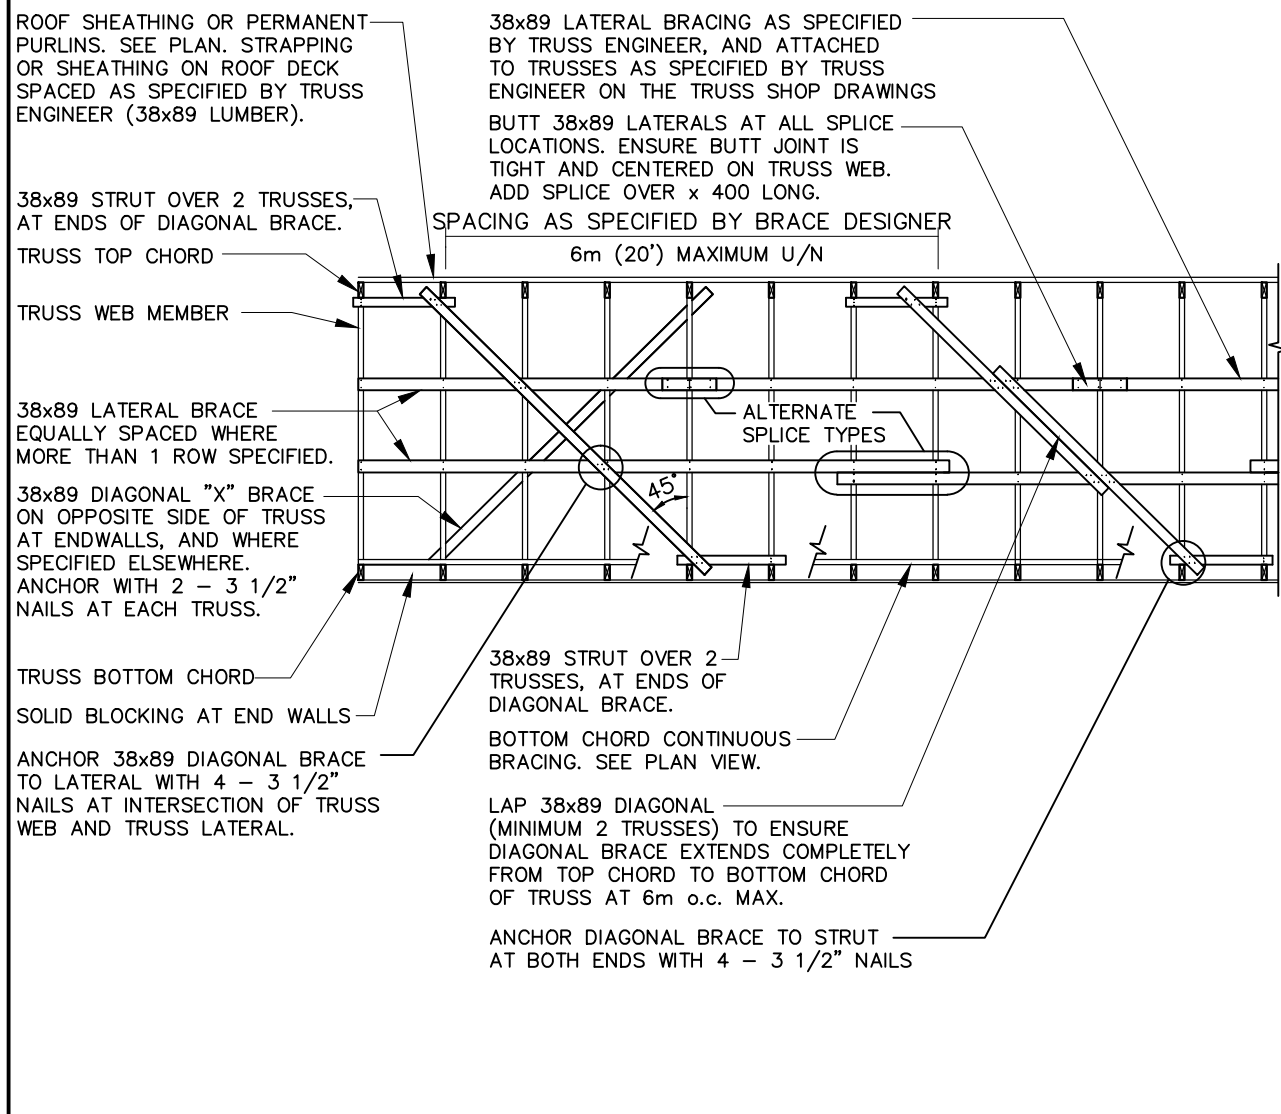


EXTERIOR APPROACH PAD (TYPICAL)

SCALE N.T.S.

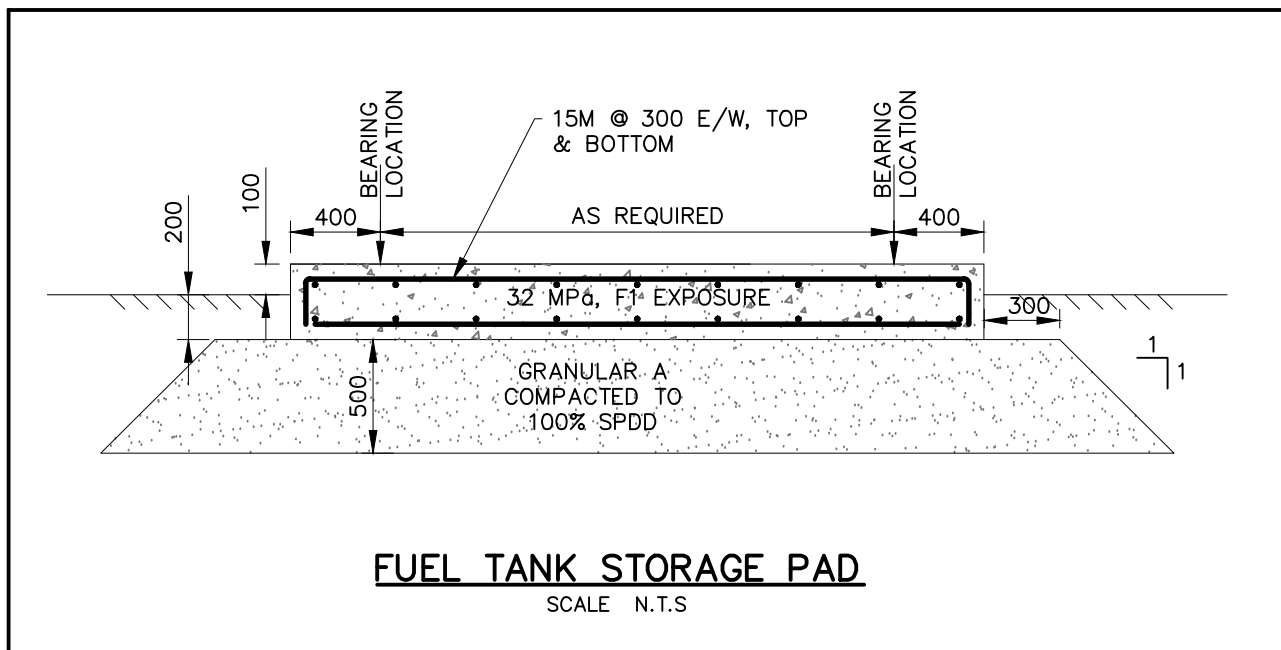

FUEL TANK STORAGE PAD

SCALE N.T.S.

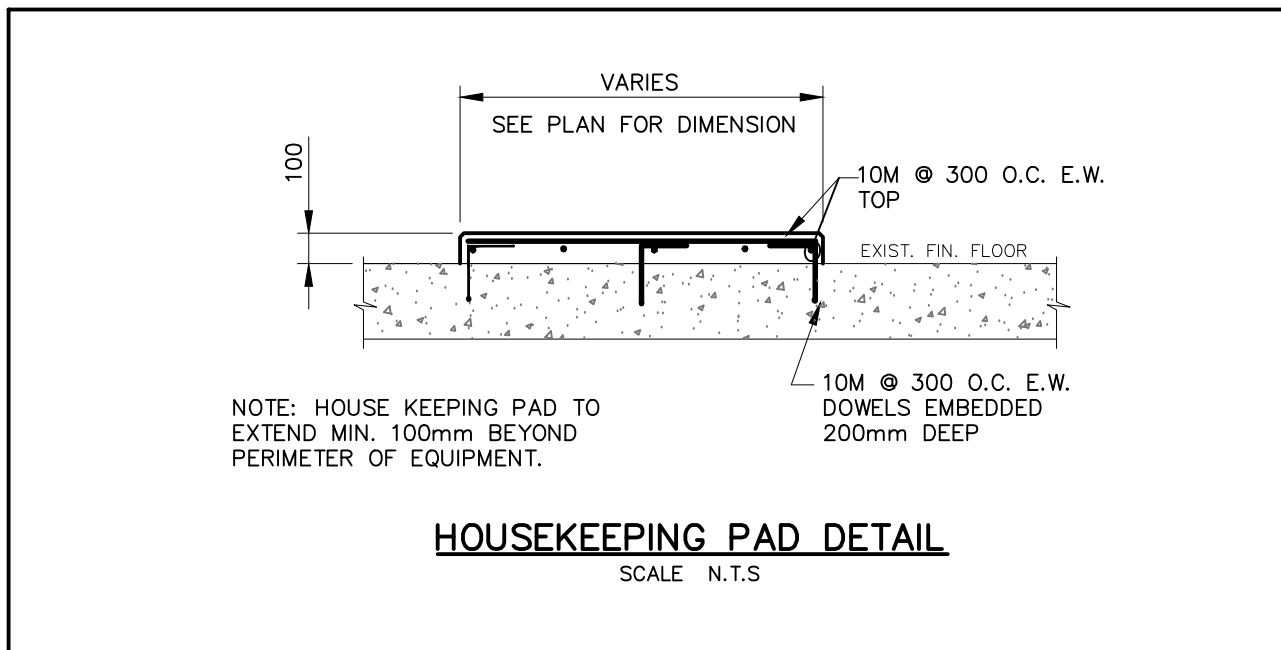

HOUSEKEEPING PAD DETAIL

SCALE N.T.S.

BRACING OF
SHOP FABRICATED WOOD TRUSSES

2012/06/04

1 of 3

NOTE:


- FOLLOW THESE STANDARD BRACING DETAILS IN COORDINATION WITH CONTRACT DOCUMENTS, SPECIFICATIONS AND SPECIFIC BRACING REQUIREMENTS AS REQUIRED ON TRUSS SHOP DRAWINGS.
- BRACING IS REQUIRED ALONG 3 PLANES, TOP CHORD, WEB MEMBERS AND BOTTOM CHORD.
- BRACING MEMBERS TO BE 38 x 89 No.1/No.2 GRADE SPF S-DRY OR KILN DRY, U/N.
- BRACING FASTENED WITH 2-90mm (3 1/2") STD. SPIRAL ARDOX NAILS (10d) PER CONNECTION POINT U/N.
- BRACING REQUIREMENTS APPLY REGARDLESS OF TRUSS SHAPE.
- ERECTION BRACING - SEE FABRICATOR'S DRAWINGS AND GUIDELINES.
- PROVIDE DIAGONAL BRACING AT ALL DISCONTINUITIES IN LATERAL BRACING SUCH AS WHERE TRUSS TYPES CHANGE

1. TOP CHORD BRACING:

- FOR PLYWOOD SHEATHED TRUSSES, APPLY SHEATHING DURING TRUSS ERECTION OR APPLY 38 x 89 MIN PURLINS AT EACH PANEL POINT. FOR LARGE TRUSSES, MAXIMUM 3m ON CENTRE, APPLY PURLINS TO U/S TOP CHORDS IF SHEATHING INSTALLED LATER.

2. BOTTOM CHORD BRACING:

- ALIGN BRACING LINE WITH POINT AT WHICH VERTICAL BRACING HITS BOTTOM CHORD WHERE POSSIBLE.

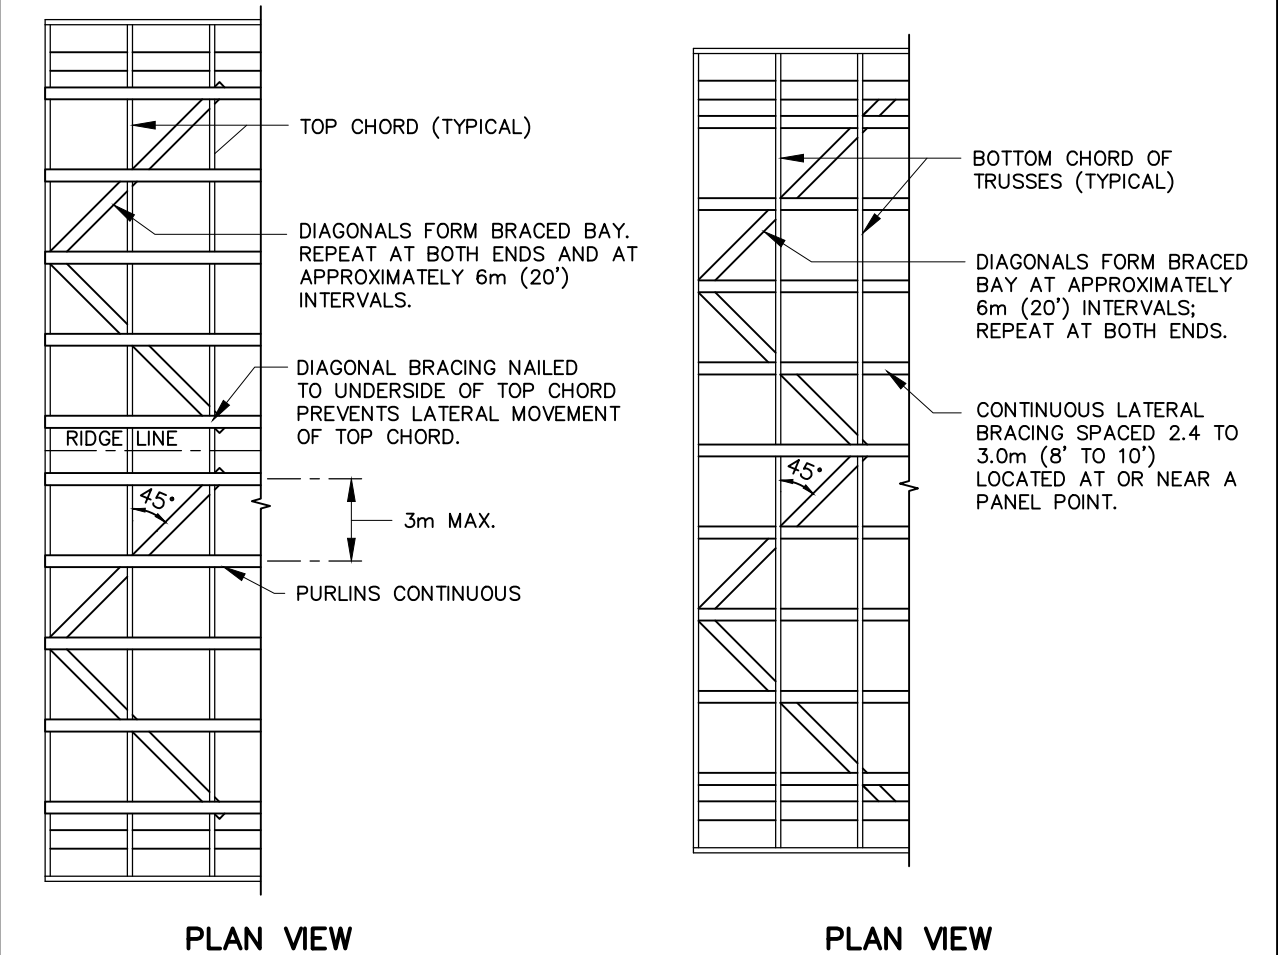


06 17
BRACING OF
SHOP FABRICATED WOOD TRUSSES

2012/06/04


3 of 3

4. OPTIONAL PIGGYBACK ATTACHMENT DETAILS:

- PIGGYBACK TRUSSES CAN BE ATTACHED TO THE BASE TRUSS BY EITHER OF THE METHODS SHOWN BELOW.

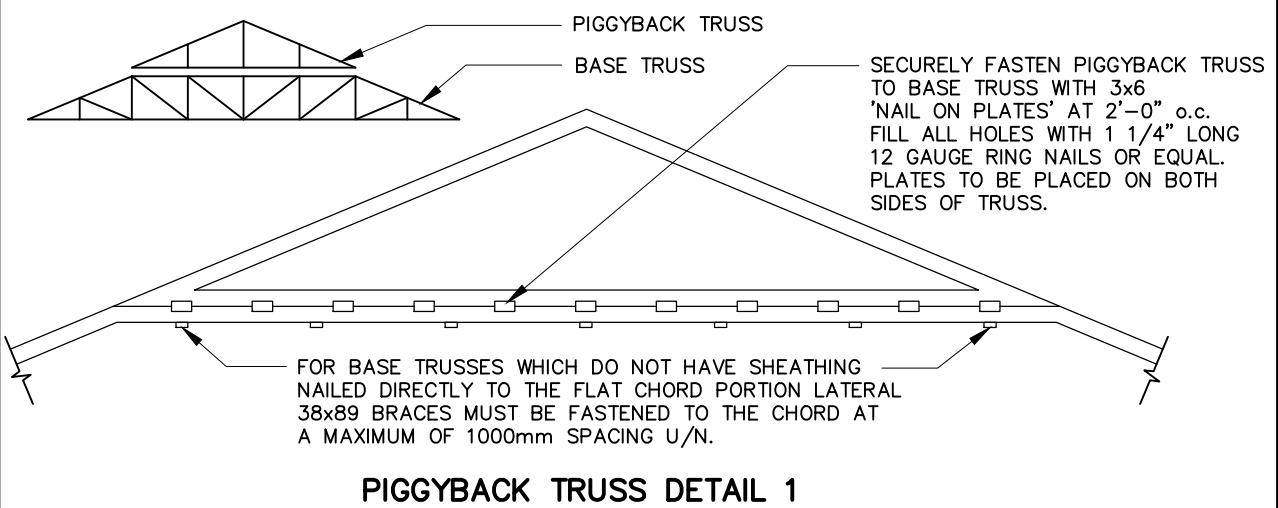


PIGGYBACK TRUSS DETAIL 1

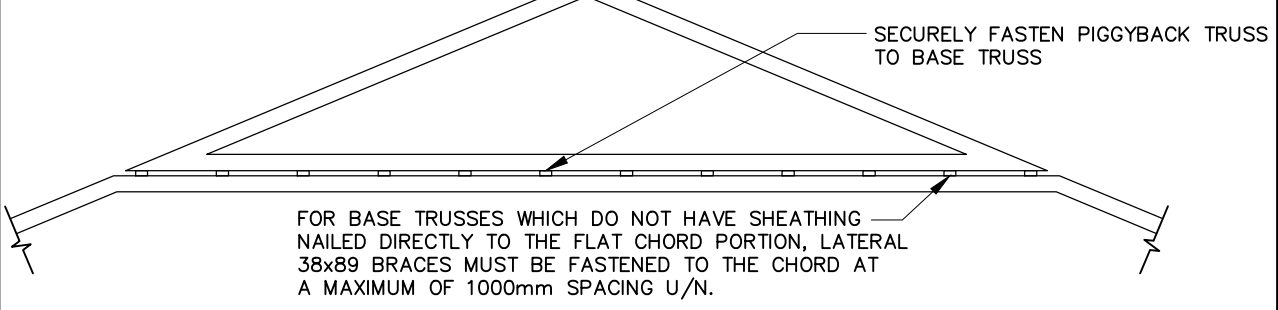

PIGGYBACK TRUSS DETAIL 2

5. ERECTION TOLERANCE:

- WHEN SHEATHING, MAKE SURE NAILS ARE DRIVEN INTO THE TOP CHORD OF THE TRUSSES.

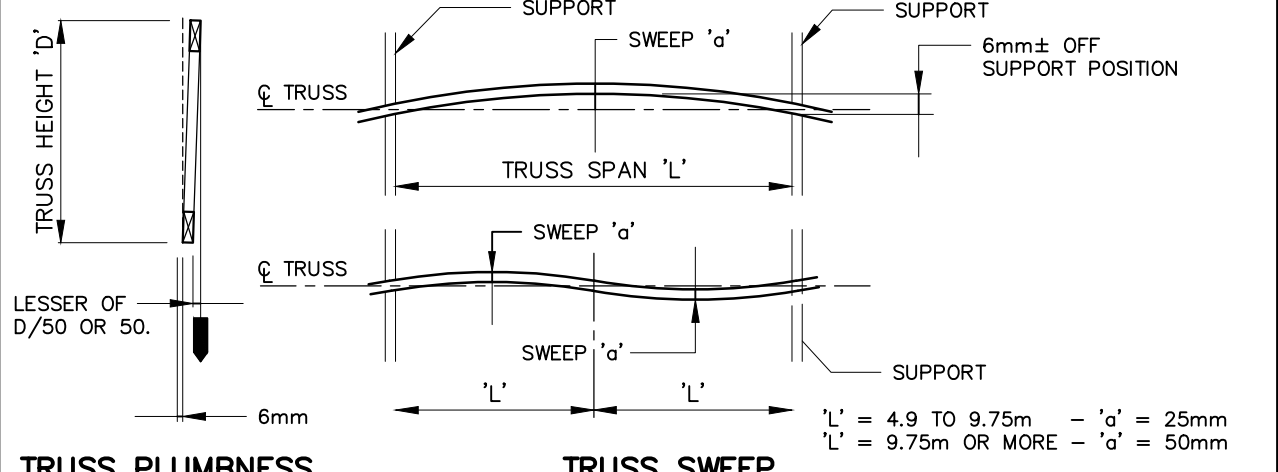

TRUSS PLUMBNESS

TRUSS SWEEP

- This drawing is the exclusive property of Nuna Burnside and the reproduction of any part without prior written consent of this office is strictly prohibited.
- The contractor shall verify all dimensions, levels, and datums on site and report any discrepancies or omissions to this office prior to construction.
- This drawing is to be read and understood in conjunction with all other plans and documents applicable to this project.
- Do not scale the drawings.

Issue / Revision	Date
1 ISSUED FOR 66% SUBMISSION	NOVEMBER 2012
2 ISSUED FOR 99 SUBMISSION	JANUARY 2013
3 ISSUED FOR TENDER	FEBRUARY 2013
4 REVISED AS PER ADDENDUM 1 TO 4 AND ISSUED FOR CONSTRUCTION	APRIL 2013
5 AS-BUILT	AUGUST 2015

AS-BUILT DRAWING
AS-BUILT INFORMATION PROVIDED BY THE
GENERAL CONTRACTOR:
KUDLIK CONSTRUCTION LTD.
IQALUIT, NUNAVUT

ORIGINAL
STAMPED
BY
C. W. JONES
04/22/13

NUNA BURNSIDE


Nuna Burnside Engineering & Environmental LTD.
106B Scurfield Blvd., Winnipeg, Manitoba
telephone (204) 949-7110 fax (204) 949-7111
web www.neeganburnside.com

Client
GOVERNMENT OF NUNAVUT
COMMUNITY & GOVERNMENT
SERVICES


RANKIN INLET
SEWAGE TREATMENT PLANT

Drawing Title
STRUCTURAL GENERAL
REQUIREMENTS CONT'D.
AND TYPICAL DETAILS

Drawn By	Checked By	Drawing No.
W. WHITEDUCK	C. JONES	S7
Scale	Project No.	
NTS	300031281	

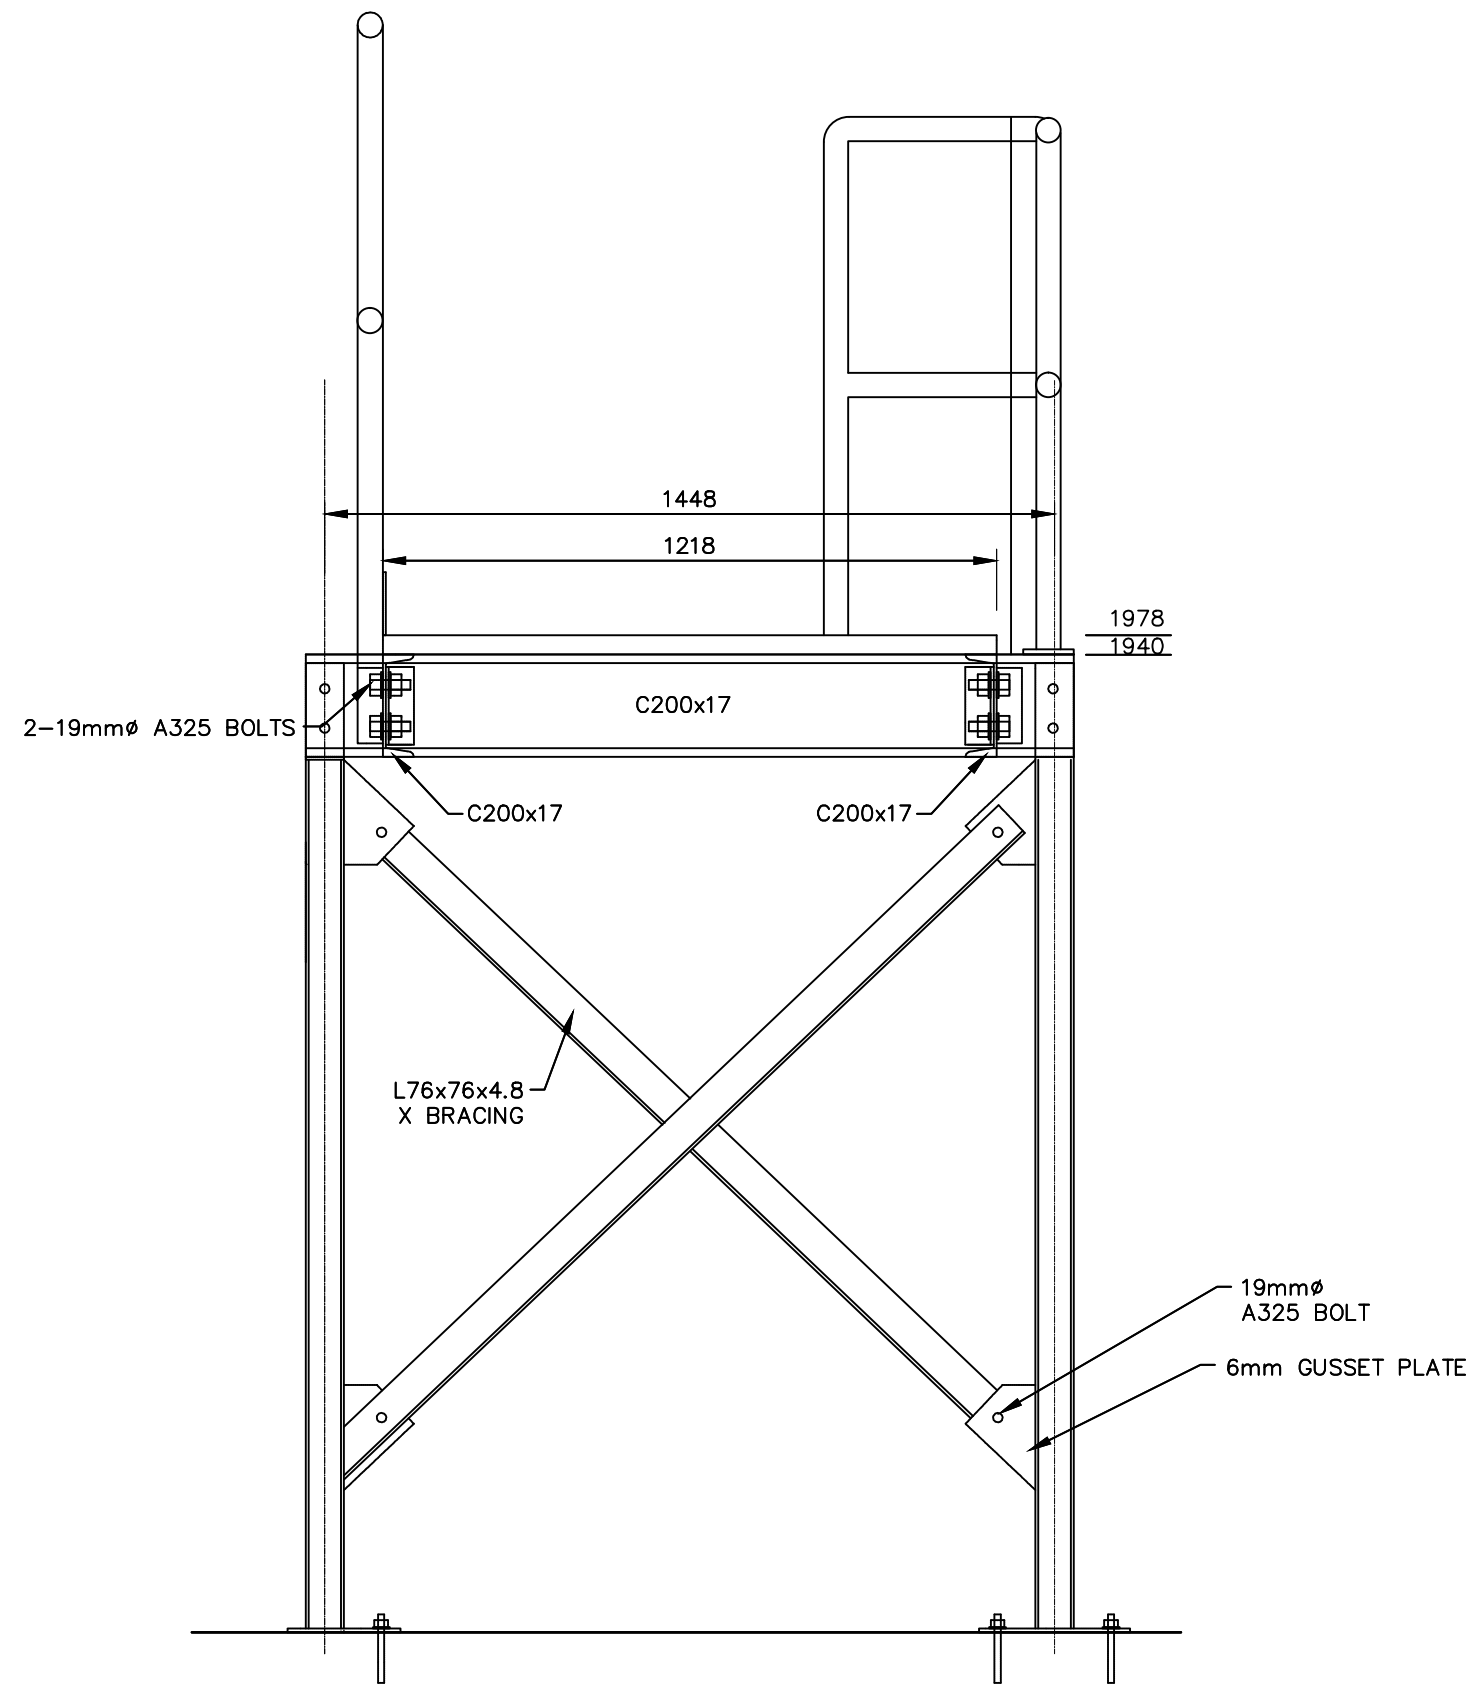


4
S8 SECTION AT CATWALK
SCALE 1:15

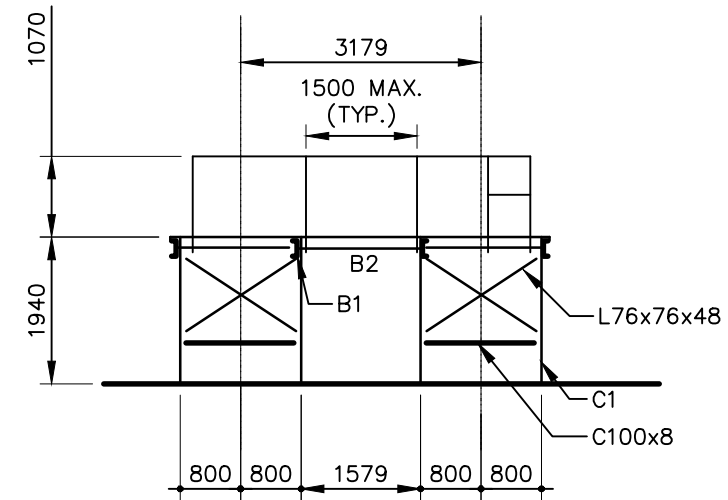


1
S8 CATWALK FRAMING SECTION (SURGE TANK)
SCALE 1:100

CATWALK MEMBER SIZES


B1	C200 x 21
B2	C200 x 21
C1	76 x 76 x 6.4 HSS

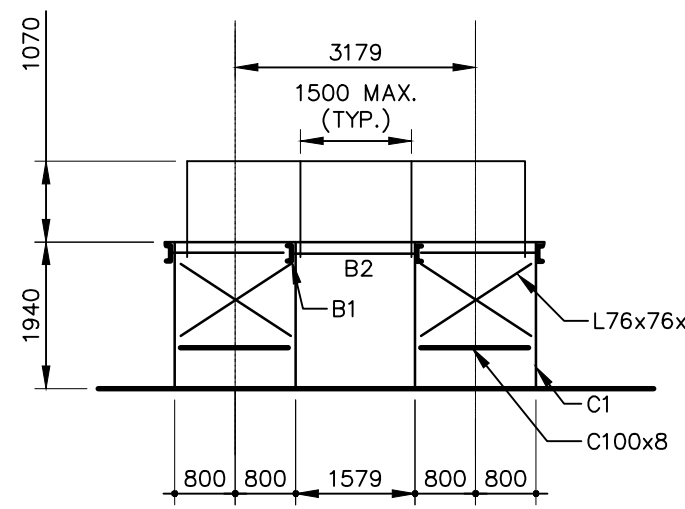


1B
S8 CATWALK FRAMING SECTION
SCALE 1:100

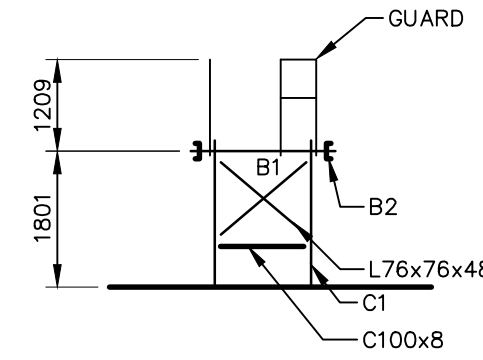


2
S8 CATWALK FRAMING SECTION (SURGE TANK)
SCALE 1:100

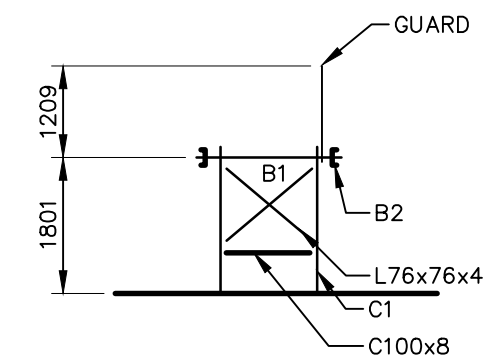


2B
S8 CATWALK FRAMING SECTION
SCALE 1:100

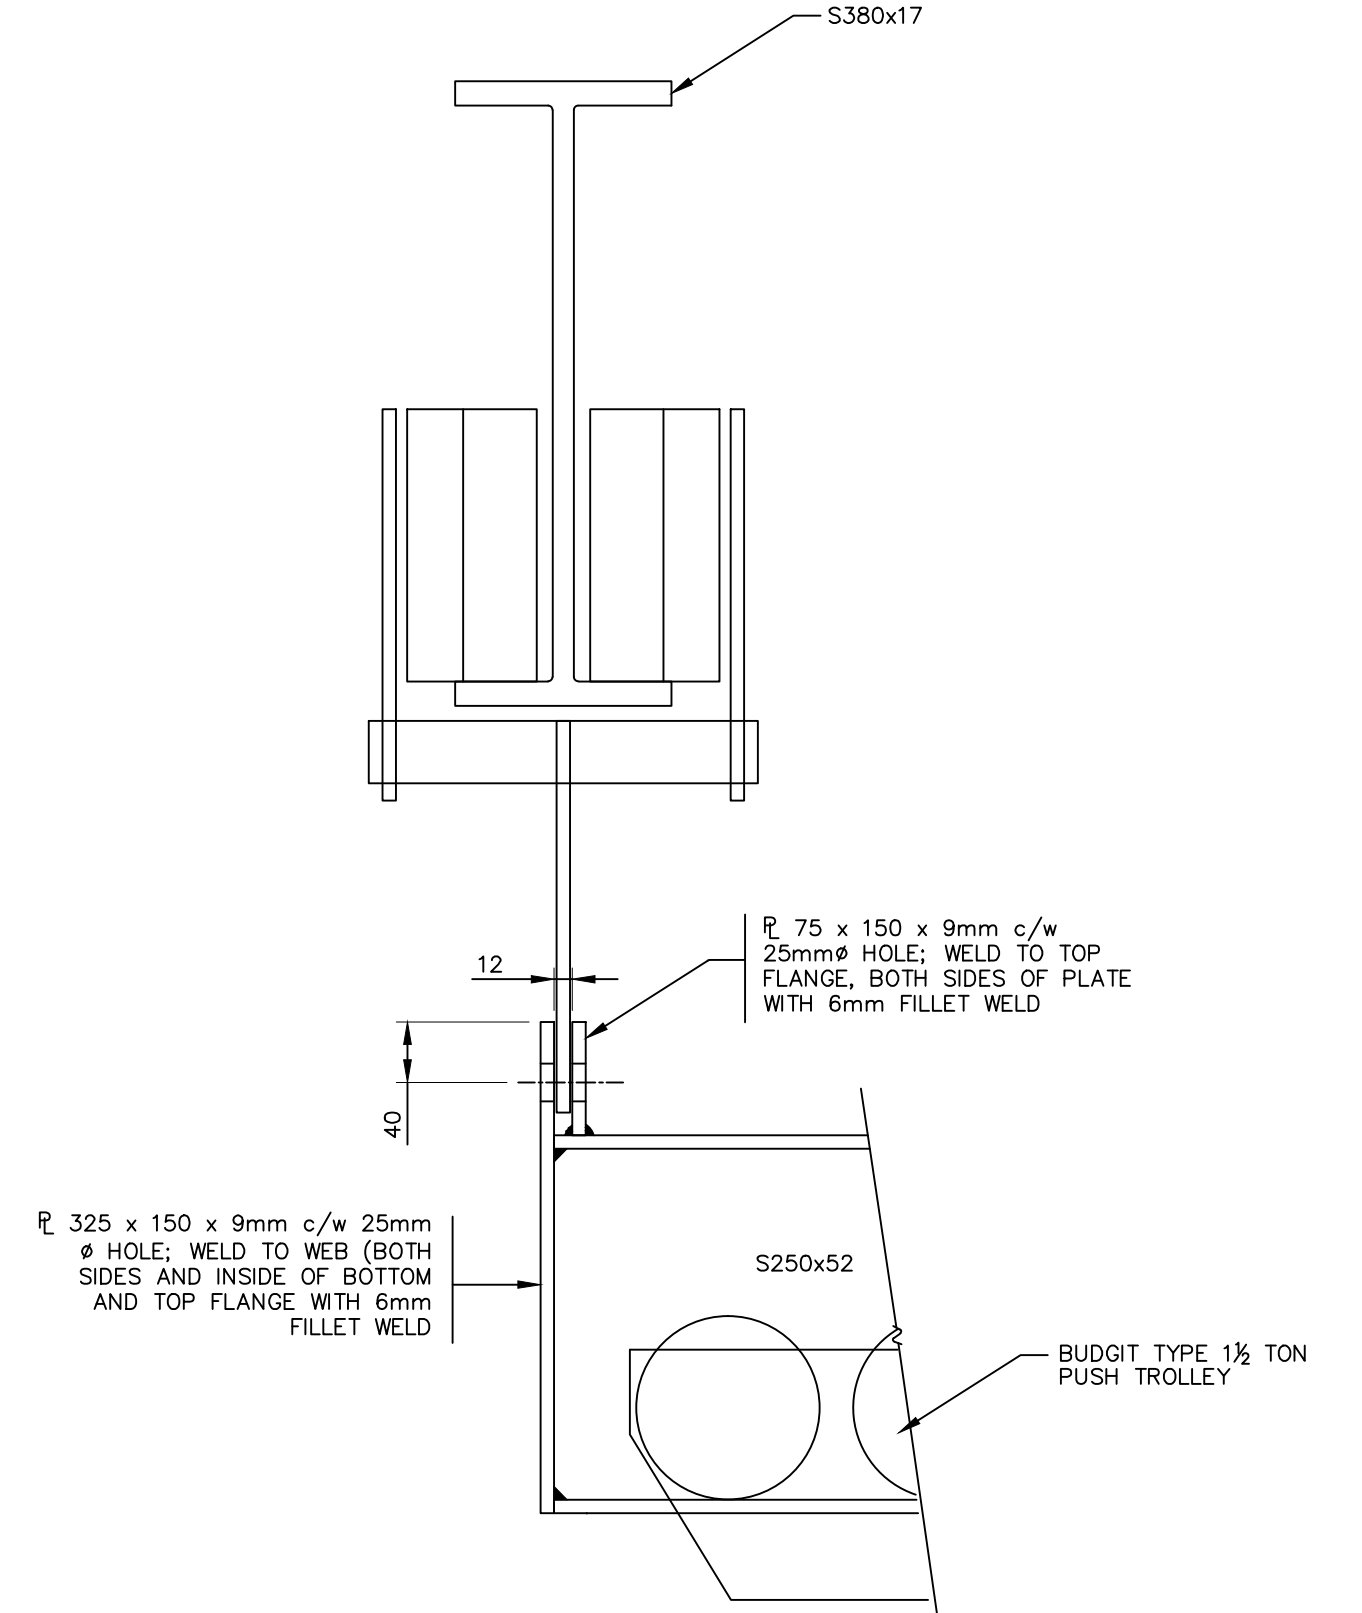


6
S8 HOIST RAIL CONNECTION
SCALE 1:5

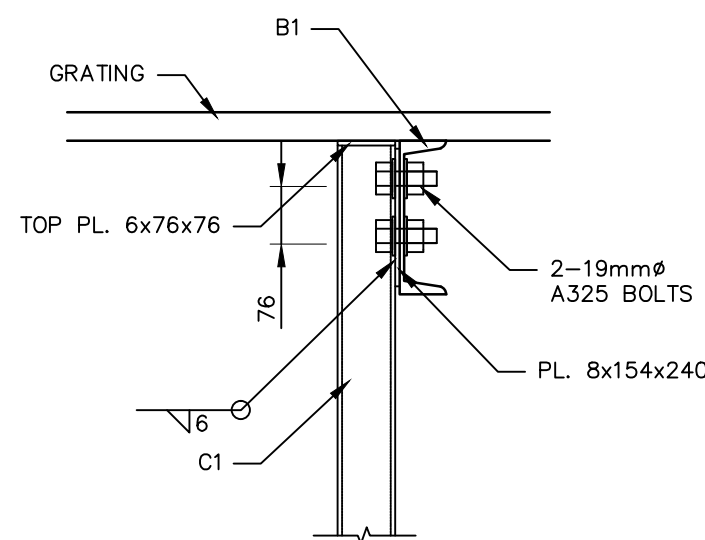


5
S8 SECTION
SCALE 1:10

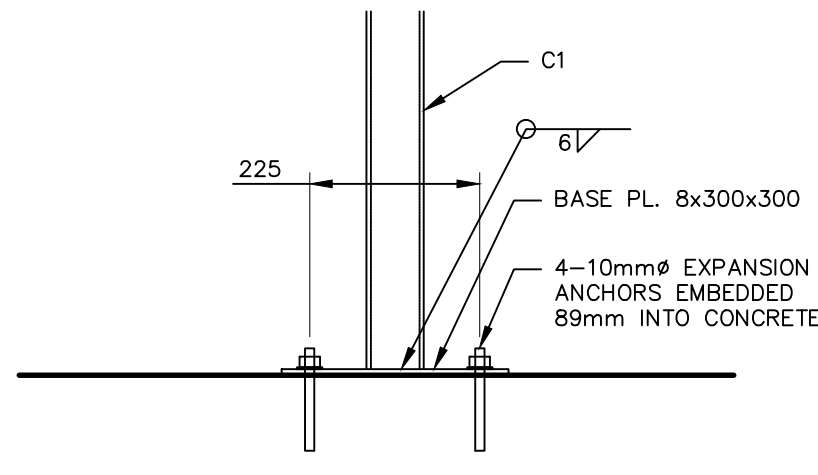

6
S8 TYP. COLUMN CONNECTION
SCALE 1:10

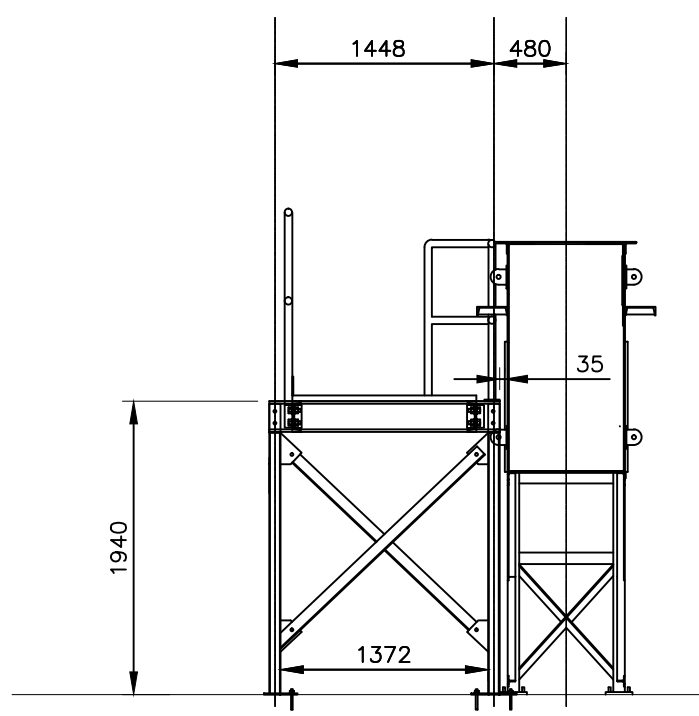

3
S8 SECTION AT CHANNEL CATWALK (SURGE TANK)
SCALE 1:50

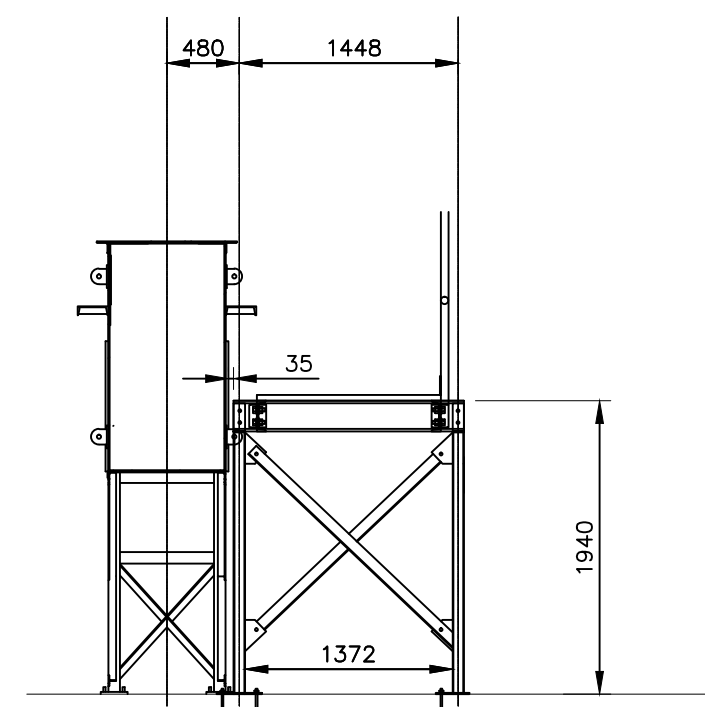

3B
S8 SECTION AT CHANNEL CATWALK
SCALE 1:50

1. This drawing is the exclusive property of Nuna Burnside and the reproduction of any part without prior written consent of this office is strictly prohibited.
2. The contractor shall verify all dimensions, levels, and datums on site and report any discrepancies or omissions to this office prior to construction.
3. This drawing is to be read and understood in conjunction with all other plans and documents applicable to this project.
4. Do not scale the drawings.

Issue / Revision	Date
1 ISSUED FOR 99% SUBMISSION	JANUARY 2013
2 ISSUED FOR TENDER	FEBRUARY 2013
3 REVISED AS PER ADDENDUM 1 TO 4 AND ISSUED FOR CONSTRUCTION	APRIL 2013
4 AS-BUILT	AUGUST 2015


AS-BUILT DRAWING
AS-BUILT INFORMATION PROVIDED BY THE GENERAL CONTRACTOR:
KUDLIK CONSTRUCTION LTD.
IQALUIT, NUNAVUT

Nuna BURNSIDE
Nuna Burnside Engineering & Environmental LTD.
106B Scurfield Blvd., Winnipeg, Manitoba
telephone (204) 949-7110 fax (204) 949-7111
web www.neeganburnside.com






Client
GOVERNMENT OF NUNAVUT
COMMUNITY & GOVERNMENT
SERVICES
RANKIN INLET
SEWAGE TREATMENT PLANT

Drawing Title
CATWALK
LOCATION AND DETAILS

Drawn By W. WHITEDUCK	Checked By C. JONES	Drawing No. S8
--------------------------	------------------------	-------------------

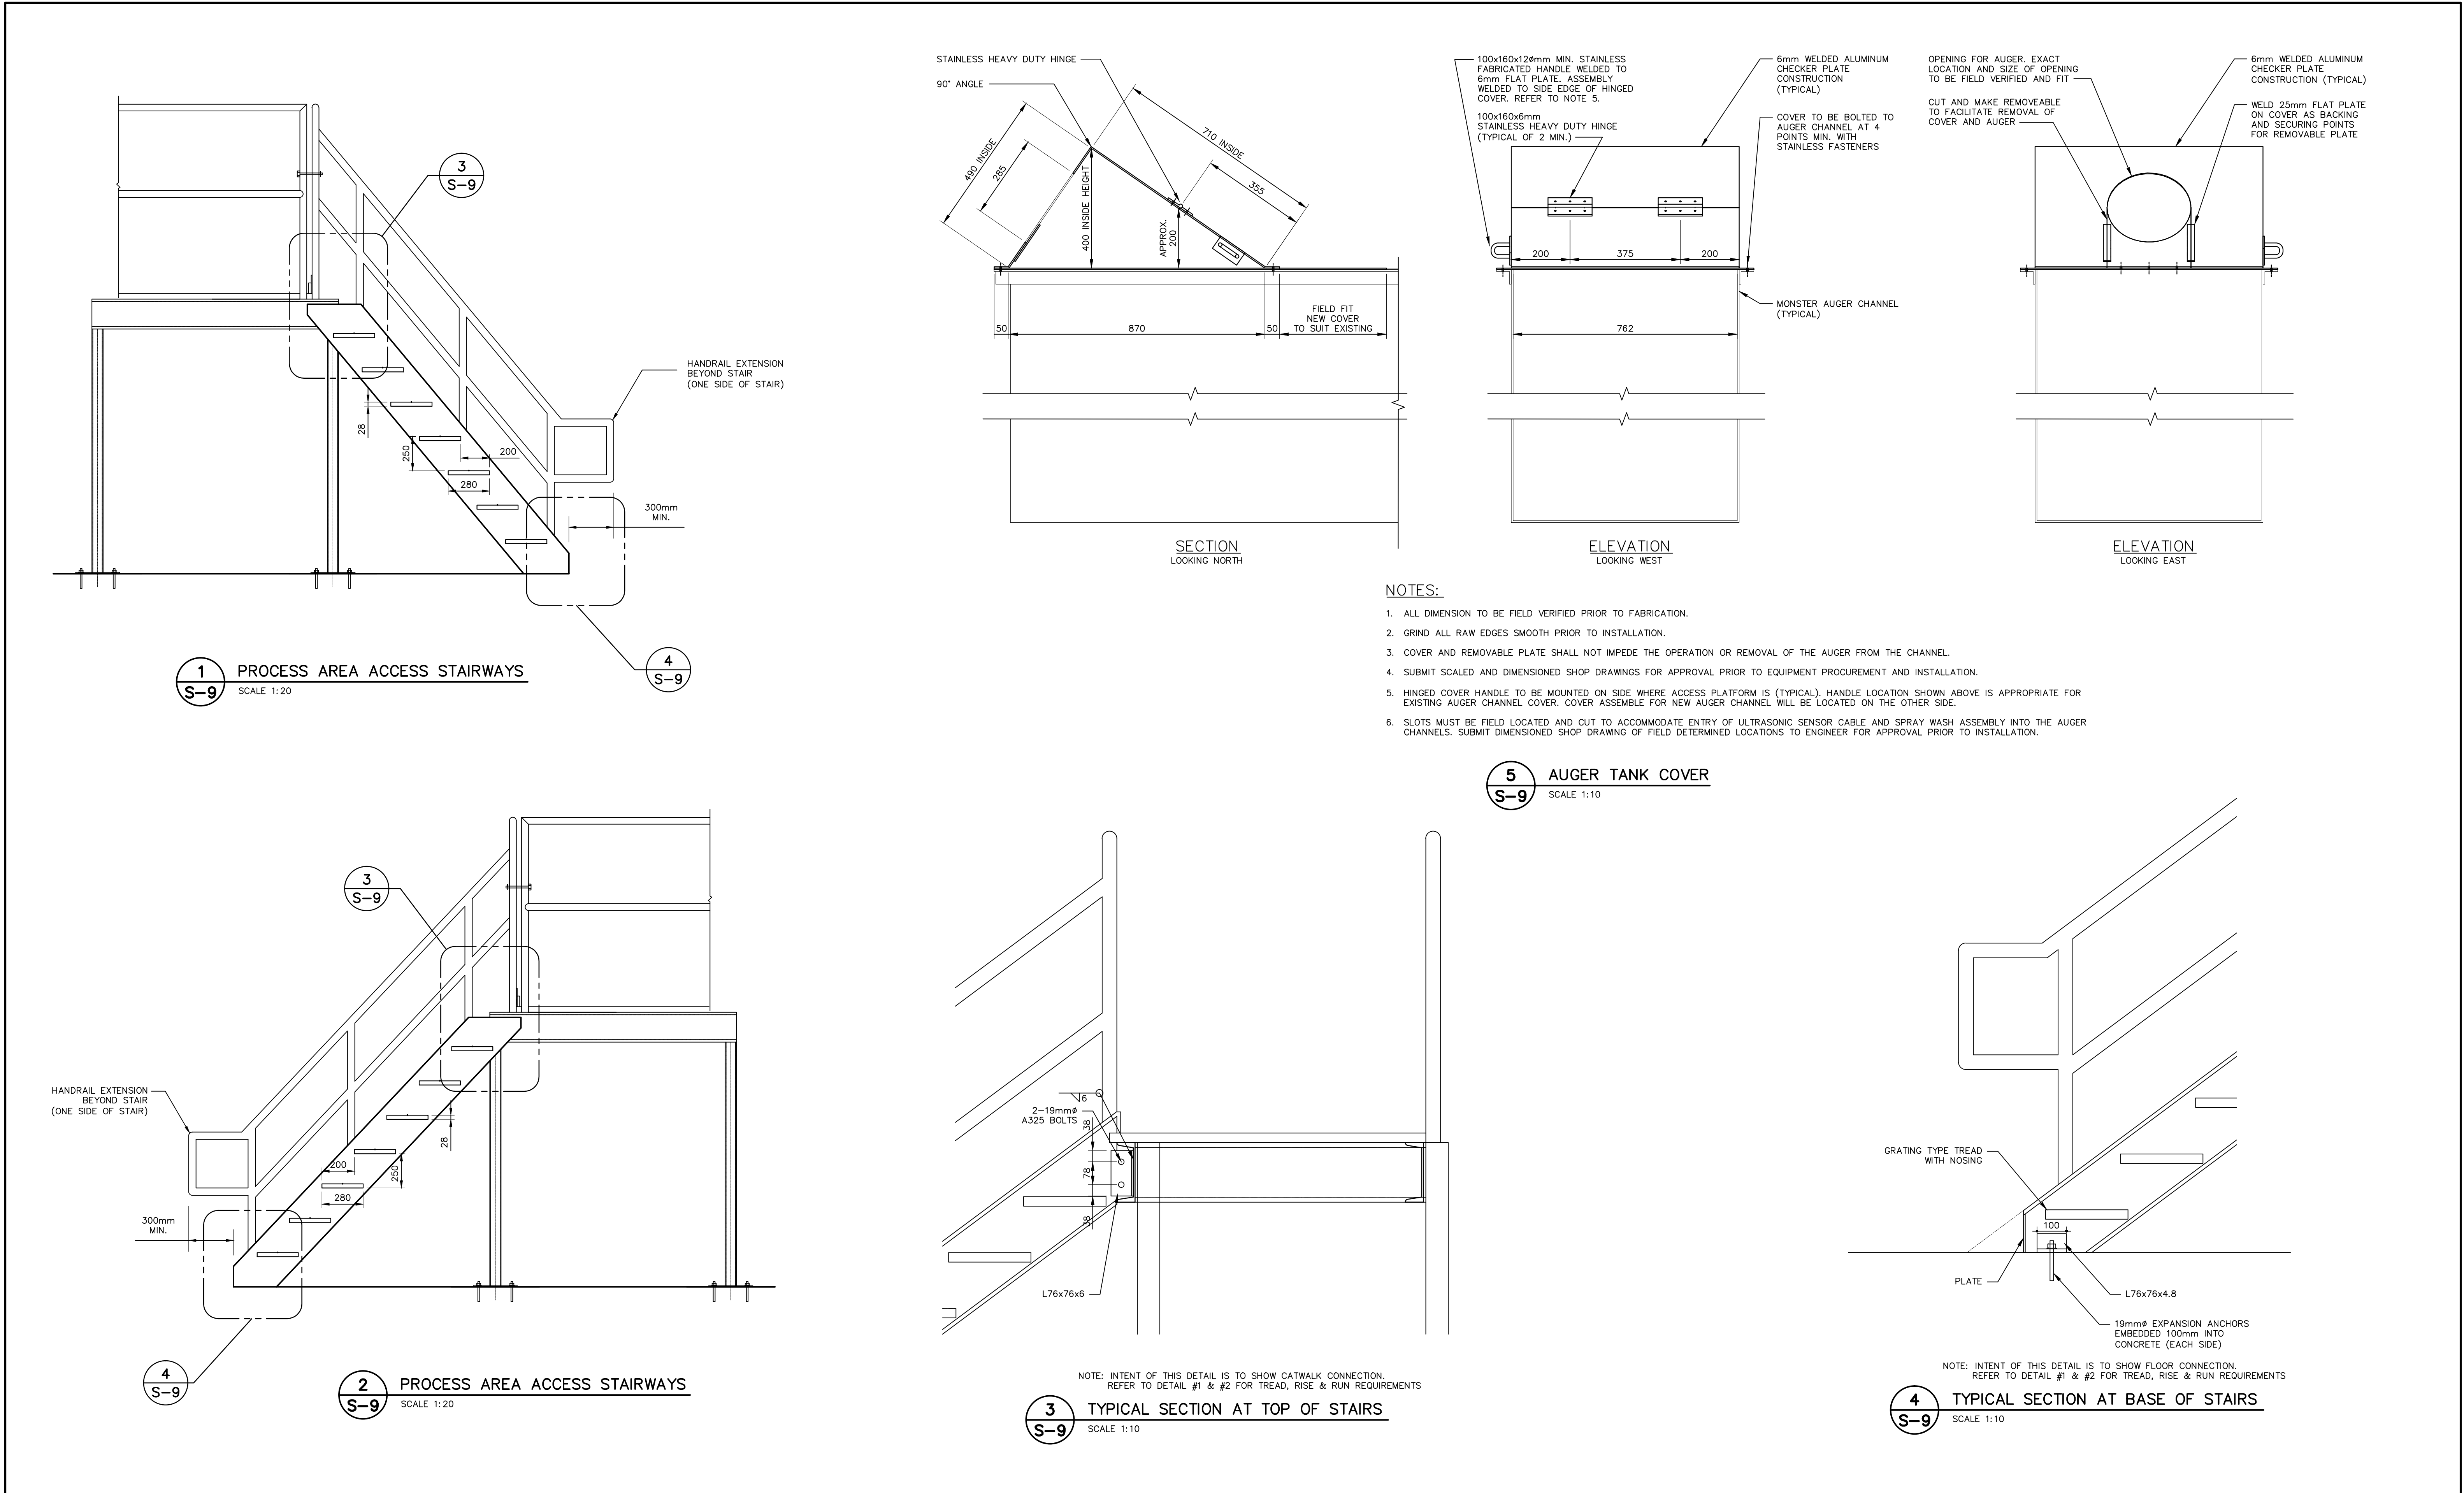

1. This drawing is the exclusive property of Nuna Burnside and the reproduction of any part without prior written consent of this office is strictly prohibited. 2. The contractor shall verify all dimensions, levels, and datums on site and report any discrepancies or omissions to this office prior to construction. 3. This drawing is to be read and understood in conjunction with all other plans and documents applicable to this project. 4. Do not scale the drawings.	Issue / Revision		Date	AS-BUILT DRAWING AS-BUILT INFORMATION PROVIDED BY THE GENERAL CONTRACTOR: KUDLIK CONSTRUCTION LTD. IQALUIT, NUNAVUT				 BURNSIDE Nuna Burnside Engineering & Environmental LTD. 106B Scurfield Blvd., Winnipeg, Manitoba telephone (204) 949-7110 fax (204) 949-7111 web www.neeganburnside.com	Client GOVERNMENT OF NUNAVUT COMMUNITY & GOVERNMENT SERVICES RANKIN INLET SEWAGE TREATMENT PLANT	Drawing Title STRUCTURAL STAIR DETAILS AND AUGER CHANNEL COVER DETAILS								
	1	ISSUED FOR TENDER	FEBRUARY 2013															
	2	REVISED AS PER ADDENDUM 1 TO 4 AND ISSUED FOR CONSTRUCTION	APRIL 2013															
	3	AS-BUILT	AUGUST 2015															
																Drawn By C. GERUS	Checked By M. STREIFLER	Drawing No. S-9
																Scale AS NOTED	Project No. 300031281	

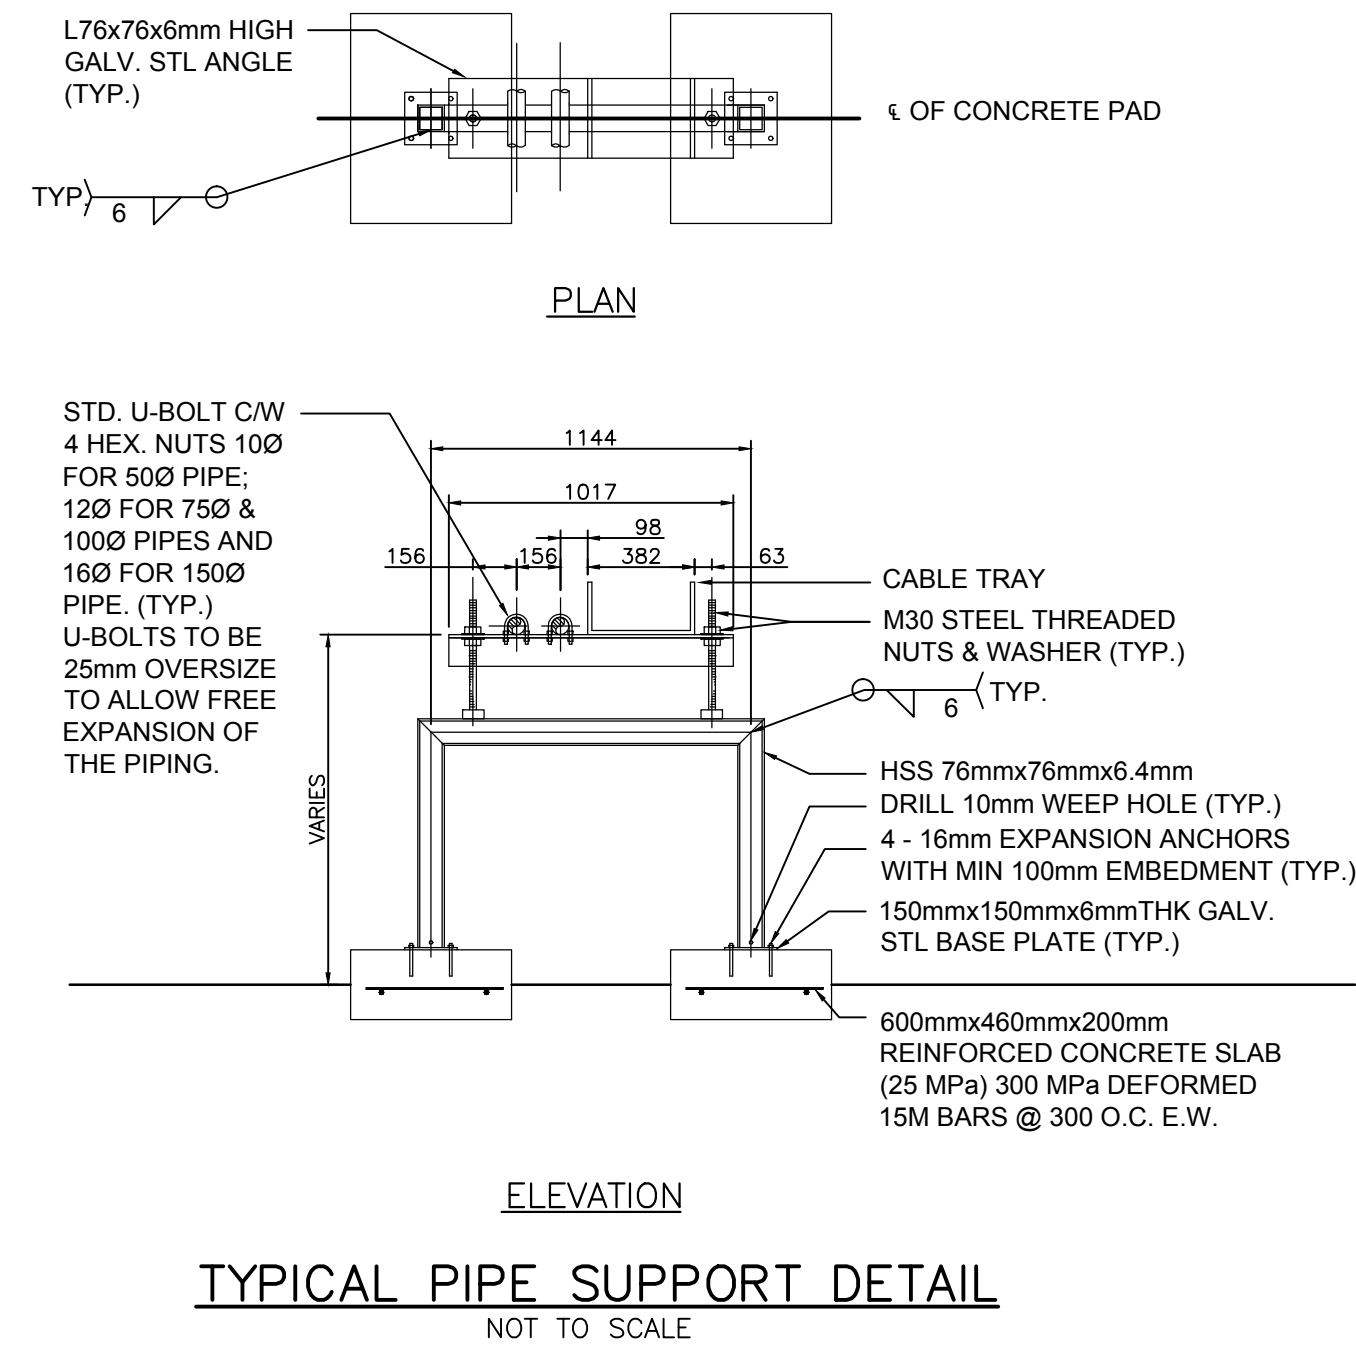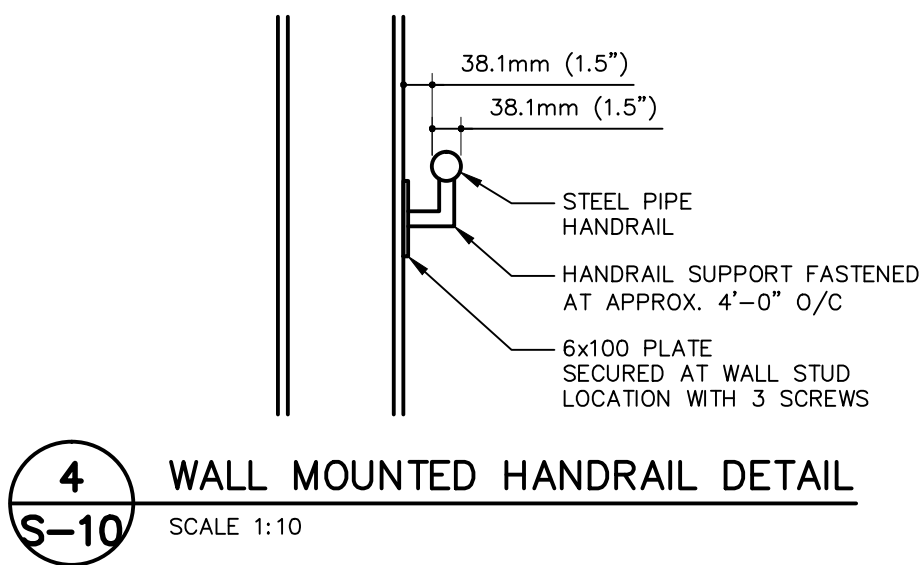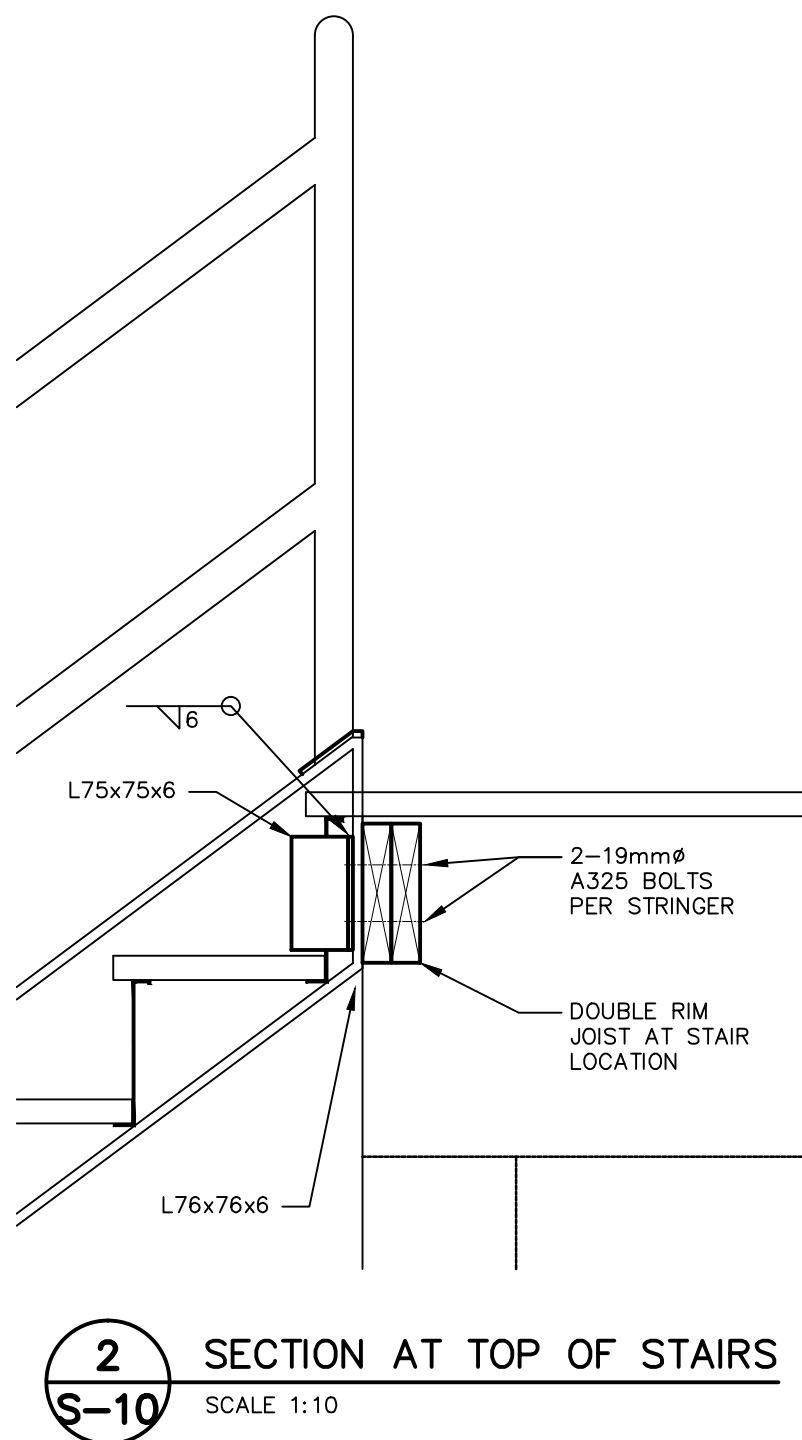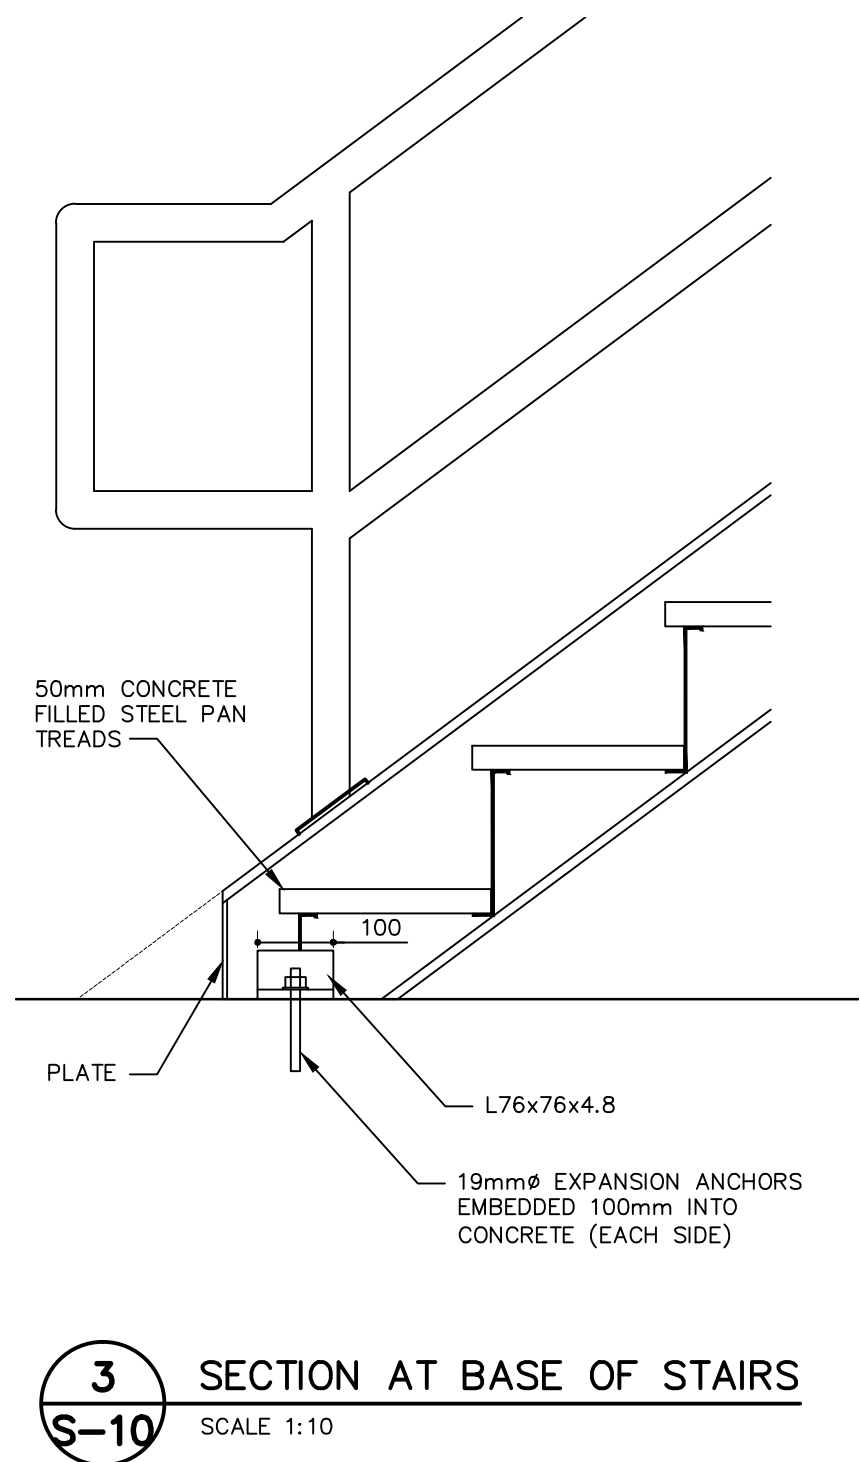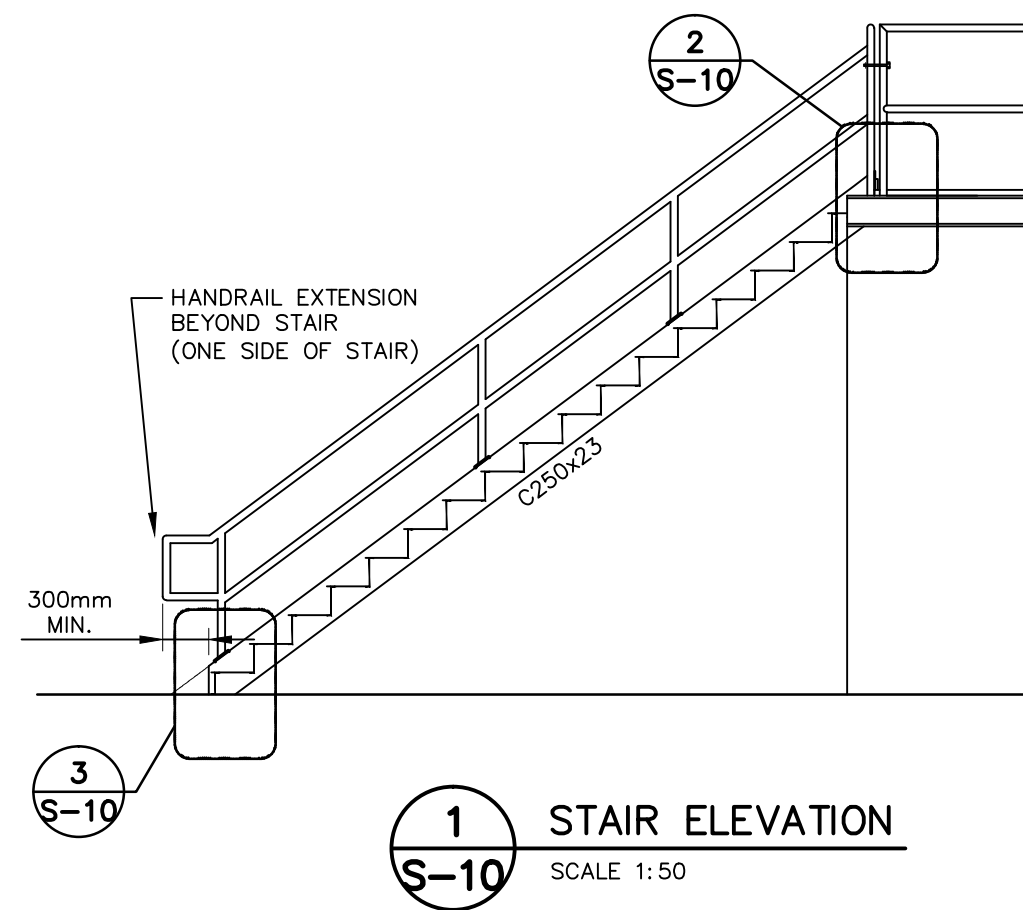

NOTE:

- SEE SECTION 05-50-00-2.6 OF THE NATIONAL BUILDING CODE FOR FABRICATION OF STEEL STAIRS AND RAILINGS
- SEE SPECIFICATION SECTION 05-50-10 STEEL TANKS, ELEVATED PLATFORMS AND STAIRS CLAUS 1.6 AND 1.7 FIR DESIGN REQUIREMENTS

1. This drawing is the exclusive property of Nuna Burnside and the reproduction of any part without prior written consent of this office is strictly prohibited.

2. The contractor shall verify all dimensions, levels, and datums on site and report any discrepancies or omissions to this office prior to construction.

3. This drawing is to be read and understood in conjunction with all other plans and documents applicable to this project.

4. Do not scale the drawings.

Issue / Revision	Date
1 ISSUED FOR TENDER	FEBRUARY 2013
2 REVISED AS PER ADDENDUM 1 TO 4 AND ISSUED FOR CONSTRUCTION	APRIL 2013
3 AS-BUILT	AUGUST 2015

AS-BUILT DRAWING

AS-BUILT INFORMATION PROVIDED BY THE GENERAL CONTRACTOR:

KUDLIK CONSTRUCTION LTD.

IQALUIT, NUNAVUT

Nuna Burnside

Nuna Burnside Engineering & Environmental LTD.

106B Scurfield Blvd., Winnipeg, Manitoba

telephone (204) 949-7110 fax (204) 949-7111

web www.neeganburnside.com

Client

GOVERNMENT OF NUNAVUT

COMMUNITY & GOVERNMENT SERVICES

RANKIN INLET

SEWAGE TREATMENT PLANT


Drawing Title

STRUCTURAL STAIR



AND HANDRAIL DETAILS

Drawn By C. GERUS	Checked By M. STREIFLER	Drawing No. S-10
Scale AS NOTED	Project No. 300031281	

NOTE:
THE OPERATIONS OF THE SEWAGE TREATMENT FACILITY
MUST BE MAINTAINED WITHOUT INTERRUPTION
THROUGHOUT DURATION OF PLANT UPGRADES.

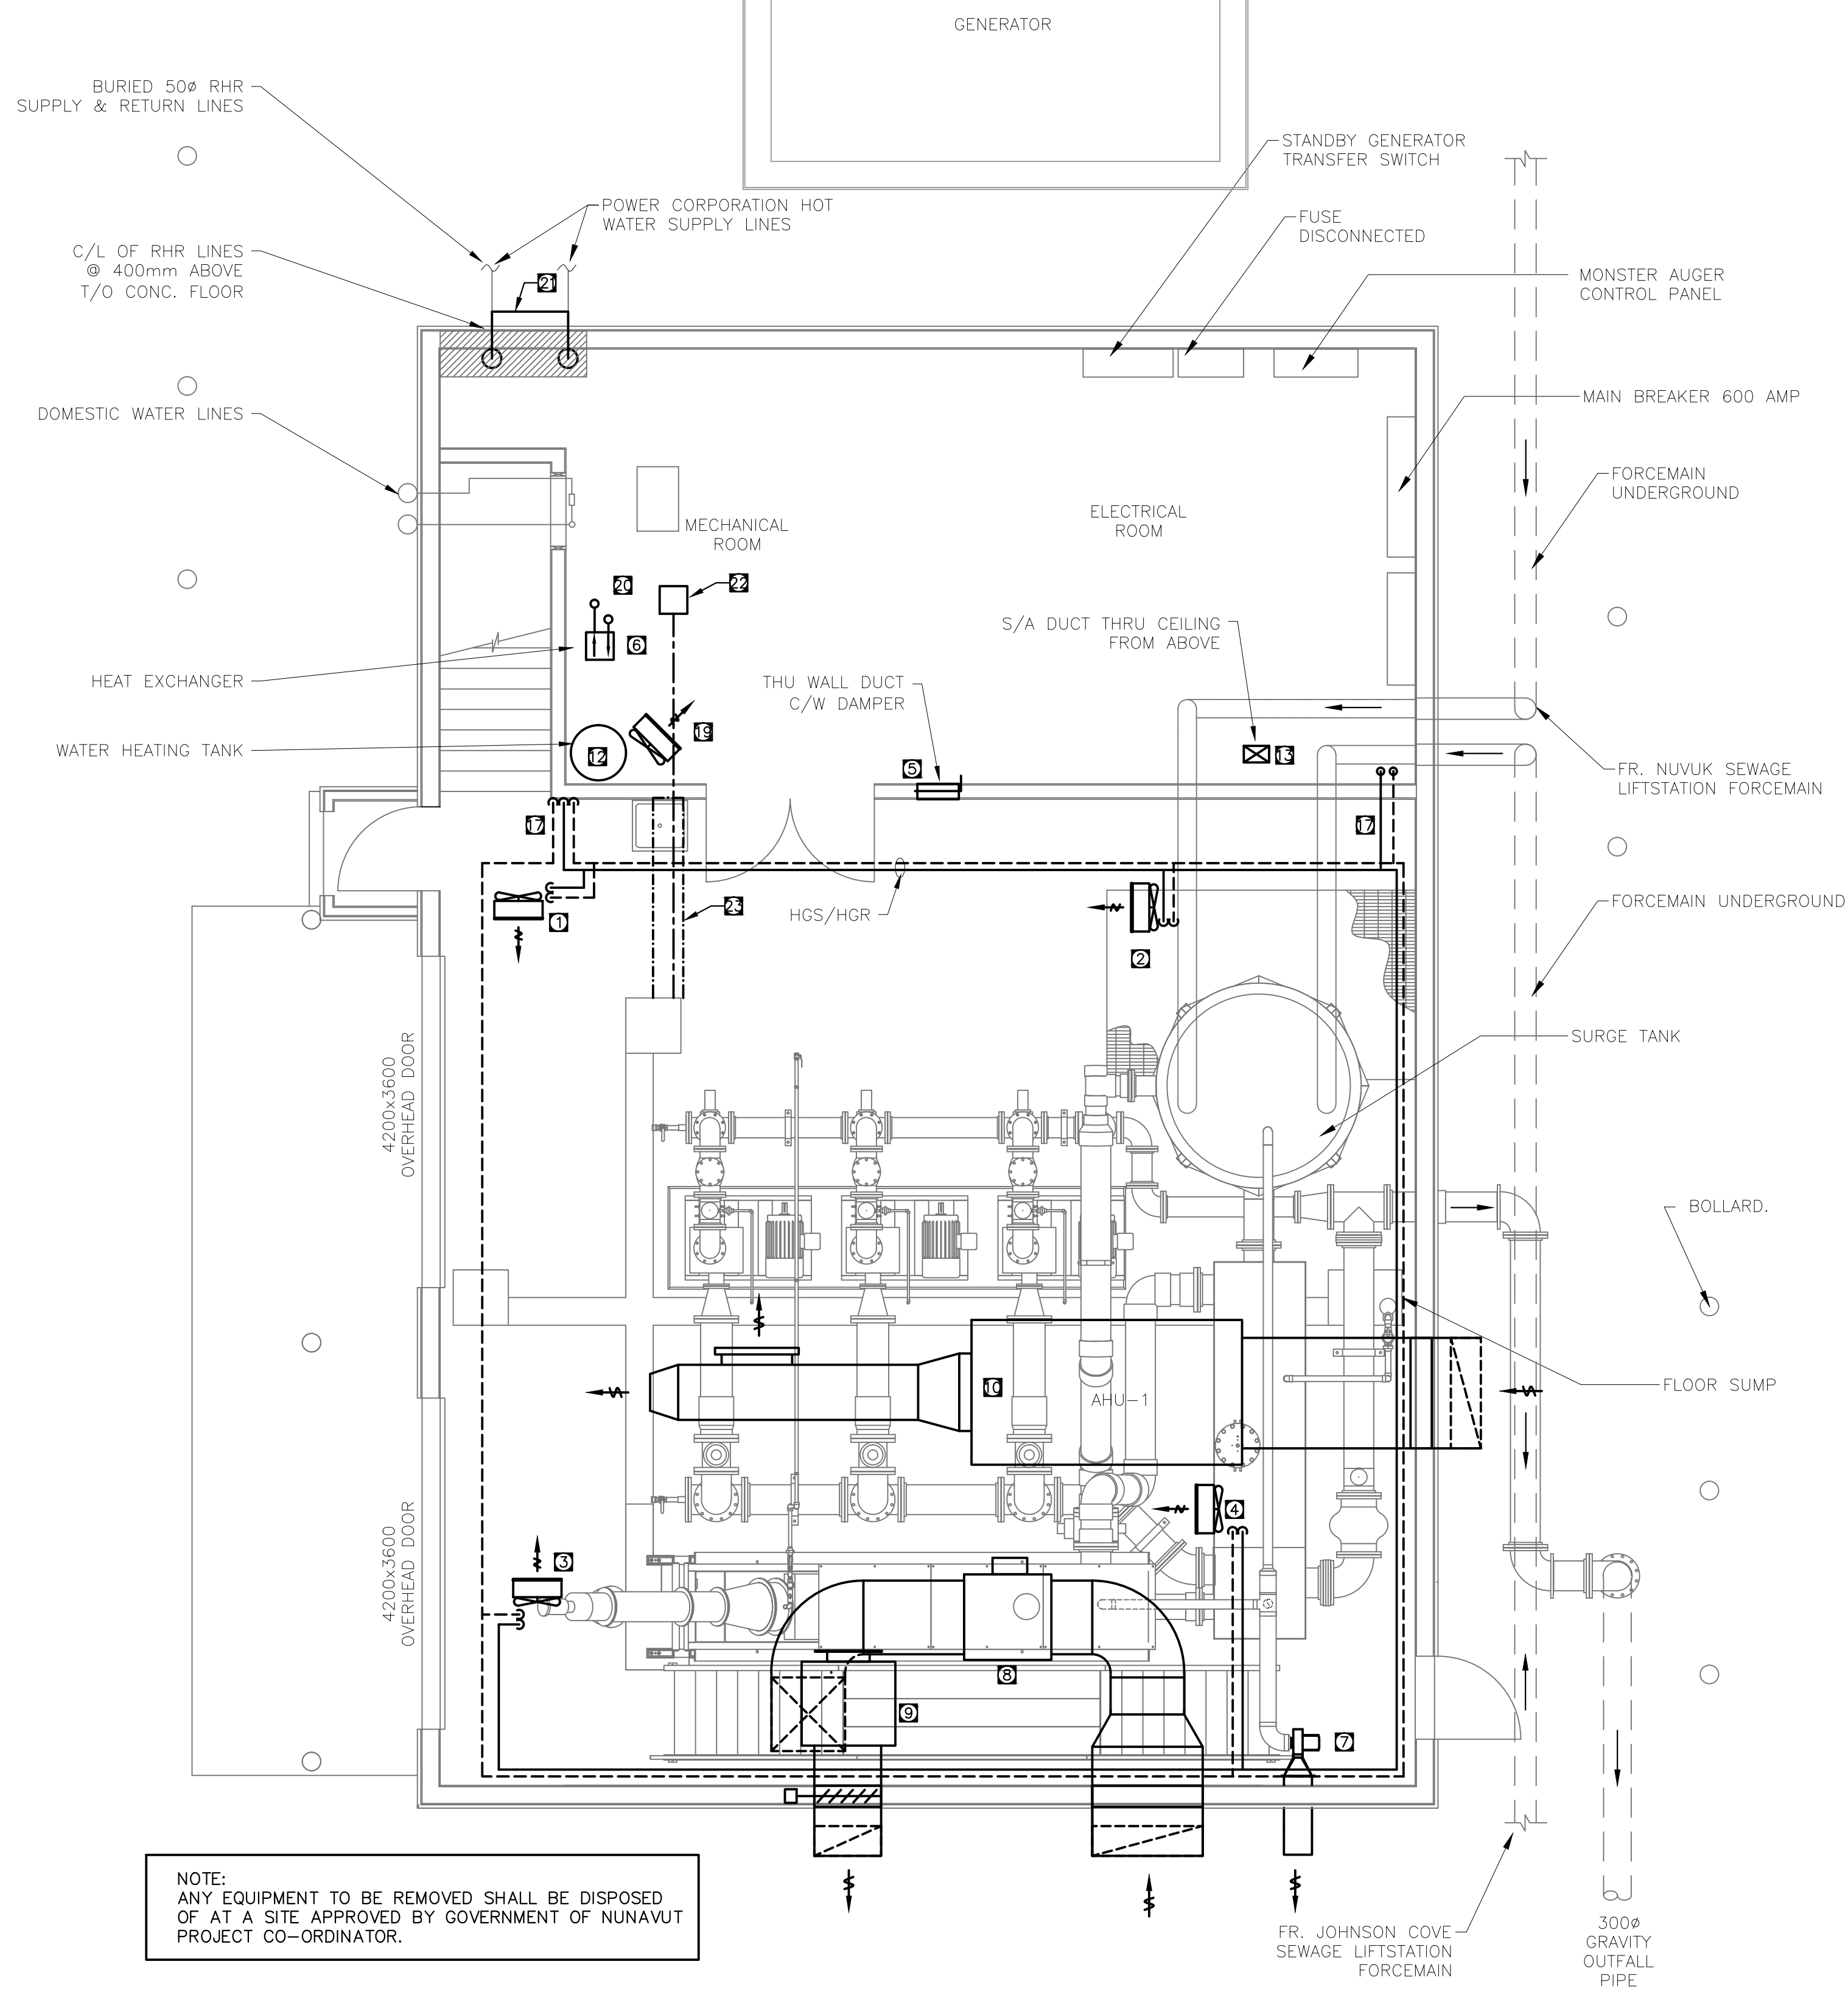

DEMO - EXISTING MAIN FLOOR PLAN
1:50

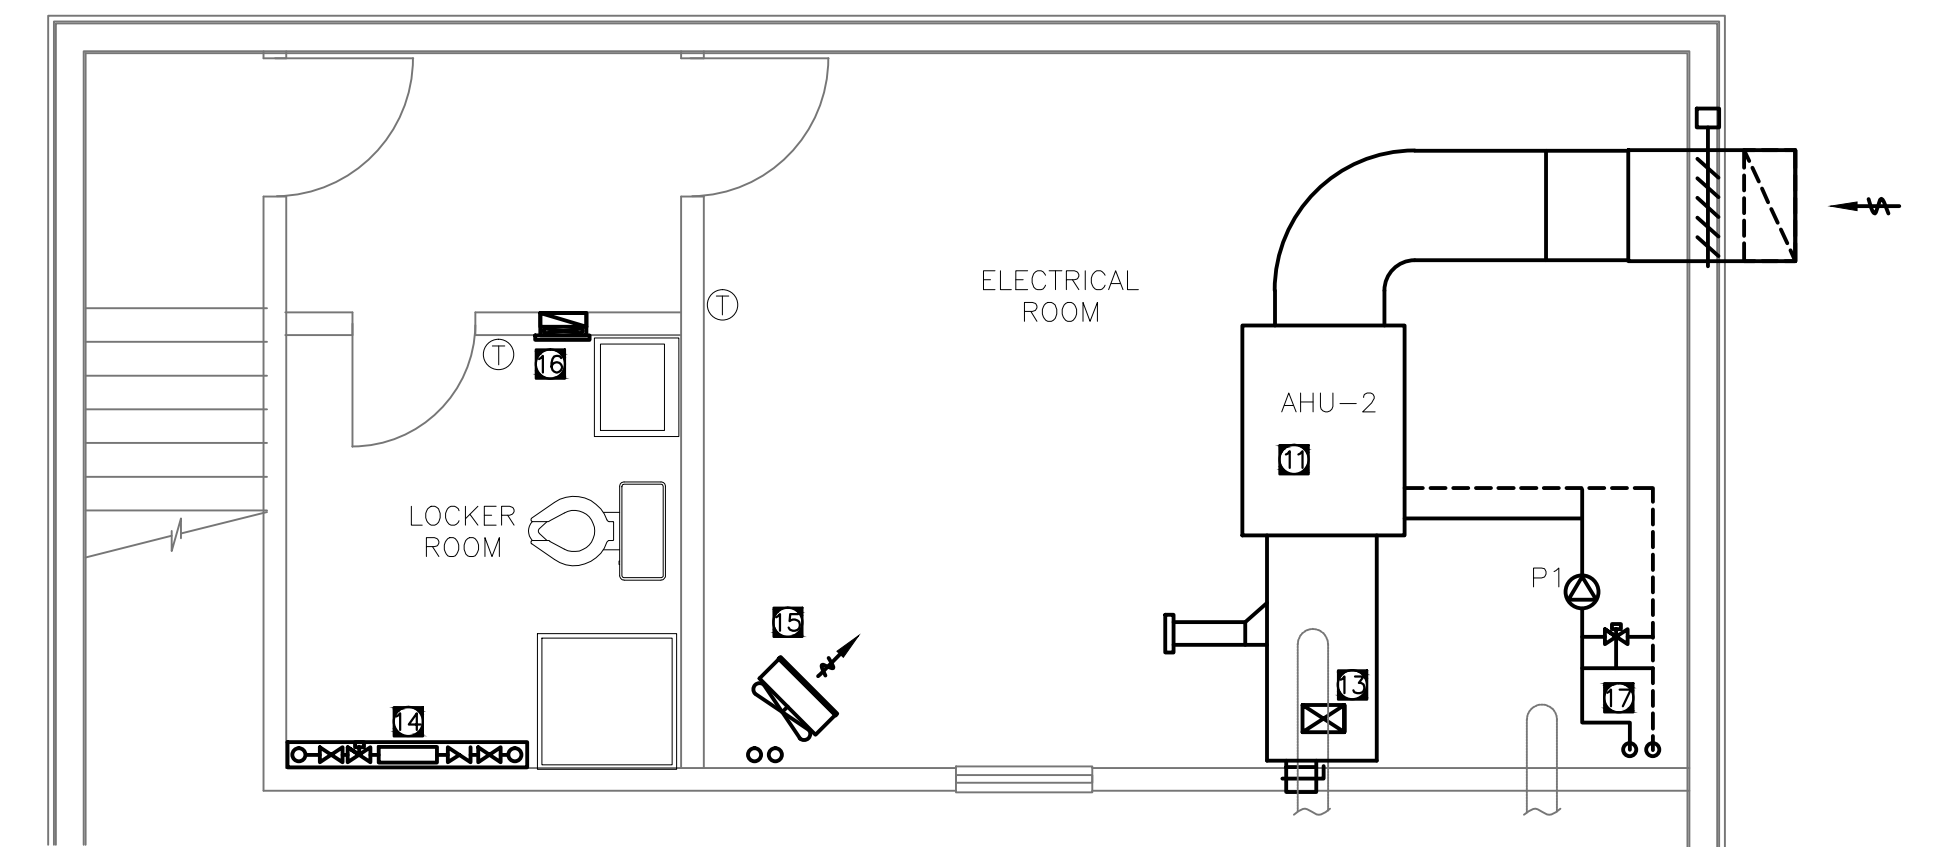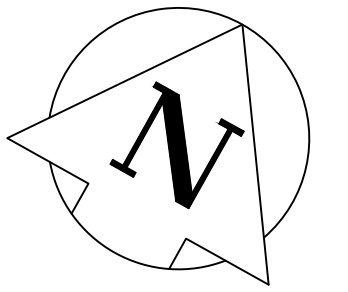

DEMO - SECOND FLOOR LEVEL
1:50

EXIST. SEWAGE PLANT DECOMMISSIONING NOTES

- 1 REMOVE & RELOCATE OF UNIT HEATER. TO BE RE-USED IN NEW TRUCK BAY.
- 2 REMOVE & RELOCATE OF UNIT HEATER. TO BE RE-USED IN NEW TRUCK BAY.
- 3 REMOVE & RELOCATE OF UNIT HEATER. TO BE RE-USED IN NEW TRUCK BAY.
- 4 REMOVE & RELOCATE OF UNIT HEATER. TO BE RE-USED IN NEW TRUCK BAY.
- 5 REMOVE THRU WALL DUCT AND SEAL OPENING TO MATCH EXISTING.
- 6 EXISTING PLATE HEAT EXCHANGER TO BE RELOCATED
- 7 REMOVE & DISPOSE OF EXHAUST FAN, REPLACE WITH EXPLOSION PROOF MODEL.
- 8 REMOVE & DISPOSE OF EXHAUST FAN C/W ALL ASSOCIATED HARDWARE, WALL PENETRATIONS TO BE PATCHED TO MATCH EXISTING.
- 9 REMOVE AND DISPOSE OF EXHAUST FAN, WALL PENETRATIONS TO BE PATCHED TO MATCH EXISTING.
- 10 REMOVE AND DISPOSE OF AHU-1
- 11 REMOVE AND DISPOSE OF AHU-2
- 12 EXISTING HOT WATER STORAGE TANK TO BE RELOCATED
- 13 EXISTING DUCT WORK TO BE REMOVED, WALL/FLOOR PENETRATIONS TO BE PATCHED TO MATCH EXISTING.
- 14 EXISTING FIN TUBE RADIANT HEATER TO REMAIN.
- 15 EXISTING RADIANT HEATER TO REMAIN.
- 16 EXISTING EXHAUST FAN TO REMAIN.
- 17 REMOVE AND DISPOSE OF ALL EXISTING HYDRONIC HEATING PIPE WORK LOCATED IN PROCESS ROOM.
- 18 DELETED
- 19 EXISTING UNIT HEATER TO BE RELOCATED
- 20 REMOVE AND DISPOSE OF ALL EXISTING HYDRONIC HEATING PIPE WORK LOCATED IN MECHANICAL ROOM.
- 21 CUT BACK AND LOOP PIPING, WITH FLANGED FITTINGS, AS CLOSE TO GRADE AS REASONABLE, EXISTING HOT WATER LINES FROM POWER CORPORATION. (TYP. OF 2)
- 22 REMOVE EXISTING GRATED FLOOR DRAIN COVER. DRAIN TO BE PLUGGED AND PATCHED WITH CONCRETE TO MATCH EXISTING FLOOR SURFACE. FLOOR DRAIN PIPE TO BE ABANDONED.
- 23 SAW-CUT EXISTING CONCRETE FLOOR SECTION TO SUIT NEW PLUMBING MODIFICATIONS REQUIRED FOR NEW FLOOR DRAIN, CLEANOUT & RELOCATED SINK. (FLOOR TO BE PATCHED TO MATCH EXISTING UPON COMPLETION)

0 1 3m
1:50

1. This drawing is the exclusive property of Nuna Burnside and the reproduction of any part without prior written consent of this office is strictly prohibited.
2. The contractor shall verify all dimensions, levels, and datums on site and report any discrepancies or omissions to this office prior to construction.
3. This drawing is to be read and understood in conjunction with all other plans and documents applicable to this project.
4. Do not scale the drawings.

Issue / Revision	Date
1 ISSUED FOR 66% SUBMISSION	NOVEMBER 2012
2 ISSUED FOR 99% SUBMISSION	JANUARY 2012
3 ISSUED FOR TENDER	FEBRUARY 2013
4 REVISED AS PER ADDENDUM 1 TO 4 AND ISSUED FOR CONSTRUCTION	APRIL 2013
5 AS-BUILT	AUGUST 2015

AS-BUILT DRAWING
AS-BUILT INFORMATION PROVIDED BY THE
GENERAL CONTRACTOR:
KUDLIK CONSTRUCTION LTD.
IGALUIT, NUNAVUT


ORIGINAL
STAMPED
BY
G. POPOWICH
05/27/13

Burnside
Nuna Burnside Engineering & Environmental LTD.
106B Scurfield Blvd., Winnipeg, Manitoba
telephone (204) 949-7110 fax (204) 949-7111
web www.neeganburnside.com

Client
GOVERNMENT OF NUNAVUT
COMMUNITY & GOVERNMENT
SERVICES
RANKIN INLET
SEWAGE TREATMENT PLANT

Drawing Title
DEMOLITION - EXISTING
MECHANICAL EQUIPMENT

Drawn By A.H.	Checked By D.Mack.	Drawing No. M-1
Scale 1:50	Project No. 300031281	

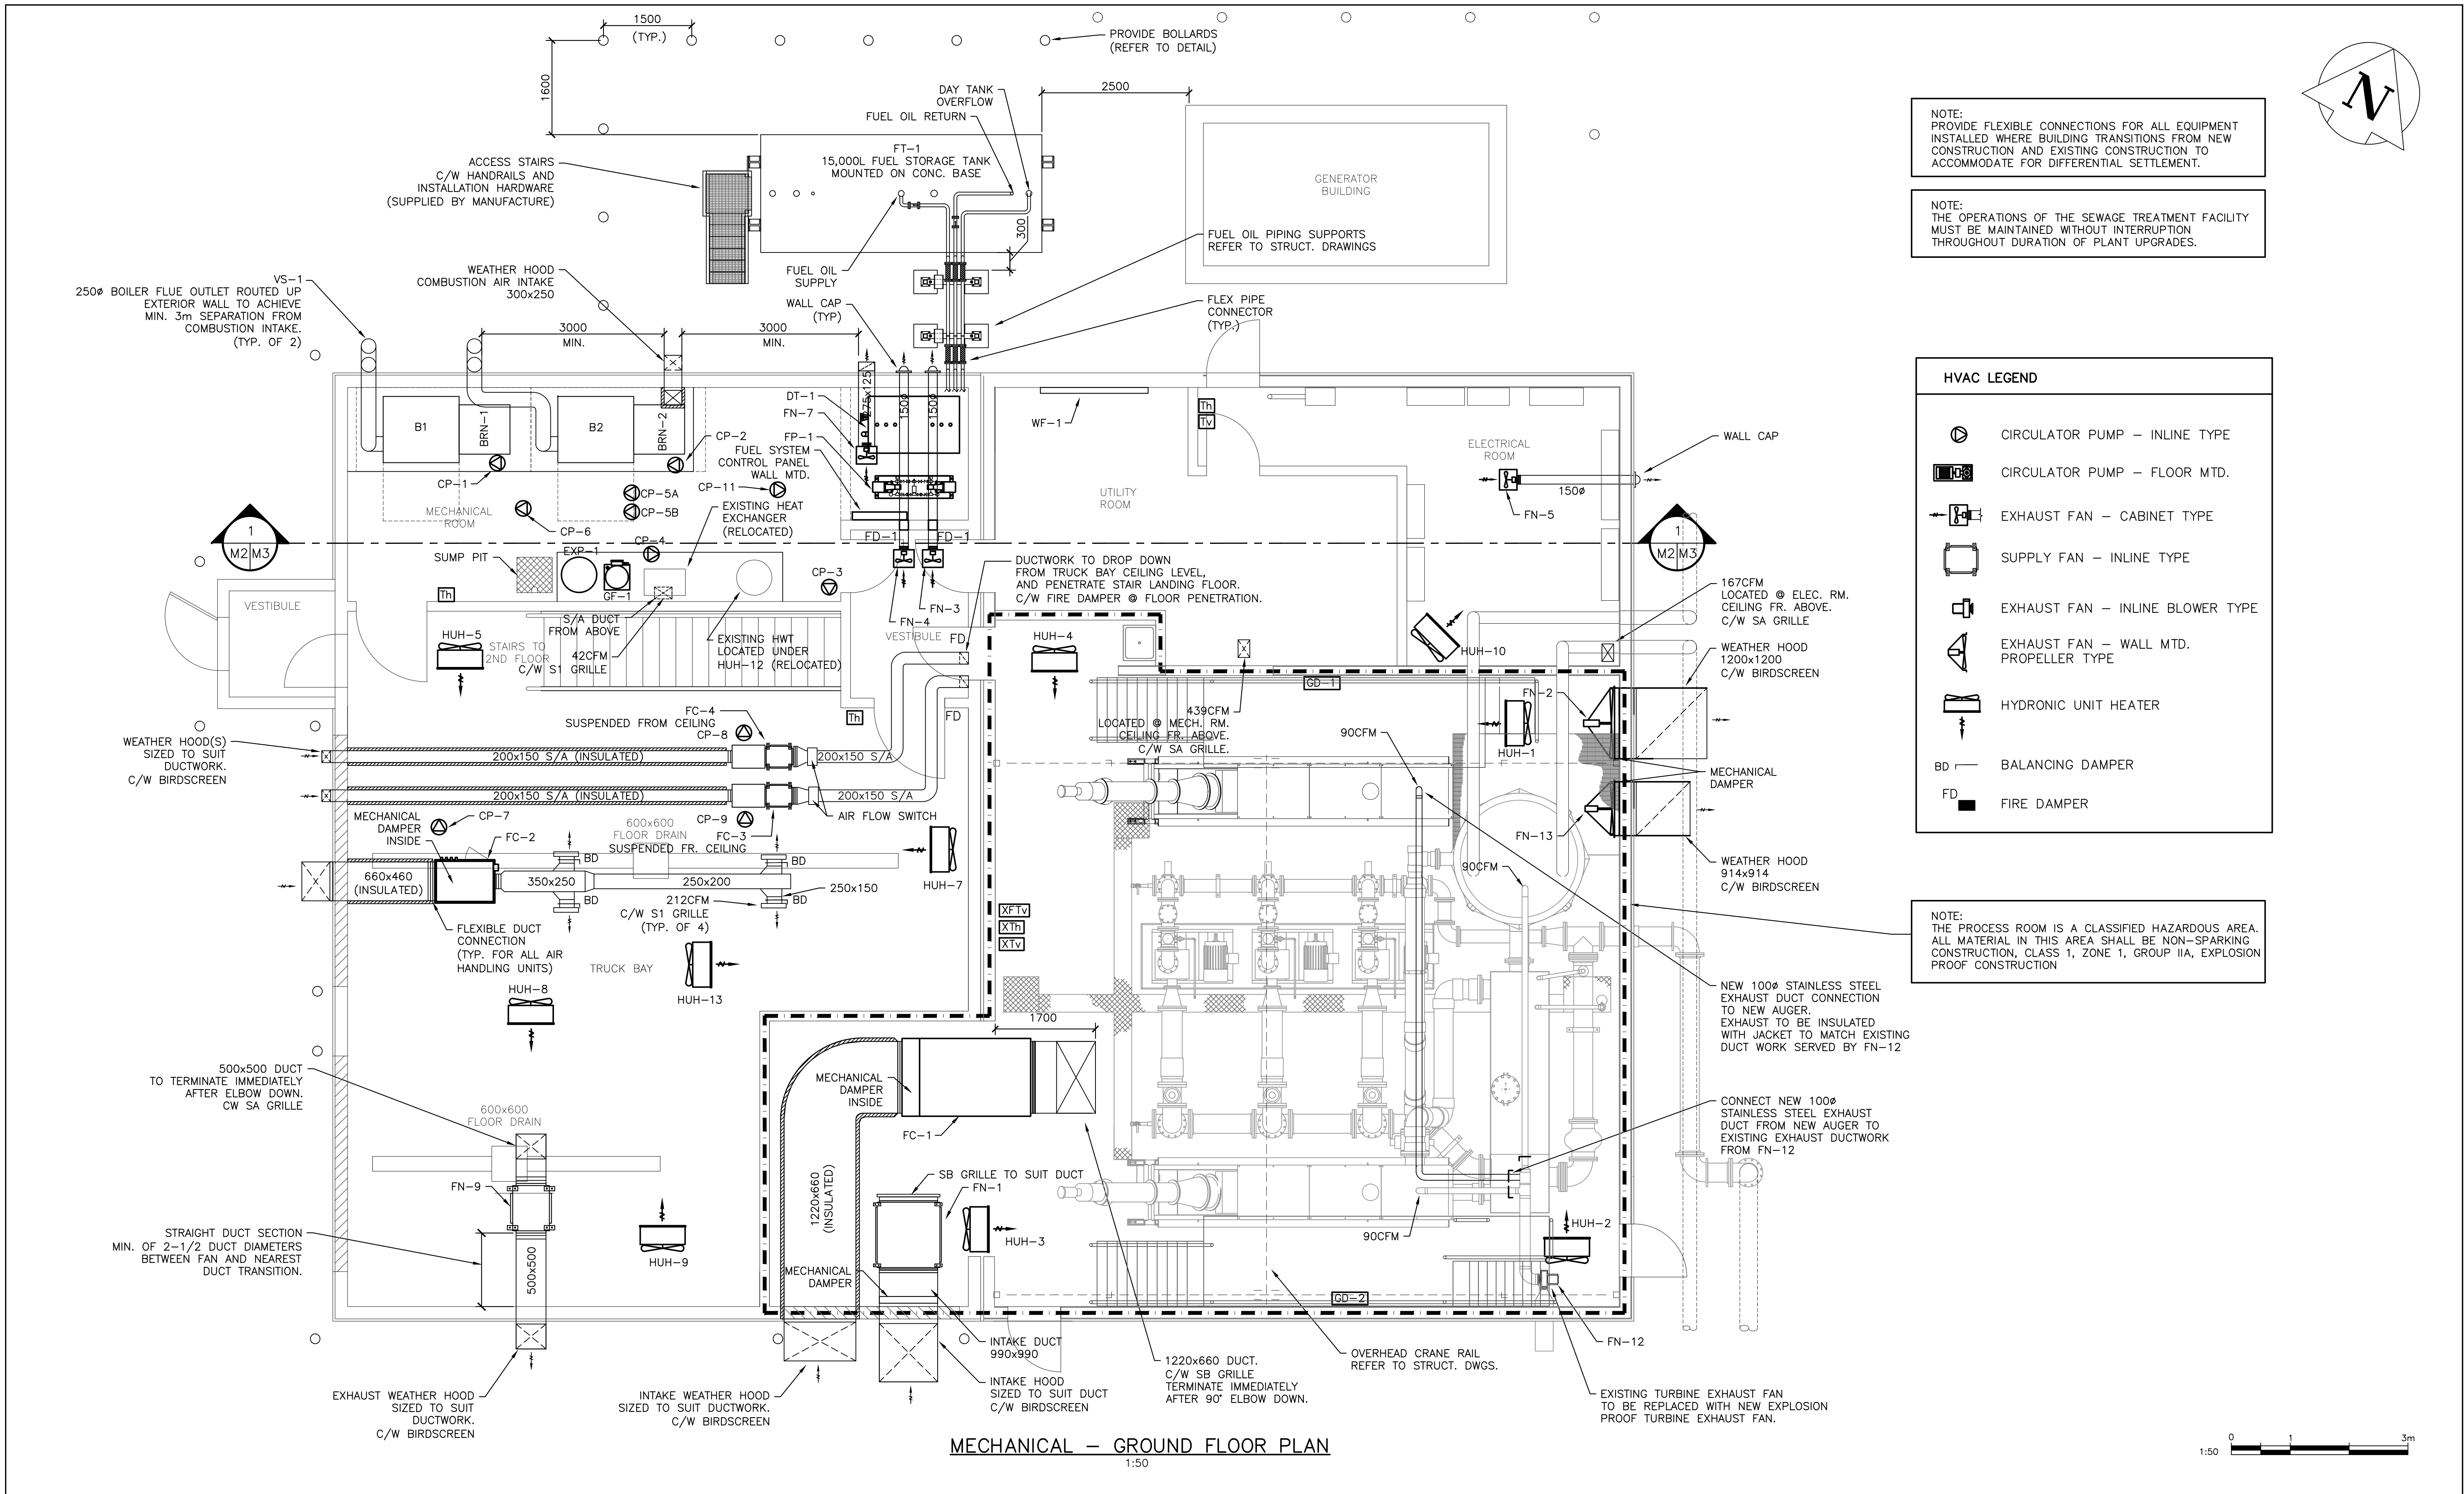



NOTE:
PROVIDE FLEXIBLE CONNECTIONS FOR ALL EQUIPMENT
INSTALLED WHERE BUILDING TRANSITIONS FROM NEW
CONSTRUCTION AND EXISTING CONSTRUCTION TO
ACCOMMODATE FOR DIFFERENTIAL SETTLEMENT.

NOTE:
THE OPERATIONS OF THE SEWAGE TREATMENT FACILITY
MUST BE MAINTAINED WITHOUT INTERRUPTION
THROUGHOUT DURATION OF PLANT UPGRADES.


HVAC LEGEND	
	CIRCULATOR PUMP - INLINE TYPE
	CIRCULATOR PUMP - FLOOR MTD.
	EXHAUST FAN - CABINET TYPE
	SUPPLY FAN - INLINE TYPE
	EXHAUST FAN - INLINE BLOWER TYPE
	EXHAUST FAN - WALL MTD. PROPELLER TYPE
	HYDRONIC UNIT HEATER
BD	BALANCING DAMPER
FD	FIRE DAMPER

NOTE:
THE PROCESS ROOM IS A CLASSIFIED HAZARDOUS AREA.
ALL MATERIAL IN THIS AREA SHALL BE NON-SPARKING
CONSTRUCTION, CLASS 1, ZONE 1, GROUP IIA, EXPLOSION
PROOF CONSTRUCTION

1. This drawing is the exclusive property of Nuna Burnside and the reproduction of any part without prior written consent of this office is strictly prohibited. 2. The contractor shall verify all dimensions, levels, and datums on site and report any discrepancies or omissions to this office prior to construction. 3. This drawing is to be read and understood in conjunction with all other plans and documents applicable to this project. 4. Do not scale the drawings.	Issue / Revision		Date	AS-BUILT DRAWING AS-BUILT INFORMATION PROVIDED BY THE GENERAL CONTRACTOR: KUDLIK CONSTRUCTION LTD. IGALUIT, NUNAVUT	<div>ORIGINAL STAMPED BY</div> <div>G. POPOWICH 05/27/13</div>	<div>BURNSIDE</div> <div>Nuna Burnside Engineering & Environmental LTD. 106B Scurfield Blvd., Winnipeg, Manitoba telephone (204) 949-7110 fax (204) 949-7111 web www.neeganburnside.com</div>	Client GOVERNMENT OF NUNAVUT COMMUNITY & GOVERNMENT SERVICES RANKIN INLET SEWAGE TREATMENT PLANT	Drawing Title GROUND FLOOR MECHANICAL HVAC LAYOUT		
	1	ISSUED FOR 66% SUBMISSION	NOVEMBER 2012					<div>Drawn By A.H.</div> <div>Scale 1: 50</div>	<div>Checked By D.Mack.</div> <div>Project No. 300031281</div>	Drawing No. M-2
	2	ISSUED FOR 99% SUBMISSION	JANUARY 2013							
	3	ISSUED FOR TENDER	FEBRUARY 2013							
	4	REVISED AS PER ADDENDUM 1 TO 4 AND ISSUED FOR CONSTRUCTION	APRIL 2013							
	5	AS-BUILT	AUGUST 2015							

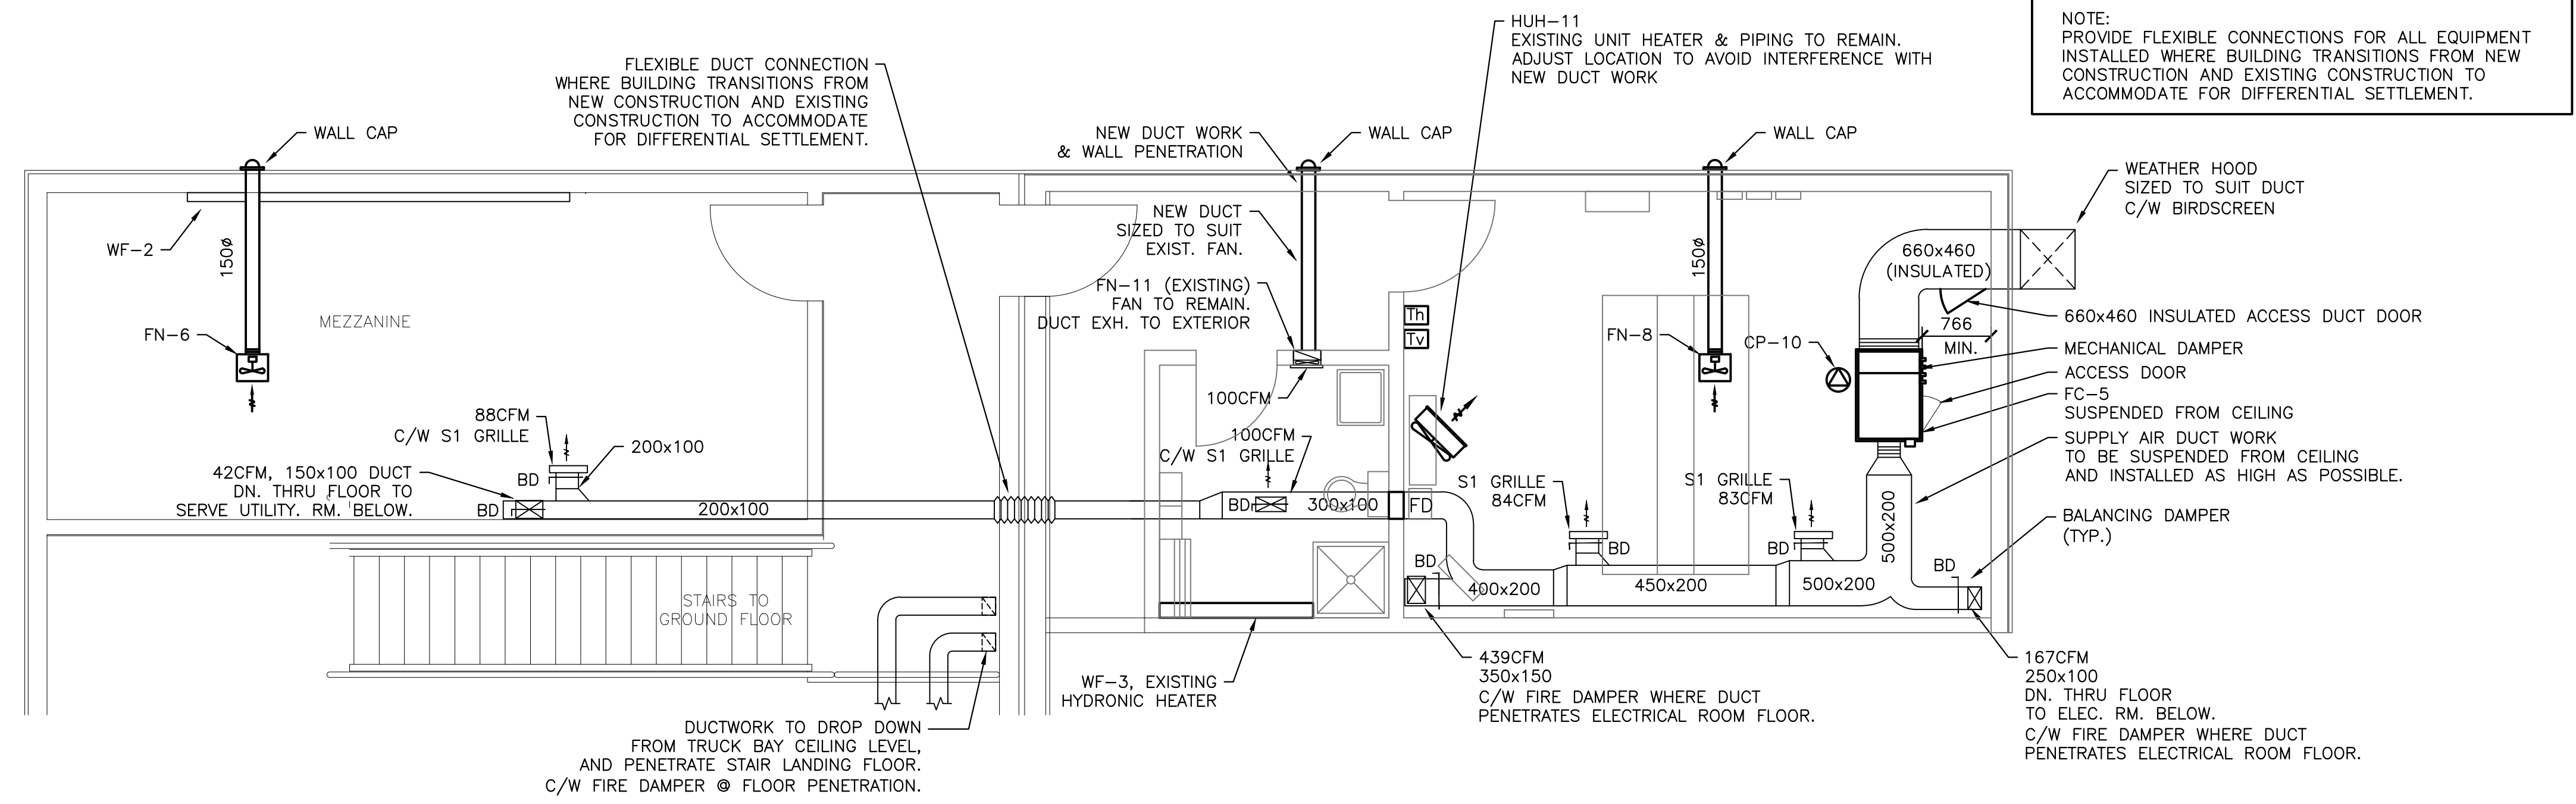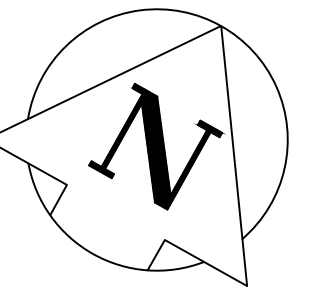

MECHANICAL - MEZZANINE FLOOR PLAN
1:50

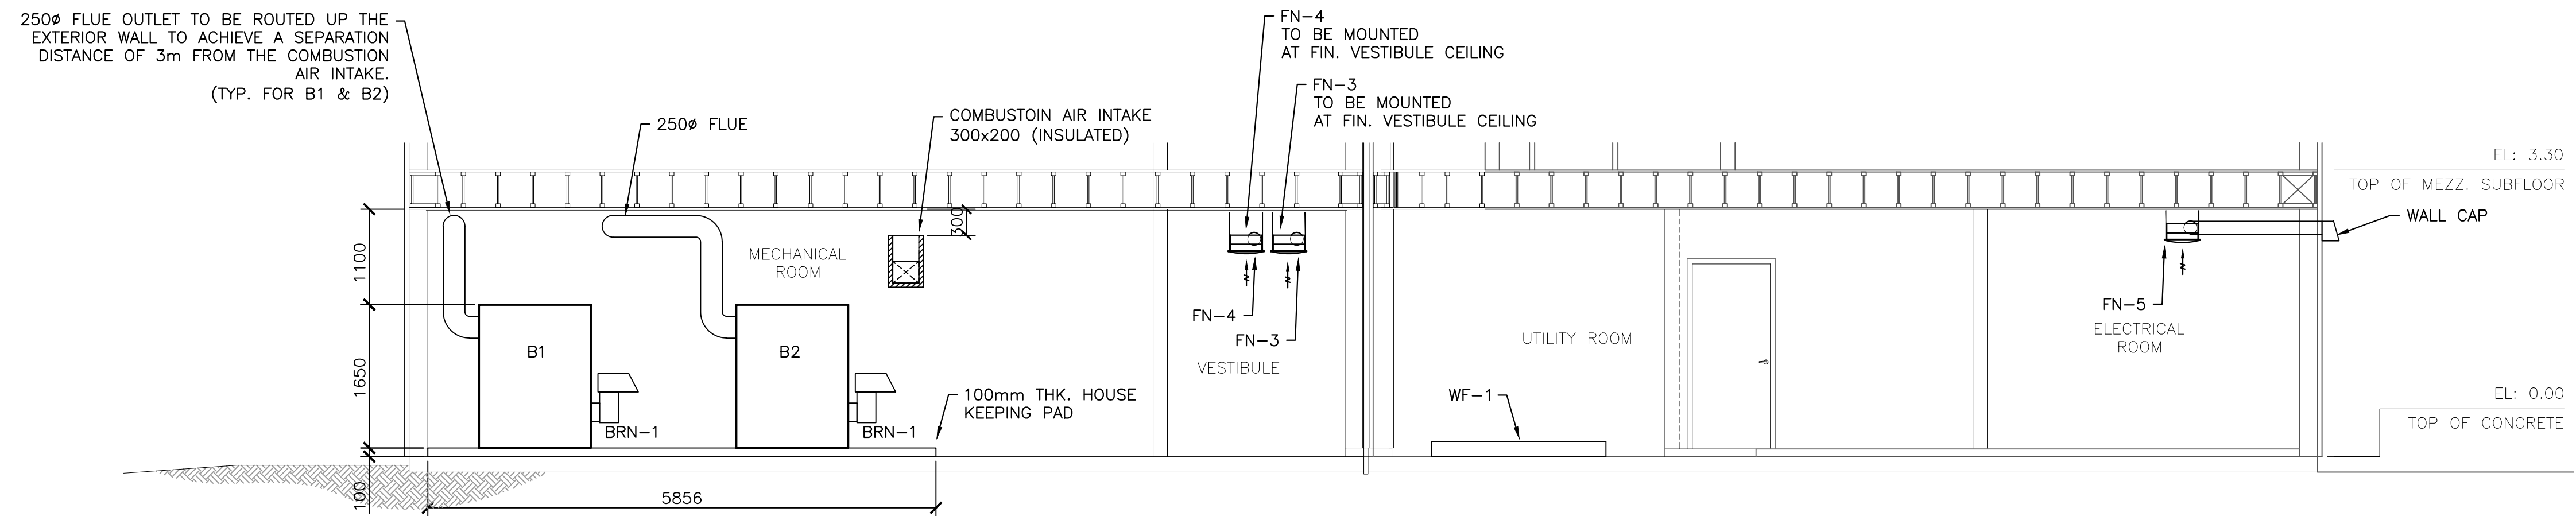

1 SECTION
M2/M3
1:50



1. This drawing is the exclusive property of Nuna Burnside and the reproduction of any part without prior written consent of this office is strictly prohibited.
2. The contractor shall verify all dimensions, levels, and datums on site and report any discrepancies or omissions to this office prior to construction.
3. This drawing is to be read and understood in conjunction with all other plans and documents applicable to this project.
4. Do not scale the drawings.

Issue / Revision	Date
1 ISSUED FOR 66% SUBMISSION	NOVEMBER 2012
2 ISSUED FOR 99% SUBMISSION	JANUARY 2013
3 ISSUED FOR TENDER	FEBRUARY 2013
4 REVISED AS PER ADDENDUM 1 TO 4 AND ISSUED FOR CONSTRUCTION	APRIL 2013
5 AS-BUILT	AUGUST 2015

AS-BUILT DRAWING
AS-BUILT INFORMATION PROVIDED BY THE
GENERAL CONTRACTOR:
KUDLIK CONSTRUCTION LTD.
IGALUIT, NUNAVUT

ORIGINAL
STAMPED
BY
G. POPOWICH
05/27/13

Burnside
Nuna Burnside Engineering & Environmental LTD.
106B Scurfield Blvd., Winnipeg, Manitoba
telephone (204) 949-7110 fax (204) 949-7111
web www.neeganburnside.com


Client
GOVERNMENT OF NUNAVUT
COMMUNITY & GOVERNMENT
SERVICES
RANKIN INLET
SEWAGE TREATMENT PLANT

Drawing Title		
SECOND FLOOR MECHANICAL HVAC LAYOUT		
Drawn By A.H.	Checked By D.Mack.	Drawing No.
Scale 1:50	Project No. 300031281	M-3

HEATING & VENTILATING EQUIPMENT LIST			HEATING & VENTILATING EQUIPMENT LIST			HEATING & VENTILATING EQUIPMENT LIST			FUEL EQUIPMENT LIST		
ITEM No.	DESCRIPTION	MF'R/MODEL	ITEM No.	DESCRIPTION	MF'R/MODEL	ITEM No.	DESCRIPTION	MF'R/MODEL	ITEM No.	DESCRIPTION	MF'R/MODEL
B-1, B-2	OIL FIRED HOT WATER BOILERS, I=B=R NET RATING OF 1,229 MBH. C/W INSULATED STEEL JACKET, LOW WATER CUTOFF, ASME 30 PSI RELIEF VALVE, DUAL HIGH LIMIT AND OPERATING CONTROL, COMBINED TEMPERATURE/PRESSURE/ALTITUDE GAUGE, BUILT IN AIR ELIMINATOR, WELL FOR TEMPERATURE SENSOR AND AIR SEPARATOR.	WEIL-MCLAIN / 88 SERIES 2 MODEL 688	FN-6 (MEZZ. RM.)	CEILING CABINET FAN CAPACITY: 49 L/s @ 6.3mm ESP (104 CFM @ 0.25" ESP) ELECTRICS: 120V / 1 PH / 60 HZ; 66 W, 0.7 A. C/W FACTORY WIRED SPEED CONTROL, BACKDRAFT DAMPER, VIBRATION ISOLATION MOUNTING HARDWARE.	COOK / GC-144	AFS-1, 2, 3 & 4	FLOWLINE THERMO FLO	AX1X	FT-1	ABOVE GROUND DOUBLE WALL OUTDOOR FUEL STORAGE TANK FOR BOILERS. 15,000 L (3300 IMP. GAL.) CAPACITY C/W END SUPPORTS, VM-3 TANK MOUNTED VACUUM GAUGE WITH COVER, OVERFILL SPILL COLLECTOR, EMERGENCY VENT, NORMAL VENT, DIPSTICK AND GAUGE CHART, ACCESS STAIRS WITH HANDRAIL AND PLATFORM, BLAST FINISH WITH ONE COAT OF PRIMER AND ONE COAT OF WHITE ENAMEL COATINGS, REMOTE INTERSTITIAL VACUUM MONITORING AND HIGH / LOW LEVEL ALARM SWITCHES TO SUIT TANK.	CLEMMER / ITEM 1 PER QUOTE CCA-17563-12.DOC WITH ADDITIONAL LEVEL SWITCHES.
BRN-1, BRN-2	FORCED DRAFT OIL BURNERS FOR WEIL MCLAIN 88 SER. 2 MODEL 688 BOILERS. SET UP FOR ON - OFF OPERATION. C/W OIL PUMPS, BURNER CONTROLS AND ALARM PANEL THAT ACCEPTS CONTROL SIGNAL FROM BOILER CONTROL SYSTEM. ELECTRICS: 208 V / 3 PH / 60 HZ; 0.75 HP	RIELLO / RL 50/2	FN-7 (DELETED)	DELETED	DELETED	WFS-1, 2.	WATER FLOW SWITCHES, PADDLE TYPE SENSITIVE TYPE SIZED TO SUIT PIPE SIZE. SWITCH RATING: 208 V AC / 1 HP (8.8 AMPS)	JOHNSON CONTROLS/ F61MD SERIES	DT-1	ABOVEGROUND DOUBLE WALL INDOOR FUEL OIL DAY TANK FOR BOILERS. 1150 L CAPACITY (250 IMP. GAL.) BUILT AND LABELLED TO ULC S 602 BLAST FINISHED AND BLUE EPOXY COATED C/W SADDLES, INTERSTITIAL VENT CONNECTION, INTERSTITIAL VACUUM GAUGE WITH SWITCH, RPCA-2 REMOTE MONITOR AND 4 STATION LEVEL SWITCH TO SUIT TANK.	CLEMMER / ITEM 2 PER QUOTE CCA-17563-12.DOC WITH ADDITIONAL LEVEL SWITCHES.
VS-1, VS-2	ENGINEERED MODULAR VENT STACK FOR BOILERS. ULC LISTED. C/W 0.64MM THICK ALUMINIZED STEEL OUTER SHELL, 0.95MM THICK TYPE 304 STAINLESS STEEL INNER LINER, AND ALL REQUIRED ACCESSORIES TO COMPLETE VENTING SYSTEM.	VAN PACKER / DW PLUS SYSTEM.	FN-8 (UPPER ELEC. RM.)	CEILING CABINET FAN CAPACITY: 79 L/s @ 6.3mm ESP (167 CFM @ 0.25" ESP) ELECTRICS: 120V / 1 PH / 60 HZ; 123 W, 1.3 A. C/W FACTORY WIRED SPEED CONTROL, BACKDRAFT DAMPER, VIBRATION ISOLATION MOUNTING HARDWARE.	COOK / GC-164				FP-1	PACKAGED DUPLEX FUEL OIL PUMPING SYSTEM WITH CONTROLLER. C/W DUPLEX PUMPS, SUCTION STRAINER, RELIEF VALVES, ISOLATION VALVES, LIQUID FILLED PRESSURE GAUGES, ULC / CSA LISTED ALBANY DUCON SERIES DUPLEX FUEL MANAGEMENT CONTROL CENTER IN NEMA 12 ENCLOSURE AND ALL ASSOCIATED ACCESSORIES AND PIPING. SYSTEM CAPACITY: 7.6 L/M (2 USGPM) OF #2 HEATING OIL. ELECTRICAL: 208V / 3 PH / 60 HZ; 1/2 HP SYSTEM IS TO PROVIDE DRY CONTACT ALARM OUTPUTS SUITABLE FOR INTEGRATION INTO SCADA CONTROLLER FOR MAIN TANK LOW FUEL, DAY TANK HIGH AND LOW LEVEL ALARM.	ALBANY PUMP / FODUP/03GC/BS
BC-1	BOILER CONTROLLER CONTROLLER TO BE CAPABLE OF CONTROLLING 2 BOILERS, DHW SYSTEM CIRCULATOR AS WELL AS 2 MAIN CIRCULATORS. C/W THE FOLLOWING FEATURES: OUTDOOR TEMPERATURE RESET, OUTDOOR TEMPERATURE SENSOR, ON-OFF BOILER CONTROL, PRIMARY AND SECONDARY PUMP CONTROL, DHW PUMP OPERATION, ADJUSTABLE WARM WEATHER SHUTDOWN, PUMP EXERCISING ROUTINE, BOILER EQUAL RUN TIME ROTATION, EQUAL RUN TIME ROTATION FOR TWO REDUNDANT SECONDARY CIRCULATORS, FLOW OR COMBUSTION AIR PROOF.	TEKMAR / A 274	FN-9 (TRUCK BAY)	INLINE EXHAUST FAN. CAPACITY: 382 L/s @ 38.1mm ESP (810CFM @ 1.5" ESP) ELECTRICS: 120 V / 1 PH / 60 HZ; 1/2 HP. C/W VIBRATION ISOLATION MOUNTING HARDWARE, BIRDSCREEN INSTALLED IN DUCT AT FAN INLET.	COOK / 150 SQN SERIES	SA GRILLES	ALUMINUM GRILLES SIZED TO SUIT SERVICE DUCT DIMENSIONS. C/W 3/4" SPACING, W/OPOSED BLADE DAMPER.	NAILOR 51DH-O			
BC-2	HYDRONIC MIXING CONTROLLER. CONTROLLER TO ACCEPT TEMPERATURE INPUT FROM 10 K OHM THERMISTOR SENSOR. CONTROLLER TO OUTPUT VFD CONTROL OF CIRCULATORS UP TO 1/6 HP.	TEKMAR / A 361	FN-10 (UTILITY RM.) (DELETED)	DELETED	DELETED	SB GRILLES	HIGH CAPACITY EXTRUDED ALUMINUM GRILLE SIZED TO SUIT DUCT DIMENSIONS. C/W EXTRUDED ALUMINUM AIRFOIL BLADES ON 3" CENTERS, HORIZONTAL FRONT & VERTICAL REAR BLADES WITH OPPOSED BLADE DAMPER.	NAILOR 813DH-O			
CP-1, CP-2	POWER: 3PH X 208-230V	GRUNDFOS / UPS-10040F	FN-11 (EXISTING (WASHROOM))	EXISTING FAN IN WASHROOM AIRFLOW: 52 L/s @ 2.5mm ESP (110 CFM @ 0.1" ESP) ELECTRICS: 120 V / 1 PH / 60 HZ; 1.3 A.	EXISTING BROAN / 676 SERIES.	HC-1	ONE STAGE SETPOINT CONTROL. CONTROLLER TO ACCEPT TEMPERATURE INPUT FROM OUTDOOR SENSOR. CONTROLLER TO OUTPUT ON - OFF SIGNAL TO CONTROL WARM WEATHER SHUTDOWN ON EQUIPMENT INDICATED ON DRAWING.	TEKMAR / A 150			
CP-3 (EXISTING)	EXISTING POTABLE HOT WATER CIRCULATOR	EXISTING B & G / SSF-22 SERIES	FN-12 (PROCESS TANK)	EXPLOSION PROOF HIGH PRESSURE EXHAUST FAN AIRFLOW: 140 L/s @ 25.4mm ESP (297 CFM @ 0.5" ESP). ELECTRICS: 120V / 1 PH / 60 HZ; 1 HP. C/W NON-SPARKING CONSTRUCTION TO AMCA A, EXPLOSION PROOF MOTOR, EISENHEISS OR SIMILAR ANTI-CORROSION FINISH ON INTERIOR AND EXTERIOR SURFACES OF FAN HOUSING AND WHEEL. ARRANGEMENT 9.	EXPLOSION PROOF REVERSEOMATIC / AF-8-4	ODS-1	OUTDOOR SENSOR FOR USE WITH TEKMAR 274 AND 150 CONTROLS	TEKMAR / OUTDOOR SENSOR 070			
CP-4 (EXISTING)	EXISTING CIRCULATOR FOR 60% PROPYLENE GLYCOL SOLUTION TO HEAT EXCHANGER.	EXISTING	FN-13 (PROCESS RM)	EXPLOSION PROOF TWO SPEED, WALL MOUNTED EXHAUST FAN. CAPACITY, LOW SPEED: 755 L/s @ 13mm ESP (1,600 CFM @ 0.5" ESP). CAPACITY, HIGH SPEED: 1510 L/s @ 13mm ESP (3,200 CFM @ 0.5 ESP). ELECTRICS: 208 V / 3 PH / 60 HZ; 1 HP. C/W VFD TO PROVIDE 2 SPEED OPERATION INSTALLED OUTSIDE OF CLASSIFIED SPACE, VIBRATION ISOLATING MOUNTING HDWE, NON-SPARKING CONSTRUCTION TYPE AMCA-A, BIRD SCREEN, EXPLOSION PROOF MOTOR.	EXPLOSION PROOF COOK / 24A11 SERIES	BS-1	BOILER SUPPLY SENSOR FOR USE WITH TEKMAR 274 CONTROL	TEKMAR / OUTDOOR SENSOR 082			
CP-5A CP-5B	POWER: 1PH X 230V	GRUNDFOS / UPS-50-160F	FC-1 (PROCESS RM.)	TRANS PERFORMANCE CLIMATE CHANGER	A1	GS-1	GENERAL USE SENSOR FOR USE WITH TEKMAR 274 AND 361 CONTROLS	TEKMAR / SENSOR 071			
CP-6	POWER: 1PH X 115V	GRUNDFOS / UPS-43-100F	FC-2 (TRUCK BAY)	TRANS PERFORMANCE CLIMATE CHANGER	A2	Th-1	HYDRONIC SYSTEM THERMOMETER. RANGE: -1 TO 115 DEG. C (30 TO 240 DEG. F) SCALE SIZE: 14 CM (5-1/2" LONG.) STRAIGHT OR RIGHT ANGLE TO SUIT APPLICATION C/W 13MM (1/2") BRASS THERMOWELL	TRERICE / HT30 SERIES AND HT31 SERIES TO SUIT APPLICATION			
CP-7	POWER: 1PH X 115V	GRUNDFOS / UPS-15-58FC				PG-1	HYDRONIC SYSTEM PRESSURE GAUGE. INDUSTRIAL, LIQUID FILLED PRESSURE GAUGE WITH STAINLESS STEEL CASE, CRIMPED RING AND WETTED PARTS. DIAL SIZE: 100MM (4") RANGE: 0 TO 207 KPA (0 TO 30 PSI) STRAIGHT OR RIGHT ANGLE ARRANGMENT TO SUIT APPLICATION	TRERICE / 700 SERIES TO SUIT APPLICATION.			
CP-8, CP-9	POWER: 1PH X 115V	GRUNDFOS / UPS-15-58FC				STR-1	WYE PATTERN BRONZE STRAINERS SIZE TO SUIT PIPE SIZE. C/W STANDARD SCREEN AND SOLID RETAINER CAP WITH GASKET	WATTS / 777 SERIES			
CP-10	POWER: 1PH X 115V	GRUNDFOS / UPS-43-100F	FC-3, FC-4 (SERVES VESTIBULE)	REDUNDANT INLINE FAN UNITS WITH HYDRONIC HEATING COILS & FLOW PROVING SWITCHES FOR AIR AND WATER. AIRFLOW: 80 L/S @ 13MM ESP (170 CFM @ 0.5" ESP) ELECTRICS: 120V / 1 PH / 60 HZ; HP 1/6. C/W DUCT MOUNTED HYDRONIC COILS EAT: -42°C (-43.6°F) LAT: 32°C (89°F) EWT: 82°C (180°F) FLUID FLOW: 2.8 USGPM; HEAD: 2.5 FT. H2O C/W AIRFLOW AND WATERFLOW PROVING SWITCHES, VIBRATION ISOLATING MOUNTING HARDWARE, BIRD SCREEN.	LAUREN COOK / 60SQN-B WITH COIL MCQUAY / 5B51402 SERIES						
CP-11	POWER: 1PH X 115V	GRUNDFOS / UPS-15-58FC	FC-5 (2ND FLR. ELEC. RM.)	TRANS PERFORMANCE CLIMATE CHANGER	A3	WF-1 (UTILITY RM.)	FIN TUBE BASEBOARD HEATER LENGTH: 6 FT. C/W 1" DIA CUAL TUBE, 3-1/4" SQUARE FINS SPACED AT 40 FINS PER FOOT, ONE TIER.	STERLING VERSALINE/ JVA-S11 ENCL. C/W C34 TYPE ELEMENT			
HUH-1, 2, 3, 4	EXPLOSION PROOF HYDRONIC UNIT HEATERS, HORIZONTAL TYPE, H5 SIZE. RATED CAPACITY: 57.3 MBH OUTPUT EWT: 180°F. AIRFLOW: 585 L/S (1240 CFM) PER UNIT. FLOW: 14.8 L/M (3.9 USGPM) OF 60% PROPYLENE GLYCOL SOLUTION. HEAD: 0.1 M (0.3 FT.) H2O ELECTRICS: 115V / 1PH / 60 HZ; AMPS = 3.0; 1/6 HP. C/W NON-SPARKING CONSTRUCTION, EXPLOSION PROOF MOTORS.	EXPLOSION PROOF ENG AIR / H5 SERIES	WF-2 (MEZZ. RM.)	FIN TUBE BASEBOARD HEATER LENGTH: 13 FT. C/W 1" DIA CUAL TUBE, 3-1/4" SQUARE FINS SPACED AT 40 FINS PER FOOT, ONE TIER.	STERLING VERSALINE/ JVA-S11 ENCL. C/W C34 TYPE ELEMENT	WF-3 (WASH RM.) (EXISTING)	EXISTING - LOCATED IN WASHROOM	EXISTING			
HUH-5, 6, 7, 8	EXISTING HYDRONIC UNIT HEATERS, HORIZONTAL TYPE, H4 SIZE RELOCATED FROM PROCESS ROOM. RATED CAPACITY: 56.8 MBH OUTPUT AIRFLOW:472 L/S (1000 CFM) EWT: 180°F. WATER FLOW: 32.6 L/M (8.6 USGPM) HEAD: 0.2M (0.7 FT.) H2O ELECTRICS: 115V / 1PH / 60 HZ; AMPS = 3.0; 1/12 HP.	EXISTING UNITS, RELOCATED FROM PROCESS ROOM.	XTh	EXPLOSION PROOF HEATING THERMOSTAT	EXPLOSION PROOF BY DIV. 26.	GD-1 GD-2	FLAMMABLE & TOXIC GAS DETECTORS	EXPLOSION PROOF BY DIV. 26.			
HUH-9 & 13	HYDRONIC UNIT HEATERS, HORIZONTAL TYPE, H5 SIZE, STANDARD DIFFUSERS. RATED CAPACITY: 57.3 MBH OUTPUT AIRFLOW:585 L/S (1240 CFM) EWT: 180°F. WATER FLOW: 14.8 L/M (3.9 USGPM) HEAD: 0.1M (0.3 FT.) H2O ELECTRICS: 115V / 1PH / 60 HZ; AMPS = 3.0; 1/6 HP.	ENG AIR / H5 SERIES	XTv	EXPLOSION PROOF VENTILATION THERMOSTAT.	EXPLOSION PROOF BY DIV. 26.	GF-1	POLY PROPYLENE GLYCOL FEEDER SYSTEM. C/W 50 US GAL TANK IN STEEL FRAME, CONTROL SYSTEM, GEAR PUMP, INDICATOR LIGHTS & AUDIBLE LOW LEVEL ALARM AND SUCTION & DISCHARGE ASSEMBLIES. ELECTRICS: 120 V / 1 PH / 60 HZ; 1/3 HP	NEPTUNE / G-50-1A			
HUH-10, 11, 12	EXISTING HYDRONIC UNIT HEATERS, HORIZONTAL TYPE, RELOCATED AS NOTED ON DRAWINGS.	EXISTING UNITS, RELOCATED AS NOTED ON DRAWINGS.	XFTv	EXPLOSION PROOF VENTILATION FREEZE STAT. SET TO SHUT OFF HIGH RATE VENTILATION AT 5°C (41°F)	EXPLOSION PROOF BY DIV. 26.	EXP-1	BLADDER TYPE EXPANSION TANK CARBON STEEL SHELL, HEAVY DUTY BUTYL/EPDM RUBBER DIAPHRAGM RED OXIDE PRIMER FINISH. C/W AIR VENTS.	AMTROL / EXTROL AX80(V)			
FN-1 (PROCESS RM)	EXPLOSION PROOF INLINE SUPPLY FAN CAPACITY: 6,041 L/s @ 12.7 mm ESP (12,800 CFM @ 0.5" ESP) ELECTRICS: 208 V / 3PH / 60 HZ; 5 HP C/W VIBRATION ISOLATION MOUNTING HDWE, NON-SPARKING CONSTRUCTION TYPE AMCA-A, SAFETY SCREEN, EXPLOSION PROOF MOTOR, EXTENDED LUB LINES, REINFORCED WHEEL.	EXPLOSION PROOF COOK / 270SQIB SERIES	Th	HEATING THERMOSTAT	BY DIV. 26.						
FN-2 (PROCESS RM)	EXPLOSION PROOF WALL MOUNTED EXHAUST FAN. CAPACITY: 6,135 L/s @ 38.1mm ESP (13,000 CFM @ 0.5" ESP) ELECTRICS: 208 V / 3 PH / 60 HZ; 3 HP. C/W VIBRATION ISOLATING MOUNTING HDWE, NON-SPARKING CONSTRUCTION TYPE AMCA-A, BIRD SCREEN, EXPLOSION PROOF MOTOR.	EXPLOSION PROOF COOK / 36EWB SERIES	Tv	VENTILATION THERMOSTAT.	BY DIV. 26.						
FN-3 (VESTIBULE)	CEILING CABINET FAN CAPACITY: 80 L/s @ 6.3mm ESP. (170 CFM @ 0.25" ESP) ELECTRICS: 120V / 1 PH / 60 HZ; 123 W, 1.3 A. C/W FACTORY WIRED SPEED CONTROL, BACKDRAFT DAMPER, VIBRATION ISOLATION MOUNTING HARDWARE.	COOK / GC-164	MTh	MECHANICAL HEATING THERMOSTATS MECHANICAL THERMOSTATIC RADIATOR VALVES C/W STANDARD VALVE BODY, REMOTE THERMOSTATIC HEAD WITH USER ADJUSTMENT AND REGULUX LOCKSHIELD DRAIN/FILL FITTING.	HEIMEIER / STANDARD BODY C/W TYPE F REMOTE HEAD AND REGULUX LOCKSHIELD.						
FN-4 (VESTIBULE)	CEILING CABINET FAN CAPACITY: 80 L/s @ 6.3mm ESP (170 CFM @ 0.25" ESP) ELECTRICS: 120V / 1 PH / 60 HZ; 123 W, 1.3 A. C/W FACTORY WIRED SPEED CONTROL, BACKDRAFT DAMPER, VIBRATION ISOLATION MOUNTING HARDWARE.	COOK / GC-164									
FN-5 (LOWER ELEC. RM.)	CEILING CABINET FAN CAPACITY: 79 L/s @ 6.3mm ESP (167 CFM @ 0.25" ESP) ELECTRICS: 120V / 1 PH / 60 HZ; 123 W, 1.3 A. C/W FACTORY WIRED SPEED CONTROL, BACKDRAFT DAMPER, VIBRATION ISOLATION MOUNTING HARDWARE.	COOK / GC-164									
1. This drawing is the exclusive property of Nuna Burnside and the reproduction of any part without prior written consent of this office is strictly prohibited. 2. The contractor shall verify all dimensions, levels, and datums on site and report any discrepancies or omissions to this office prior to construction. 3. This drawing is to be read and understood in conjunction with all other plans and documents applicable to this project. 4. Do not scale the drawings.			AS-BUILT DRAWING AS-BUILT INFORMATION PROVIDED BY THE GENERAL CONTRACTOR:			Nuna Burnside Engineering & Environmental LTD. 106B Scurfield Blvd., Winnipeg, Manitoba telephone (204) 949-7110 fax (204) 949-7111 web www.neeganburnside.com			Client GOVERNMENT OF NUNAVUT COMMUNITY & GOVERNMENT SERVICES RANKIN INLET SEWAGE TREATMENT PLANT		
			ORIGINAL STAMPED BY G. POPOWICH 05/27/13			Drawing Title MECHANICAL EQUIPMENT SCHEDULE & NOTES			Drawing No. M-4		
						Drawn By A.H. Scale NTS			Checked By D.Mack. Project No. 300031281		

NOTE:
THE OPERATIONS OF THE SEWAGE TREATMENT FACILITY
MUST BE MAINTAINED WITHOUT INTERRUPTION
THROUGHOUT DURATION OF PLANT UPGRADES.

NOTE:
ONLY HYDRONIC HEATING
EQUIPMENT SHOWN FOR CLARITY.

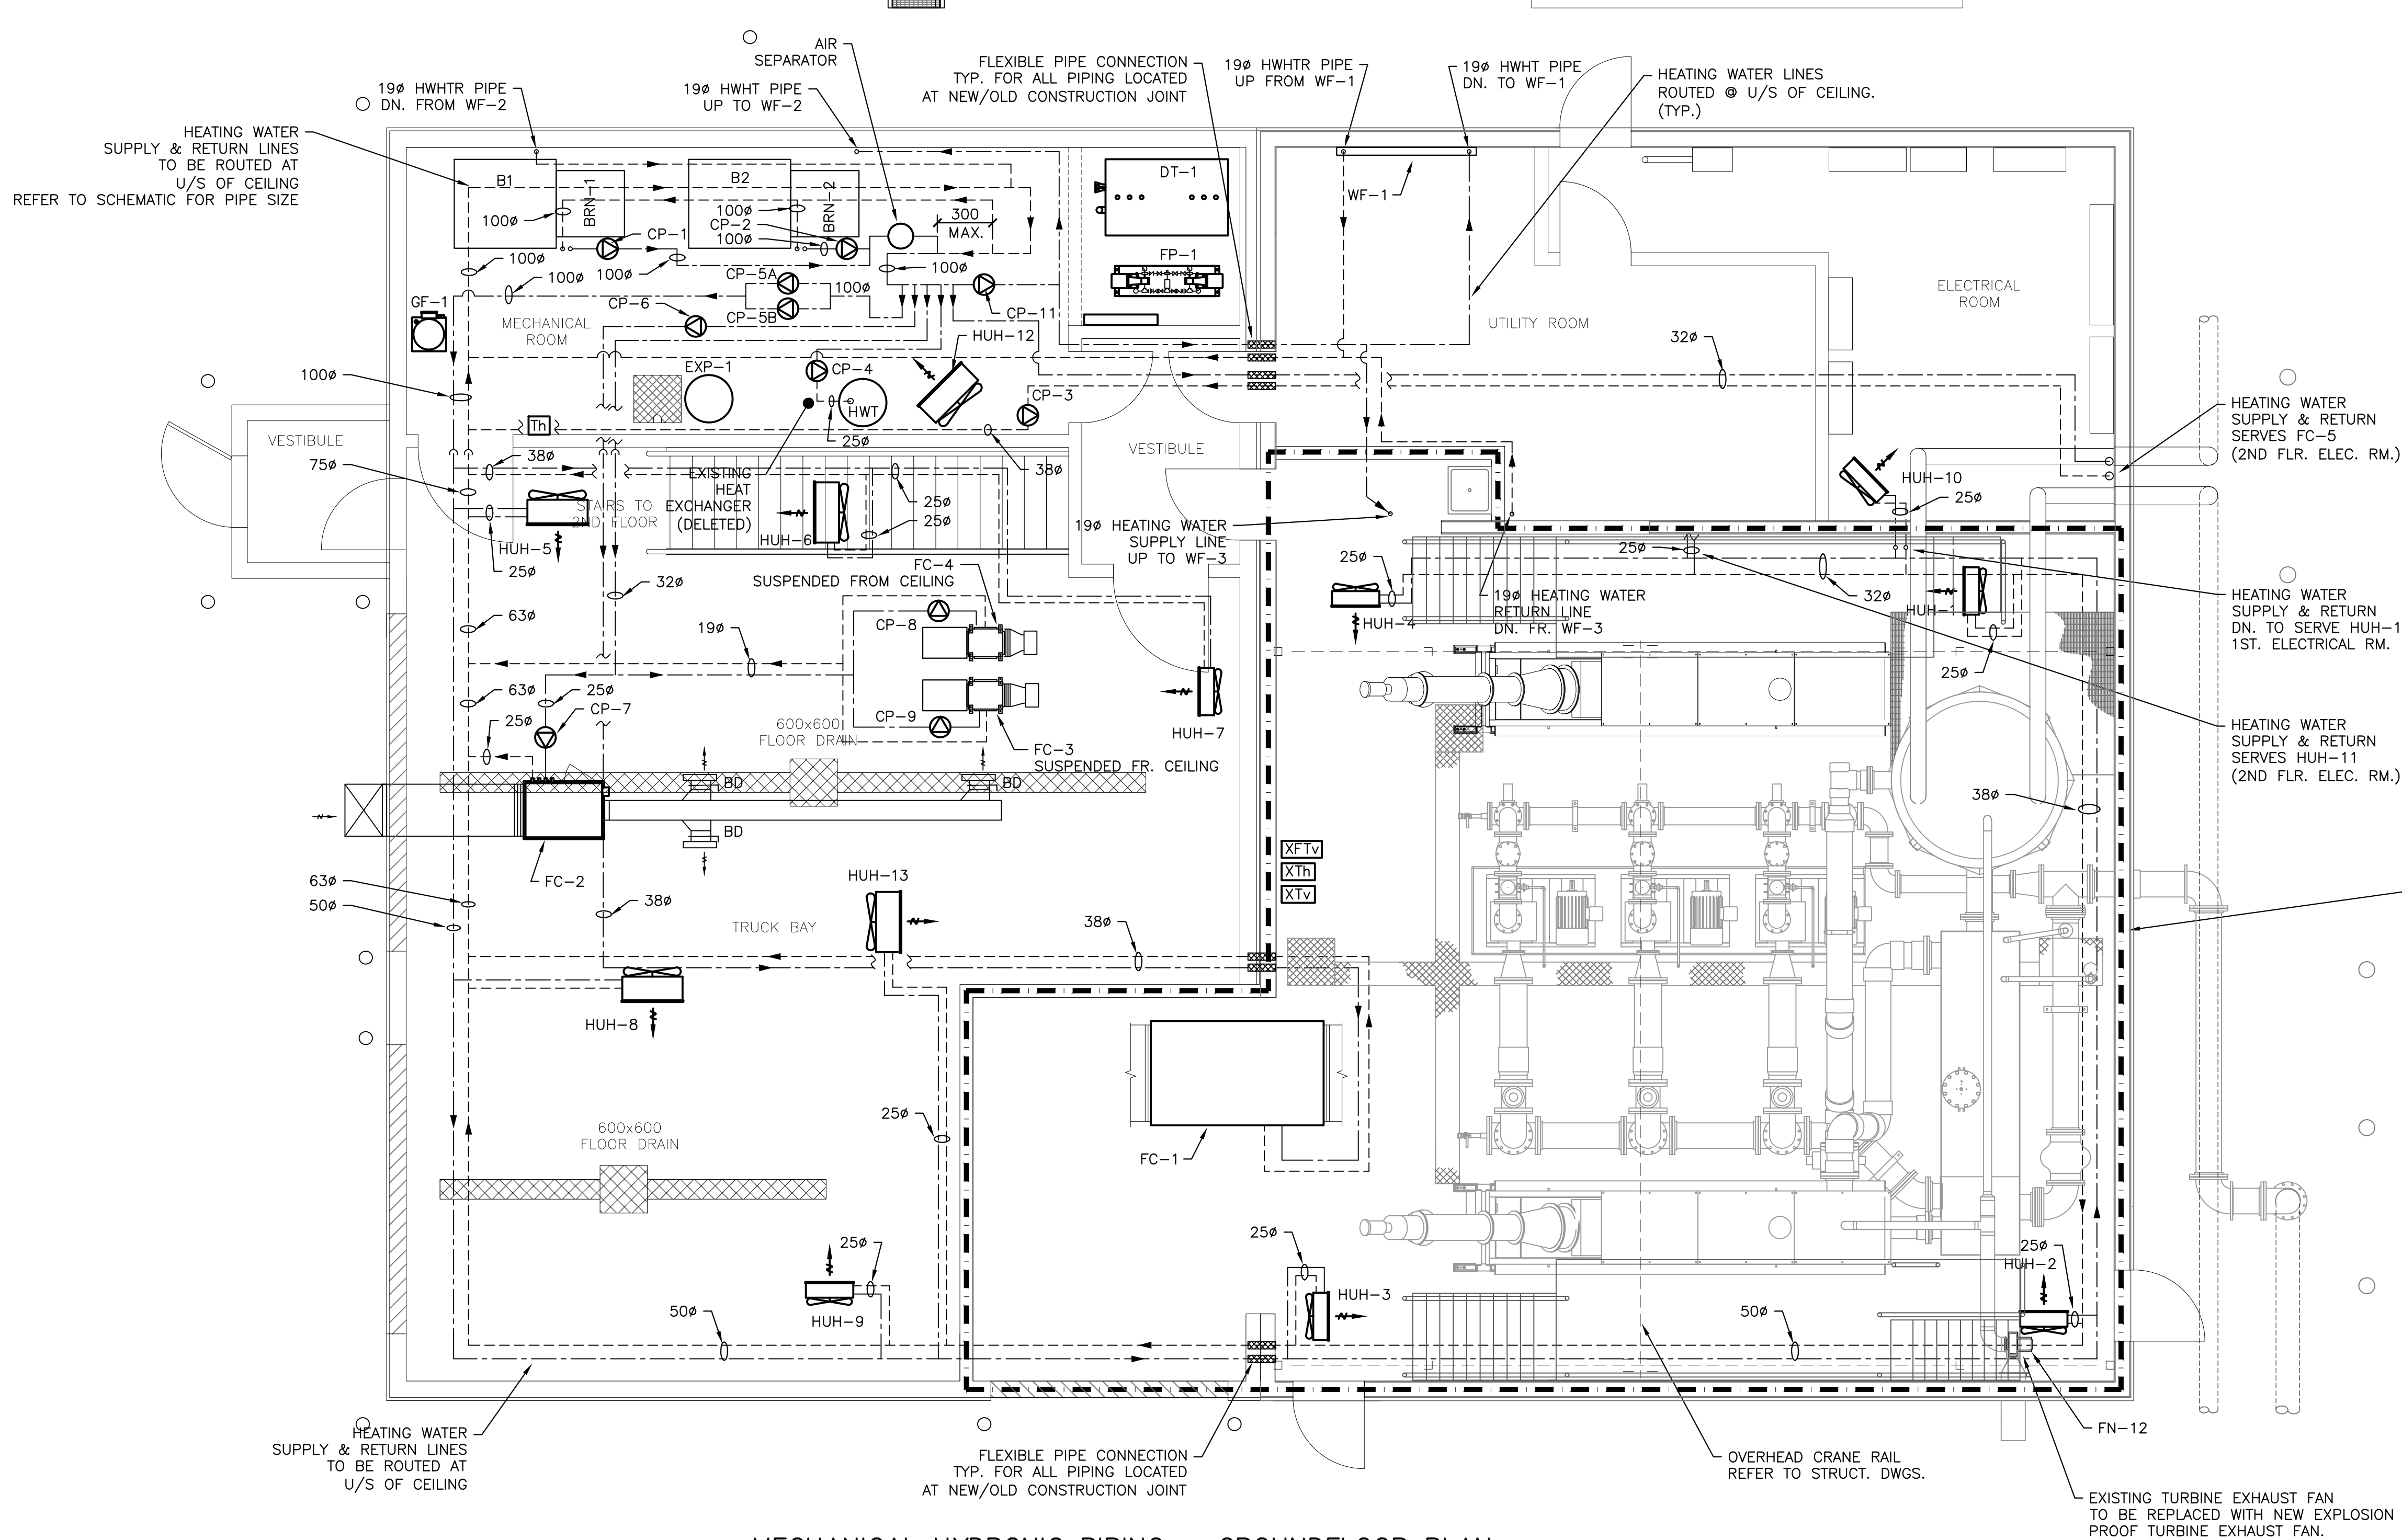

HYDRONIC PIPE LEGEND	
	HYDRONIC SUPPLY PIPE
	HYDRONIC RETURN PIPE

NOTE:
PROVIDE FLEXIBLE CONNECTIONS FOR ALL EQUIPMENT
INSTALLED WHERE BUILDING TRANSITIONS FROM NEW
CONSTRUCTION AND EXISTING CONSTRUCTION TO
ACCOMMODATE FOR DIFFERENTIAL SETTLEMENT.

NOTE:
THE PROCESS ROOM IS A CLASSIFIED HAZARDOUS AREA.
ALL MATERIAL IN THIS AREA SHALL BE NON-SPARKING
CONSTRUCTION, CLASS 1, ZONE 1, GROUP IIA, EXPLOSION
PROOF CONSTRUCTION

MECHANICAL HYDRONIC PIPING - GROUND FLOOR PLAN
1:50

1. This drawing is the exclusive property of Nuna Burnside and the reproduction of any part without prior written consent of this office is strictly prohibited.
2. The contractor shall verify all dimensions, levels, and datums on site and report any discrepancies or omissions to this office prior to construction.
3. This drawing is to be read and understood in conjunction with all other plans and documents applicable to this project.
4. Do not scale the drawings.

Issue / Revision	Date
1 ISSUED FOR 99% SUBMISSION	JANUARY 2013
2 ISSUED FOR TENDER	FEBRUARY 2013
3 REVISED AS PER ADDENDUM 1 TO 4 AND ISSUED FOR CONSTRUCTION	APRIL 2013
4 AS-BUILT	AUGUST 2015

AS-BUILT DRAWING
AS-BUILT INFORMATION PROVIDED BY THE
GENERAL CONTRACTOR:
KUDLIK CONSTRUCTION LTD.
IGALUIT, NUNAVUT

ORIGINAL
STAMPED
BY
G. POPOWICH
05/27/13

Burnside
Nuna Burnside Engineering & Environmental LTD.
106B Scurfield Blvd., Winnipeg, Manitoba
telephone (204) 949-7110 fax (204) 949-7111
web www.neeganburnside.com


Client
GOVERNMENT OF NUNAVUT
COMMUNITY & GOVERNMENT
SERVICES
RANKIN INLET
SEWAGE TREATMENT PLANT

Drawing Title
GROUND FLOOR
MECHANICAL HYDRONIC
HEATING LAYOUT

Drawn By A.H.	Checked By D.Mack.	Drawing No. M-5
Scale AS NOTED	Project No. 300031281	



<div>1. This drawing is the exclusive property of Nuna Burnside and the reproduction of any part without prior written consent of this office is strictly prohibited.</div> <div>2. The contractor shall verify all dimensions, levels, and datums on site and report any discrepancies or omissions to this office prior to construction.</div> <div>3. This drawing is to be read and understood in conjunction with all other plans and documents applicable to this project.</div> <div>4. Do not scale the drawings.</div>	Issue / Revision	Date	<div>AS-BUILT DRAWING</div> <div>AS-BUILT INFORMATION PROVIDED BY THE GENERAL CONTRACTOR:</div> <div>KUDLIK CONSTRUCTION LTD.</div> <div>IQALUIT, NUNAVUT</div>	<div>ORIGINAL STAMPED BY</div> <div>G. POPOWICH</div> <div>05/27/13</div>	<div><div><div><div><div><div></div><div></div><div></div></div><div></div></div><div>BURNSIDE</div></div><div><div>Nuna Burnside Engineering & Environmental LTD.</div><div>106B Scurfield Blvd., Winnipeg, Manitoba</div><div>telephone (204) 949-7110 fax (204) 949-7111</div><div>web www.neeganburnside.com</div></div></div></div>	<div>Client</div> <div>GOVERNMENT OF NUNAVUT COMMUNITY & GOVERNMENT SERVICES</div> <div>RANKIN INLET SEWAGE TREATMENT PLANT</div>	Drawing Title	
	1	ISSUED FOR 99% SUBMISSION					JANUARY 2013	SECOND FLOOR MECHANICAL HYDRONIC HEATING LAYOUT
	2	ISSUED FOR TENDER					FEBRUARY 2013	
	3	REVISED AS PER ADDENDUM 1 TO 4 AND ISSUED FOR CONSTRUCTION					APRIL 2013	
	4	AS-BUILT					AUGUST 2015	
						<div>Drawn By A.H.</div> <div>Checked By D.Mack.</div> <div>Scale AS NOTED</div> <div>Project No. 3000131281</div> <div>Drawing No. M-6</div>		

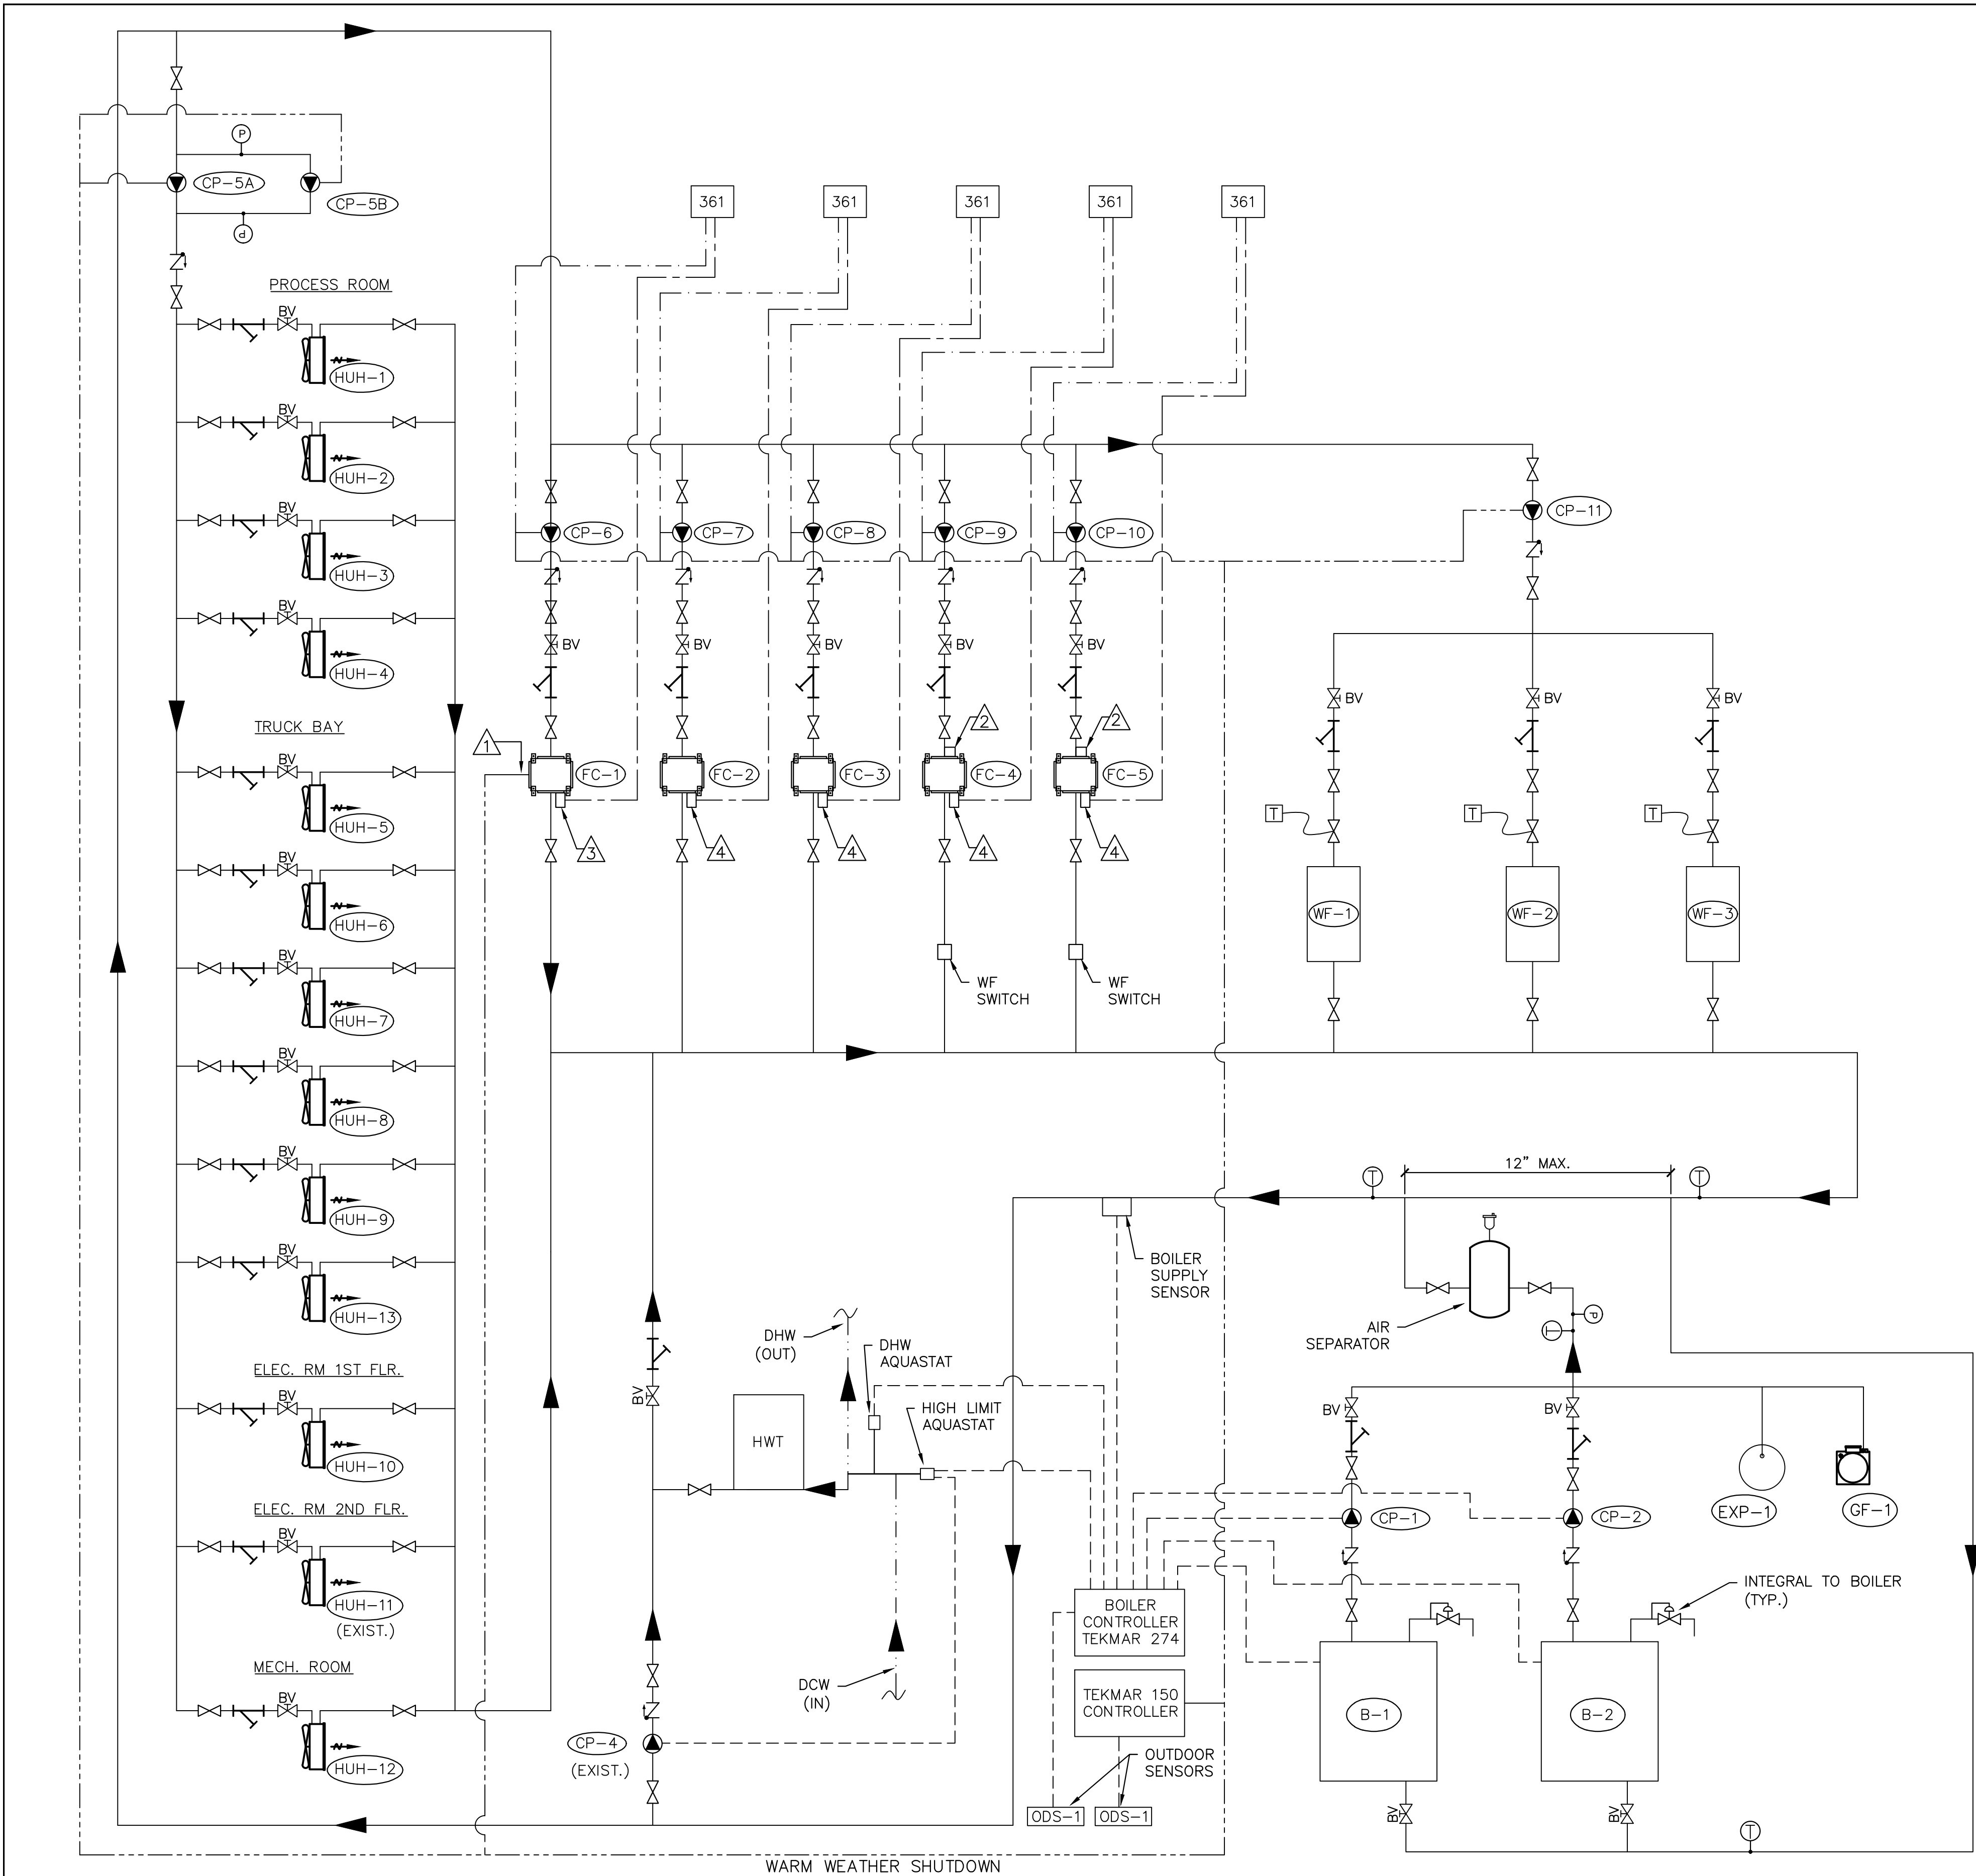

MECHANICAL HYDRONIC LEGEND

HYDRONIC ISOLATION VALVE

HYDRONIC CHECK VALVE
INSTALL ON PUMP DISCHARGE

INLINE CIRCULATING PUMP

FLOW DIRECTION

HYDRONIC BALANCING VALVE
INSTALL ON SUPPLY TO EA. HEATER.

EQUIPMENT TAG

THERMOSTATIC RAD VALVE
C/W WALL MOUNTED
TEMPERATURE CONTROL

DIFFERENTIAL PRESSURE
RELIEF VALVE

PRESSURE GAUGE

TEMPERATURE GAUGE

STRAINER

- NOTES
1.

INSTALL AUTOMATIC AIR VENTS AT HIGH POINTS.
2.

THE CONTRACTOR SHALL VERIFY ALL DIMENSIONS AND CONDITIONS BEFORE PROCEEDING WITH ANY PART OF THE WORK.
3.

THE PIPING CONTAINED ON THIS DRAWING IS DIAGRAMMATIC IN NATURE AND IS NOT INTENED TO SHOW EXACT LOCATIONS OR DIMENSIONS UNLESS OTHERWISE INDICATED.

NOTE:
ALL MATERIAL IN THE PROCESS ROOM SHALL BE
NON-SPARKING CONSTRUCTION, CLASS 1, ZONE 1,
GROUP IIA, EXPLOSION PROOF CONSTRUCTION.

- CONTROLS NOTES
- 1

WARM WEATHER SHUT DOWN TO CAUSE FC-1 TO SWITCH TO HI FAN SPEED IN SUMMER & LOW FAN SPEED IN WINTER.
- 2

IF NO AIRFLOW OR NO WATER FLOW ON RUNNING UNIT – THEN SWITCH ON OTHER UNIT. ONE UNIT IS CP-9 & FC-4 OTHER UNIT IS CP-10 & FC-5.
- 3

10K OHM EXPLOSION PROOF TEMP. SENSOR TO BE INSTALLED IN AIR DUCT OF FAN COIL.
- 4

TEKMAR TEMP. SENSOR TO BE INSTALLED IN AIR DUCT OF FAN COIL.

NOTE:
PROVIDE FLEXIBLE CONNECTIONS FOR ALL EQUIPMENT
INSTALLED WHERE BUILDING TRANSITIONS FROM NEW
CONSTRUCTION AND EXISTING CONSTRUCTION TO
ACCOMMODATE FOR DIFFERENTIAL SETTLEMENT.

1.

This drawing is the exclusive property of Nuna Burnside and the reproduction of any part without prior written consent of this office is strictly prohibited.
2.

The contractor shall verify all dimensions, levels, and datums on site and report any discrepancies or omissions to this office prior to construction.
3.

This drawing is to be read and understood in conjunction with all other plans and documents applicable to this project.
4.

Do not scale the drawings.

Issue / Revision	Date
1 ISSUED FOR 99% SUBMISSION	JANUARY 2013
2 ISSUED FOR TENDER	FEBRUARY 2013
3 REVISED AS PER ADDENDUM 1 TO 4 AND ISSUED FOR CONSTRUCTION	APRIL 2013
4 AS-BUILT	AUGUST 2015

AS-BUILT DRAWING

AS-BUILT INFORMATION PROVIDED BY THE
GENERAL CONTRACTOR:
KUDLIK CONSTRUCTION LTD.
IGALUIT, NUNAVUT

ORIGINAL
STAMPED
BY

G. POPOWICH
05/27/13

BURNSIDE

Nuna Burnside Engineering & Environmental LTD.
106B Scurfield Blvd., Winnipeg, Manitoba
telephone (204) 949-7110 fax (204) 949-7111
web www.neeganburnside.com

Client

GOVERNMENT OF NUNAVUT
COMMUNITY & GOVERNMENT
SERVICES

RANKIN INLET
SEWAGE TREATMENT PLANT













Drawing Title

MECHANICAL
HYDRONIC HEATING SCHEMATIC

Drawn By
A.H.
Scale
NTS

Checked By
D.Mack.
Project No.
300031281

Drawing No.
M-7

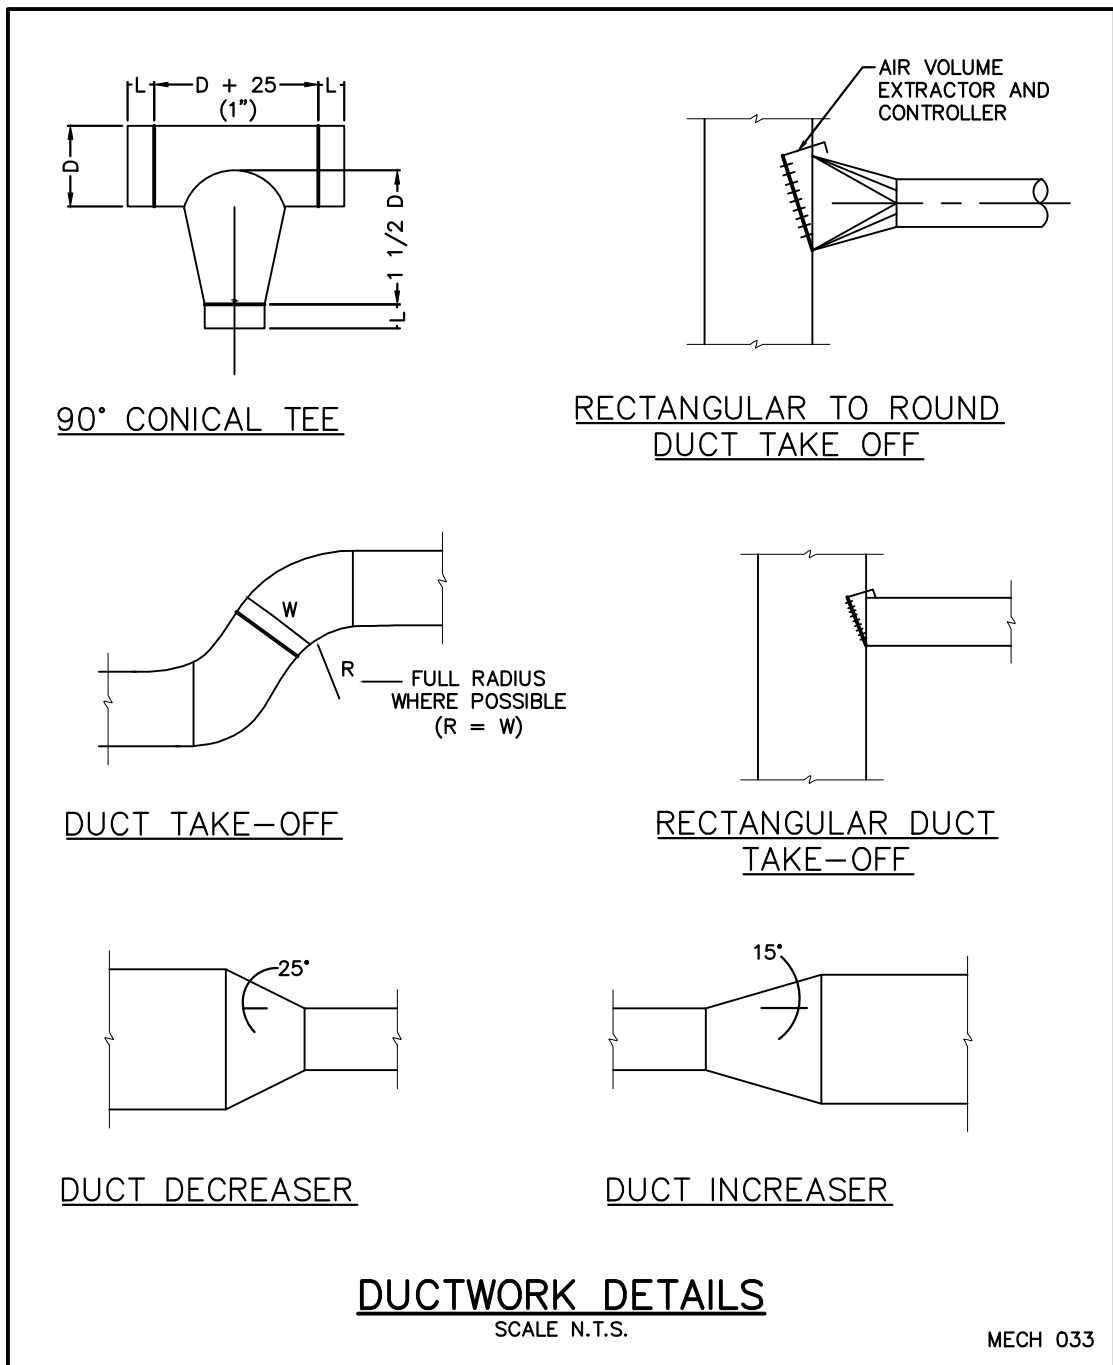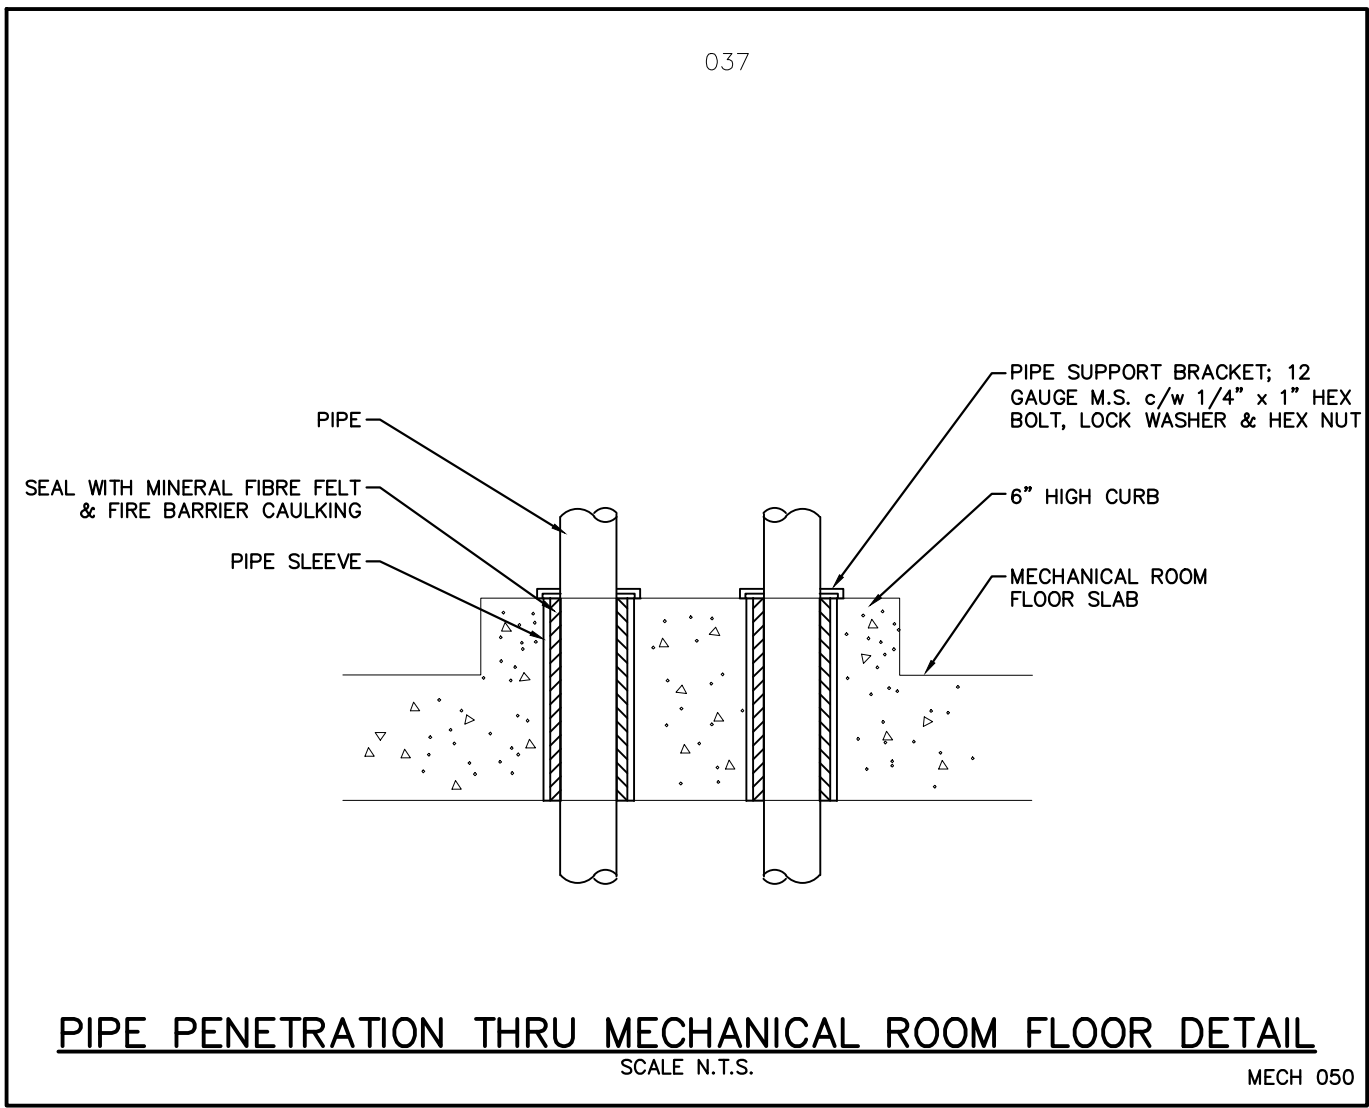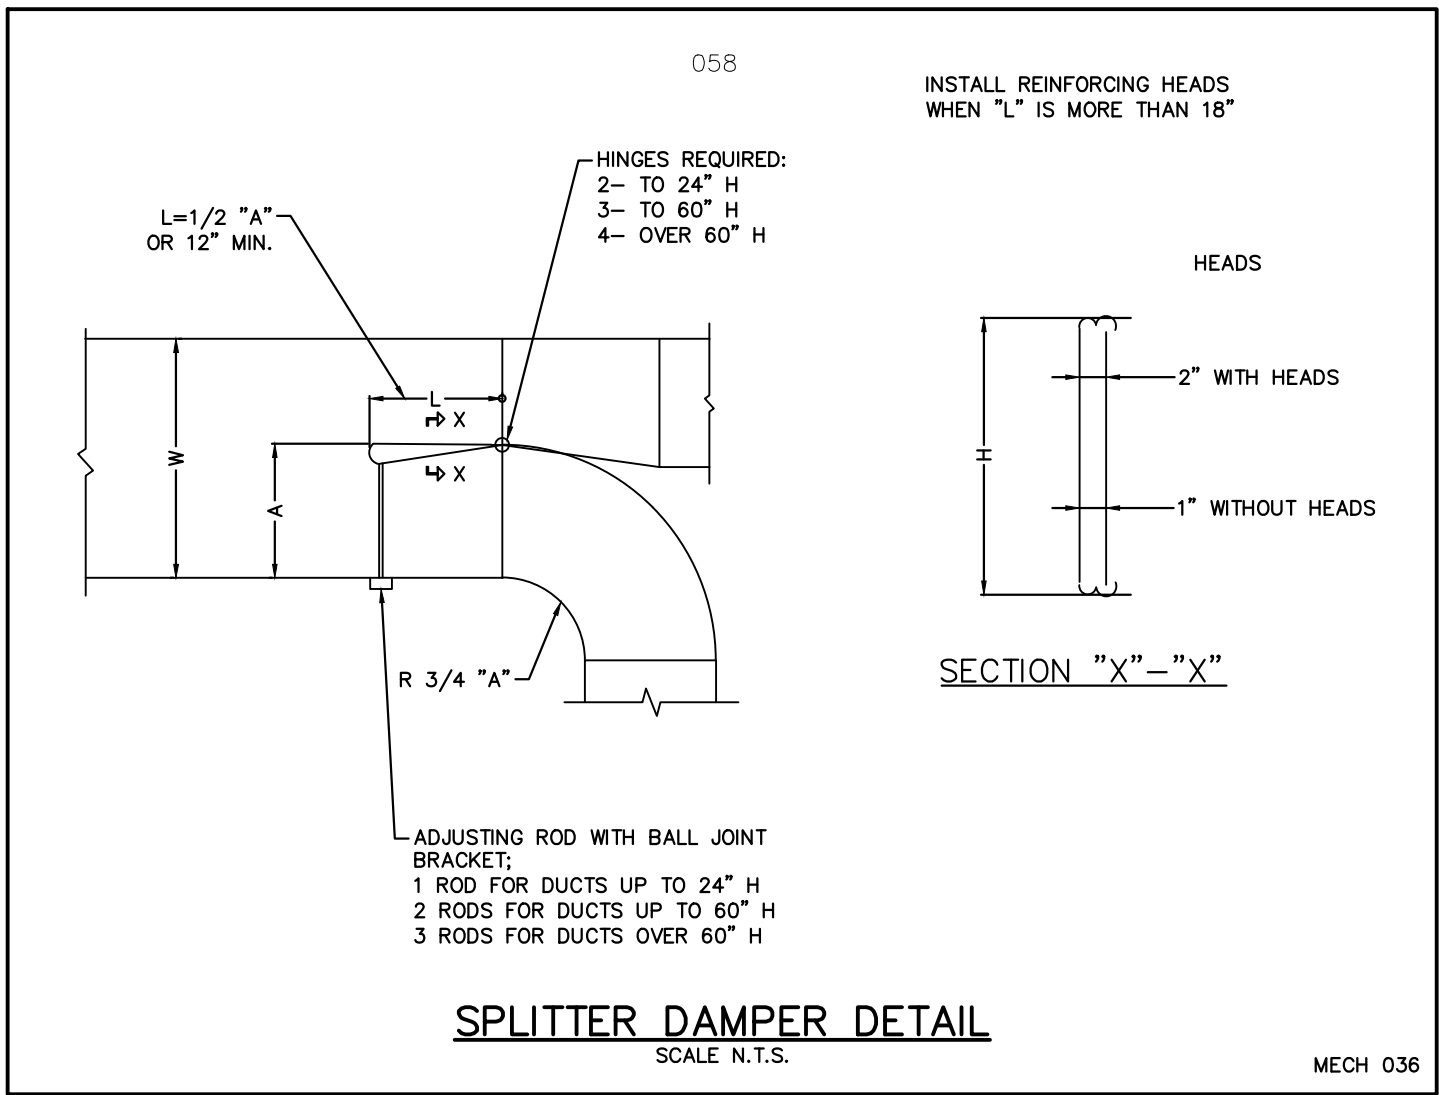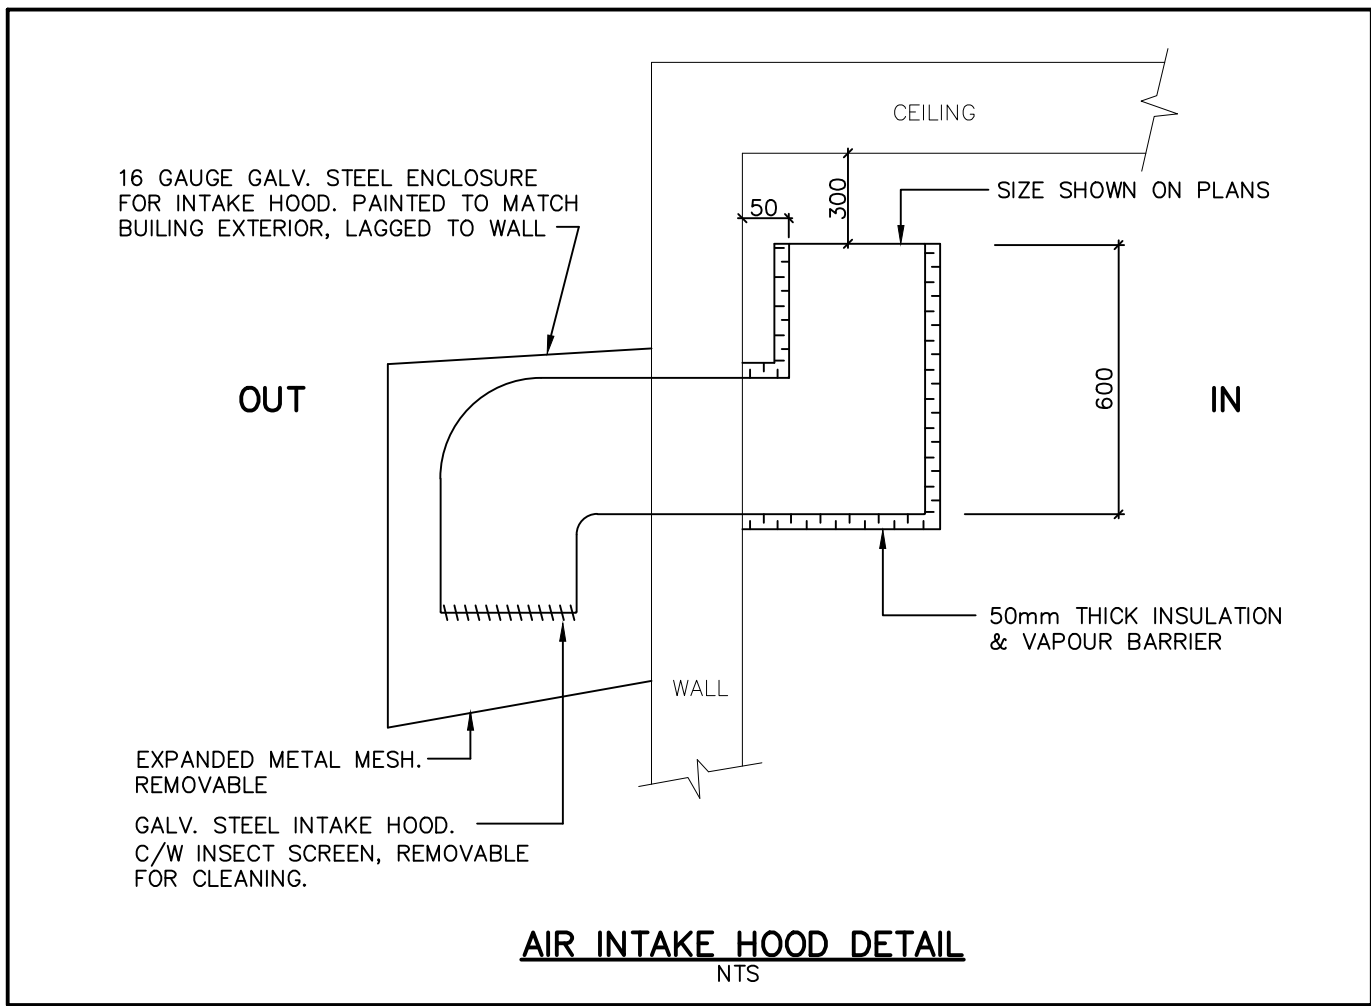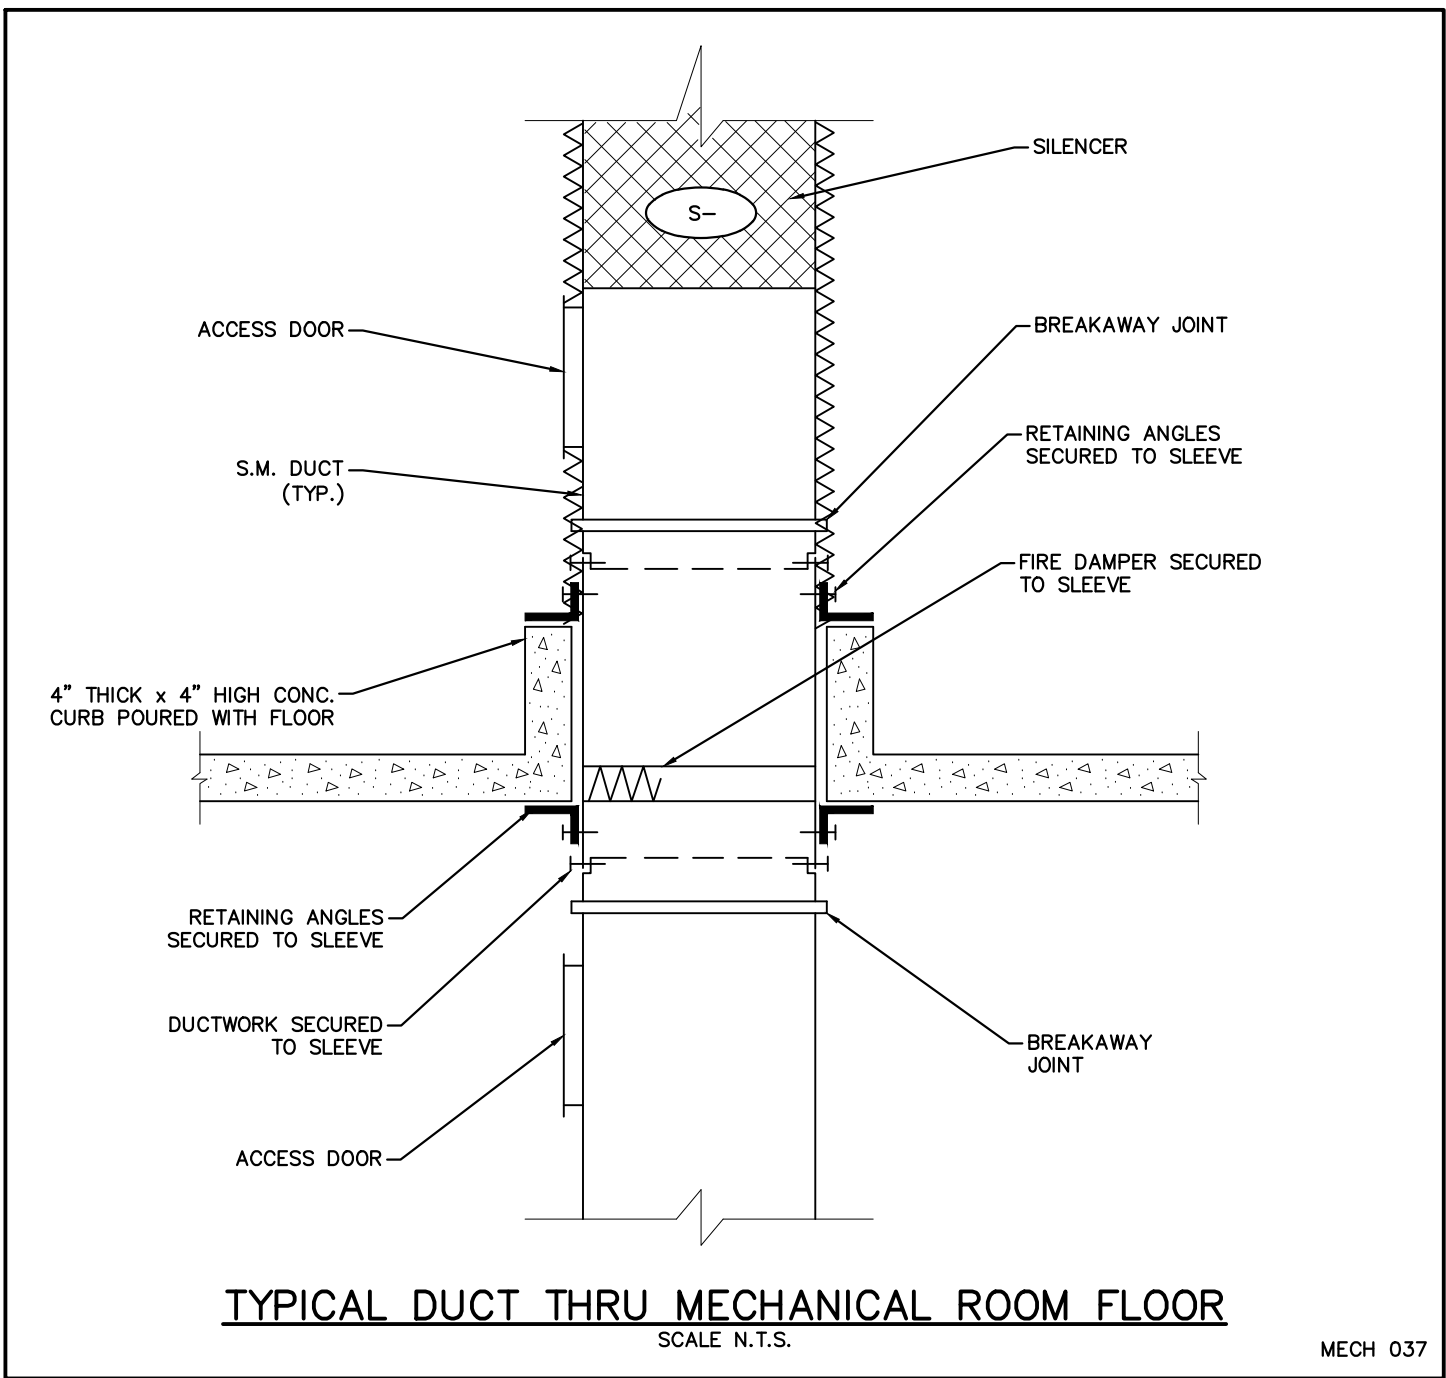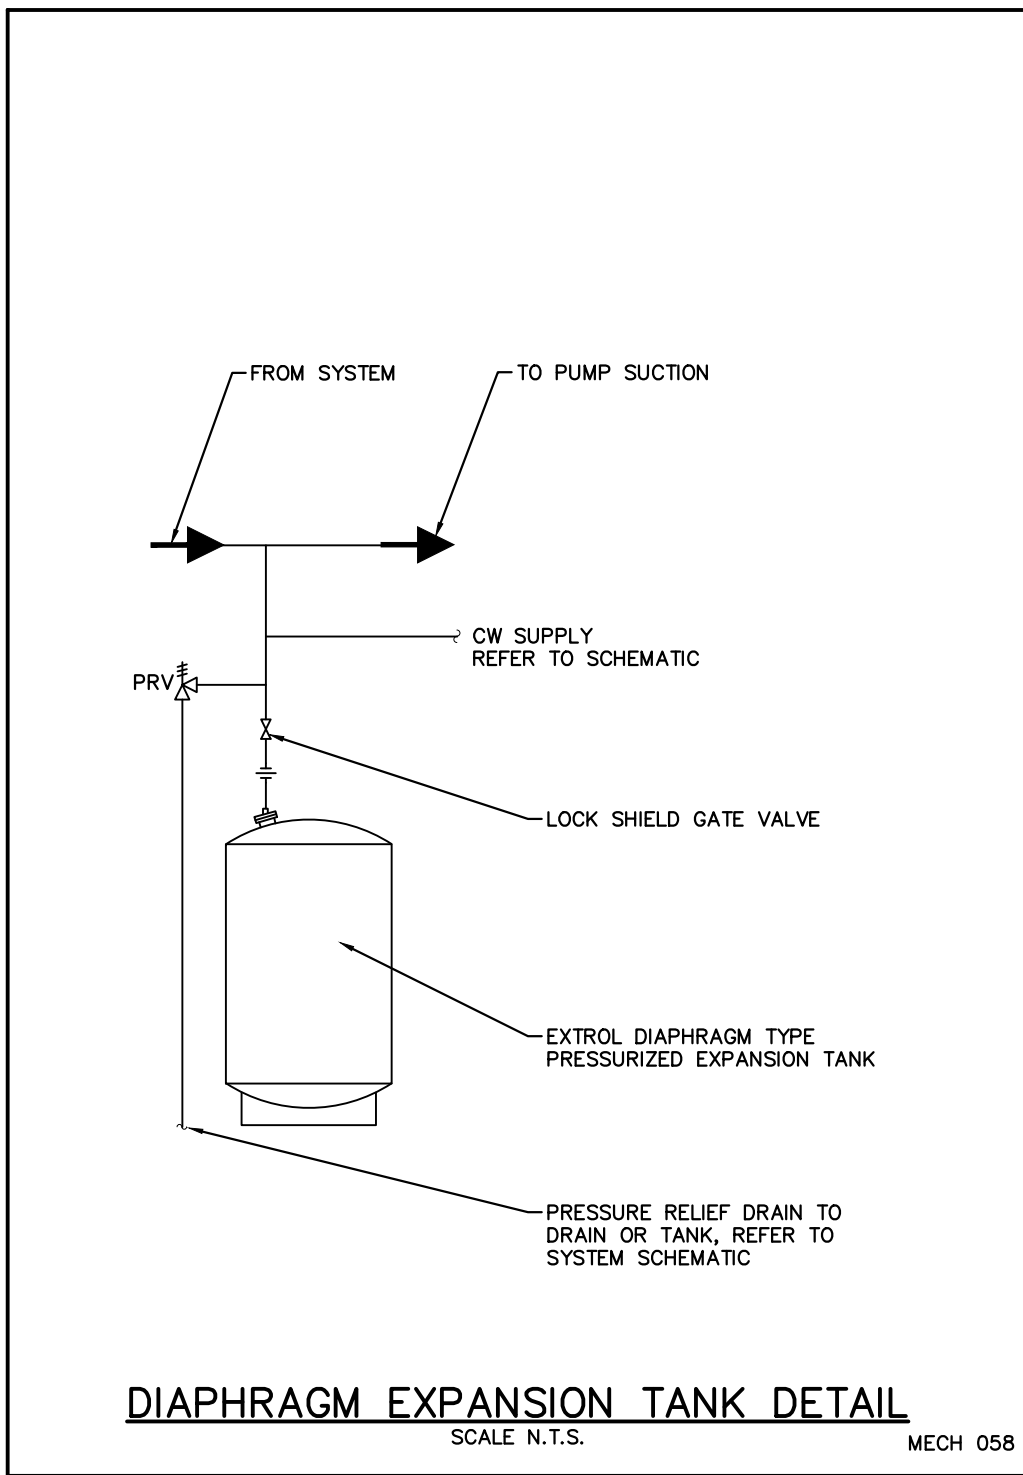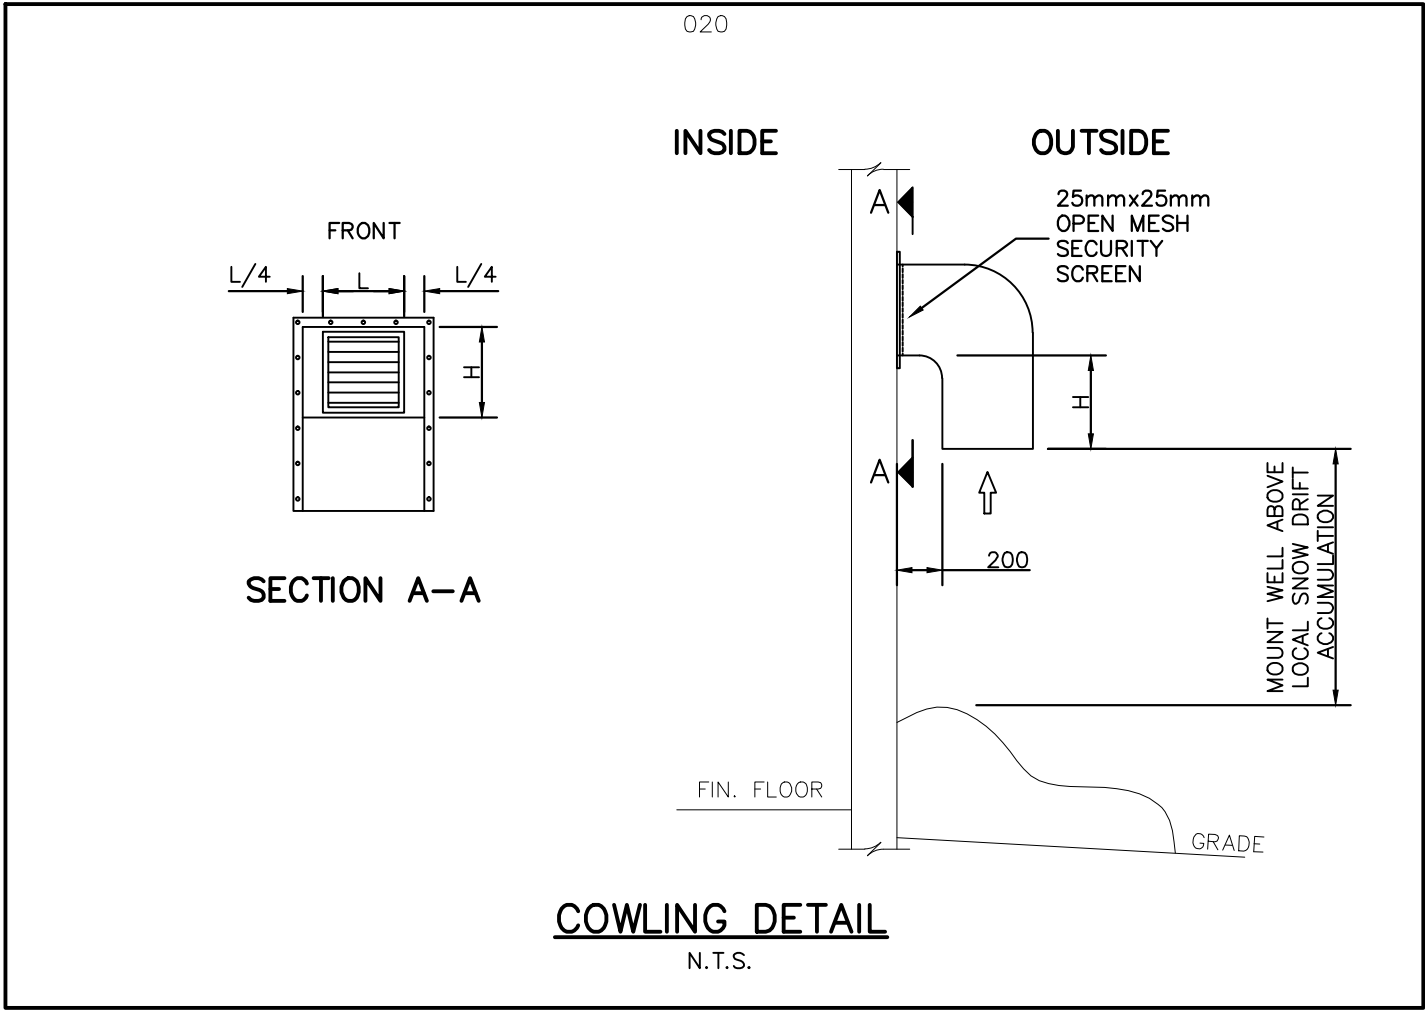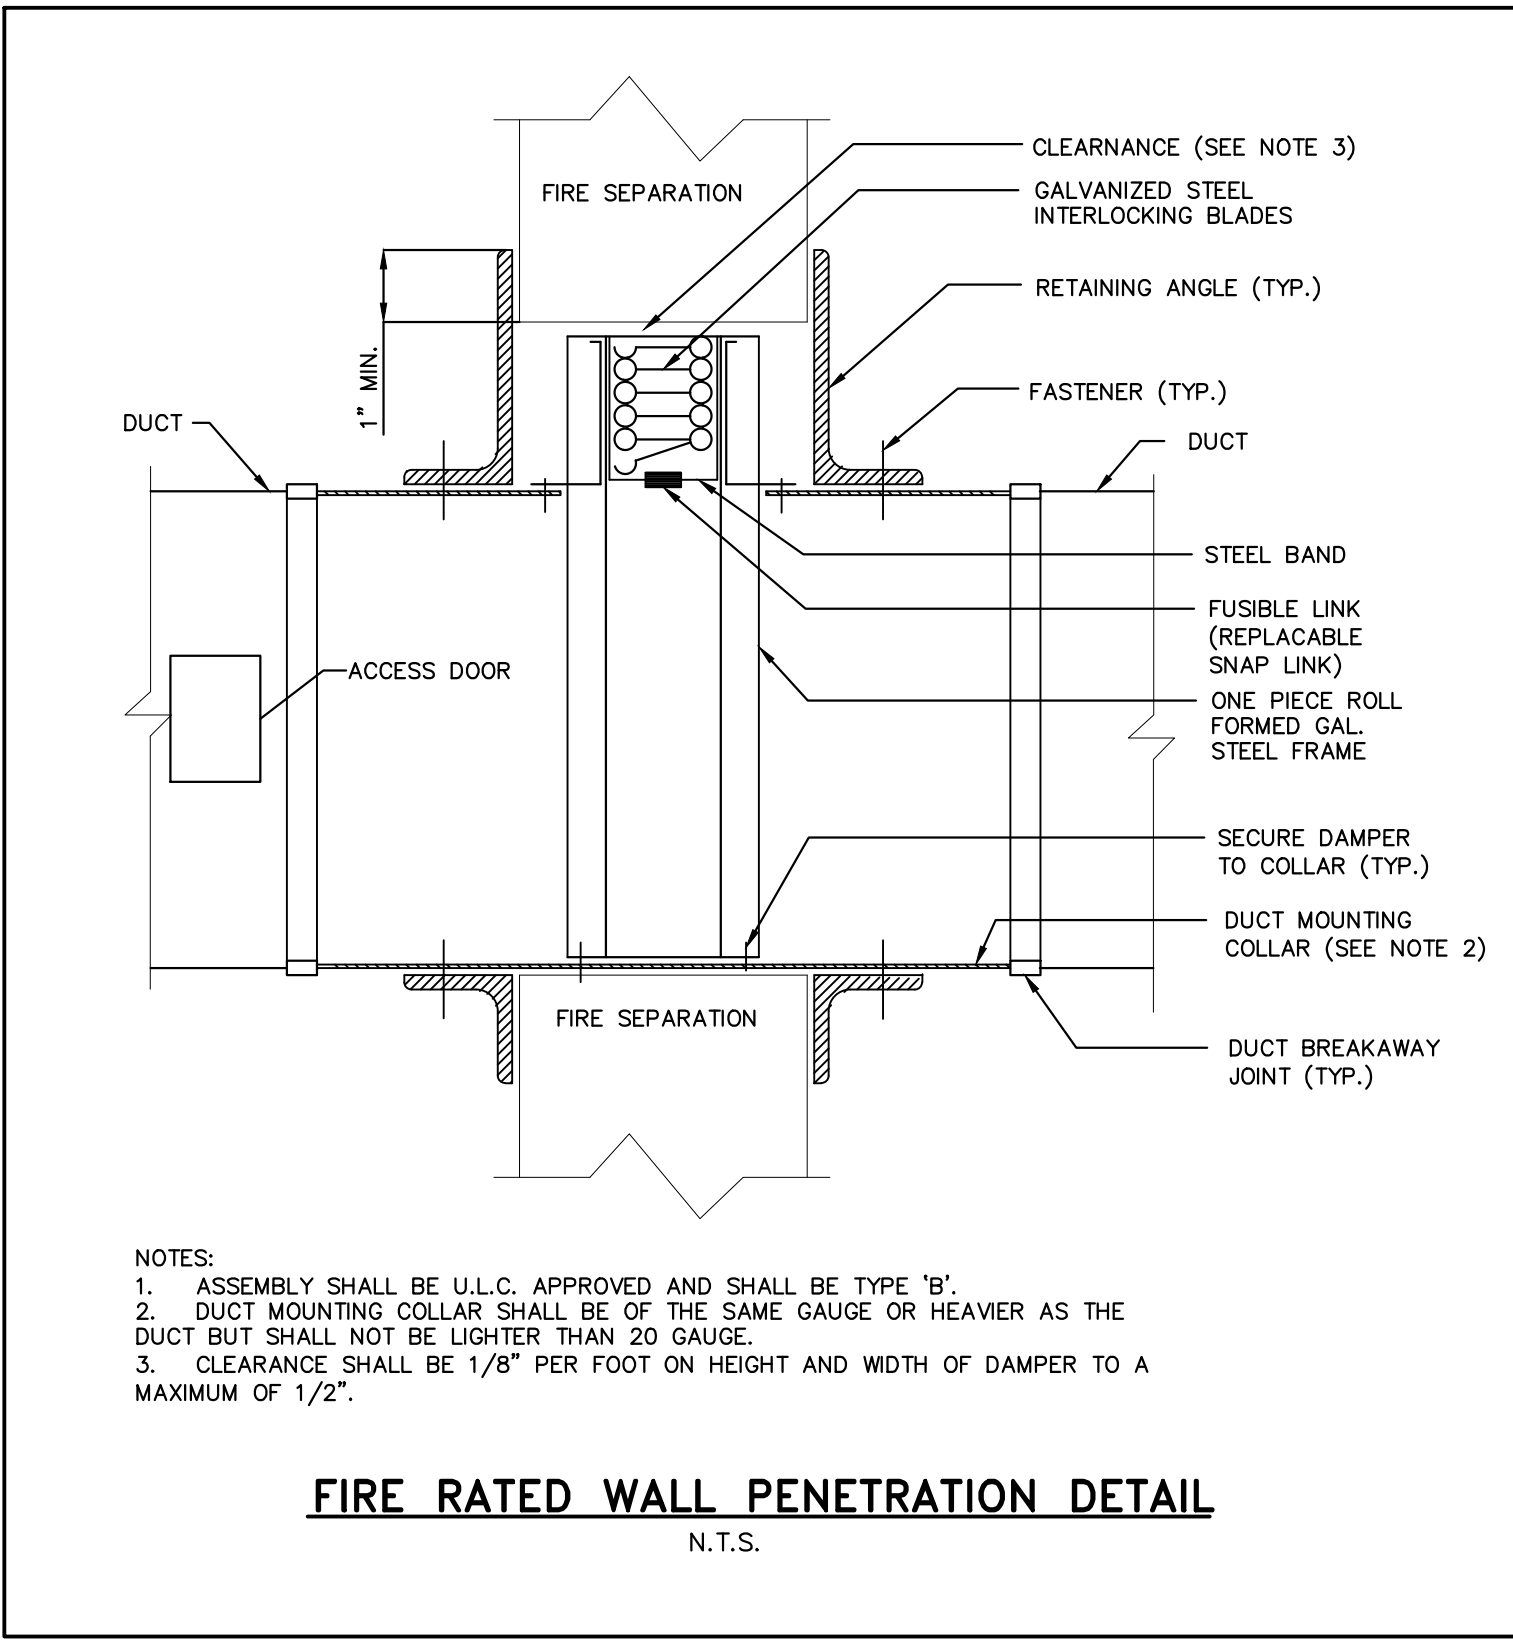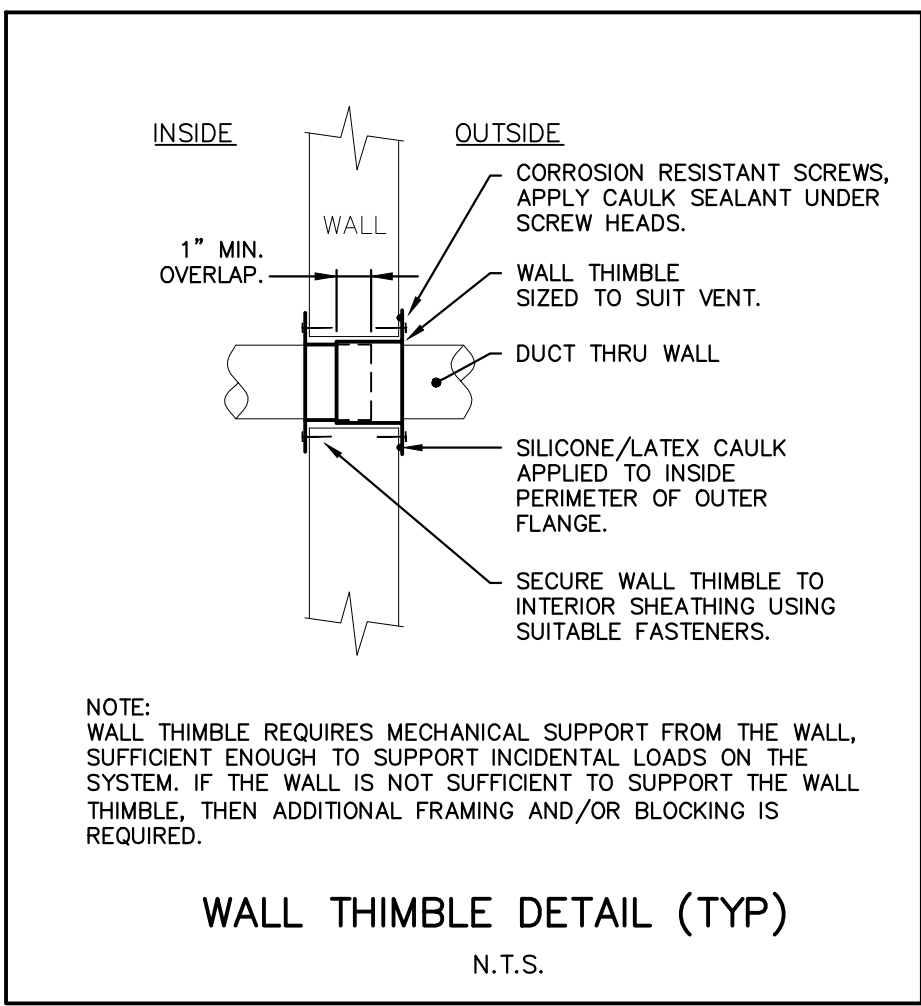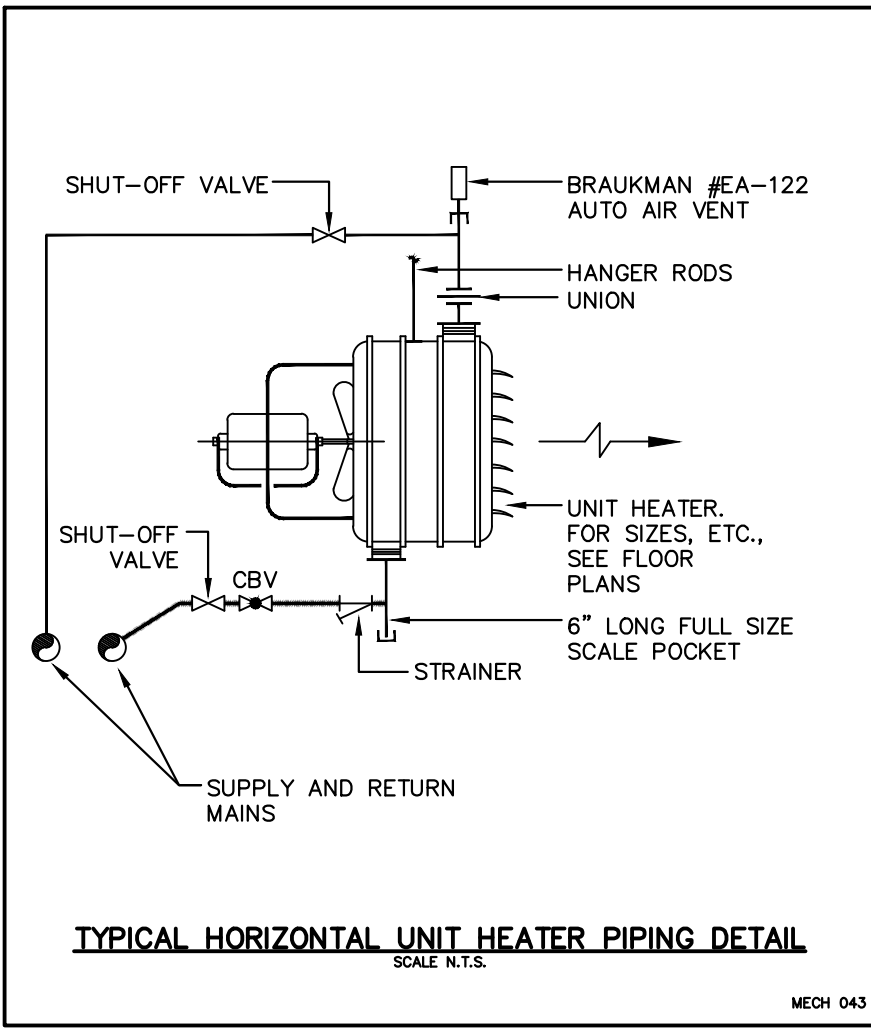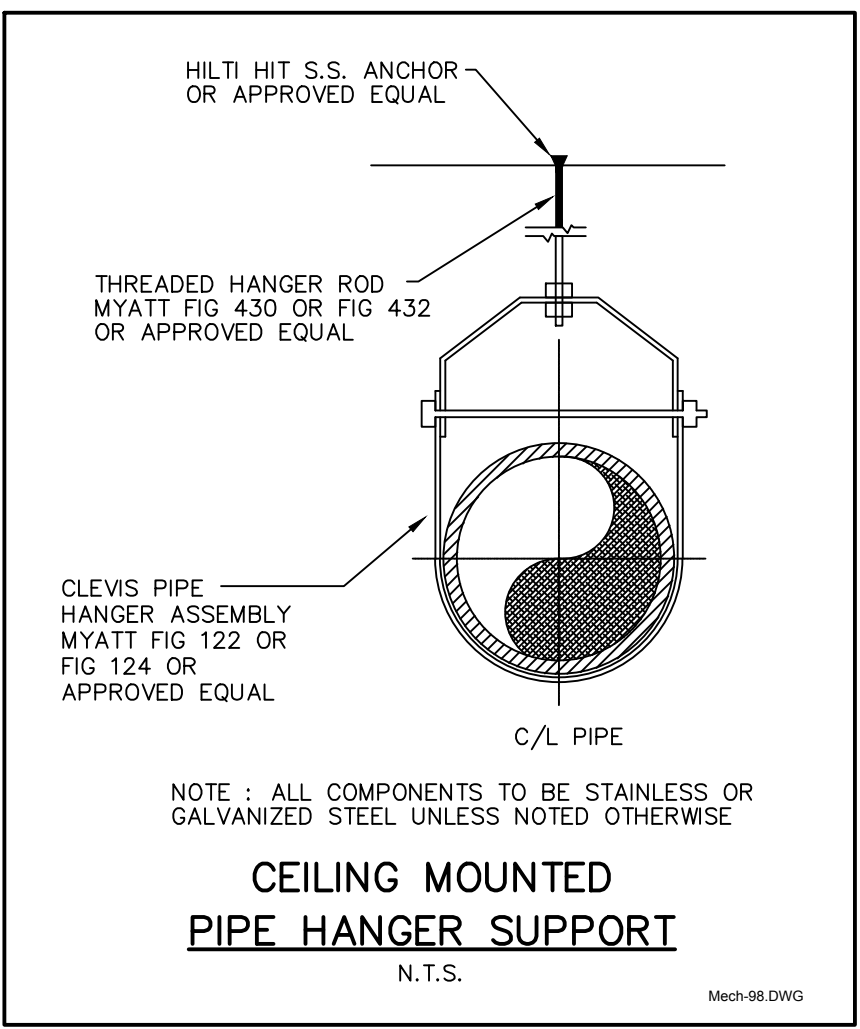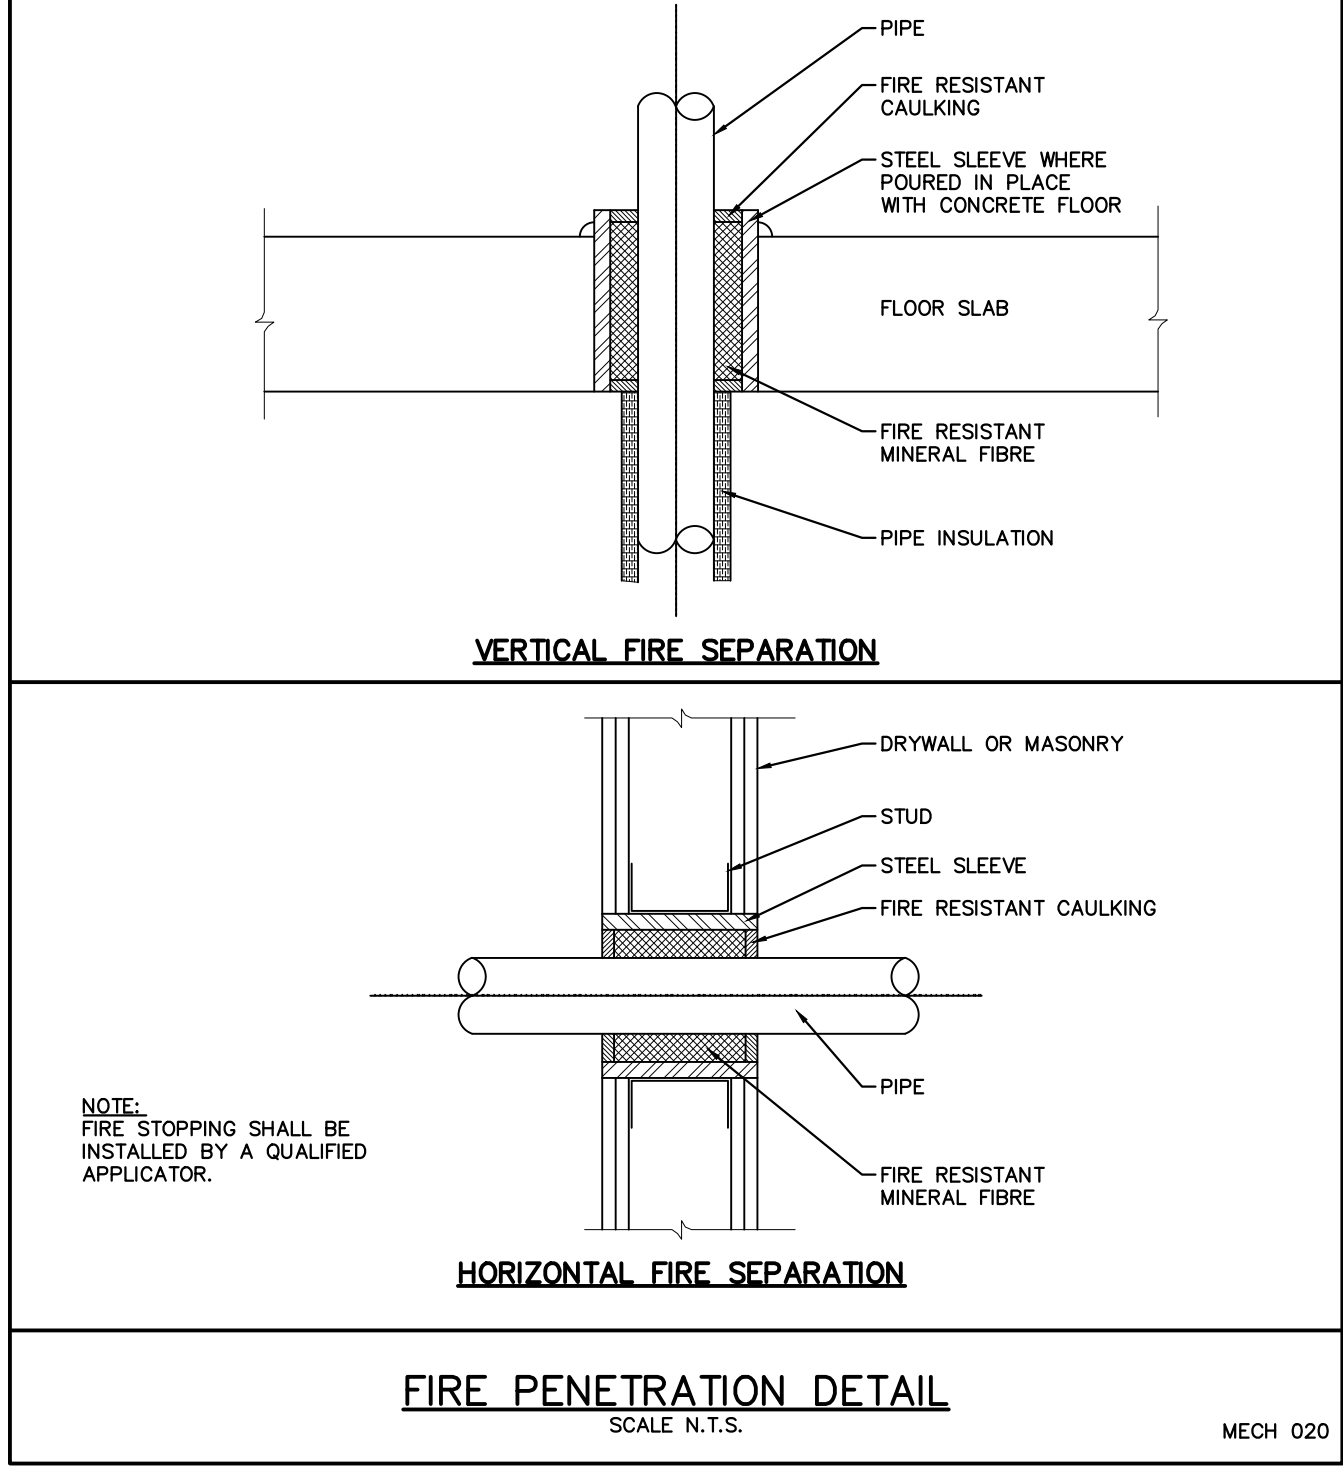

1. This drawing is the exclusive property of Nuna Burnside and the reproduction of any part without prior written consent of this office is strictly prohibited.
2. The contractor shall verify all dimensions, levels, and datums on site and report any discrepancies or omissions to this office prior to construction.
3. This drawing is to be read and understood in conjunction with all other plans and documents applicable to this project.
4. Do not scale the drawings.

Issue / Revision	Date
1 ISSUED FOR 99% SUBMISSION	JANUARY 2013
2 ISSUED FOR TENDER	FEBRUARY 2013
3 REVISED AS PER ADDENDUM 1 TO 4 AND ISSUED FOR CONSTRUCTION	APRIL 2013
4 AS-BUILT	AUGUST 2015

AS-BUILT DRAWING

AS-BUILT INFORMATION PROVIDED BY THE GENERAL CONTRACTOR:

KUDLIK CONSTRUCTION LTD.
IQALUIT, NUNAVUT

ORIGINAL
STAMPED
BY

G. POPOWICH
05/27/13

nuna BURNSIDE

Nuna Burnside Engineering & Environmental LTD.
106B Scurfield Blvd., Winnipeg, Manitoba
telephone (204) 949-7110 fax (204) 949-7111
web www.neeganburnside.com

Client


GOVERNMENT OF NUNAVUT
COMMUNITY & GOVERNMENT
SERVICES

RANKIN INLET
SEWAGE TREATMENT PLANT

Drawing Title


**MECHANICAL
STANDARD DETAILS 1**

Drawn By A.H.	Checked By D.Mack.	Drawing No.
Scale NTS	Project No. 300031281	M-8

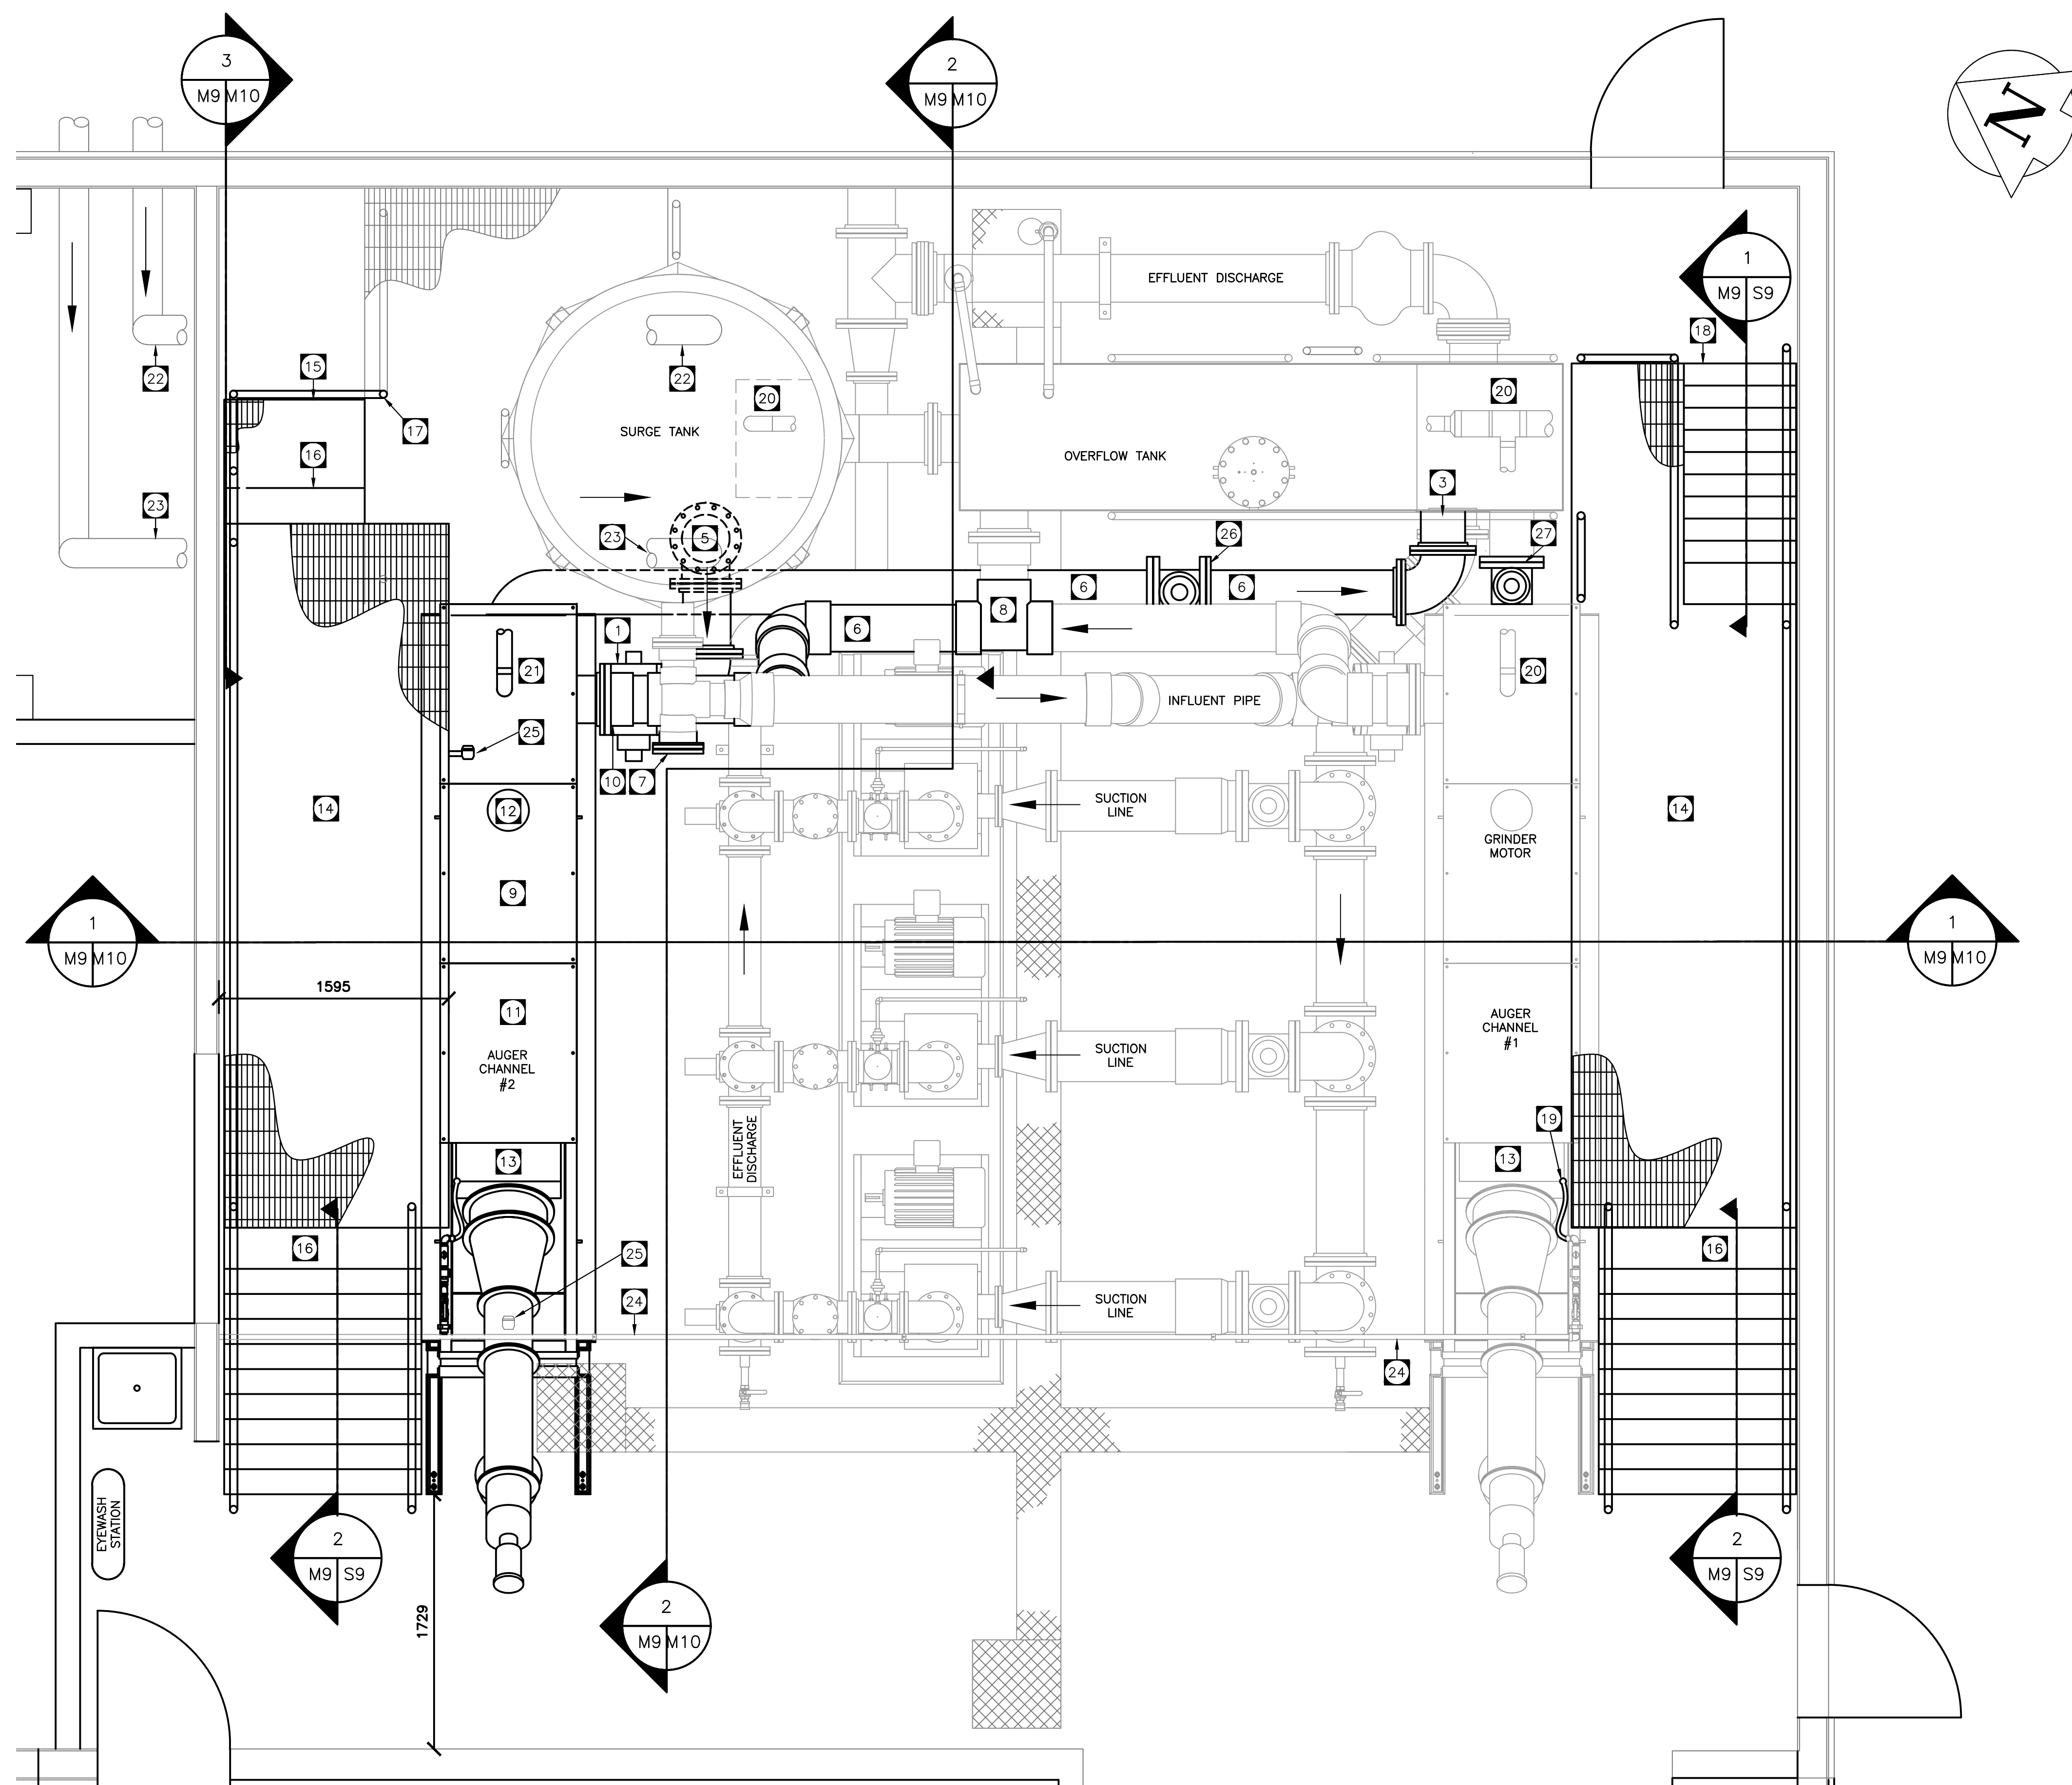

CONSTRUCTION NOTES:

1. INSTALL NEW 300Ø PLUG VALVE ON AUGER CHANNEL INLET
2. INSTALL NEW FLANGE CONNECTION TO EXISTING BOTTOM OF SURGE TANK (NOT SHOWN ON DRAWING)
3. INSTALL NEW 300Ø DISCHARGE PIPE FLANGE CONNECTION TO EXISTING 300Ø FLANGE ON OVERFLOW TANK
4. INSTALL PIPE SUPPORTS AS REQUIRED TO FULLY SUPPORT PIPING (NOT SHOWN ON DRAWING)
5. PENETRATION AT BOTTOM OF SURGE TANK TO BE C/W 300mm STEEL STUB AND FLANGE. PIPING FROM STEEL FLANGE PENETRATION TO BE PVC SCHEDULE 80 TO AUGER CHANNEL.
6. INSTALL 300Ø PVC SCHEDULE 80 PIPING
7. REMOVE EXISTING PLUG VALVE AND INSTALL BLIND FLANGE
8. DISCONNECT EXISTING AUGER CHANNEL #1 OVERFLOW CONNECTION TO OVERFLOW TANK AND INSTALL NEW 300Ø PVC TEE. CONNECT TO EXISTING AND NEW AUGER CHANNEL OVERFLOW PIPING.
9. COVER SCREEN CHANNEL WITH REMOVABLE CHECKER PLATE PANELS. SEE APPENDIX 'B' IN SPECIFICATIONS FOR DETAILS
10. CONNECT NEW 300Ø PVC OVERFLOW PIPING TO AUGER CHANNEL FLANGED OUTLET
11. NEW AUGER CHANNEL
REFER TO DRAWING M10 AND SPECIFICATIONS APPENDIX 'B' FOR DETAILS
12. NEW GRINDER MOTOR
13. INSTALL NEW AUGER TANK COVER
(NOT SHOWN FOR CLARITY - SEE DWG S-9 FOR DETAILS)
14. NEW CATWALK C/W GUARDS & RAILINGS
(SEE DWG S-8 FOR DETAILS)
15. EXTEND EXISTING PLATFORM
16. NEW CATWALK STAIRS
(SEE DWG S-9 FOR DETAILS)
17. INSTALL NEW PLATFORM RAILING
CUT AND CONNECT TO EXISTING RAILING
18. NEW CATWALK STAIRS
(SEE DWG S-9 FOR DETAILS)
19. RELOCATE AUGER CHANNEL WATER SPRAY.
REFER TO MECHANICAL
20. EXISTING PROCESS VENTILATION AT HIGH LEVEL
(PARTIALLY SHOWN FOR CLARITY)
21. NEW PROCESS VENTILATION EXTENDED TO NEW AUGER CHANNEL
PARTIALLY SHOWN. REFER TO MECHANICAL
22. JOHNSON COVE 200mm H.D.P.E. FORCEMAIN
(PARTIALLY SHOWN FOR CLARITY)
23. NUUVUK 200mm H.D.P.E. FORCEMAIN
(PARTIALLY SHOWN FOR CLARITY)
24. DOMESTIC WATER SERVICE TO BE REMOVED.
REFER TO MECHANICAL
25. ULTRA SONIC TRANSDUCER (SENSOR) - 2 REQUIRED.
SENSOR SURFACE SHALL BE MOUNTED A MINIMUM OF 250mm ABOVE THE CHANNEL HIGH WATER LEVEL.
REFER TO DWG M-10 FOR FURTHER DETAILS
26. 300mmØ PLUG VALVE FOR AUGER CHANNEL #2 DISCHARGE LINE.
27. 250mmØ PLUG VALVE FOR AUGER CHANNEL #1 DISCHARGE LINE.

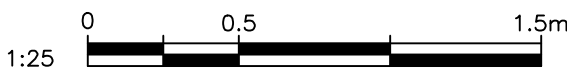

1. This drawing is the exclusive property of Nuna Burnside and the reproduction of any part without prior written consent of this office is strictly prohibited.
2. The contractor shall verify all dimensions, levels, and datum on site and report any discrepancies or omissions to this office prior to construction.
3. This drawing is to be read and understood in conjunction with all other plans and documents applicable to this project.
4. Do not scale the drawings.

Issue / Revision	Date
1. ISSUED FOR CLIENT REVIEW	OCTOBER 2012
2. ISSUED FOR 66% SUBMISSION	NOVEMBER 2012
3. ISSUED FOR 99% SUBMISSION	JANUARY 2013
4. ISSUED FOR TENDER	FEBRUARY 2013
5. REVISED AS PER ADDENDUM 1 TO 4 AND ISSUED FOR CONSTRUCTION	APRIL 2013
6. AS-BUILT	AUGUST 2015

AS-BUILT DRAWING
AS-BUILT INFORMATION PROVIDED BY THE
GENERAL CONTRACTOR:
KUDLIK CONSTRUCTION LTD.
IQALUIT, NUNAVUT

ORIGINAL
STAMPED
BY
G. POPOWICH
05/27/13


OBJECT LINEWORK					
	FLOOR TRENCH		CATWALK/PLATFORM		FLOW DIRECTION
	EXISTING		PROPOSED		EXISTING
	LEGEND - PLAN		LEGEND - PLAN		PROPOSED

nuna BURNSIDE
Nuna Burnside Engineering & Environmental LTD.
106B Scurfield Blvd., Winnipeg, Manitoba
telephone (204) 949-7110 fax (204) 949-7111
web www.neeganburnside.com

Client
GOVERNMENT OF NUNAVUT
COMMUNITY & GOVERNMENT
SERVICES
RANKIN INLET
SEWAGE TREATMENT PLANT

Drawing Title
SEWAGE PROCESS EQUIPMENT
PLAN


Drawn By G. GERUS	Checked By G. POPOWICH	Drawing No. M-9
Scale 1:25	Project No. 300031281	

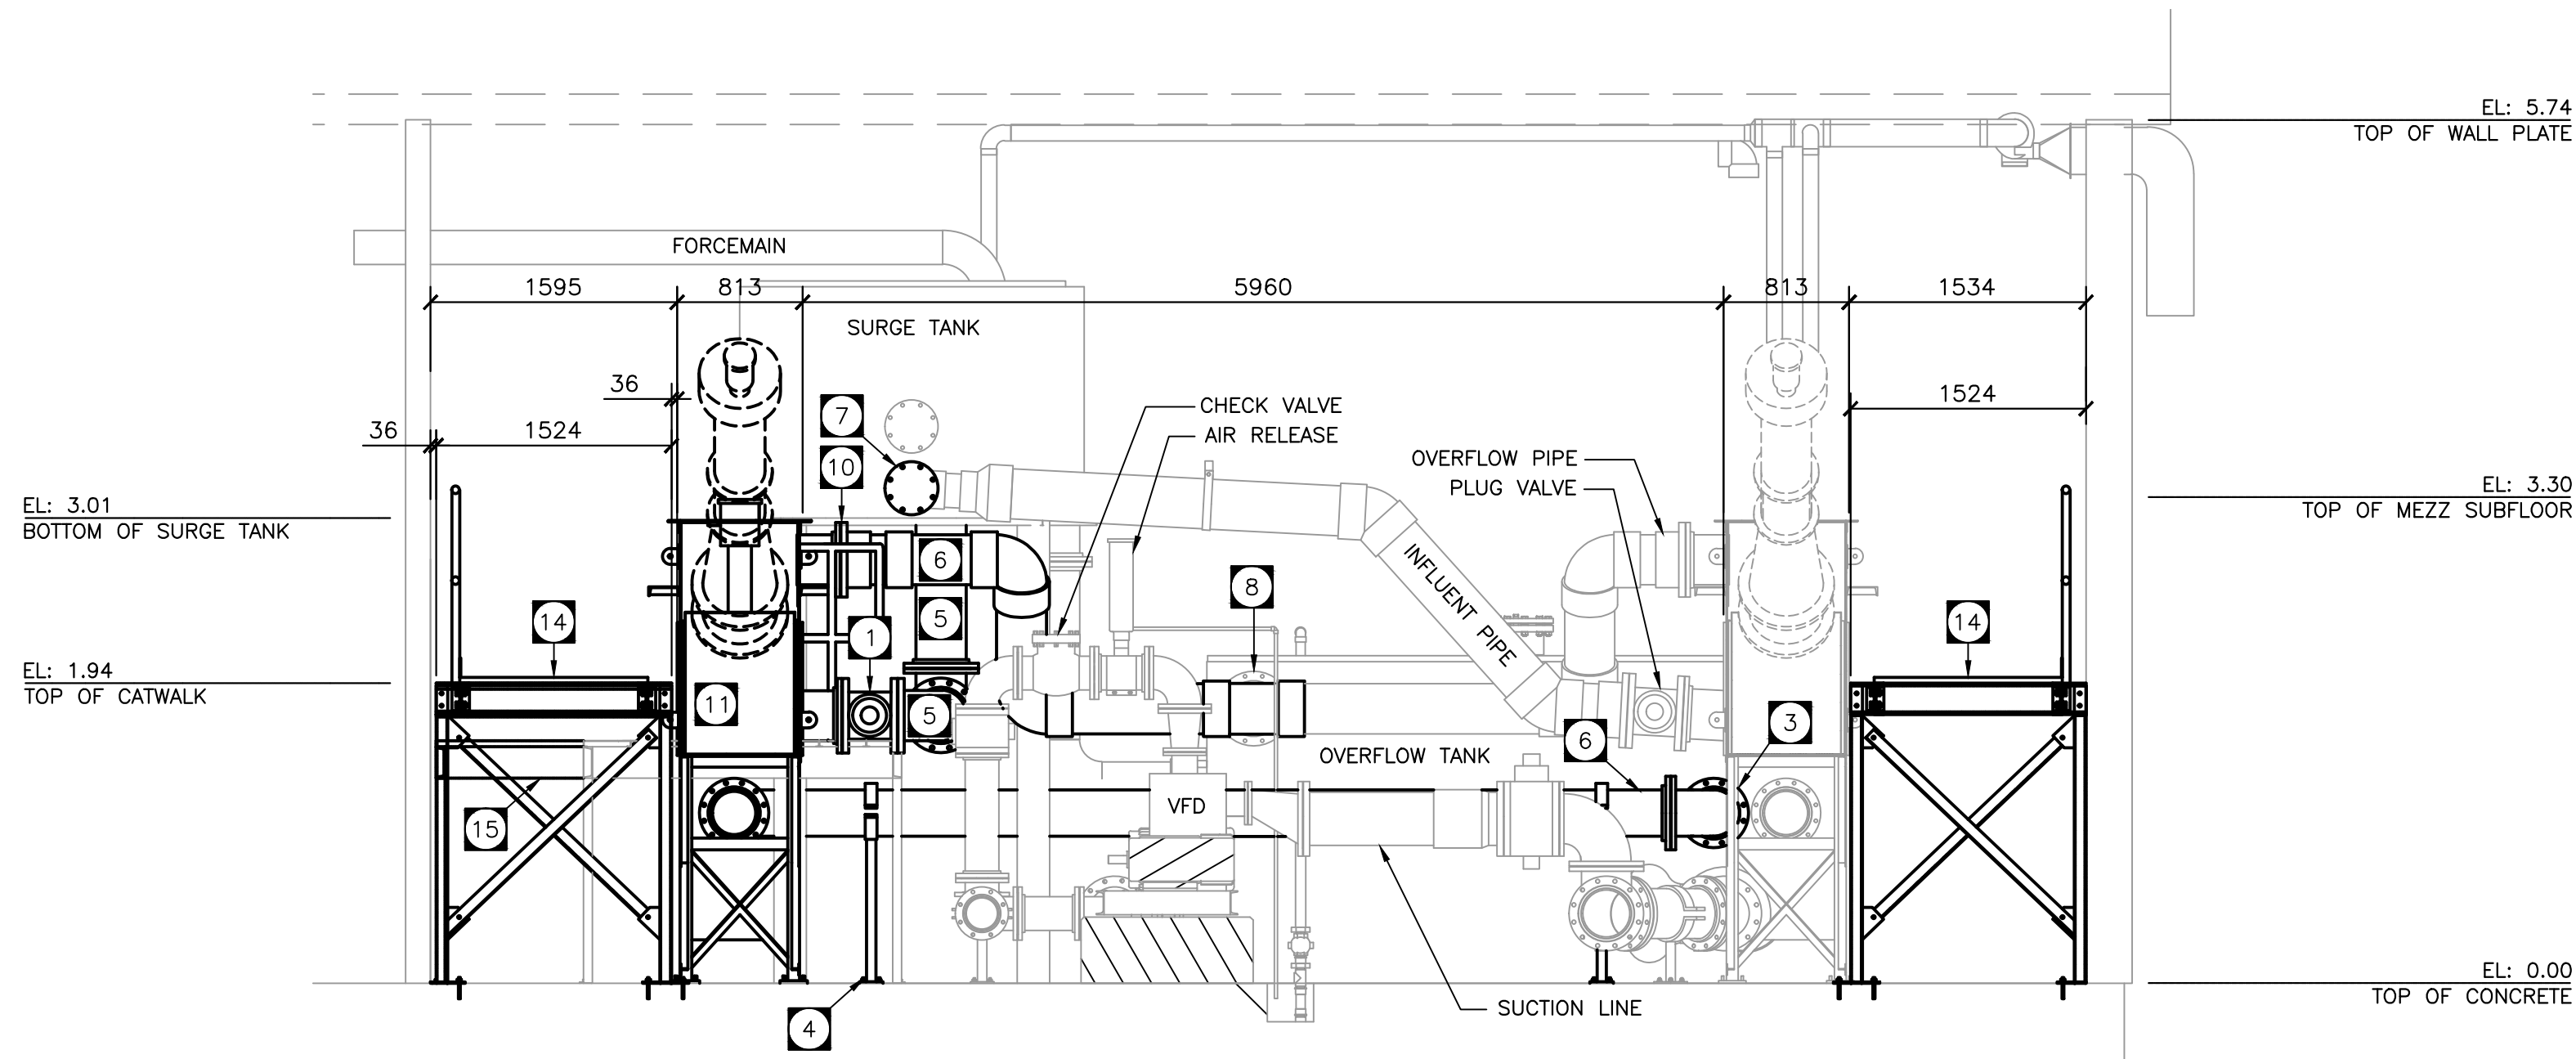

1 MECHANICAL PROCESS SECTION
M9 M10 1:40

CONSTRUCTION NOTES:

1. INSTALL NEW 300# PLUG VALVE ON AUGER CHANNEL INLET
2. INSTALL NEW FLANGE CONNECTION TO EXISTING BOTTOM OF SURGE TANK (NOT SHOWN ON DRAWING)
3. INSTALL NEW 300# DISCHARGE PIPE FLANGE CONNECTION TO PLUG VALVE GOING TO OVERFLOW TANK
4. INSTALL PIPE SUPPORTS AS REQUIRED TO FULLY SUPPORT PIPING (NOT SHOWN ON DRAWING)
5. INSTALL 300# DUCTILE IRON PIPE AND FLANGE
6. INSTALL 300# PVC SCHEDULE 80 PIPING
7. REMOVE EXISTING PLUG VALVE AND INSTALL BLIND FLANGE
8. DISCONNECT EXISTING AUGER CHANNEL #1 OVERFLOW CONNECTION TO OVERFLOW TANK AND INSTALL NEW 300# PVC TEE. CONNECT TO EXISTING AND NEW AUGER CHANNEL OVERFLOW PIPING.
9. COVER SCREEN CHANNEL WITH REMOVABLE CHECKER PLATE PANELS. SEE APPENDIX 'B' IN SPECIFICATIONS FOR DETAILS
10. CONNECT NEW 300# PVC OVERFLOW PIPING TO AUGER CHANNEL FLANGED OUTLET
11. NEW AUGER CHANNEL
12. NEW GRINDER MOTOR
13. INSTALL NEW AUGER TANK COVER (NOT SHOWN FOR CLARITY - SEE DWG S-9 FOR DETAILS)
14. NEW CATWALK C/W GUARDS & RAILINGS (SEE DWG S-8 FOR DETAILS)
15. EXTEND EXISTING PLATFORM
16. NEW CATWALK STAIRS STEP (SEE DWG S-9 FOR DETAILS)
17. INSTALL NEW PLATFORM RAILING CUT AND CONNECT TO EXISTING RAILING
18. AUGER CHANNEL SAMPLE BALL VALVE
19. ULTRA SONIC TRANSDUCER (SENSOR) - 2 REQUIRED. TRANSDUCER SHALL BE MOUNTED TO STAINLESS MOUNTING BRACKET AS SHOWN TO PROVIDE VERTICAL ADJUSTMENT TO SUIT. REFER TO DWG M-9 FOR FURTHER DETAILS

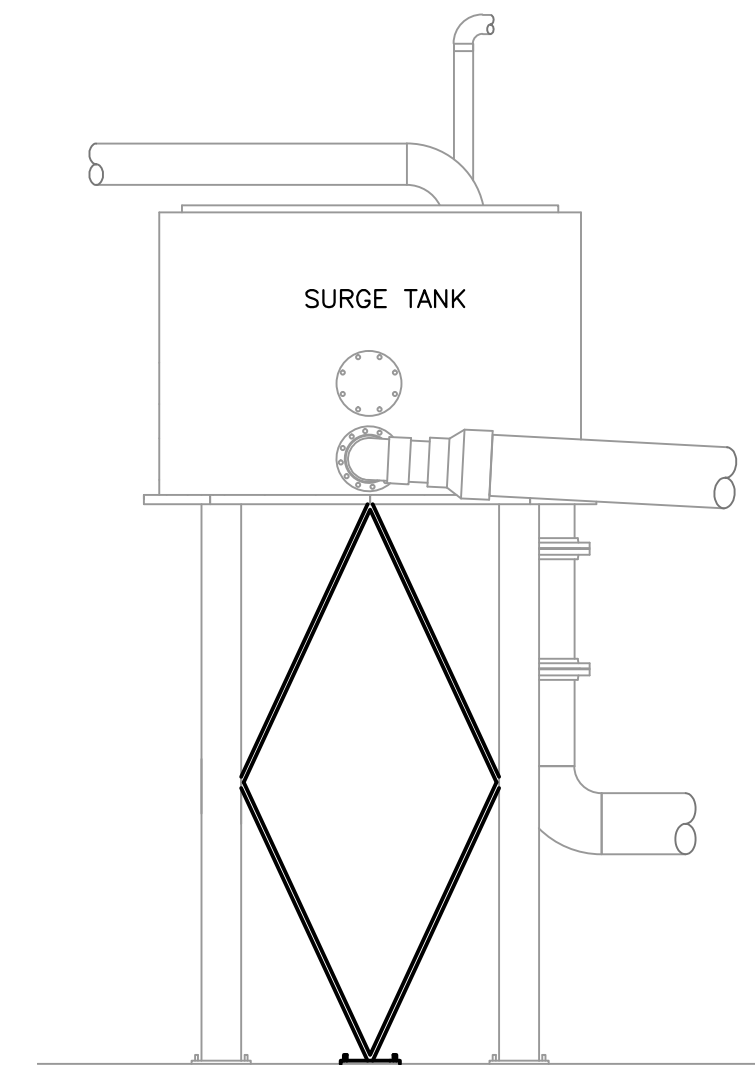


NOTES


1. REMOVE EXISTING CROSS BRACING ON SOUTH SIDE OF SURGE TANK SUPPORTS
2. INSTALL NEW KNEE BRACING ON FOUR CORNERS ON SOUTH SIDE OF SURGE TANK SUPPORTS
3. NEW SURGE TANK LEG SUPPORTS ARE TO BE INCLUDED BUT NOT LIMITED TO SPECIFICATIONS UNDER SECTION 05-50-10 STEEL TANK, ELEVATED PLATFORM AND STAIRS
4. ALL NEW STEEL SUPPORTS TO BE PAINTED AS PER SPECIFICATION

SURGE TANK DETAIL


NTS

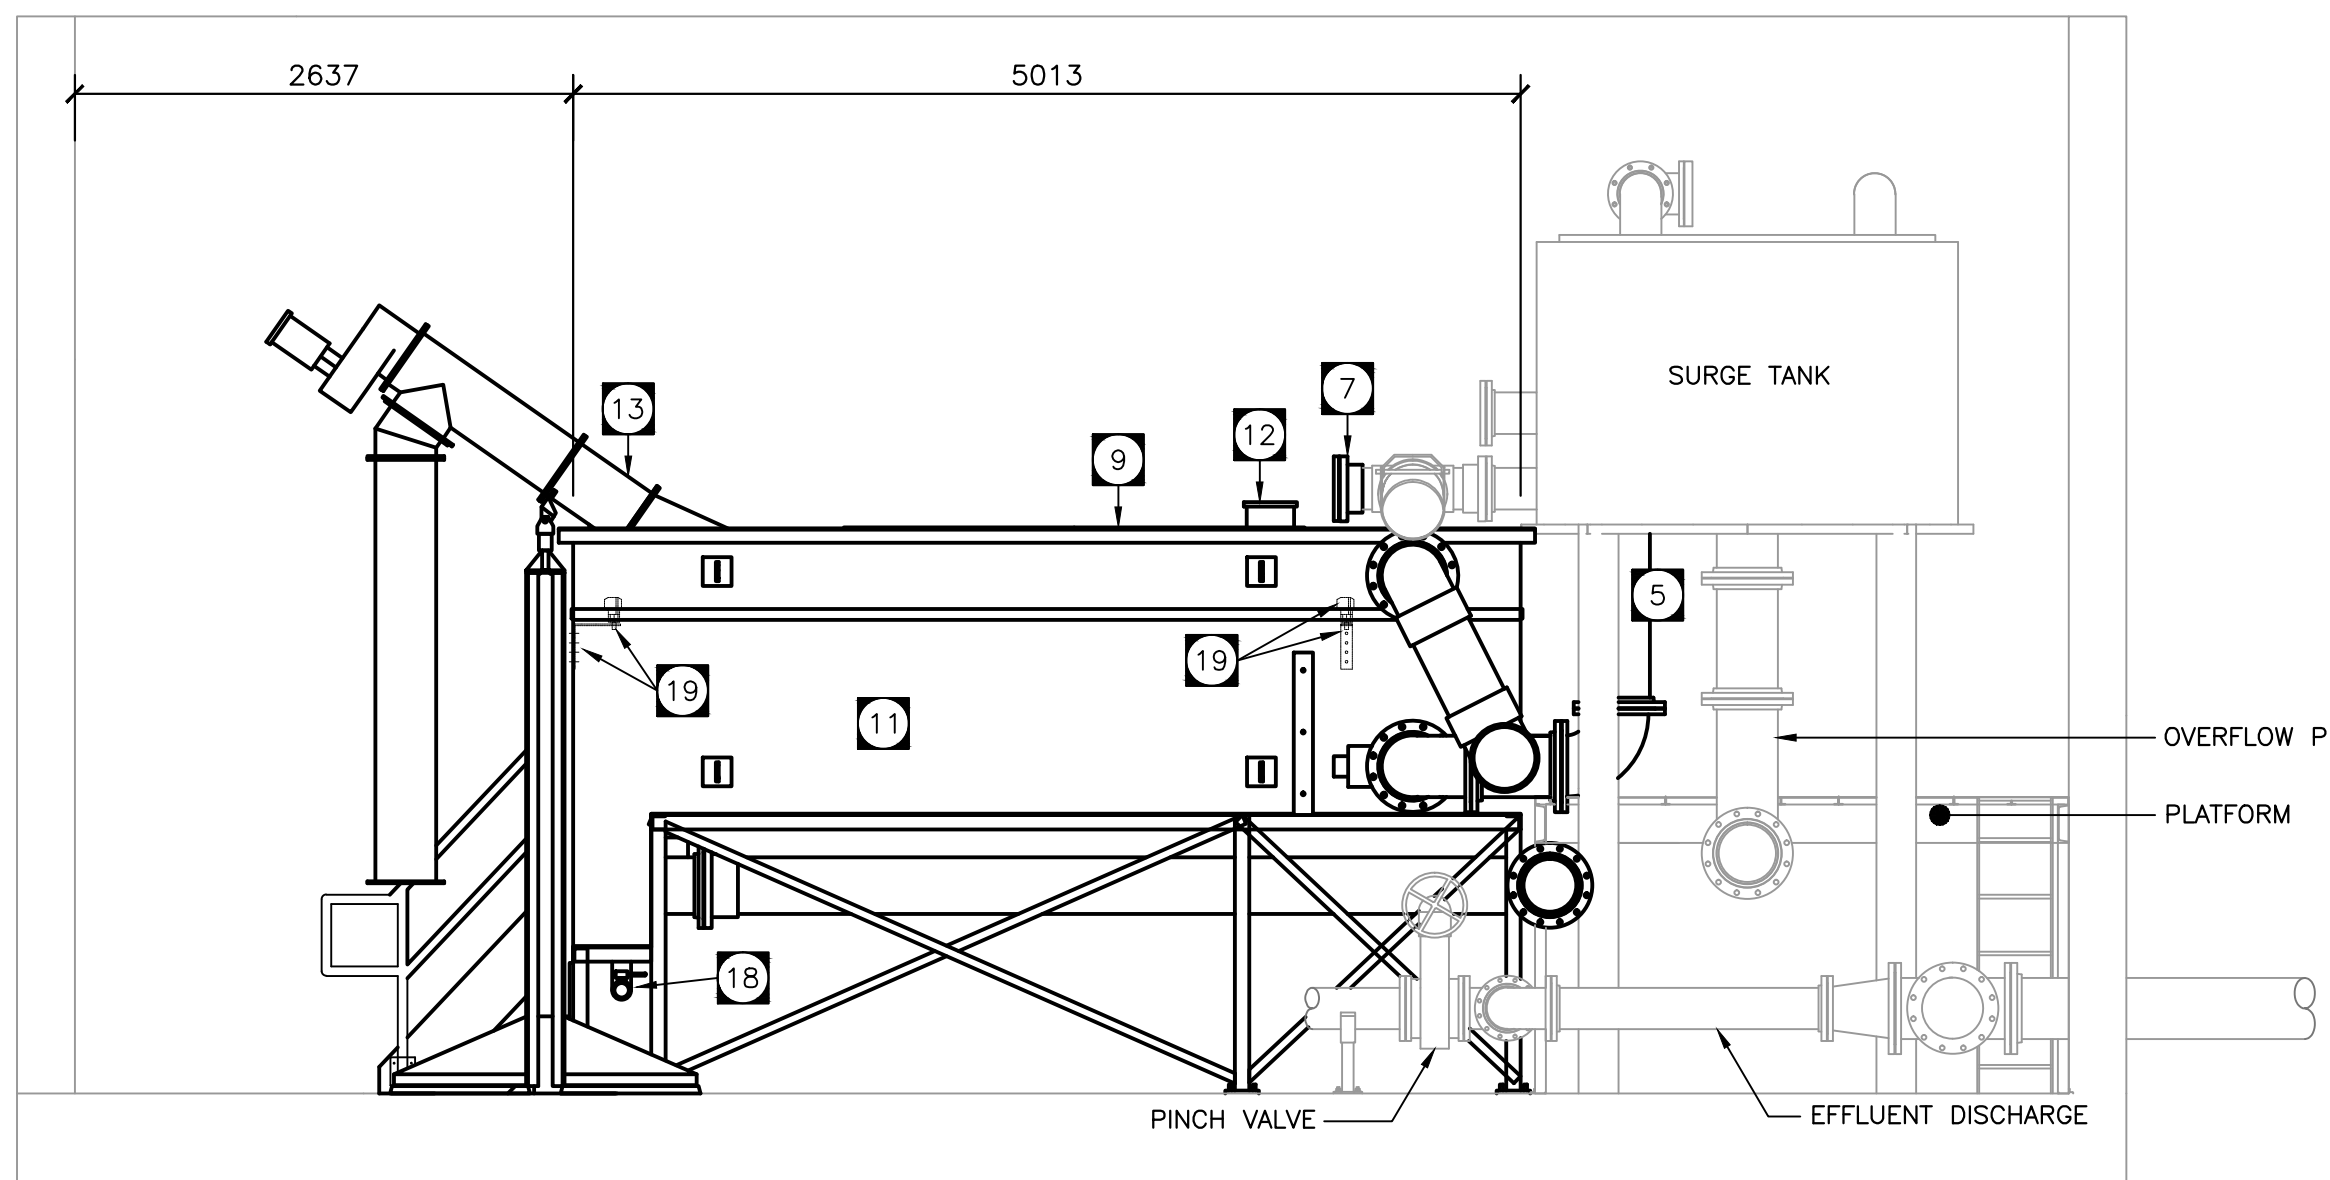

2 MECHANICAL PROCESS SECTION
M9 M10 1:40

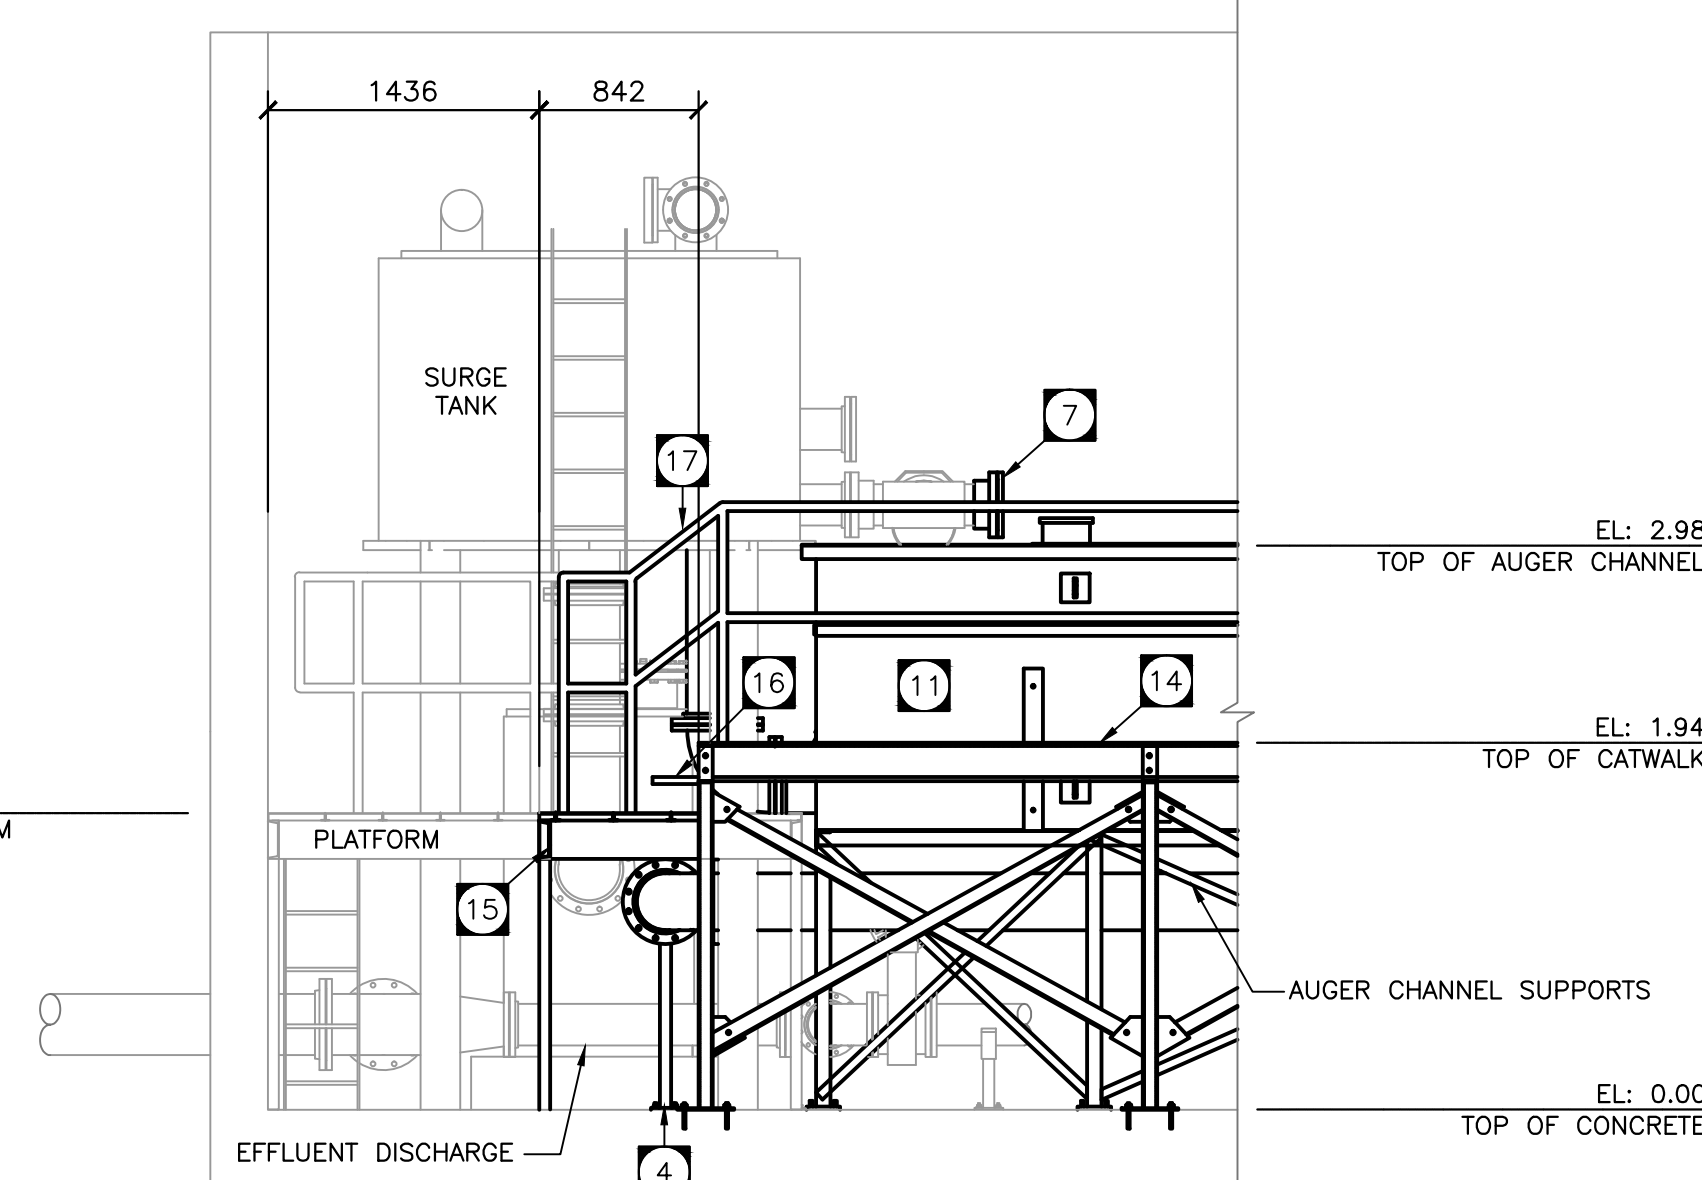

3 MECHANICAL PROCESS SECTION
M9 M10 1:40

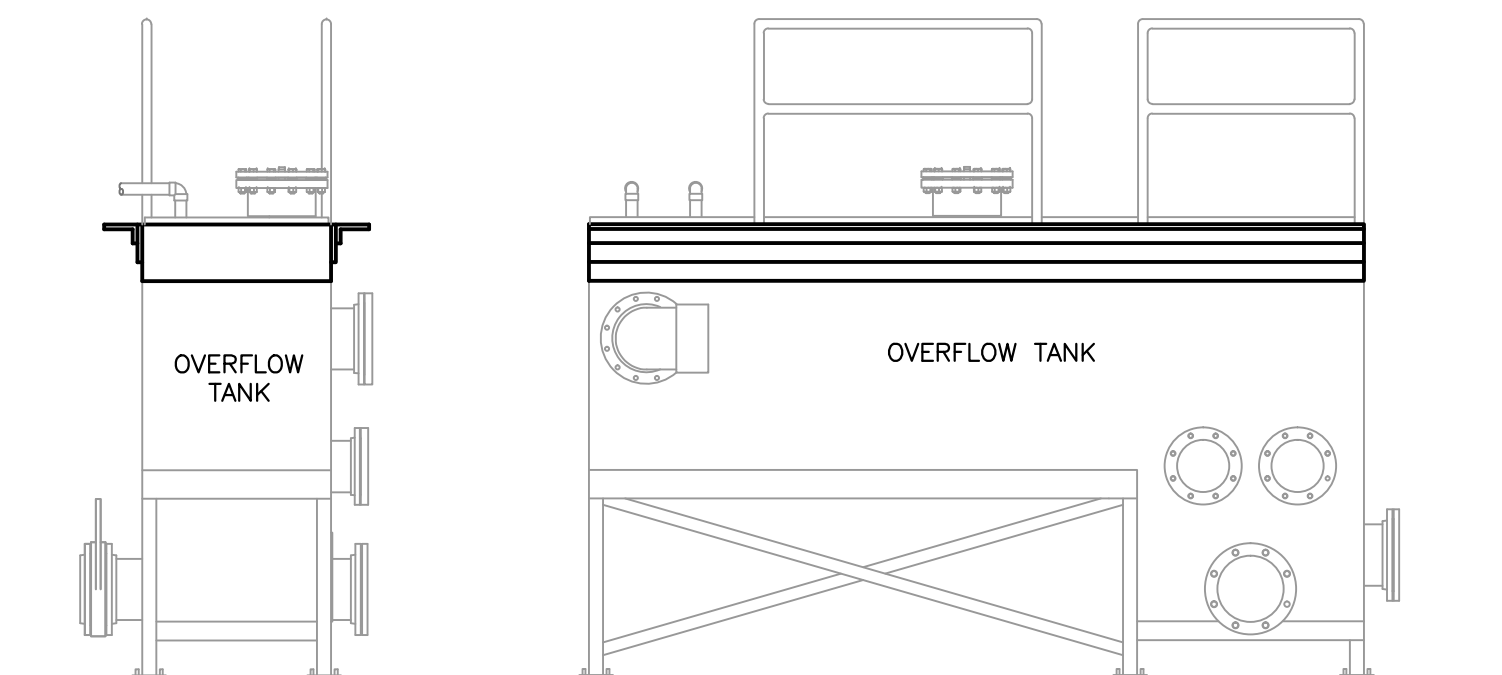

NOTES


1. OVERFLOW TANK WALLS TO BE RAISED 300mm VERTICALLY. STEEL PLATE TO BE 300W AND 0.25mm THICK. WORK TO BE AS PER SECTION 05-50-10 STEEL TANK, ELEVATED PLATFORM AND STAIR SPECIFICATION
2. ALL EXISTING RAILING TO BE RELOCATED AT NEW RAISED ELEVATION
3. ASSOCIATED WORKS SHALL INCLUDE MODIFICATION TO TANK, RELOCATION OF TANK GRATING COVER AND ULTRASONIC LEVEL SENSOR TO RAISED ELEVATION
4. RELOCATION OF ALL MECHANICAL PIPING TO SUIT SIDE WALL
5. TANK, RAILING AND SUPPORTS TO BE PAINTED AS PER SPECIFICATION

OVERFLOW TANK DETAIL

NTS



<p>1. This drawing is the exclusive property of Nuna Burnside and the reproduction of any part without prior written consent of this office is strictly prohibited.</p> <p>2. The contractor shall verify all dimensions, levels, and datum on site and report any discrepancies or omissions to this office prior to construction.</p> <p>3. This drawing is to be read and understood in conjunction with all other plans and documents applicable to this project.</p> <p>4. Do not scale the drawings.</p>	Issue / Revision		Date	<p>AS-BUILT DRAWING</p> <p>AS-BUILT INFORMATION PROVIDED BY THE GENERAL CONTRACTOR:</p> <p>KUDLIK CONSTRUCTION LTD. IQALUIT, NUNAVUT</p>	<p>ORIGINAL STAMPED BY</p> <p>G. POPOWICH 05/27/13</p>	OBJECT LINEWORK			<p>BURNSIDE</p> <p>Nuna Burnside Engineering & Environmental LTD. 106B Scurfield Blvd., Winnipeg, Manitoba telephone (204) 949-7110 fax (204) 949-7111 web www.neeganburnside.com</p>	<p>Client</p> <p>GOVERNMENT OF NUNAVUT COMMUNITY & GOVERNMENT SERVICES</p> <p>RANKIN INLET SEWAGE TREATMENT PLANT</p>	Drawing Title		
	1	ISSUED FOR 99% SUBMISSION		JANUARY 2013		EXISTING	LEGEND - PLAN	PROPOSED			SEWAGE PROCESS EQUIPMENT CROSS SECTIONS		
	2	ISSUED FOR TENDER		FEBRUARY 2013		EXISTING	LEGEND - PLAN	PROPOSED			Drawn By	Checked By	Drawing No.
	3	REVISED AS PER ADDENDUM 1 TO 4 AND ISSUED FOR CONSTRUCTION		APRIL 2013		EXISTING	LEGEND - PLAN	PROPOSED			G. GERUS	G. POPOWICH	M-10
	4	AS-BUILT		AUGUST 2015		EXISTING	LEGEND - PLAN	PROPOSED			Scale	Project No.	

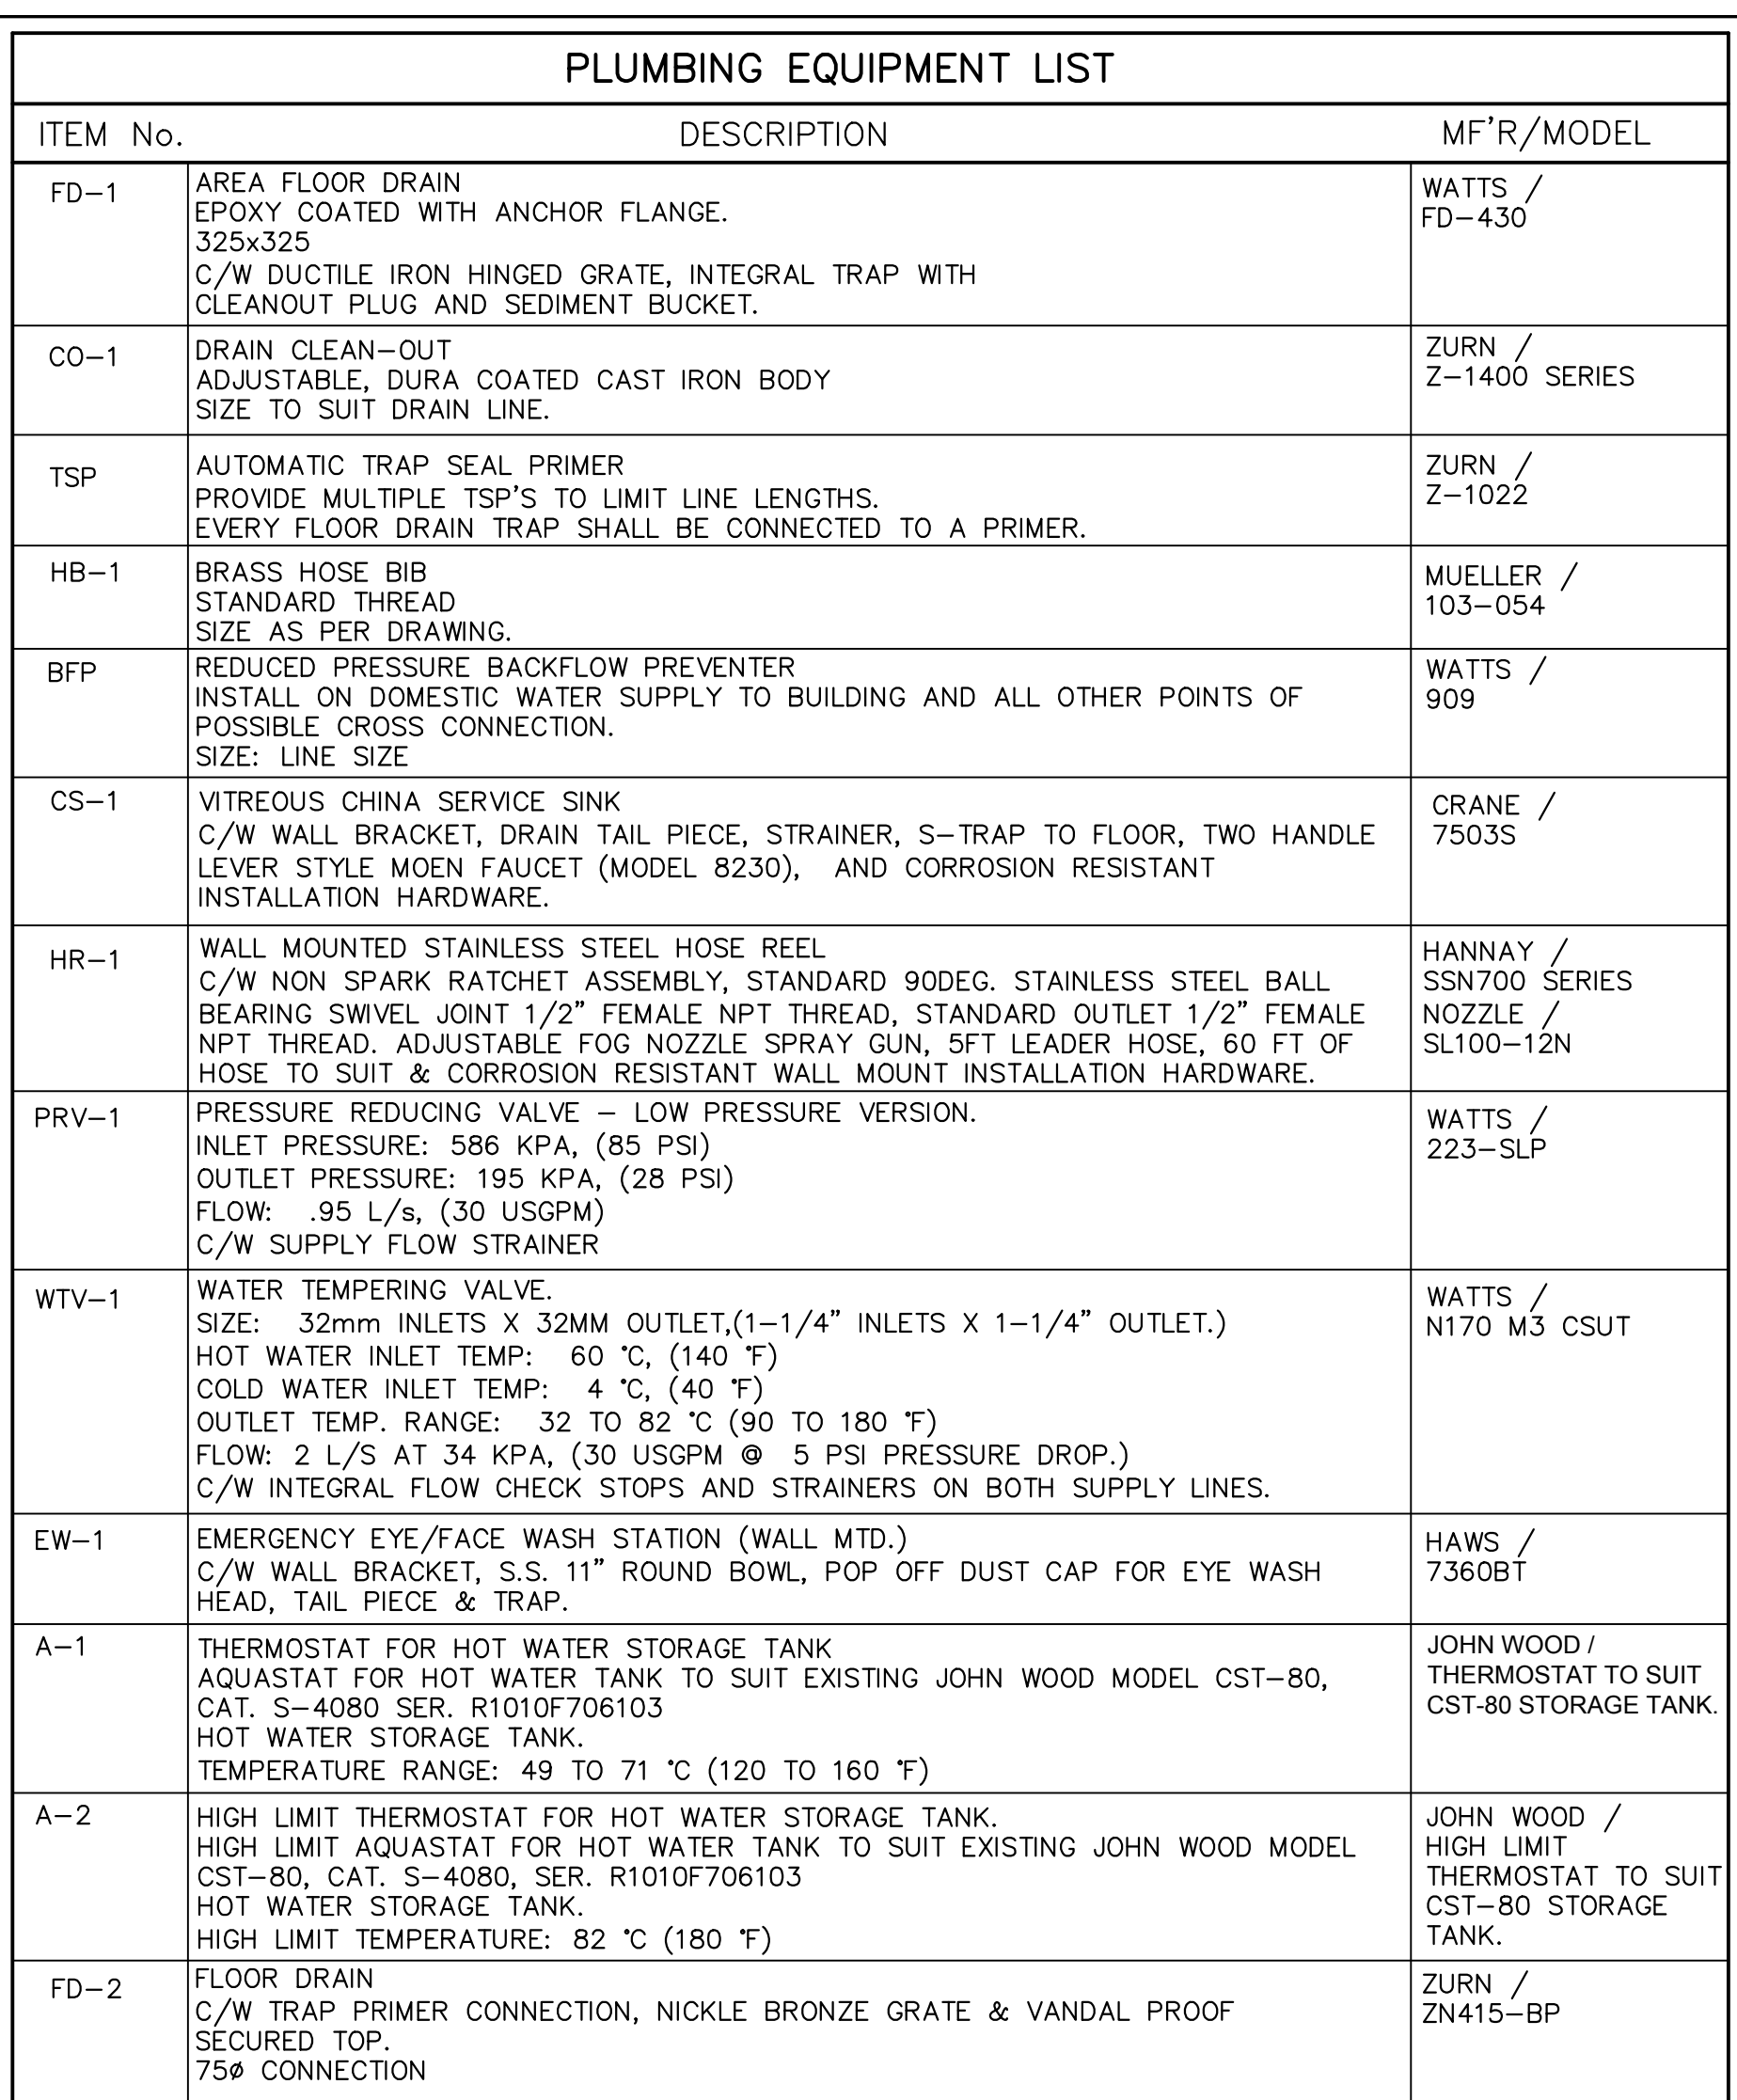

1. INSTALL ALL PLUMBING AND DRAINAGE SYSTEMS IN STRICT ACCORDANCE WITH THE NATIONAL PLUMBING CODE, AND TO THE REQUIREMENTS OF LOCAL AUTHORITIES.
2. SLOPE NOMINALLY HORIZONTAL DRAIN LINES AT A MINIMUM 1:100 UNLESS NOTED OTHERWISE.
3. YOKE SANITARY VENTS IN WALLS OR CEILING SPACES TO MINIMIZE BUILDING ENVELOPE PENETRATIONS. MINIMUM ROOF PENETRATION SIZE FOR VENTS IS 75mm.
4. ALL FLOOR DRAIN / TRAP SEALS MUST HAVE TRAP SEAL PIPING IN LOCATION OF TRAP SEAL DIST. HEADERS TO BE DETERMINED IN THE FIELD. CONTRACTOR TO SUBMIT SHOP DRAWINGS FOR FLOOR DRAIN / PRIMER WATER FOR REVIEW PRIOR TO ANY INSTALLATION WORKS PROCEEDING.
5. HOT AND COLD WATER SUPPLY PIPING TO BE COPPER.
6. INSULATE ALL HOT AND COLD WATER LINES WITH 25mm THICK PRE-FORMED PIPE INSULATION COVERED WITH ASJ, (VAPOUR PROOF JACKET).

PIPING BURIED OR CAST IN CONCRETE

POTABLE WATER	- 75mm AND OVER --- DUCTILE IRON
(HOT & COLD)	- 62mm AND UNDER --- SCHED. 80 CPVC
SANITARY WASTE	- PVC SEWER PIPE
TRAP PRIMER LINE	- 12mm SCHED. 80 PVC

POTABLE WATER	- 62mm AND OVER --- SCHED. 80 PVC
(BELOW FLOOR SLAB)	- 50mm AND UNDER --- SCHED. 80 PVC
POTABLE WATER	- 75mm AND OVER --- DUCTILE IRON
(ABOVE FLOOR SLAB)	- 62mm AND UNDER --- SCHED. 80 CPVC
SANITARY WASTE	- ABS DWV (ABOVE FLOOR SLAB)
AND VENT	- PVC SDR35 (BELOW FLOOR SLAB)
FUEL OIL	- MILL STEEL PIPE SCHED 40

ITEM	DESCRIPTION	PLUMBING CONNECTIONS			
		SANITARY	COLD WATER	HOT WATER	VENT
LAV	LAVATORY (ALL)	36mm	12mm	12mm	36mm
WC	WATER CLOSET (ALL)	75mm	25mm	----	36mm
TSP	TRAP SEAL PRIMER	----	12mm	----	----
FD	FLOOR DRAIN (ALL)	75mm	----	----	----

[illegible]