




REPAIR MORTAR TYPE TO BE
SELECTED TO SUIT AMOUNT, TYPE,
DEPTH OF REPAIR, AND TO BE
ACCEPTABLE FOR USE IN POTABLE
WATER RESERVOIR.

RECEIVE ENGINEER'S APPROVAL OF
MORTAR PRODUCT PRIOR TO
PROCEEDING.

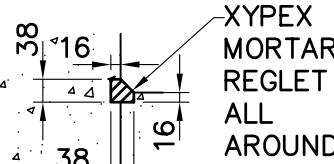

DETAIL

EXIST. CONC. WALLS
BEYOND TO REMAIN

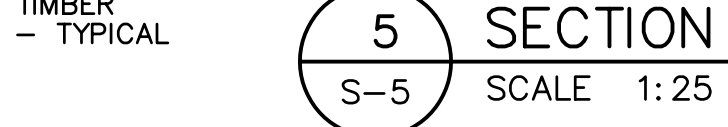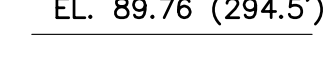

NOTES:

1. REFERENCE : INFORMATION PRESENTED ON THIS DRAWING DESCRIBING EXISTING STRUCTURE FROM CONTRACT NO. CA-62-1-28 DRAWINGS.
2. ALL EXISTING WALLS AND SLABS ARE REINFORCED CONCRETE. REINFORCEMENT NOT INDICATED.
3. REFER TO DEPARTMENT OF PUBLIC WORKS CANADA - WATER TREATMENT AND WATER SUPPLY DRAWINGS FOR FROBISHER BAY N.W.T. CONTRACT NO. CA-62-1-28 FOR DETAILS DESCRIBING EXISTING STRUCTURE.

Company Permit	Engineer Seal
RECORD DRAWING INFORMATION CONTAINED IN THESE DRAWINGS IS AS SUPPLIED BY: NINETY NORTH CONSTRUCTION & DEVELOPMENT LTD. THE COMPLETENESS AND ACCURACY OF THIS RECORD DRAWING IS <u>NOT</u> GUARANTEED. INFORMATION SHOULD BE VERIFIED AT THE ACTUAL LOCATION BEFORE USE.	

RECORD DRAWING
INFORMATION CONTAINED IN THESE DRAWINGS
IS AS SUPPLIED BY:
NINETY NORTH CONSTRUCTION &
DEVELOPMENT LTD.
THE COMPLETENESS AND ACCURACY OF THIS
RECORD DRAWING IS NOT GUARANTEED.
INFORMATION SHOULD BE VERIFIED AT THE
ACTUAL LOCATION BEFORE USE.

STRUCTURAL

SECTIONS AND DETAILS



**CITY of IQALUIT,
Nunavut**

CITY OF IQALUIT

IQALUIT WATER TREATMENT PLANT



Earth Tech (Canada) Inc

DRAWN BY: BL CHECKED BY: GJK	SCALE: AS NOTED	DATE: FEB. 19, 2003	SHEET NO.
CADD SYSTEM AutoCAD	DWG NO.	S-8	REV. 1 CONTRACT 55524