




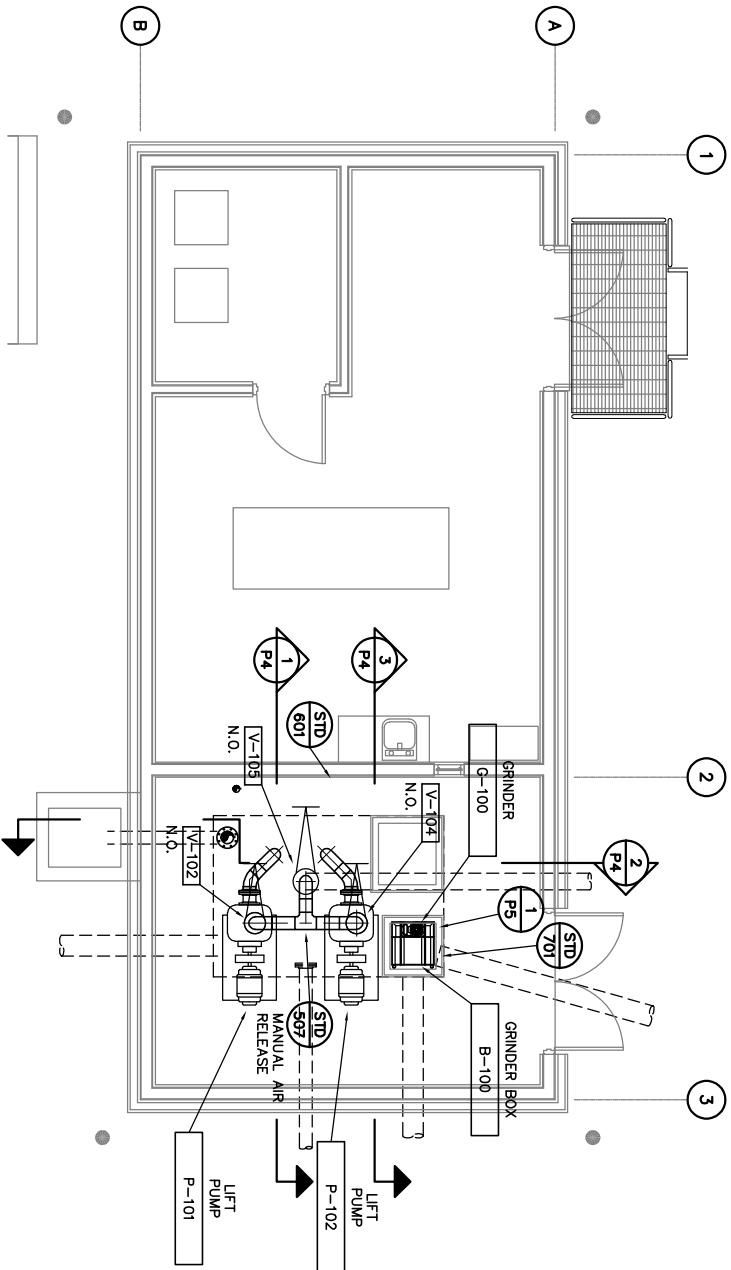


FLOOR PLAN
1:50

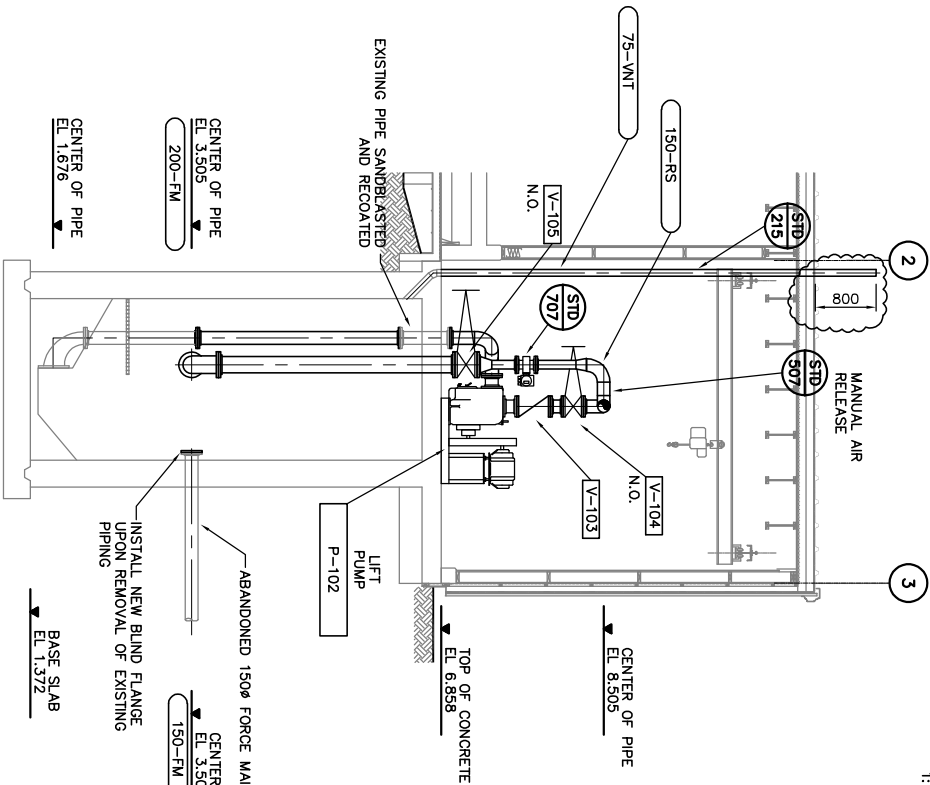

SECTION 1
1:50

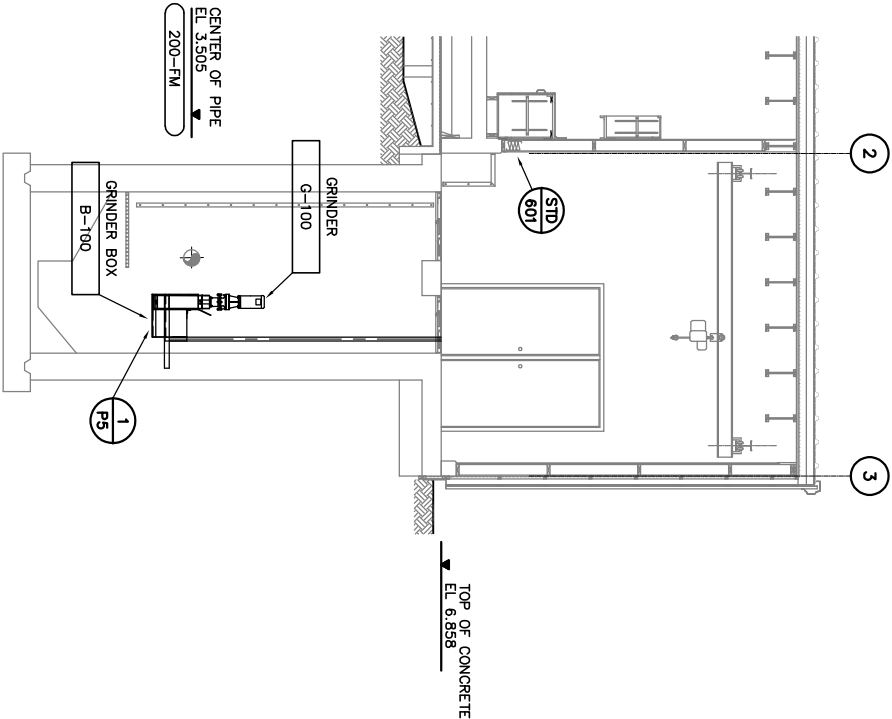

SECTION 2
1:50

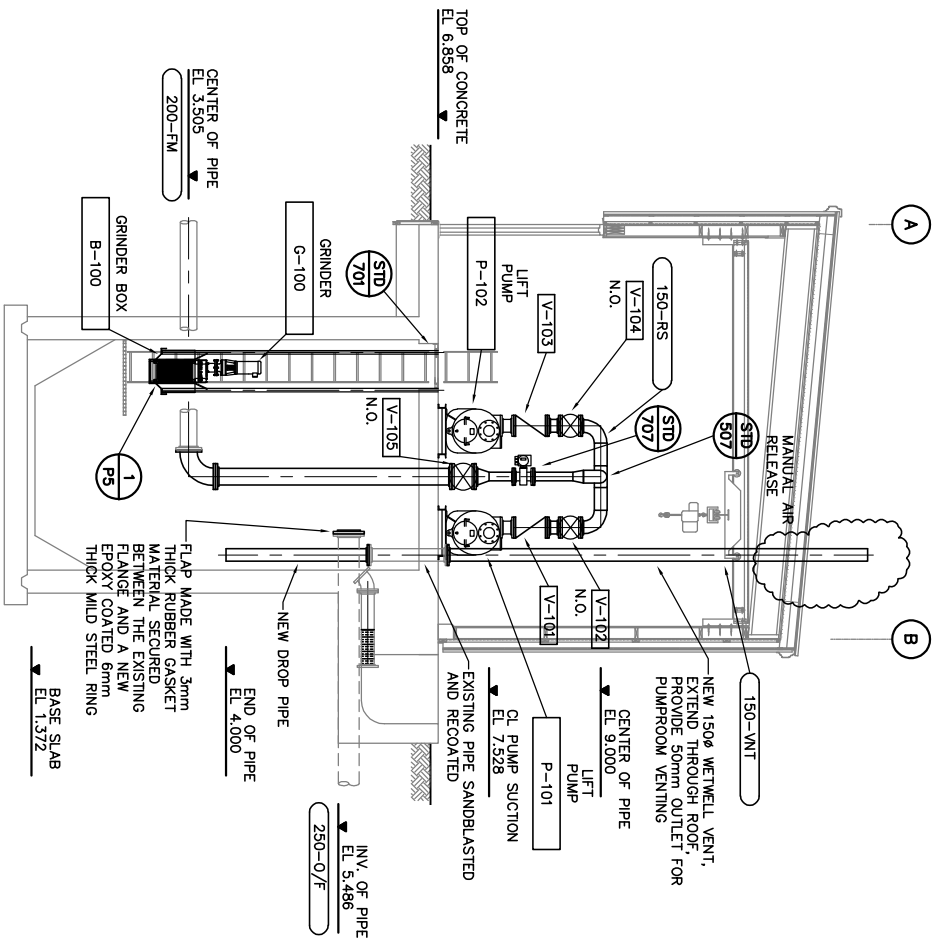

SECTION 3
1:50

NOTES:
1. PROVIDE PIPING SUPPORTS TO ENSURE THAT NO WEIGHT FORM THE PIPING IS TRANSFERRED TO THE PUMPS.
2. ALL NEW PIPING IS TO BE EPOXY COATED IN AND OUT, SEE SPECIFICATIONS FOR COATING REQUIREMENTS.

EarthTech
A 100% owned and operated company
17203-103rd Avenue
Edmonton, Alberta
T5S 1A4 CANADA
Tel. 780-486-6800
Fax. 780-486-2121
www.earthtech.ca

RECORD DRAWING
INFORMATION CONTAINED IN THESE DRAWINGS IS AS SUPPLIED BY THE CLIENT. EARTHTECH LTD. MAKES NO WARRANTY, REPRESENTATION OR GUARANTEE OF THE COMPLETENESS AND ACCURACY OF THIS RECORD DRAWING. INFORMATION SHOULD BE VERIFIED AT THE ACTUAL LOCATION BEFORE USE.

No.	Date	Description
1	06/20	ISSUED FOR TENDER
2	06/20	RECORD DRAWING
3	06/20	GENERAL REVISION
4	06/20	GENERAL REVISION

City of Iqaluit
City of Iqaluit
Nunavut

Design	RHB
Drawn	DKB
Approved	
Checked	

LIFT STATION
No. 1 UPGRADE

PROCESS
PLANS &
SECTIONS

Scale	1:50
Project No.	84454
Date	13/04/05
Drawing No.	P4
Revision	2