

Iqaluit



LEGEND

PERMIT OF PRACTICE
TROW ASSOCIATES INC.


Signature Steve Bouchard

Date May 11, 2010

PERMIT NUMBER: P184
The Association of Professional Engineers
Geologists and Geophysicists of the NWT/NU

Kudlik Construction Ltd.
As-Permitted: 10/05/10
P.O. Box 727, 1519 Federal Road
Iqaluit (Nunavut) X0A 0H0
Tel.: (867) 979-1165
Fax: (867) 979-1169
Issue for As Built: 08-02-2012

No.	DESCRIPTION	DATE	BY	APP'D
03	ISSUED FOR CONSTRUCTION	10/05/10	ABZ	SLB
02	ISSUED FOR TENDER	05/06/09	ABZ	SLB
01	90% SUBMISSION	17/04/09	ABZ	SLB
REVISIONS				

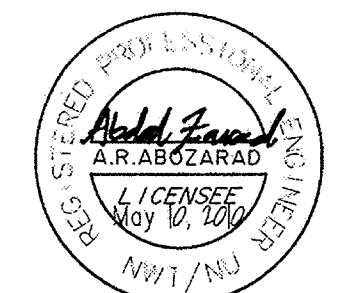


Trow Associates Inc.
154 Colonnade Road South
Ottawa, Ont. K2E 7J5
Tel: (613) 225-9940
Fax: (613) 225-7337

CLIENT
CITY OF IQALUIT


PROJECT
LIFT STATION No. 2
MODIFICATIONS

TITLE
DEMOLITION & MODIFICATIONS


design by	ABZ	project no.	OTCD19365A
drawn by	ABZ	drawing no.	P-2
checked by	SLB		
date	30/01/09		
scale	HORIZ 1:50		

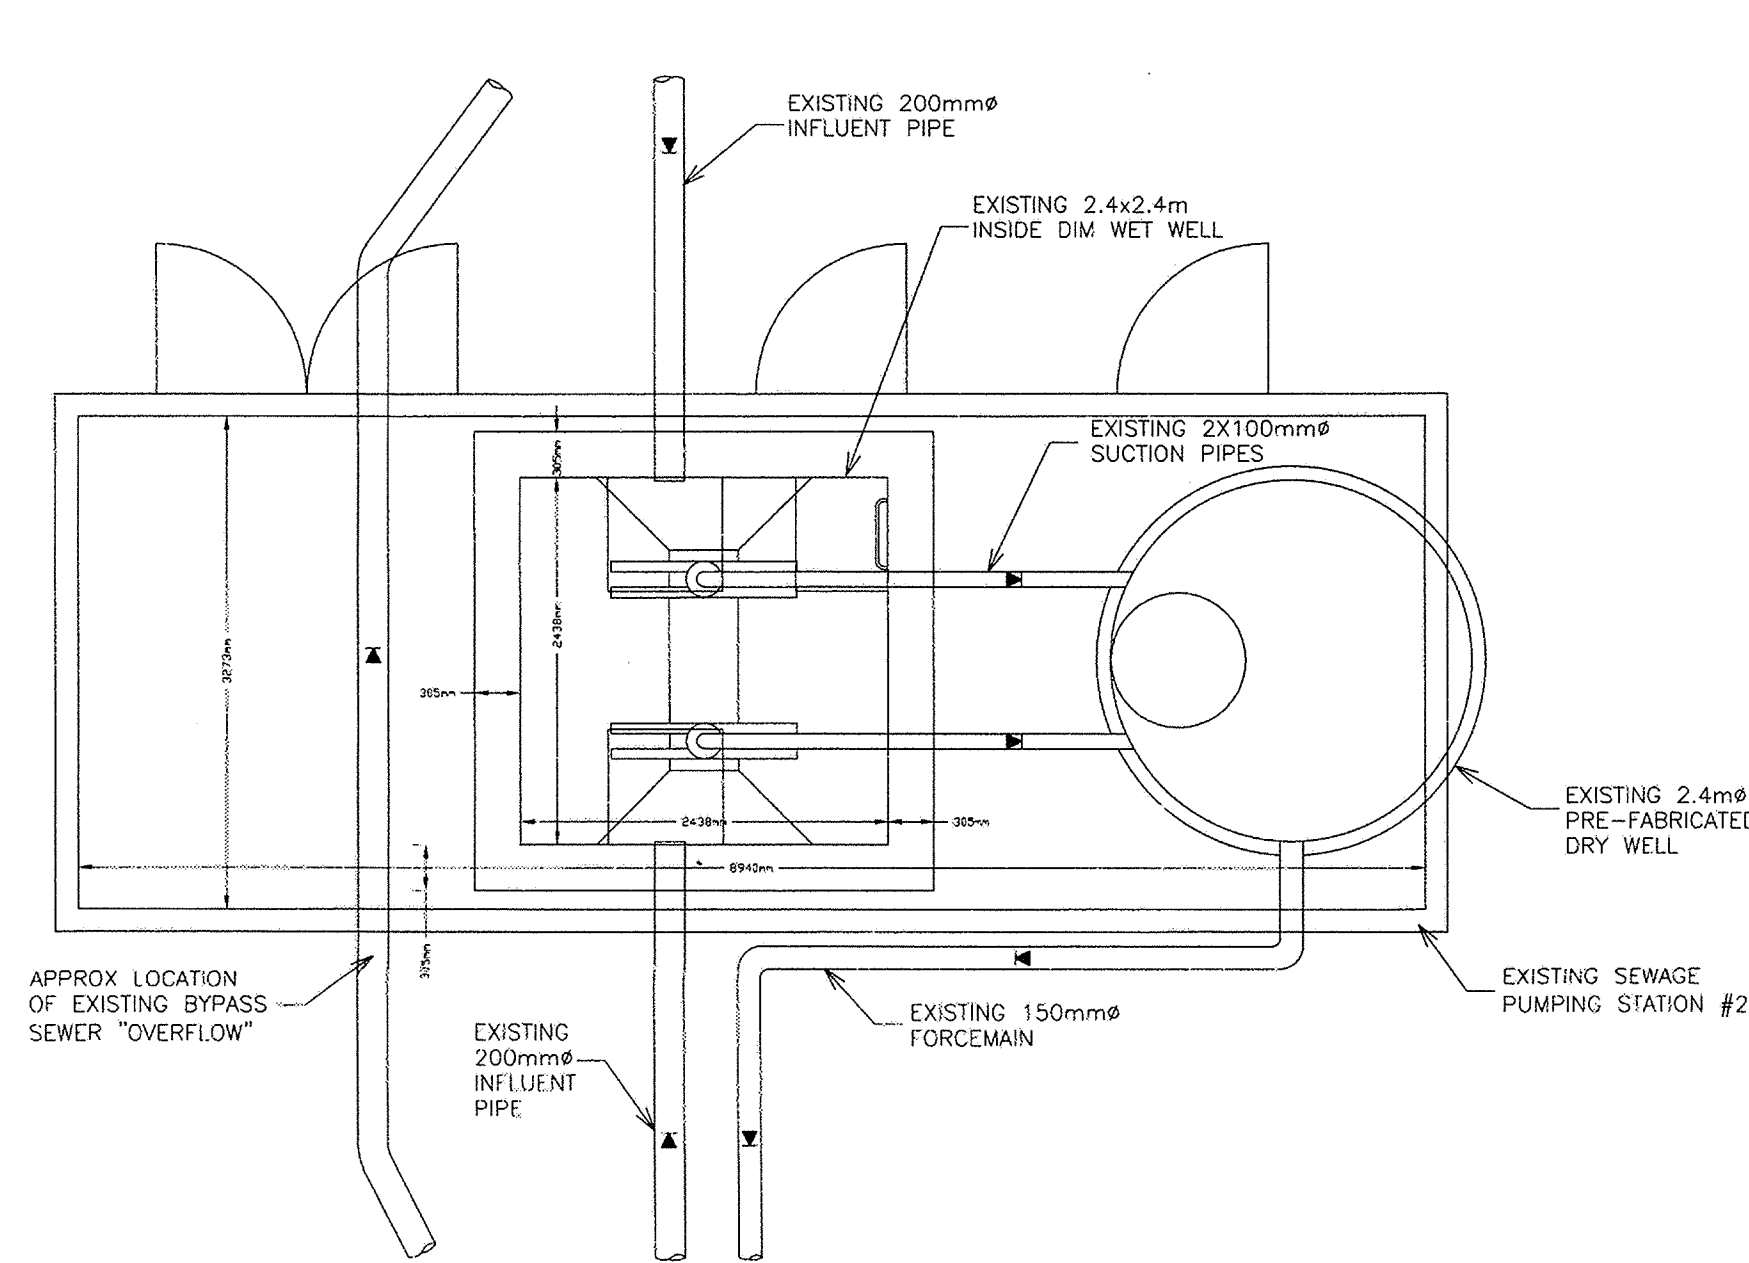

EXISTING PUMPING STATION
PLAN VIEW

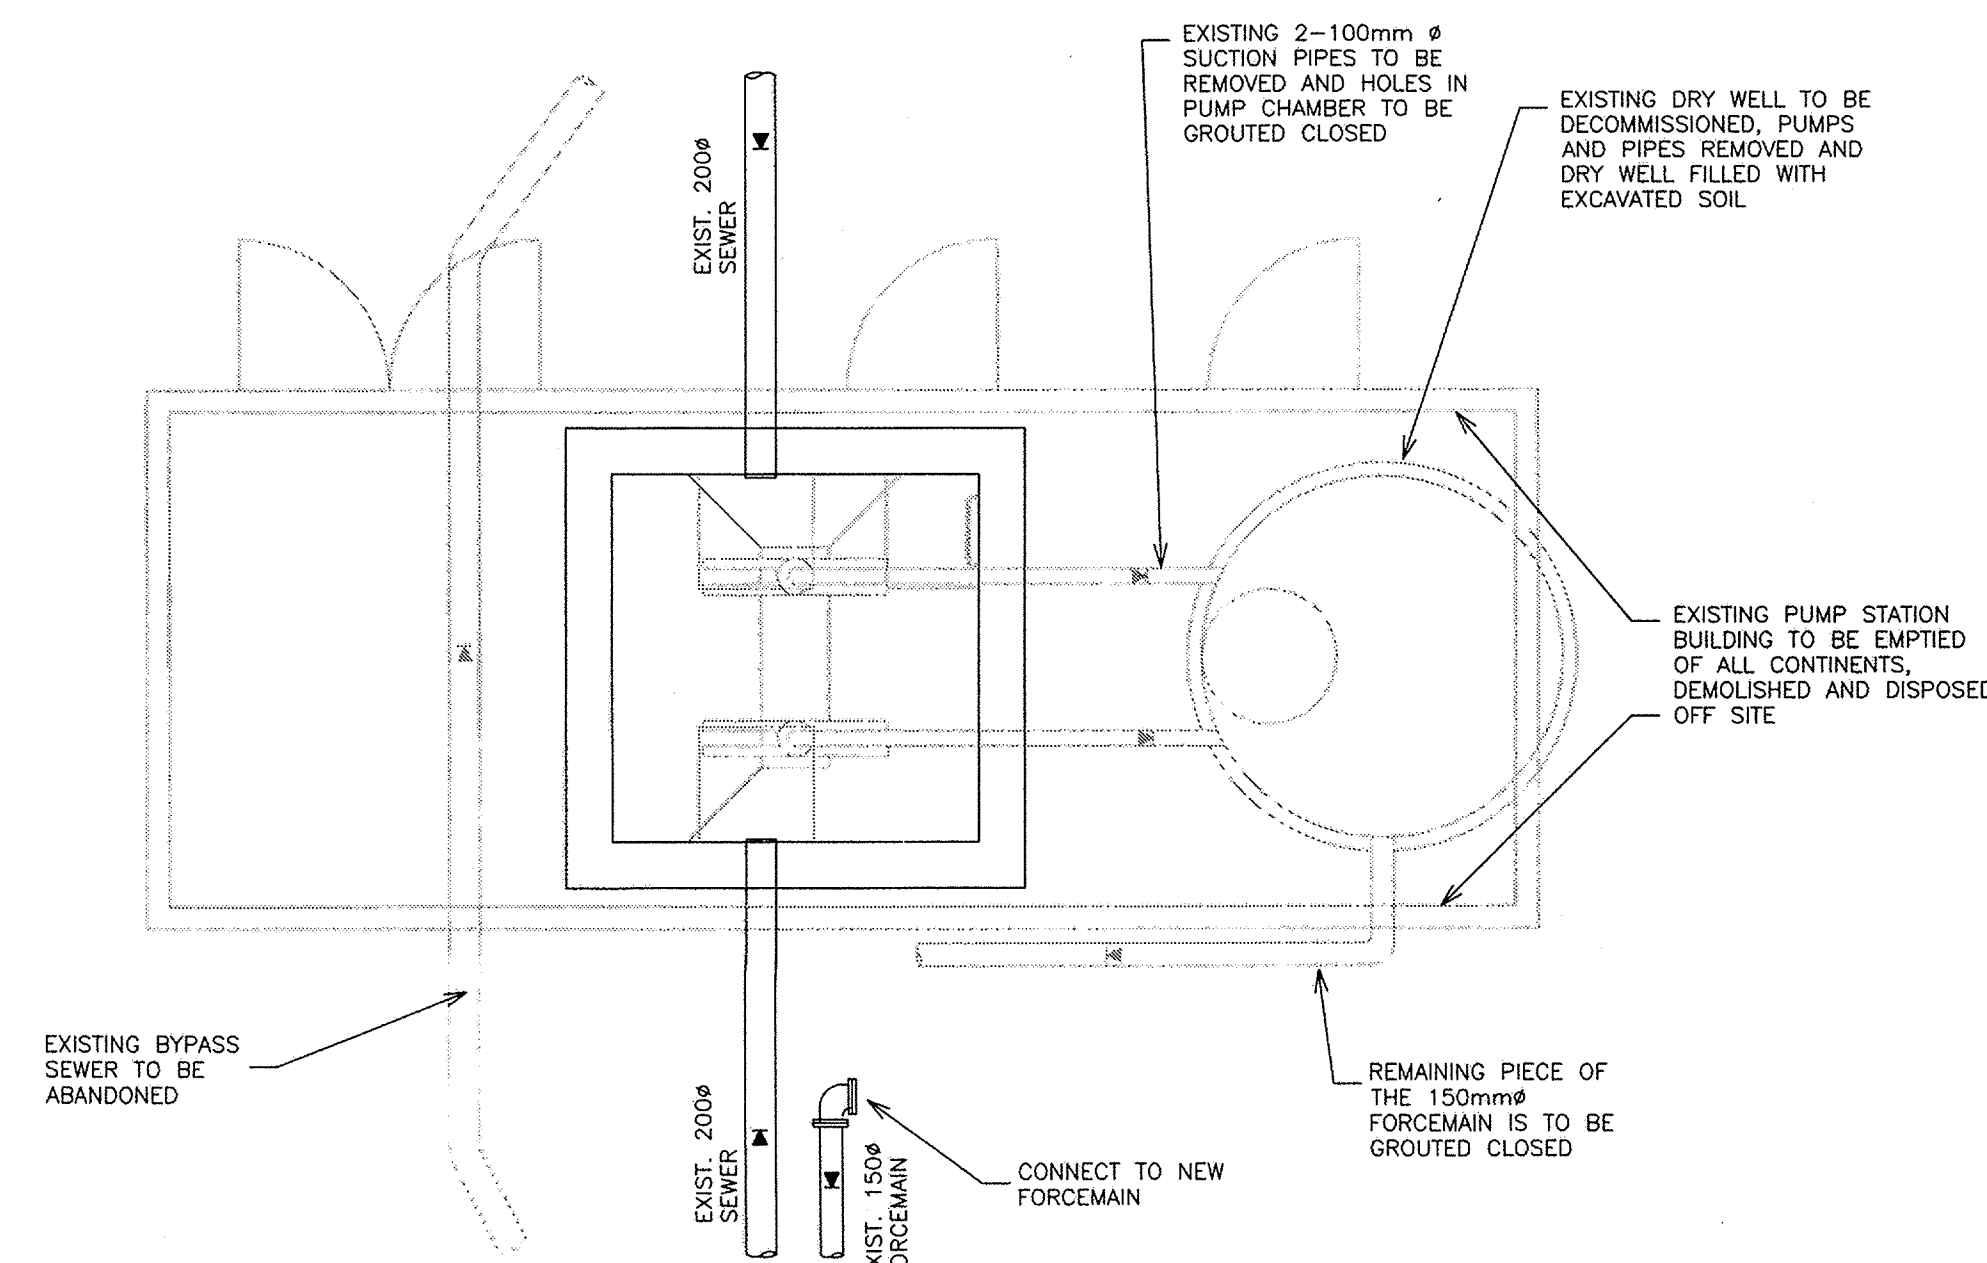


WET WELL
MODIFICATIONS

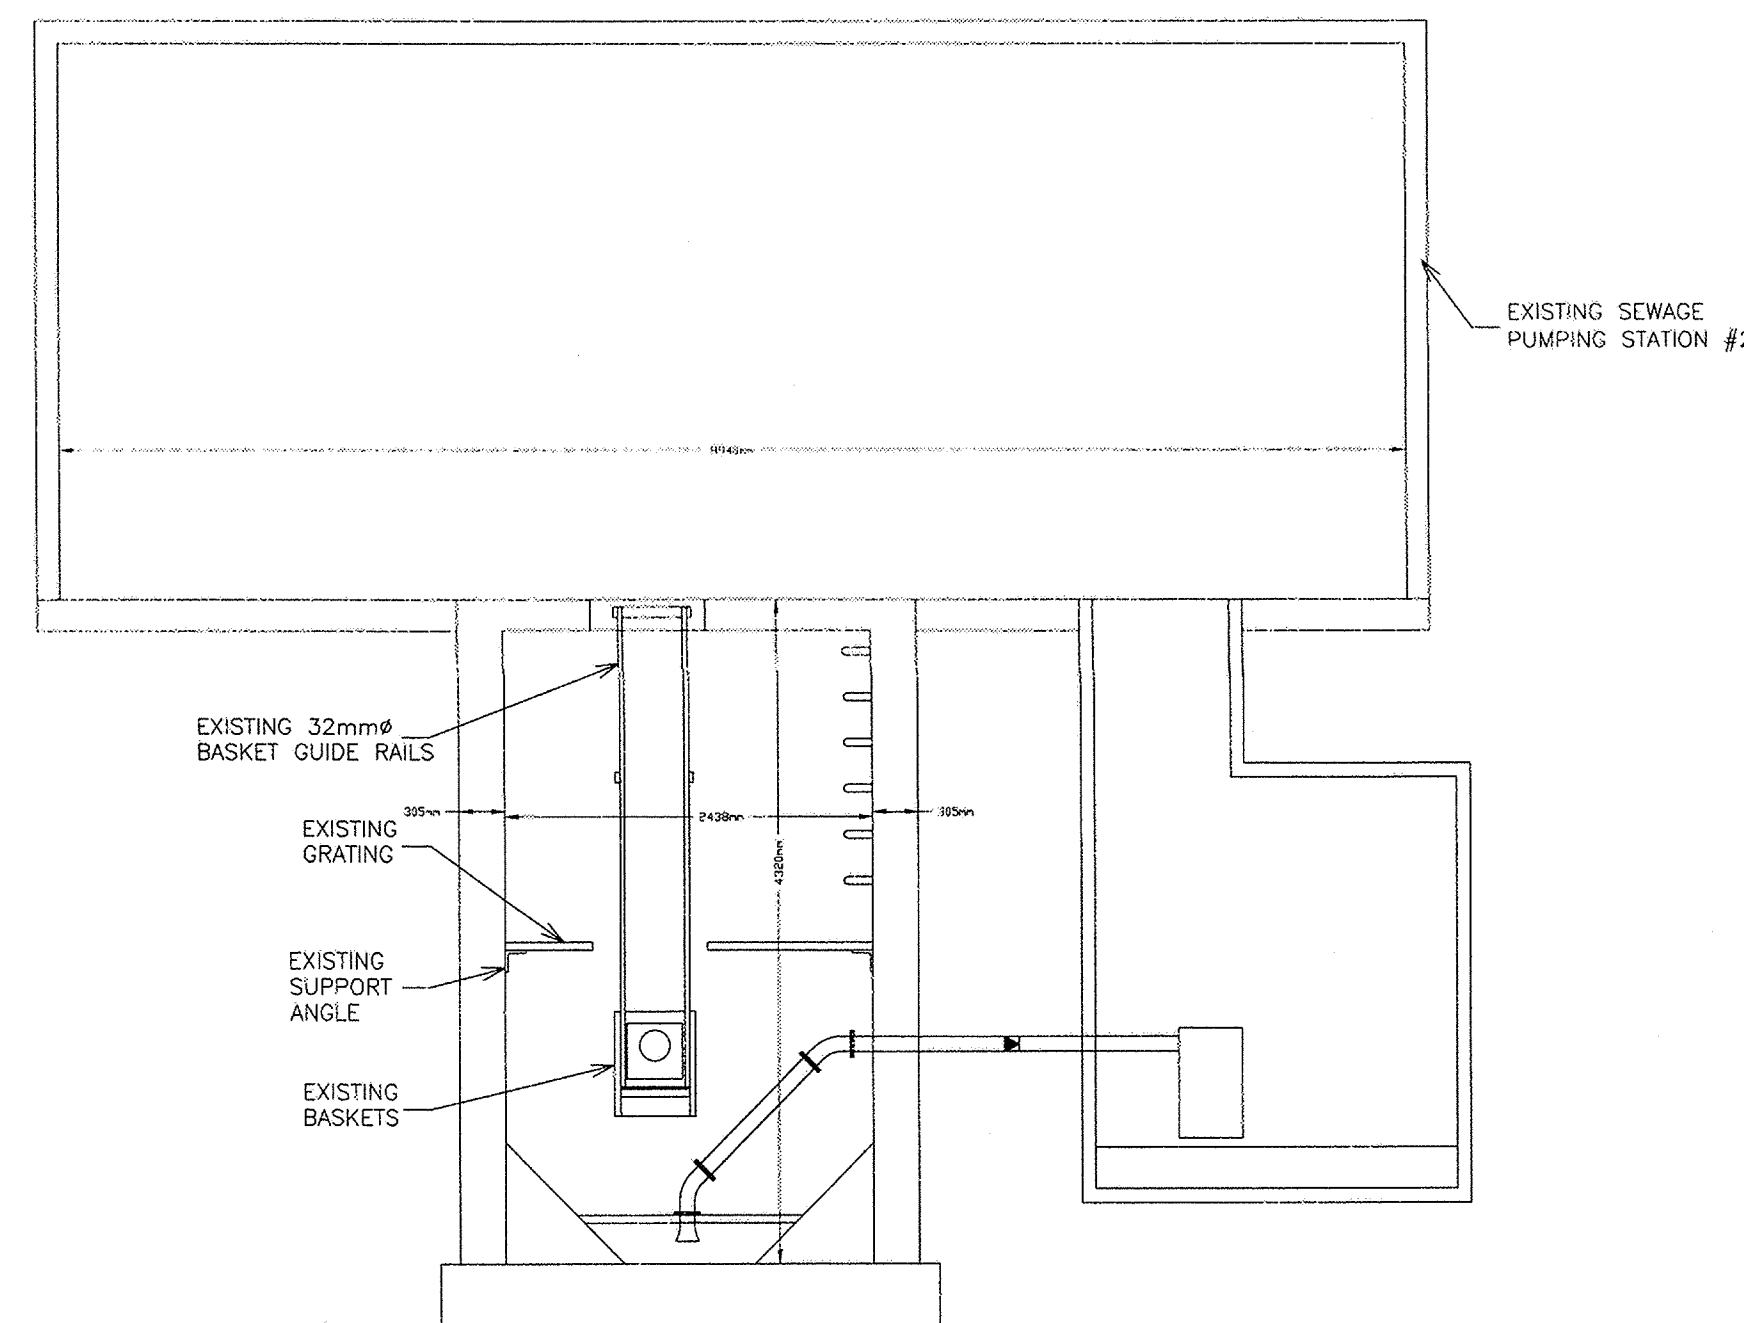

EXISTING WET WELL
SECTION

EXISTING GRADE

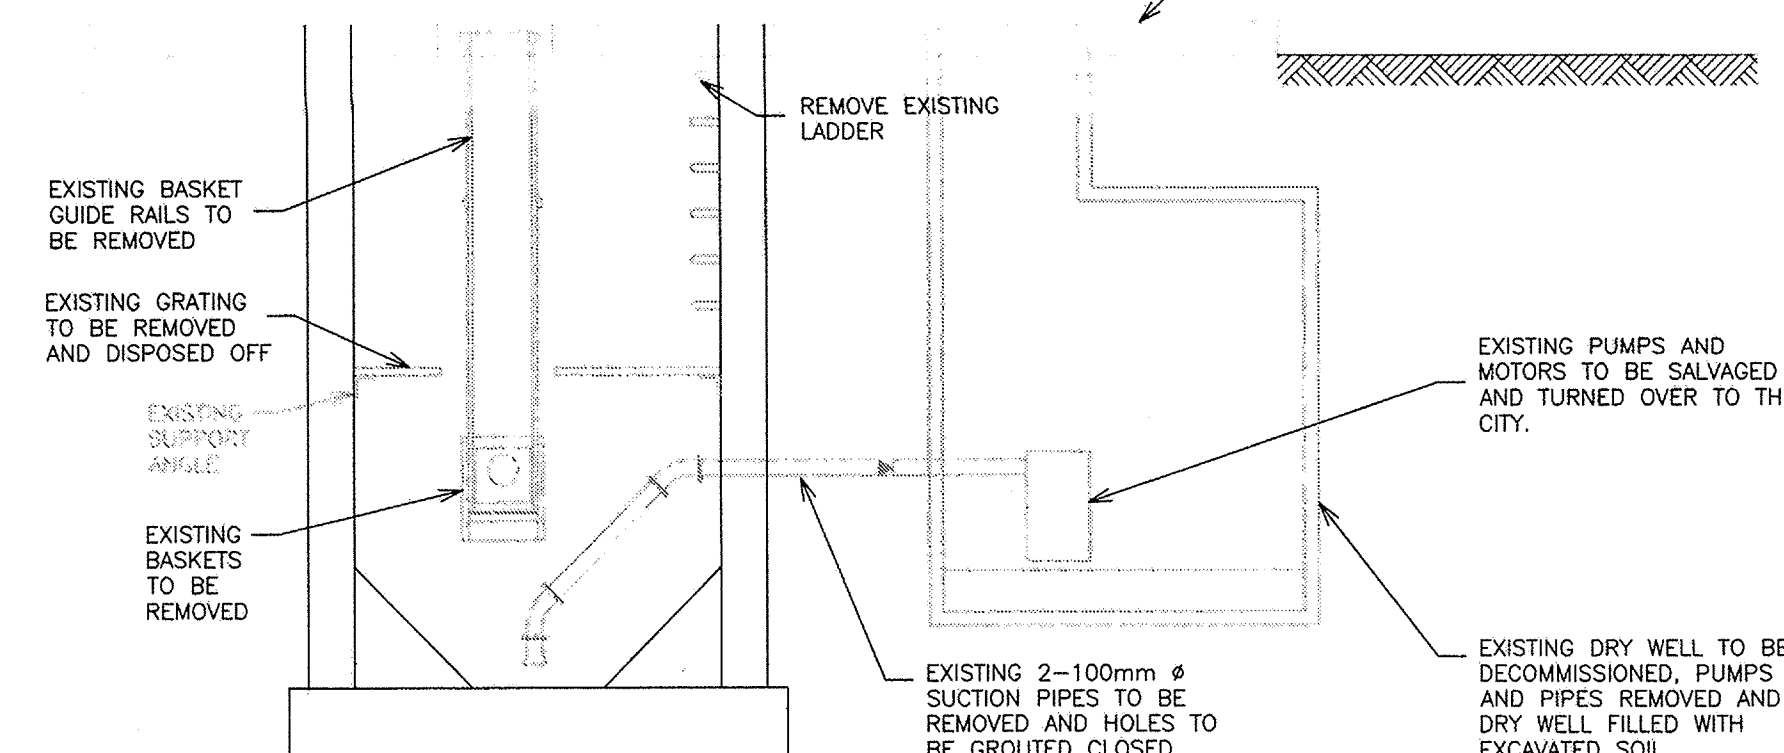

EXISTING DRY WELL
SECTION