

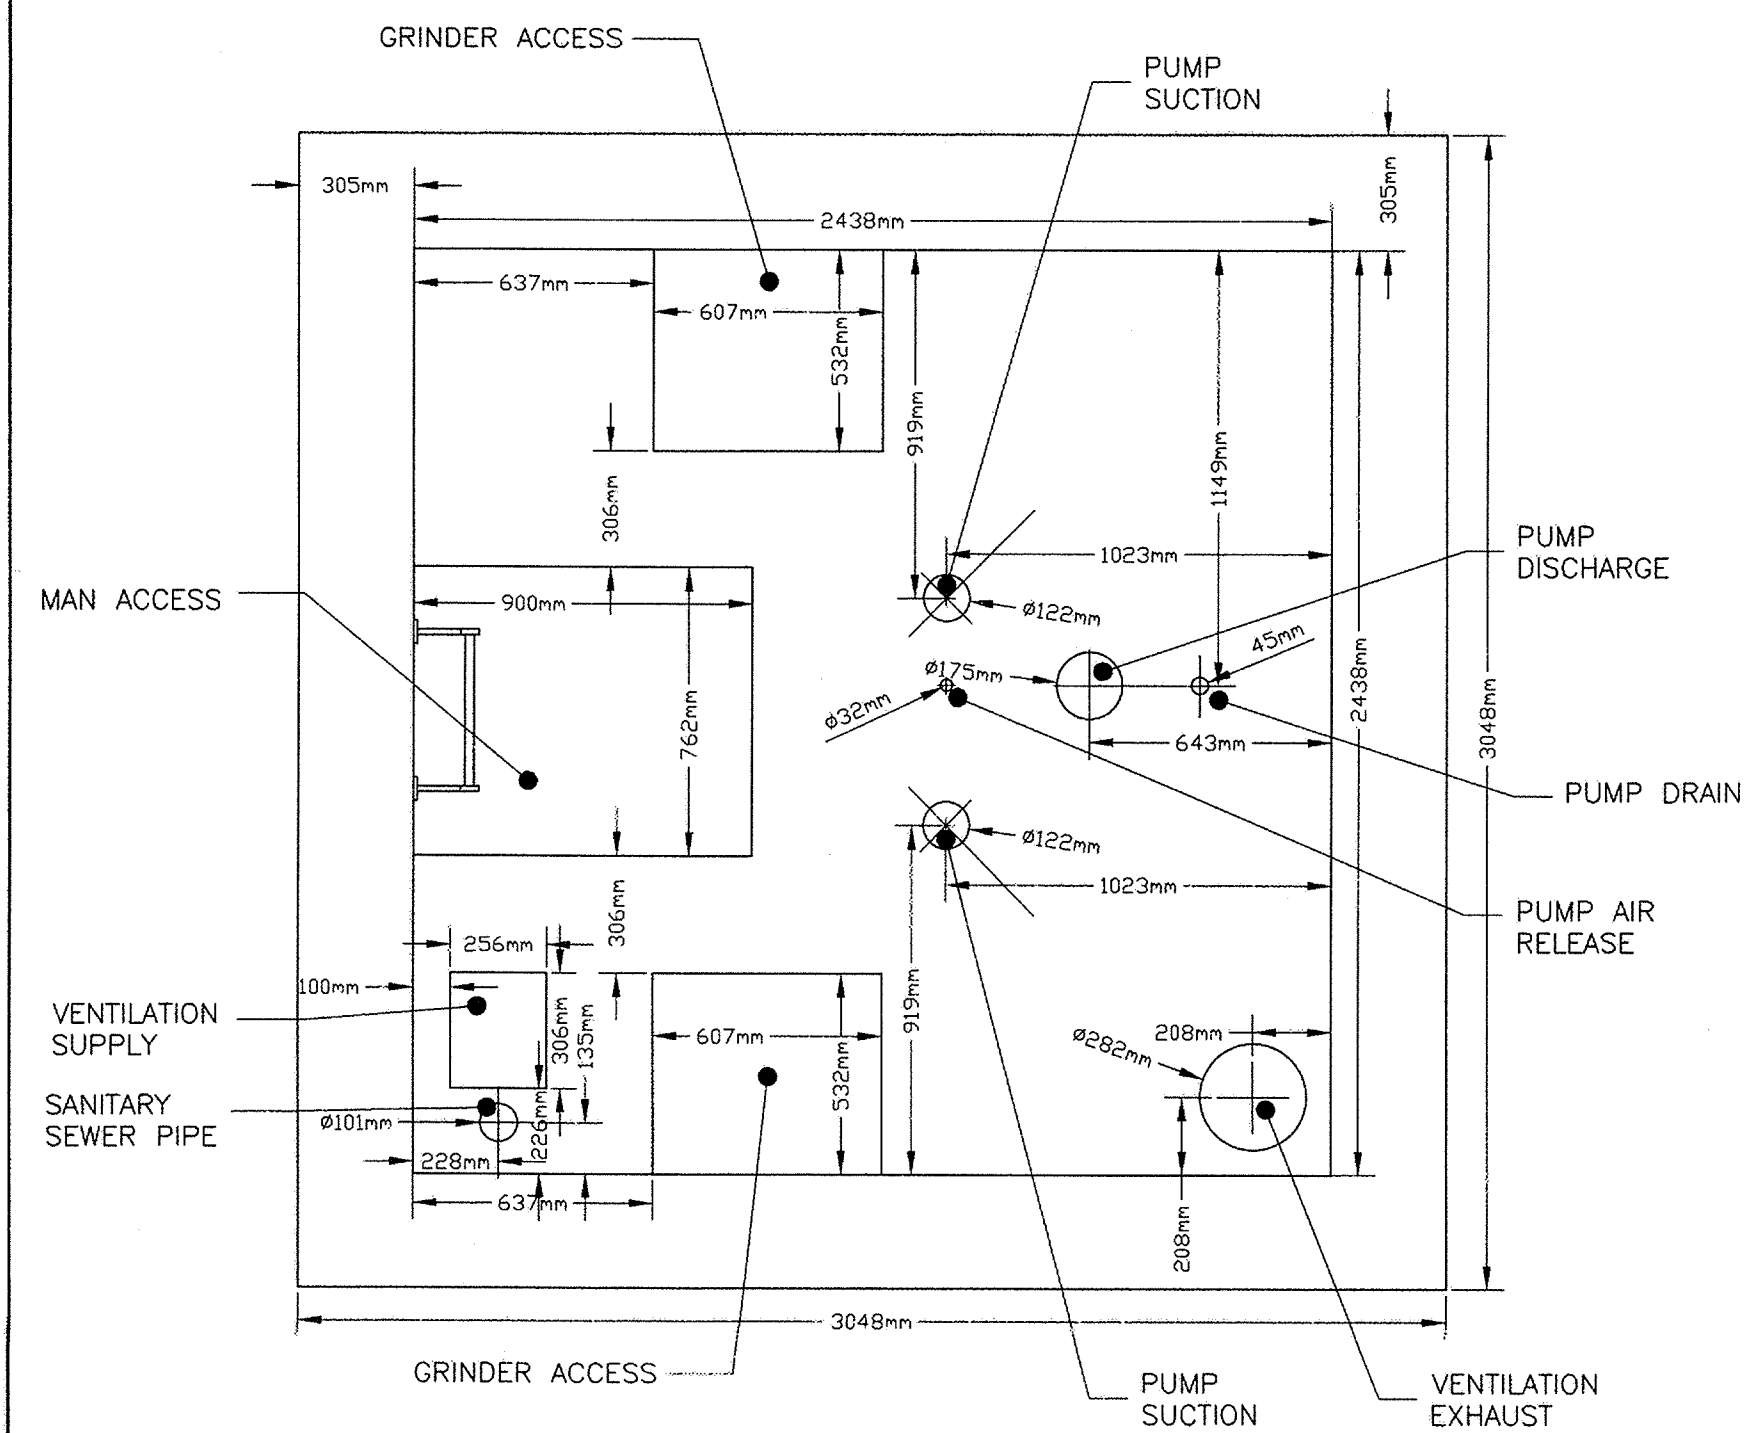


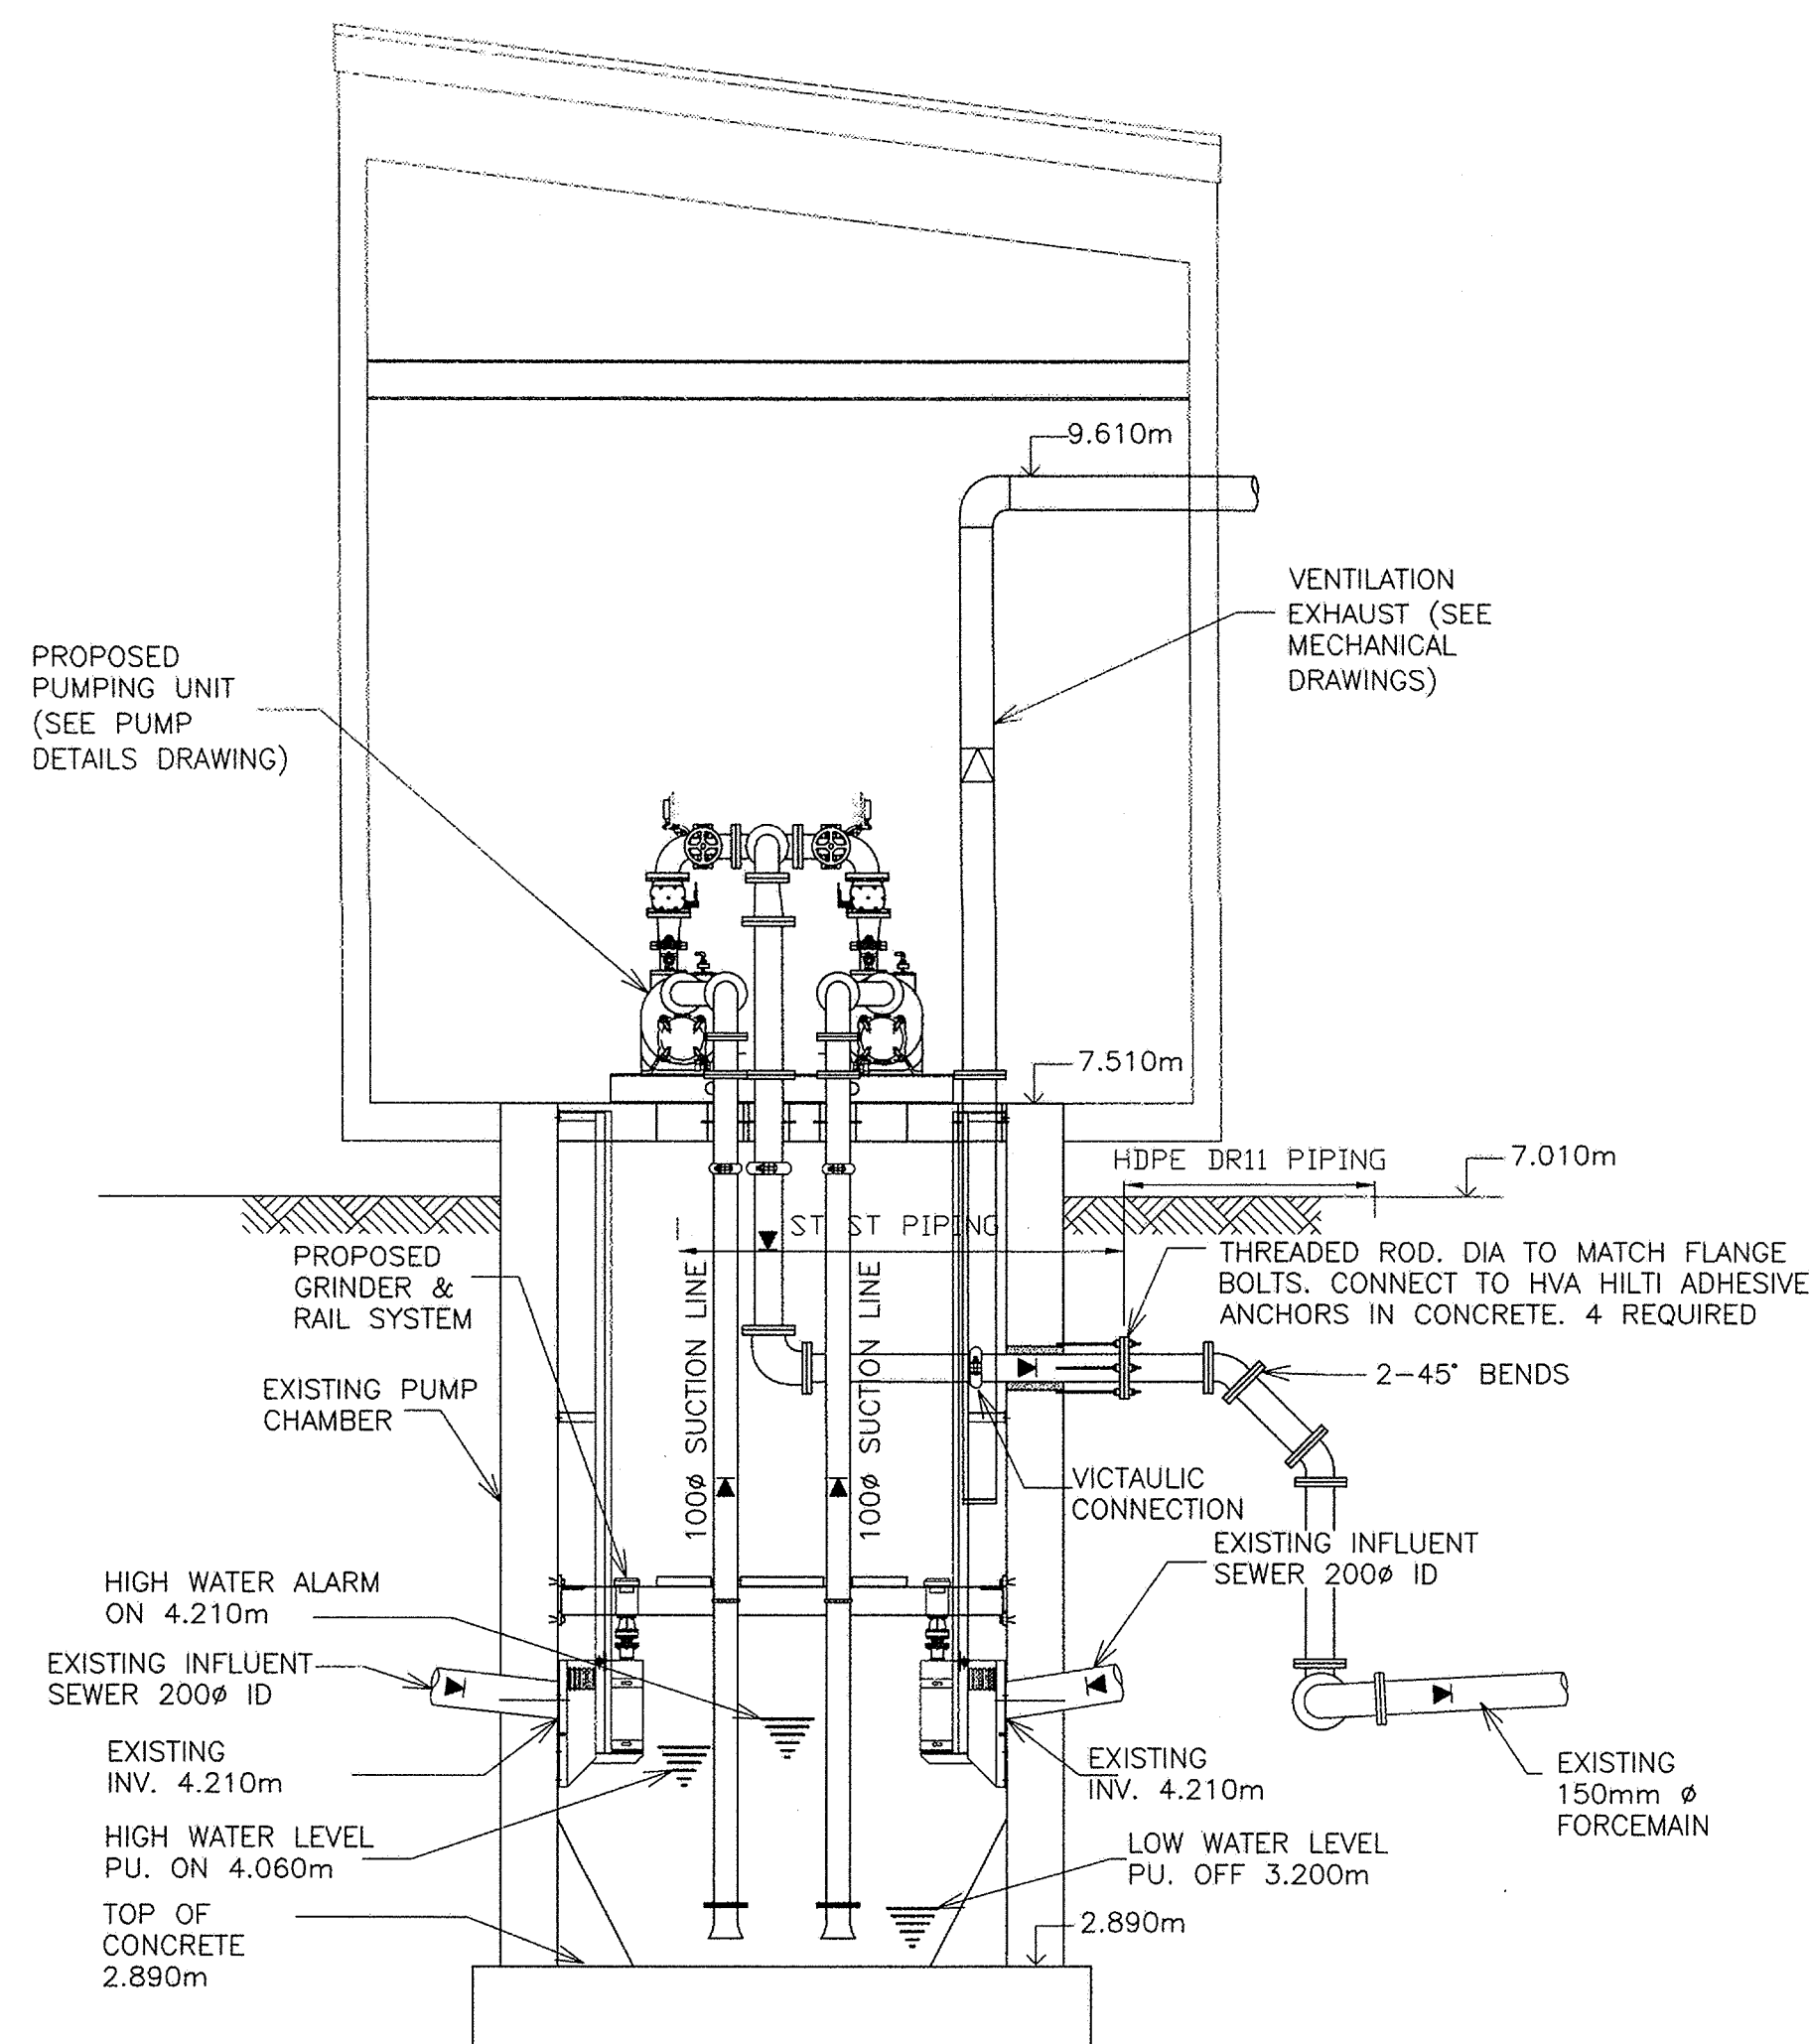


WET WELL COVER OPENINGS DIAGRAM

SCALE 1:20

FUEL TANK AND PAD
"SEE MECH &
STRUCTURAL DWG'S
FOR DETAILS"

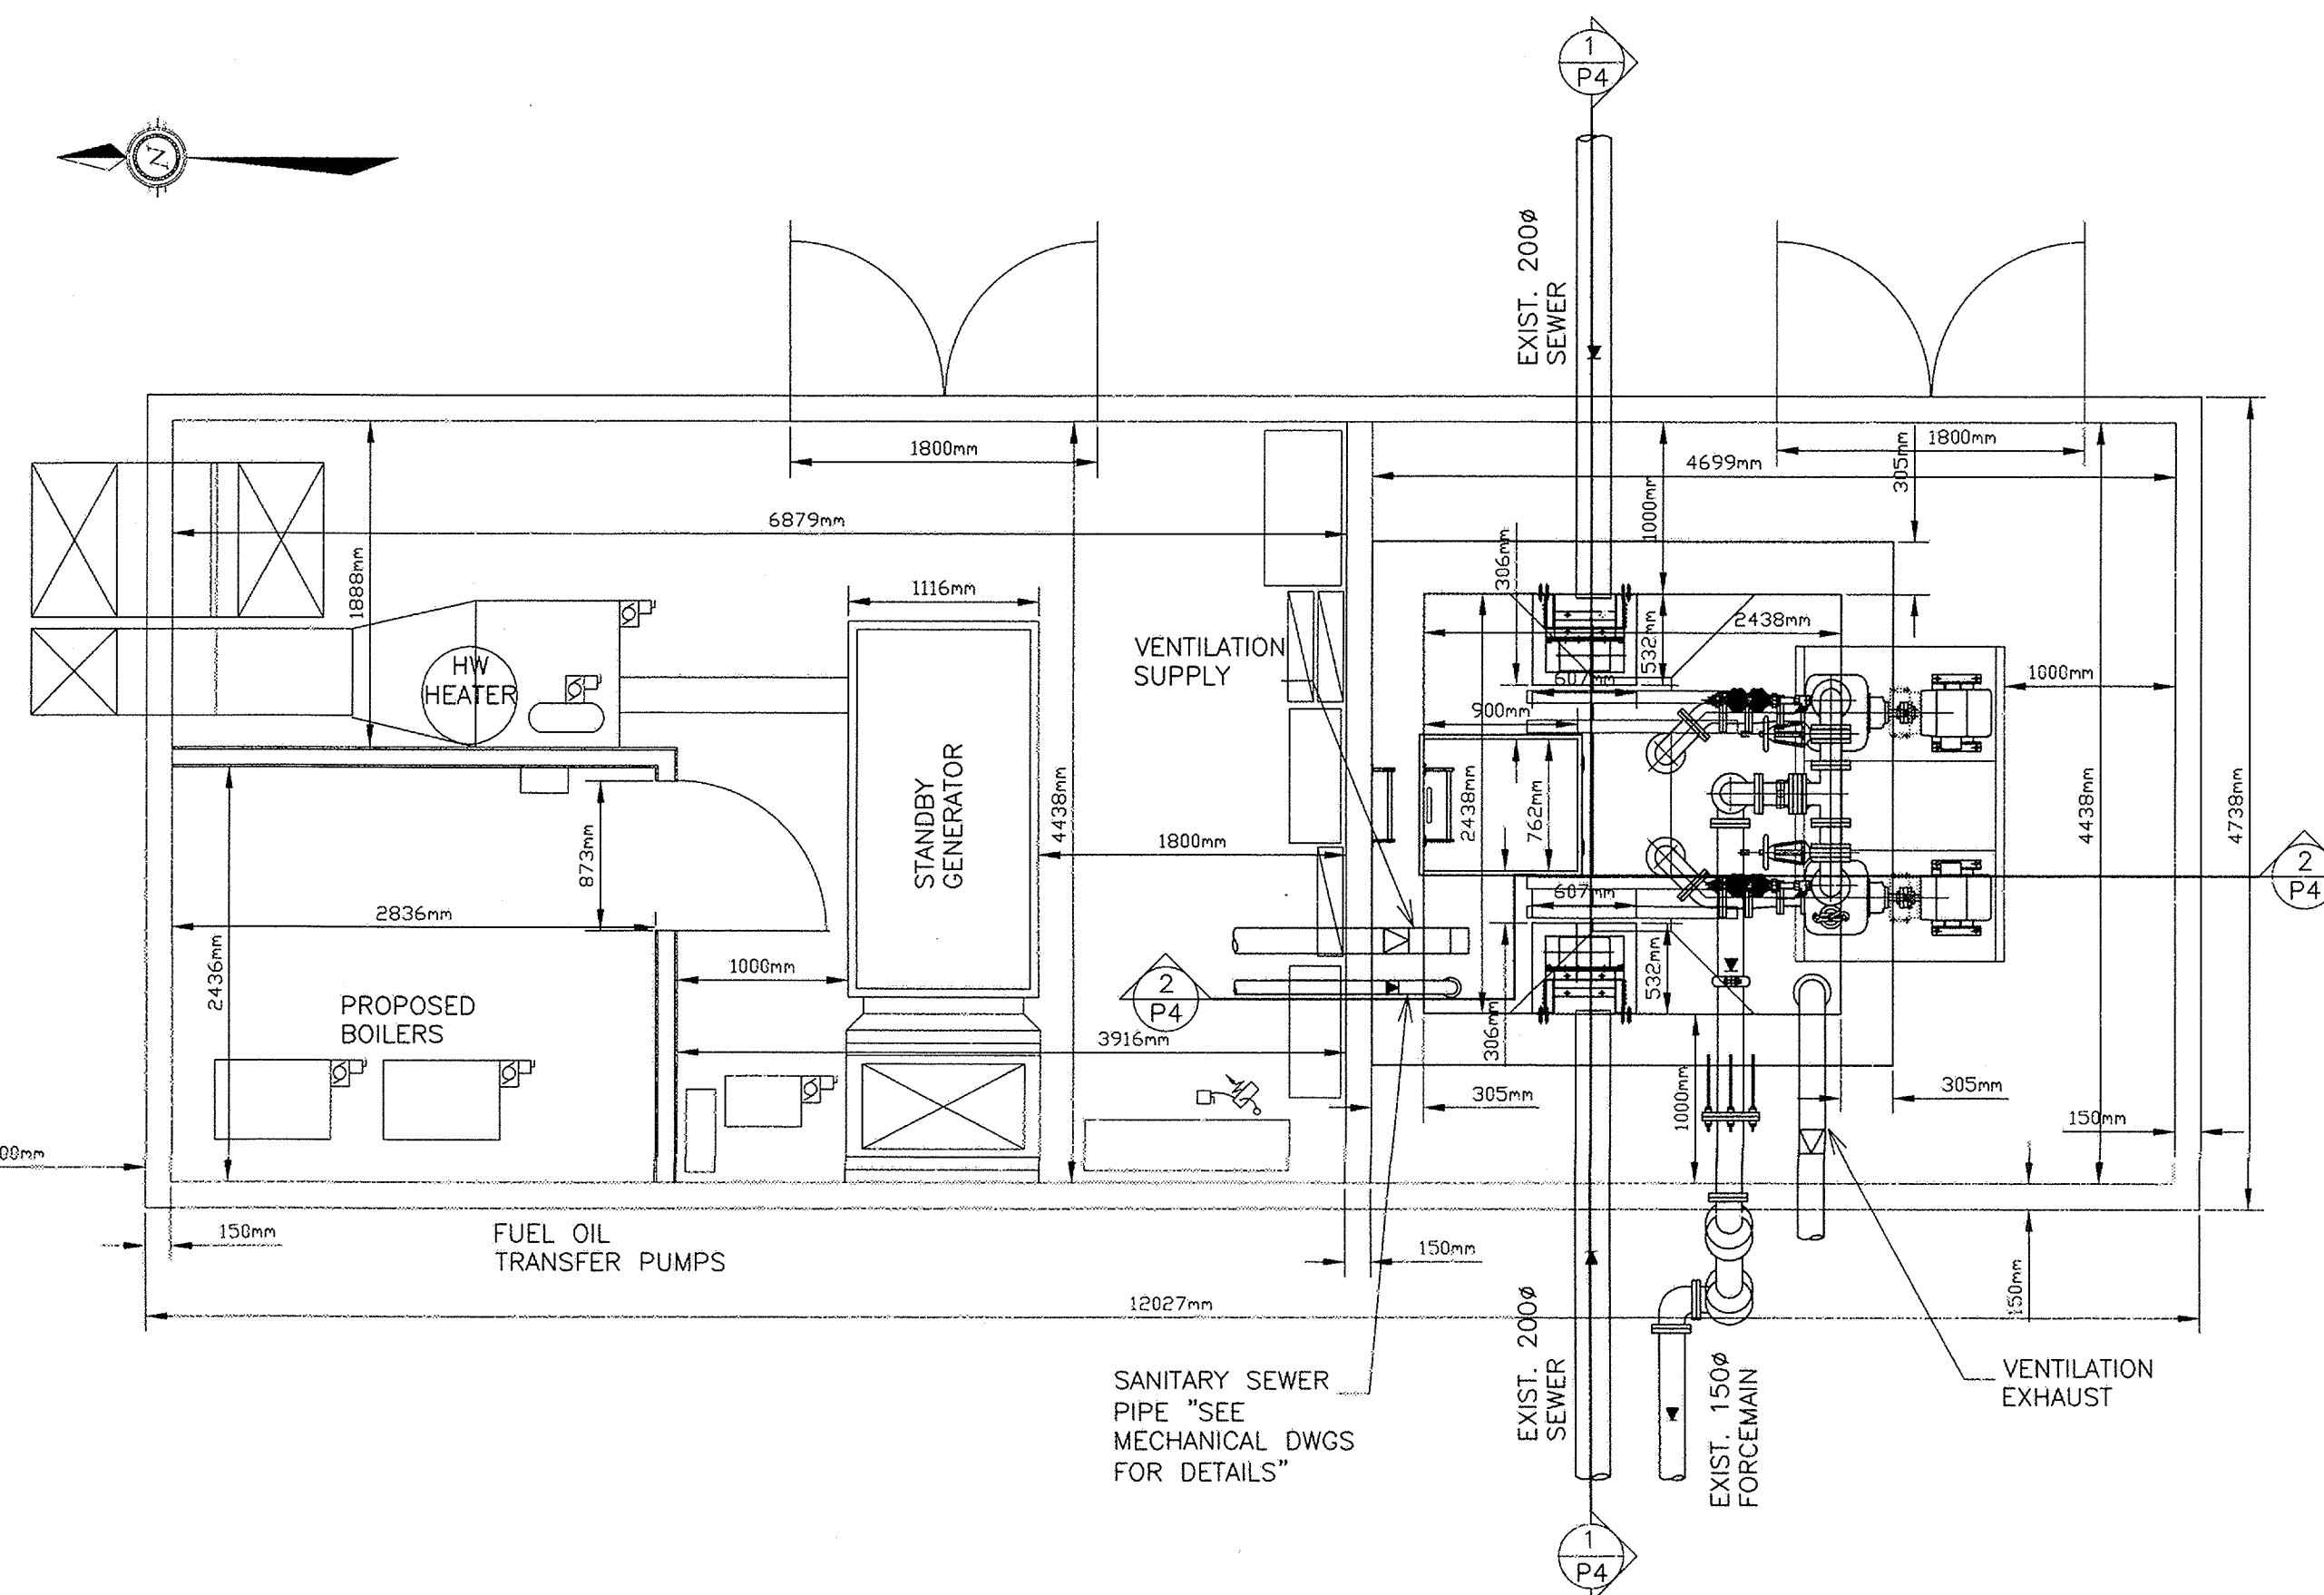

SECTION 1-1

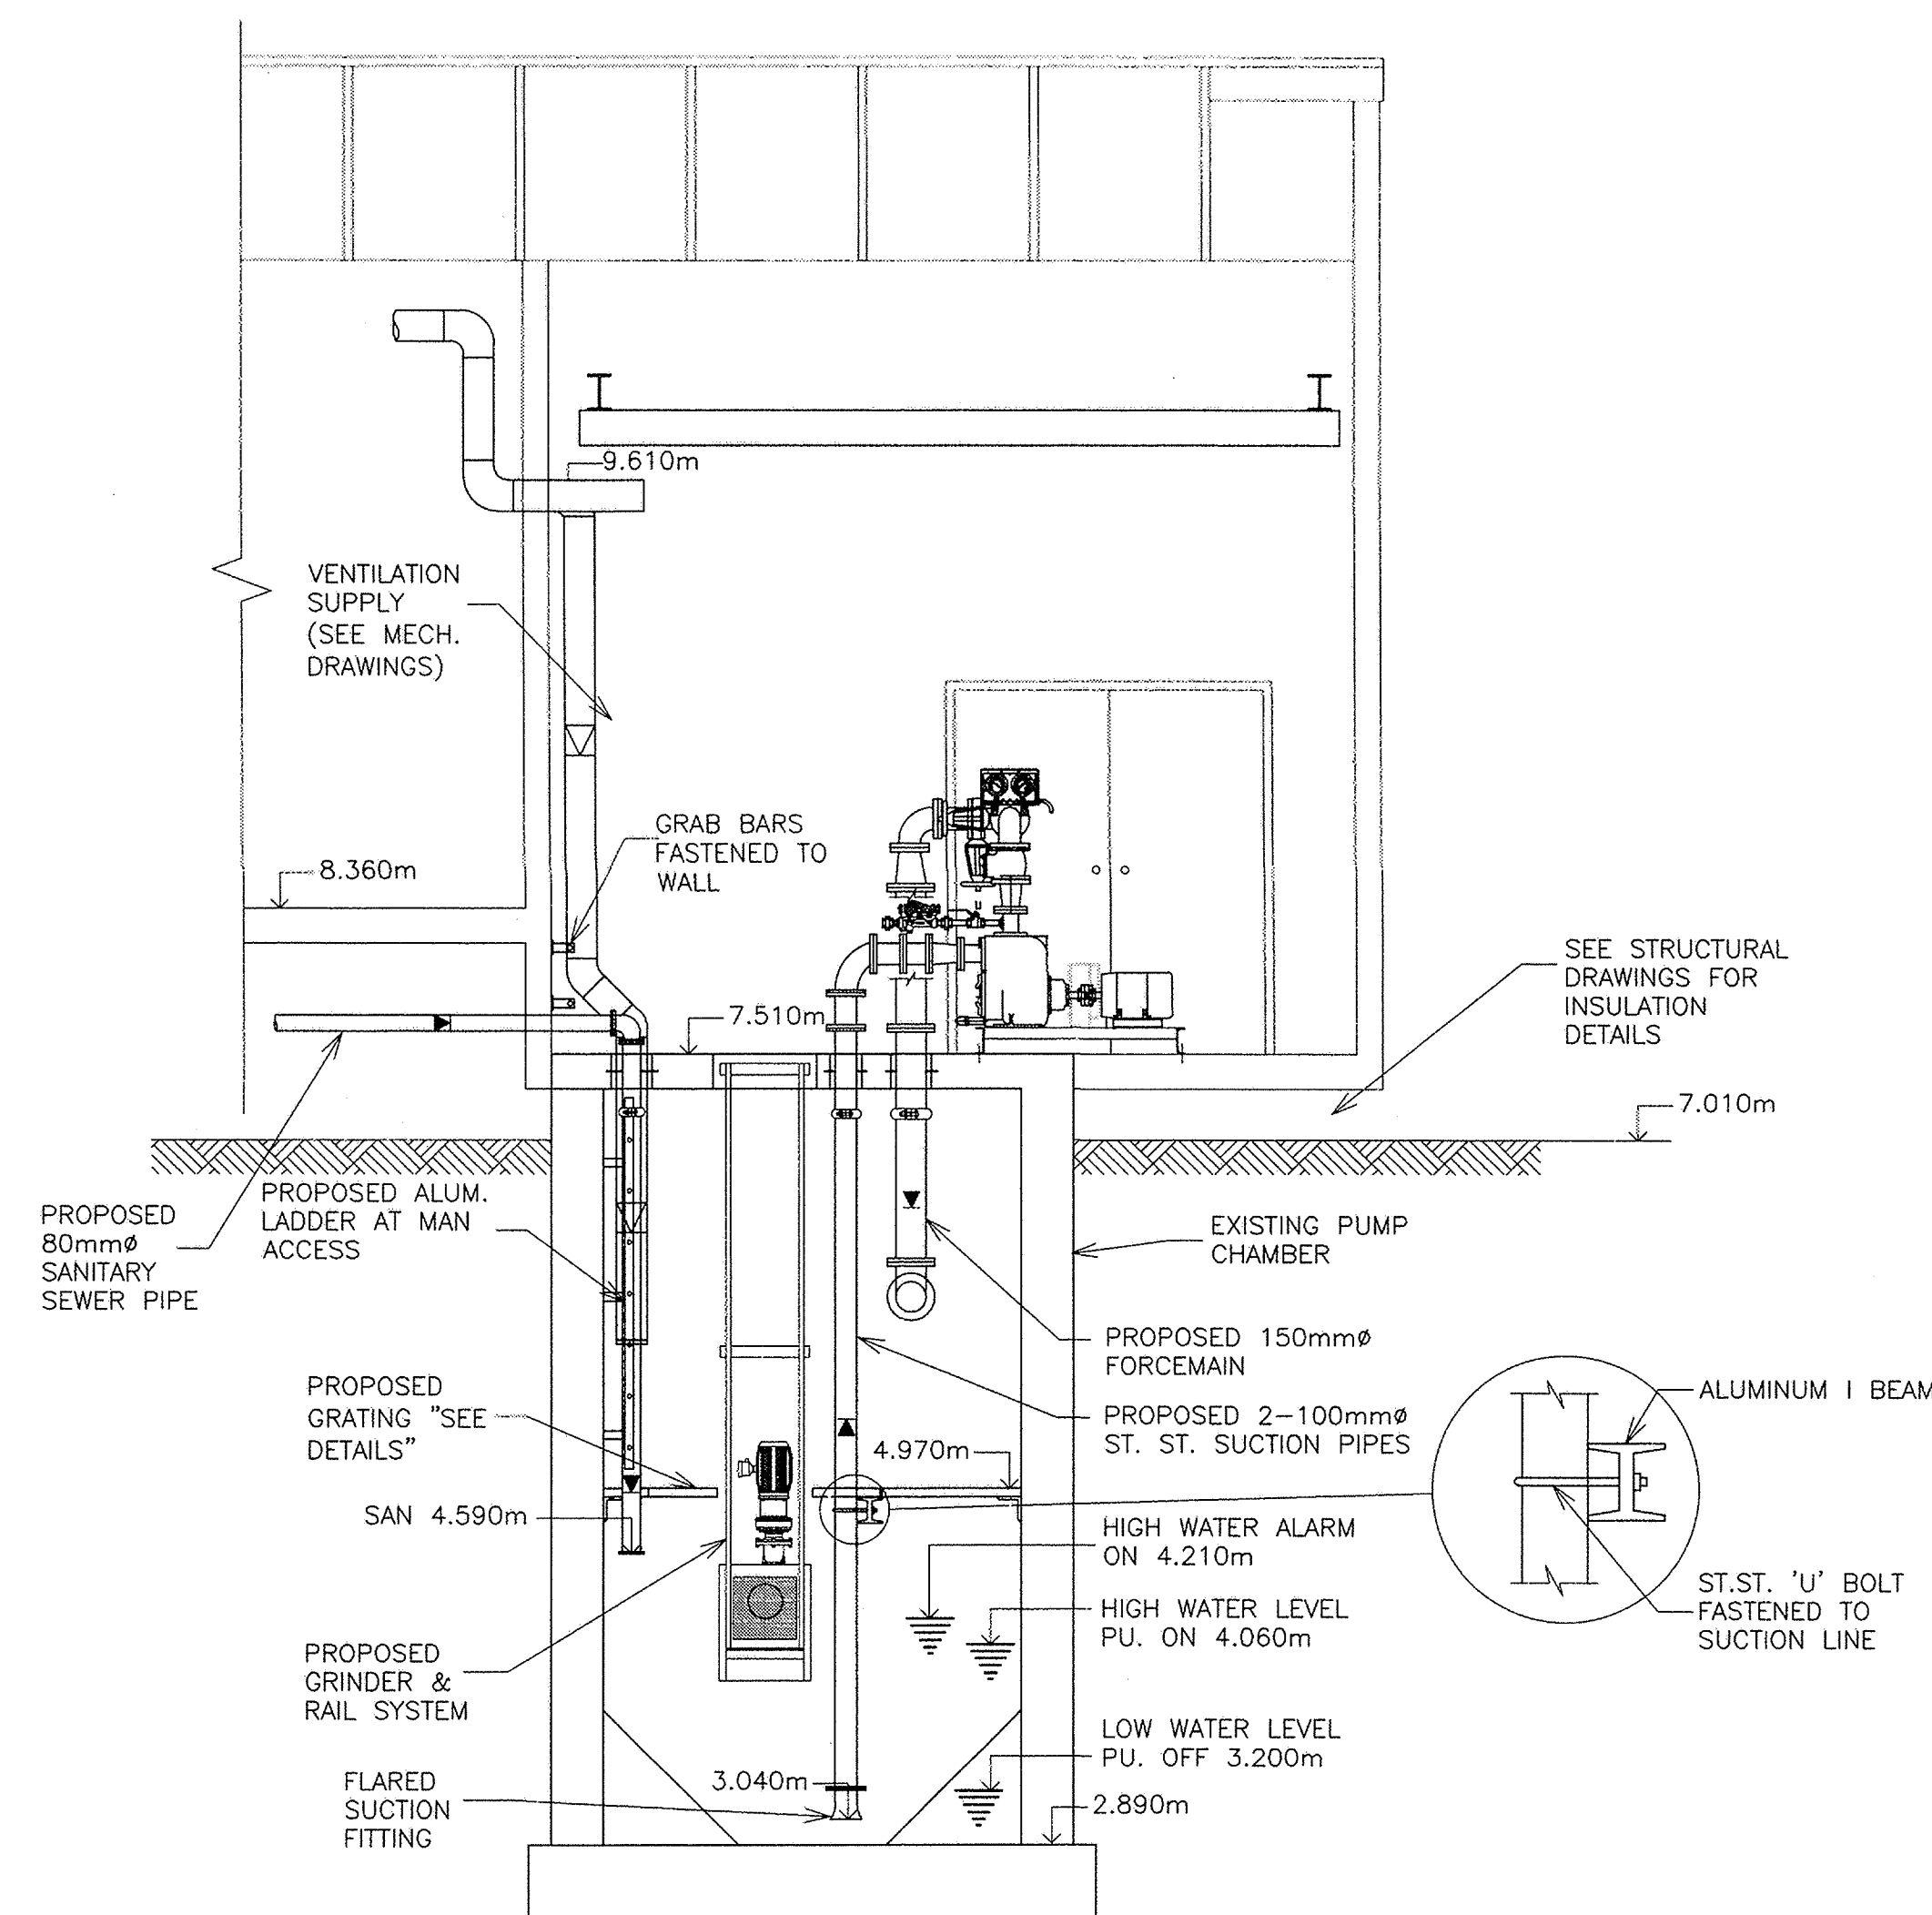

SECTION 2-2



LEGEND


ALL PIPING INSIDE THE WET WELL AND PUMPING AREA IS TO BE STAINLESS STEEL 11 GAUGE 316 OR EQUAL

PERMIT OF PRACTICE
TROW ASSOCIATES INC.
Signature: *[Signature]*
Date: May 11, 2010
PERMIT NUMBER: P184
The Association of Professional Engineers
Geologists and Geophysicists of the NWT/NYU

Kudlik Construction Ltd.
ADVANCED PROJECTS
P.O. Box 727, 1519 Federal Road
Iqaluit (Nunavut) X0A 0H0
Tel: (867) 979-1166
Fax: (867) 979-1169
Issue for As Built: 08-02-2012

No.	DESCRIPTION	DATE	BY	APP'D
03	ISSUED FOR CONSTRUCTION	10/05/10	ABZ	SLB
02	ISSUED FOR TENDER	05/06/09	ABZ	SLB
01	90% SUBMISSION	17/04/09	ABZ	SLB

REVISIONS

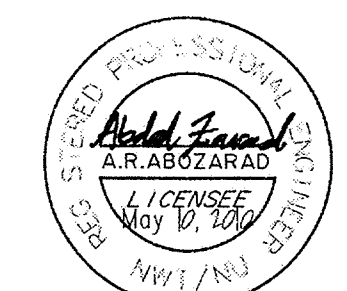

Trow Associates Inc.
154 Colonnade Road South
Ottawa, Ont. K2E 7J5
Tel: (613) 225-9940
Fax: (613) 225-7337

CITY OF IQALUIT

LIFT STATION No. 2
MODIFICATIONS

PLANS & SECTIONS

design by	ABZ	project no.	OTCD19365A
drawn by	ABZ	drawing no.	P-3
checked by	SLB		
date	30/01/09		
scale	1:40		