



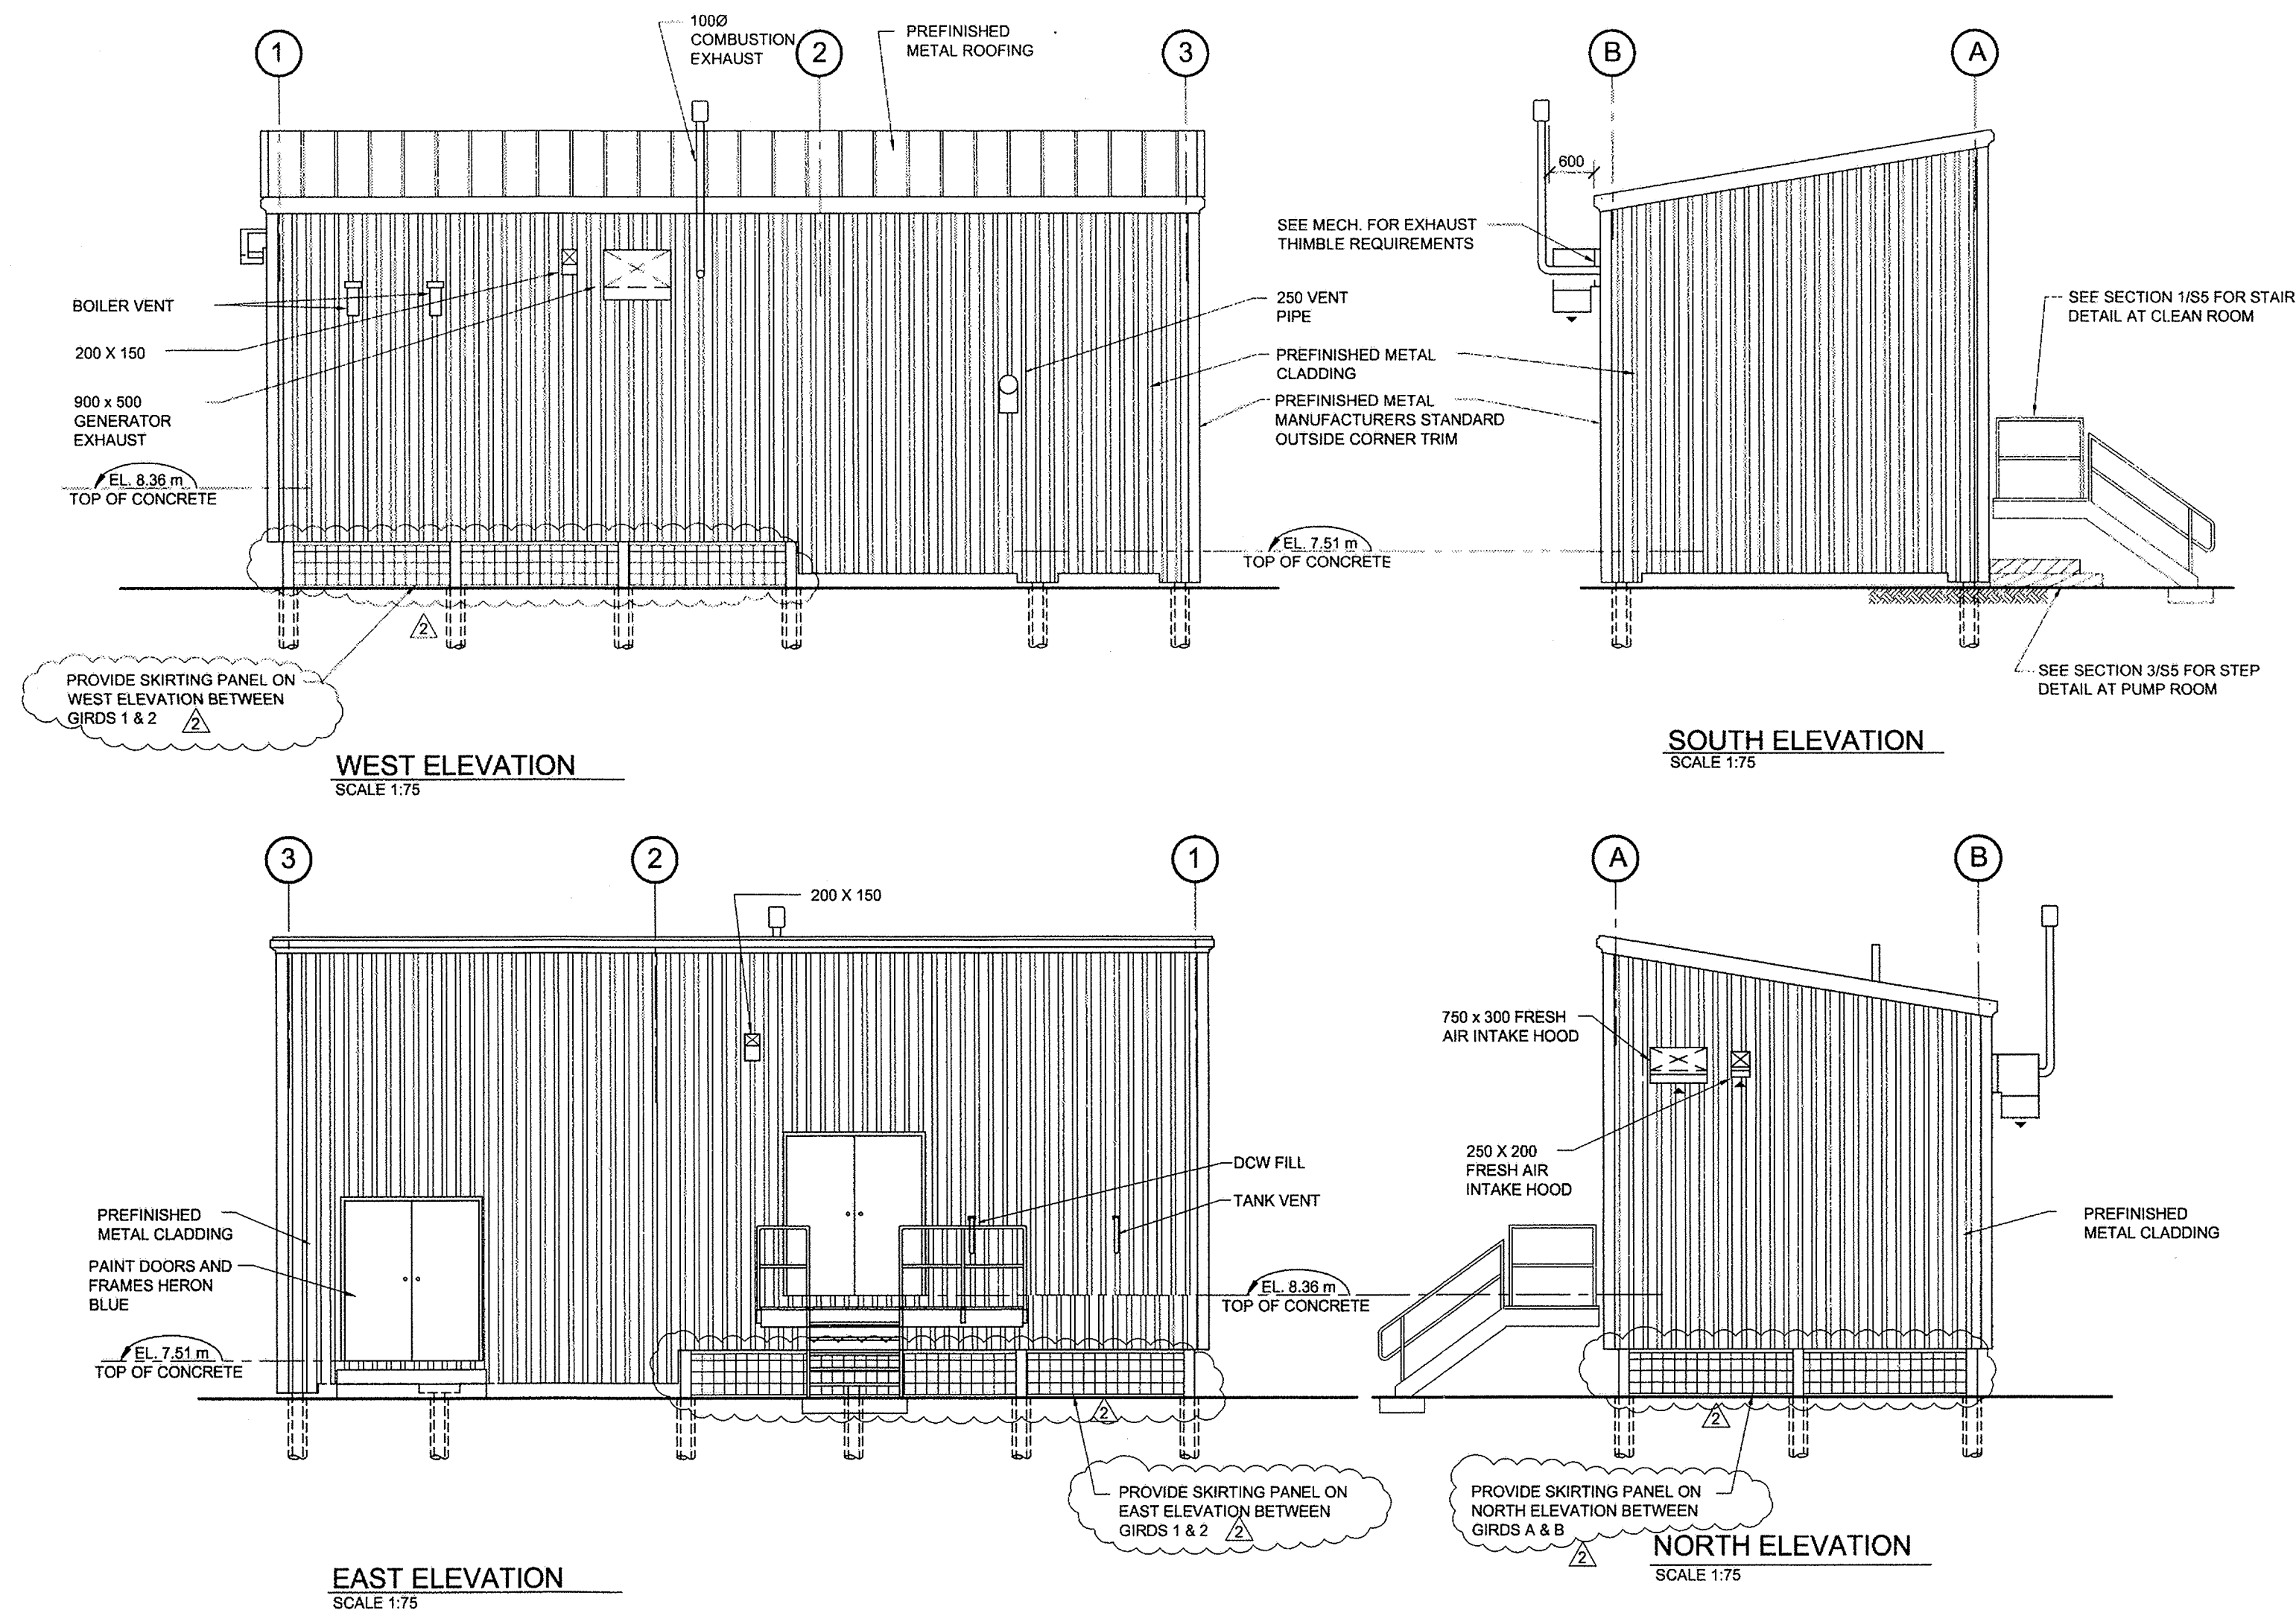

KEY PLAN

LEGEND

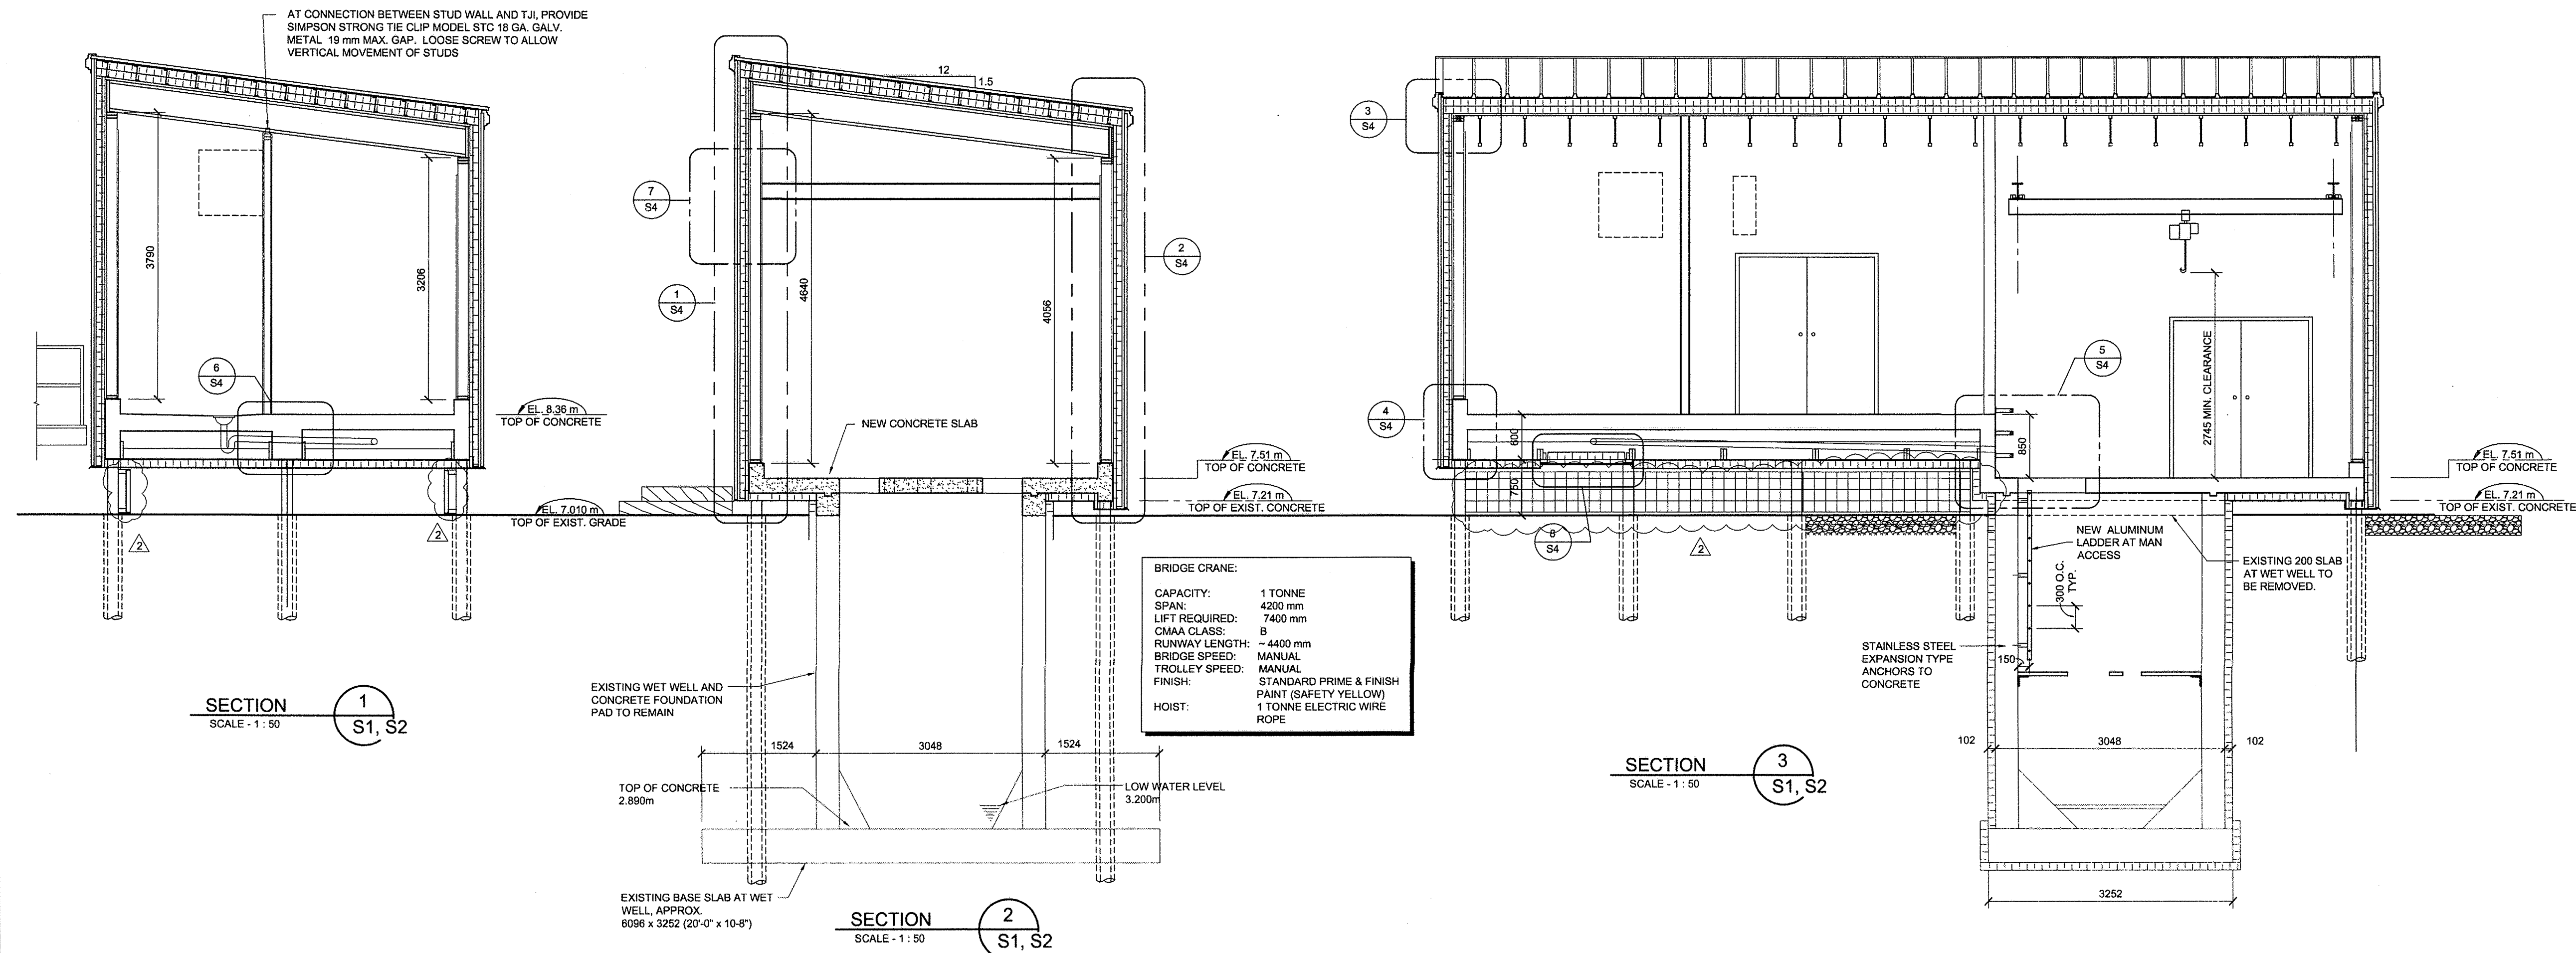


Kudlik Construction Ltd.

P.O. Box 727, 1519 Federal Road
Ipswich (Ontario) M0A 0H0
Tel: (867) 979-1166
Fax: (867) 979-1169
Issue for As Built: 08-02-2012

NOTES: GENERAL CONTRACTOR TO VERIFY ALL DIMENSIONS WITH FINAL ARCHITECTURAL AND MECHANICAL DRAWINGS. NOTIFY THE ENGINEERS OF ANY ERRORS AND/OR OMISSIONS PRIOR TO CONSTRUCTION FOR DIRECTION. DO NOT SCALE THIS DRAWING.

No.	DESCRIPTION	DATE	BY	APP'D
2	ISSUED FOR CONSTRUCTION	10/05/2010	M.N.	K.A.B.
1	ISSUED FOR TENDER	15/06/2009	M.N.	K.A.B.
0	90% SUBMISSION	23/04/2009	M.N.	K.A.B.

REVISIONS

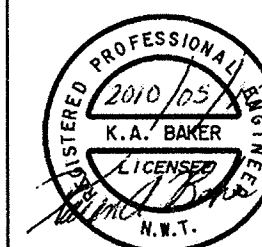

PERMIT TO PRACTICE
TROW ASSOCIATES INC.

Signature: *K.A. Baker*
Date: *May 10/2010*
PERMIT NUMBER: P184
The Association of Professional Engineers,
Geologists and Geophysicists of the NWT/NU



Trow Associates Inc.

154 Colonnade Road South
Ottawa, Ont. K2E 7J5
Tel: (613) 225-9940
Fax: (613) 225-7337

CLIENT

CITY OF IQUALUIT

PROJECT

**LIFT STATION NO. 2
MODIFICATIONS**

TITLE

**SECTIONS
AND ELEVATIONS**

design by	K.A. BAKER	project no.	OTBS00019365A
drawn by	M. NUGENT	drawing no.	S3
checked by	K.A. BAKER		
date	03/03/2009		
scale	AS NOTED		