

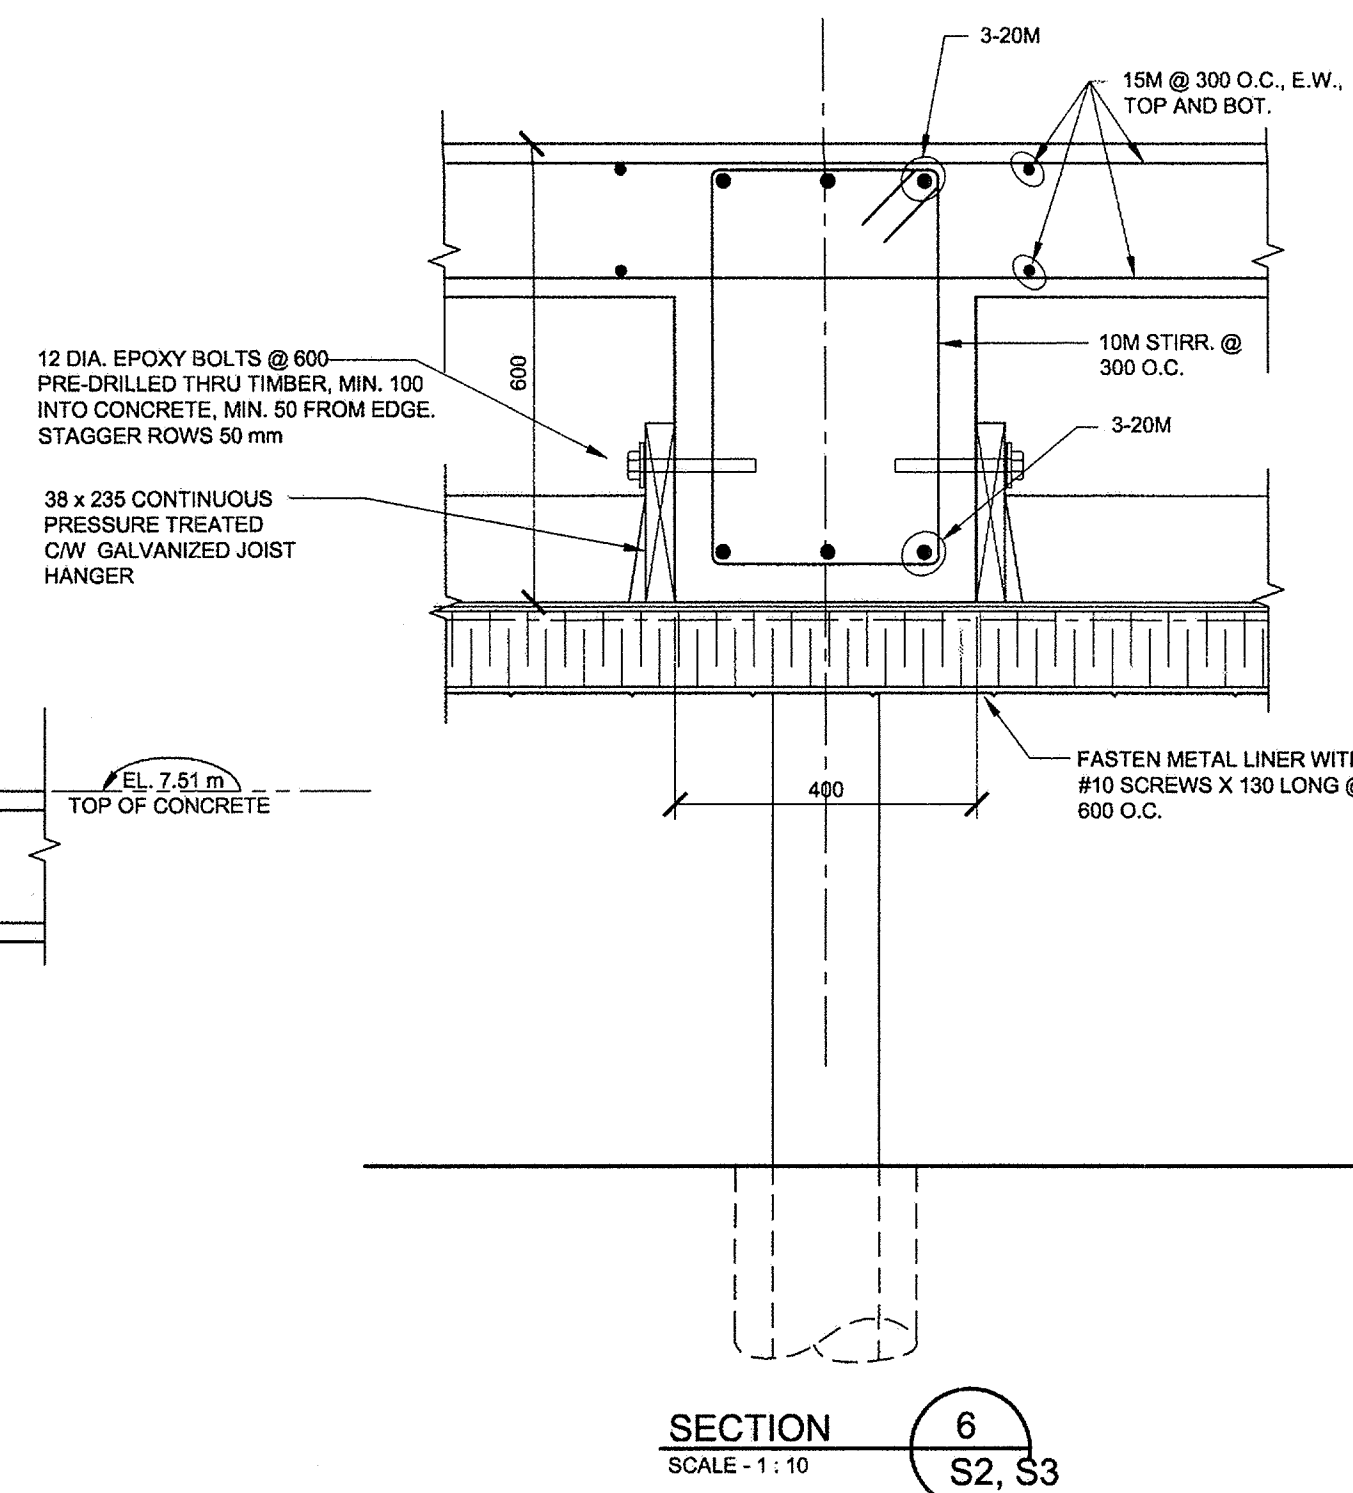
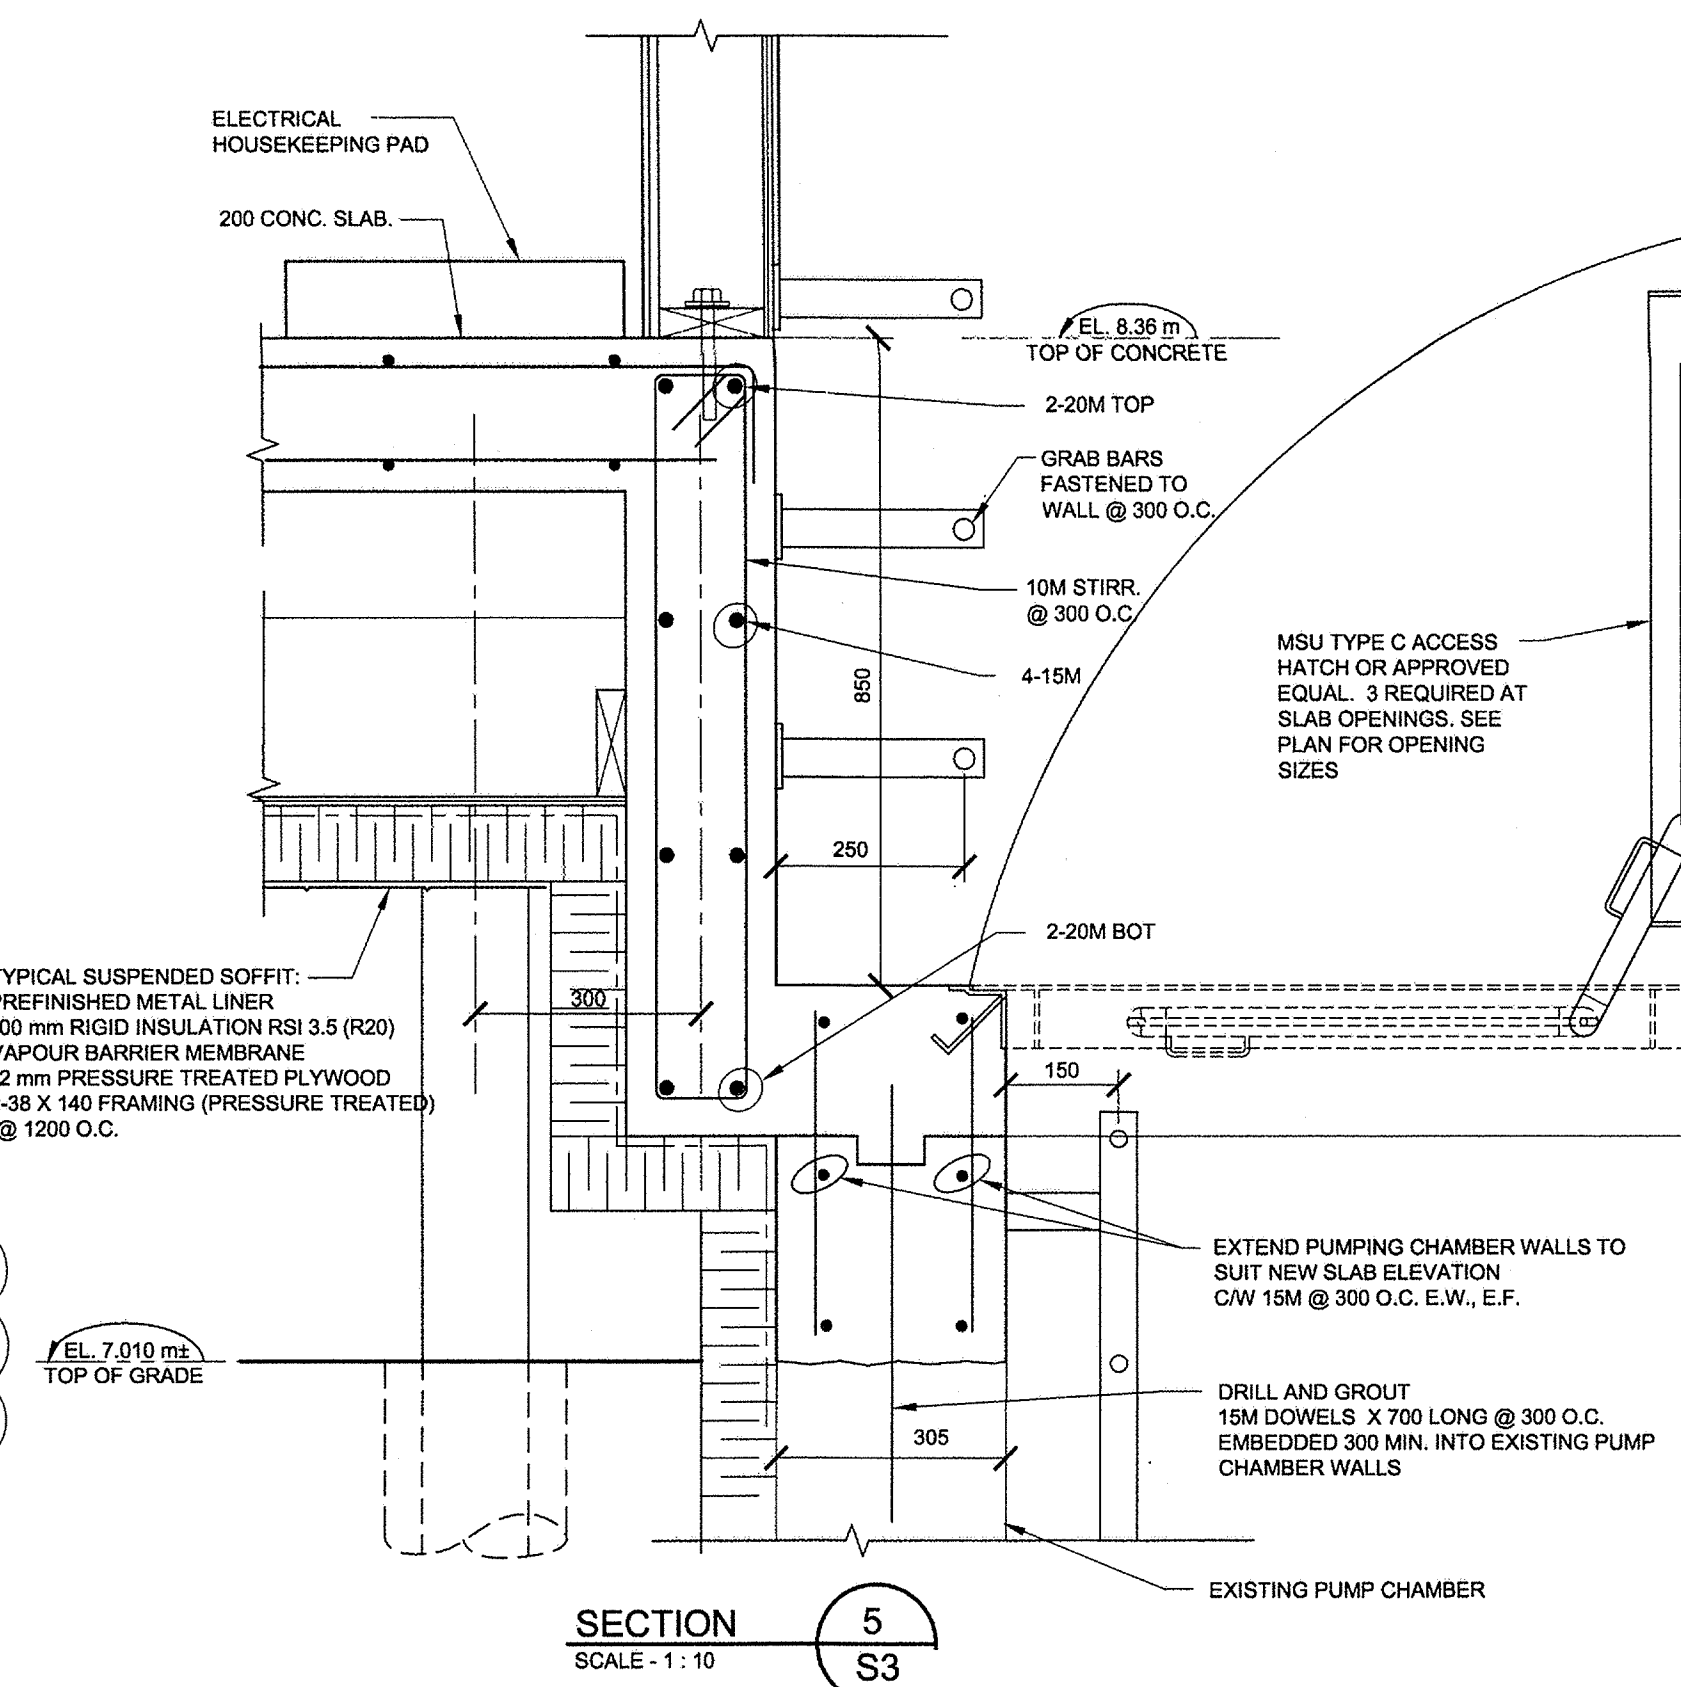
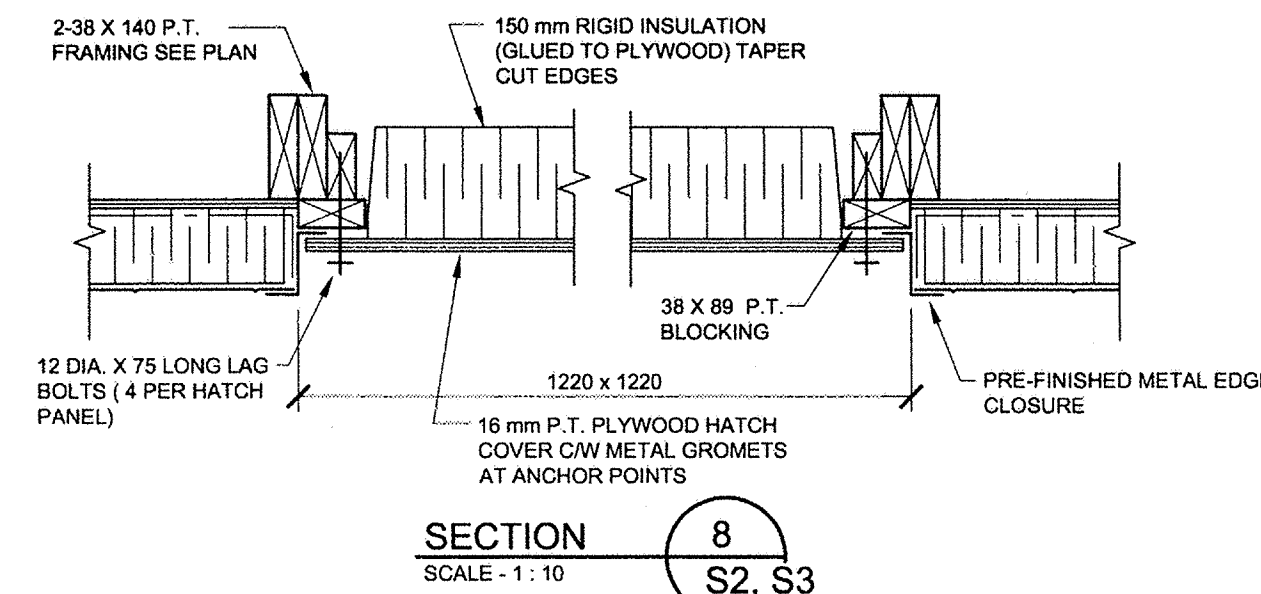
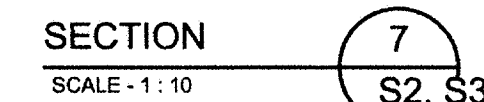
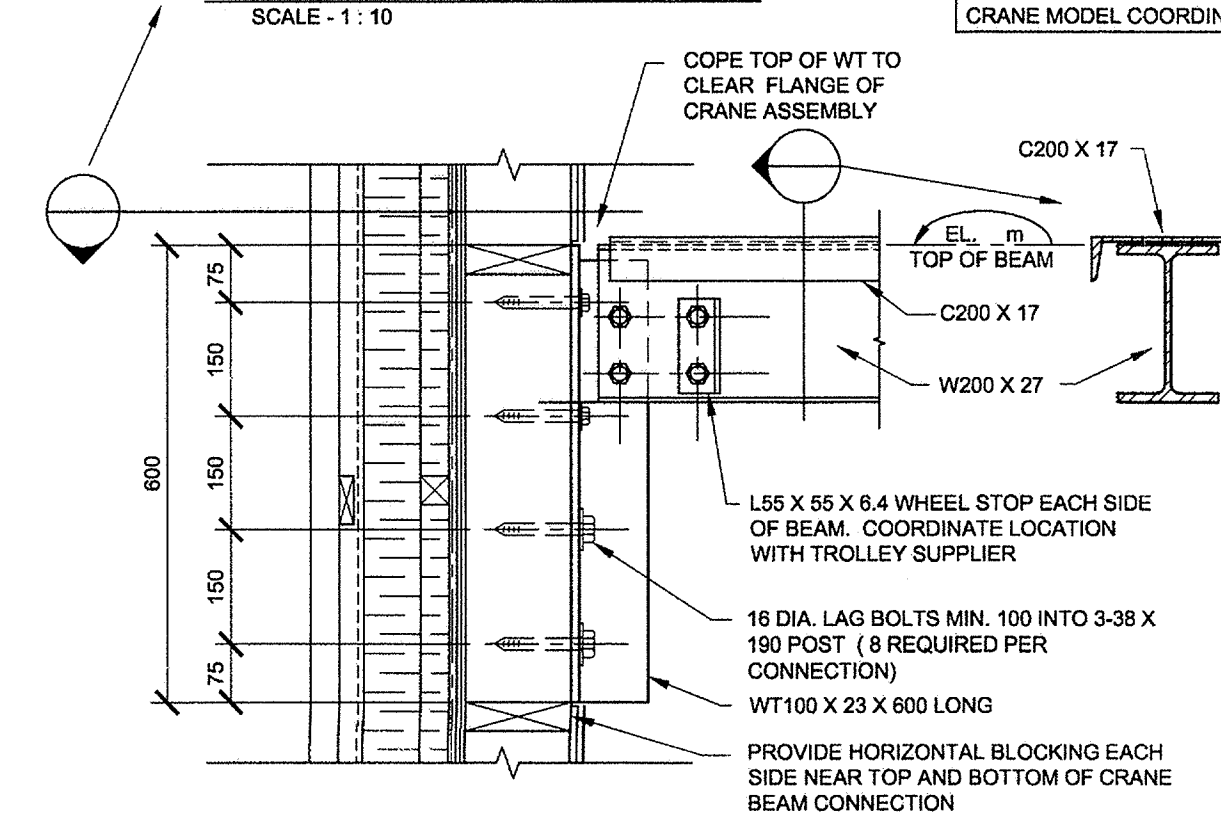
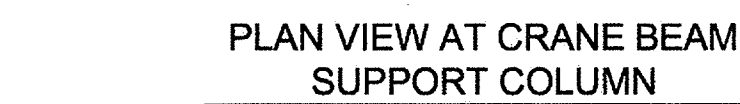


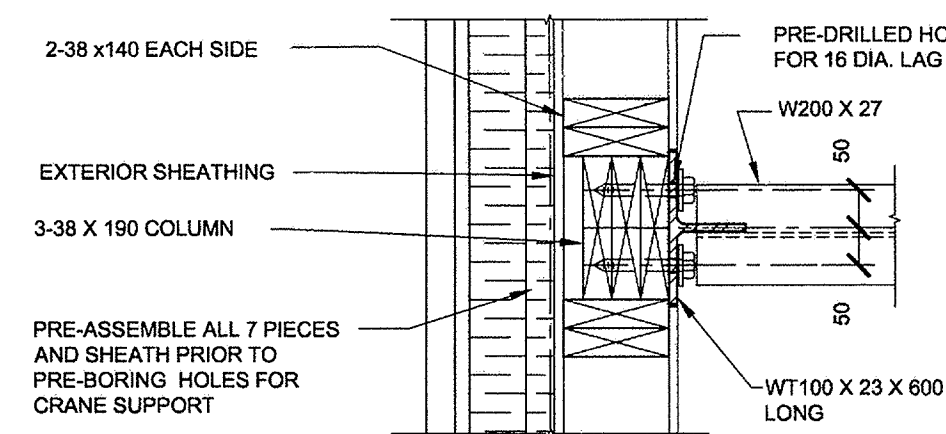

KEY PLAN

LEGEND

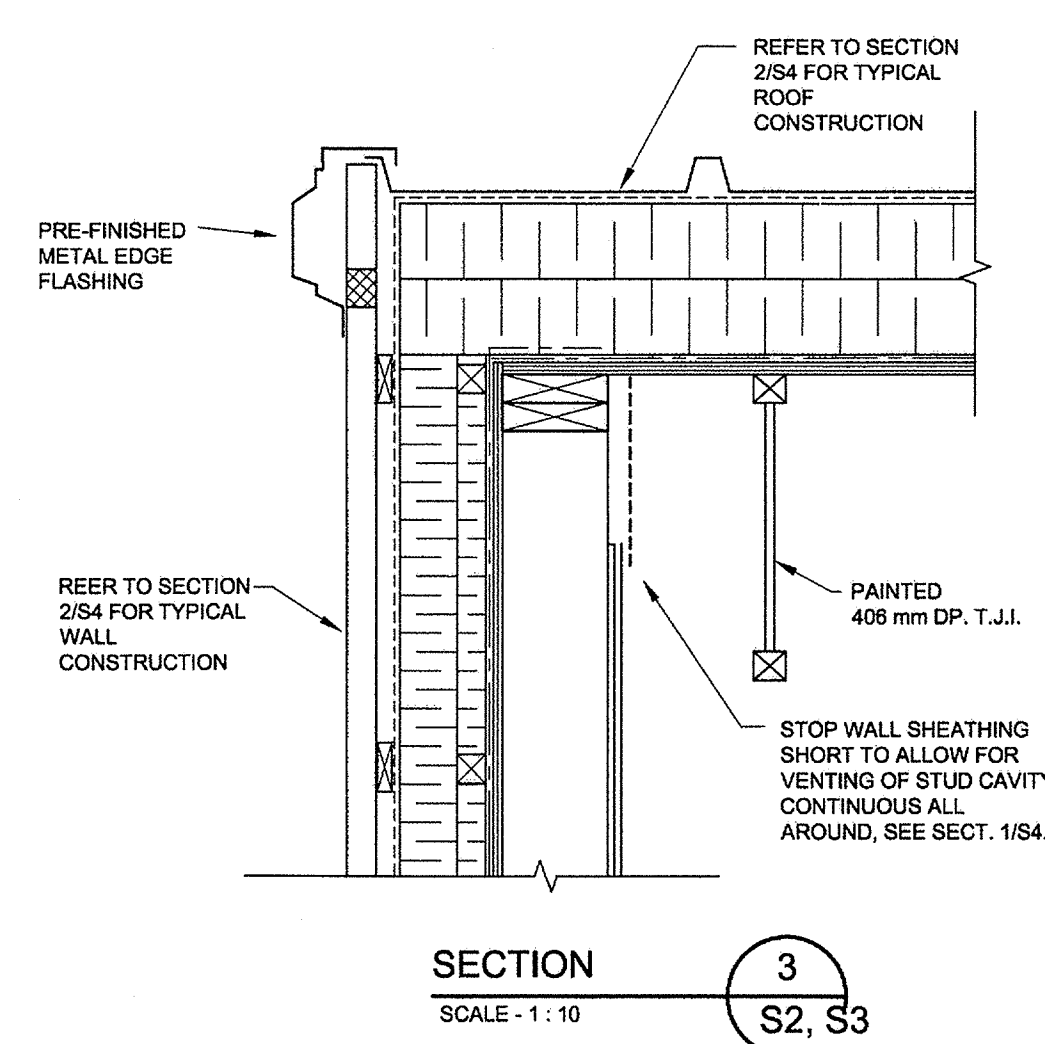


Kudlik Construction Ltd.

P.O. Box 727, 1519 Federal Road
Iqaluit (Nunavut) X0A 0H0
Tel.: (867) 979-1166
Fax: (867) 979-1169
Issue for As Built : 08-02-2012

NOTES: GENERAL CONTRACTOR TO VERIFY ALL DIMENSIONS
WITH FINAL ARCHITECTURAL AND MECHANICAL DRAWINGS.
NOTIFY THE ENGINEERS OF ANY ERRORS AND/OR
OMISSIONS PRIOR TO CONSTRUCTION FOR DIRECTION.
DO NOT SCALE THIS DRAWING.

2	ISSUED FOR CONSTRUCTION	10/05/2010	M.N.	K.A.
1	ISSUED FOR TENDER	15/06/2009	M.N.	K.A.
0	90% SUBMISSION	23/04/2009	M.N.	K.A.
No.	DESCRIPTION	DATE	BY	APP
R E V I S I O N S				

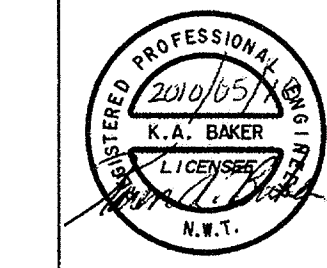

PERMIT TO PRACTICE
TROW ASSOCIATES INC.

Signature Karen A. Baker
Date May 10/2010

PERMIT NUMBER: P184
The Association of Professional Engineers
Contractors and Architects of the ABPEA

Geologists and Geophysicists of the NWI/M



Trow Associates Inc.

154 Colonnade Road South Tel:(613)225-994
Ottawa, Ont. K2E 7J5 Fax:(613)225-733

CLIENT

CITY OF IQALUIT

PROJECT LIFT STATION NO. 2
MODIFICATIONS

SECTIONS

design by	K.A. BAKER	project no. OTBS00019365 drawing no. S4
drawn by	M. NUGENT	
checked by	K.A. BAKER	
date	03/03/2009	
scale	AS SHOWN	