

PLAN VIEW OF DAM

SCALE: 1:200

GENERAL NOTES:

- ALL WORK TO BE PERFORMED IN ACCORDANCE WITH APPLICABLE LEGISLATION AND REGULATIONS INCLUDING, BUT NOT LIMITED TO, OCCUPATIONAL HEALTH AND SAFETY ACT AND REGULATIONS.
- THE CONTRACTOR SHALL AS PART OF THEIR WORK, CHECK AND VERIFY ALL DIMENSIONS AND ELEVATIONS AND REPORT ANY DISCREPANCIES TO THE ENGINEER BEFORE PROCEEDING WITH CONSTRUCTION.
- CONTRACTOR IS RESPONSIBLE FOR PROVIDING FALL PROTECTION FOR WORK PERFORMED WHEN A FALL HAZARD EXISTS.
- CONTRACTOR IS RESPONSIBLE FOR PROVIDING ADEQUATE SAFETY BARRIERS/ HOARDING DURING THE CONSTRUCTION PHASE.

POLYURETHANE INJECTION

- THE INJECTION RESIN TO BE USED IS: FLEXIBLE WATER REACTIVE POLYURETHANE RESIN AS MANUFACTURED BY MME MULTIRETHANES LTD.
- AREAS REQUIRING REPAIR ARE IDENTIFIED ON THE DRAWINGS. CONTRACTOR SHALL CONFIRM WITH THE CONSULTANT THE EXACT AREAS PRIOR TO COMMENCING WORK.
- CONTRACTOR SHALL MAKE REPAIRS WHERE REQUIRED UNDER THE DIRECTION OF THE SPECIFICATIONS AND THE MANUFACTURERS RECOMMENDATIONS FOR CRACK INJECTION TECHNIQUES.

ENVIRONMENTAL REQUIREMENTS

- THE CONTRACTOR SHALL ENSURE COMPLIANCE WITH ALL MUNICIPAL, TERRITORIAL, AND FEDERAL AUTHORITIES HAVING JURISDICTION OVER THE DURATION OF THE PROJECT.
- WHERE NOTIFICATION, EVALUATION, AND APPROVALS ARE REQUIRED FOR THE WORK, THE CONTRACTOR SHALL BE RESPONSIBLE FOR SUPPLYING THE REQUIRED INFORMATION AND PAYMENT OF ASSOCIATED FEES OR PERMITS.
- THE NOTIFICATION AND APPROVAL PROCESS SHALL INCLUDE, BUT IS NOT LIMITED TO, CONSTRUCTION OVER A WATERCOURSE (DEPARTMENT OF FISHERIES & OCEANS) DISPOSAL OF MATERIALS, (CITY OF IQALUIT) AND ENVIRONMENTAL COMPLIANCE (MINISTRY OF ENVIRONMENT).



OTTAWA
1-866-919-4530

LONDON
1-866-919-4531

IQALUIT
1-866-919-4533

CLIENT NAME:

THE CITY OF IQALUIT

PROJECT ADDRESS:

LAKE GERALDINE DAM

IQALUIT, NUNAVUT

PROJECT NAME:

LAKE GERALDINE DAM & WATER

TREATMENT PLANT GROUTING PROGRAM

DRAWING TITLE:

PLAN VIEW OF DAM

DESIGN: STP


DRAWN: ADM

DATE: JUNE/2010

FILE No: 10-3171


SHEET No.

A1

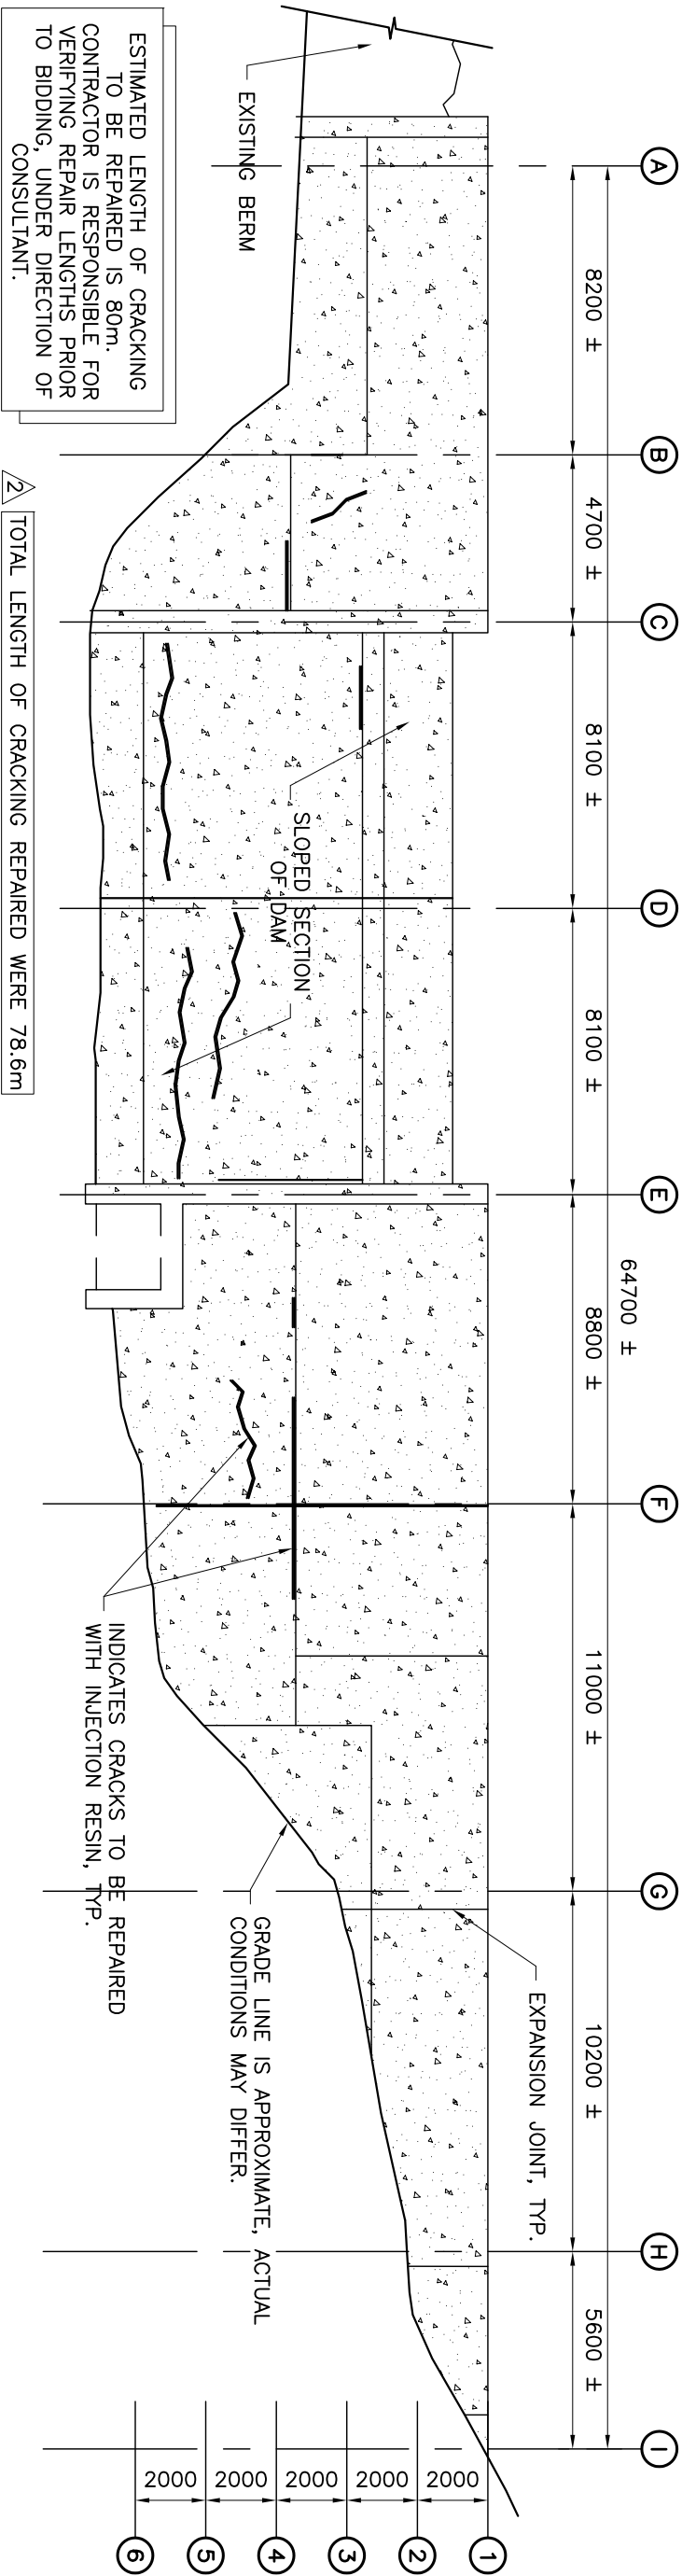


DOWNSTREAM ELEVATION

SCALE: 1:200

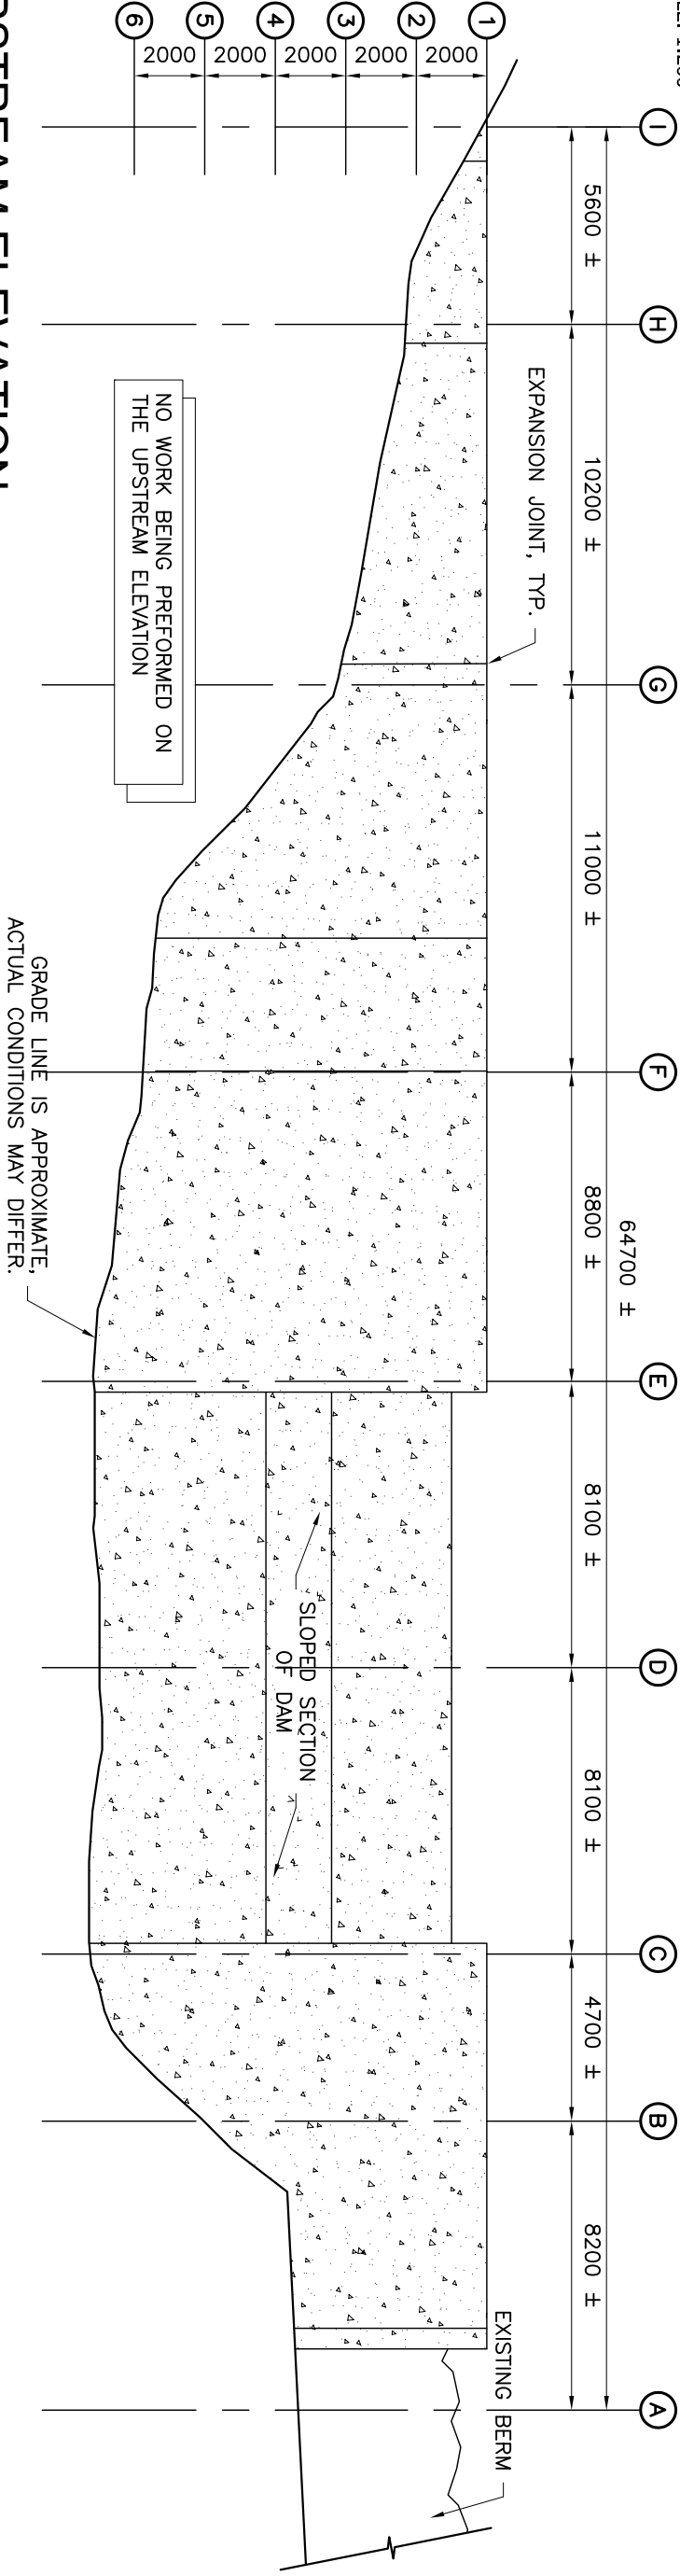

UPSTREAM ELEVATION

SCALE: 1:200



ASSOCIATES INTERNATIONAL
INCORPORATED

OTTAWA
1-866-919-4530

LONDON
1-866-919-4531

ICALUIT
1-866-919-4533

CLIENT NAME:

THE CITY OF ICALUIT

PROJECT ADDRESS:

LAKE GERALDINE DAM
ICALUIT, NUNAVUT

PROJECT NAME:

LAKE GERALDINE DAM & WATER
TREATMENT PLANT GROUTING PROGRAM

DESIGN: STP

DRAWN: ADM

DATE: JUNE/2010

FILE No: 10-3171

NO.

REVISION

DATE

1

FOR TENDER

JULY 7, 2011

2


AS-BUILT

FEB 1, 2012

3

SHEET No.


A2

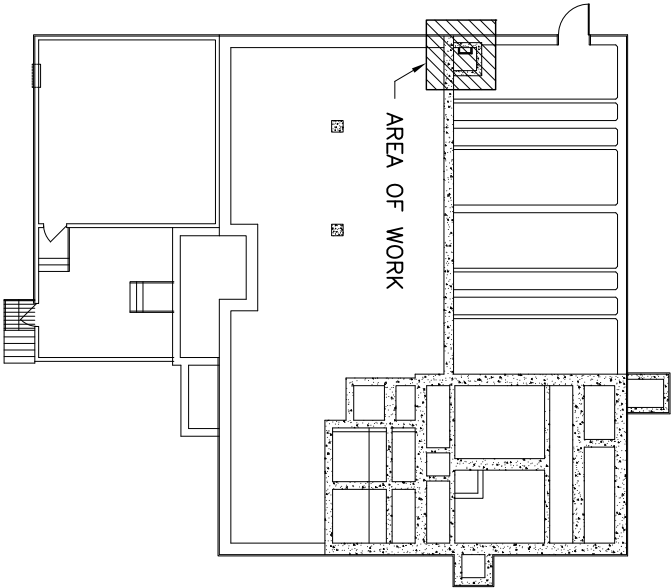

KEY PLAN


SCALE: 1:300

CONFINED SPACE PROGRAM REQUIRED FOR INJECTION REPAIRS PERFORMED IN ENTRANCE PIT. CONTRACTOR SHALL PROVIDE DETAILS OF CONFINED SPACE PROGRAM TO FACILITATE INJECTION REPAIRS PRIOR TO PERFORMING THE WORK. THE PROGRAM SHALL CONFORM TO THE REQUIREMENTS OF CANADA OCCUPATIONAL HEALTH AND SAFETY REGULATION SOR/86-304 AND SHALL INCLUDE (BUT NOT BE LIMITED TO) PROTECTION EQUIPMENT REQUIRED, MONITORING EQUIPMENT REQUIRED, EMERGENCY EQUIPMENT AND PLAN, TRAINING REQUIRED, AND ALL OTHER REQUIRED ITEMS.

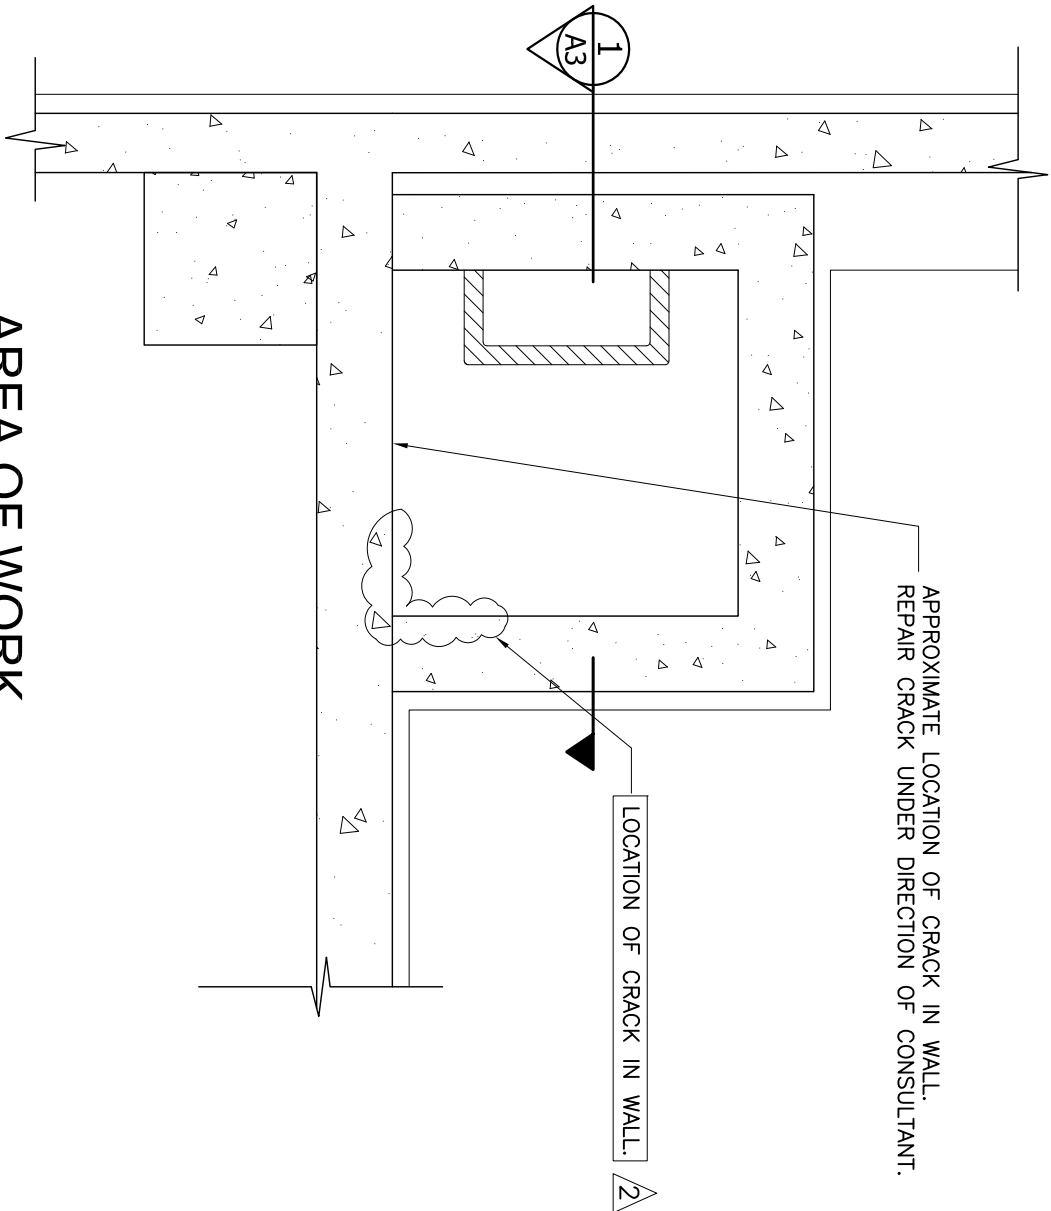

AREA OF WORK

SCALE: 1:20

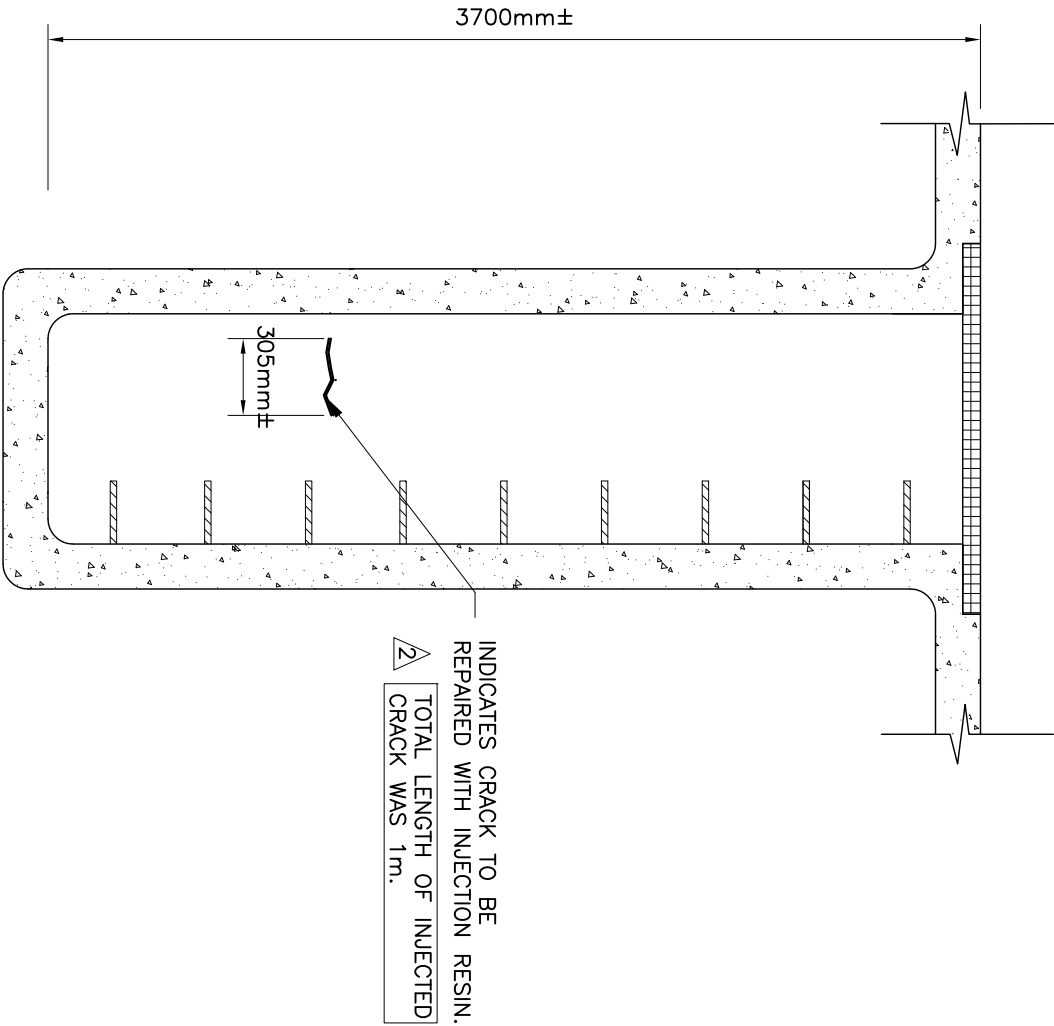

ENTRANCE PIT

SCALE: 1:30

NO.	REVISION	DATE
1	FOR TENDER	JULY 7, 2011
2	AS-BUILT	FEB 1, 2012
3		