


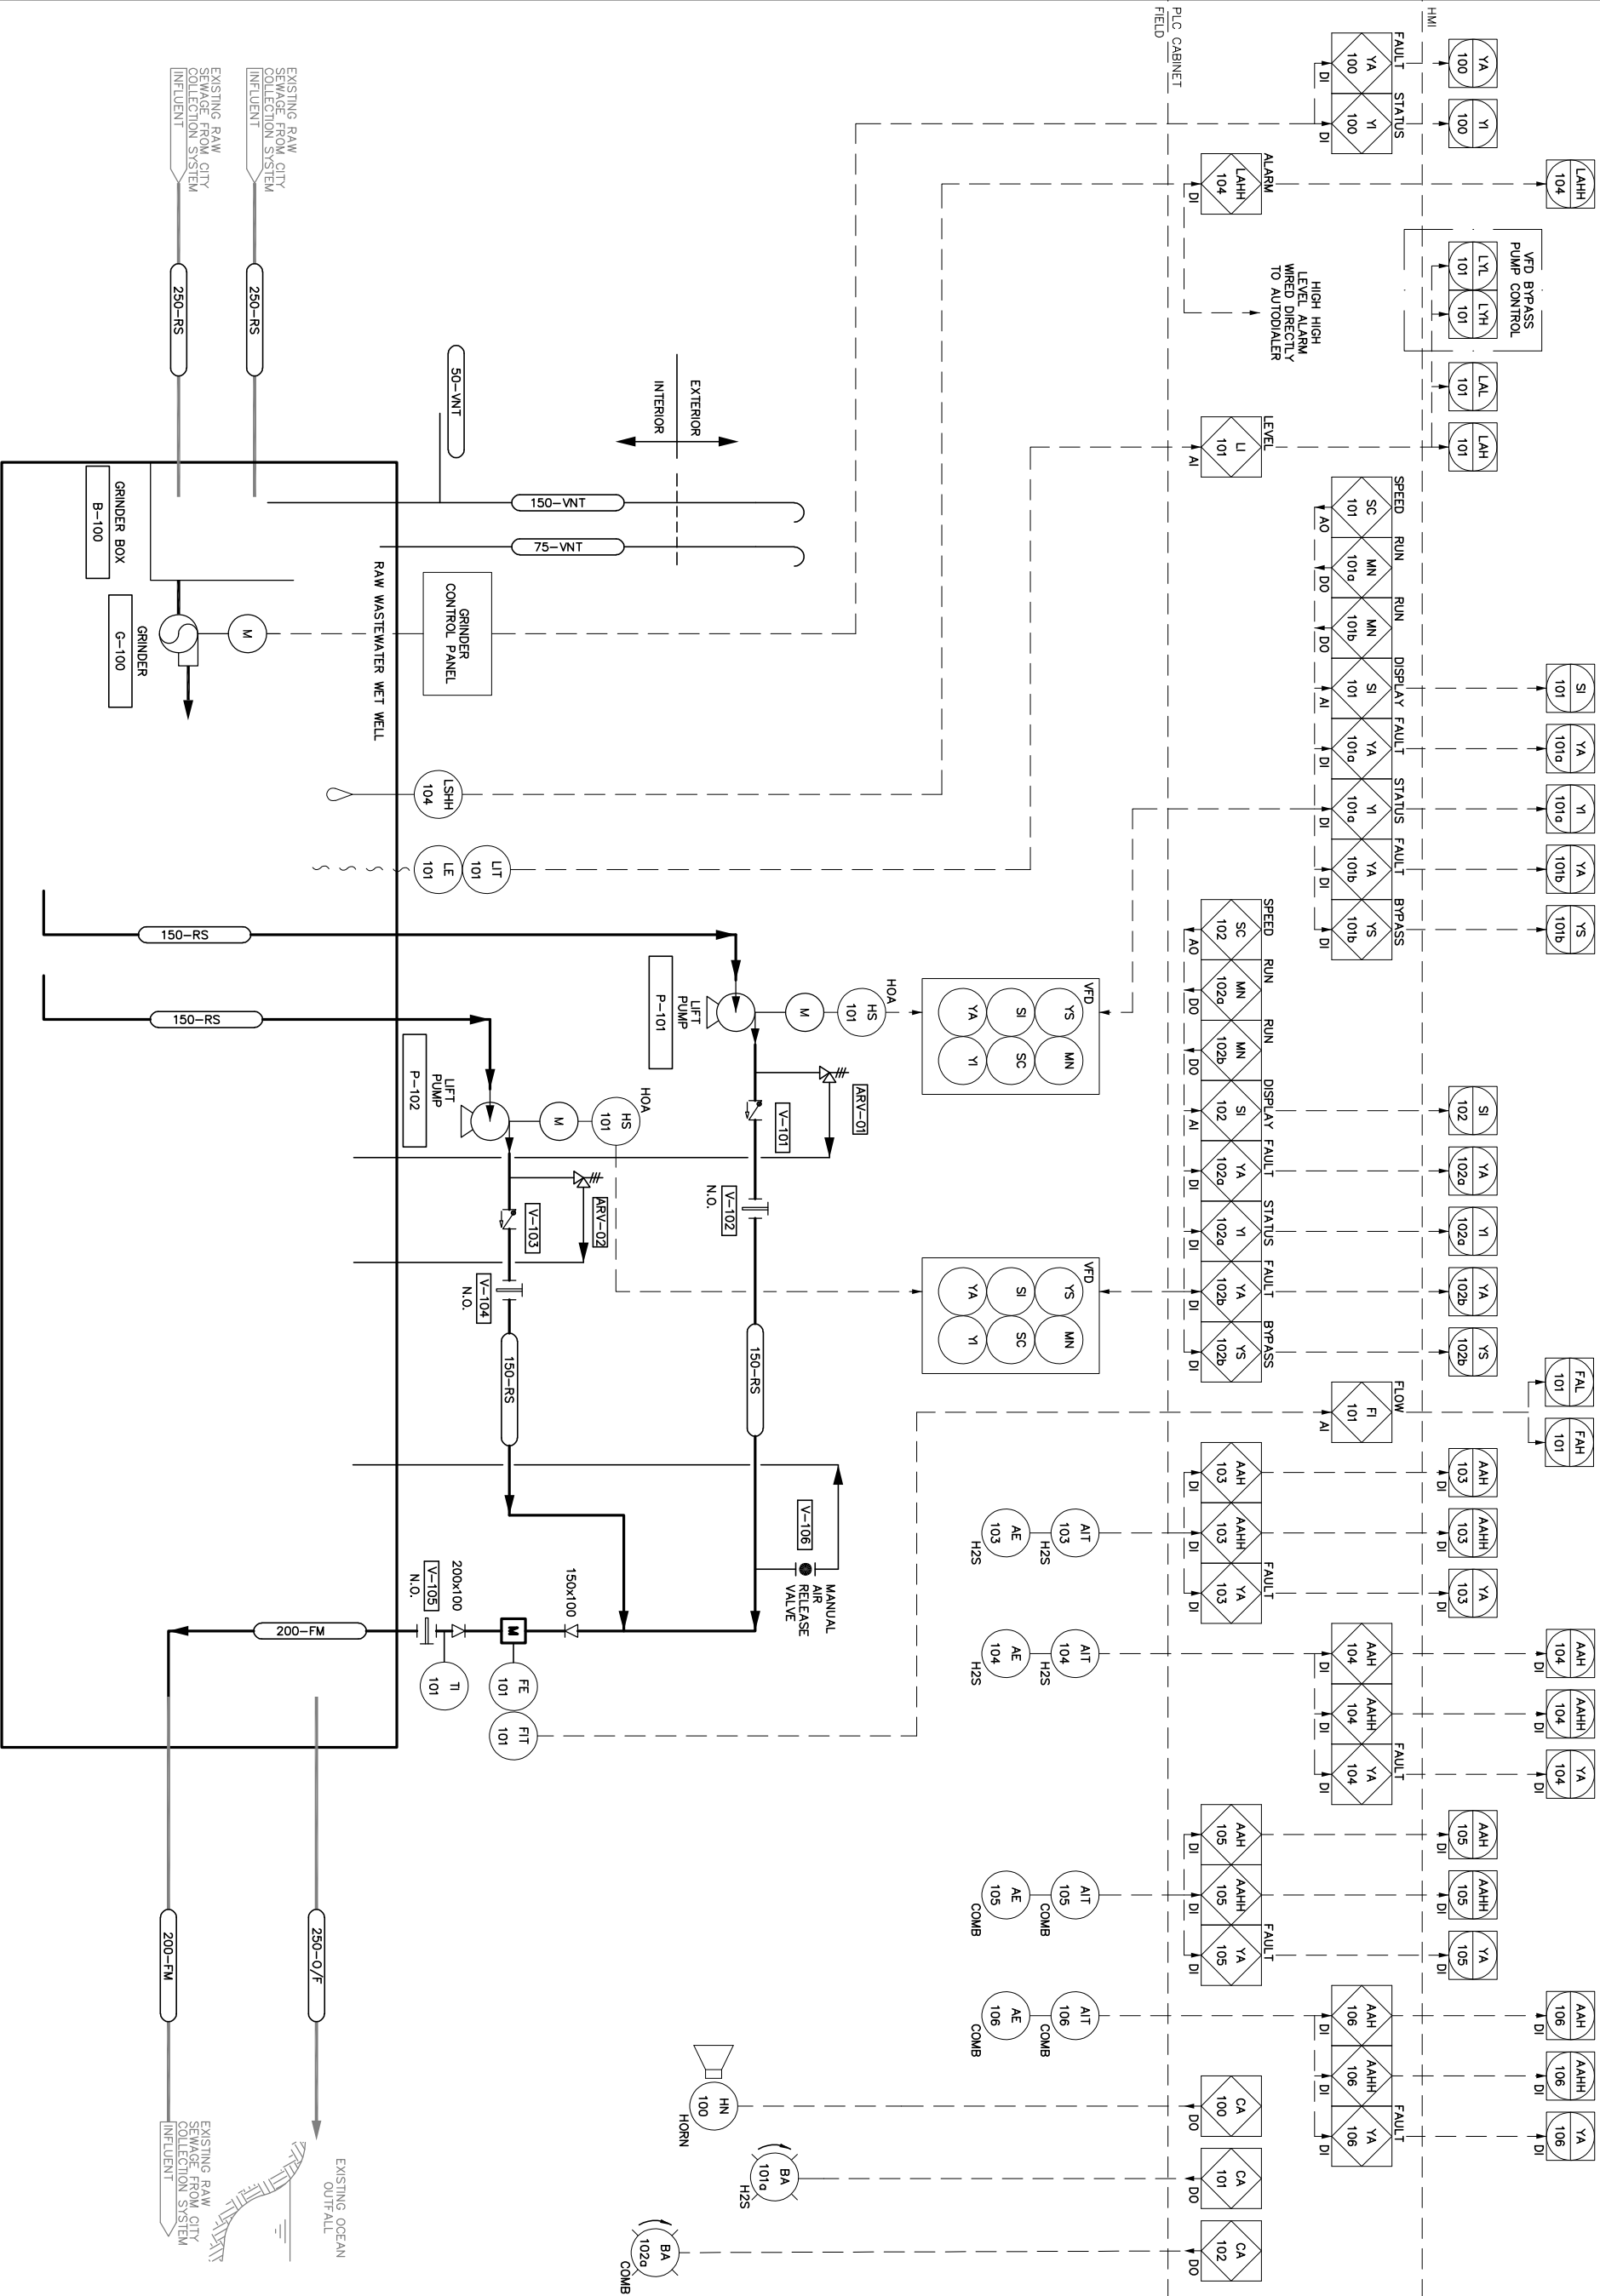

GENERAL NOTES

1. P&ID DOES NOT REPRESENT ALL I/O. REFER TO PLC I/O INDEX

Stamp

RECORD DRAWING
INFORMATION CONTAINED IN THESE DRAWINGS IS AS SUPPLIED BY THE CLIENT. EARTHTECH LTD. MAKES NO WARRANTY AS TO THE COMPLETENESS AND ACCURACY OF THIS RECORD DRAWING. IT IS NOT GUARANTEED. INFORMATION SHOULD BE VERIFIED AT THE ACTUAL LOCATION BEFORE USE.

No.	Date	Description
2	2007 03/20	RECORD DRAWING
1	2006 03/12	ISSUED FOR CONSTRUCTION
0	2005 15/06	ISSUED FOR TENDER
A	2005 05/27	ISSUED FOR REVIEW

Iqaluit
CITY of IQUALUIT,
Nunavut

Design CFC/DKB/RJB

Drawn CFC/DKB

Approved

Checked

LIFT STATION
NO. 1 UPGRADE

PIPING AND
INSTRUMENTATION
DIAGRAM