


STD 207

FLANGED PIPE SUPPORT

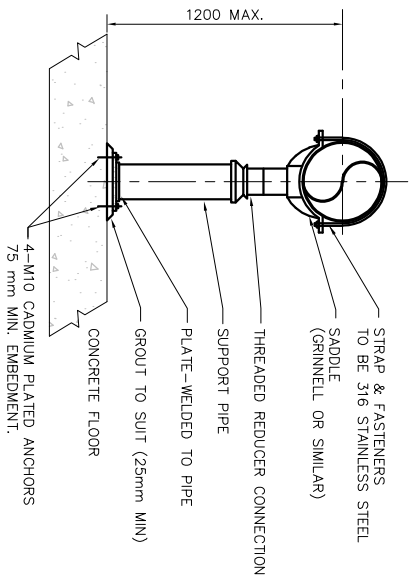


GLAVANIZE AFTER FABRICATION

PIPE SIZE (mm)	SUPPORT PIPE (mm)	PLATE SIZE (mm)
50	38	150 X 150 X 9.5
75	50	250 X 250 X 9.5
100	50	250 X 250 X 9.5
150	75	250 X 250 X 9.5
200	100	250 X 250 X 9.5
250	150	250 X 250 X 9.5
	200	300 X 300 X 9.5

STD 213


ADJUSTABLE PIPE SUPPORT

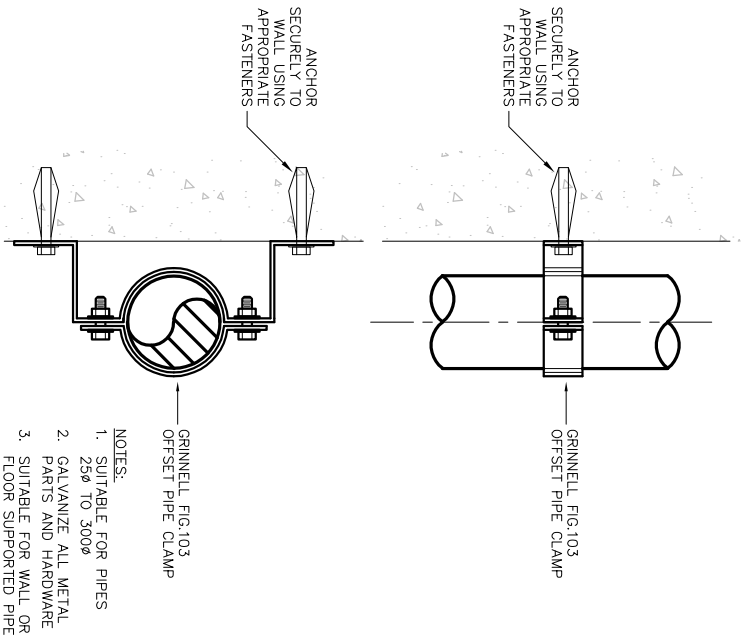

- NOTES:
- SUITABLE FOR PIPES 25ø TO 300ø
 - GALVANIZE ALL METAL PARTS AND HARDWARE
 - SUITABLE FOR WALL OR FLOOR SUPPORTED PIPE

STD 215


OFFSET PIPE SUPPORT

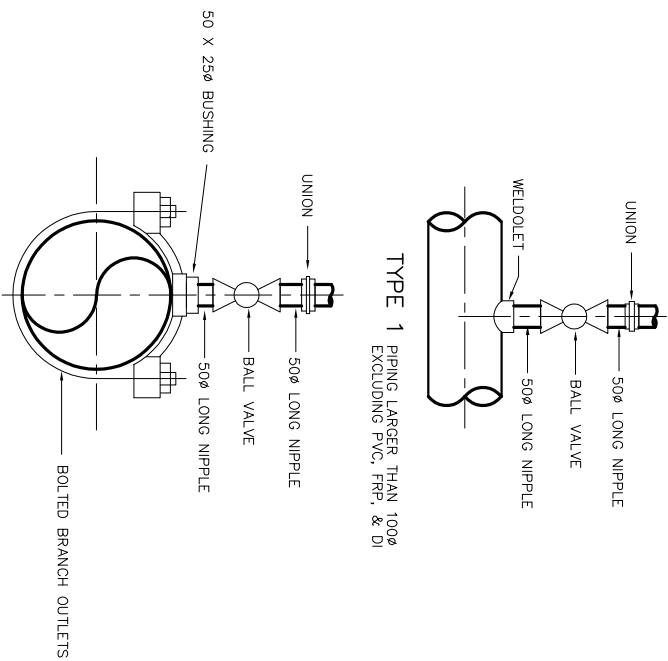

TYPE 2 SERVICE SADDLE FOR ALL PVC, S.S. FRP, DI & STEEL LINES 200ø AND LESS.


STD 503

TYPE 1 AND 2 TAPPINGS

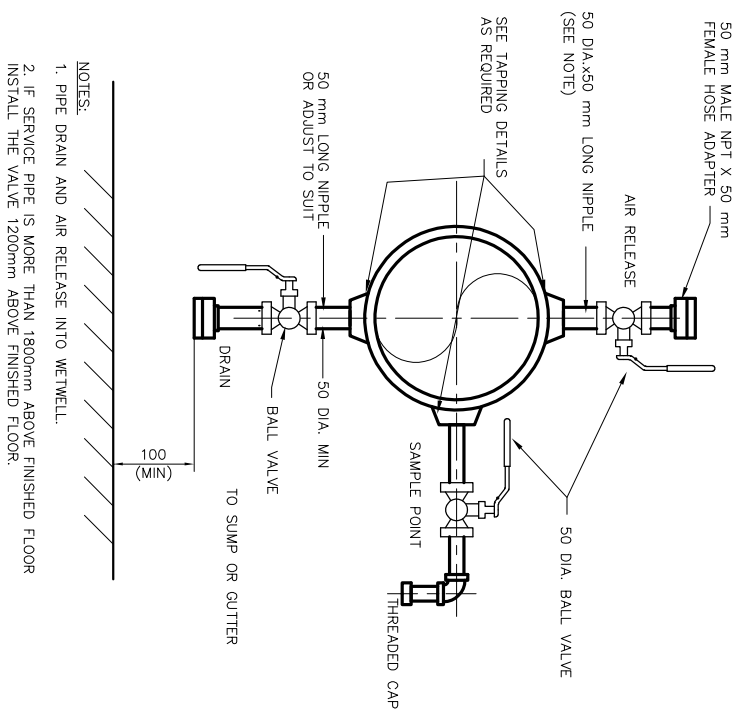

STD 507

50mm AIR RELEASE, SAMPLE AND DRAIN CONNECTION DETAILS

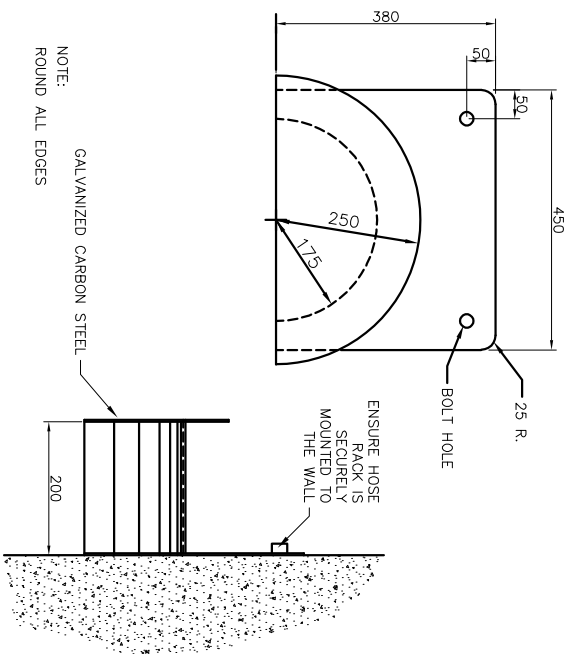

STD 601

TYPE 1 HOSE RACK

RECORD DRAWING
INFORMATION CONTAINED IN THESE DRAWINGS IS AS SUPPLIED BY THE CLIENT. EARTHTECH LTD. MAKES NO WARRANTY, REPRESENTATION OR GUARANTEE OF THE COMPLETENESS AND ACCURACY OF THIS RECORD DRAWING. INFORMATION SHOULD BE VERIFIED AT THE ACTUAL LOCATION BEFORE USE.

2	05/20	RECORD DRAWING
1	10/13	GENERAL REVISION
0	06/20	ISSUED FOR TENDER
No.	Date	Description
REVISIONS		

lqaluit
CITY of IQUALUIT,
Nunavut

Design	RHB
Drawn	DKB
Approved	
Checked	
Project Title	LIFT STATION No. 1 UPGRADE
Drawing Title	PROCESS STANDARD DETAILS

Scale	NOT TO SCALE
Project No.	84454
Date	13/05/05
Drawing No.	P6
Revision	2