


CHAIN HOOK



NOTES:

1. REFER TO THE MANUFACTURER'S INSTALLATION INSTRUCTIONS IN CONJUNCTION WITH THESE INSTALLATION RECOMMENDATIONS.
2. WHERE SPECIFIC INSTALLATION CONFLICTS ARISE THAT MIGHT PREVENT THESE INSTALLATION RECOMMENDATIONS FROM BEING COMPLIED WITH, CONSULT THE ENGINEER BEFORE PROCEEDING WITH THE INSTALLATION.
3. WHERE THE DRAWINGS INDICATE DIMENSIONS THAT DIFFER FROM THESE DETAILS, THE DRAWINGS SHALL TAKE PRIORITY.

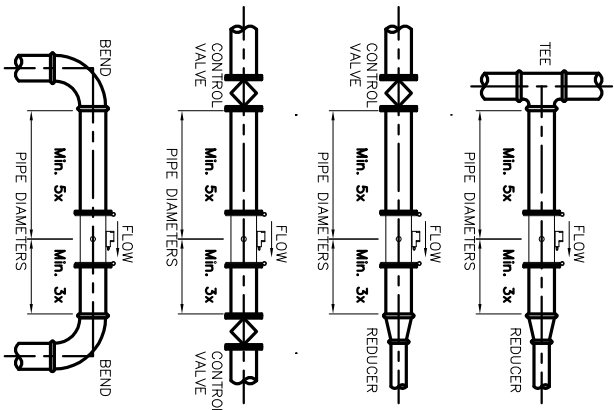

MAGNETIC FLOWMETER INSTALLATION CONFIGURATIONS

RECORD DRAWING
INFORMATION CONTAINED IN THESE DRAWINGS
IS AS SUPPLIED BY:
KUDLUK CONSTRUCTION LTD.
THE COMPLETENESS AND ACCURACY OF THIS
RECORD DRAWING IS NOT GUARANTEED.
INFORMATION SHOULD BE VERIFIED AT THE
ACTUAL LOCATION BEFORE USE.

No.	Date	Description
2	2007 06/20	RECORD DRAWING
1	2005 10/13	GENERAL REVISION
0	2005 06/27	ISSUED FOR TENDER



Design	RHB
Drawn	DKB
Approved	
Checked	
Project Title	

LIFT STATION
No. 1 UPGRADE

Drawing Title	
PROCESS STANDARD DETAILS	
Scale NOT TO SCALE	
Project No.	Date
84454	13/05/05
Drawing No.	Revision
P7	2