


CITY OF IQUALUIT







PROJECT: EXPANSION OF IQUALUIT LANDFILL FACILITY
CONTRACT 1
LOCATION: IQUALUIT, NUNAVUT
PROJECT NO: 01-9235

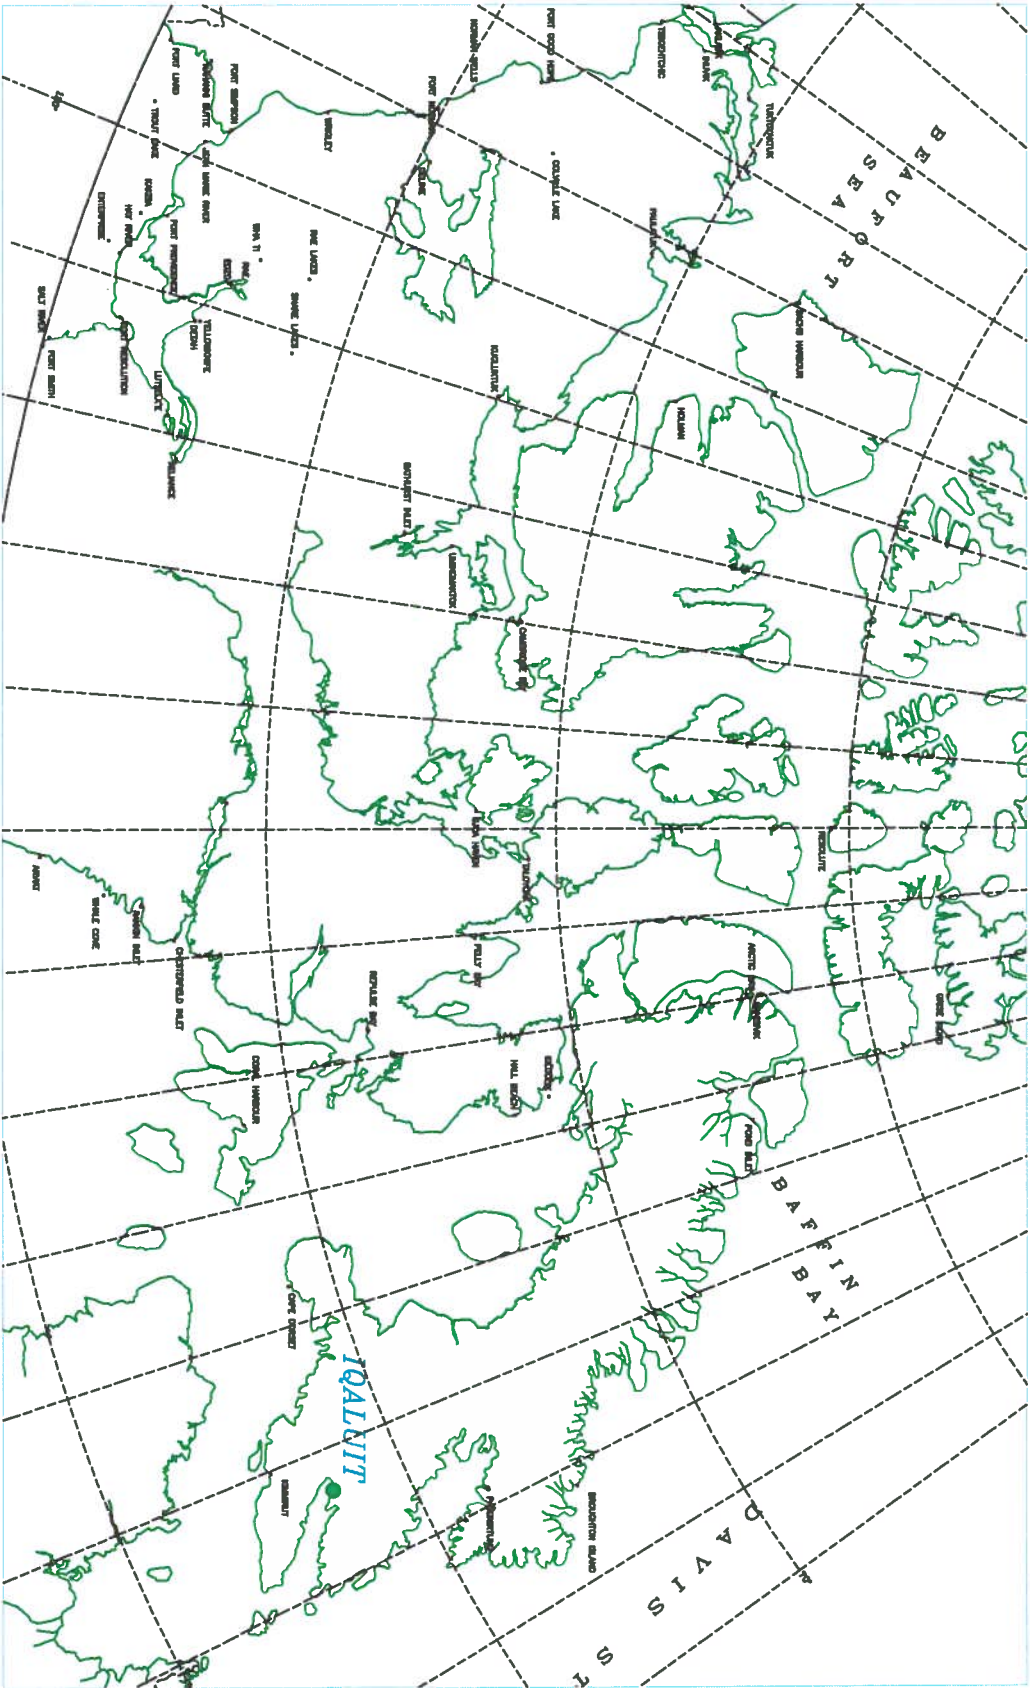

LOCATION PLAN

LIST OF DRAWINGS

- DWG. 1 EXISTING SITE PLAN
- DWG. 2 PROPOSED CELL 1 SITE PLAN
- DWG. 3 TYPICAL DETAILS

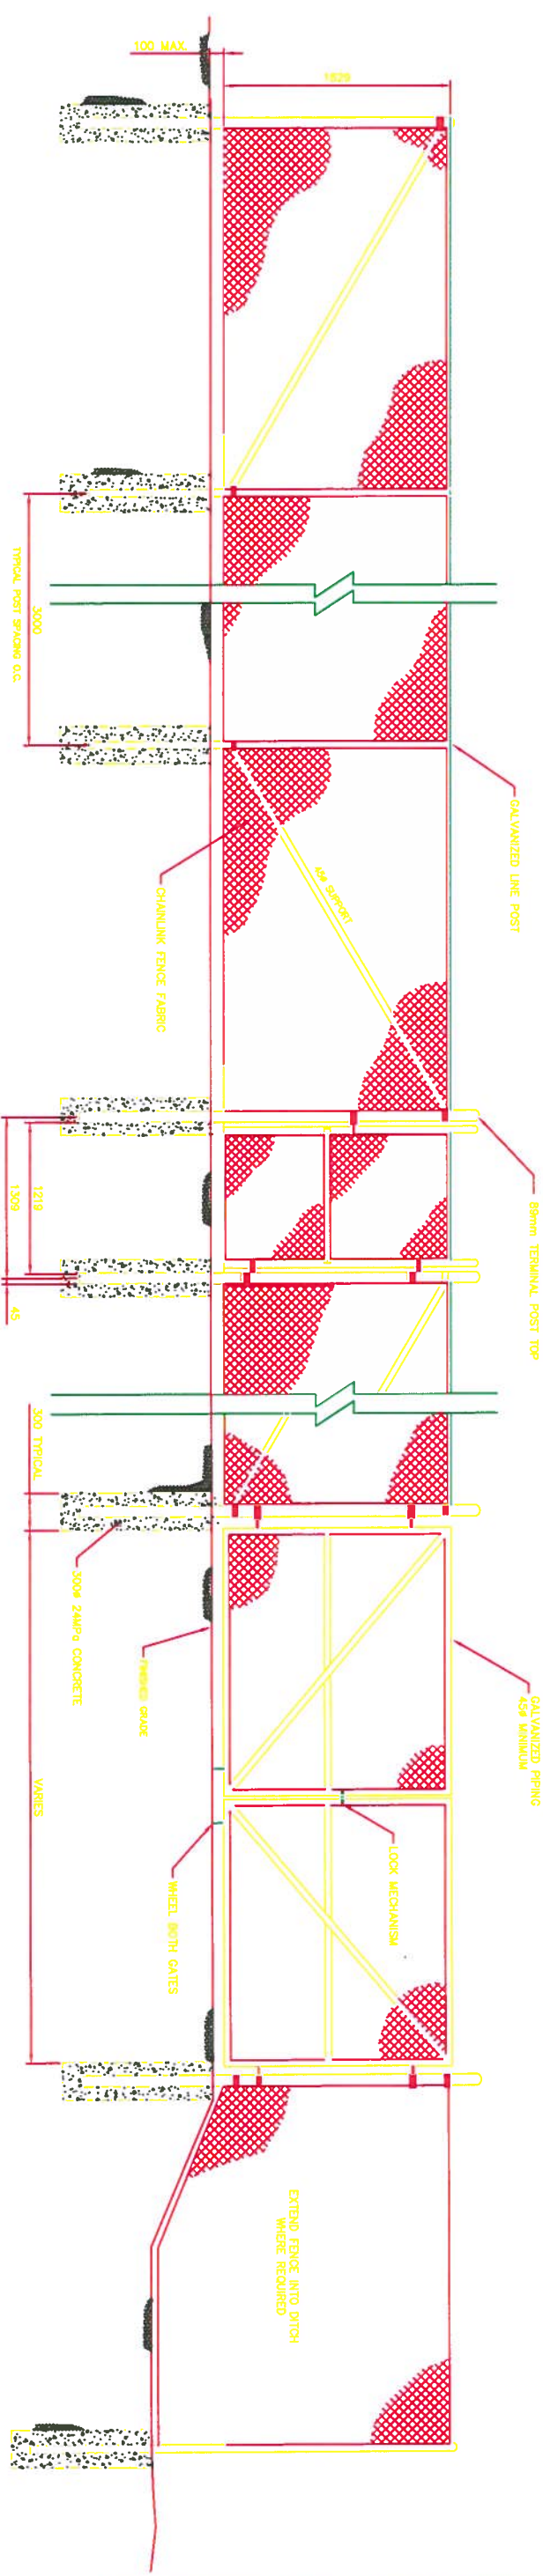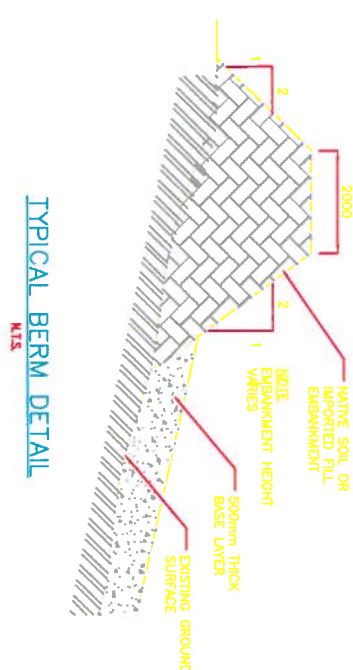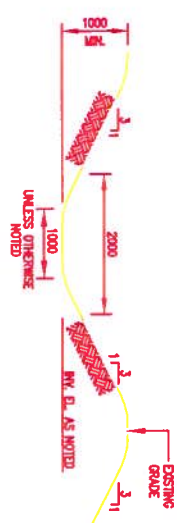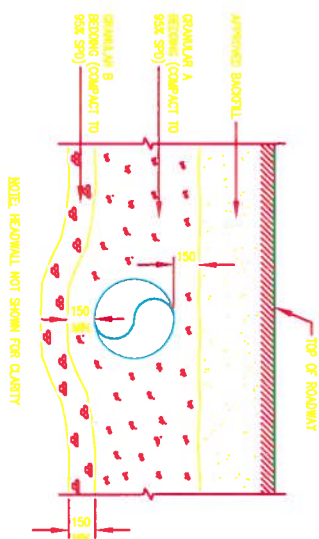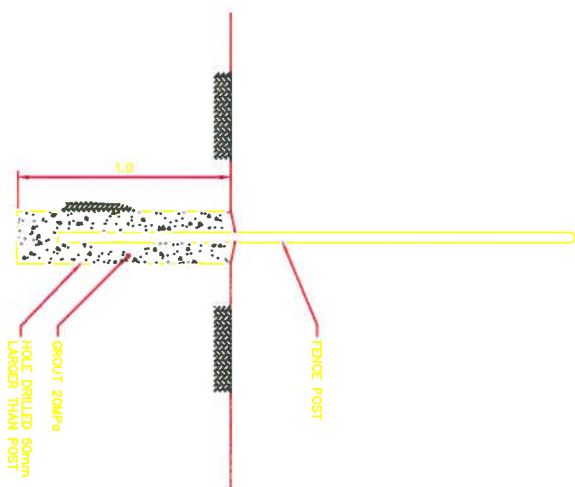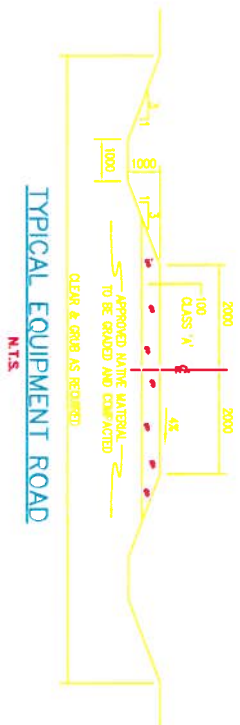

RECORD DRAWING

APPROVED BY

一

[illegible]

THE ASSOCIATION OF
PROFESSIONAL ENGINEERS,
GEOLOGISTS AND GEOPHYSICISTS
OF THE NORTHWEST TERRITORIES
PERMIT NUMBER
P 010
DILLON CONSULTING
LIMITED



DATE	RECORDS	DATE	BY	FILE	CLASS	KT7/SS
					CLASS	KT7/SS
					TRAIN	TPW
					ORDERED	CS
2	RECORD DRAWING	12/18/01			KT7/SS	
1	ISSUED FOR TENDER	06/20/01	-		APPROVED	KT7/SS
DATE	RECORDS	DATE	BY	FILE	AS NOTED	

IGALUT LANDFILL FACILITY EXPANSION


TYPICAL DETAILS

01-9235

3



NOTE:
CONTOURS WITHIN THE LANDFILL CELL
ARE PRE-CONSTRUCTION ELEVATIONS.

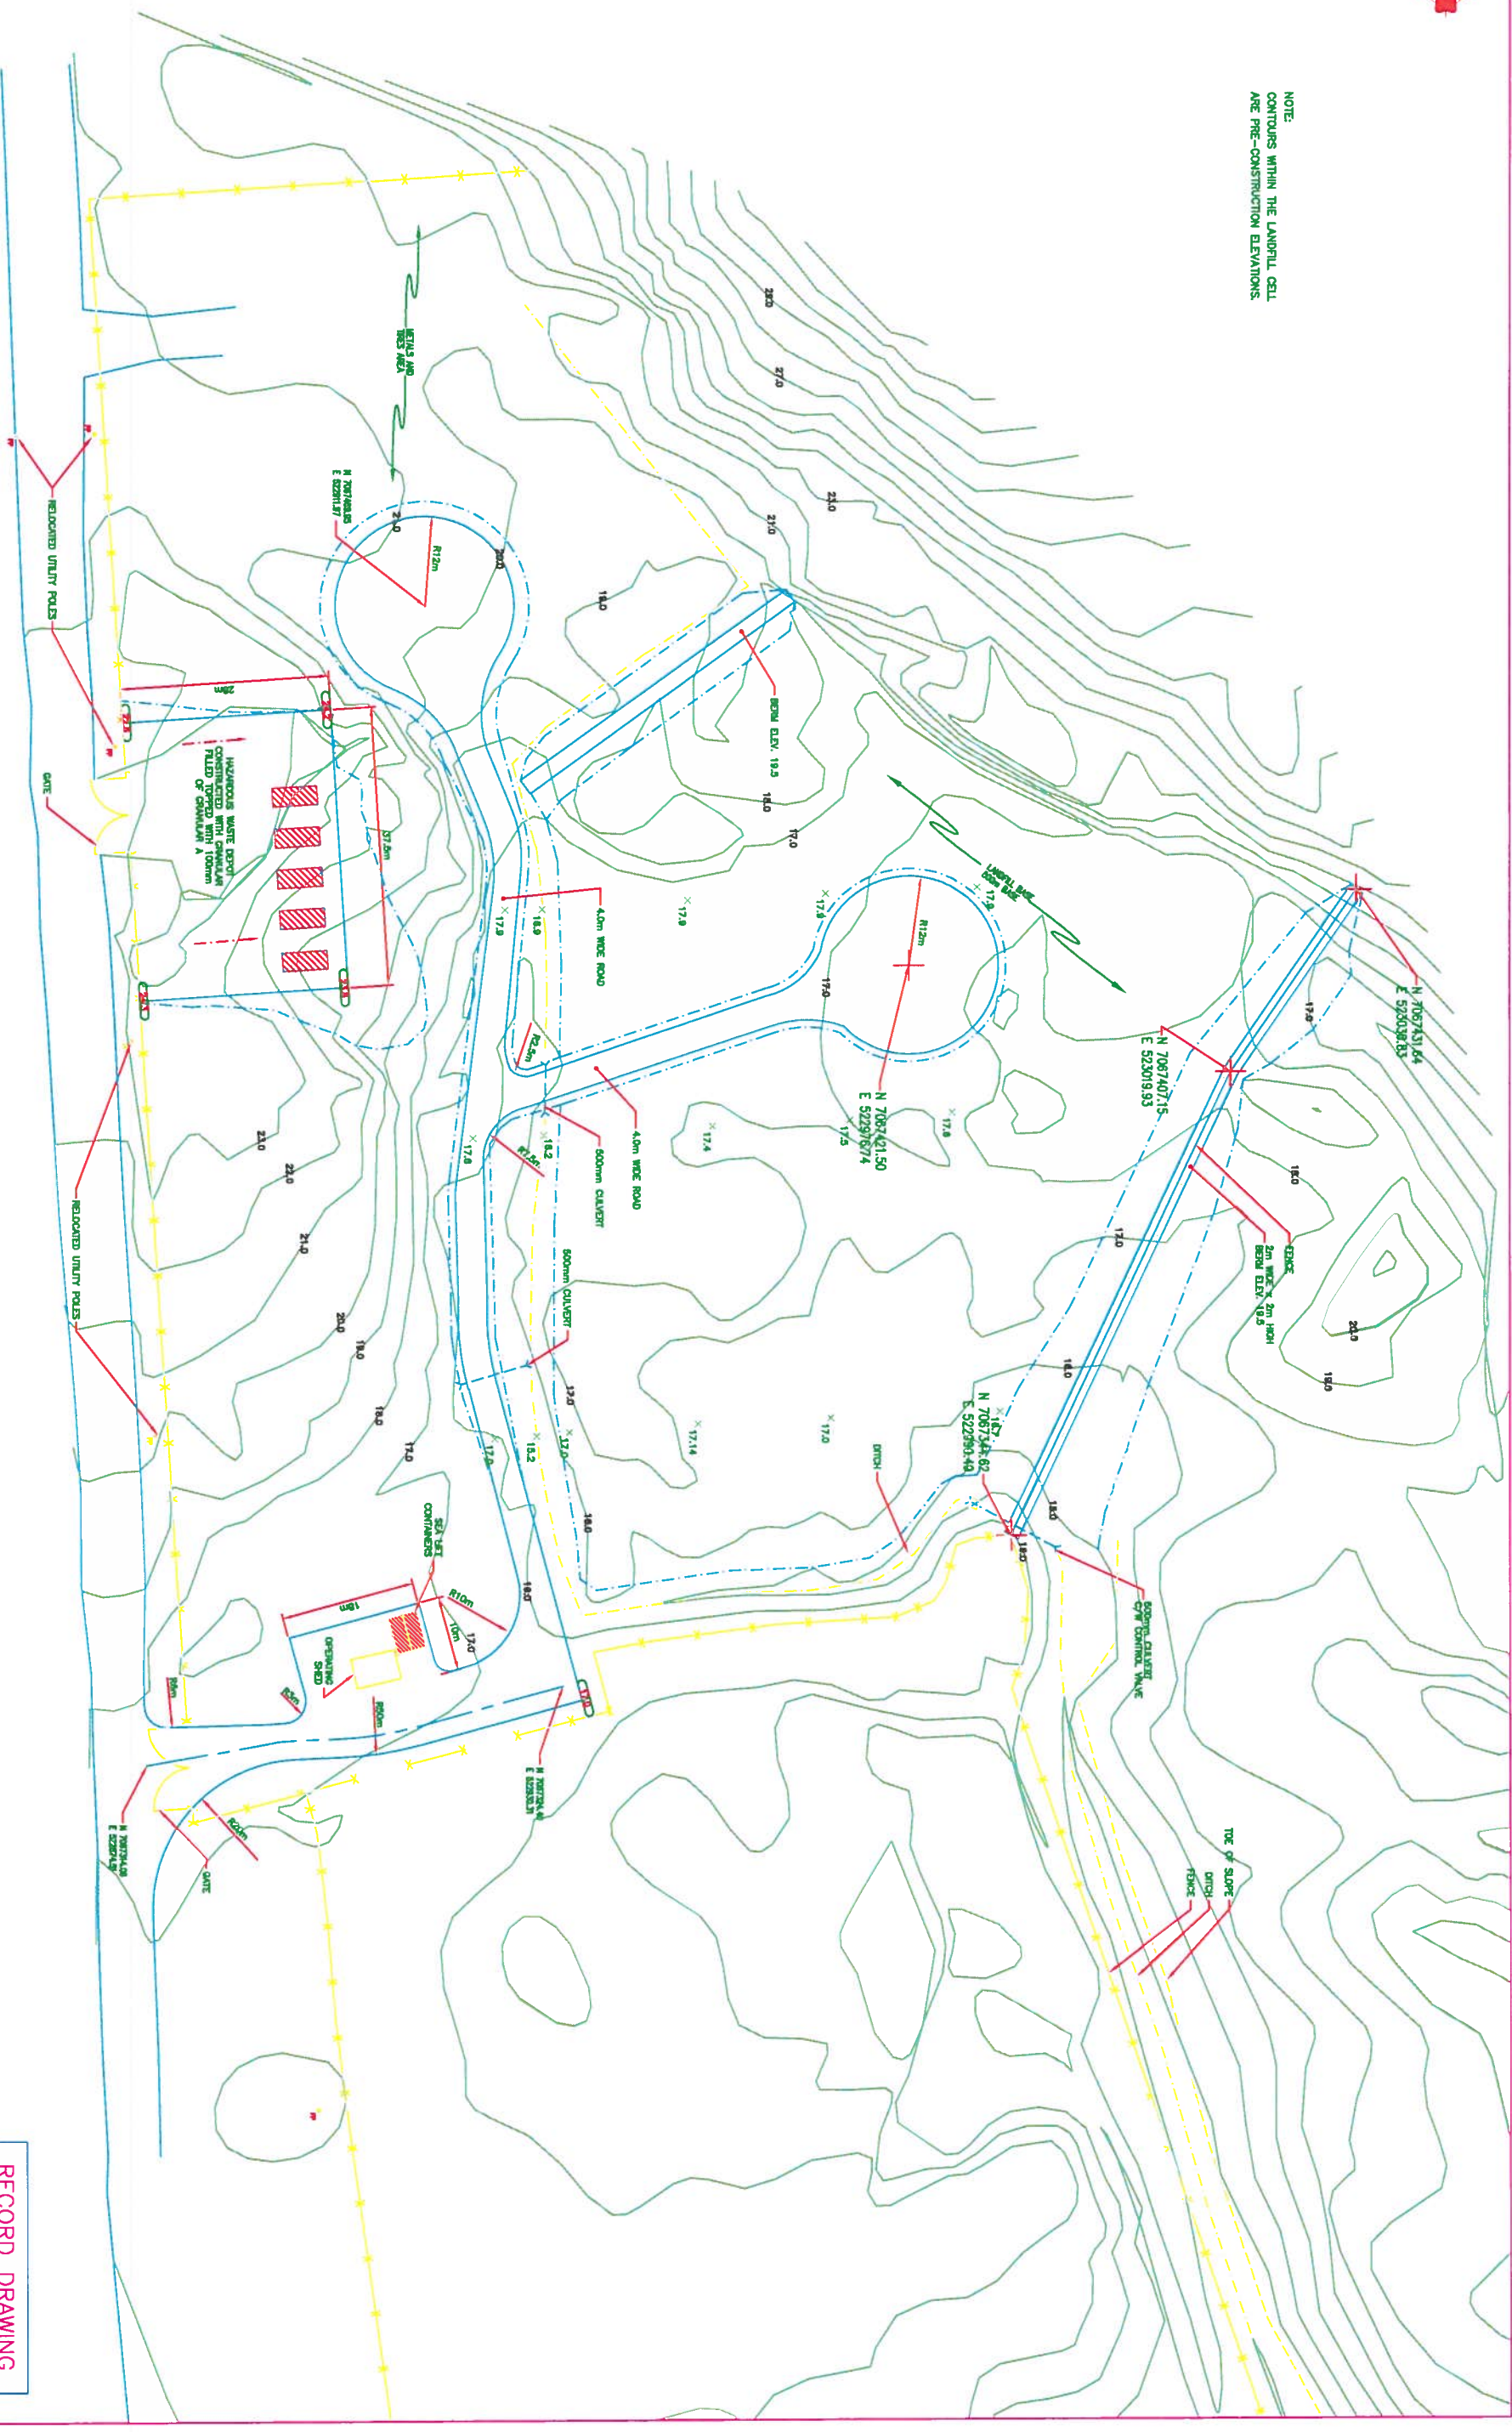

RECORD DRAWING


Approved by

PRINT RECORD			NO.		FOR		DATE																												
THE ASSOCIATION OF PROFESSIONAL ENGINEERS OF ALBERTA, BRITISH COLUMBIA, SASKATCHEWAN, MANITOBA, ONTARIO, QUEBEC AND THE NORTHWEST TERRITORIES PERMIT NUMBER P 010 DILLON CONSULTING LIMITED																																			
																																			
 CITY OF IQALUIT																																			
 DILLON CONSULTING																																			
<table border="1"> <thead> <tr> <th>NO.</th> <th>RECORD DRAWING</th> <th>ISSUED FOR TENDER</th> <th>DATE</th> <th>BY</th> <th>SCALE</th> <th>DATE</th> <th>BY</th> <th>SCALE</th> </tr> </thead> <tbody> <tr> <td>1</td> <td>ISSUED FOR TENDER</td> <td>12/18/01</td> <td>08/20/01</td> <td>-</td> <td>AUG 01</td> <td></td> <td></td> <td></td> </tr> <tr> <td>2</td> <td>RECORD DRAWING</td> <td>12/18/01</td> <td>08/20/01</td> <td>-</td> <td>AUG 01</td> <td></td> <td></td> <td></td> </tr> </tbody> </table>									NO.	RECORD DRAWING	ISSUED FOR TENDER	DATE	BY	SCALE	DATE	BY	SCALE	1	ISSUED FOR TENDER	12/18/01	08/20/01	-	AUG 01				2	RECORD DRAWING	12/18/01	08/20/01	-	AUG 01			
NO.	RECORD DRAWING	ISSUED FOR TENDER	DATE	BY	SCALE	DATE	BY	SCALE																											
1	ISSUED FOR TENDER	12/18/01	08/20/01	-	AUG 01																														
2	RECORD DRAWING	12/18/01	08/20/01	-	AUG 01																														
CELL 1 ASBUILT SITE PLAN																																			
IQALUIT LANDFILL FACILITY EXPANSION-9233																																			
2																																			
3																																			

RECORD DRAWING

APPROVED BY


DATE

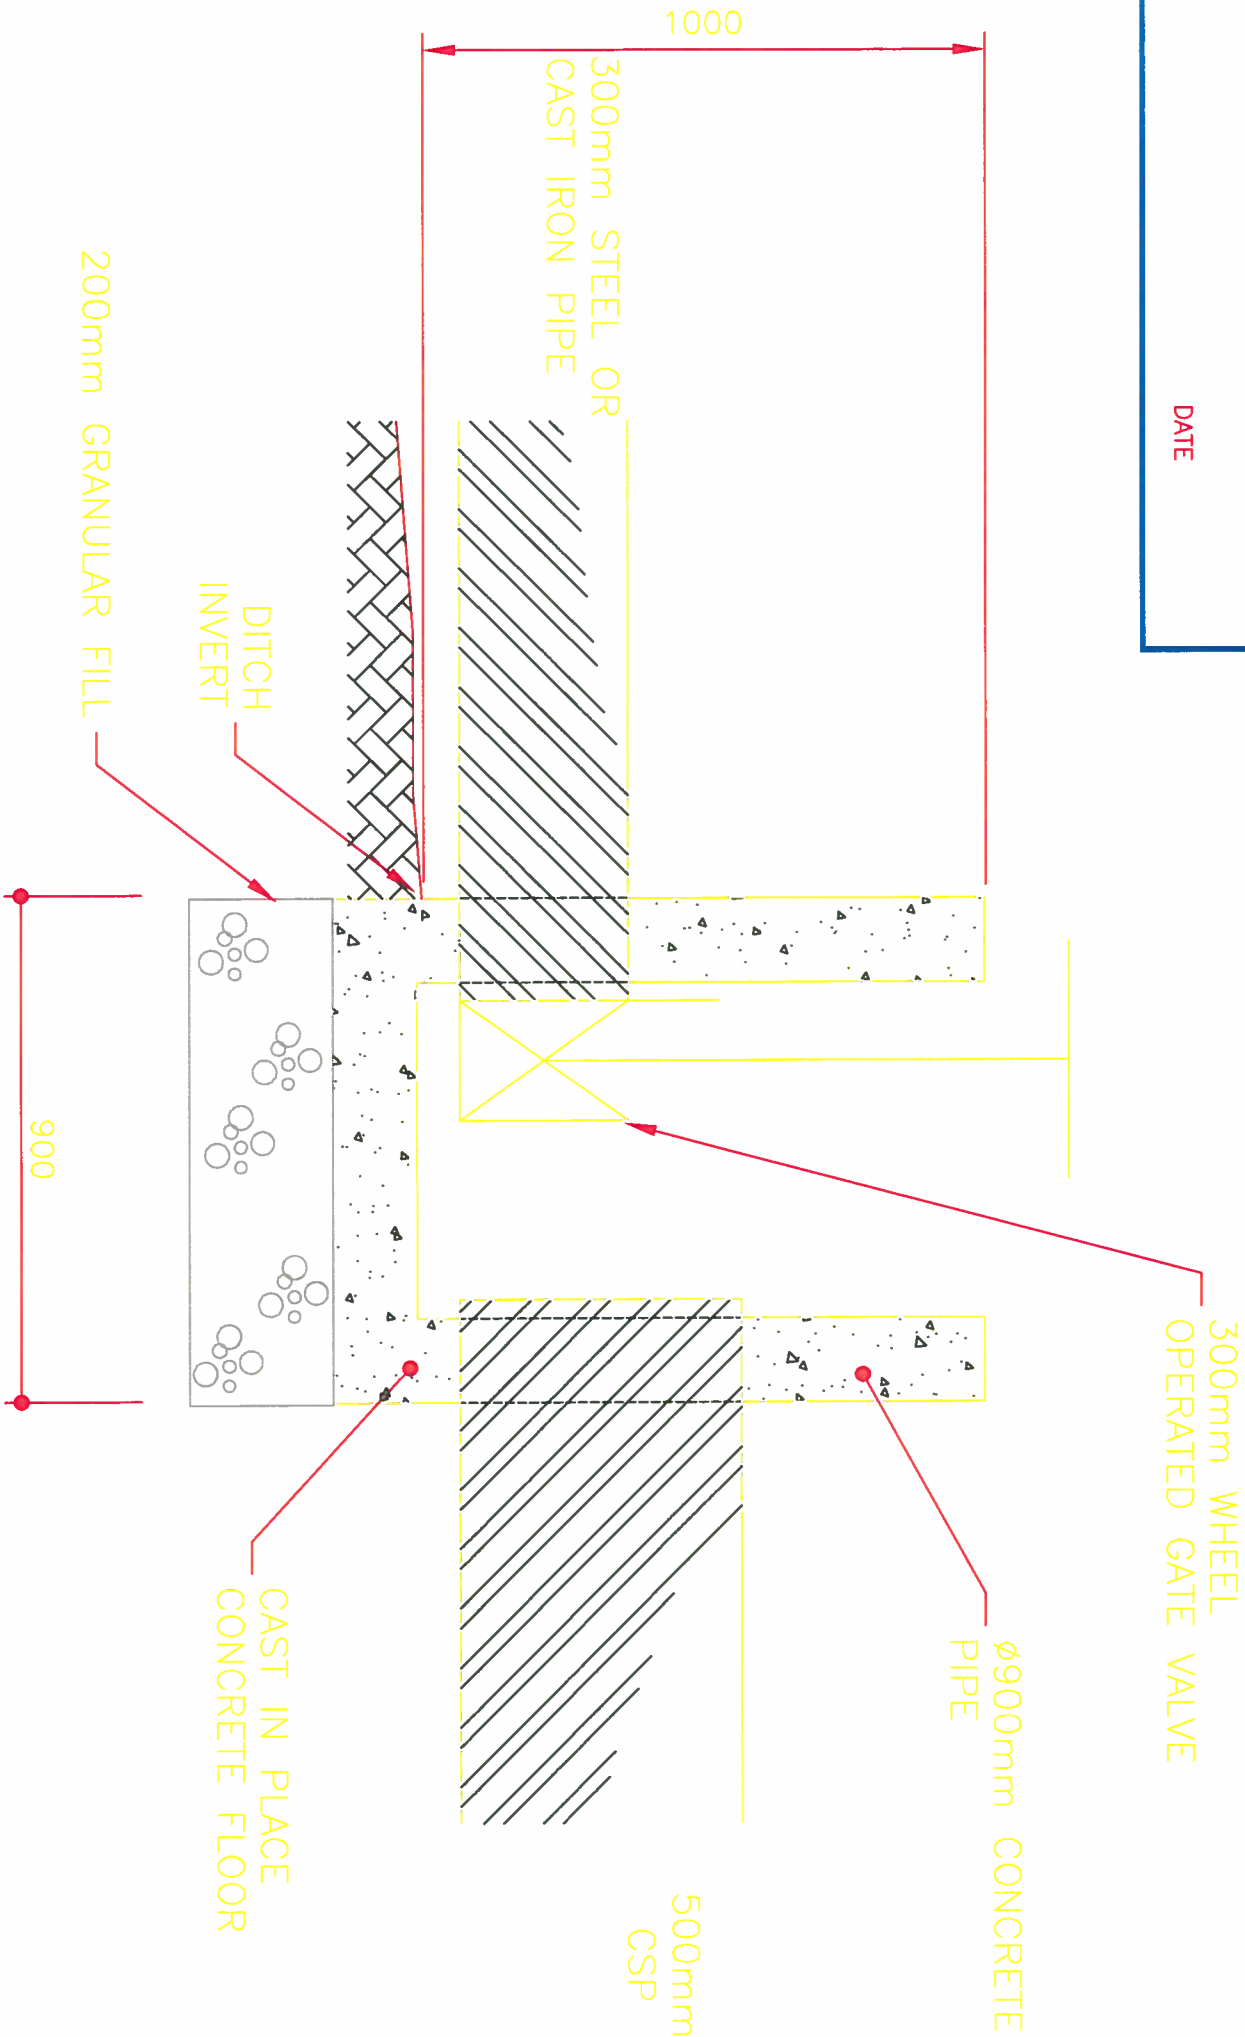

CONTROL STRUCTURE

N.T.S.

EDIT DATE: 30/11/00 BASE NAME:
ACAD FILE:

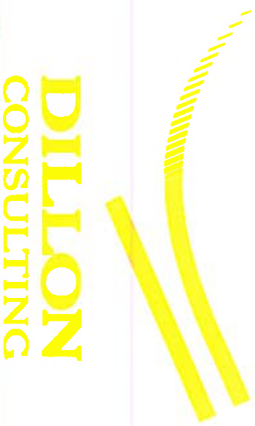	PROJECT	PROJECT NUMBER	
	TITLE	01-9235	
		DATE	
IQUALUIT LANDFILL FACILITY EXPANSION		AUG 2001	
CONTROL STRUCTURE DETAIL		FIGURE NUMBER FIG 1	