



	PROPOSED OFF-SITE DRAINAGE
	PROPOSED ON-SITE DRAINAGE
	PROPOSED CULVERT
	EXISTING CULVERT
	OVER HEAD POWER LINE
	SHACK
	PROJECT LIMIT
	CONSTRUCTION CONTROL POINT

4	04/16 2010	ISSUED FOR RECORD DRAWING BASED UPON CONTRACTOR DATA
3	09/07 2006	ISSUED FOR LAYOUT
2	08/23 2006	ISSUED FOR CONSTRUCTION
1	07/24 2006	ISSUED FOR TENDER
0	06/06 2006	PRELIMINARY
No.	Date	Description


 CITY of IQALUIT,
Nunavut

Project Title	IQALUIT LANDFILL IMPROVEMENTS—2006
---------------	--

Drawing Title

CENTRAL
EXPANSION
IMPROVEMENTS

Scale: 1:500	
Project No. 93107	Date 10.04.16
Drawing No. C03	Revision 4

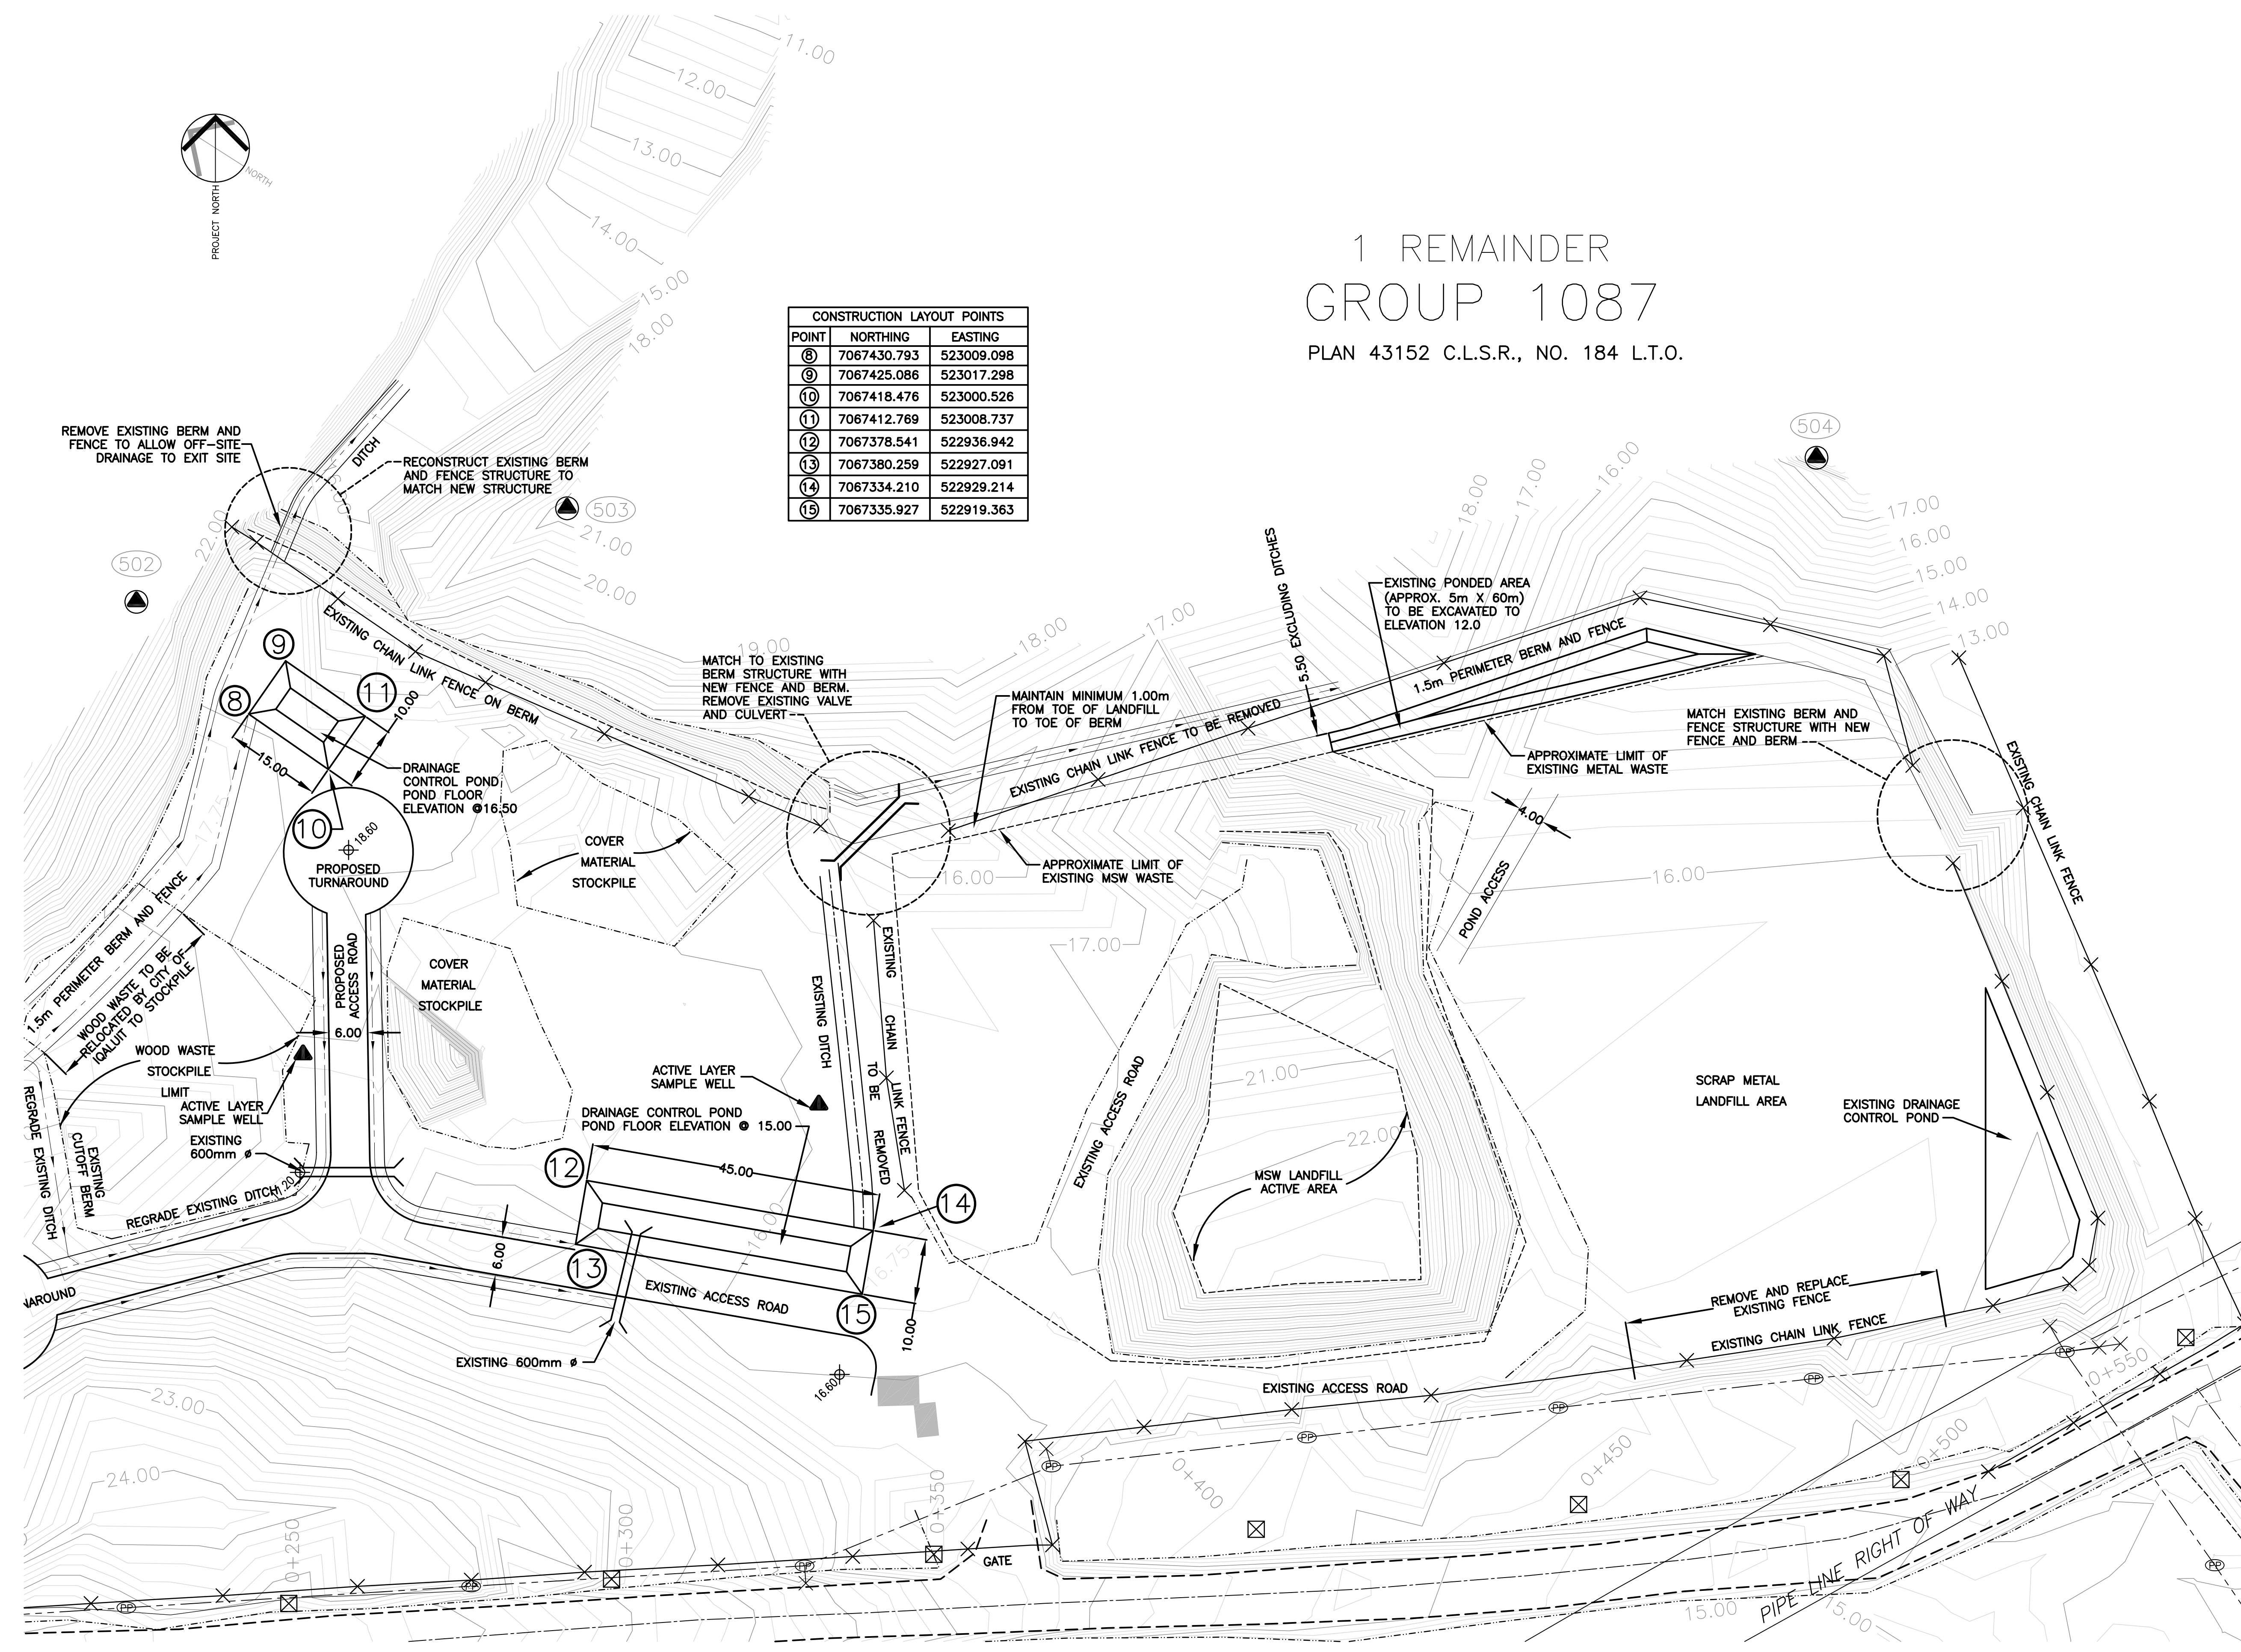

LAST SAVED: 15/4/2010 1:58 PM
L:\work\93000\93107\02a-CAD\WAT\Issued\2010-04-15 Issued For Record Drawings\CAD\B3\DATE-C035 DRGN\AGE-FLN\BUBBLR: ARE-AMMRS. MATTHEW