



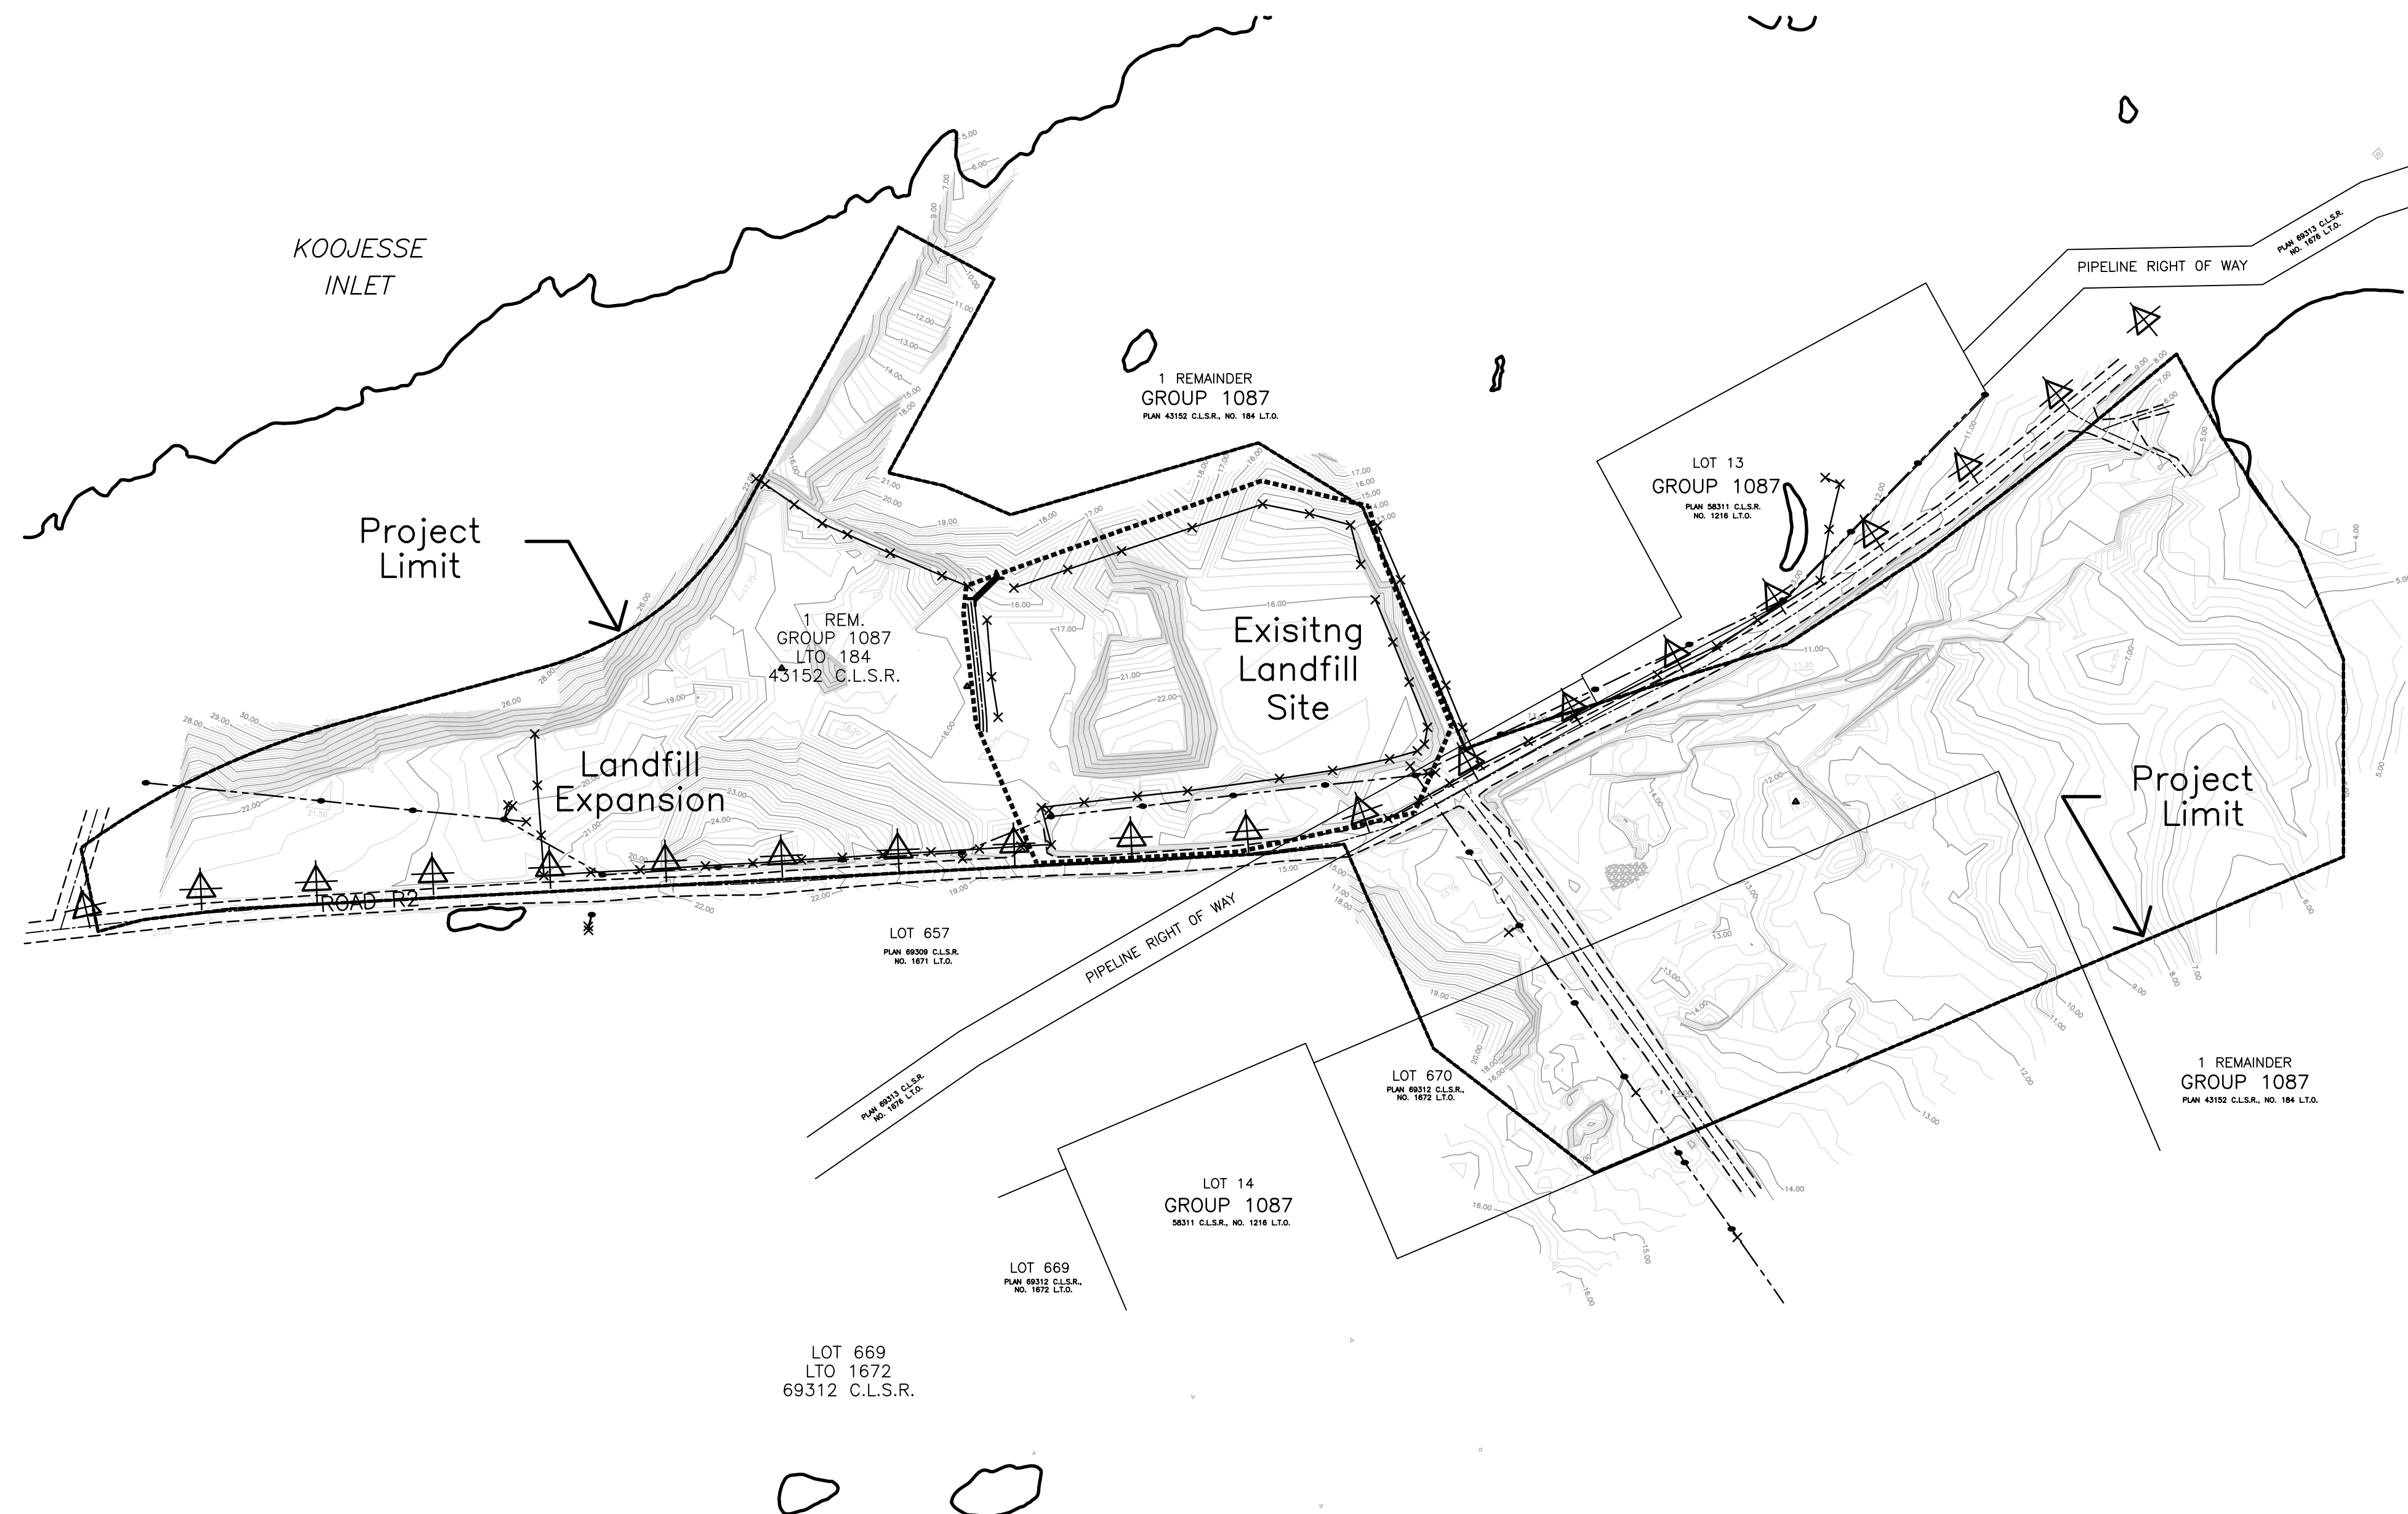

CONTROL POINT LOCATIONS			
STATION #	NORTHING	EASTING	ELEVATION
500	522876.29	7067469.11	24.056
501	522931.67	7067621.70	31.028
502	523026.42	7067488.16	25.379
503	523040.90	7067381.56	21.345
504	523048.72	7067188.35	19.106
505	522792.72	7067149.11	24.236

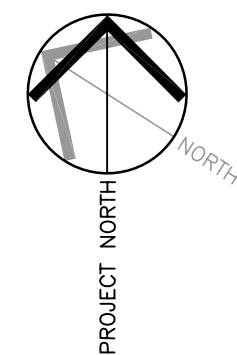

17203-103rd Avenue
EDMONTON, ALBERTA
T5S 1J4 CANADA
Tel. 780-488-6800
Fax. 780-488-2121
www.earthtech.ca

LEGEND

- PROJECT LIMIT
- OVERHEAD POWER with GUY WIRE
- SURVEY CONTROL POINT
- CONSTRUCTION CONTROL POINT
- PROPERTY LINE

Stamp

3	04/16/2010	ISSUED FOR RECORD DRAWING BASED UPON CONTRACTOR DATA
2	08/23/2006	ISSUED FOR CONSTRUCTION DATA
1	07/24/2006	ISSUED FOR TENDER
0	06/03/2006	PRELIMINARY
No.	Date	Description

REVISIONS



Design MM/KRJ
Drawn SB/CJD
Project Title

IQALUIT LANDFILL IMPROVEMENTS-2006

Drawing Title
SITE PLAN

Scale: 1:2000	Date
Project No. 93107	10.04.16
Drawing No. C01	Revision 3