




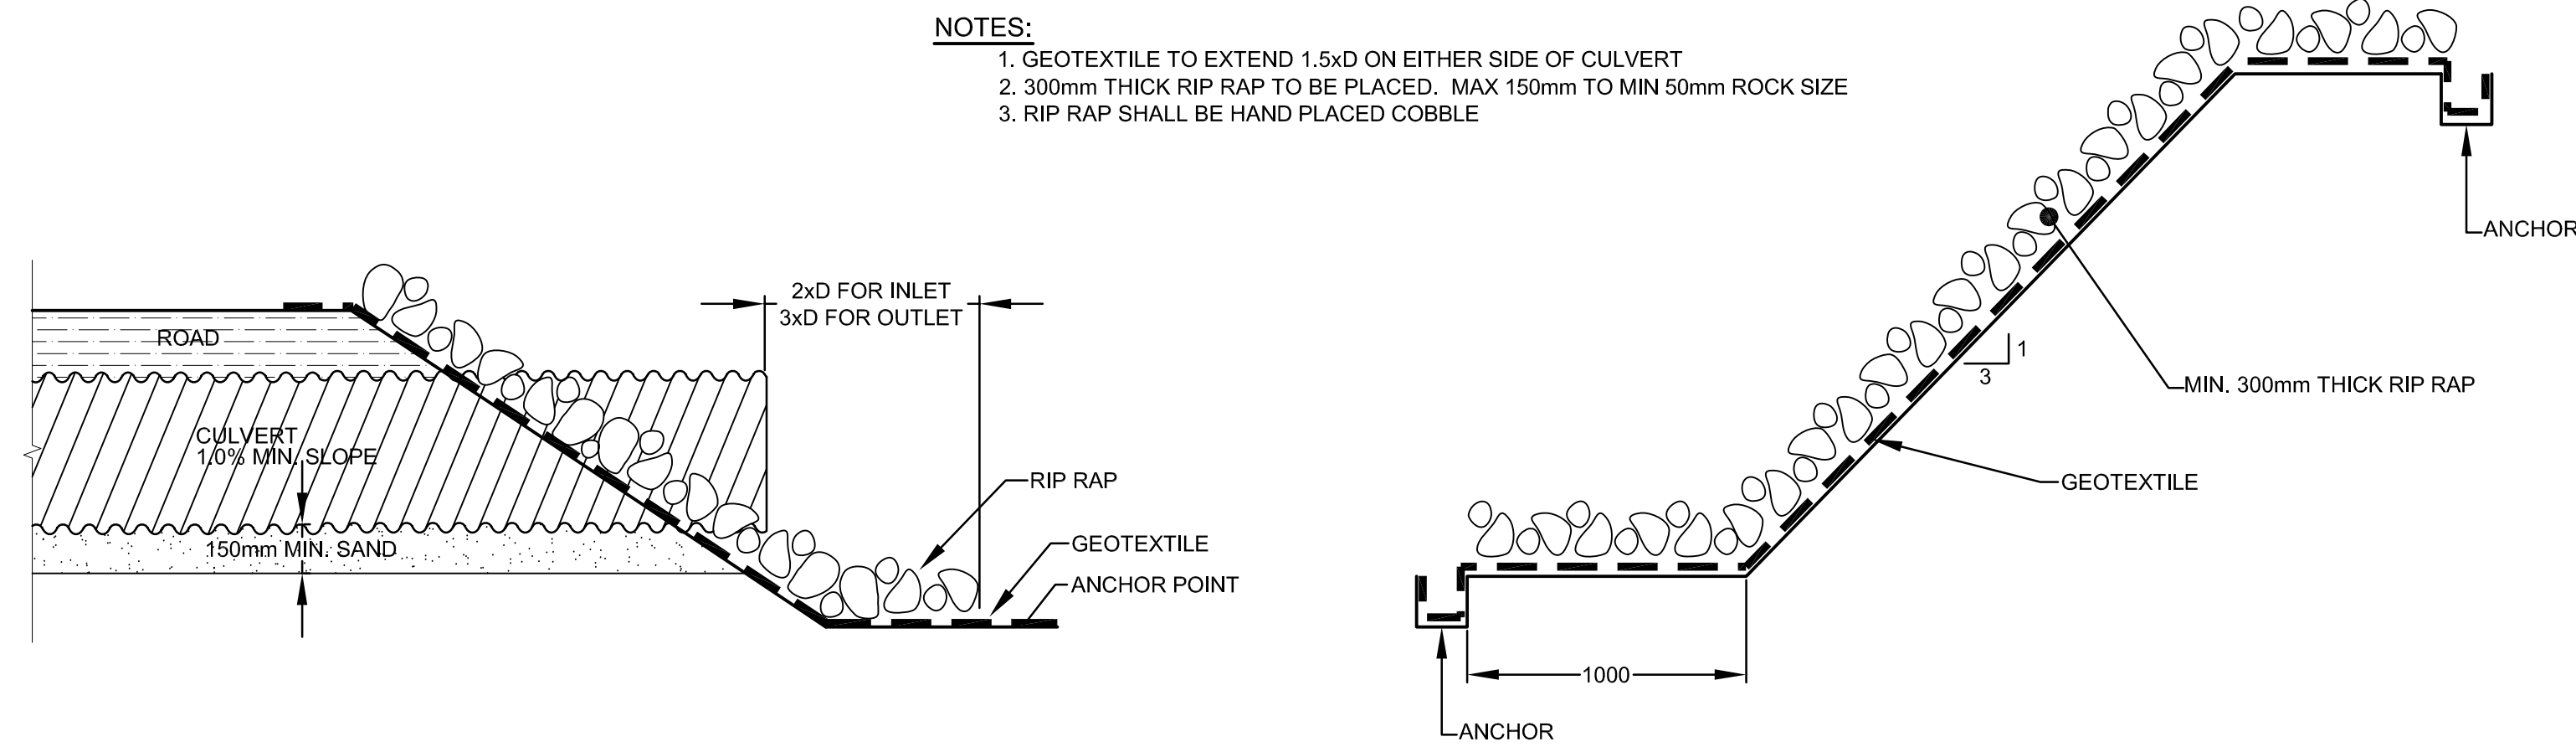


CULVERT with EROSION PROTECTION
NOT TO SCALE

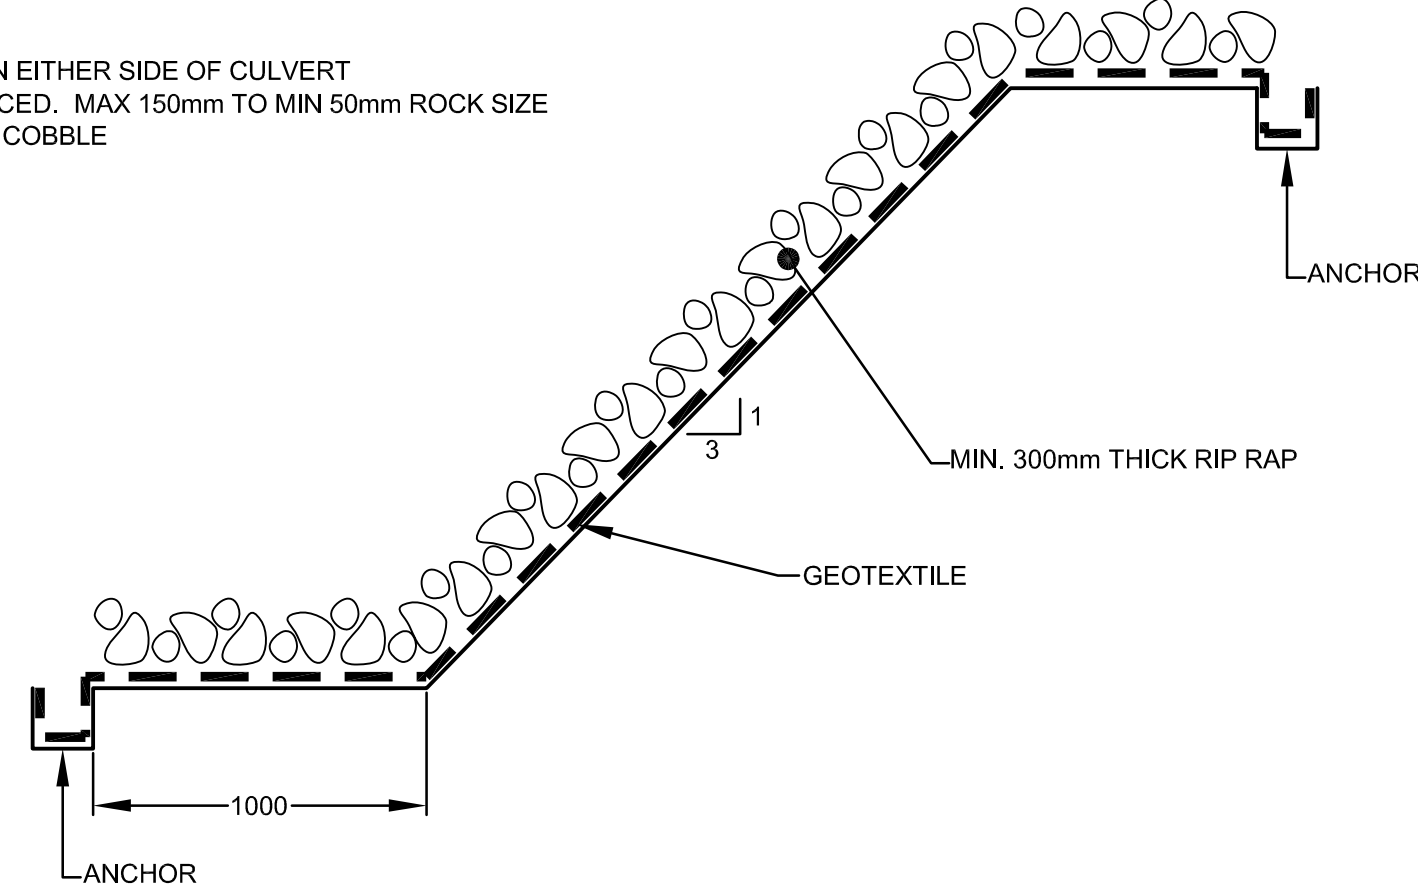

POND INLET STRUCTURE
NOT TO SCALE
DIMENSIONS IN mm

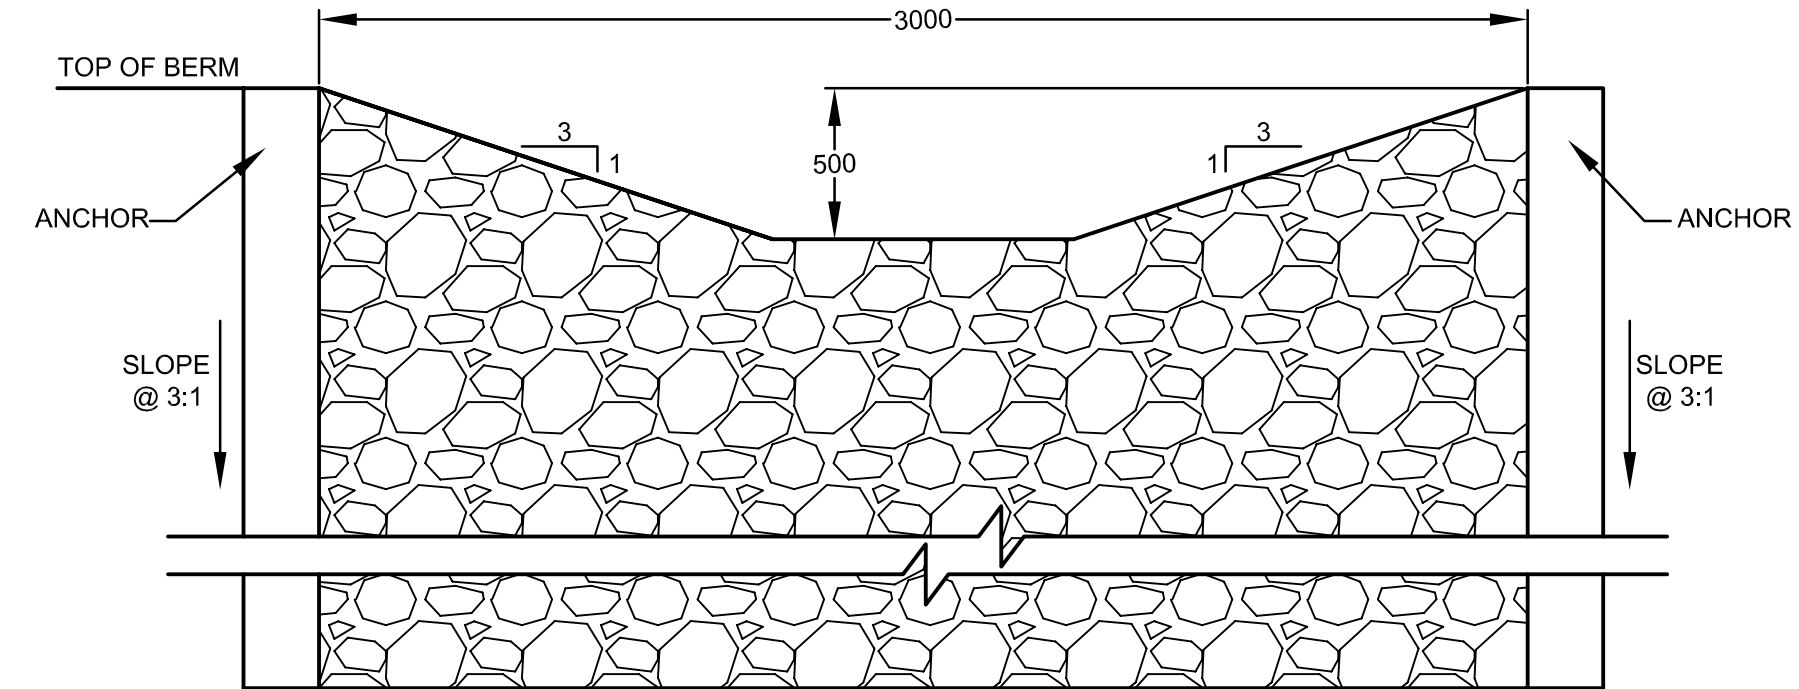


POND INLET STRUCTURE
NOT TO SCALE
DIMENSIONS IN mm

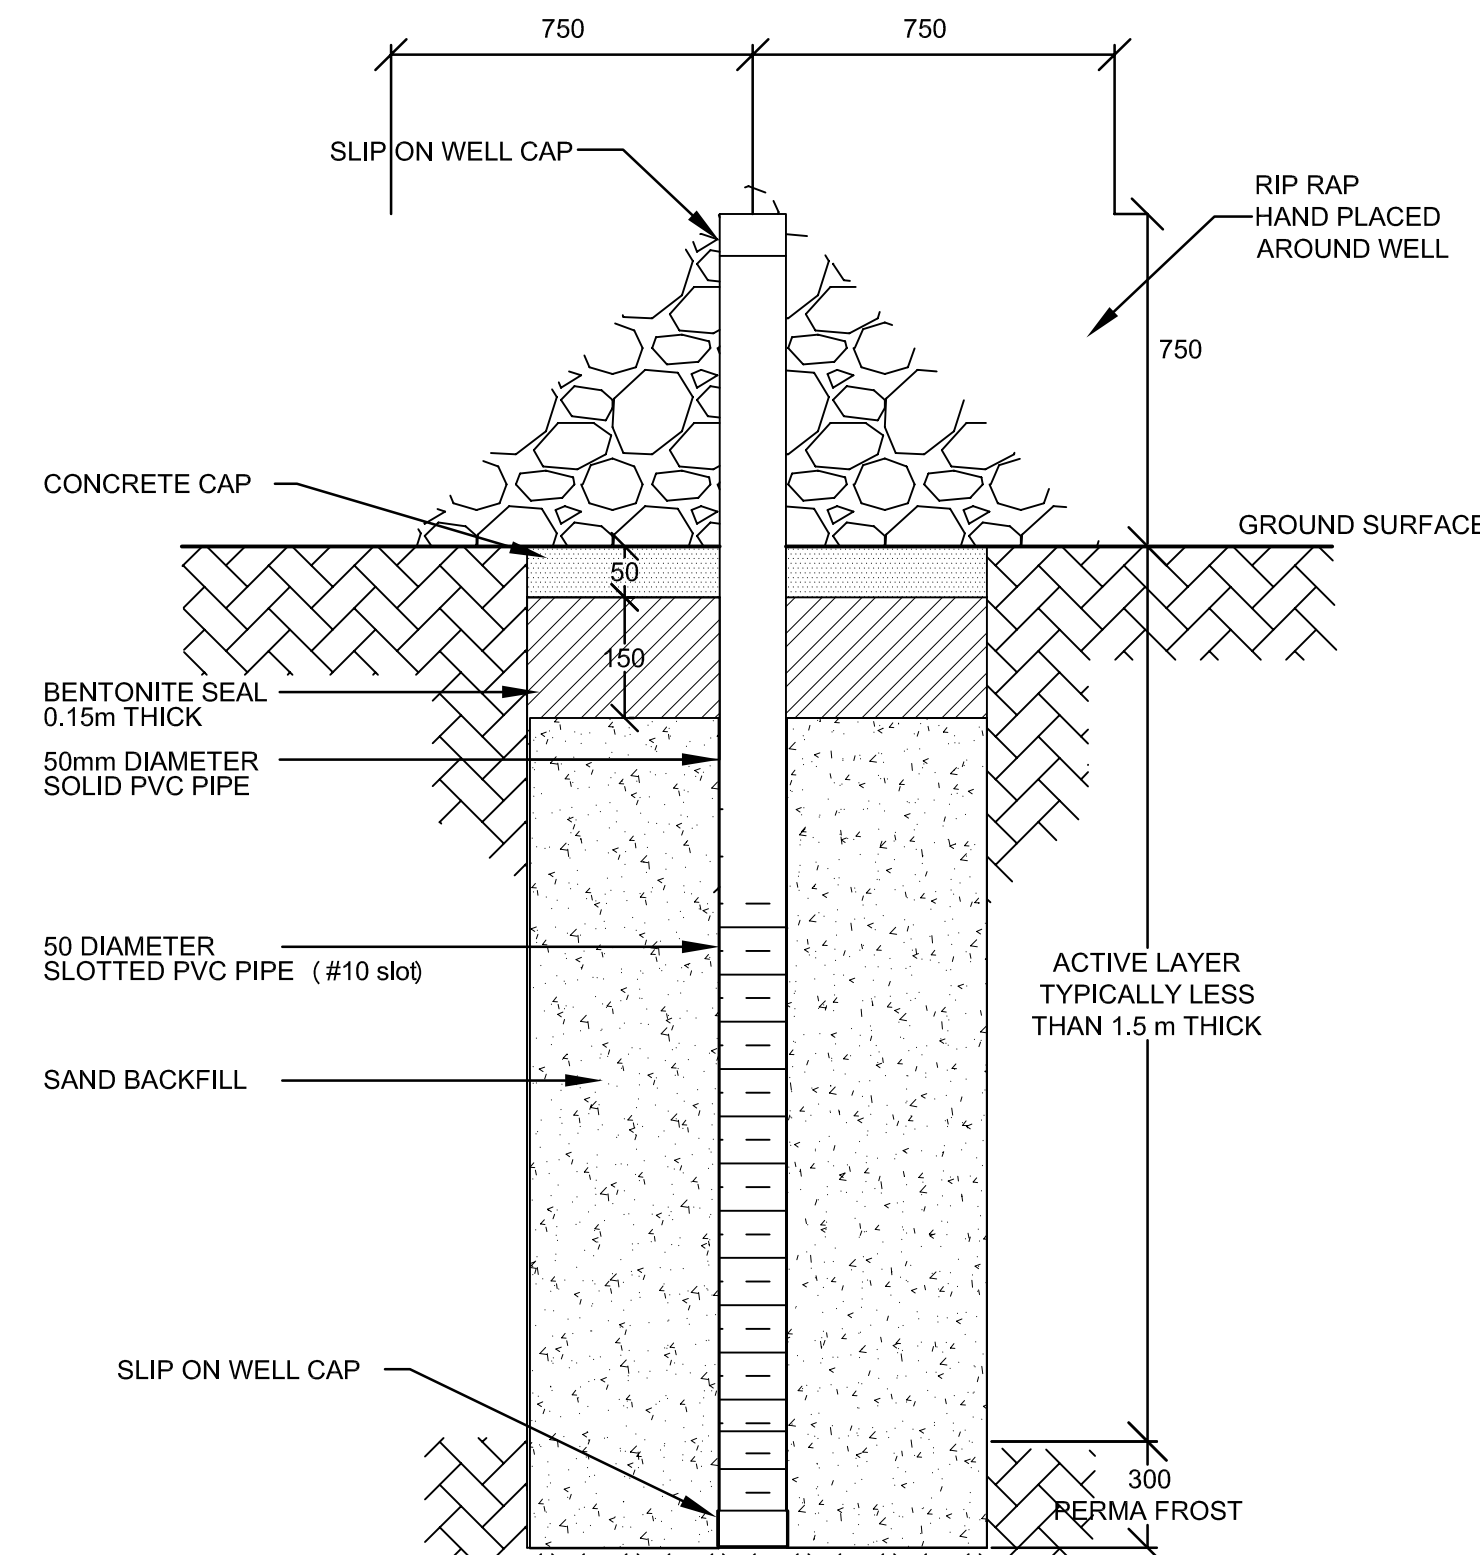

- NOTES:**
1. INSTALL WELL TO DEPTH 0.3 METERS INTO PERMAFROST.
2. EXTEND WELL 0.75 METERS ABOVE EXISTING GRADE, MARK WITH FLAGGING AND BARRICADE WITH ROCK.

ACTIVE LAYER SAMPLING WELL
NOT TO SCALE

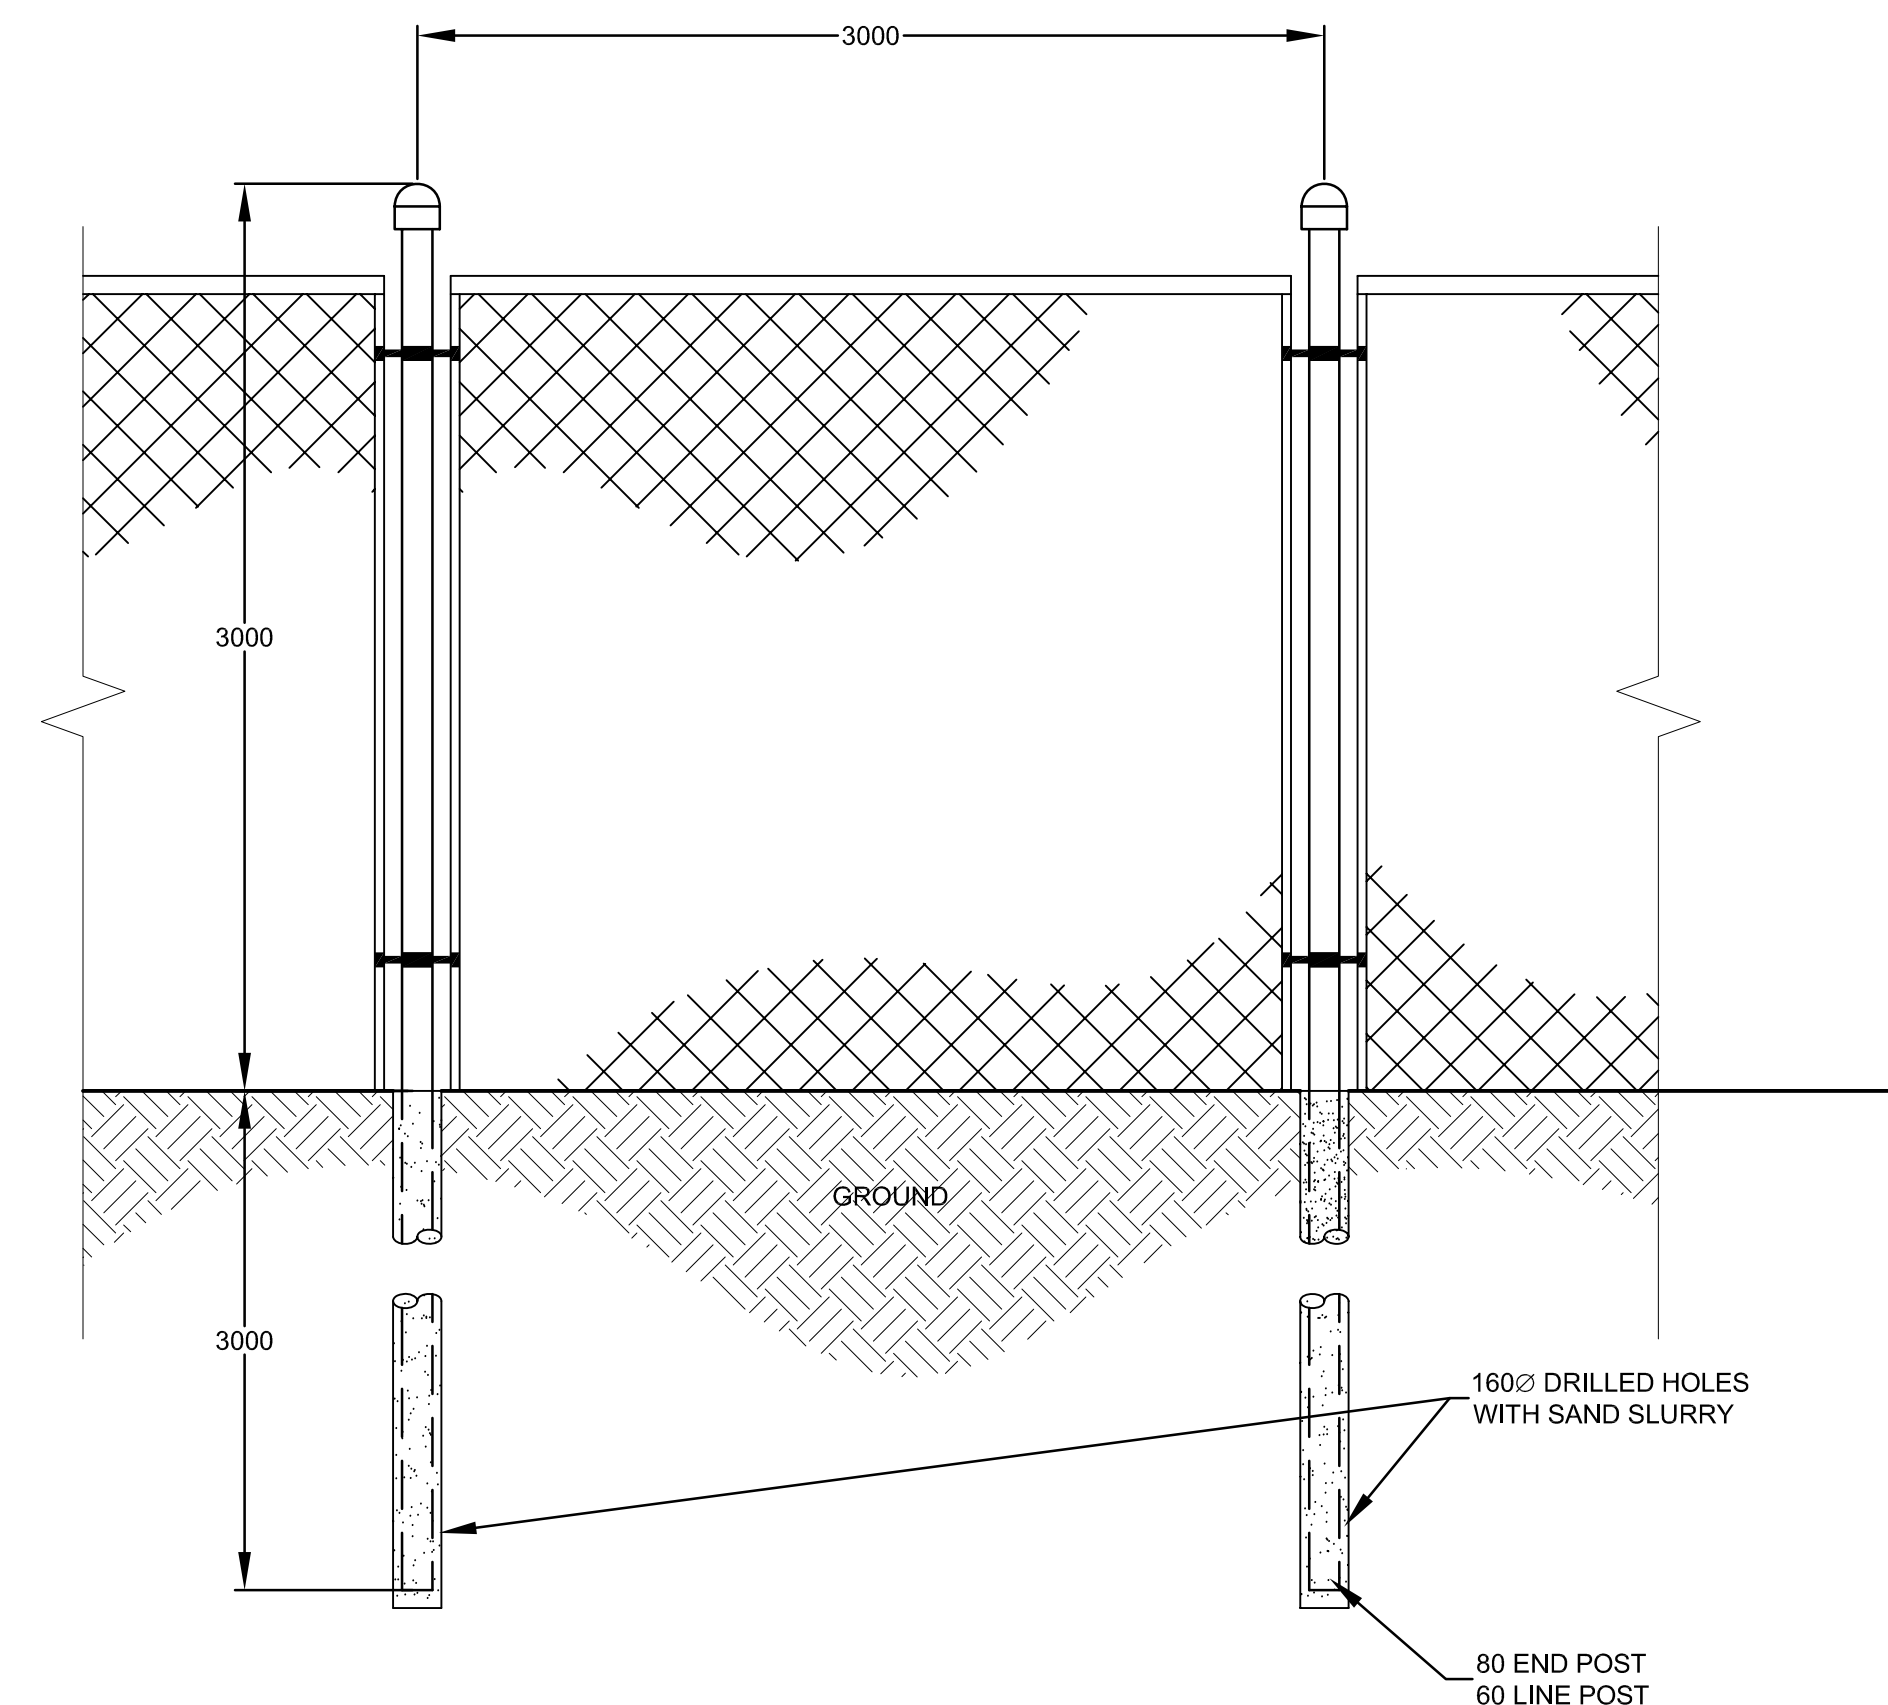

FENCE DETAIL
NOT TO SCALE

Stamp

3	04/16/2010	ISSUED FOR RECORD DRAWING BASED UPON CONTRACTOR DATA
2	08/23/2006	ISSUED FOR CONSTRUCTION
1	07/24/2006	ISSUED FOR TENDER
0	06/06/2006	PRELIMINARY
No.	Date	Description

REVISIONS



Design MM/KRJ

Drawn SB/CJD

Project Title
IQALUIT LANDFILL IMPROVEMENTS-2006

Drawing Title
CONSTRUCTION DETAILS

Scale: AS SHOWN
Project No. 93107
Drawing No. C06
Date 10.04.16
Revision 3