



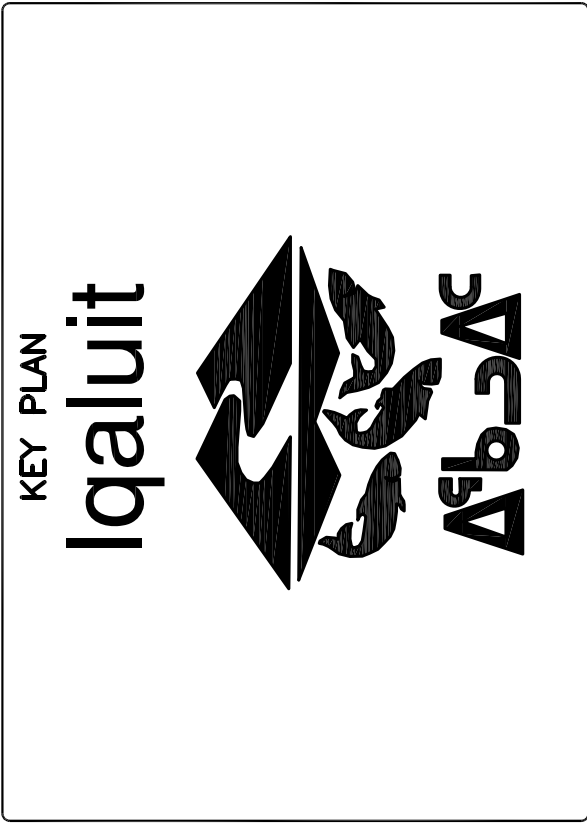


**RECORD
DRAWING**

DATE: JANUARY 31, 2011

DATE: JANUARY 31, 2011

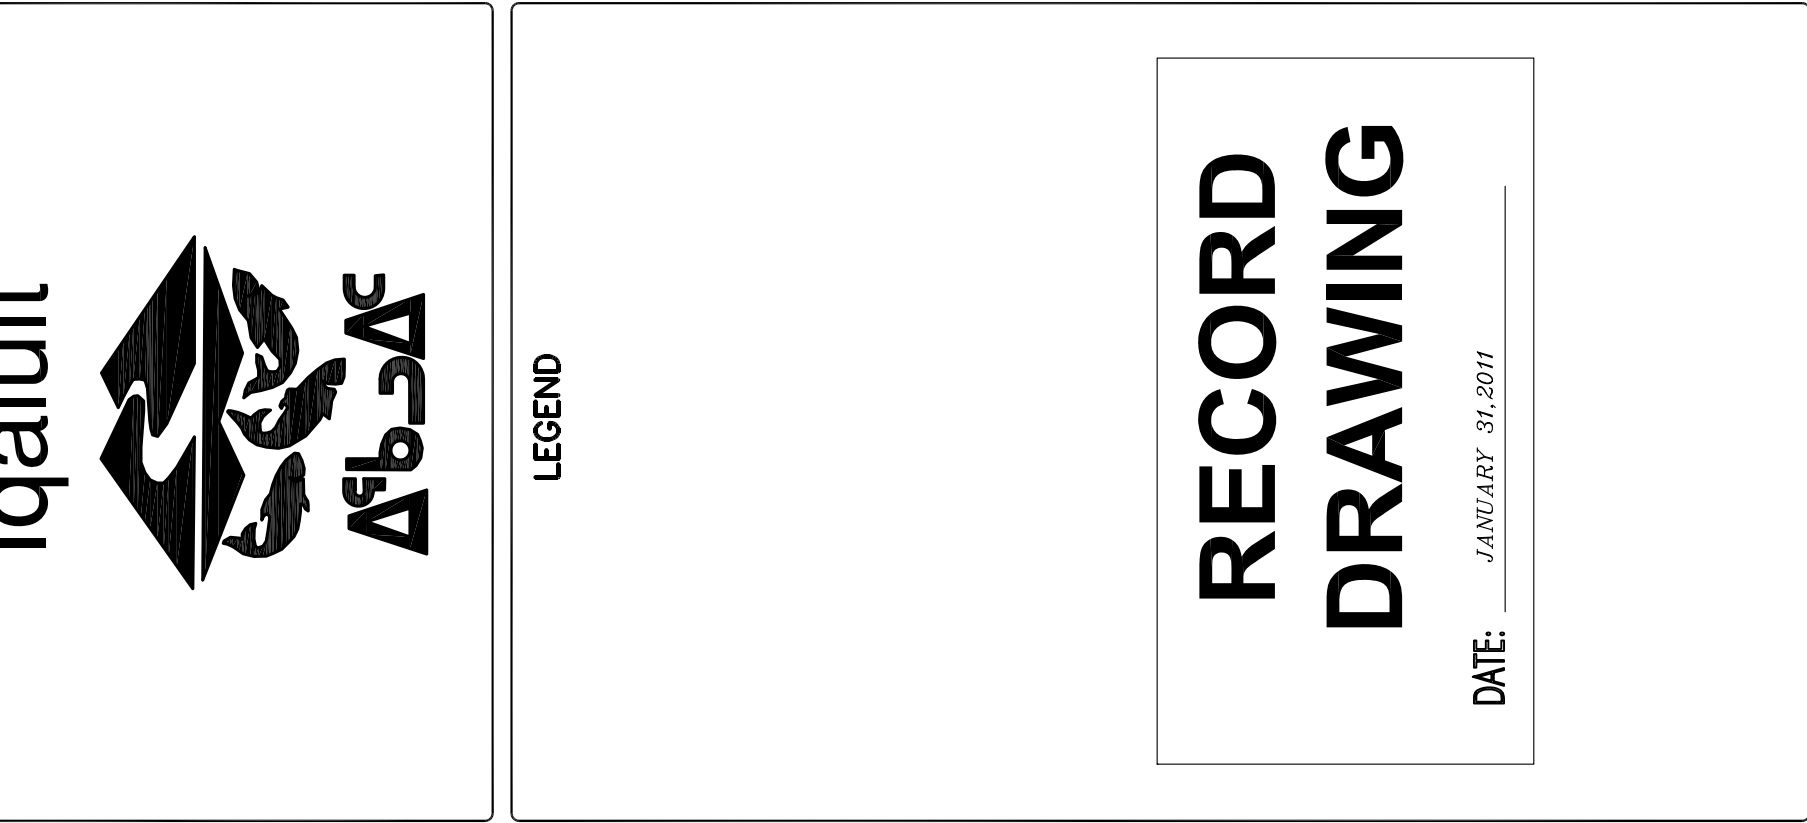

10

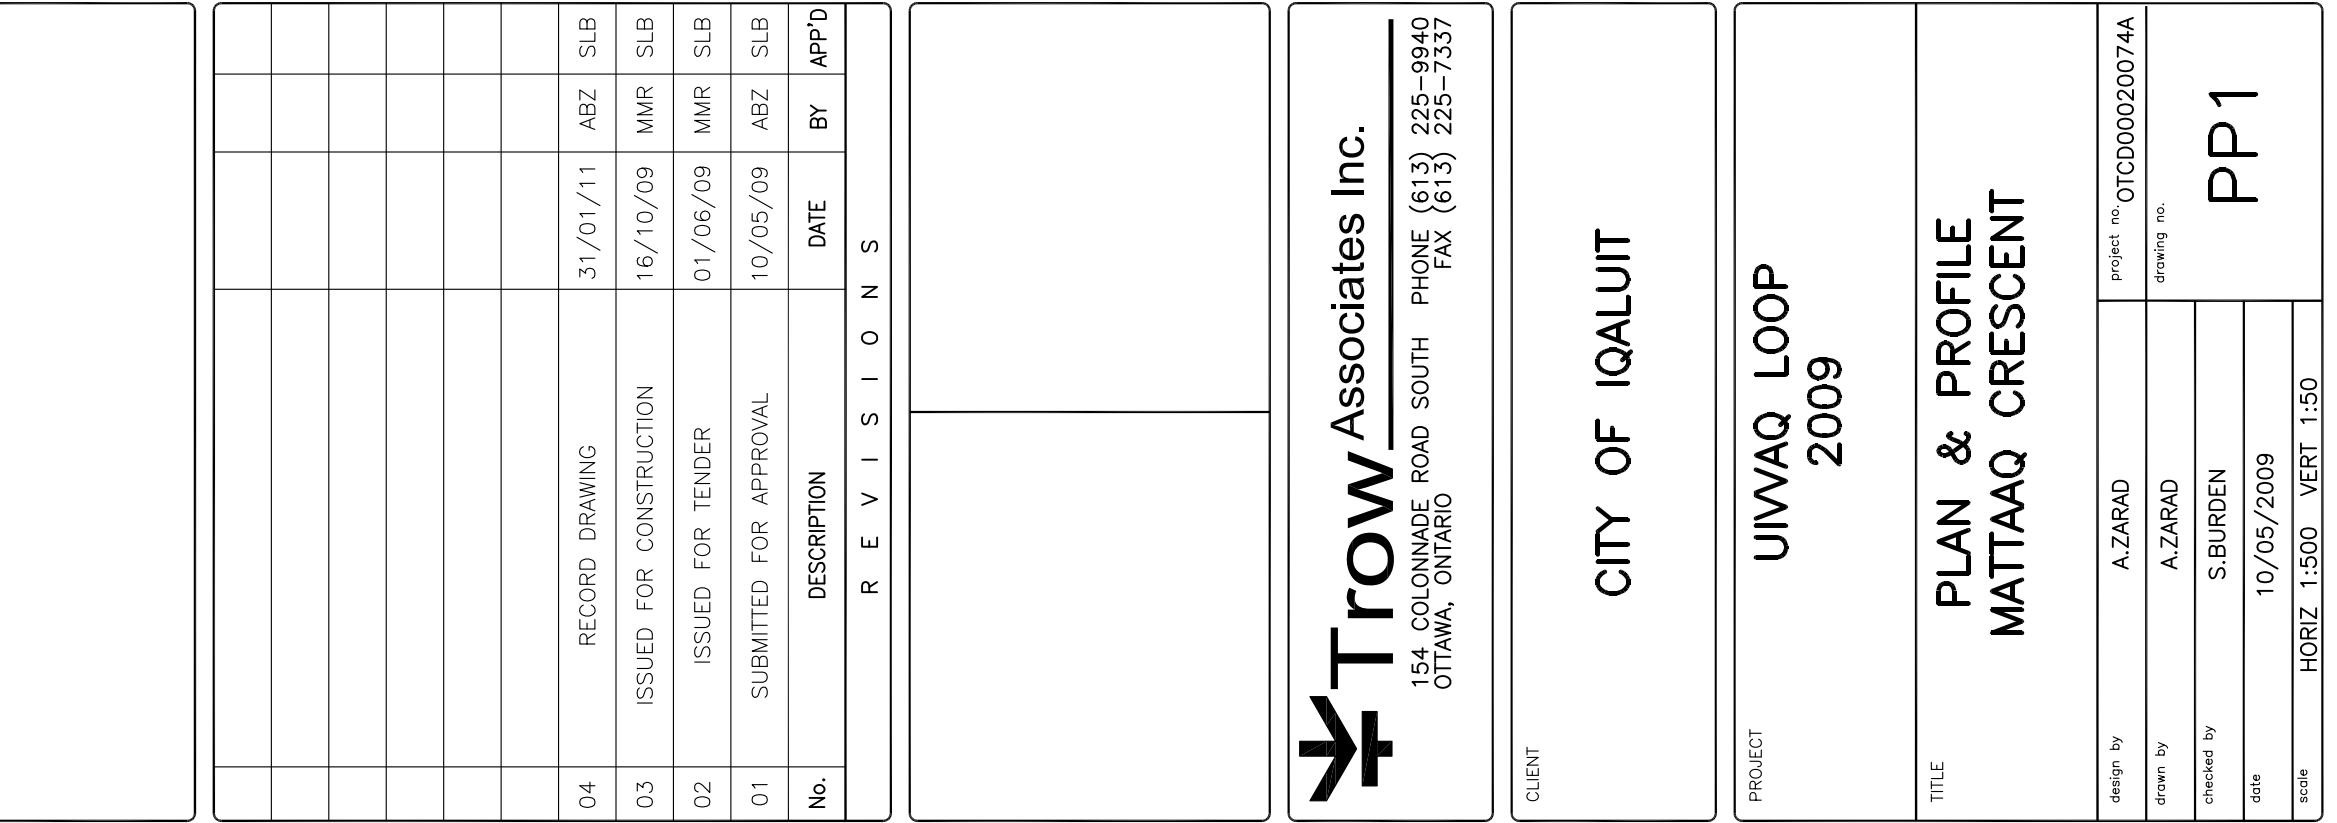[illegible]

Trow Associates Inc.
154 COLONNADE ROAD SOUTH PHONE (613) 225-9940
OTTAWA, ONTARIO FAX (613) 225-7337

CITY OF IQUALUIT

PROJECT UIWAQ LOOP 2009

TITLE

design by	A.ZARAD	drawing no.	project no.	OTC000020074A
drawn by	A.ZARAD			
checked by	S.BURDEN			
date	10/05/2009			
scale	HORIZ 1:500 VERT 1:50	PP1		