




RECORD DRAWING

DATE: JANUARY 31, 2011[illegible]

REVISIONS

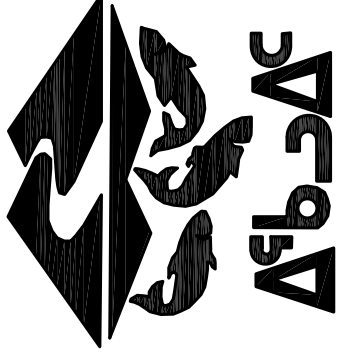

154 Colonnade Road South
Ottawa, Ont. K2E 7J5
Tel: (613) 225-9940
Fax: (613) 225-7337

154 Colonnade Road South
Ottawa, Ont. K2E 7J5

Tel: (613) 225-9940
Fax: (613) 225-7337

CIENT

CITY OF IQUALUIT

UIWAQ LOOP
2009

SITE PLAN

design by	A.ZARAD	project no.	QTCD000020074A
-----------	---------	-------------	----------------

A. ZARAD

3. **STUDENT**

3. BONDEN

05/20

19

