


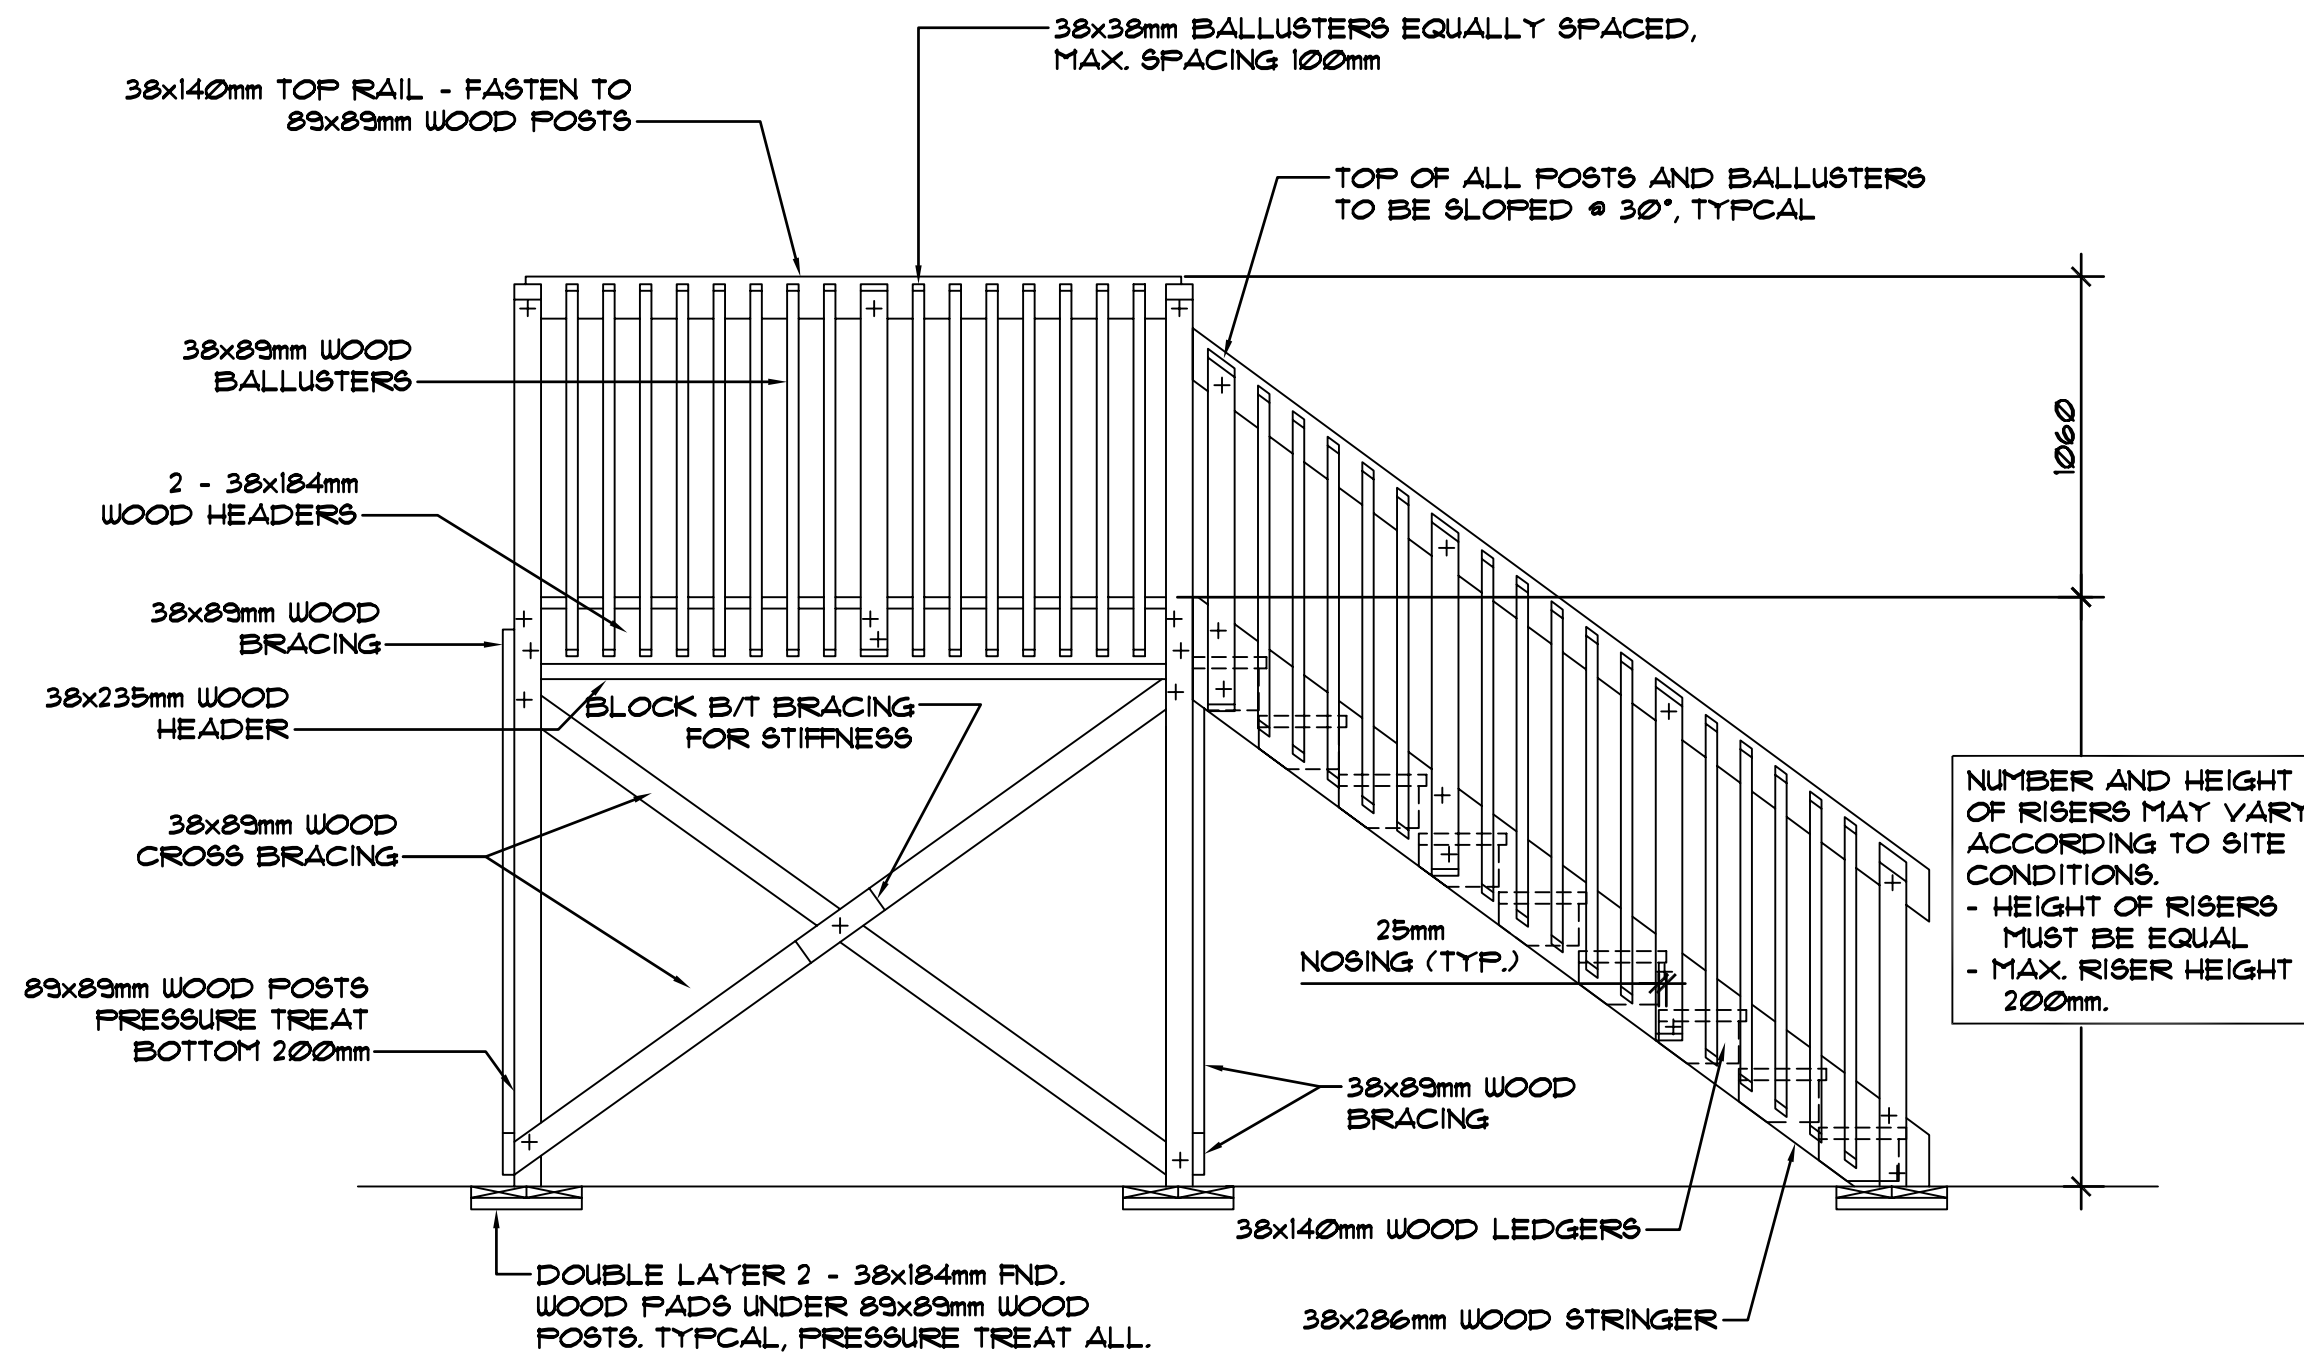

1 EXTERIOR WOOD STAIRS
A3 SCALE: 1:25

ROOM FINISH SCHEDULE



		FLOOR	BASE	WALLS		CEILING		REMARKS
ROOM NAME	RM.NO.	MATERIAL	MATERIAL	MATERIAL	FINISH	MATERIAL	FINISH	
OPEN FLOOR AREA	100	NSRF	VINYL COVE	GYPSPUM	PTD	EXISTING	—	PAINT EXISTING WALLS & CEILING TO MATCH NEW
NEW OFFICE	101	RF	VINYL COVE	GYPSPUM	PTD	GYPSPUM	PTD	
EXISTING OFFICE & LAB.	102	NSRF	VINYL COVE	GYPSPUM	PTD	EXISTING	—	PAINT EXISTING WALLS & CEILING TO MATCH NEW
EXISTING WASHROOM	103	NSRF	VINYL COVE	GYPSPUM	PTD	EXISTING	—	PAINT EXISTING WALLS & CEILING TO MATCH NEW
NEW CHLORINE ROOM	104	NSRF	VINYL COVE	PLYWOOD /CONCRETE	PTD	EXISTING	—	PAINT EXISTING WALLS & CEILING TO MATCH NEW
NEW CHEMICAL ROOM	105	RF	VINYL COVE	PLYWOOD	PTD	EXISTING	—	PAINT EXISTING WALLS & CEILING TO MATCH NEW
NEW CHEMICAL ROOM	106	RF	VINYL COVE	PLYWOOD	PTD	EXISTING	—	PAINT EXISTING WALLS & CEILING TO MATCH NEW
NEW FILTER AREA	107	CONC. PTD.	VINYL COVE	MRGWB	PTD	MRGWB	PTD	VARIES
EXISTING PUMP FLOOR AREA	108	SEE NOTE 1	VINYL COVE	SEE NOTE 1	PTD	EXISTING	PTD	EXISTING

DOOR SCHEDULE

										DOOR				FRAME				FIRE		HARD
DOOR				SIZE	HEIGHT	L	CONST.	FACE	FINISH	TYPE	NUMBER	GLASS	MAT.	FINISH	TYPE	RAT'S	REMARKS	WARE		
ROOM NAME	RM.NO.	MARK	WIDTH	HEIGHT	2											TABLE		GROUP		
EXTERIOR /OPEN FLOOR AREA	---	100	2440	2438	2	HMI	M	PTD	1	GWG	HMI	PTD	1				6mm TEMPERED GLASS			
EXTERIOR/CHLORINE ROOM	---	101	1220	2032	1	HMI	M	PTD	2	GWG	HMI	PTD	2							
NEW OFFICE	101	102	812	2032	1	SCW	M	S&V	3		HM	PTD	3				6mm TEMPERED GLASS			
OPEN FLOOR AREA/FILTER AREA	100	103	914	2032	1	HM	M	PTD	4	GWG	HM	PTD	4							
EXTERIOR /OPEN FLOOR AREA	---	104	1525	2032	2	HMI	M	PTD	5	GWG	HMI	PTD	5				6mm TEMPERED GLASS			
EXTERIOR	---	105	914	2032	1	HMI	M	PTD	6	-	HMI	PTD	6							
EXTERIOR	---	106	914	2032	1	HMI	M	PTD	6	-	HMI	PTD	6							

NOTES:

1. PATCH AND REPAIR FLOOR TO RECEIVE EPOXY PAINT. PATCH AND REPAIR CONCRETE WALLS TO RECEIVE PAINT.

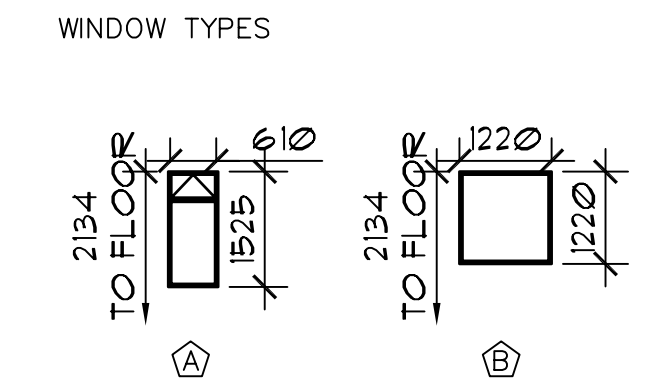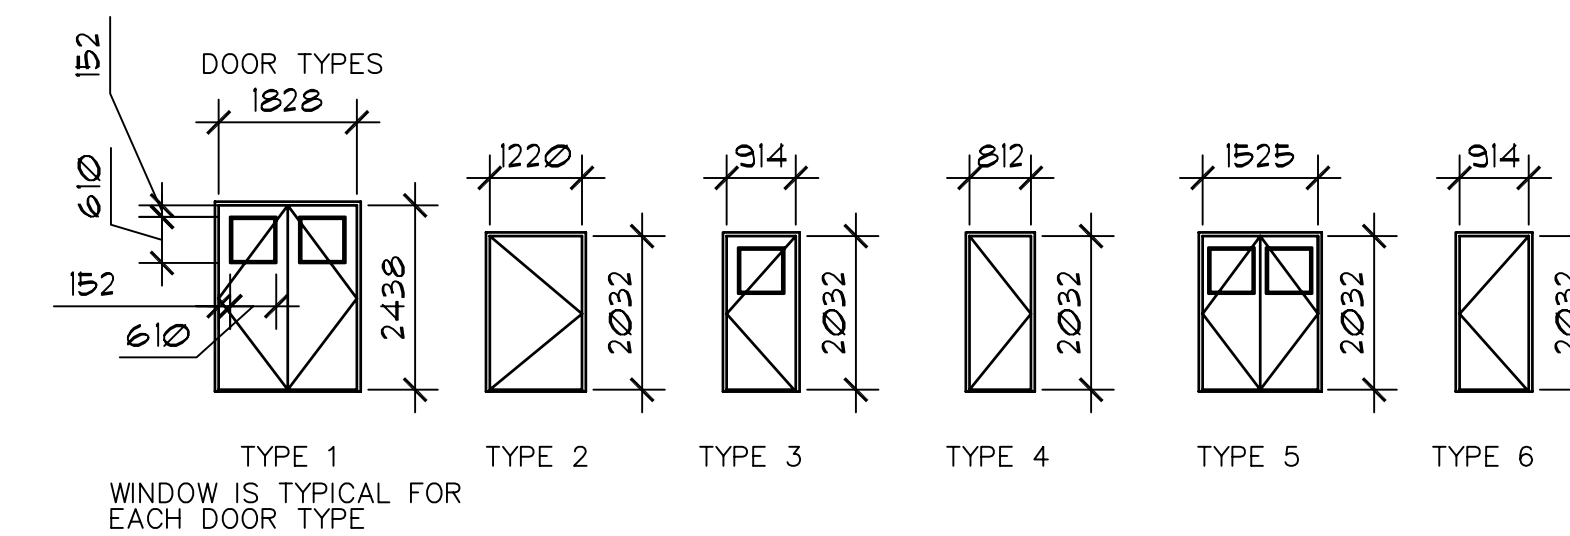

LIST OF FINISHES;

STEEL DOORS AND FRAMES: TO MATCH SICO 4145-63

WALLS AND CEILINGS: TO MATCH SICO 4151-11

EXTERIOR GRADE PLYWOOD: TO MATCH SICO 4151-11

FLOORING:

RESILIENT FLOORING: FORBO MARMOLEUM REAL 3160

NON-SLIP RESILIENT FLOORING: ALTRO DESIGNER SERIES DESERT D25522

RESILEINT BASE: JOHNSONITE #85 BURGENDY

[illegible]