
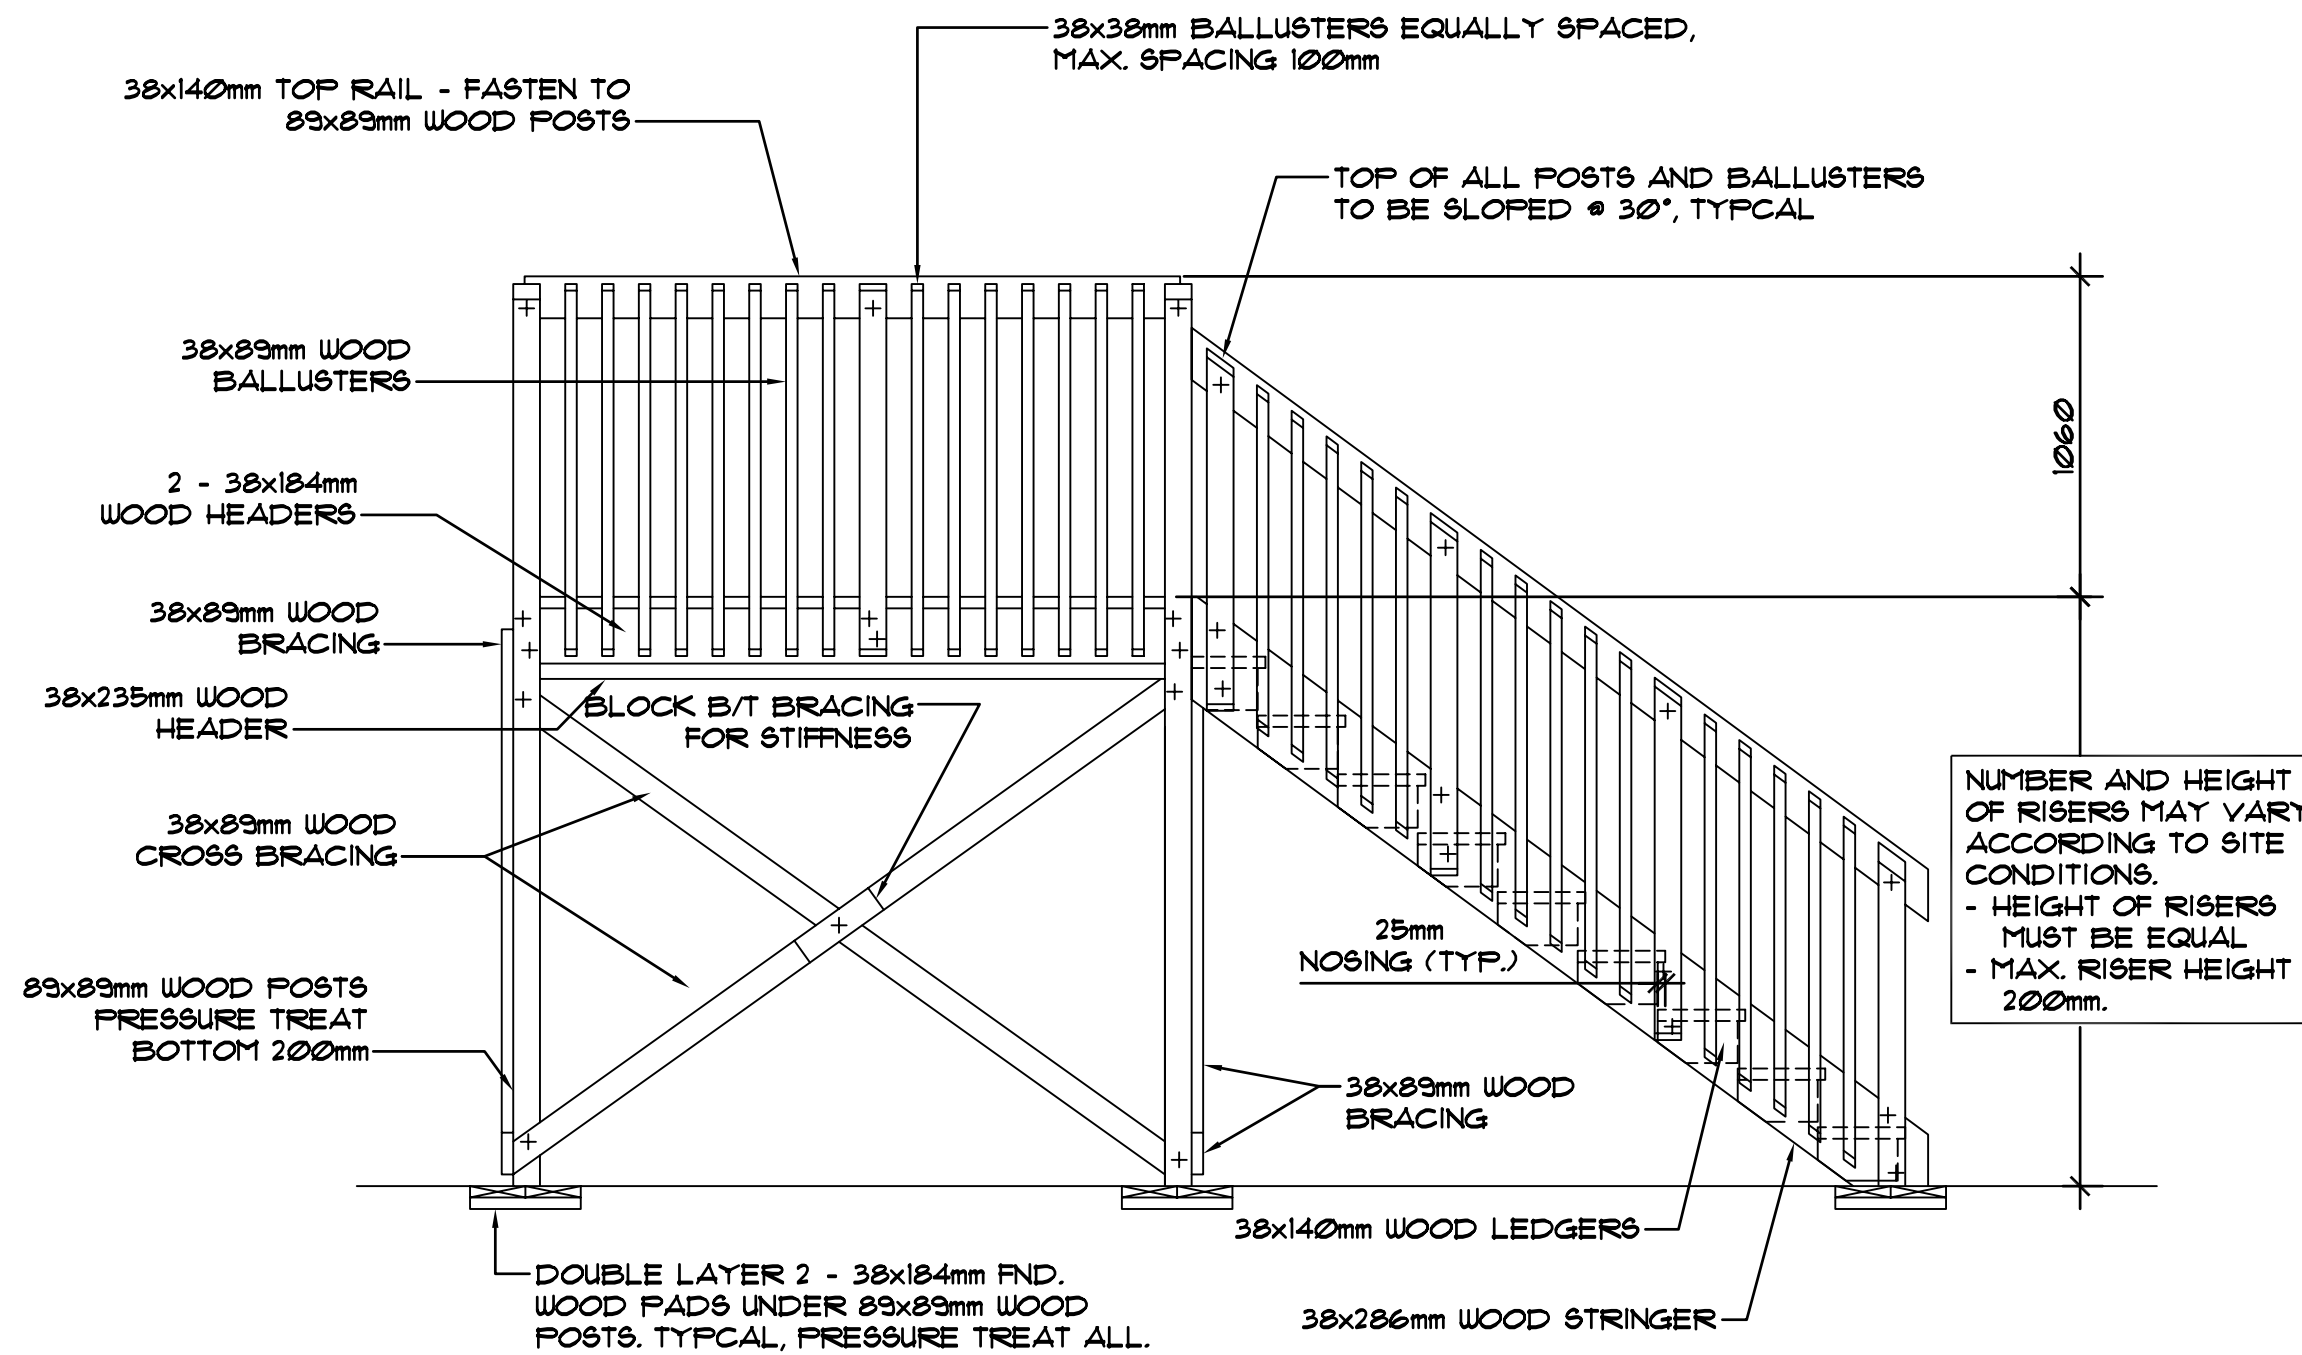


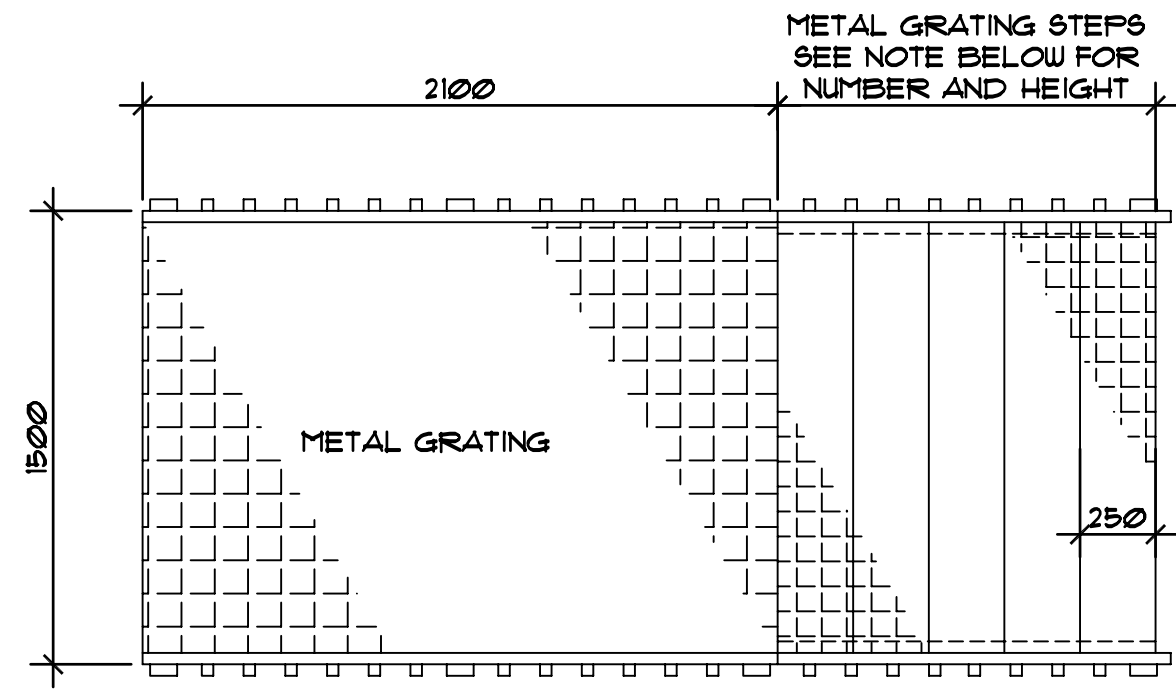

1
A3 EXTERIOR WOOD STAIRS
SCALE: 1:25


ROOM FINISH SCHEDULE

ROOM NAME	RM.NO.	FLOOR MATERIAL	BASE MATERIAL	WALLS MATERIAL	FINISH	CEILING MATERIAL	FINISH	HEIGHT	REMARKS
OPEN FLOOR AREA	100	NSRF	VINYL COVE	GYP SUM	PTD	EXISTING	—	EXISTING	PAINT EXISTING WALLS & CEILING TO MATCH NEW
NEW OFFICE	101	RF	VINYL COVE	GYP SUM	PTD	GYP SUM	PTD	2438	
EXISTING OFFICE & LAB.	102	NSRF	VINYL COVE	GYP SUM	PTD	EXISTING	—	EXISTING	PAINT EXISTING WALLS & CEILING TO MATCH NEW
EXISTING WASHROOM	103	NSRF	VINYL COVE	GYP SUM	PTD	EXISTING	—	EXISTING	PAINT EXISTING WALLS & CEILING TO MATCH NEW
NEW CHLORINE ROOM	104	NSRF	VINYL COVE	PLYWOOD /CONCRETE	PTD	EXISTING	—	EXISTING	PAINT EXISTING WALLS & CEILING TO MATCH NEW
NEW CHEMICAL ROOM	105	RF	VINYL COVE	PLYWOOD	PTD	EXISTING	—	EXISTING	PAINT EXISTING WALLS & CEILING TO MATCH NEW
NEW CHEMICAL ROOM	106	RF	VINYL COVE	PLYWOOD	PTD	EXISTING	—	EXISTING	PAINT EXISTING WALLS & CEILING TO MATCH NEW
NEW FILTER AREA	107	CONC. PTD.	VINYL COVE	MRCWB	PTD	MRCWB	PTD	VARIES	
EXISTING PUMP FLOOR AREA	108	SEE NOTE 1	VINYL COVE	SEE NOTE 1	PTD	EXISTING	PTD	EXISTING	PAINT EXISTING WALLS & CEILING TO MATCH NEW

DOOR SCHEDULE

DOOR ROOM NAME	RM.NO.	MARK	DOOR SIZE WIDTH	HEIGHT	E	CONST.	FACE MAT.	FINISH	NUMBER	GLASS	FRAME MAT.	FINISH	TYPE	FIRE RAT'S NUMBER	REMARKS	HARD WARE GROUP
EXTERIOR/OPEN FLOOR AREA	---	100	2440	2438	2	HMI	M	PTD	1	GWG	HMI	PTD	1		6mm TEMPERED GLASS	
EXTERIOR/CHLORINE ROOM	---	101	1220	2032	1	HMI	M	PTD	2	GWG	HMI	PTD	2			
NEW OFFICE	101	102	812	2032	1	SCW	M	S&V	3		HM	PTD	3		6mm TEMPERED GLASS	
OPEN FLOOR AREA/FILTER AREA	100	103	914	2032	1	HM	M	PTD	4	GWG	HM	PTD	4			
EXTERIOR/OPEN FLOOR AREA	---	104	1525	2032	2	HMI	M	PTD	5	GWG	HMI	PTD	5		6mm TEMPERED GLASS	
EXTERIOR	---	105	914	2032	1	HMI	M	PTD	6	—	HMI	PTD	6			
EXTERIOR	---	106	914	2032	1	HMI	M	PTD	6	—	HMI	PTD	6			

NOTES:
1. PATCH AND REPAIR FLOOR TO RECEIVE EPOXY PAINT. PATCH AND REPAIR CONCRETE WALLS TO RECEIVE PAINT.

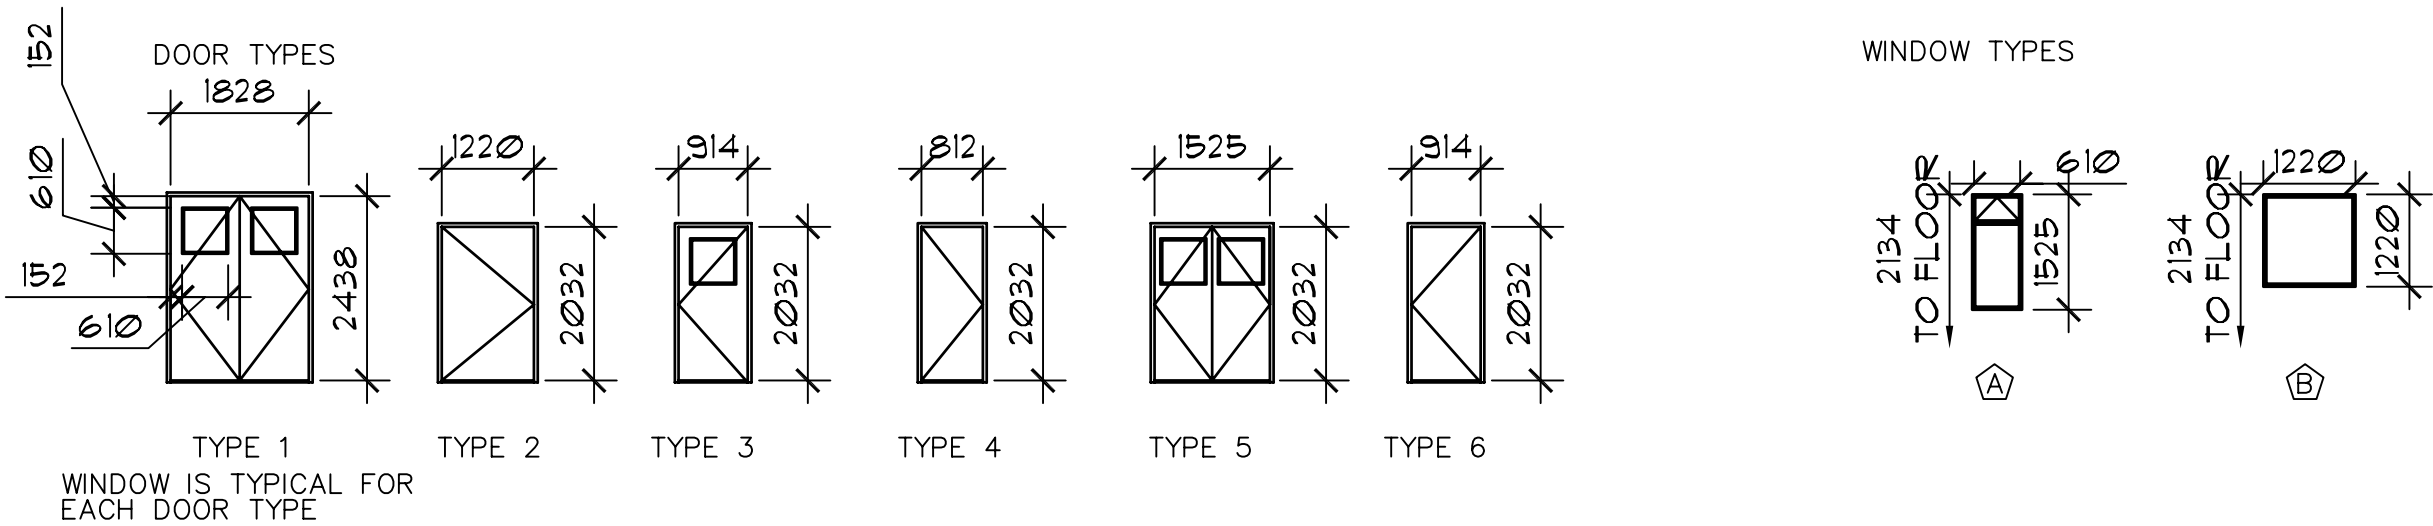

LIST OF FINISHES;

STEEL DOORS AND FRAMES: TO MATCH SICO 4145-63

WALLS AND CEILINGS: TO MATCH SICO 4151-11

EXTERIOR GRADE PLYWOOD: TO MATCH SICO 4151-11

FLOORING:

RESILIENT FLOORING: FORBO MARMOLEUM REAL 3160

NON-SLIP RESILIENT FLOORING: ALTRO DESIGNER SERIES DESERT D25522

RESILEINT BASE: JOHNSONITE #85 BURGENDY

LIVINGSTONE
Architect
P.O. BOX 1186 IQUALUIT, NU X0A 0H0
PH (867) 878-4180 FAX (867) 878-3891

				Company Permit	Engineer Seal	DISCIPLINE		 CITY of IQUALUIT, Nunavut	CITY OF IQUALUIT		EARTHTECH Earth Tech (Canada) Inc. BRANCH									
2		RECORD DRAWING		23/04/04		RECORD DRAWING INFORMATION CONTAINED IN THESE DRAWINGS IS AS SUPPLIED BY: NINETY NORTH CONSTRUCTION & DEVELOPMENT LTD. THE COMPLETENESS AND ACCURACY OF THIS RECORD DRAWING IS NOT GUARANTEED. INFORMATION SHOULD BE VERIFIED AT THE ACTUAL LOCATION BEFORE USE.			ROOM & DOOR SCHEDULES		IQUALUIT WATER TREATMENT PLANT		DRAWN BY: G.R.		SCALE: AS NOTED		DATE: FEB. 03, 2003		SHEET NO. A3	
1		ISSUED FOR CONSTRUCTION		22/04/03									CHECKED BY: A.L.							
A		ISSUED FOIR FINAL REVIEW		FEB.3/03											CADD SYSTEM AutoCAD		DWG NO. 55524-A3		REV. 1	
NO.		REVISION		DATE		INITIAL														