
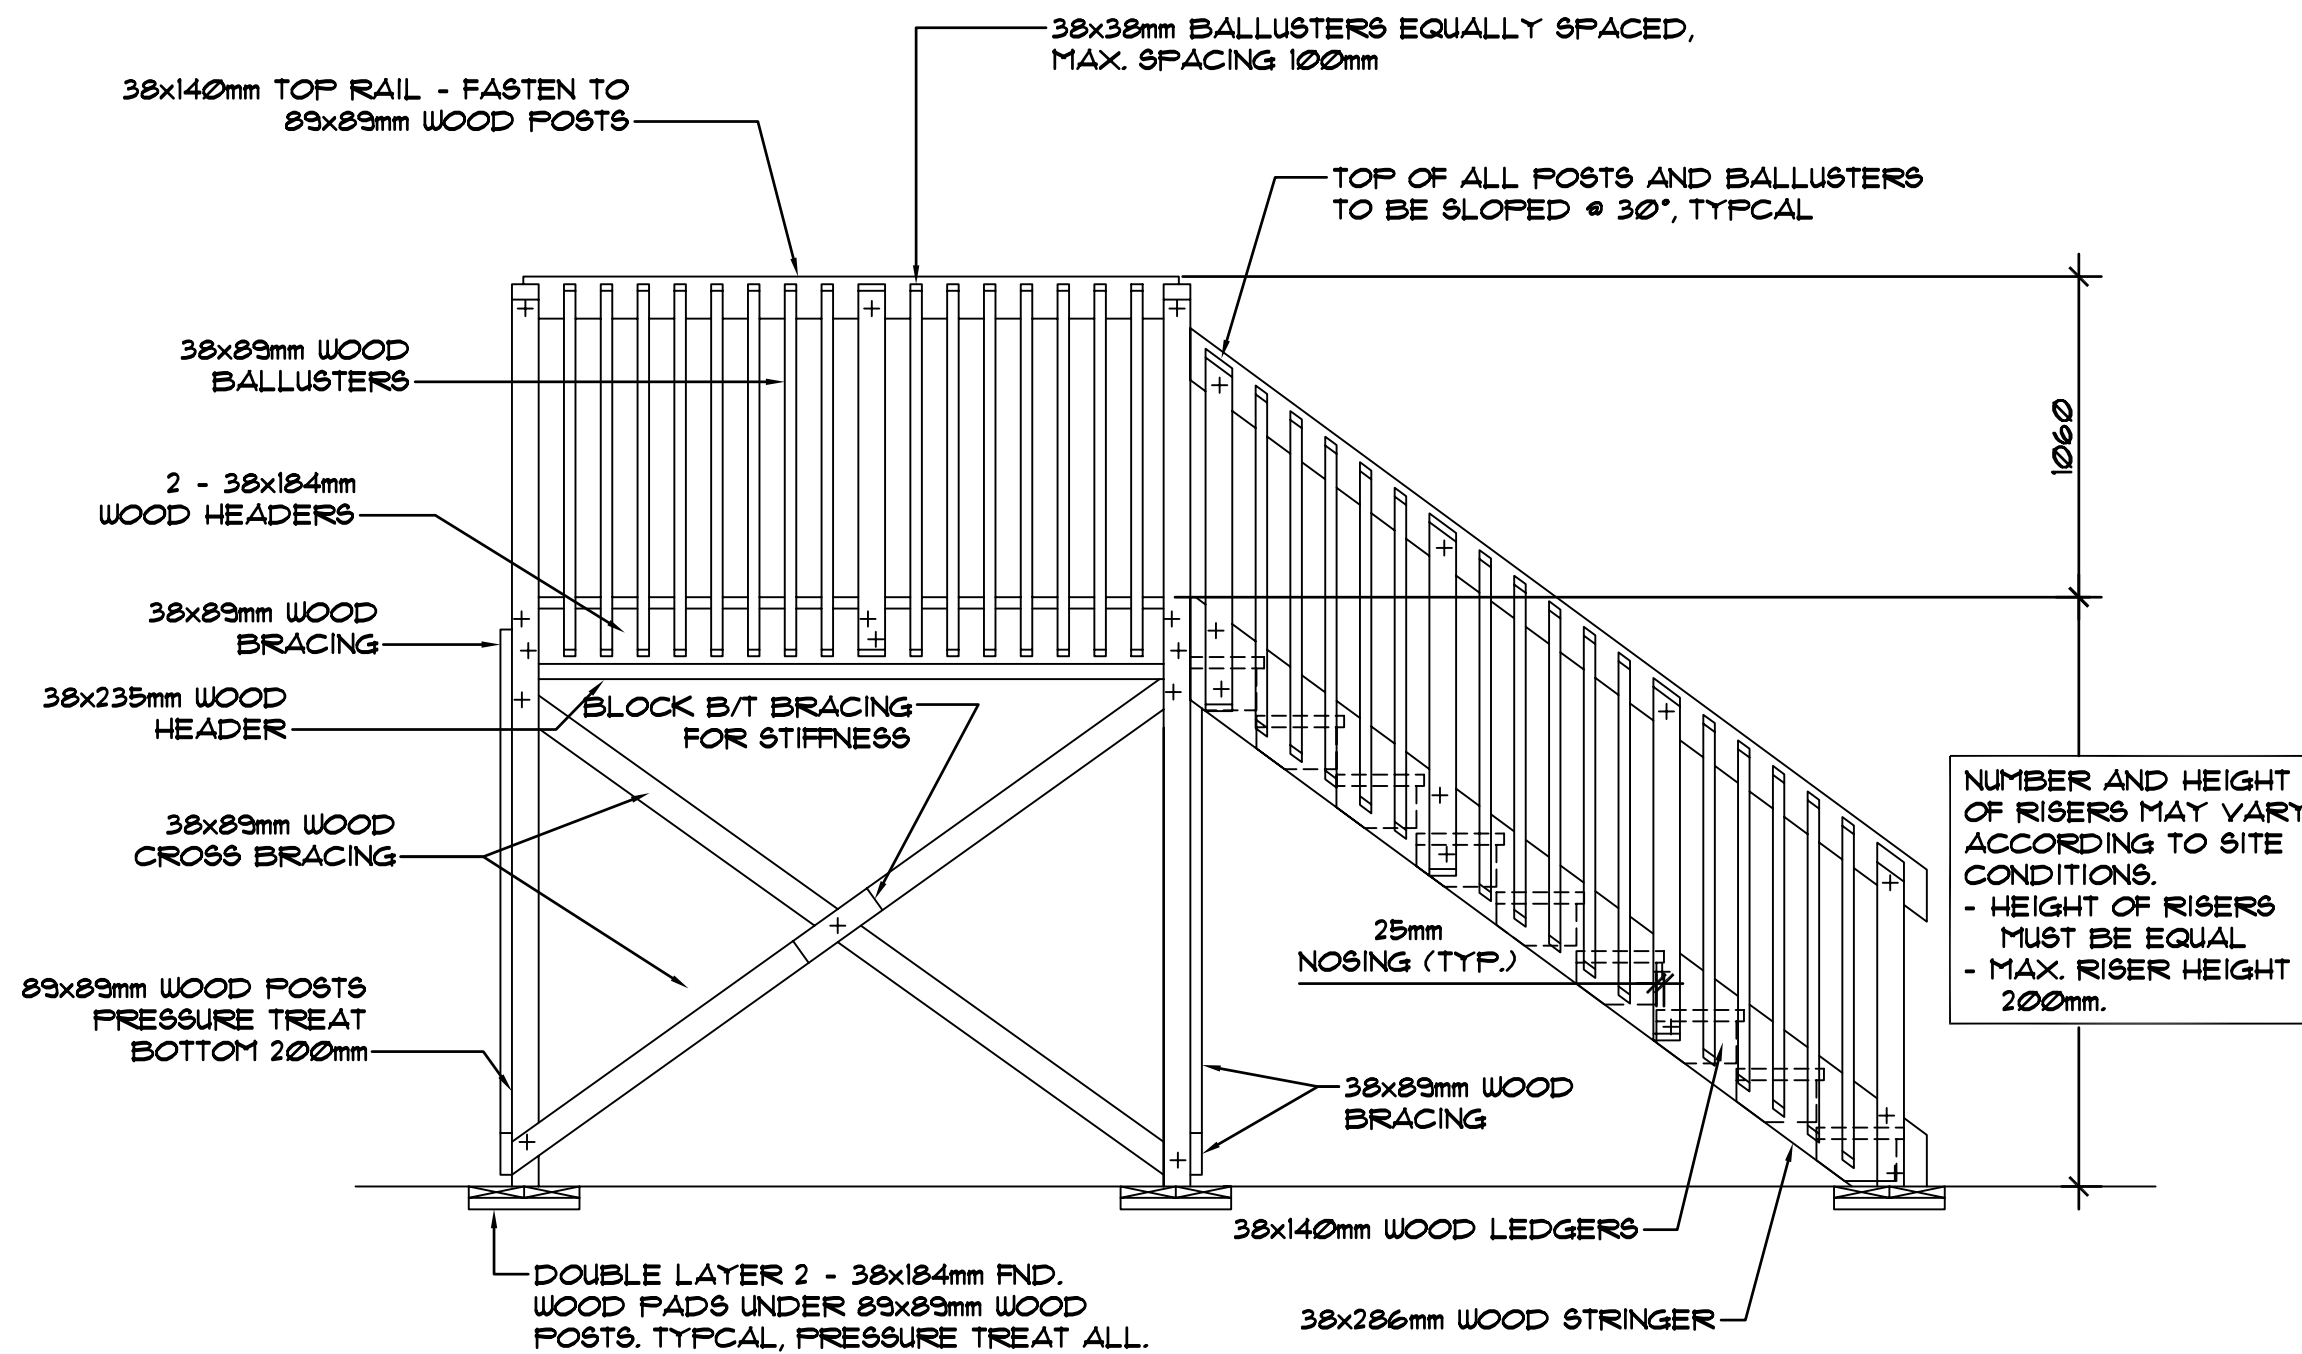


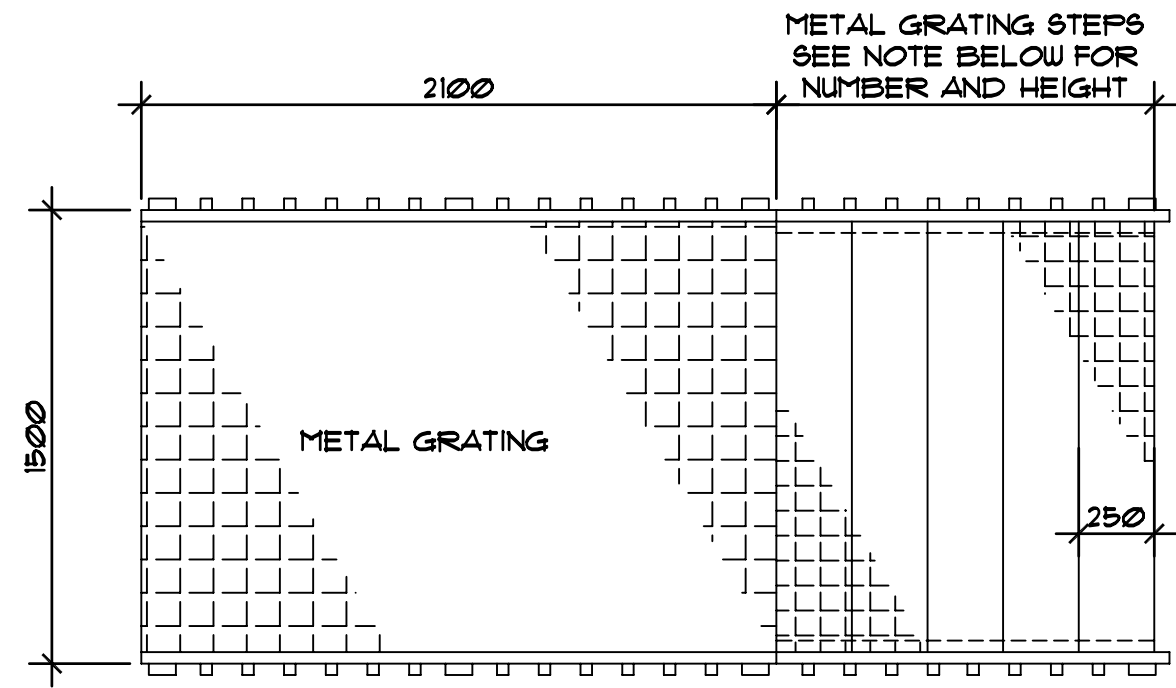

1
A3 EXTERIOR WOOD STAIRS
SCALE: 1:25


ROOM FINISH SCHEDULE

ROOM NAME	RM.NO.	FLOOR MATERIAL	BASE MATERIAL	WALLS MATERIAL	FINISH	CEILING MATERIAL	FINISH	HEIGHT	REMARKS
OPEN FLOOR AREA	100	NSRF	VINYL COVE	GYP SUM	PTD	EXISTING	—	EXISTING	PAINT EXISTING WALLS & CEILING TO MATCH NEW
NEW OFFICE	101	RF	VINYL COVE	GYP SUM	PTD	GYP SUM	PTD	2438	
EXISTING OFFICE & LAB.	102	NSRF	VINYL COVE	GYP SUM	PTD	EXISTING	—	EXISTING	PAINT EXISTING WALLS & CEILING TO MATCH NEW
EXISTING WASHROOM	103	NSRF	VINYL COVE	GYP SUM	PTD	EXISTING	—	EXISTING	PAINT EXISTING WALLS & CEILING TO MATCH NEW
NEW CHLORINE ROOM	104	NSRF	VINYL COVE	PLYWOOD/CONCRETE	PTD	EXISTING	—	EXISTING	PAINT EXISTING WALLS & CEILING TO MATCH NEW
NEW CHEMICAL ROOM	105	RF	VINYL COVE	PLYWOOD	PTD	EXISTING	—	EXISTING	PAINT EXISTING WALLS & CEILING TO MATCH NEW
NEW CHEMICAL ROOM	106	RF	VINYL COVE	PLYWOOD	PTD	EXISTING	—	EXISTING	PAINT EXISTING WALLS & CEILING TO MATCH NEW
NEW FILTER AREA	107	CONC. PTD	VINYL COVE	MRGWB	PTD	MRGWB	PTD	VARIES	
EXISTING PUMP FLOOR AREA	108	SEE NOTE 1	VINYL COVE	SEE NOTE 1	PTD	EXISTING	PTD	EXISTING	PAINT EXISTING WALLS & CEILING TO MATCH NEW

DOOR SCHEDULE

DOOR ROOM NAME	RM.NO.	MARK	DOOR SIZE WIDTH HEIGHT	FACE	CONST.	MAT.	FINISH	TYPE	GLASS	FRAME	TYPE	FIRE RAT'S	REMARKS	HARD WARE GROUP
EXTERIOR/OPEN FLOOR AREA	---	100	2440 2438	2	HMI	M	PTD	1	GWG	HMI	PTD	1	6mm TEMPERED GLASS	
EXTERIOR/CHLORINE ROOM	---	101	1220 2032	1	HMI	M	PTD	2	GWG	HMI	PTD	2		
NEW OFFICE	101	102	812 2032	1	SCW	M	S&V	3		HM	PTD	3	6mm TEMPERED GLASS	
OPEN FLOOR AREA/FILTER AREA	100	103	914 2032	1	HM	M	PTD	4	GWG	HM	PTD	4		
EXTERIOR/OPEN FLOOR AREA	---	104	1525 2032	2	HMI	M	PTD	5	GWG	HMI	PTD	5	6mm TEMPERED GLASS	
EXTERIOR	---	105	914 2032	1	HMI	M	PTD	6	—	HMI	PTD	6		
EXTERIOR	---	106	914 2032	1	HMI	M	PTD	6	—	HMI	PTD	6		

NOTES:
1. PATCH AND REPAIR FLOOR TO RECEIVE EPOXY PAINT. PATCH AND REPAIR CONCRETE WALLS TO RECEIVE PAINT.

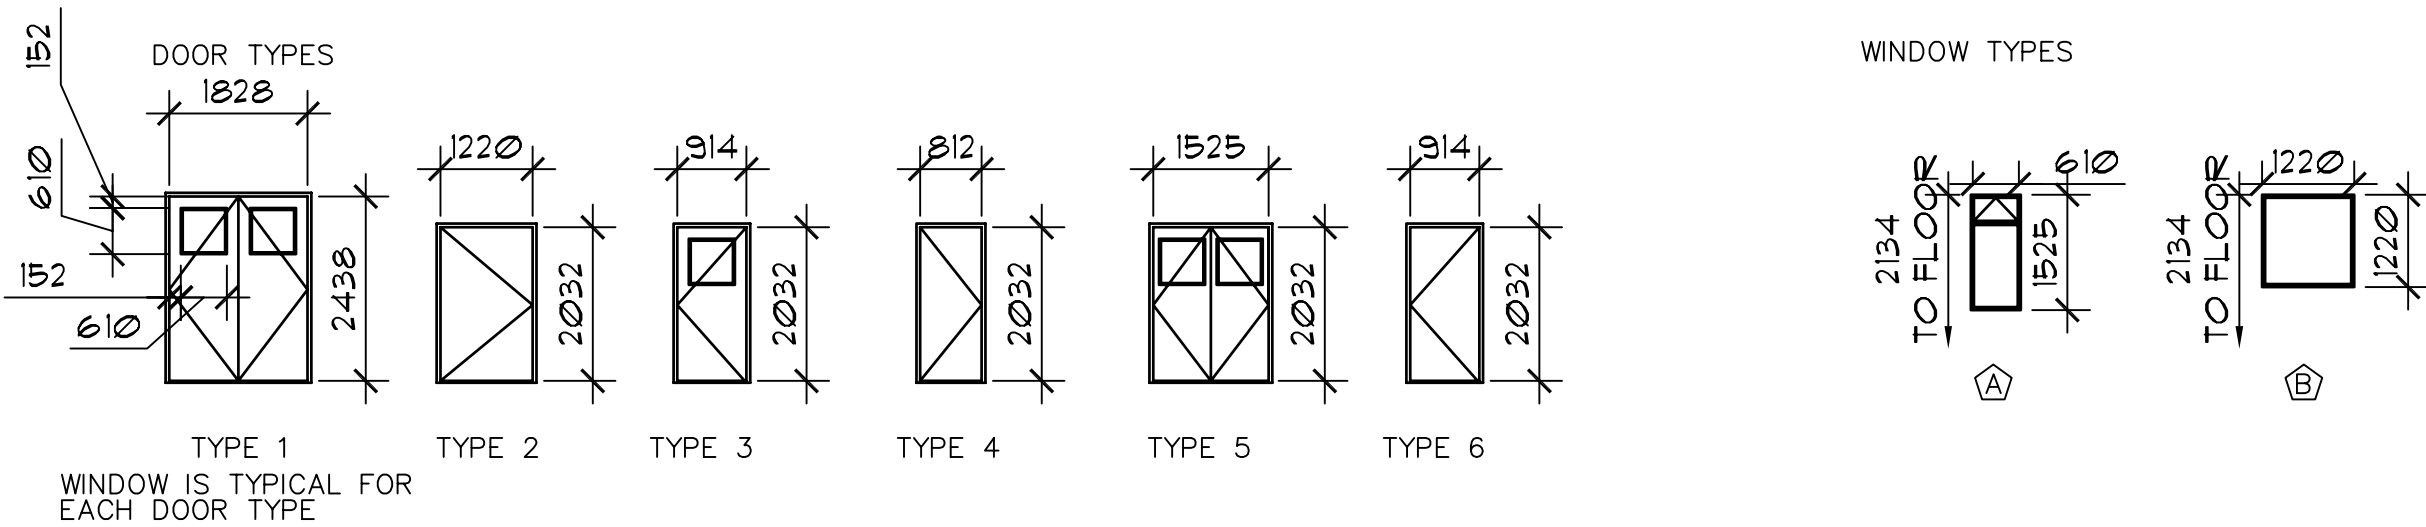

LIST OF FINISHES:

STEEL DOORS AND FRAMES: TO MATCH SICO 4145-63

WALLS AND CEILINGS: TO MATCH SICO 4151-11

EXTERIOR GRADE PLYWOOD: TO MATCH SICO 4151-11

FLOORING:

RESILIENT FLOORING: FORBO MARMOLEUM REAL 3160

NON-SLIP RESILIENT FLOORING: ALTRO DESIGNER SERIES DESERT D25522

RESILEINT BASE: JOHNSONITE #85 BURGENDY

LIVINGSTONE
Architect

P.O. BOX 1150 IQALUIT, NU X0A 0H0
PH (867) 979-4180 FAX (867) 979-3091

				Company Permit	Engineer Seal	DISCIPLINE		CITY OF IQALUIT		Earth Tech (Canada) Inc. BRANCH DRAWN BY: G.R. CHECKED BY: AL SCALE: AS NOTED DATE: FEB. 03, 2003 SHEET NO. A3 CADD SYSTEM AutoCAD DWG NO. 55524-A3 REV. 1 CONTRACT 55524
2	RECORD DRAWING	23/04/04				ROOM & DOOR SCHEDULES		IQALUIT WATER TREATMENT PLANT		
1	ISSUED FOR CONSTRUCTION	22/04/03								
A	ISSUED FOIR FINAL REVIEW	FEB.3/03								
NO.	REVISION	DATE	INITIAL							

RECORD DRAWING
INFORMATION CONTAINED IN THESE DRAWINGS
IS AS SUPPLIED BY:
NINETY NORTH CONSTRUCTION &
DEVELOPMENT LTD.
THE COMPLETENESS AND ACCURACY OF THIS
RECORD DRAWING IS NOT GUARANTEED.
INFORMATION SHOULD BE VERIFIED AT THE
ACTUAL LOCATION BEFORE USE.