
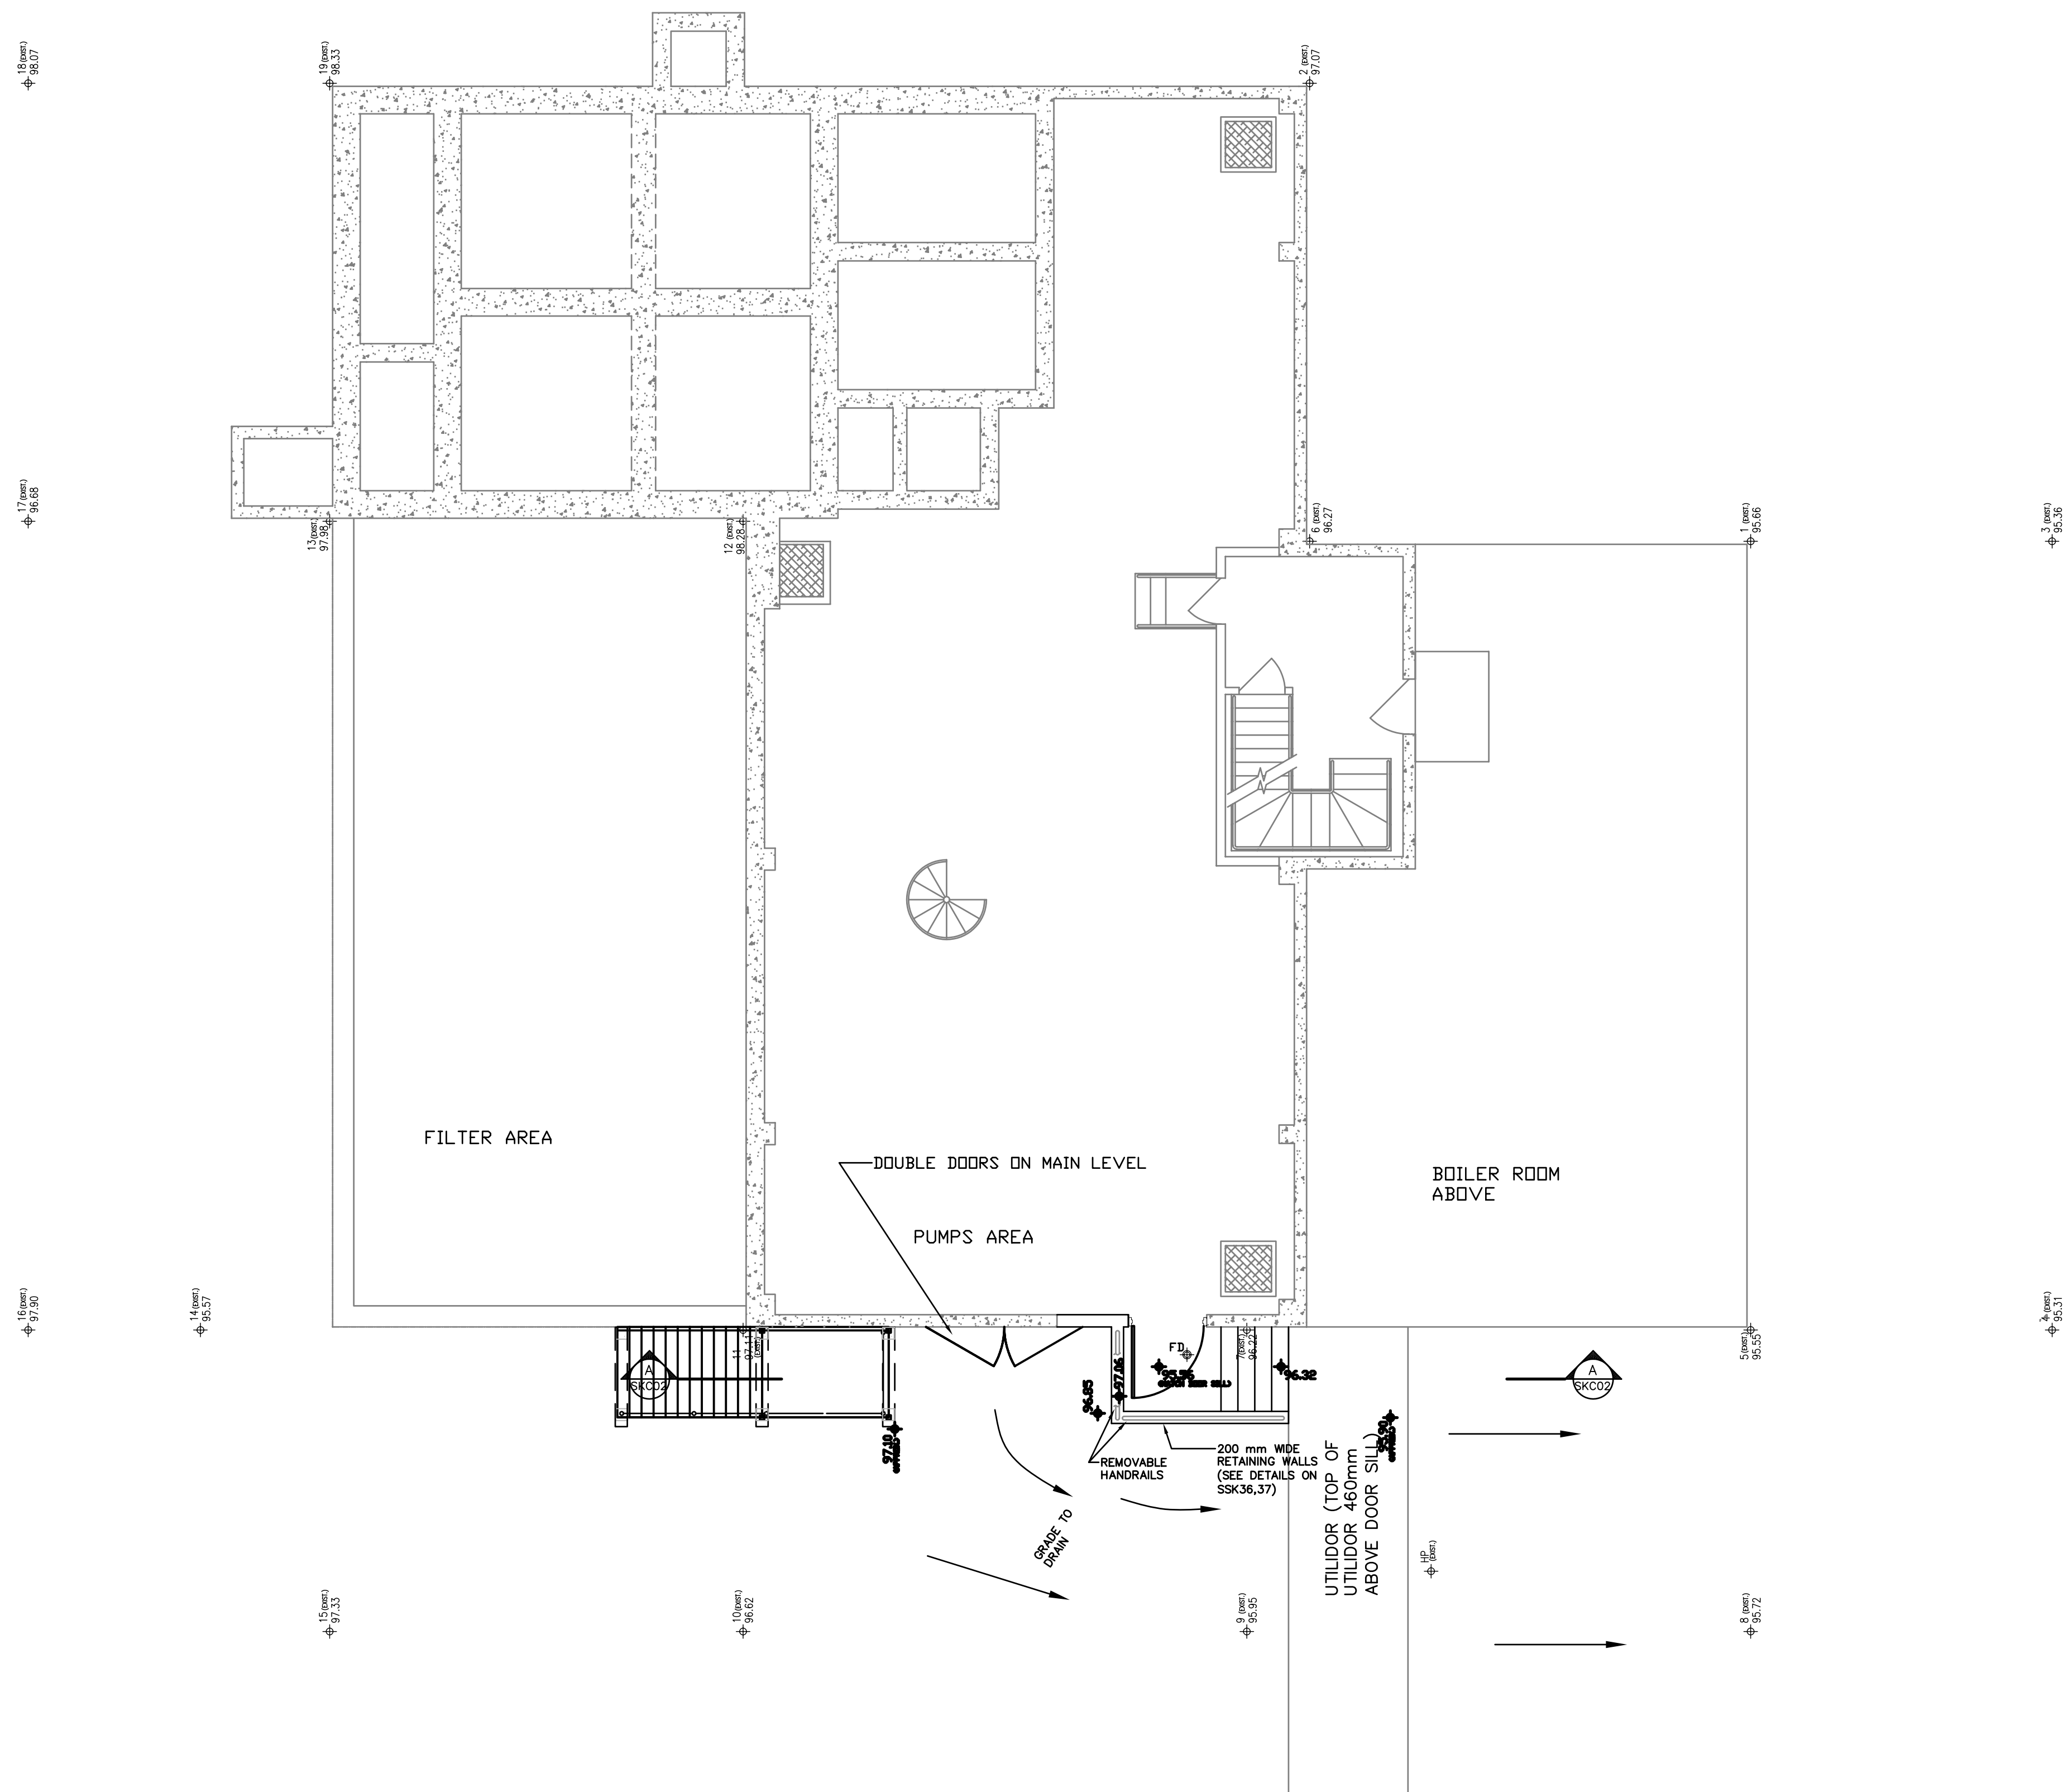


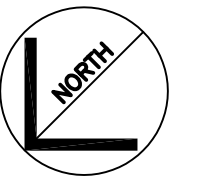

NO.	REVISION	DATE	INITIAL
0			

Company Permit

Engineer Seal

RECORD DRAWING
INFORMATION CONTAINED IN THESE DRAWINGS
IS AS SUPPLIED BY:
THE COMPLETENESS AND ACCURACY OF THIS
RECORD DRAWING IS NOT GUARANTEED.
INFORMATION SHOULD BE VERIFIED AT THE
ACTUAL LOCATION BEFORE USE.

CIVIL

SITE GRADING
SHOWING PUMPS FLOOR

**CITY of IQALUIT,
Nunavut**

CITY OF IQALUIT

IQALUIT WATER TREATMENT PLANT

EARTH TECH

Earth Tech (Canada) Inc.

DRAWN BY: DKB	SCALE: 1:30	DATE: MAY 2004	SHEET NO.
CHECKED BY: GAP			
CADD SYSTEM AutoCAD	DWG NO. C-1	REV. 0	CONTRACT 55524