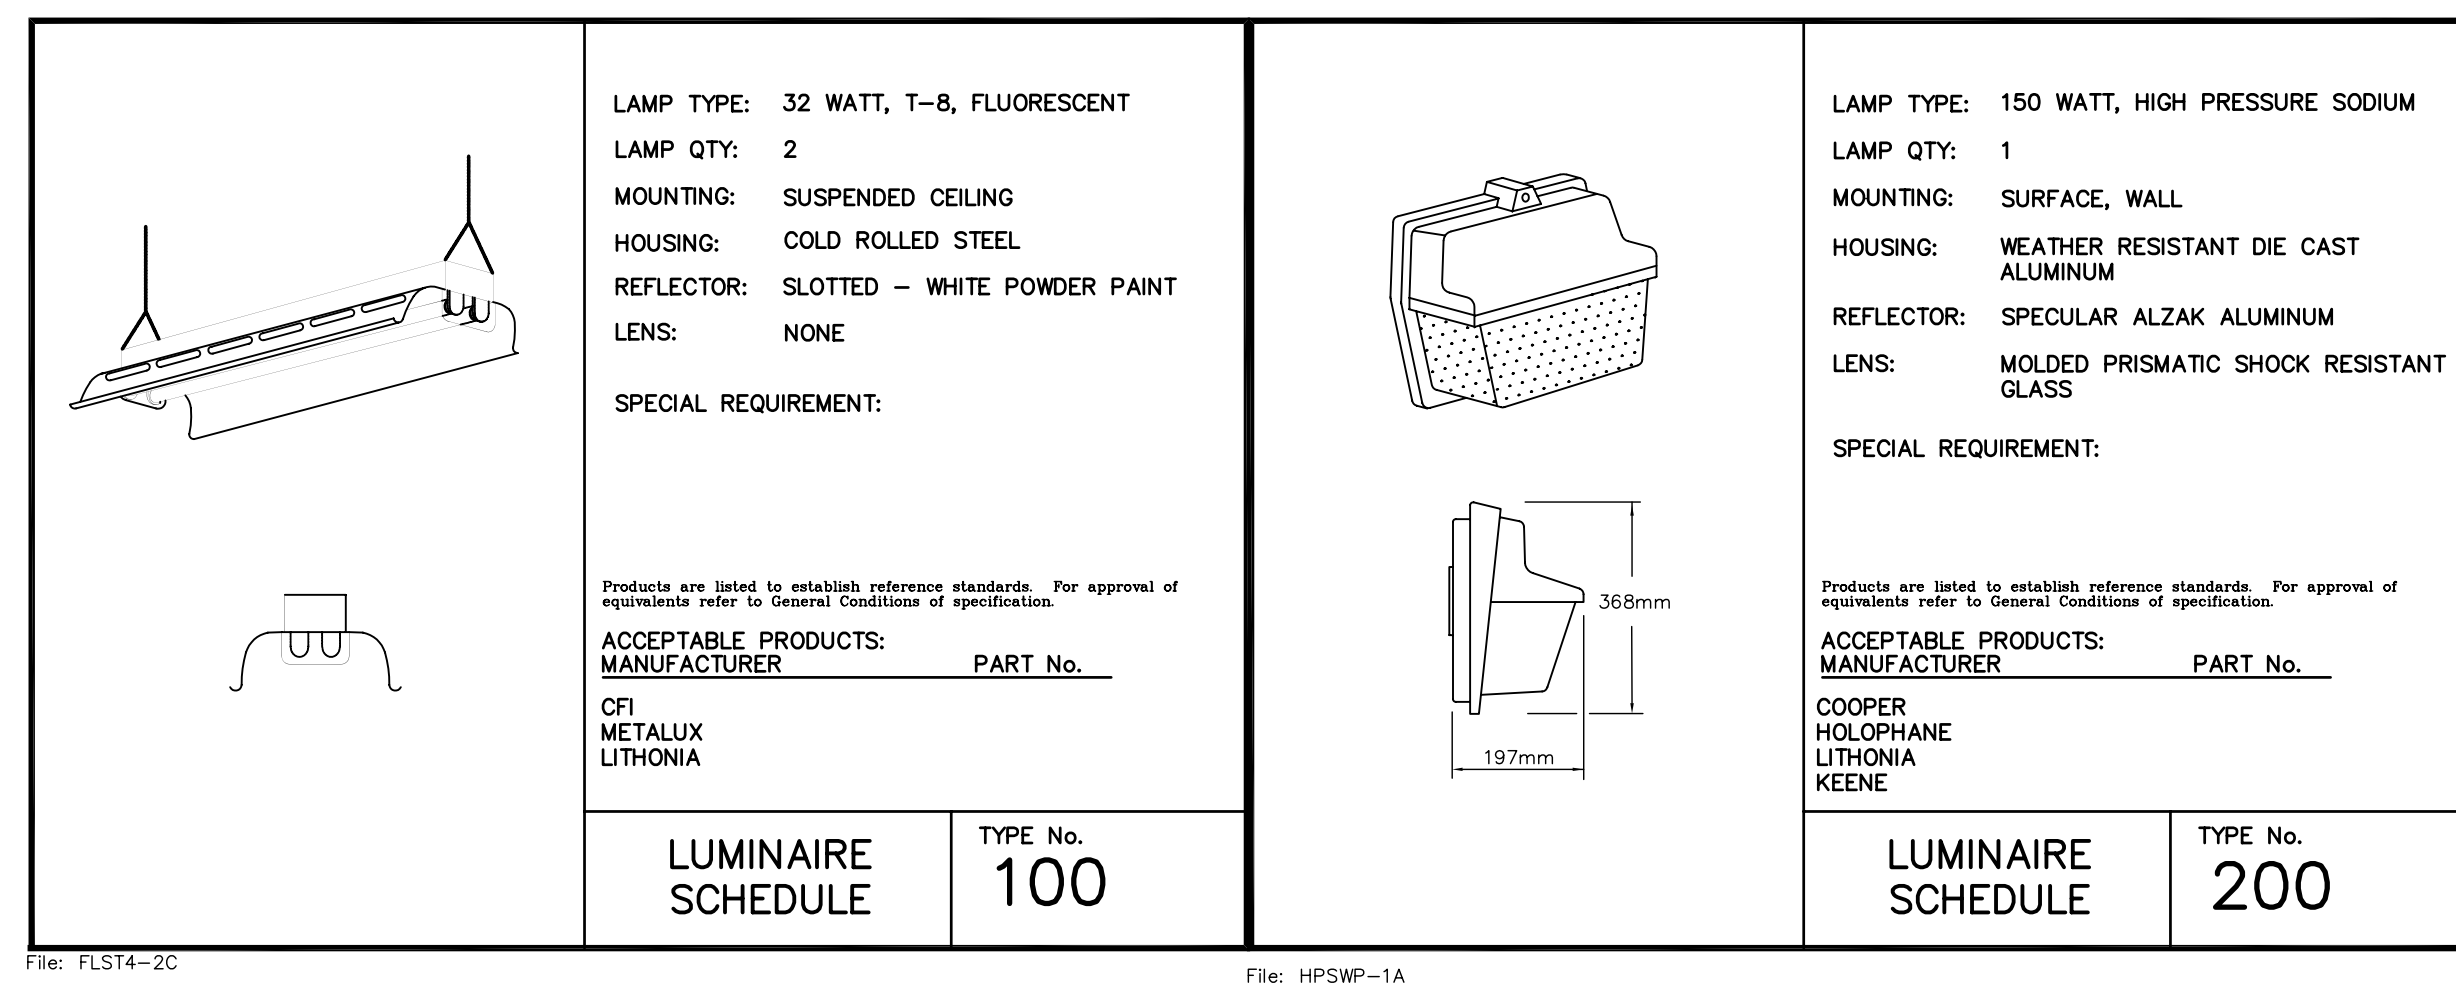
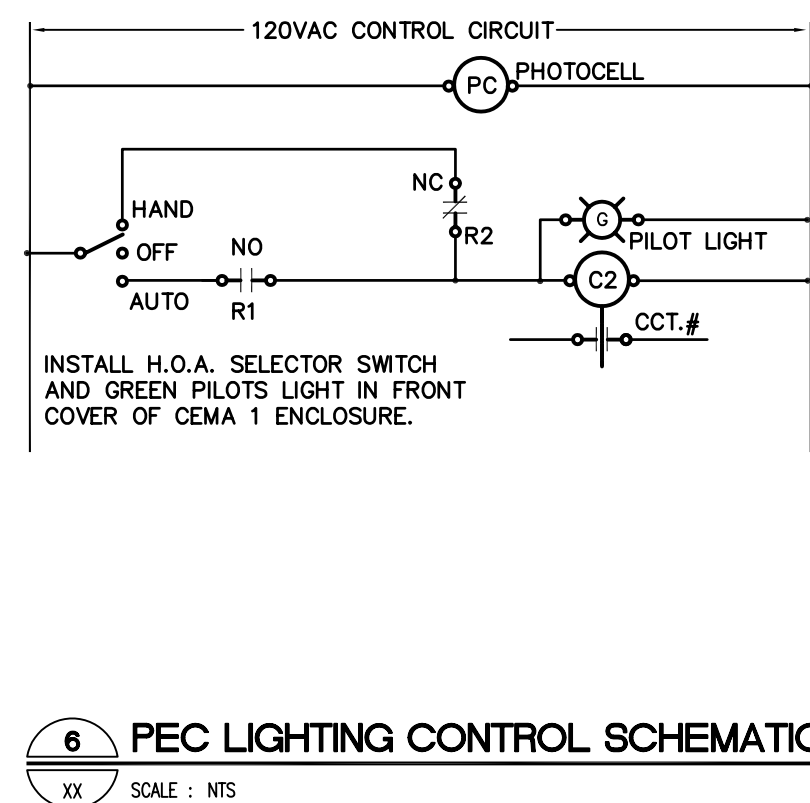
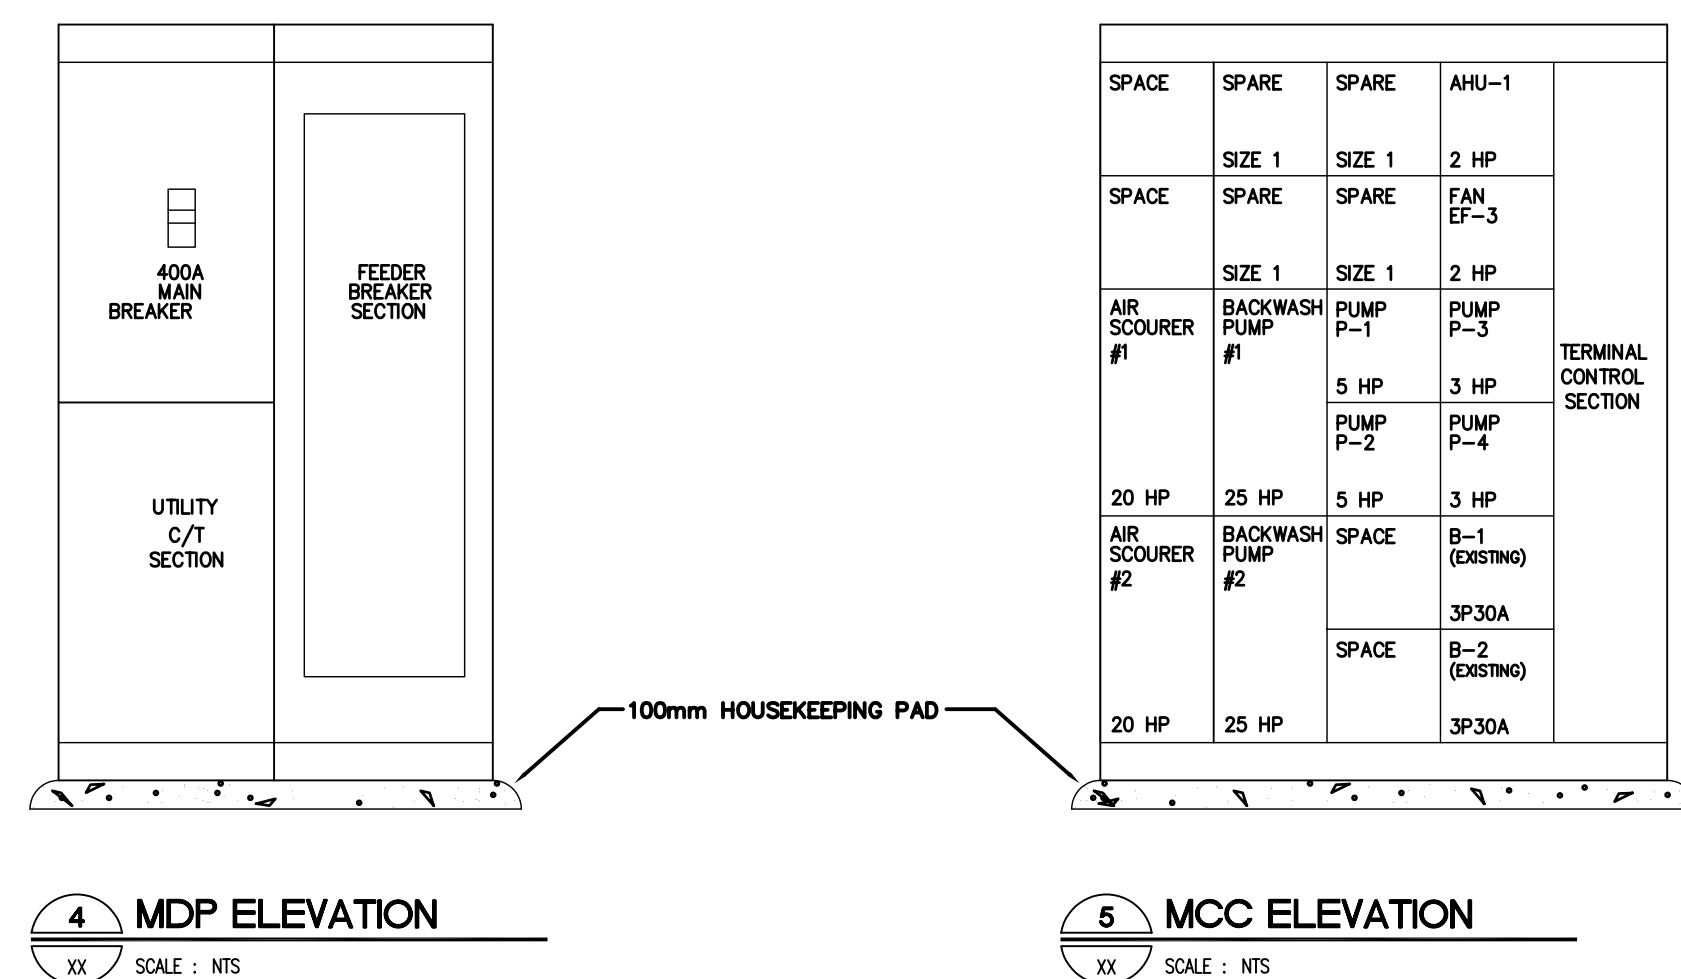


[illegible]

				Company Permit	Engineer Seal	ELECTRICAL	 CITY of IQALUIT, Nunavut	CITY OF IQALUIT	 EARTH TECH Earth Tech (Canada) Inc.<table><tr><td>DRAWN BY: FF</td><td>SCALE:</td><td>DATE:</td><td>SHEET NO.</td></tr><tr><td>CHECKED BY: WA</td><td>AS NOTED</td><td>FEB. 03, 2003</td><td></td></tr><tr><td>CADD SYSTEM AutoCAD</td><td>DWG NO.</td><td>REV. 1</td><td>CONTRACT 55524</td></tr><tr><td></td><td>E-3</td><td></td><td></td></tr></table>	DRAWN BY: FF	SCALE:	DATE:	SHEET NO.	CHECKED BY: WA	AS NOTED	FEB. 03, 2003		CADD SYSTEM AutoCAD	DWG NO.	REV. 1	CONTRACT 55524		E-3		
DRAWN BY: FF	SCALE:	DATE:	SHEET NO.																						
CHECKED BY: WA	AS NOTED	FEB. 03, 2003																							
CADD SYSTEM AutoCAD	DWG NO.	REV. 1	CONTRACT 55524																						
	E-3																								
2	RECORD DRAWING	23/04/04				MCC SCHEDULE AND DETAILS	IQALUIT WATER TREATMENT PLANT																		
1	ISSUED FOR CONSTRUCTION	22/04/03																							
0	ISSUED FOR TENDER	19/02/03																							
NO.	REVISION	DATE	INITIAL																						

RECORD DRAWING
INFORMATION CONTAINED IN THESE DRAWINGS IS AS SUPPLIED BY:
KRT ELECTRIC
THE COMPLETENESS AND ACCURACY OF THIS RECORD DRAWING IS NOT GUARANTEED. INFORMATION SHOULD BE VERIFIED AT THE ACTUAL LOCATION BEFORE USE.