
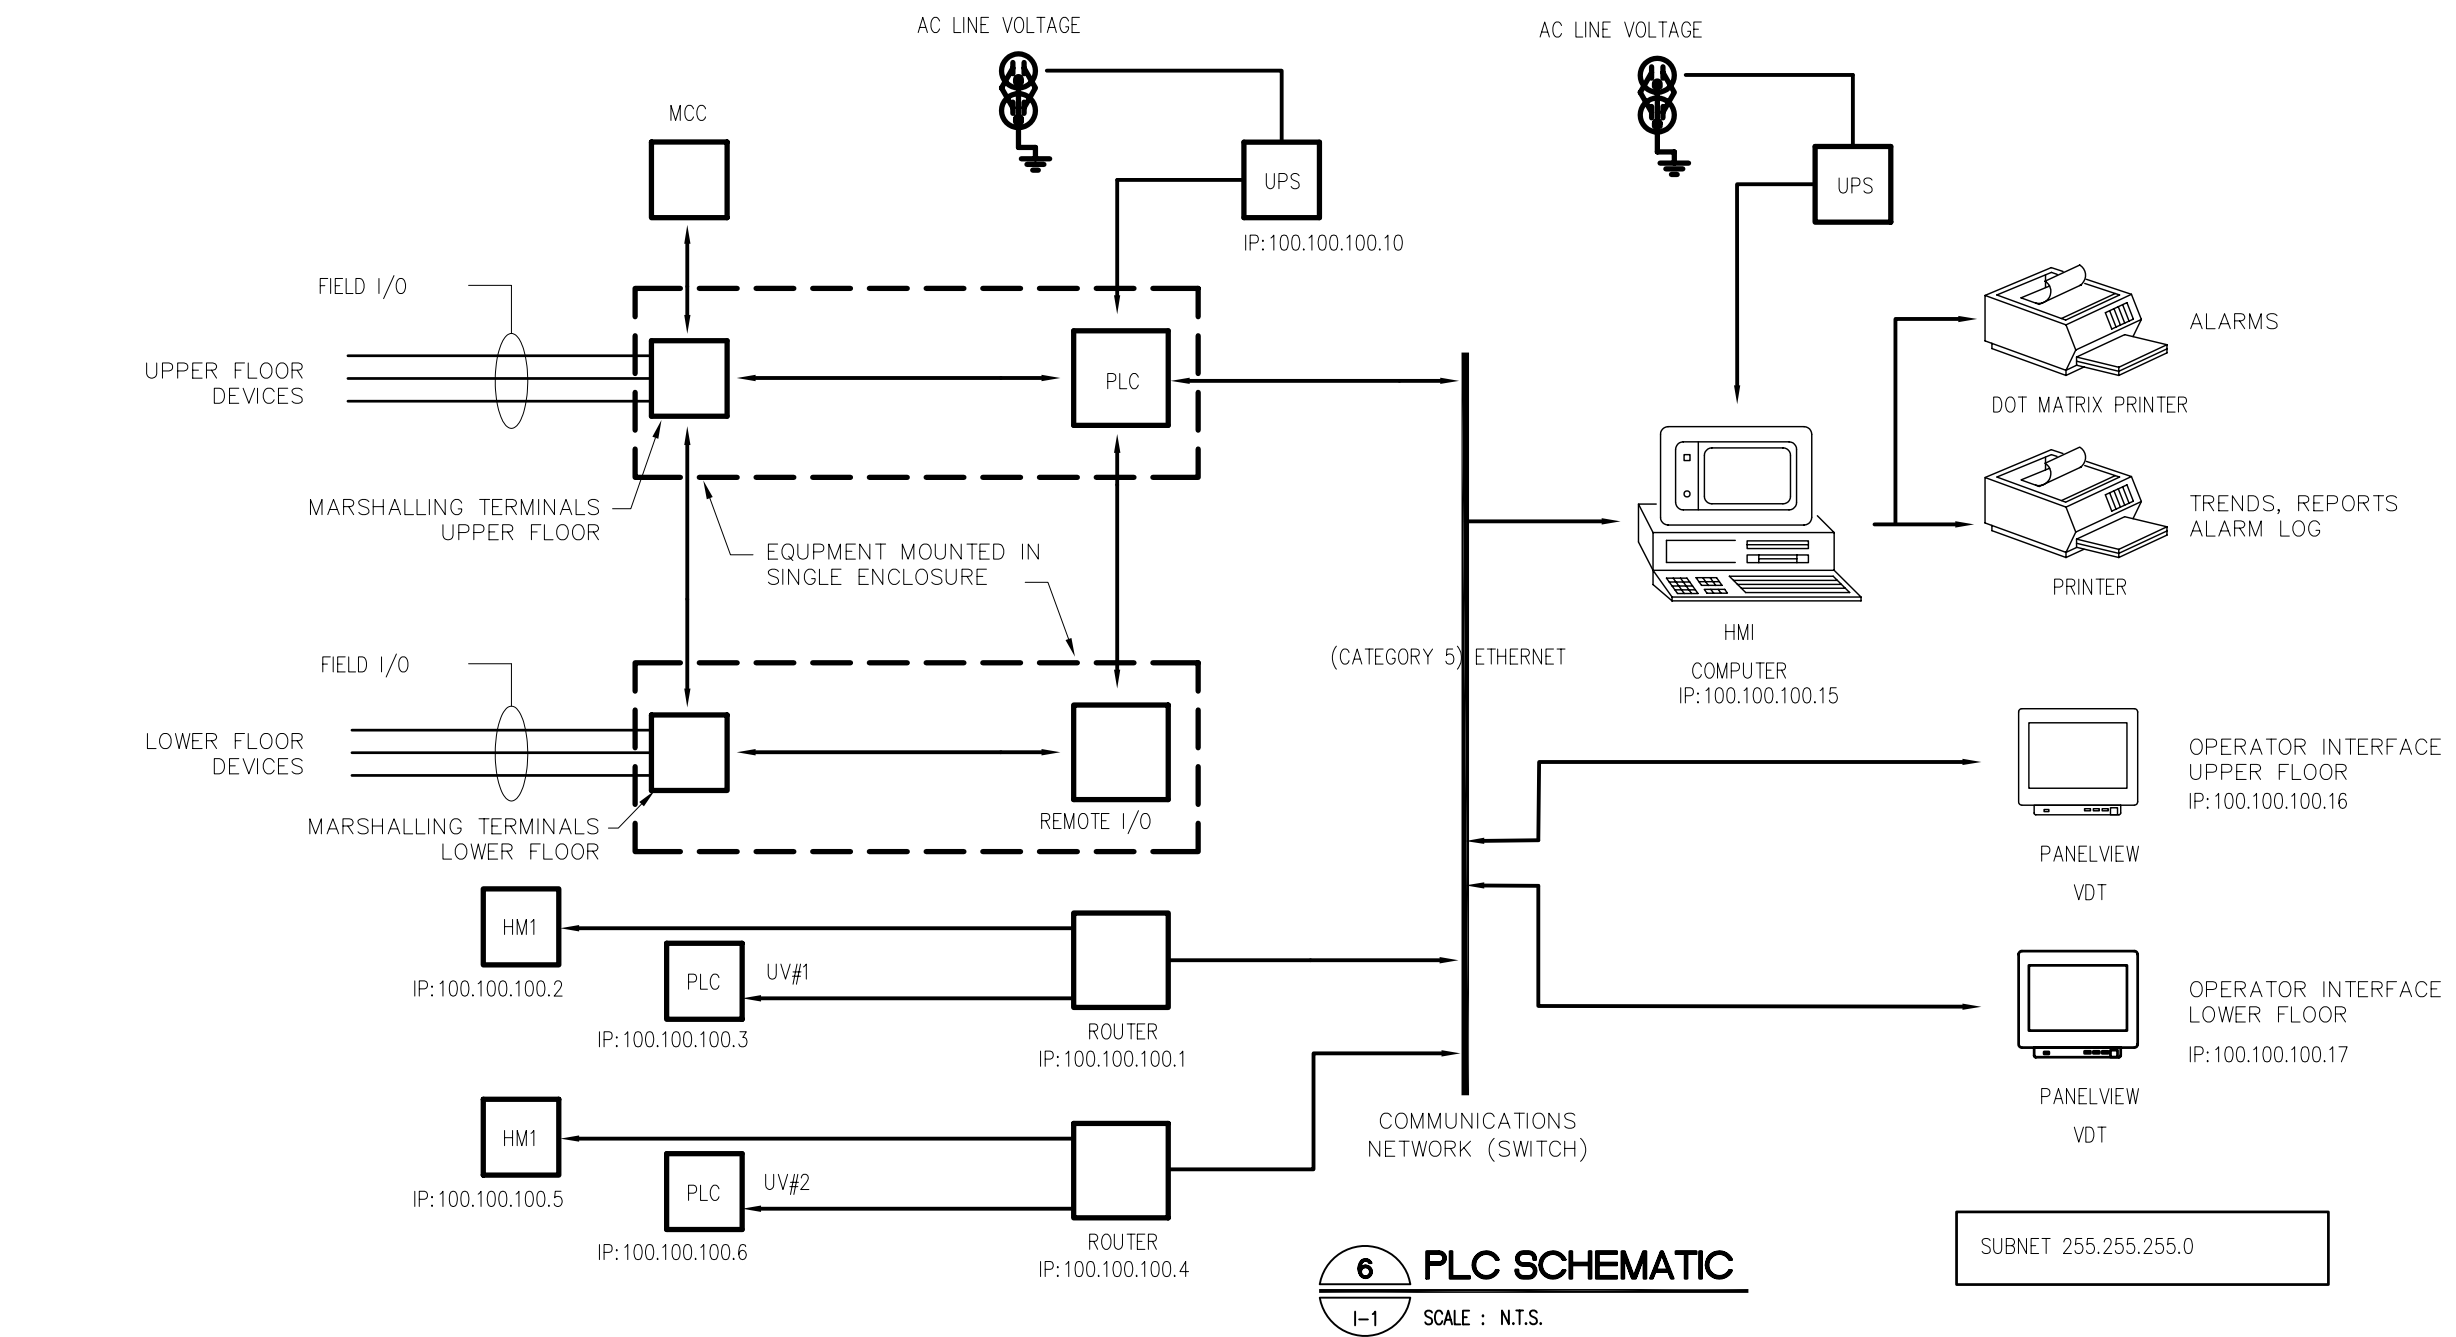


L:\WORK\55500\55524\02A-CAD\WAT\DWGS\DESIGN\INSTR\I-1

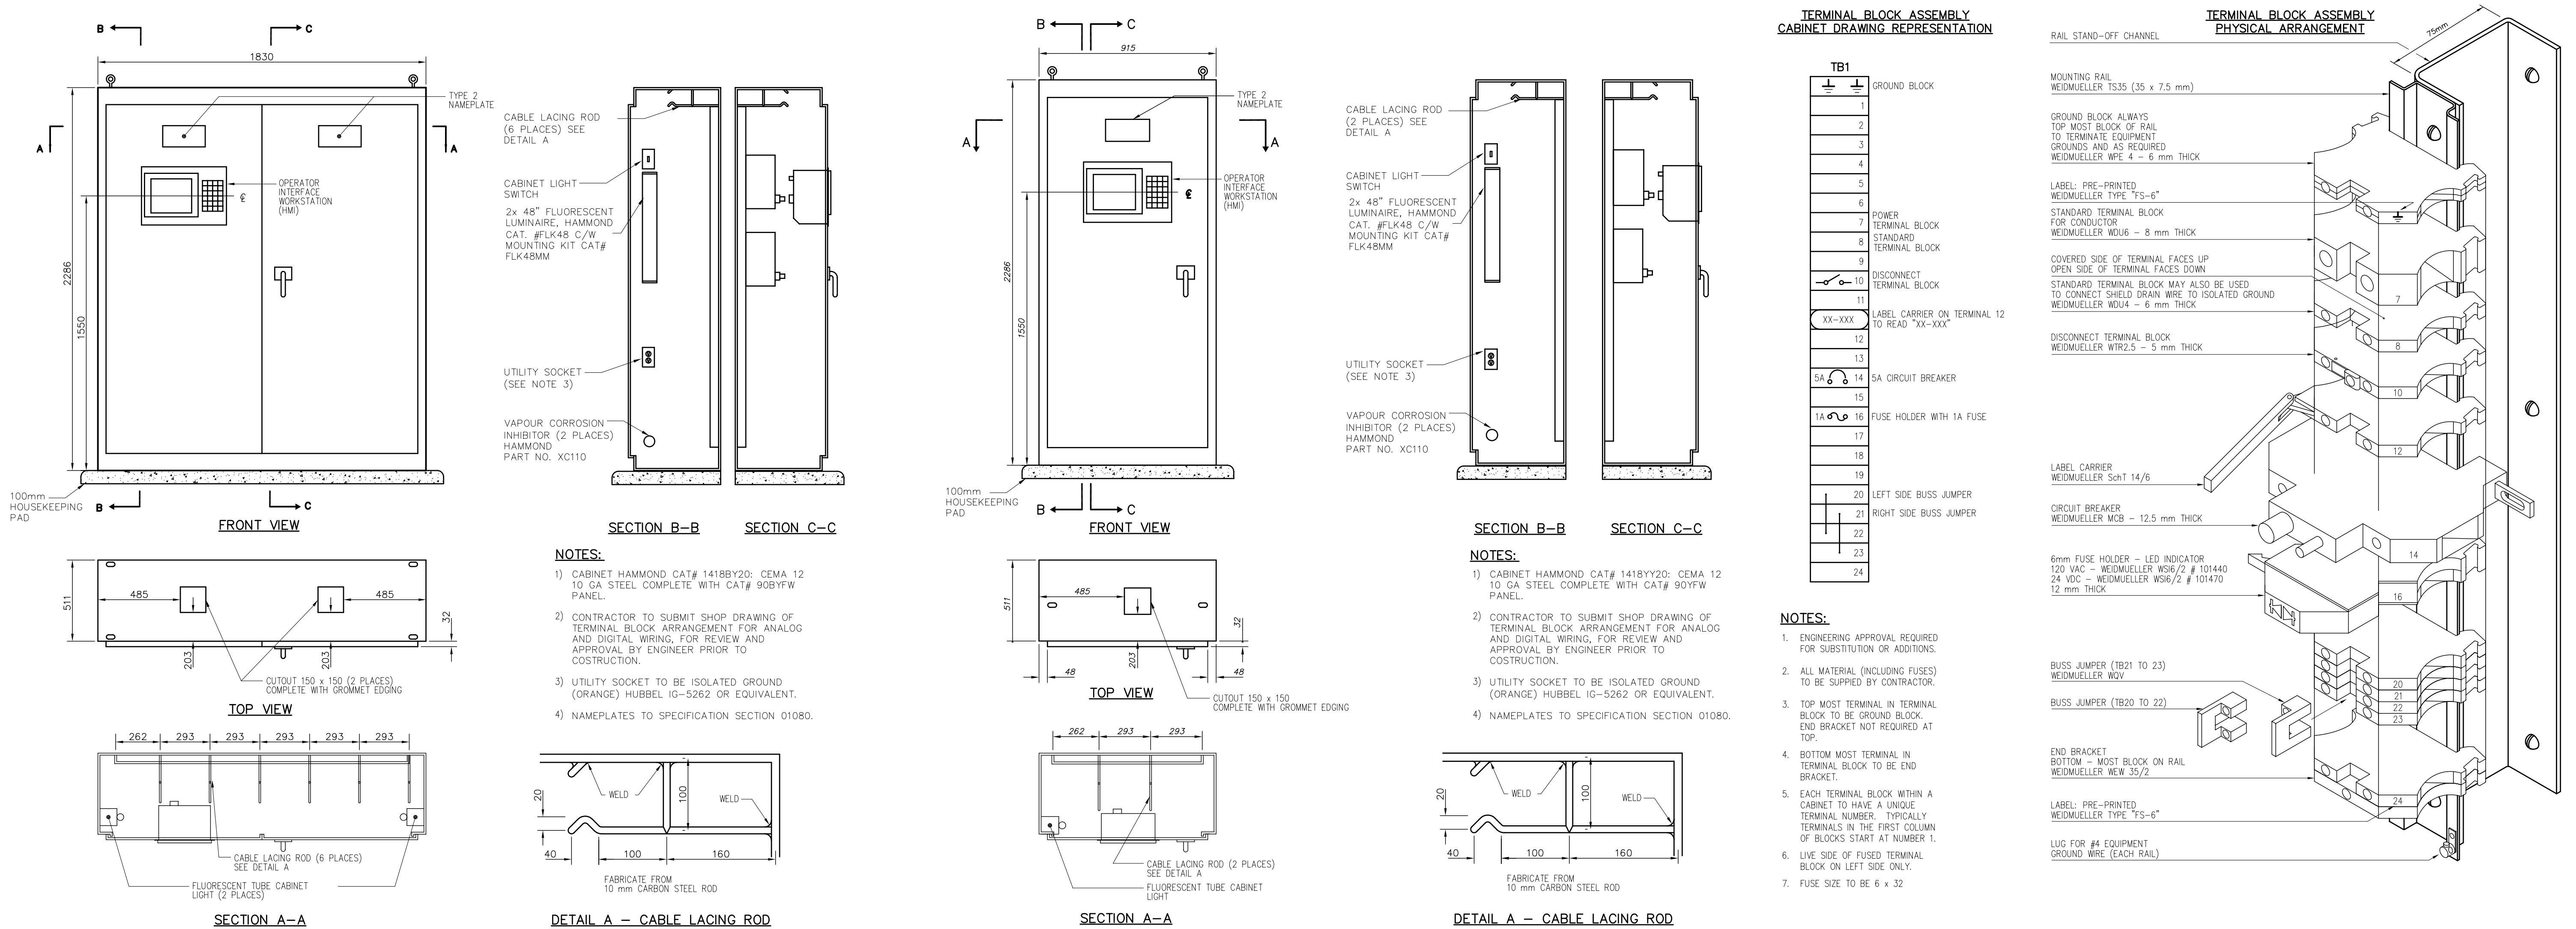

Company Permit				Engineer Seal		INSTRUMENTATION		CITY of IQUALUIT, Nunavut		CITY OF IQUALUIT		EARTH TECH	
RECORD DRAWING				INFORMATION CONTAINED IN THESE DRAWINGS IS AS SUPPLIED BY: SCENDEL MECHANICAL CONTRACTING LTD. & VECTOR ELECTRIC & CONTROLS. THE COMPLETENESS AND ACCURACY OF THIS RECORD DRAWING IS NOT GUARANTEED. INFORMATION SHOULD BE VERIFIED ON LOCATION BEFORE USE.		PLC SYSTEM		IQUALUIT WATER TREATMENT PLANT		Earth Tech (Canada) Inc.		DRAWN BY: TDC	
1				ISSUED FOR CONSTRUCTION		22/04/03				SCALE: AS NOTED		DATE: FEB. 03, 2003	
0				ISSUED FOR TENDER		19/02/03				CADD SYSTEM AutoCAD		DWG NO. I-1	
NO.				REVISION		DATE		INITIAL		REV.		SHEET NO. CONTRACT 55524	