
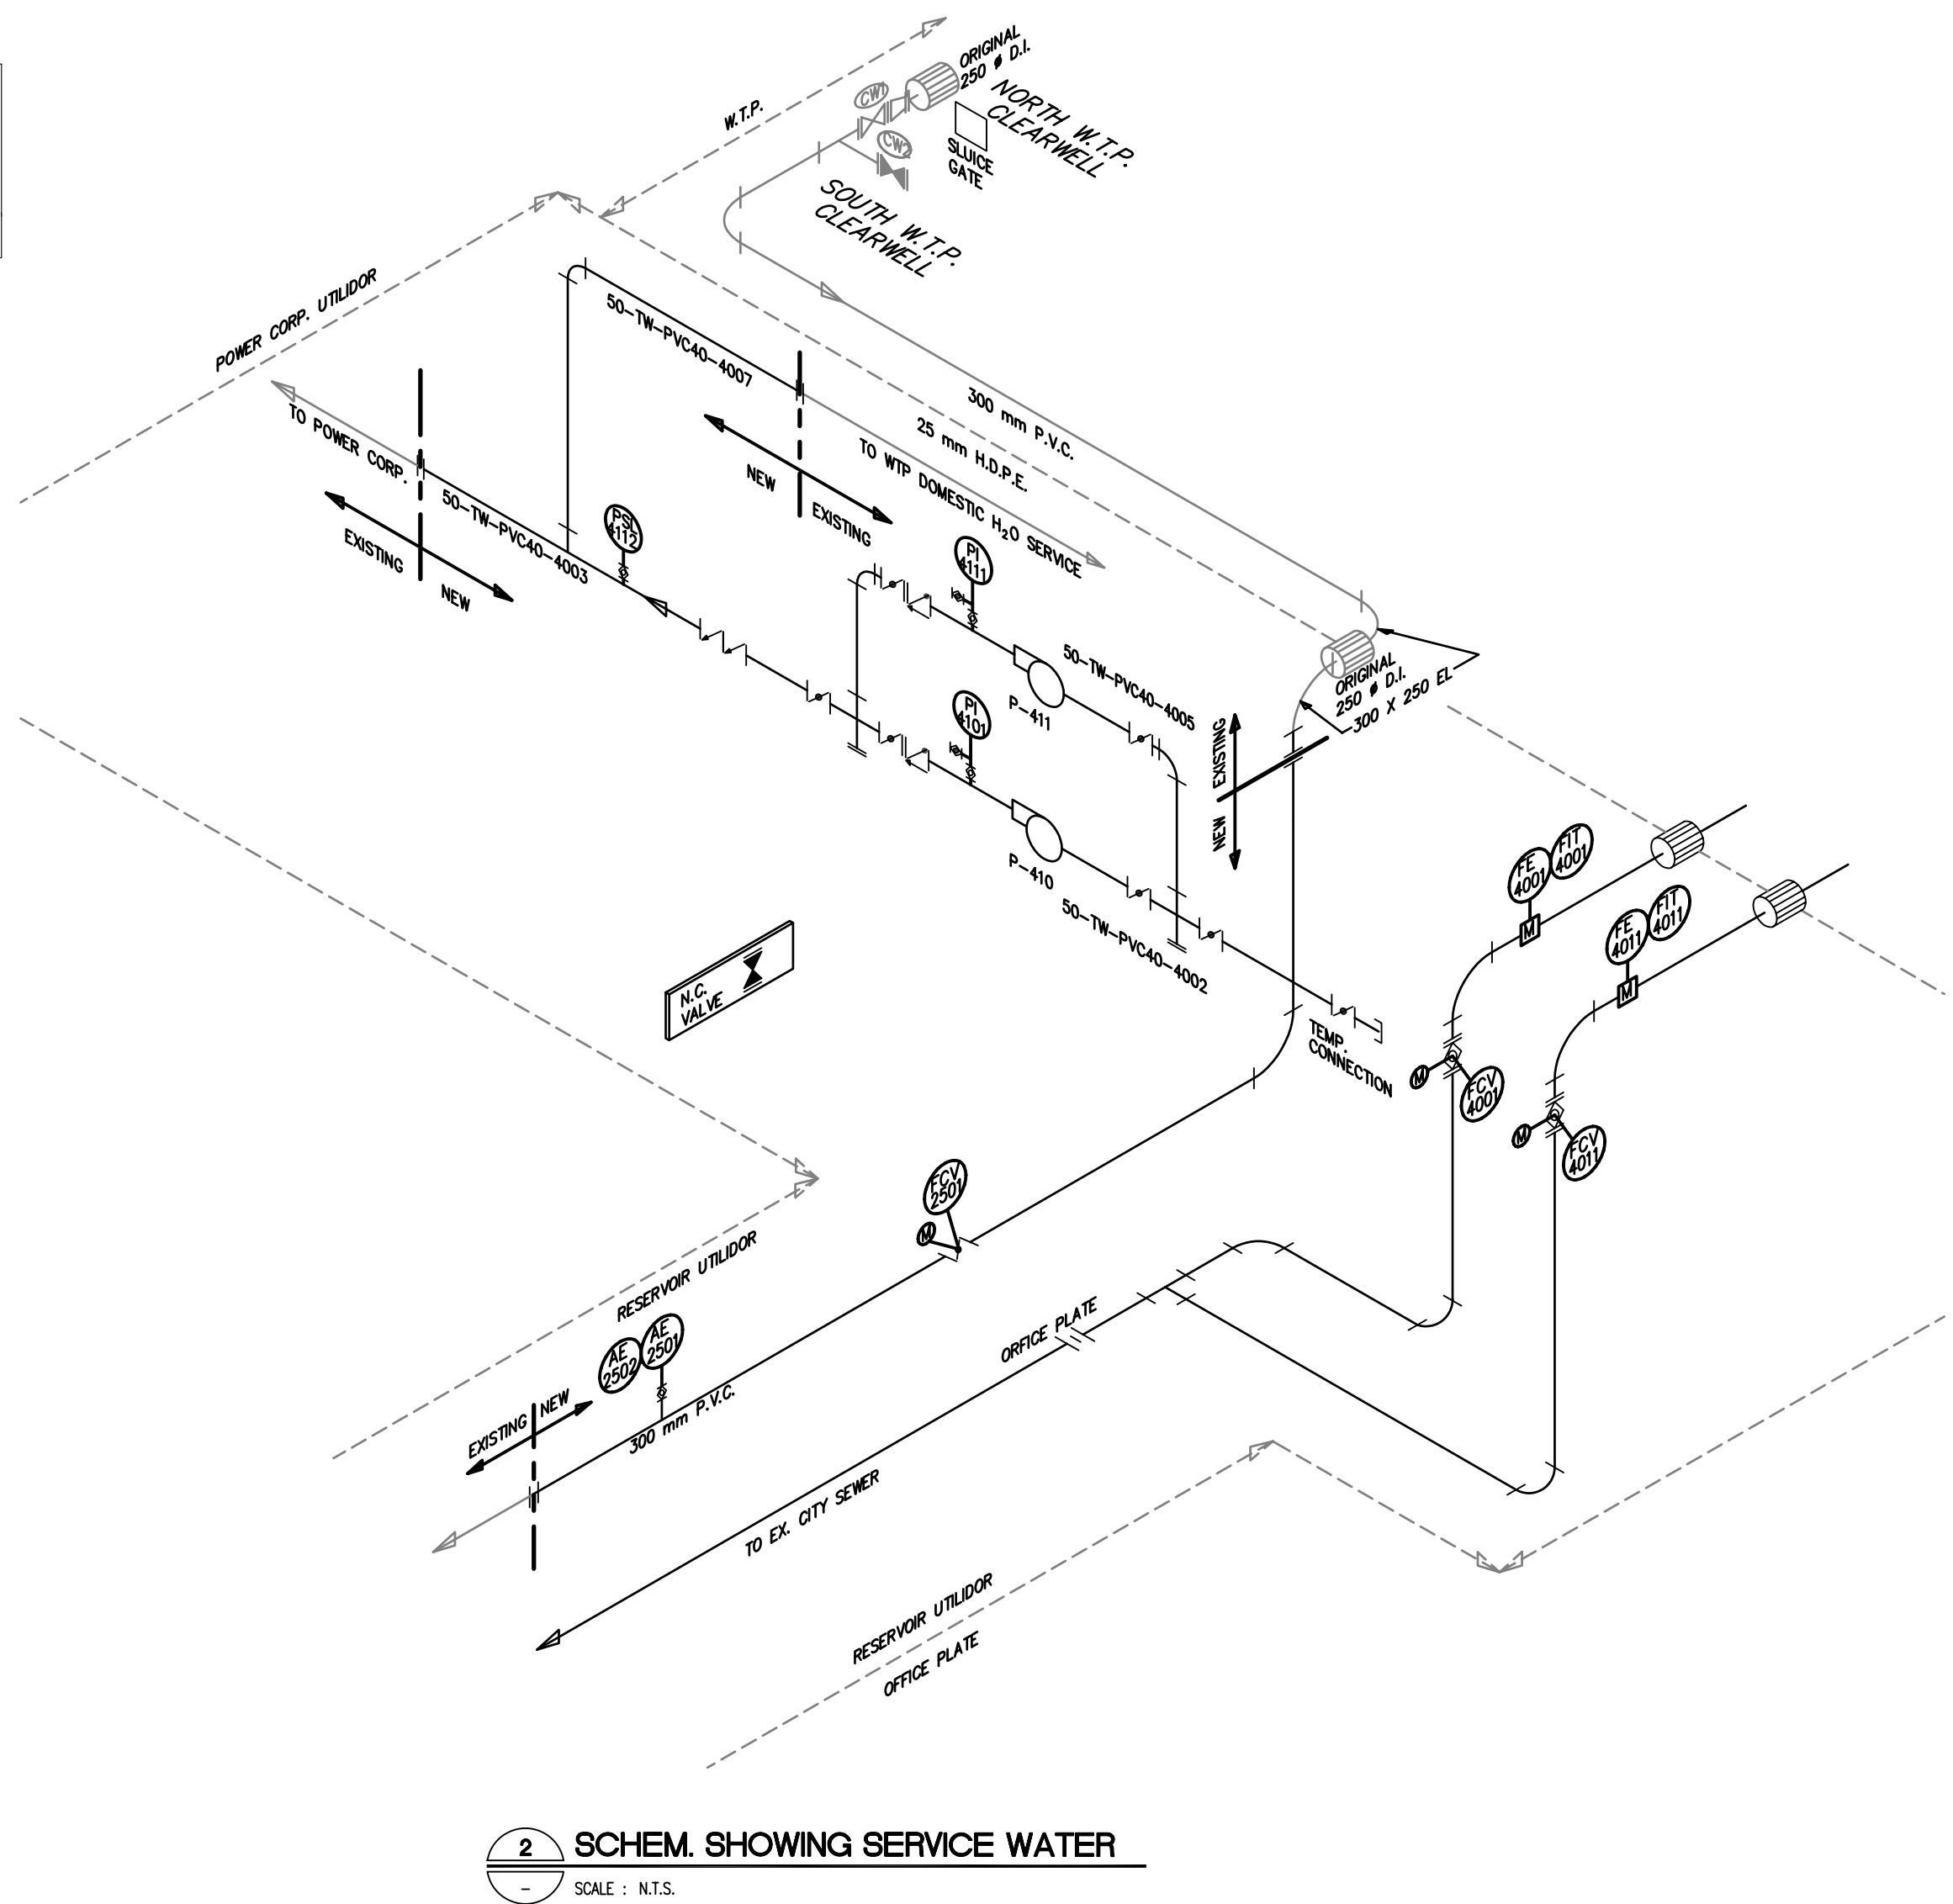


L:\WORK\55500\55524\02A-CAD\WAT\DWGS\DESIGN\55524-1-14.dwg

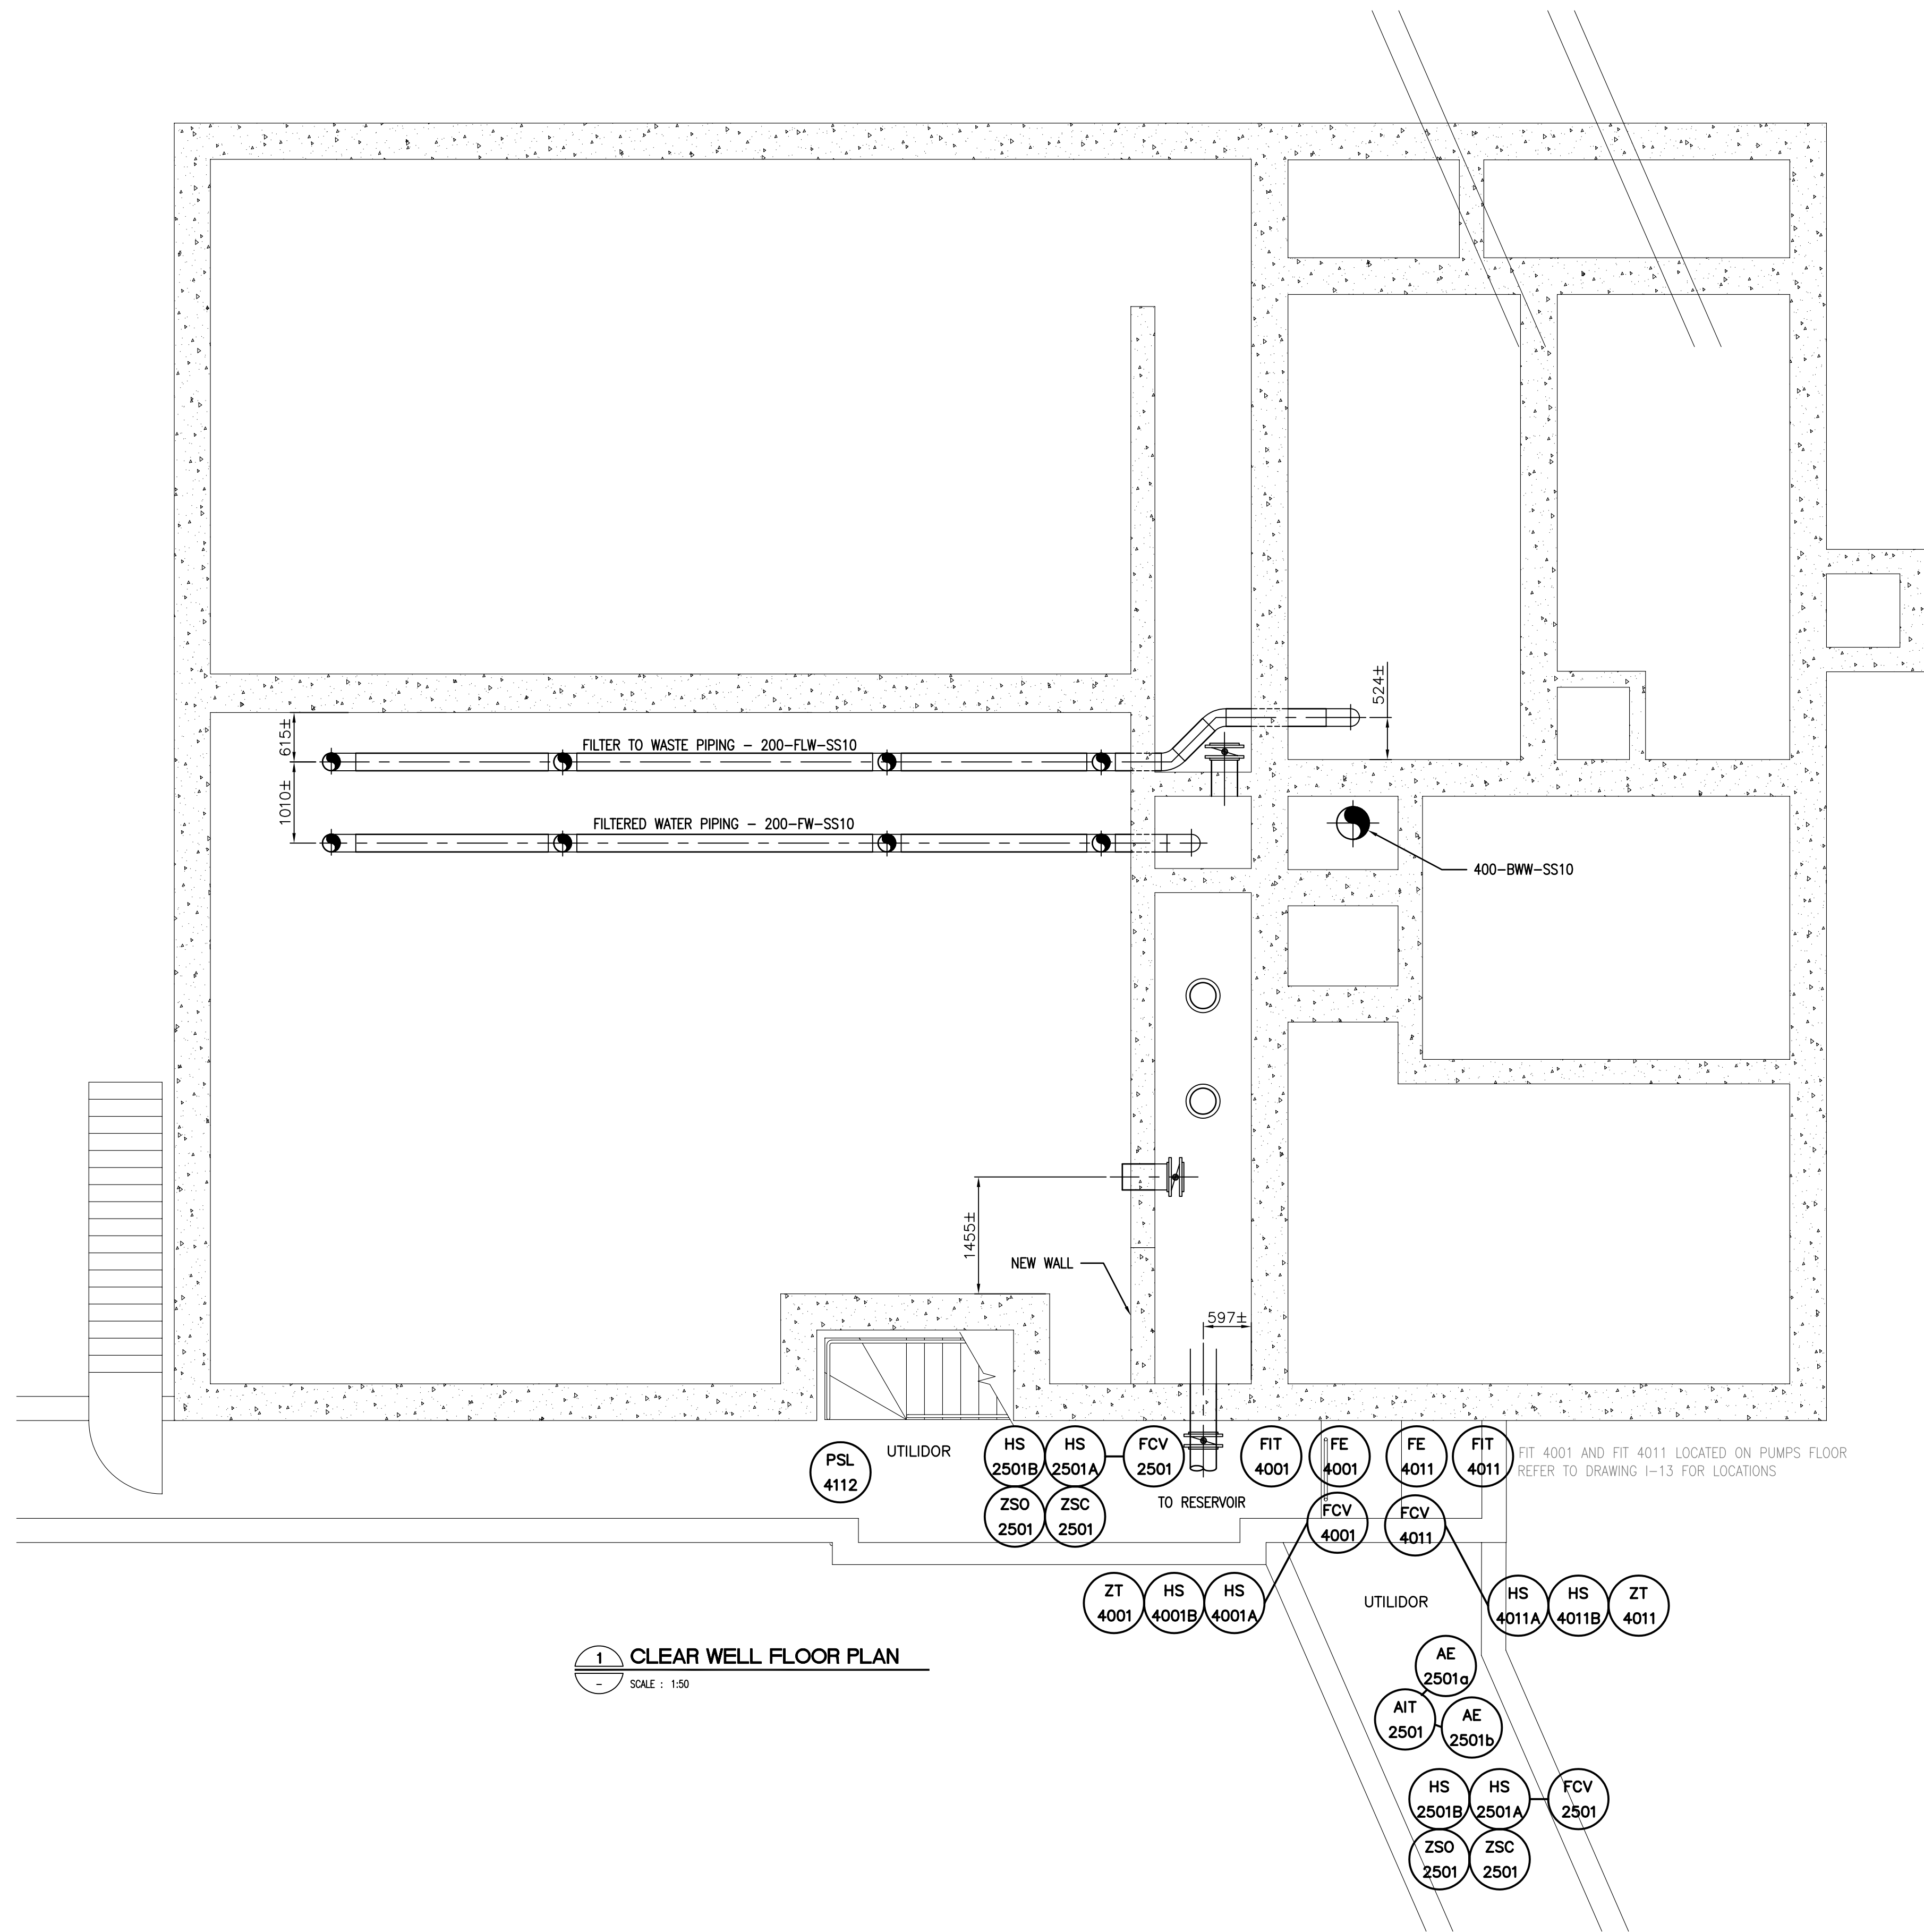

1	ISSUED FOR CONSTRUCTION	22/04/03	CKW	
0	ISSUED FOR TENDER	19/02/03	CKW	
NO.	REVISION	DATE	INITIAL	

Company Permit	Engineer Seal
RECORD DRAWING INFORMATION CONTAINED IN THESE DRAWINGS IS AS SUPPLIED BY: SCHEDEL MECHANICAL CONTRACTING LTD. & VECTOR ELECTRIC & CONTROLS. THE COMPLETENESS AND ACCURACY OF THIS RECORD DRAWING IS NOT GUARANTEED. INFORMATION SHOULD BE VERIFIED ON LOCATION BEFORE USE.	

INSTRUMENTATION
CLEARWELL FLOOR
DEVICE
LOCATIONS



CITY OF IQALUIT
IQALUIT WATER TREATMENT PLANT

EARTH TECH			
Earth Tech (Canada) Inc.			
DRAWN BY: TDC	SCALE: AS NOTED	DATE: OCT. 2002	SHEET NO.
CHECKED BY: CKW	DWG NO.	REV. 1	CONTRACT 55524
CADD SYSTEM AutoCAD	1-11		