



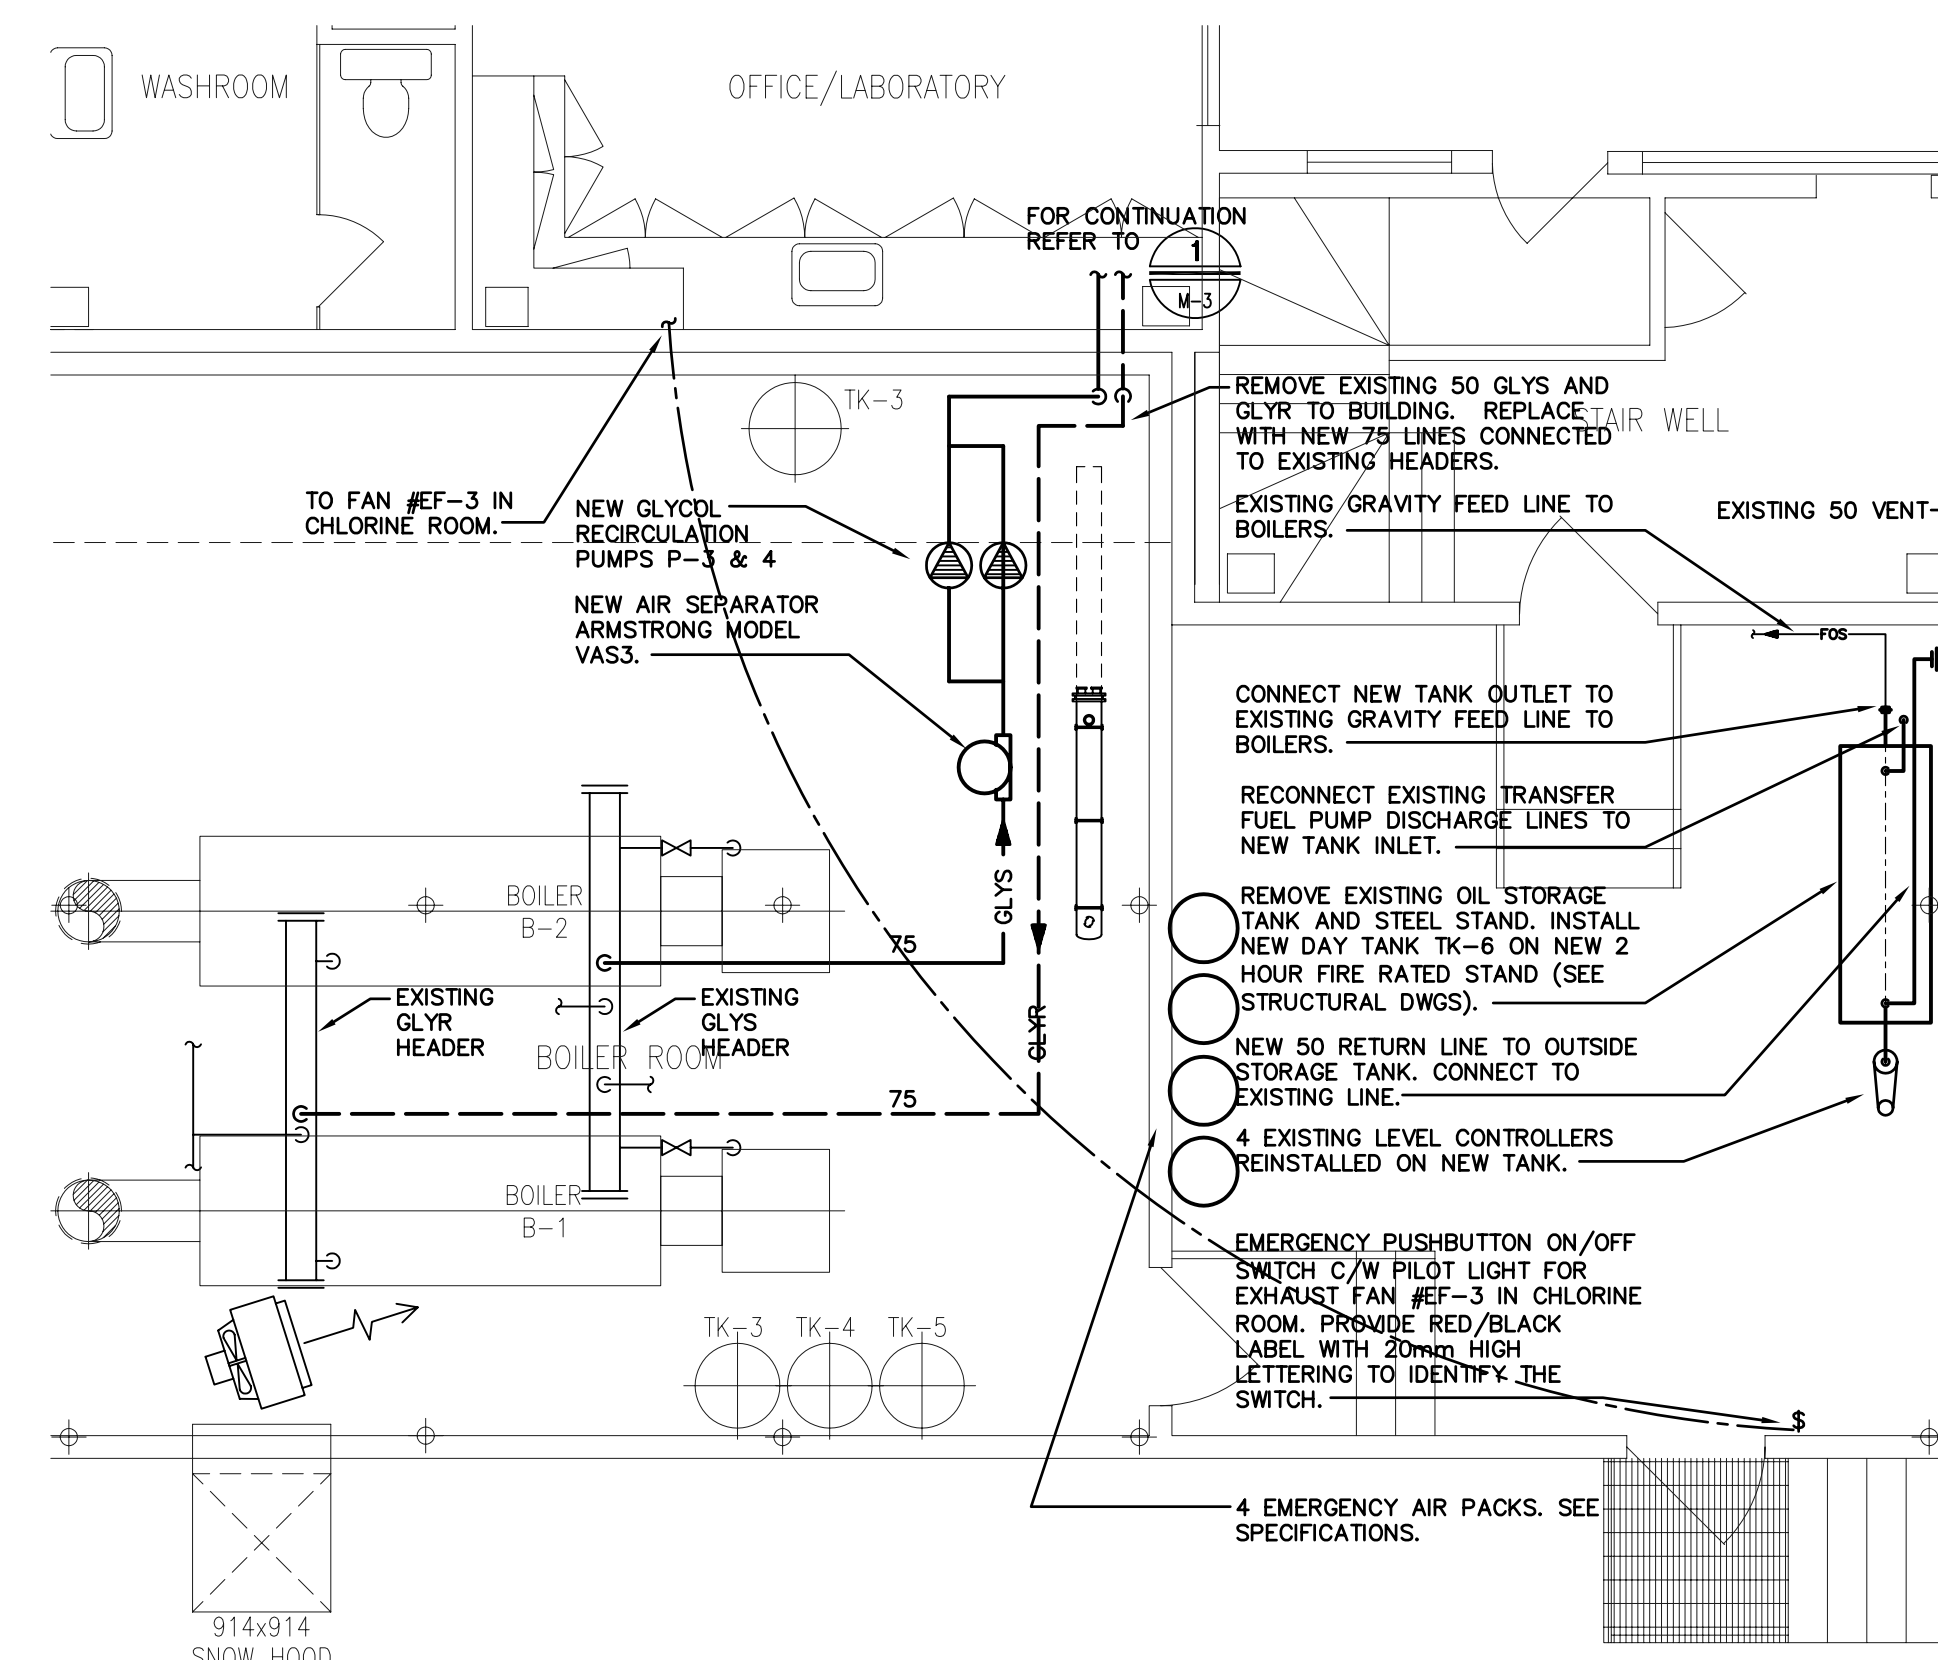

SCALE : 1:50

NOTE:

1. FIELD RUN NEW HEATING PIPES TO PREVENT INTERFERENCE WITH NEW PROCESS PIPING.
2. INSTALL ALL THERMOSTATS ON BRACKETS MIN. 50 CLEAR OF THE WALL.
3. 400x250 DOOR GRILLE. E.H. PRICE SERIES "ATGH", BORDER STYLE "BF", FINISH "B15".

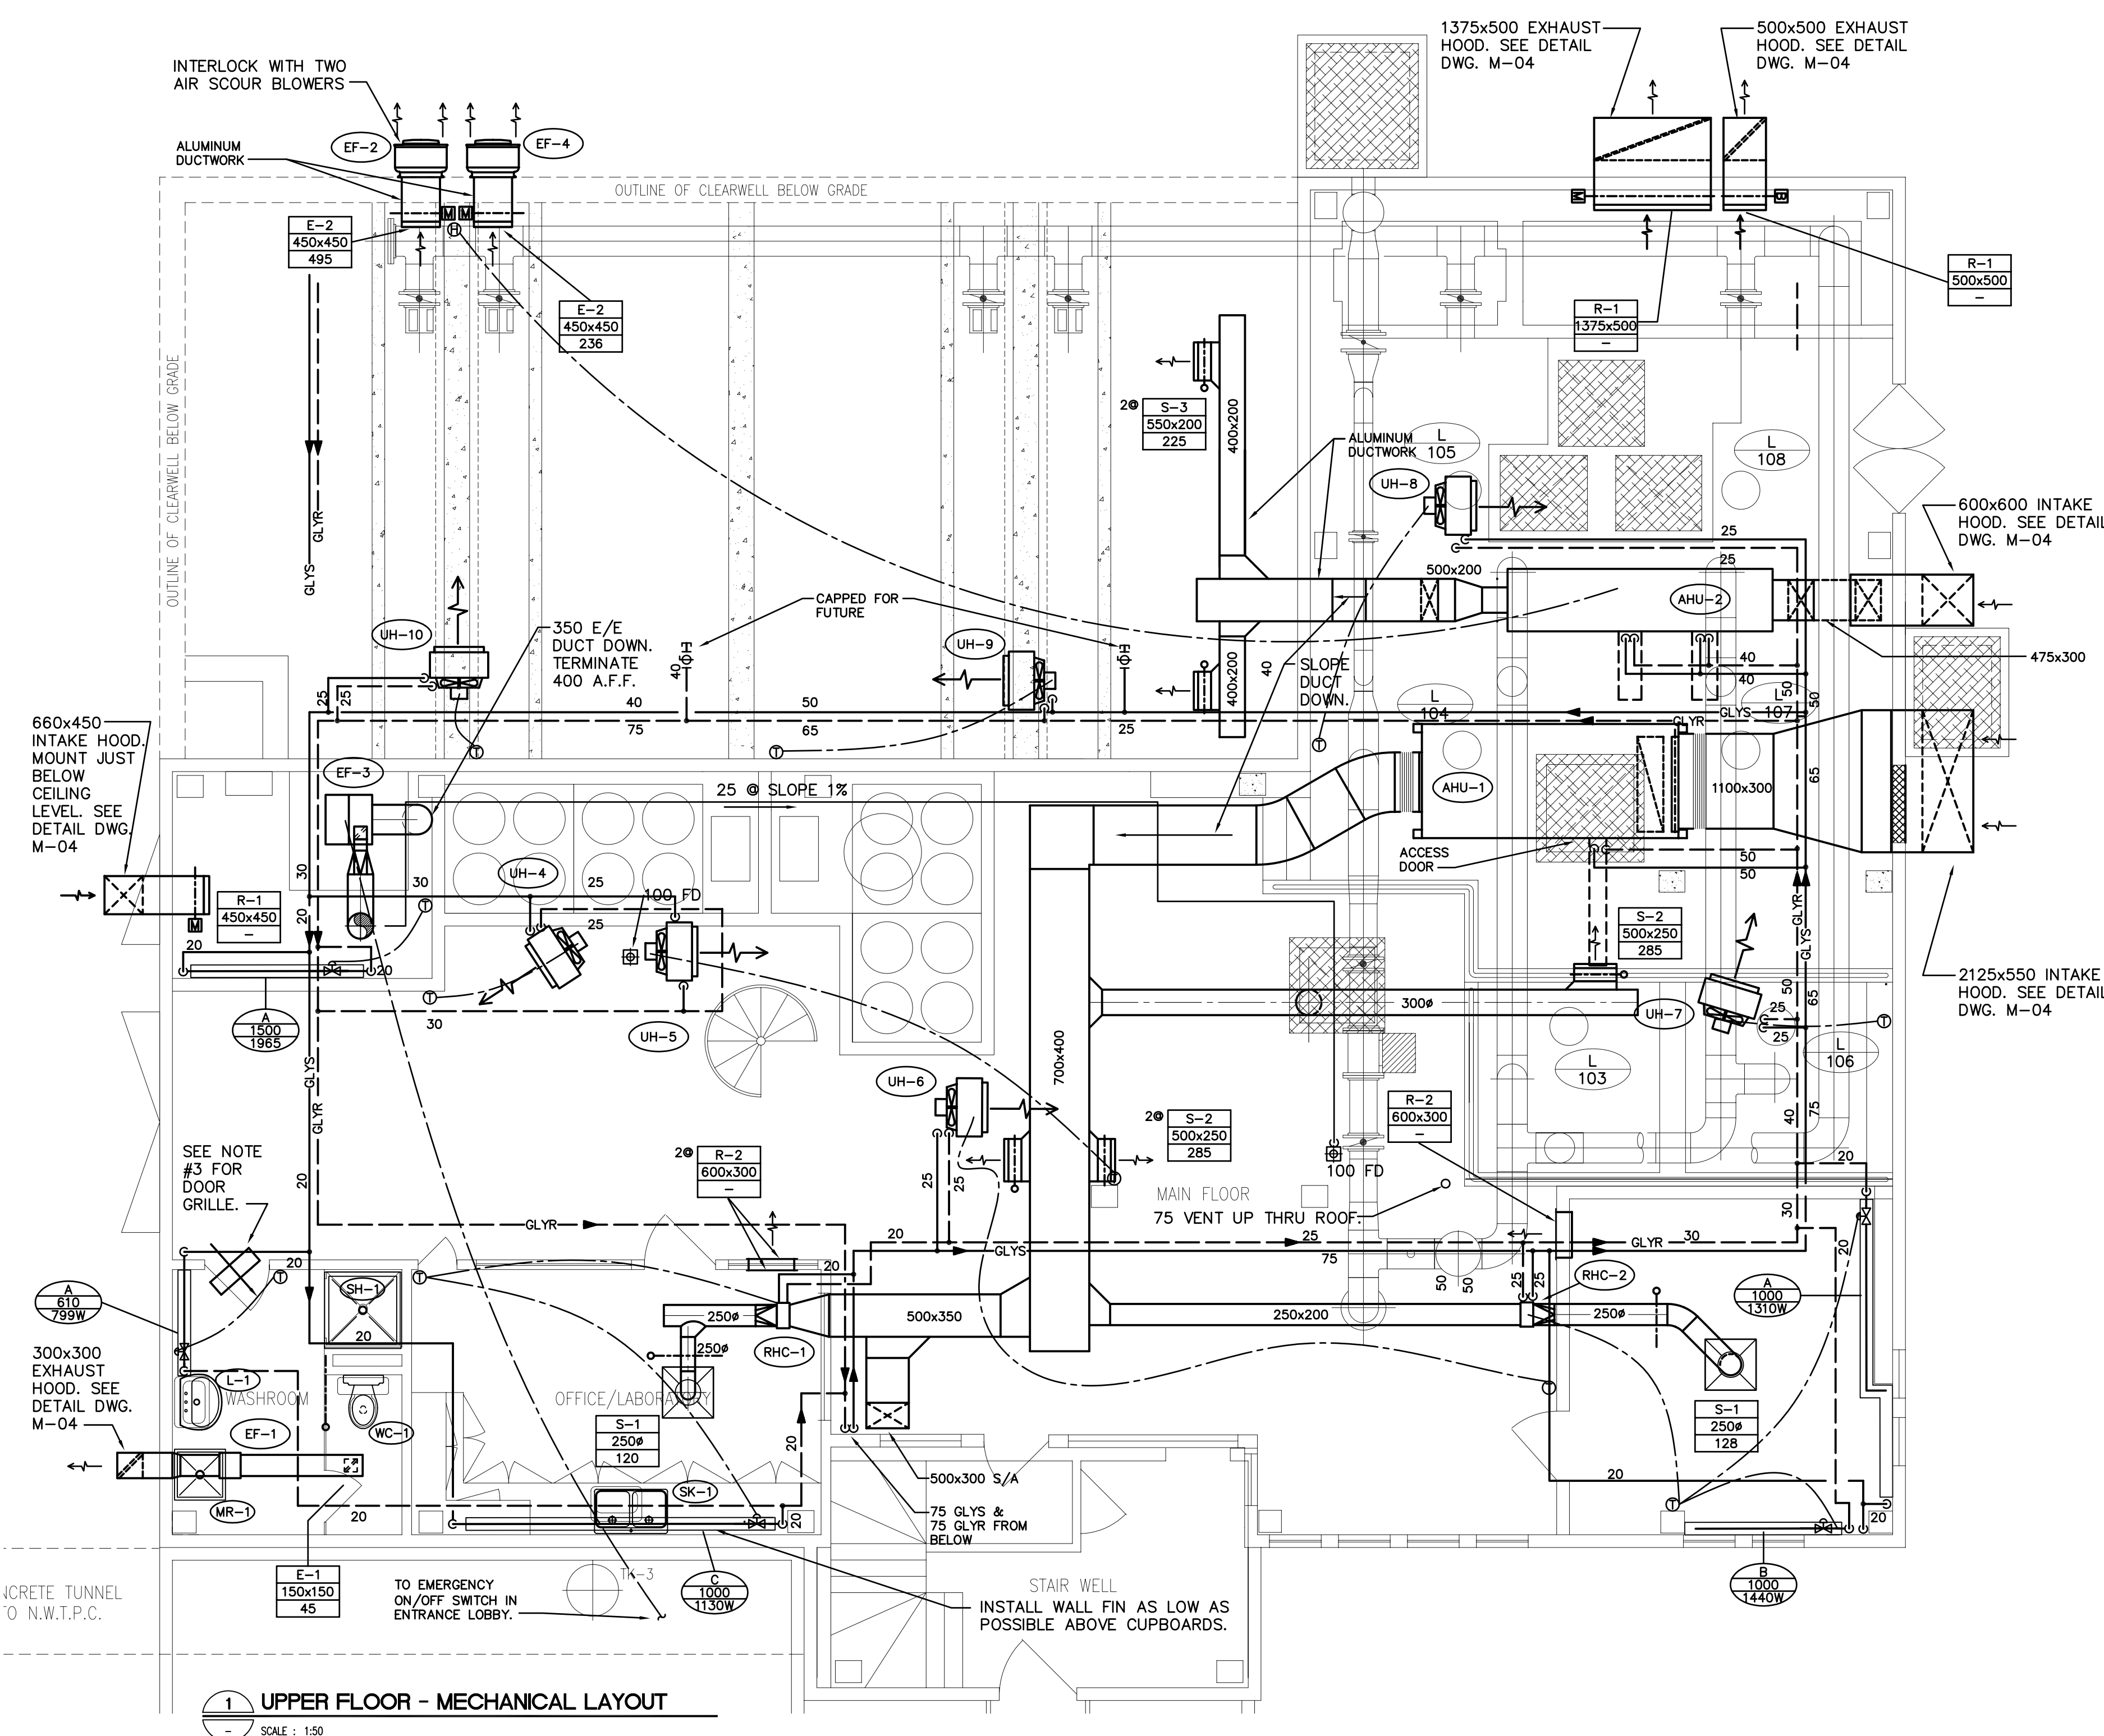

2	RECORD DRAWING	23/04/04	IV
1	ISSUED FOR CONSTRUCTION	22/04/03	DBF
0	ISSUED FOR TENDER	19/02/03	DBF
NO.	REVISION	DATE	INITIAL

INFORMATION CONTAINED IN THESE DRAWINGS
IS AS SUPPLIED BY SHENDEL MECHANICAL
CONTRACTING LTD.
DATE: MAY 03, 2004

Iqaluit

 ᐃᑭᐱᐸᐱᐸ

CITY of IQALUIT,
Nunavut

IQALUIT WATER TREATMENT PLANT



Earth Tech (Canada) Inc.

DRAWN BY: E.JL CHECKED BY: DBF	SCALE: AS NOTED	DATE: FEB. 03, 2003	SHEET NO.
CADD SYSTEM AutoCAD	DWG NO. M-2	REV. 1	CONTRACT 55524

ET:55524/Cadd File:A1-PROJ-SHT.dwg/Last Edit: 2004-04-06 (17:00)/Plot Scale: 1:1 (A1)