
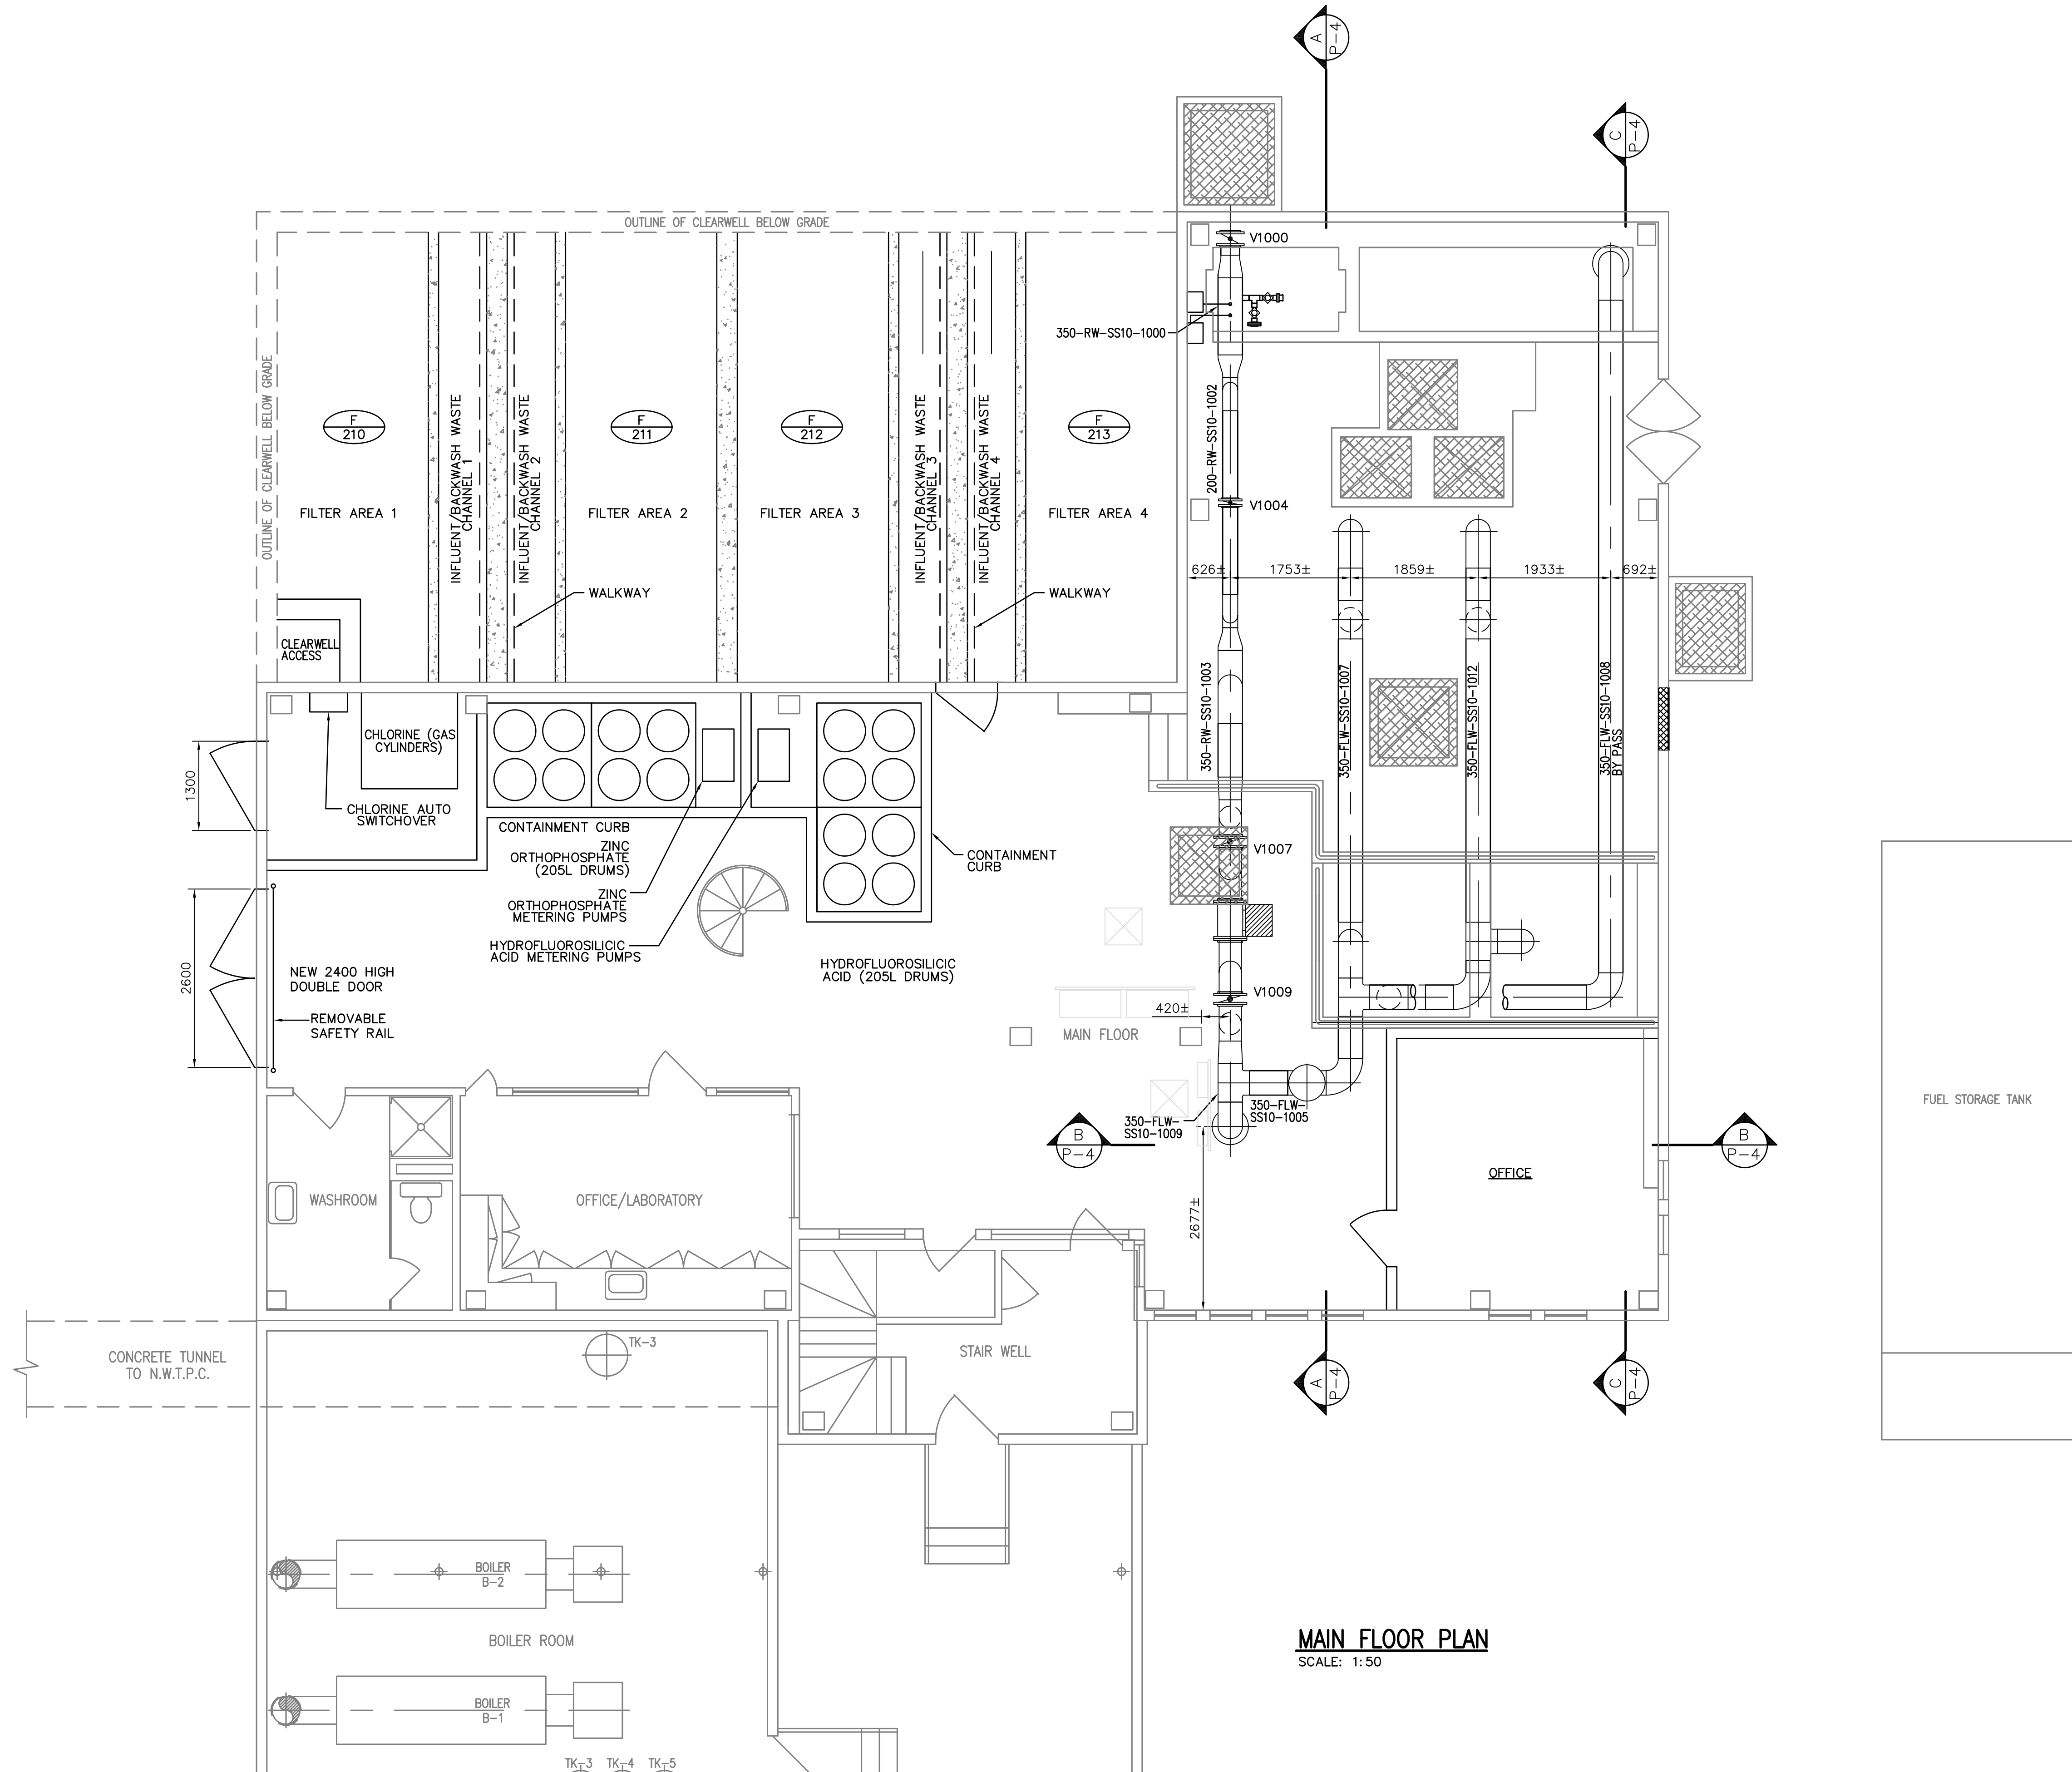


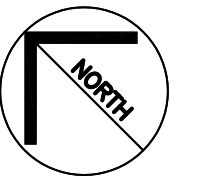

MAIN FLOOR PLAN
SCALE: 1:50

NOTES:
1. ALL ELEVATIONS AND DIMENSIONS ARE APPROXIMATE.

				Company Permit		Engineer Seal		PROCESS		CITY OF IQALUIT		EARTH TECH	
				RECORD DRAWING		INFORMATION CONTAINED IN THESE DRAWINGS IS AS SUPPLIED BY: SCHEDEL MECHANICAL CONTRACTING LTD. THE COMPLETENESS AND ACCURACY OF THIS RECORD DRAWING IS NOT GUARANTEED. INFORMATION SHOULD BE VERIFIED AT THE ACTUAL LOCATION BEFORE USE.		UPPER FLOOR LAYOUT		IQALUIT WATER TREATMENT PLANT		Earth Tech (Canada) Inc.	
2	RECORD DRAWING	23/04/04	DKB									DRAWN BY: CKW/KWM	
1	ISSUED FOR CONSTRUCTION	22/04/03	CKW									CHECKED BY: CKW	
0	ISSUED FOR TENDER	19/02/03	CKW									SCALE: 1:50	
NO.	REVISION	DATE	INITIAL									DATE: OCT. 2002	
												SHEET NO.	
												CADD SYSTEM AutoCAD	
												DWG NO. P-1	
												REV. 1	
												CONTRACT 55524	