
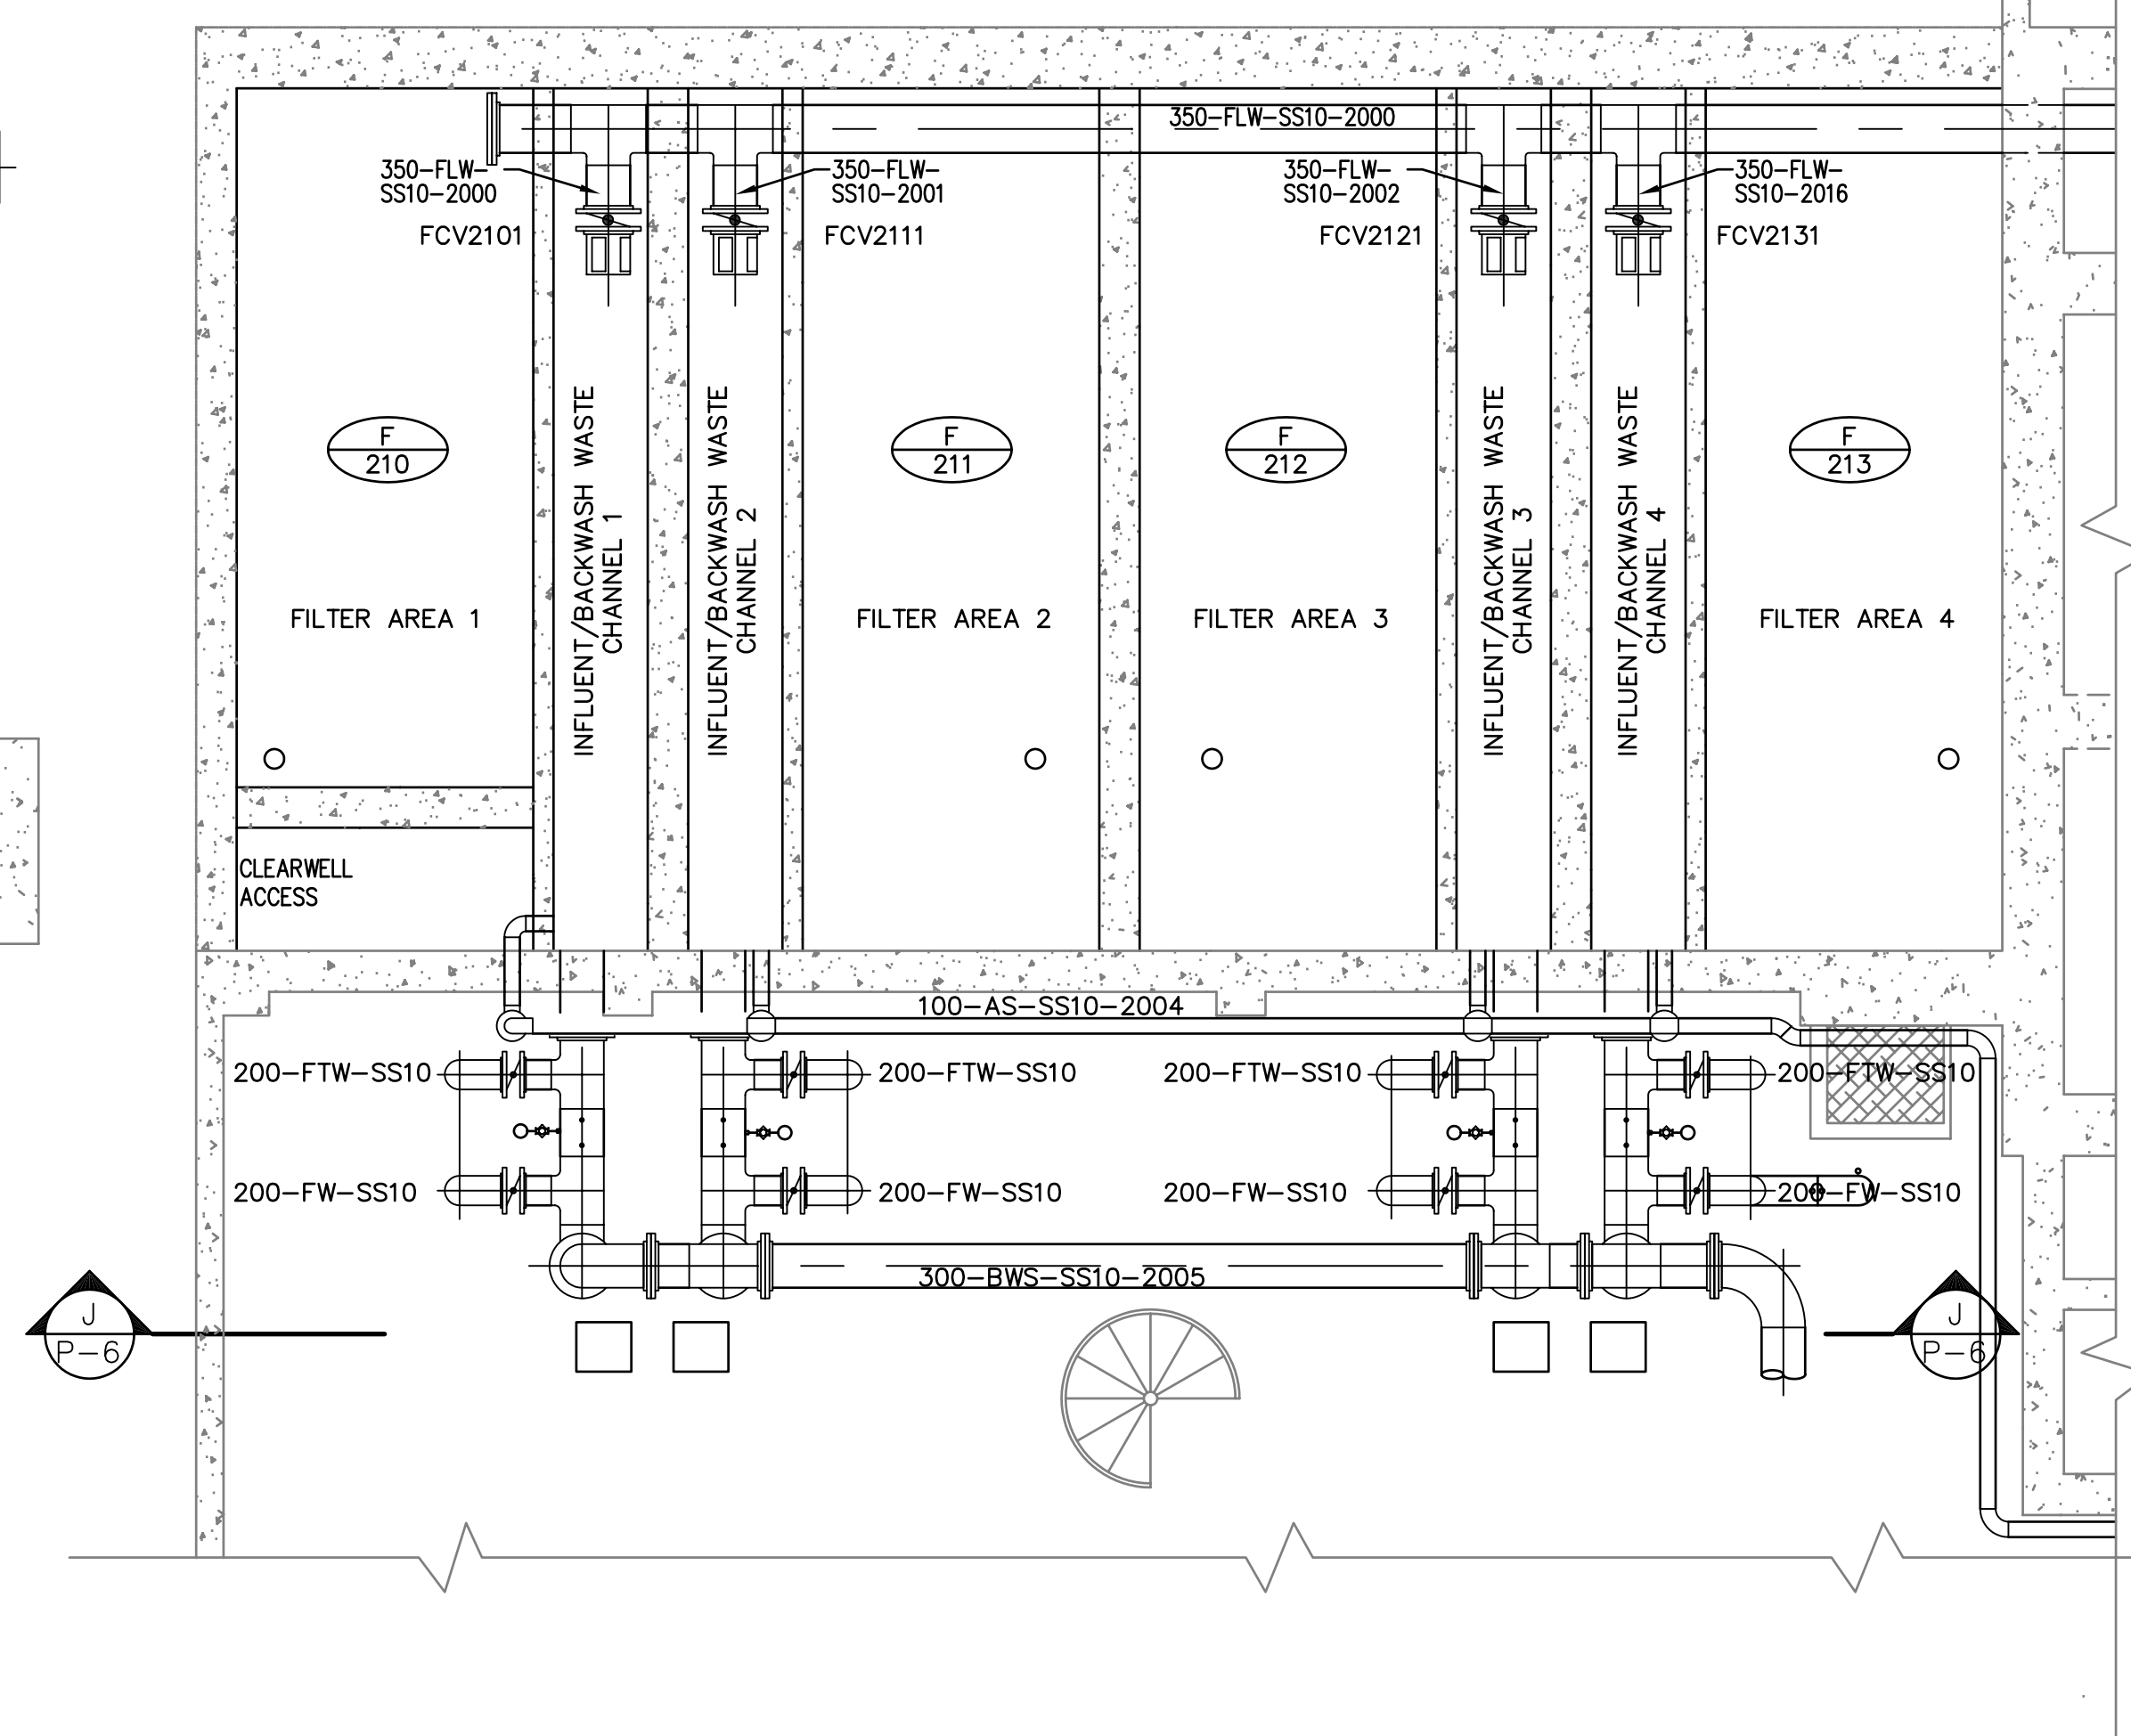


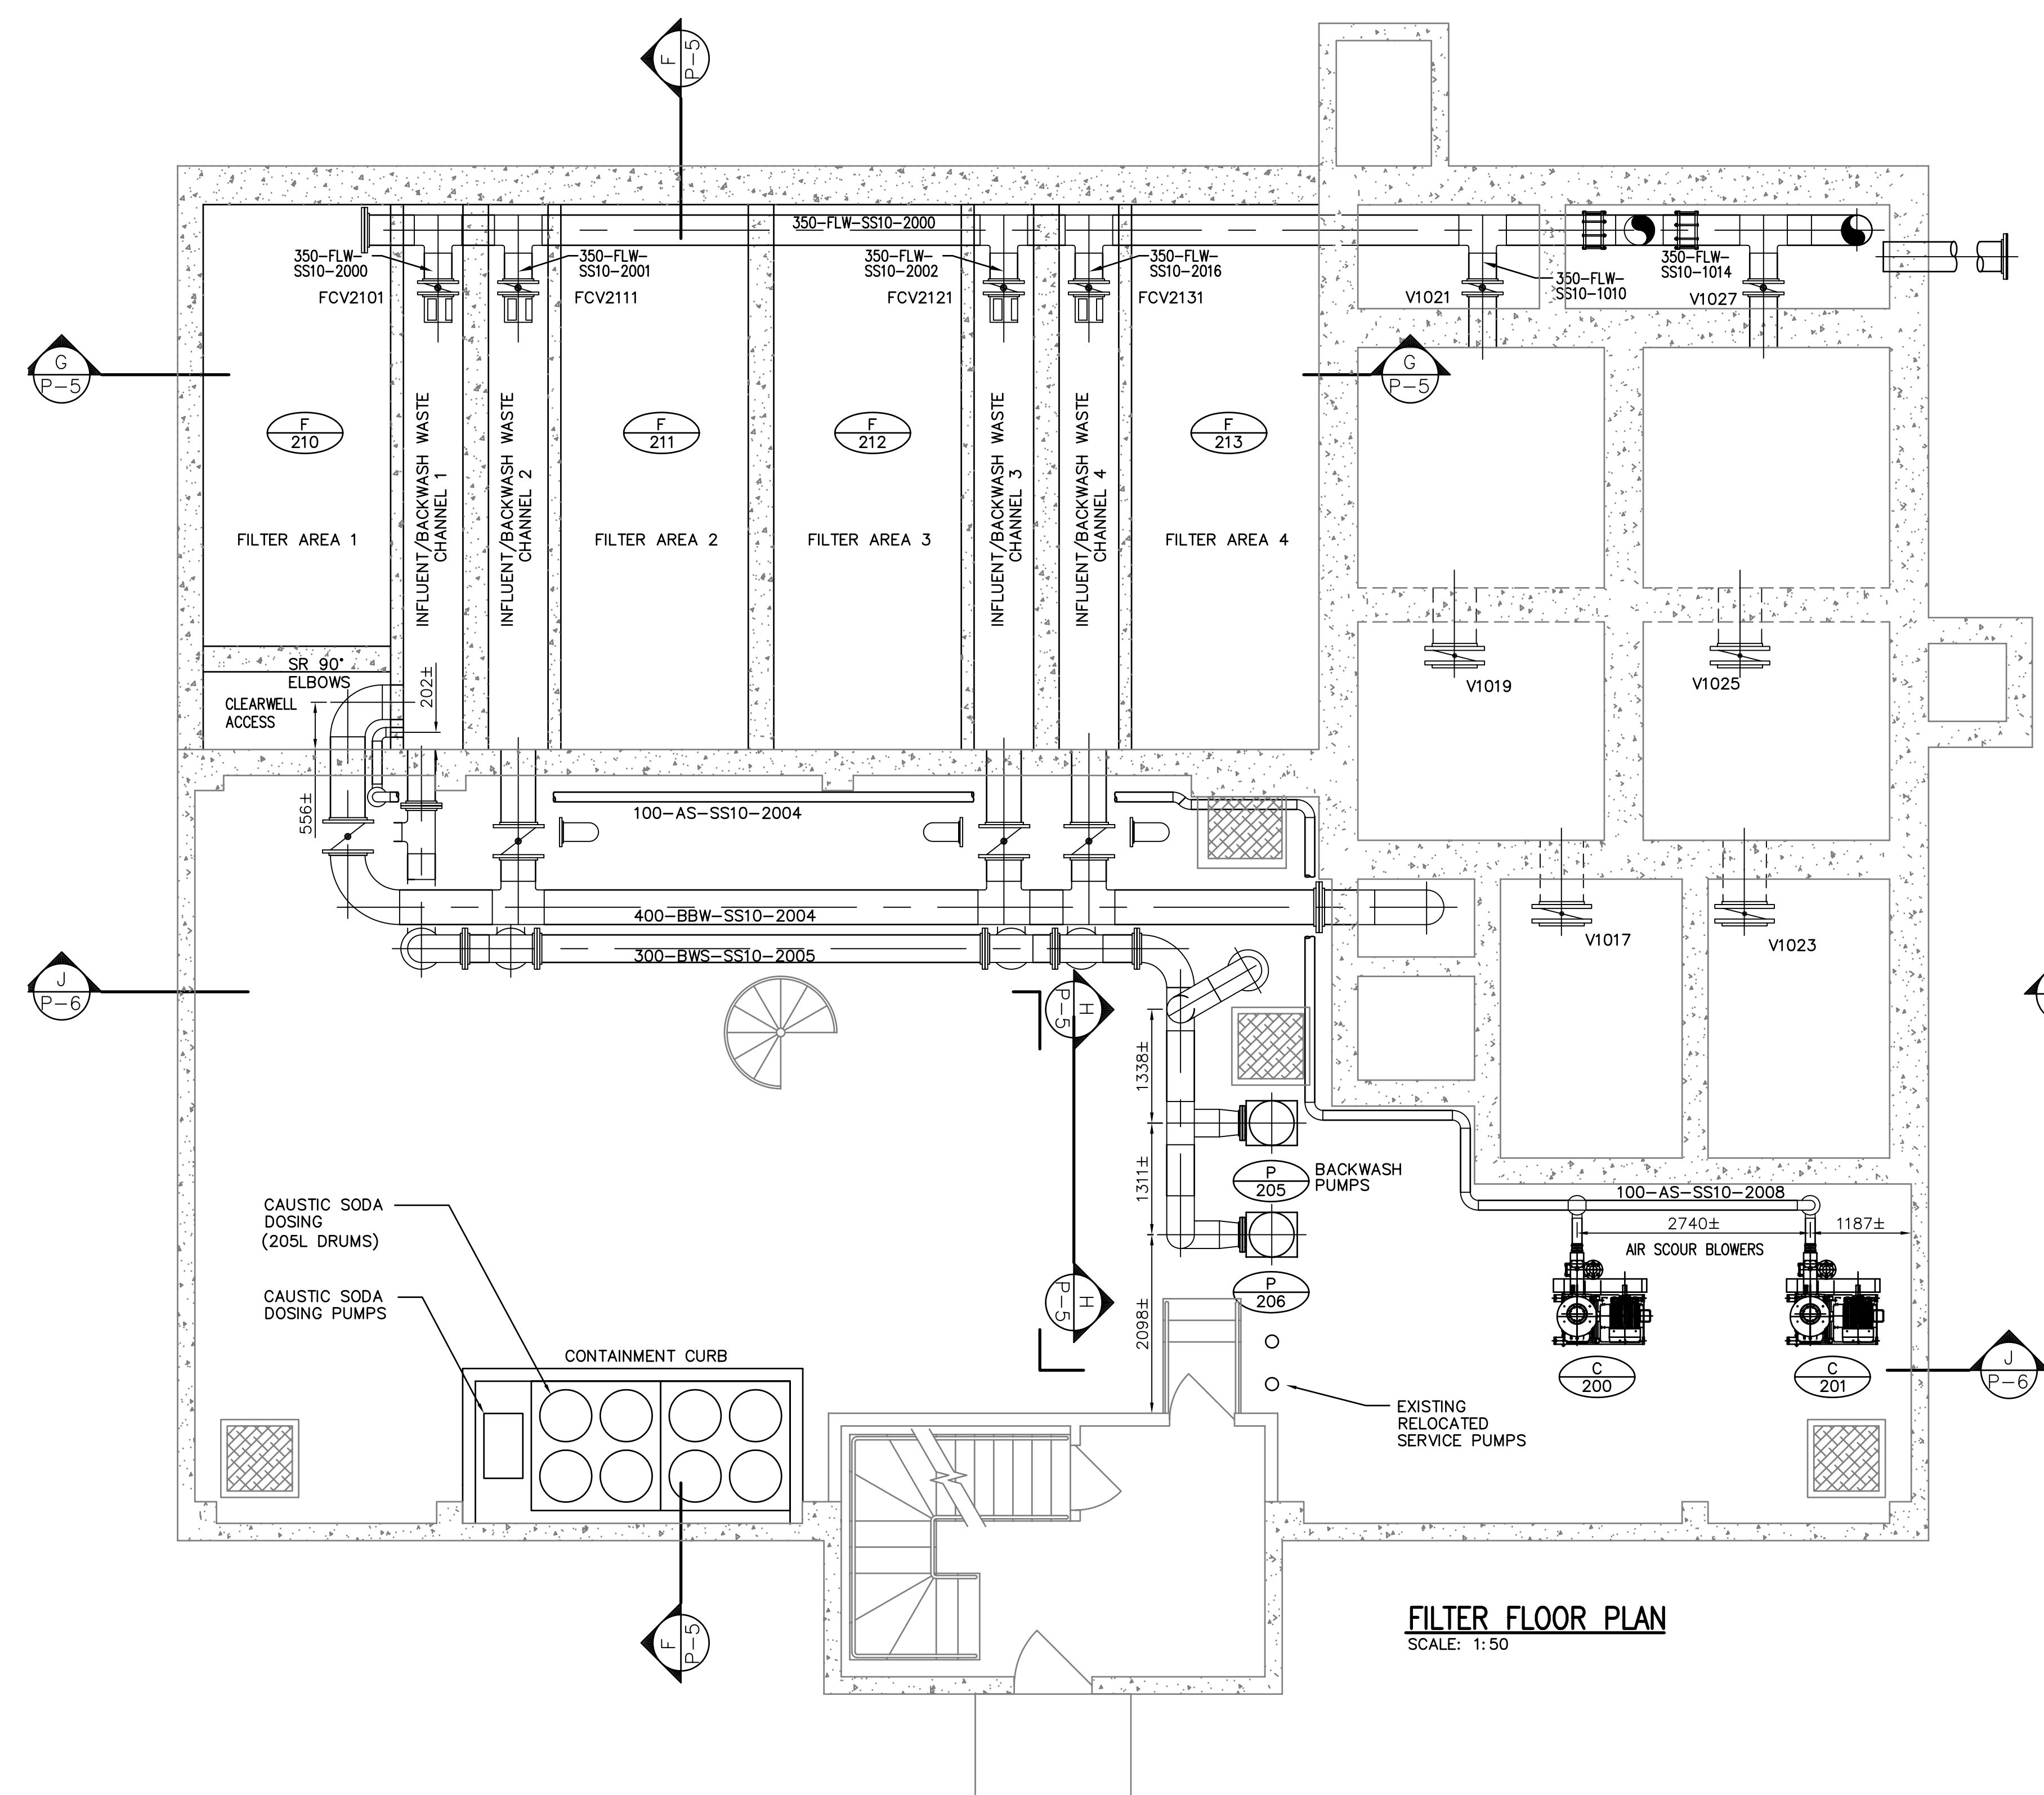

NOTES:

1. ALL ELEVATIONS AND DIMENSIONS ARE APPROXIMATE.

[illegible]