


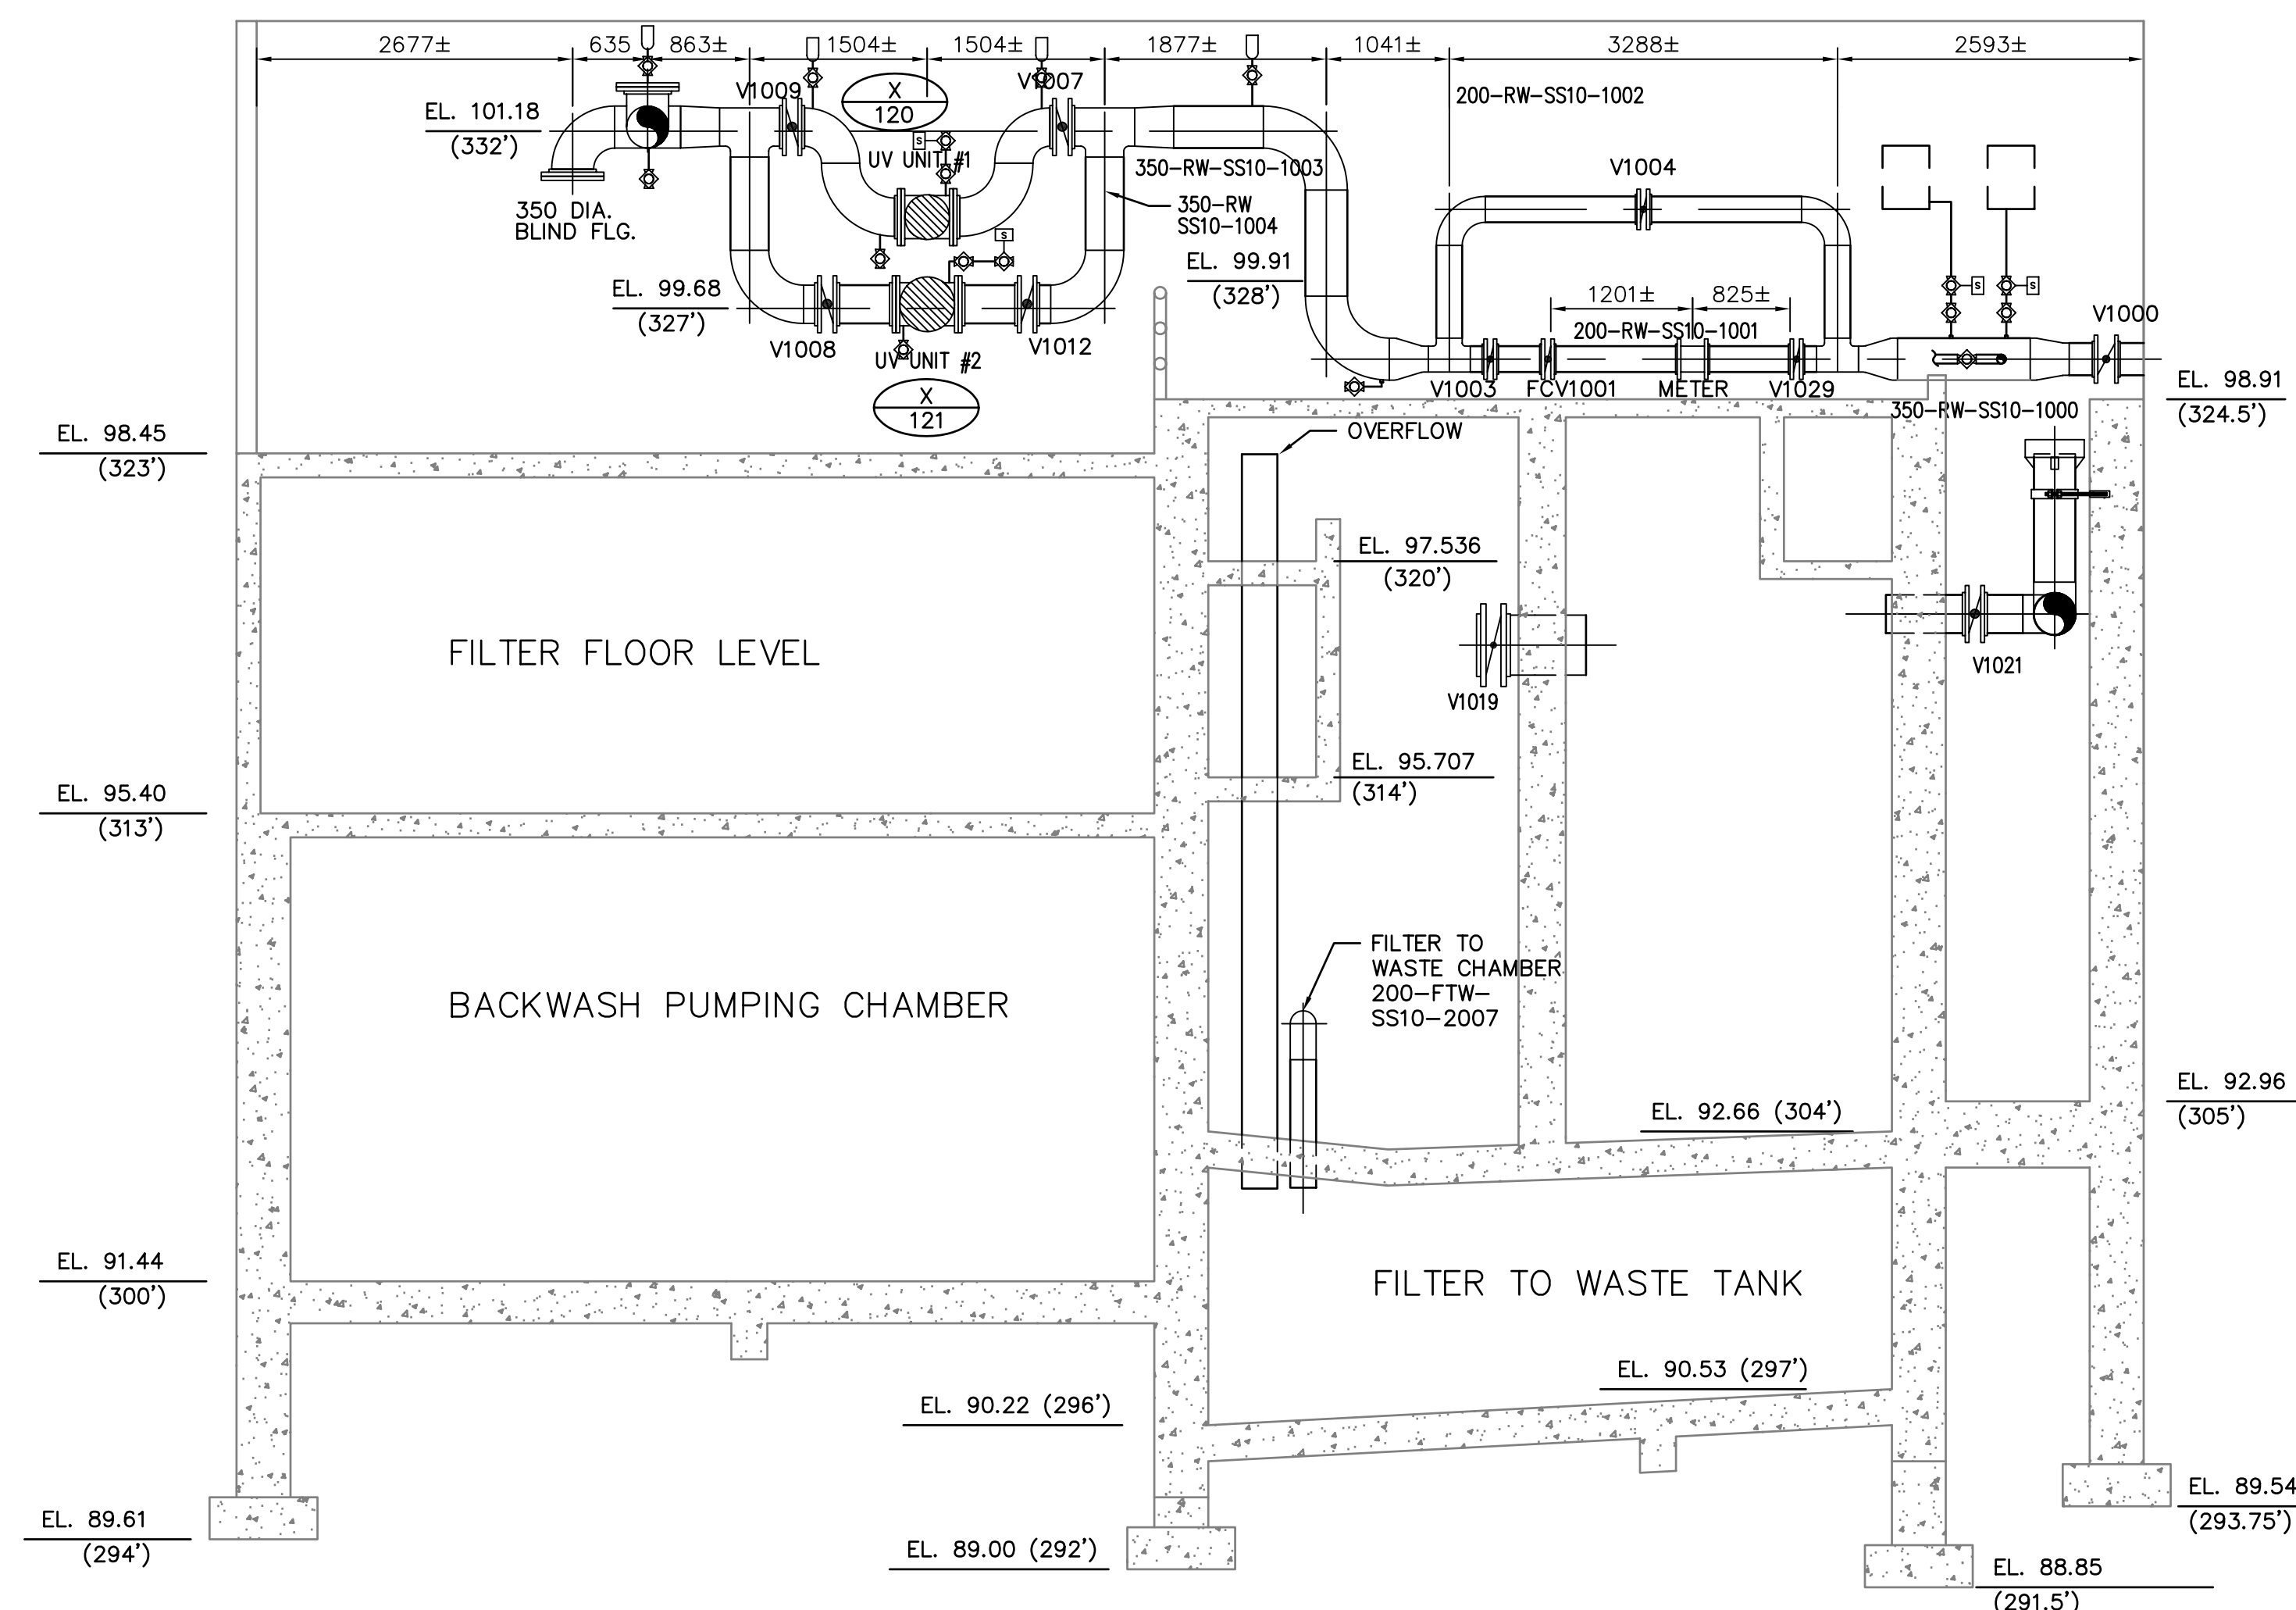


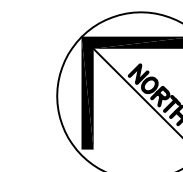

SECTION A
SCALE: 1:50
P-1

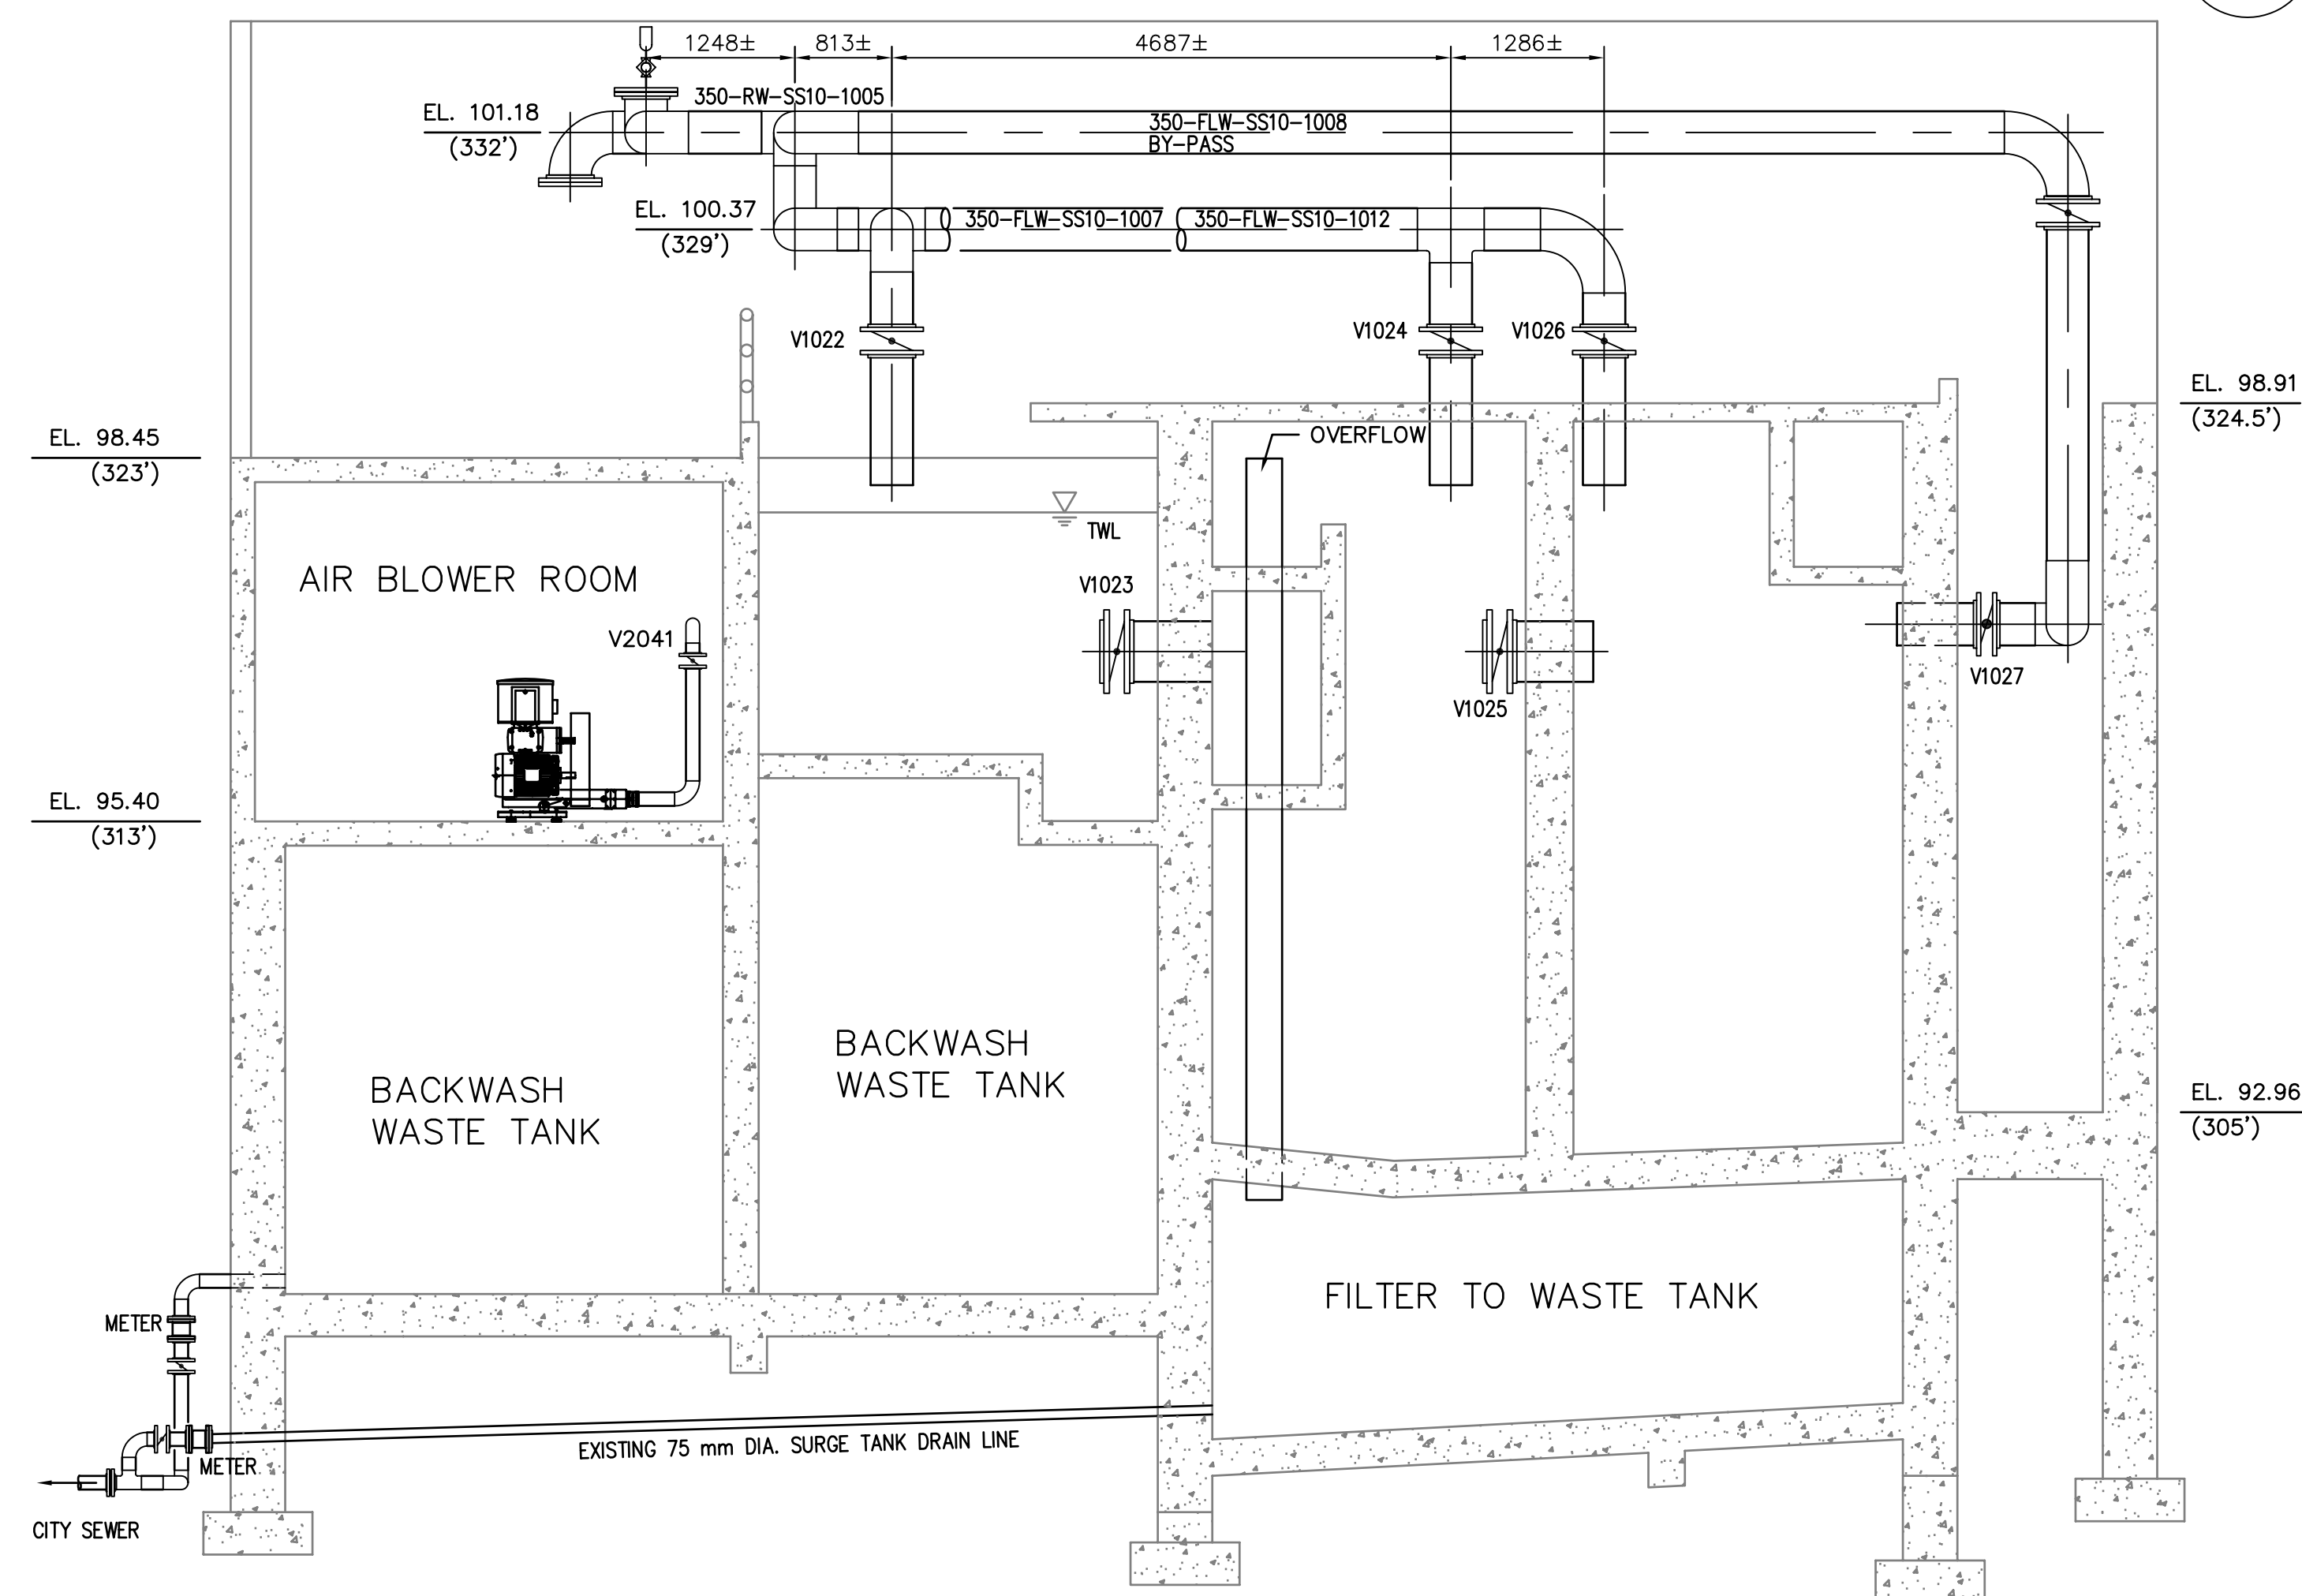

SECTION C
SCALE: 1:50
P-1

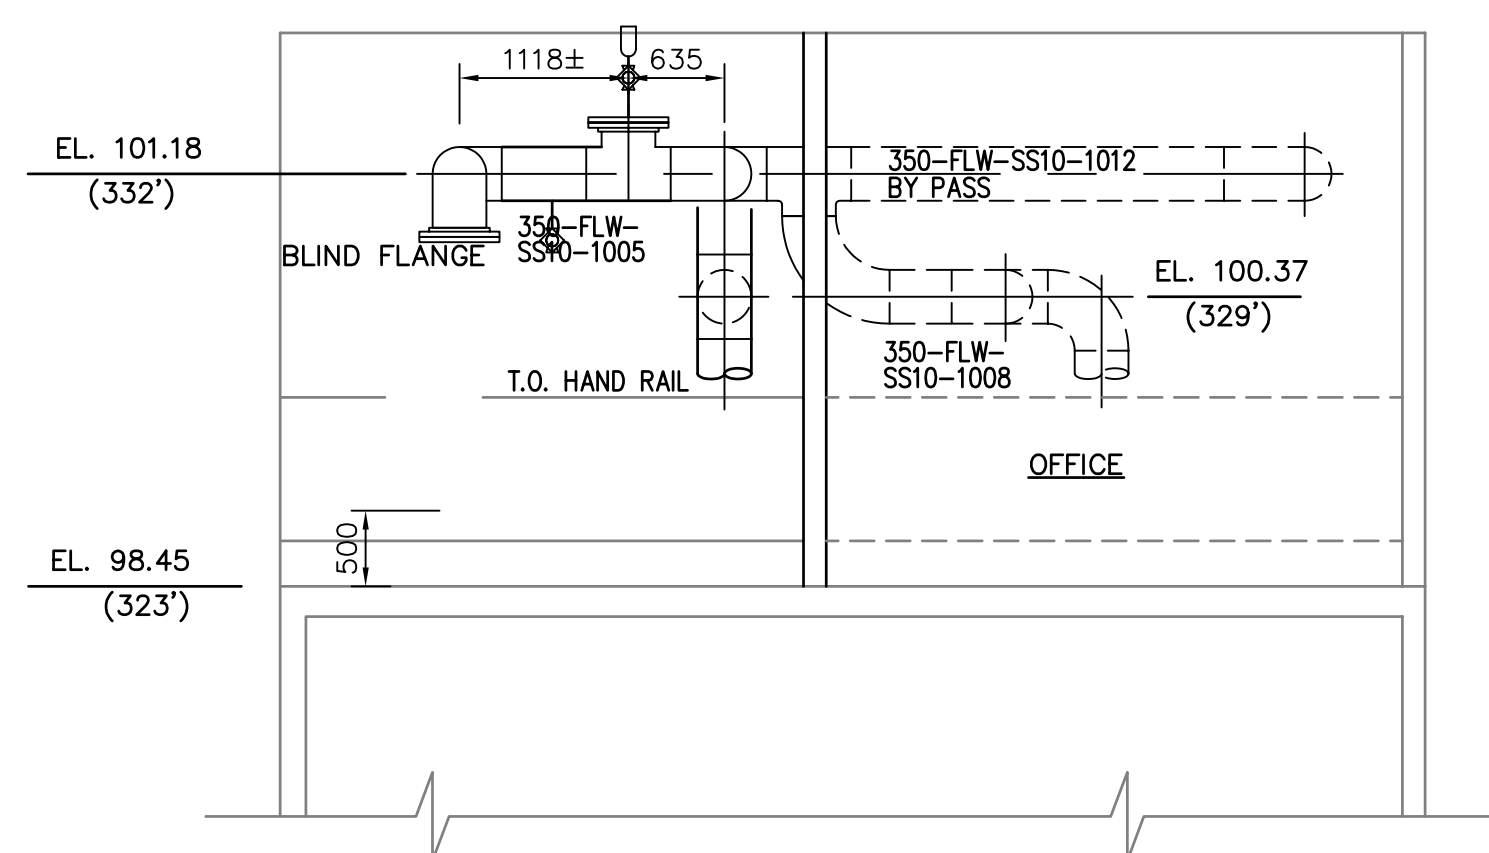

SECTION B
SCALE: 1:50
P-1

NOTES:
1. ALL ELEVATIONS AND DIMENSIONS ARE APPROXIMATE.

Company Permit				Engineer Seal		PROCESS		CITY OF IQALUIT		EARTH TECH			
RECORD DRAWING				INFORMATION CONTAINED IN THESE DRAWINGS IS AS SUPPLIED BY: SCHEDEL MECHANICAL CONTRACTING LTD. THE COMPLETENESS AND ACCURACY OF THIS RECORD DRAWING IS NOT GUARANTEED. INFORMATION SHOULD BE VERIFIED AT THE ACTUAL LOCATION BEFORE USE.		UPPER FLOOR		IQALUIT WATER TREATMENT PLANT		Earth Tech (Canada) Inc.			
2				RECORD DRAWING		23/04/04		DKB		DRAWN BY: CKW/KWM			
1				ISSUED FOR CONSTRUCTION		22/04/03		CKW		CHECKED BY: CKW			
0				ISSUED FOR TENDER		19/02/03		CKW		SCALE: AS NOTED			
NO.				REVISION		DATE		INITIAL		DATE: OCT. 2002			
										SHEET NO.			
										CADD SYSTEM: AutoCAD			
										DWG NO. P-4			
										REV. 1			
										CONTRACT 55524			