


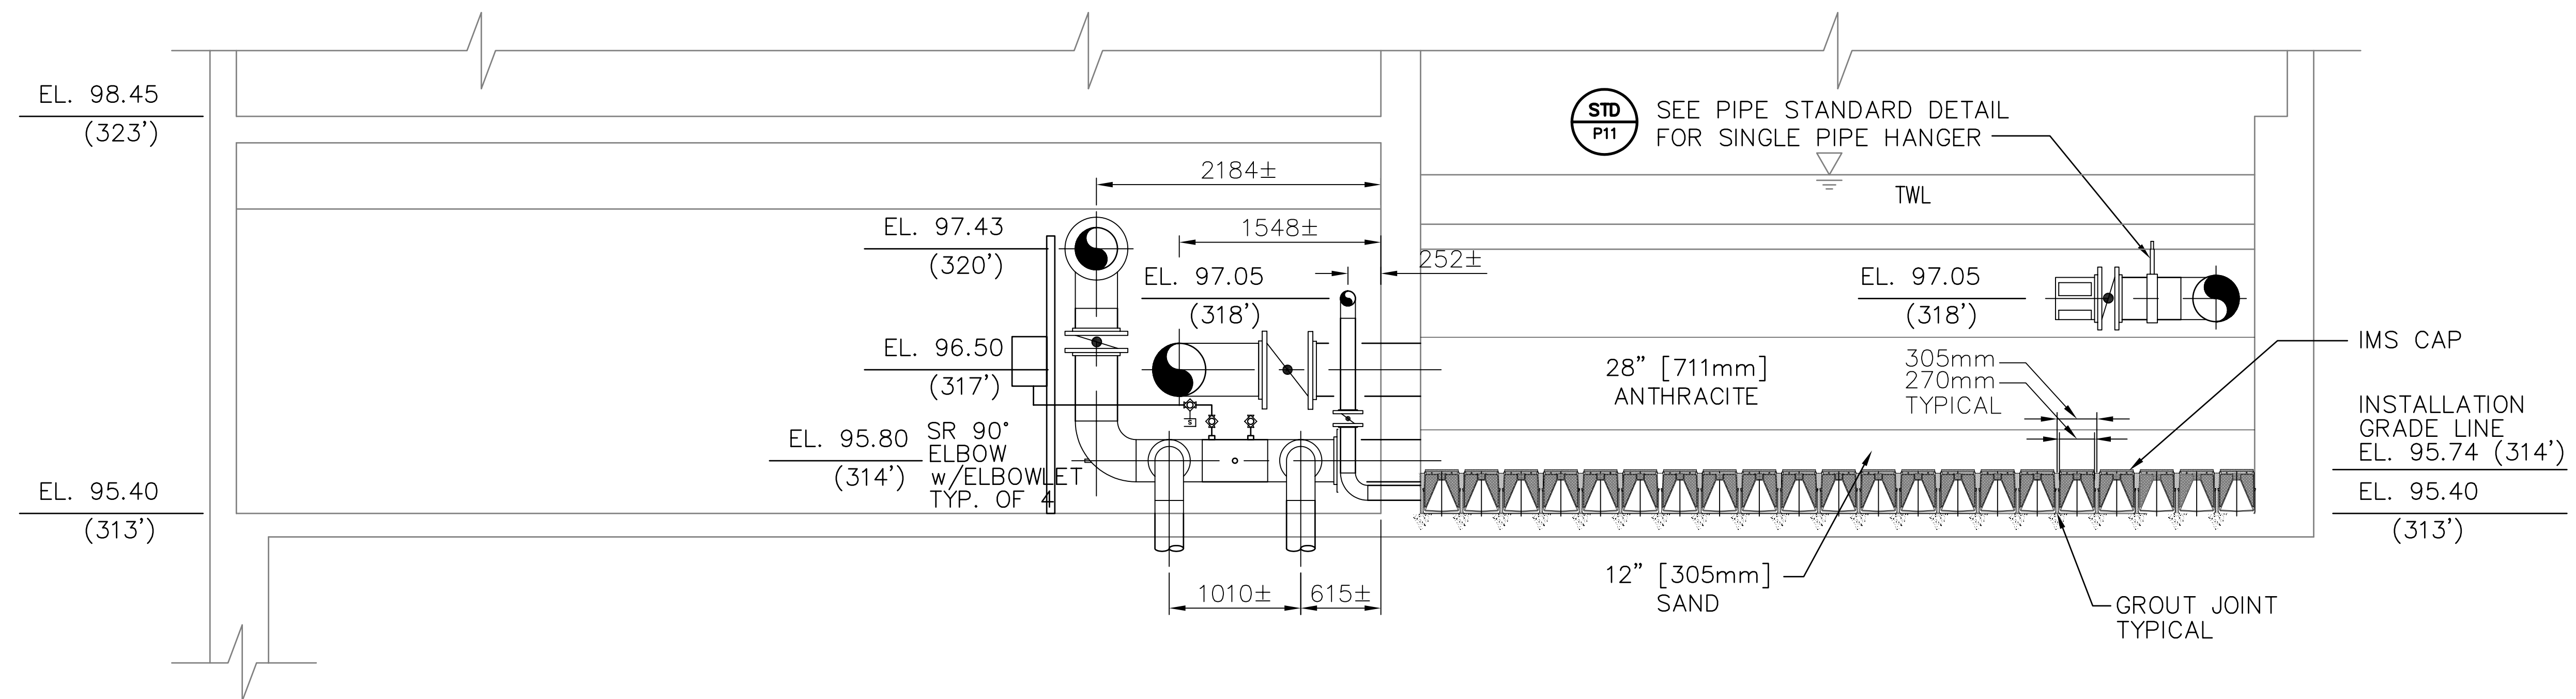


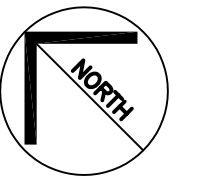

SECTION F
SCALE: 1:30

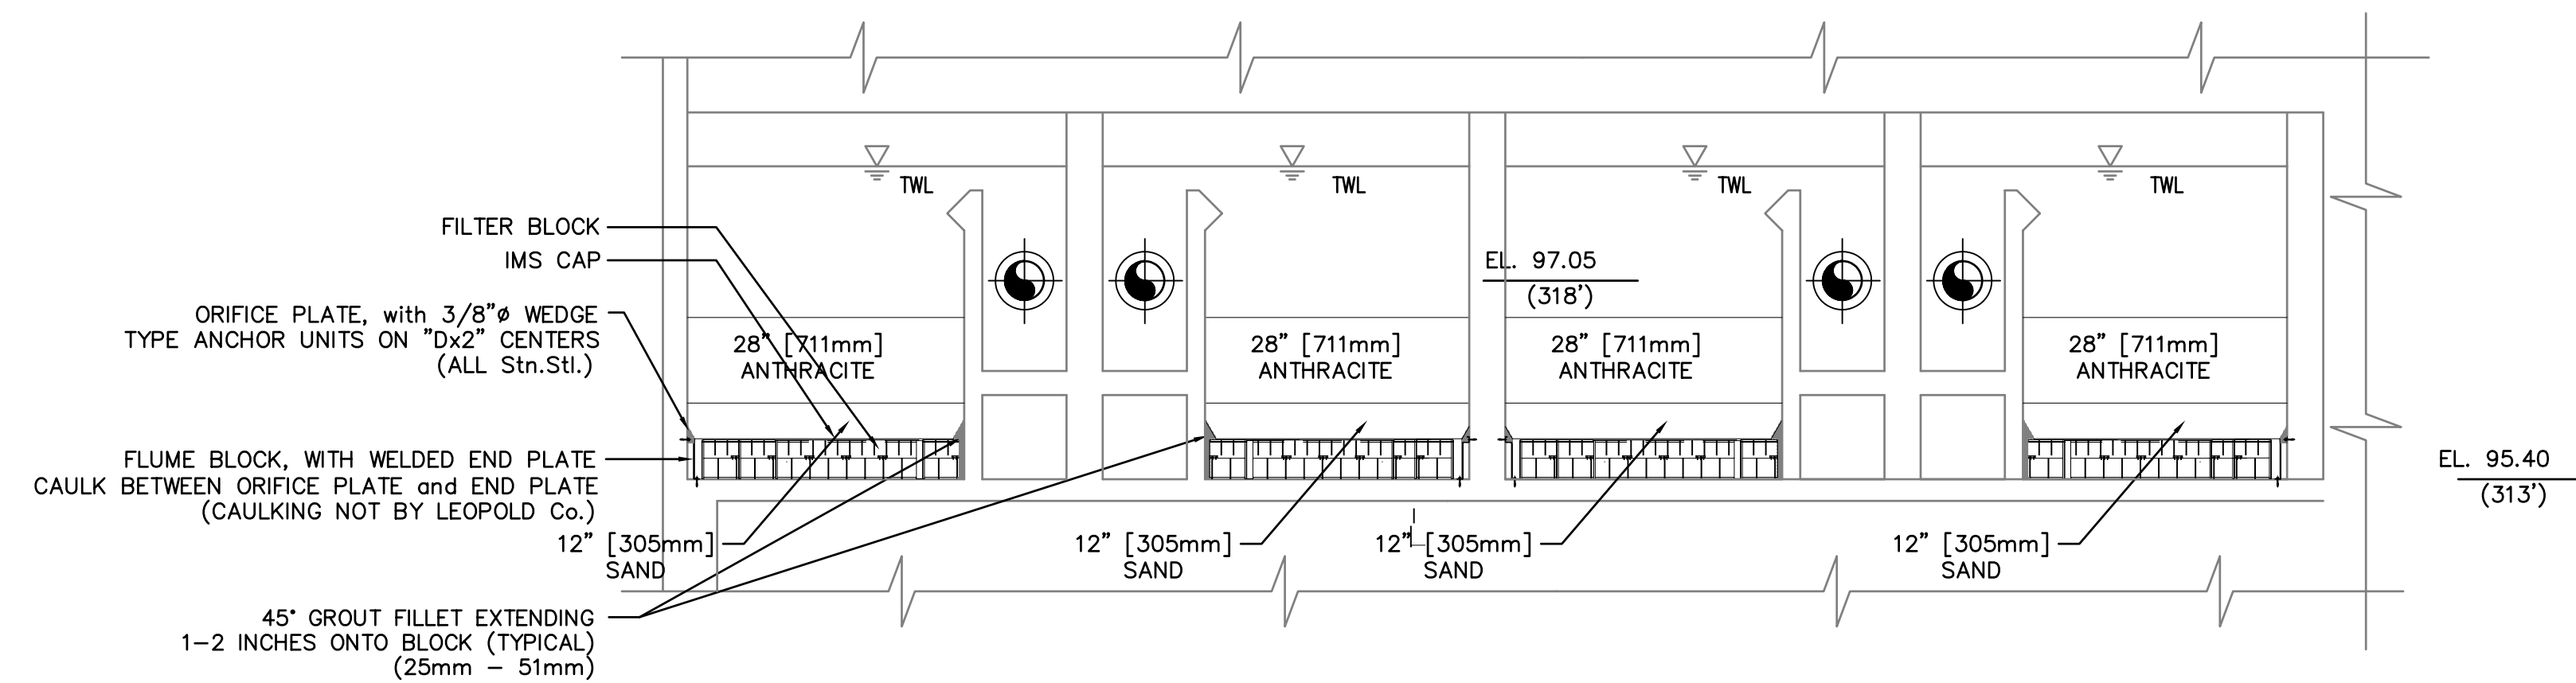

SECTION G
SCALE: 1:50

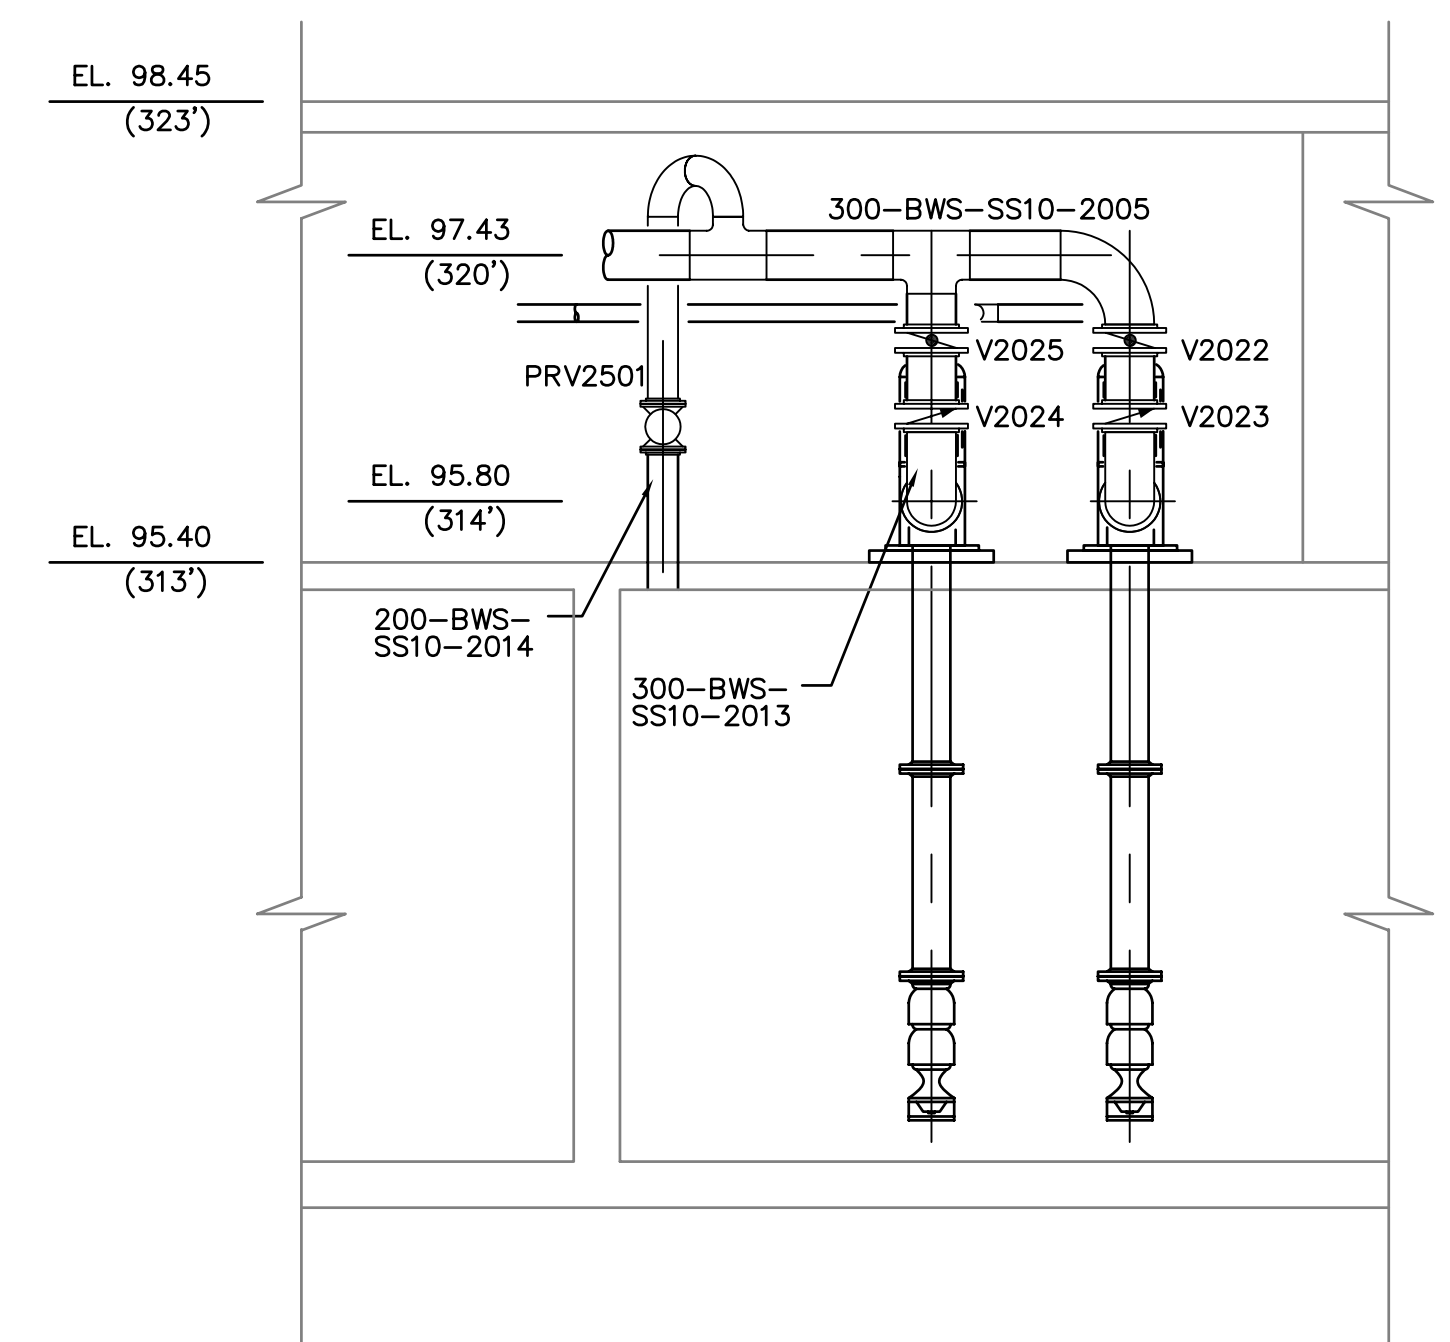

SECTION H
SCALE: 1:50

NOTES:
1. ALL ELEVATIONS AND DIMENSIONS ARE APPROXIMATE.

Company Permit				Engineer Seal		PROCESS		CITY OF IQALUIT		EARTH TECH			
RECORD DRAWING				INFORMATION CONTAINED IN THESE DRAWINGS IS AS SUPPLIED BY: SCHENDEL MECHANICAL CONTRACTING LTD. THE COMPLETENESS AND ACCURACY OF THIS RECORD DRAWING IS NOT GUARANTEED. INFORMATION SHOULD BE VERIFIED AT THE ACTUAL LOCATION BEFORE USE.		FILTER FLOOR		CITY of IQALUIT, Nunavut		Earth Tech (Canada) Inc.			
ISSUED FOR CONSTRUCTION				22/04/03		SECTION F TO H		IQALUIT WATER TREATMENT PLANT		DRAWN BY: CKW/KWM			
ISSUED FOR TENDER				19/02/03						CHECKED BY: CKW			
NO.				REVISION						CADD SYSTEM AutoCAD			
				DATE						DWG NO. P-5			
				INITIAL						DATE: OCT. 2002			
										SHEET NO.			
										REV. 1			
										CONTRACT 55524			