
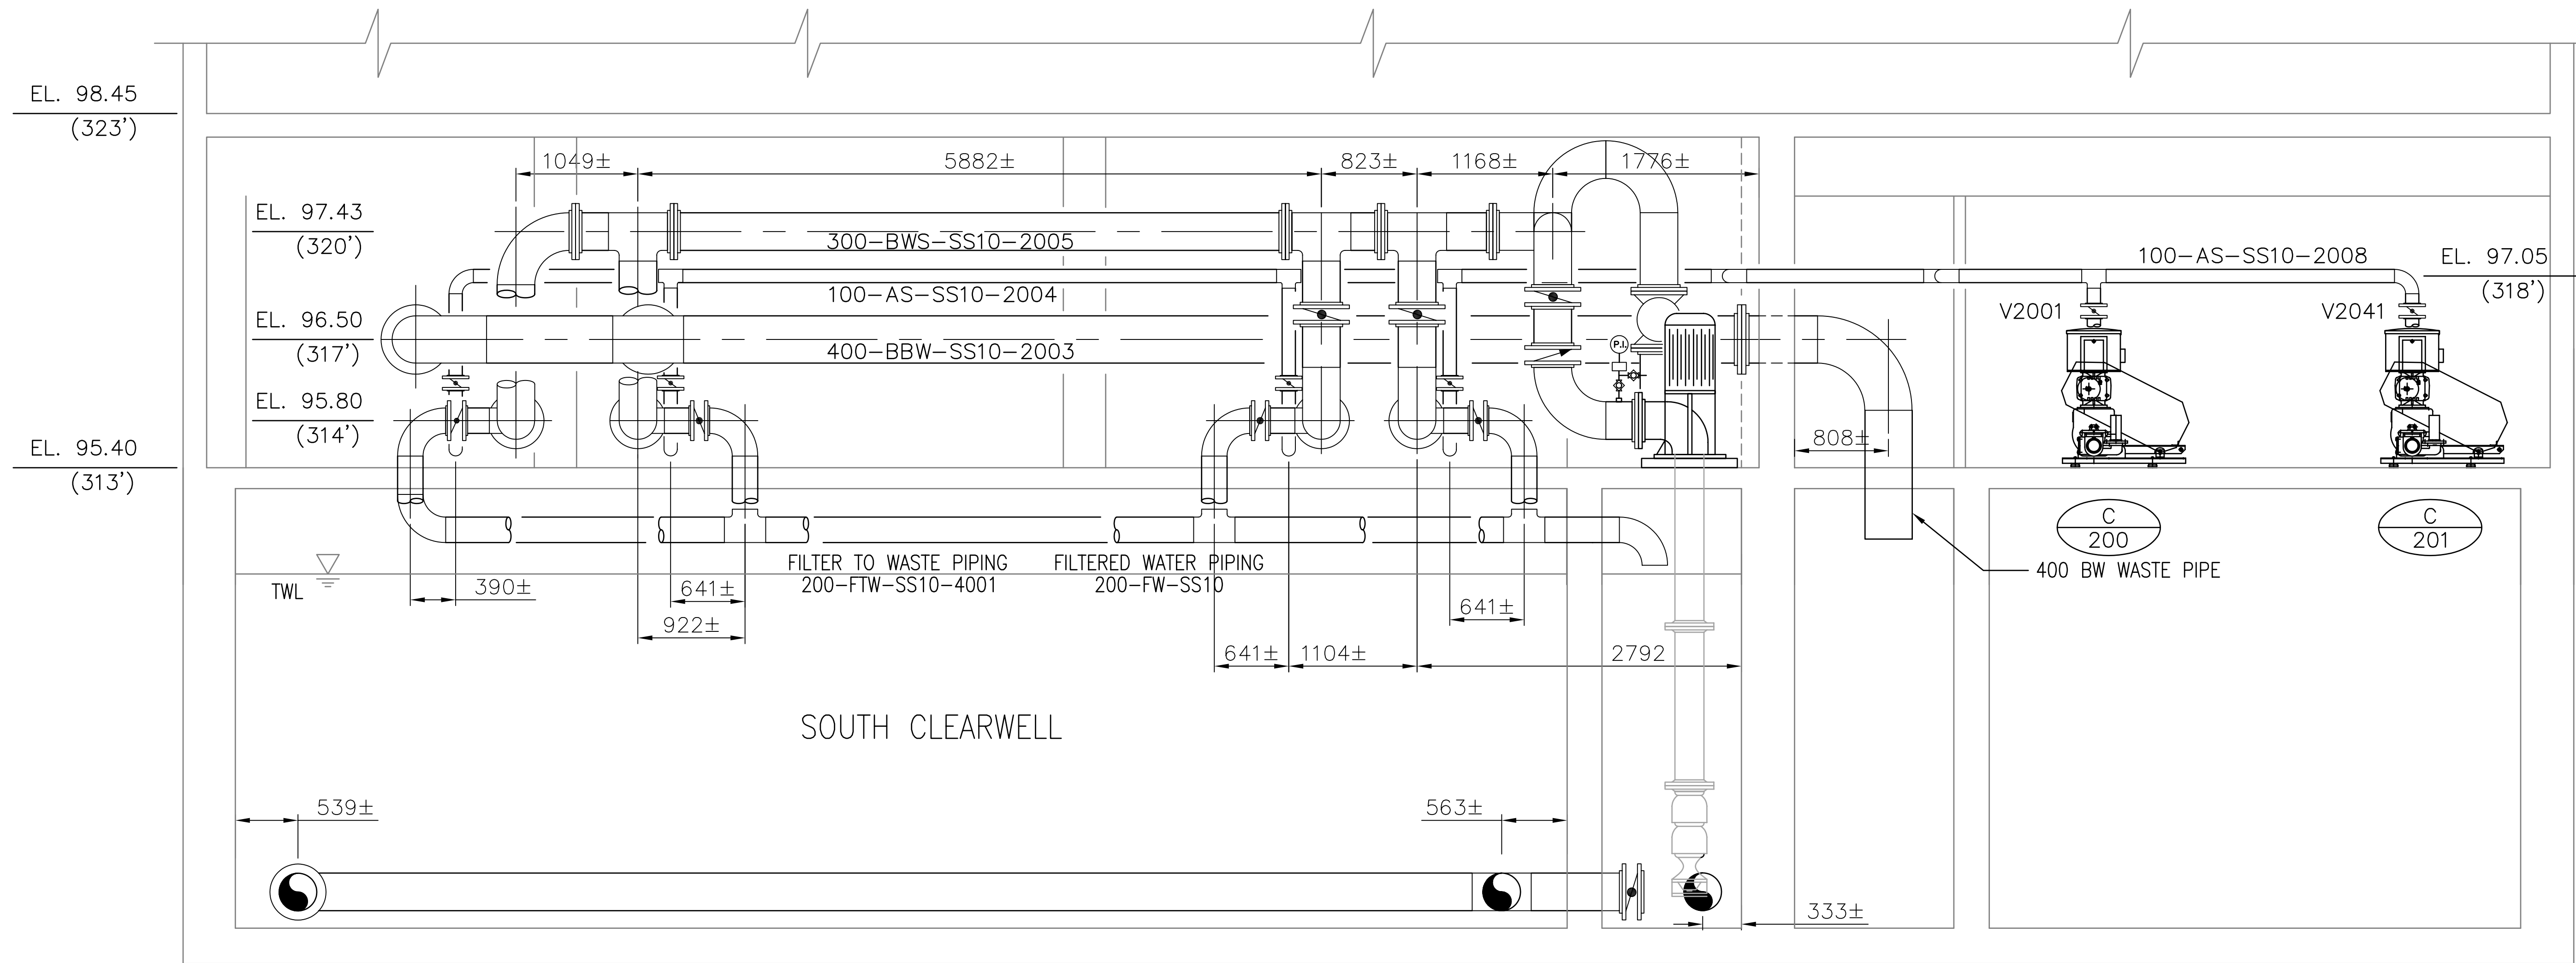


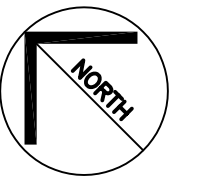

SECTION J
SCALE: 1:30

NOTES:
1. ALL ELEVATIONS AND DIMENSIONS ARE APPROXIMATE.

				Company Permit		Engineer Seal		PROCESS		CITY OF IQALUIT		EARTHTECH			
				RECORD DRAWING INFORMATION CONTAINED IN THESE DRAWINGS IS AS SUPPLIED BY: SCHENDEL MECHANICAL CONTRACTING LTD. THE COMPLETENESS AND ACCURACY OF THIS RECORD DRAWING IS NOT GUARANTEED. INFORMATION SHOULD BE VERIFIED AT THE ACTUAL LOCATION BEFORE USE.				FILTER FLOOR SECTION J				IQALUIT WATER TREATMENT PLANT		Earth Tech (Canada) Inc.	
DRAWN BY: CKW/KWM		SCALE: AS NOTED	DATE: OCT. 2002											SHEET NO.	
CHECKED BY: CKW															
CADD SYSTEM AutoCAD		DWG. NO. P-6	REV. 1.											CONTRACT 55524	
2	RECORD DRAWING	23/04/04	DKB												
1	ISSUED FOR CONSTRUCTION	22/04/03	CKW												
0	ISSUED FOR TENDER	19/02/03	CKW												
NO.	REVISION	DATE	INITIAL												